

**BUILDING 100
REFLECTED CEILING PLAN**


APPLICATION NO. 77/50602

REFLECTED CEILING PLAN - BUILDING 100
DETAILS

MT. VERNON MODERNIZATION
BAKERSFIELD CITY SCHOOL DISTRICT
2161 POTIOMAC AVENUE
BAKERSFIELD, CALIFORNIA 93307

87-126

1 FEB. 1989

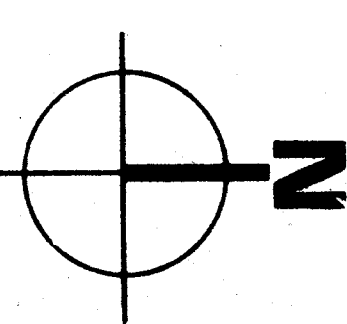

architects - planners

approved

CR/CA

DR GRANT

DR GRANT

C 3182
C 6564
C 8021
C 8702
© copyright 1989

DR GRANT

bfgc inc.
architects planners
37 Broadway
New York, NY 10013
Tel: 212 675 1332
© copyright 1989

APPLICATION NO. 77/50602

87-126
1 FEB. 1989

