

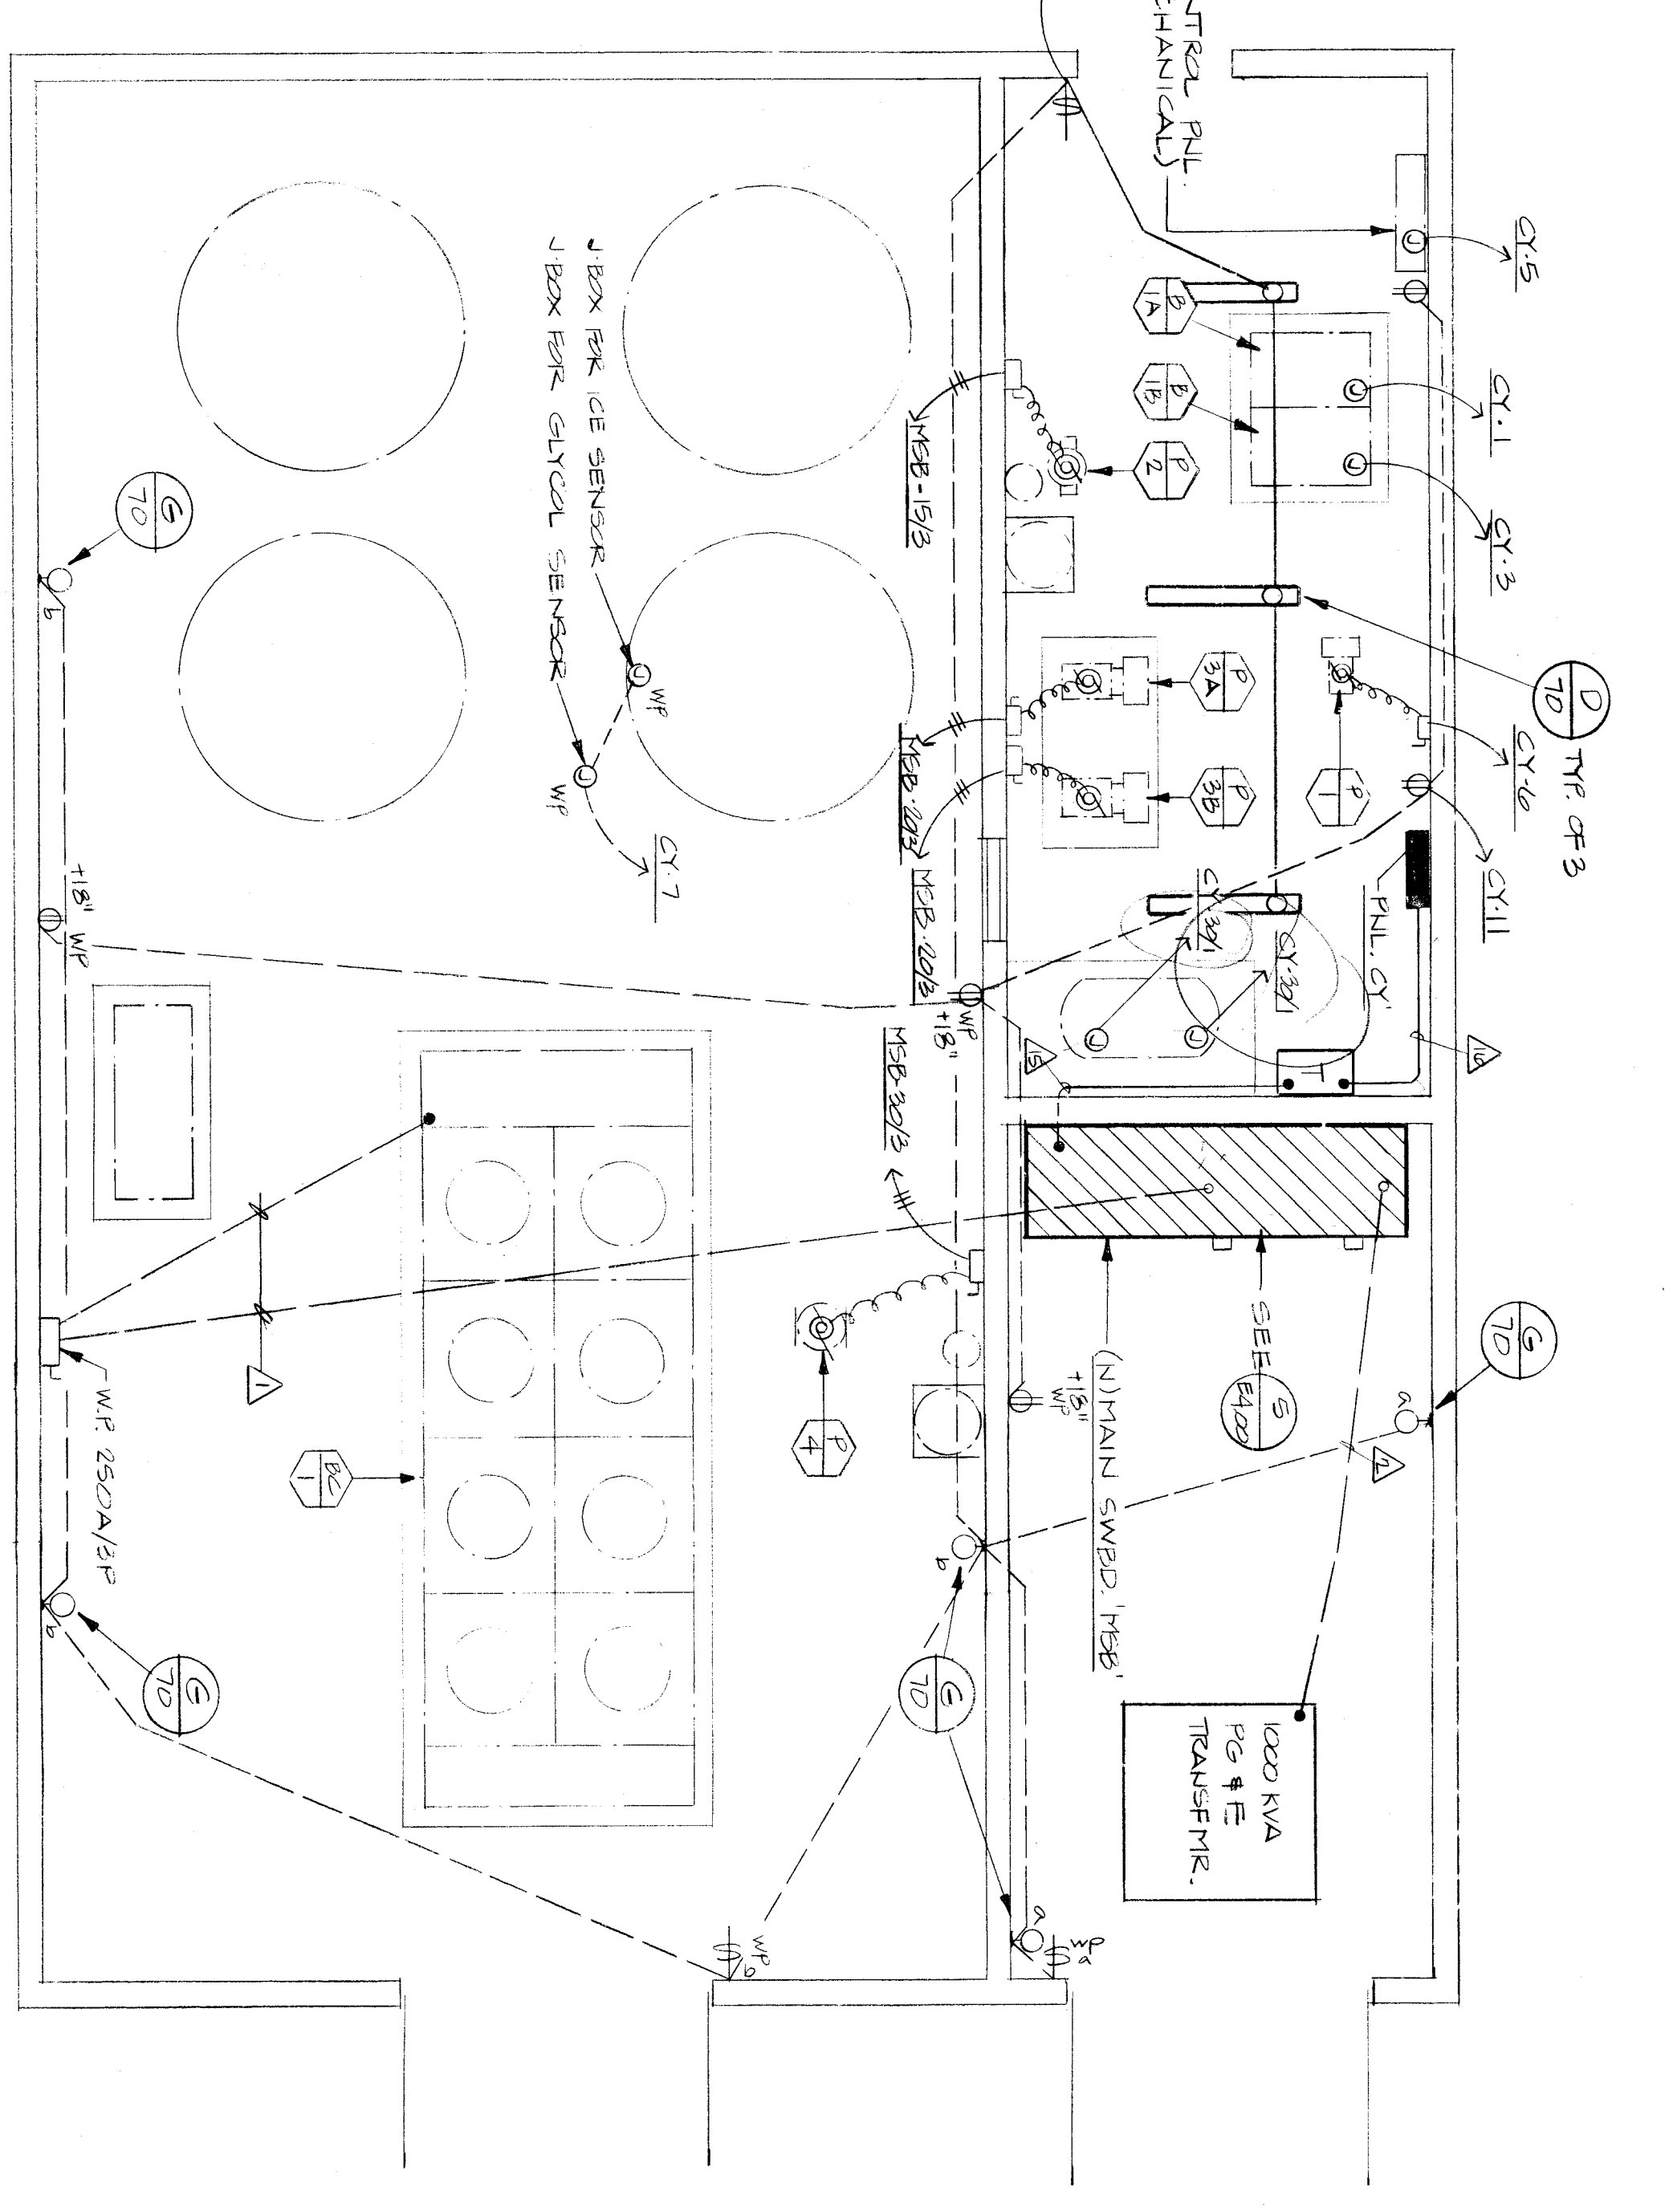


PANEL			TYPE		
CIRCUIT NUMBER	USE	LOAD TYPE	CIRCUIT NUMBER	USE	LOAD TYPE
01	FEEDER	CB	1	FEEDER	CB
02	FEEDER	CB	2	FEEDER	CB
03	FEEDER	CB	3	FEEDER	CB
42	FEEDER	CB	42	FEEDER	CB

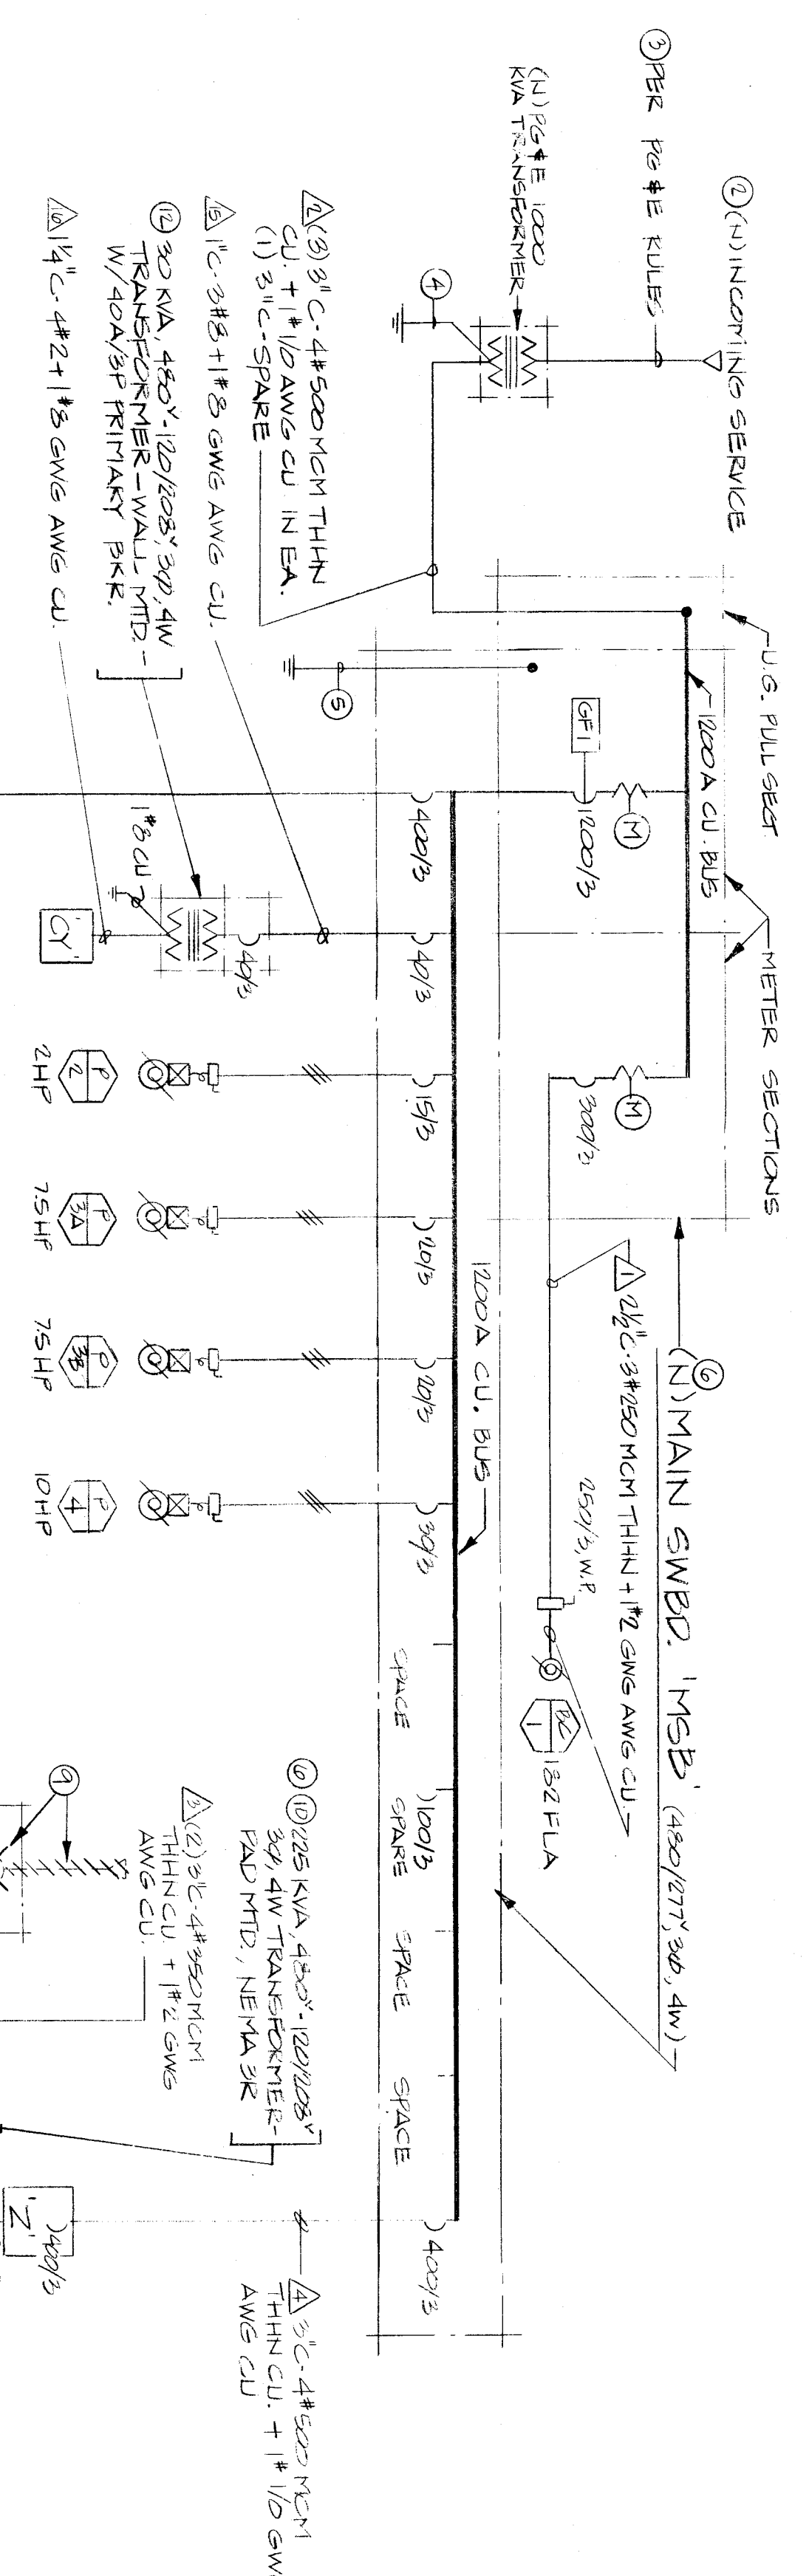


CHILLER YARD ELECTRICAL PLAN  
1/4" = 1'-0"

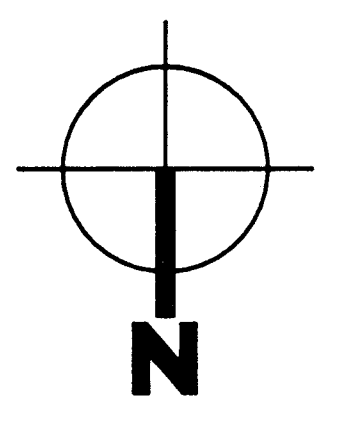

NOTES:

- SEE MECHANICAL PLANS FOR EXACT LOCATIONS OF MECHANICAL EQUIPMENT.
- CONTRACTOR TO DEFRAY ALL CHARGES FOR NEW P, G & E SERVICE.
- VERIFY CONDUIT SIZE WITH P, G & E PRIOR TO BID.
- GROUND P, G & E TRANSFORMER PER P, G & E RULES.
- COLD WATER PIPE GROUND PLUS UFER GROUND PER NEC ARTICLE 250.
- EXTERIOR ELECTRICAL EQUIPMENT TO BE RAINTIGHT, NEMA 3R.
- EXACT LOCATION OF PANEL, "P", AND SIZE AND LOCATION OF FEEDER TO PANEL "P" SHALL BE DETERMINED IN FIELD PRIOR TO BID.
- VERIFY EXACT LENGTH OF FEEDER PRIOR TO BID.
- EXISTING P, G & E SERVICE TO BE DISCONNECTED AND EXISTING METER BLANKED OFF AFTER NEW POWER IS CONNECTED AND FUNCTIONING.
- CONTRACTOR TO CONSTRUCT A CONCRETE PAD FOR NEW TRANSFORMER PER DETAIL 4/45.00.
- CONTRACTOR TO CONSTRUCT AN 8" (4" ABOVE GRADE, 4" BELOW GRADE) CONCRETE PAD FOR NEW SWITCHBOARD.
- NEW TRANSFORMER TO BE WALL MOUNTED TOP OF TRANSFORMER TO BE AT 6'-6".
- INSTALL NEW 100A/3P BREAKER IN EXISTING SPACE IN EXISTING SWITCHBOARD.
- INSTALL NEW PANELS AT BUILDING 100 - SEE EC-01.

ONE LINE DIAGRAM  
NO SCALE

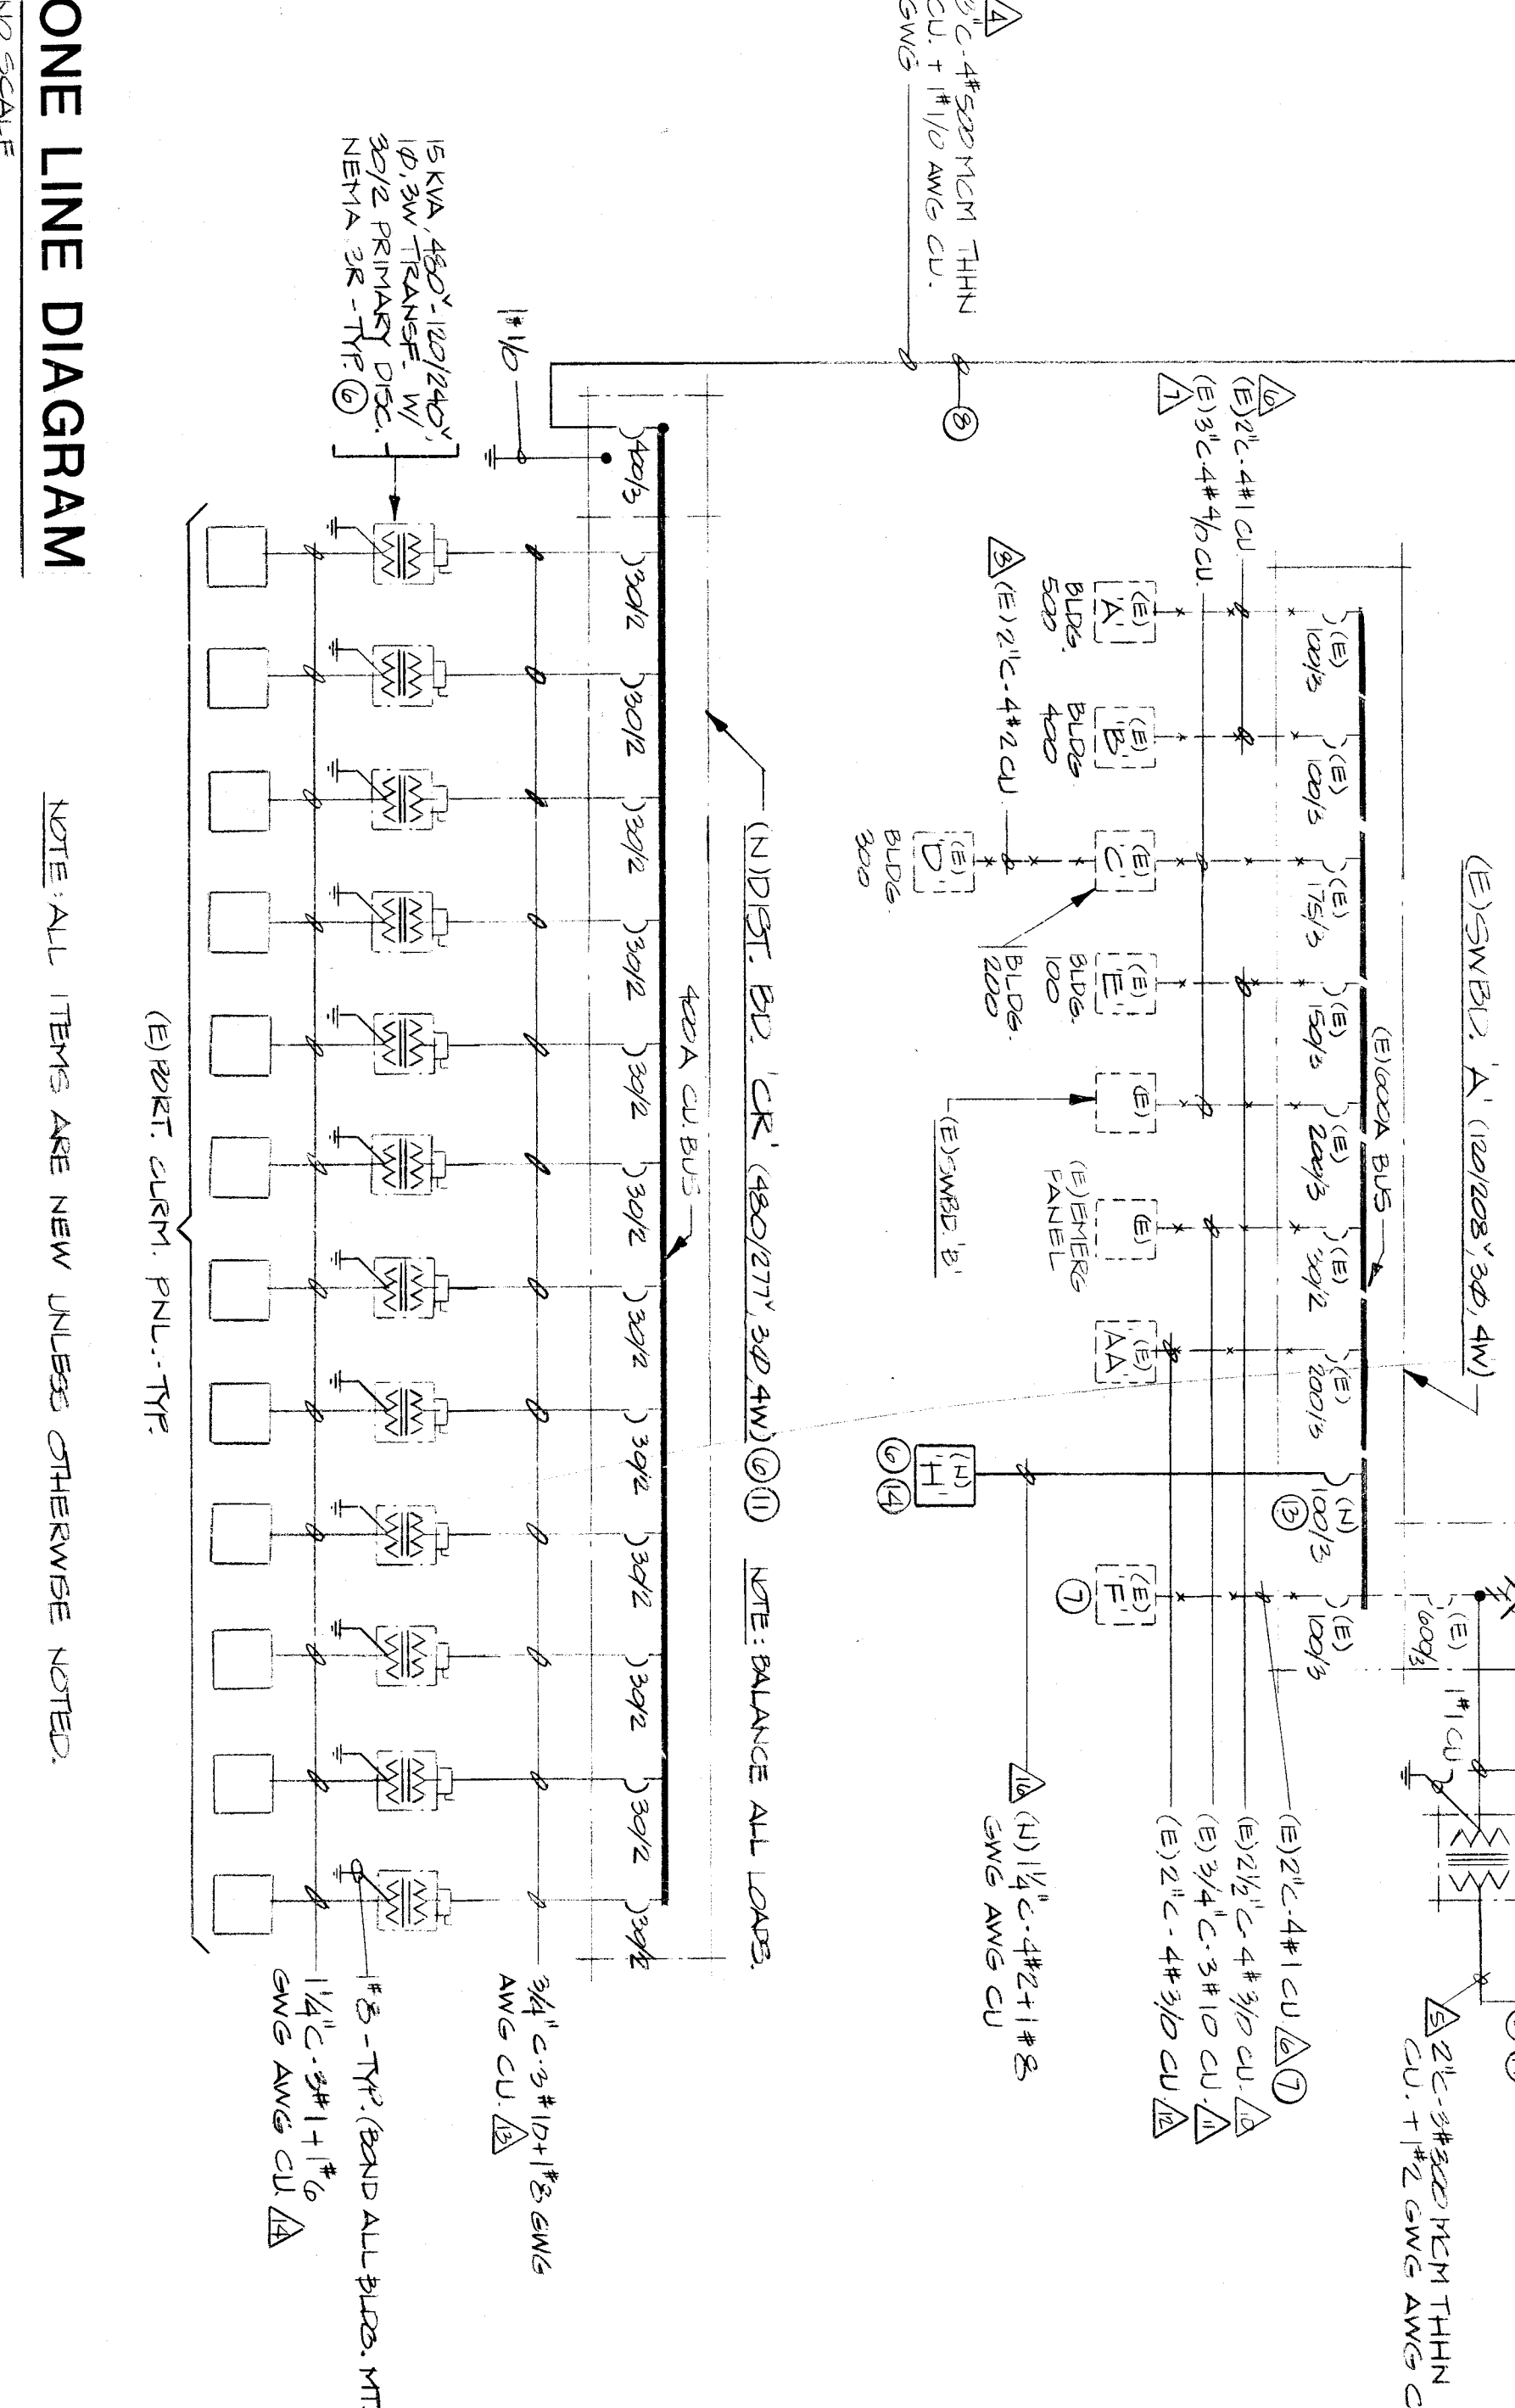

SYMBOL	DESCRIPTION	REMARKS
☐	FLUORESCENT FIXTURE	SEE PLAN & FIXTURE SCHEDULE
○	RECESSED FIXTURE	SEE PLAN & FIXTURE SCHEDULE
○	MALL BRACKET FIXTURE	SEE PLAN & FIXTURE SCHEDULE
○	EXIT LIGHT FIXTURE	SEE PLAN & FIXTURE SCHEDULE
○	PORCELAIN RECEPTACLE	SEE PLAN & FIXTURE SCHEDULE
○	LOCAL SWITCH MTD. @ 48" MAX.	20 A - AC QUIET 277V
○	3-WAY SWITCH MTD. @ 48" MAX.	20 A - AC QUIET 277V
○	SWITCH WITH PILOT LITE	NEON IN HANDLE MTD. @ 48" MAX.
○	FIXTURE TO LOCAL SWITCH	SEE FIXTURE SCHEDULE
○	FIXTURE TYPE AND MATTAGE	REFER TO MECHANICAL DRAWINGS
○	DEMOTES MECHANICAL EQUIP.	20 A NEMA GROUNDED MTD. @ 12" MIN.
○	DUPLEX CONVENIENCE OUTLET	20 A NEMA GROUNDED MTD. @ 12" MIN.
○	FOURPLEX CONV. OUTLET	45 BOX & FLUSH PLATE MIN.
○	J-BOX AS REQUIRED	AS REQUIRED, MINIMUM 1" CONDUIT
○	TELEPHONE OUTLET	
○	DEMOTES EXISTING ITEM	
○	DEMOTES NEW ITEM	
○	(N) SIGNAL RACEWAY	UNLESS OTHERWISE NOTED
○	(N) WIRING IN CEILING	UNLESS OTHERWISE NOTED
○	(N) WIRING IN FLOOR OR WALL	UNLESS OTHERWISE NOTED
○	LTR. WIRING @ 4' OUTLET MTS.	SEE DETAIL 3/7E-100
○	SWITCHBACK	SEE DETAIL
○	MOTION DETECTOR	SEE DETAIL
○	PHOTOCELL	SEE DETAIL
○	SURFACE MTD. METAL RACEWAY	SEE PLANS & REF. NOTES
○	(E) WIRING	
○	(E) LIGHTING OUTLET	
○	(E) LIGHT SWITCH	
○	(E) DUPLEX OUTLET	
○	(E) THERMOSTAT	
○	DISCONNECT SWITCH	REFER TO MECHANICAL DRAWINGS
○	ELECTRICAL PANEL	REFER TO PANEL SCHEDULE
○	TERMINAL CABINET	
○	GROUND FAULT INTERRUPTING	
○	WEATHERPROOF	
○	FIRE ALARM FLASHING LITE	PACKAGED #55916 CEM # 7155-055101
○	HORN AND FLASHING LITE	PACKAGED #61010/0510 CEM # 7155-055101
○	IONIZATION SMOKE DETECTOR	PACKAGED #94420 CEM # 7267-055110
○	HEAT DETECTOR, FIXED TEMP. IN ATTIC	PACKAGED #93488 CEM # 7210-055115
○	HEAT DETECTOR, FIXED TEMP. IN ATTIC	PACKAGED #7150-0551104 CEM # 7150-0551104
○	MANUAL PULL STATION	
○	ZONE NUMBER - DEVICE NUMBER	
○	END OF LINE DEVICE	
○	HEAT DETECTOR, FIXED TEMP.	
○	FIRE ALARM CONTROL PANEL	PACKAGED #11948 CEM # 7155-055101
○	CLOCK	PACKAGED #11948 CEM # 7155-055101
○	CLOCK MTD. #34"	CONNECT TO (N) MTR. CLK
○	CLOCK MTR.	PACKAGED #2311E/18205 PACKAGED #14201/14202 PACKAGED #4454-AC
○	CLK BELL MTD. #34"	

LOAD SUMMARY	AMPS
PANELS:	
A	23.0 KM
B	285.0 KM
C (INCLUDES "D")	39.0 KM
E	37.0 KM
F	13.0 KM
AA	50.0 KM
EXISTING SWITCHBOARD "B"	50.0 KM
EXISTING EMERGENCY PANEL	5.0 KM
H	25.0 KM
CHL:	18.0 KM
PORTABLE CLASSROOMS: 12K X 12	144.0 KM
PUMPS:	
P-2 (2 HP)	2.0 KM
P-3A (7.5 HP)	6.0 KM
P-3B (7.5 HP)	6.0 KM
P-4 (10 HP)	10.0 KM
CHILLER: 182 FLA	121.0 KM
SUBTOTAL	998.0 KM
+121 KW LARGEST MOTOR	121.0 KM
TOTAL	1119.0 KM
* 959 AMPS AT 480/277V, 3Ø, 4W	

FOR  
ROOSEVELT  
SCHOOL  
MODERNIZATION

BAKERSFIELD CITY SCHOOL  
DISTRICT

DR. ORTEGA

big architects planners inc.  
8400 99th Boulevard California 93309-9908  
(805) 832 8122

Job no. 08-142  
date 20 JAN 1998  
drawn by RCW  
chk'd by CE  
copyright 1998

0.00