


2 BLDG C - YARD NORTH
SCALE: 1" = 20'

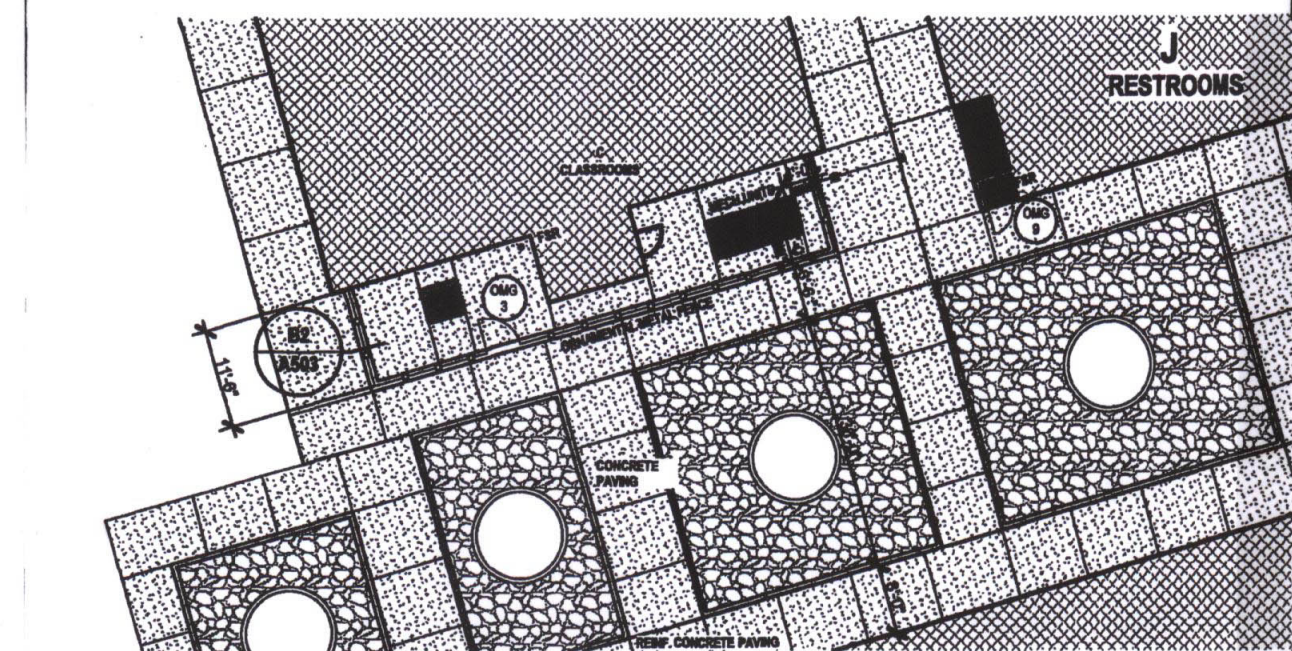

1 BLDG C - YARD SOUTH
SCALE: 1" = 20'

REFER TO ARCHITECTURAL SHEET A-113
ARCHITECTS SUPPLEMENTAL INSTRUCTION

BLDG-C MECH YARDS

ORDIZ MELBY ARCHITECTS INC.


NEW MIDDLE / ELEMENTARY SCHOOL FOR
BAKERSFIELD CITY SCHOOL DISTRICT
1300 BAKER STREET
BAKERSFIELD CALIFORNIA 93305

ASI 21.1

JOB NUMBER 2009-1212
DATE MAY 21, 2013
FILE # 154
PERMITS 154

APPROVED ARCHITECT
No. C-14728
MAY 21, 2013
STATE OF CALIFORNIA

DATE 05/21/13

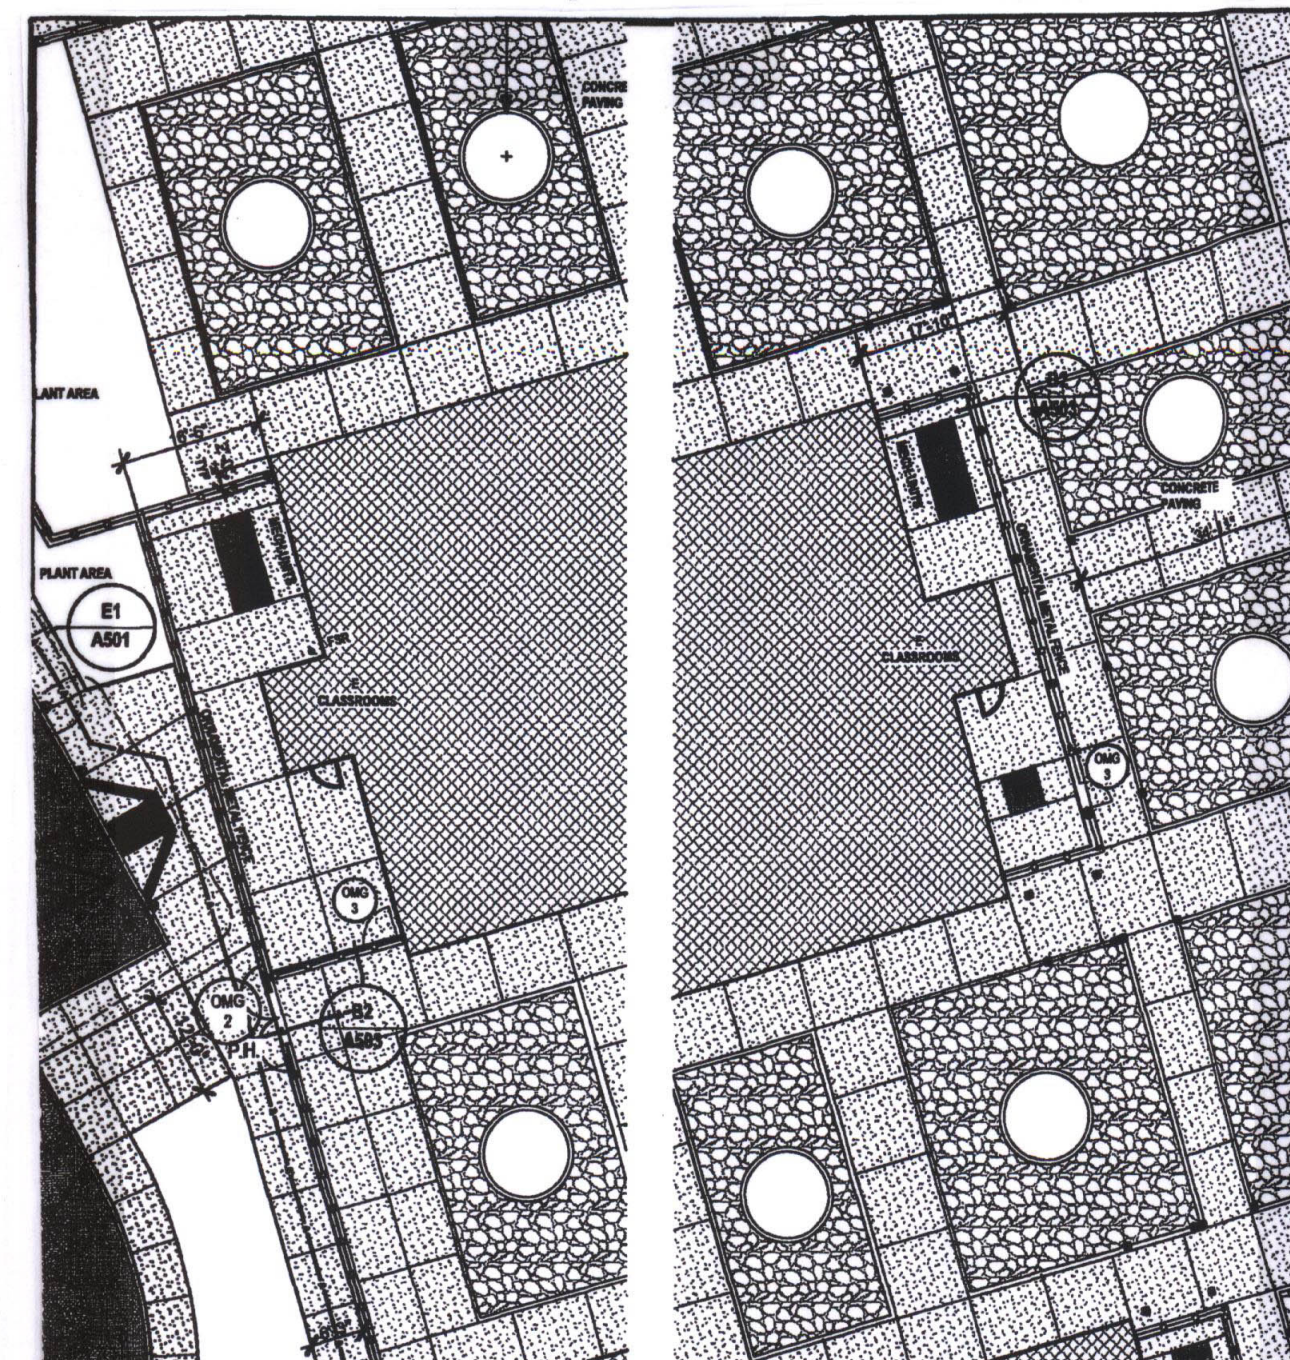

2 BLDG E - YARD WEST
SCALE: 1" = 20'

1 BLDG E - YARD EAST
SCALE: 1" = 20'

REFER TO ARCHITECTURAL SHEETS A-113 & A-114
ARCHITECTS SUPPLEMENTAL INSTRUCTION

BLDG-E MECH YARDS

ORDIZ MELBY ARCHITECTS INC.


NEW MIDDLE / ELEMENTARY SCHOOL FOR
BAKERSFIELD CITY SCHOOL DISTRICT
1300 BAKER STREET
BAKERSFIELD CALIFORNIA 93305

ASI 21.3

JOB NUMBER 2009-1212
DATE MAY 21, 2013
FILE # 154
PERMITS 154

APPROVED ARCHITECT
No. C-14728
MAY 21, 2013
STATE OF CALIFORNIA

DATE 05/21/13

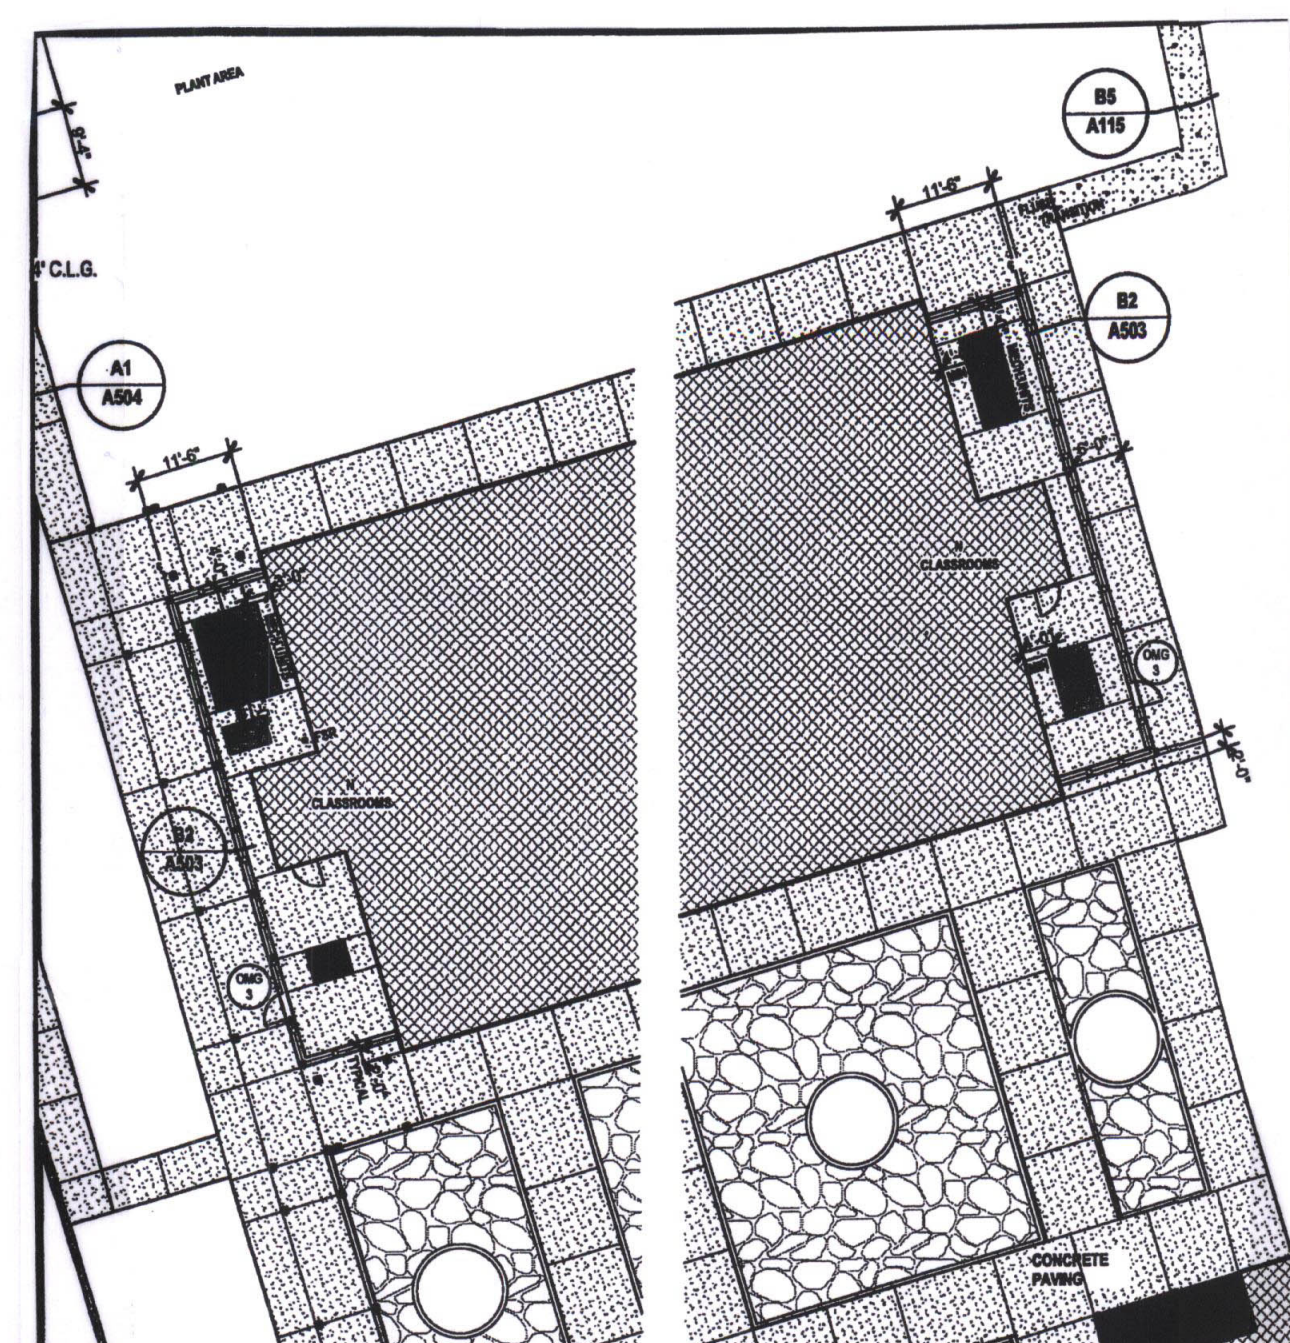

2 BLDG N - YARD WEST
SCALE: 1" = 20'

1 BLDG N - YARD EAST
SCALE: 1" = 20'

REFER TO ARCHITECTURAL SHEETS A-112
ARCHITECTS SUPPLEMENTAL INSTRUCTION

BLDG-N MECH YARD

ORDIZ MELBY ARCHITECTS INC.


NEW MIDDLE / ELEMENTARY SCHOOL FOR
BAKERSFIELD CITY SCHOOL DISTRICT
1300 BAKER STREET
BAKERSFIELD CALIFORNIA 93305

ASI 21.7

JOB NUMBER 2009-1212
DATE MAY 21, 2013
FILE # 154
PERMITS 154

APPROVED ARCHITECT
No. C-14728
MAY 21, 2013
STATE OF CALIFORNIA

DATE 05/21/13

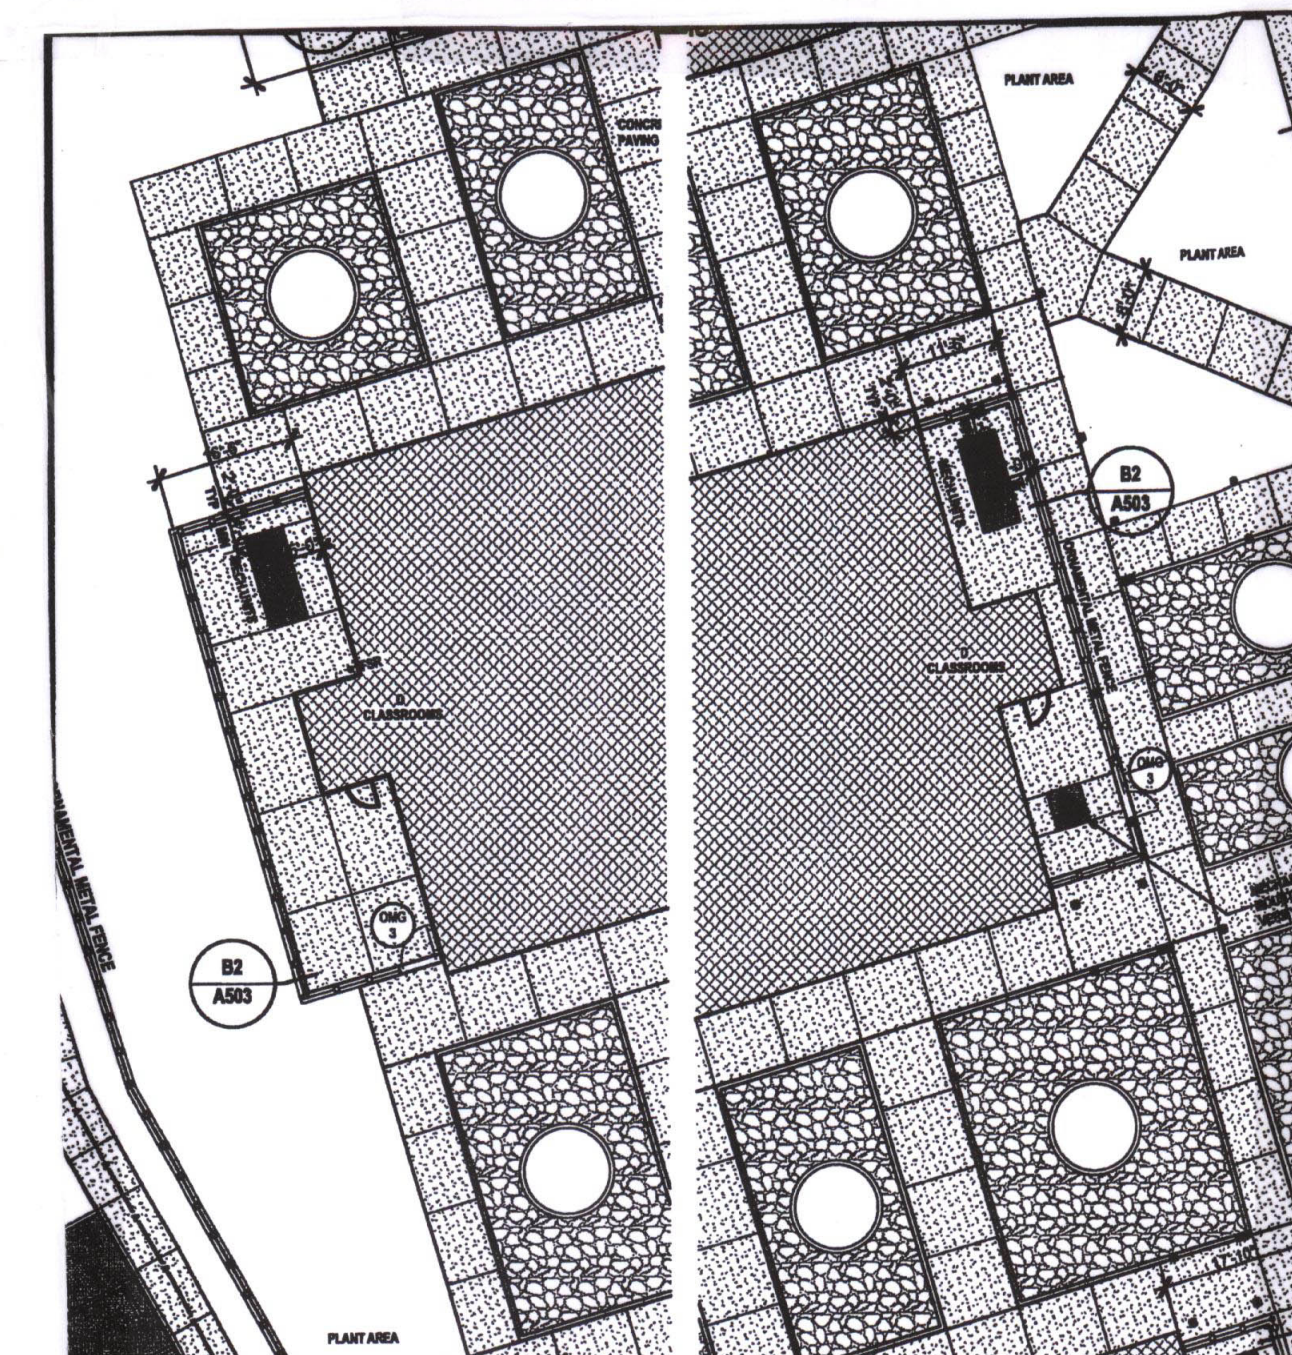

2 BLDG D - YARD WEST
SCALE: 1" = 20'

1 BLDG D - YARD EAST
SCALE: 1" = 20'

REFER TO ARCHITECTURAL SHEET A-113
ARCHITECTS SUPPLEMENTAL INSTRUCTION

BLDG-D MECH YARDS

ORDIZ MELBY ARCHITECTS INC.


NEW MIDDLE / ELEMENTARY SCHOOL FOR
BAKERSFIELD CITY SCHOOL DISTRICT
1300 BAKER STREET
BAKERSFIELD CALIFORNIA 93305

ASI 21.2

JOB NUMBER 2009-1212
DATE MAY 21, 2013
FILE # 154
PERMITS 154

APPROVED ARCHITECT
No. C-14728
MAY 21, 2013
STATE OF CALIFORNIA

DATE 05/21/13

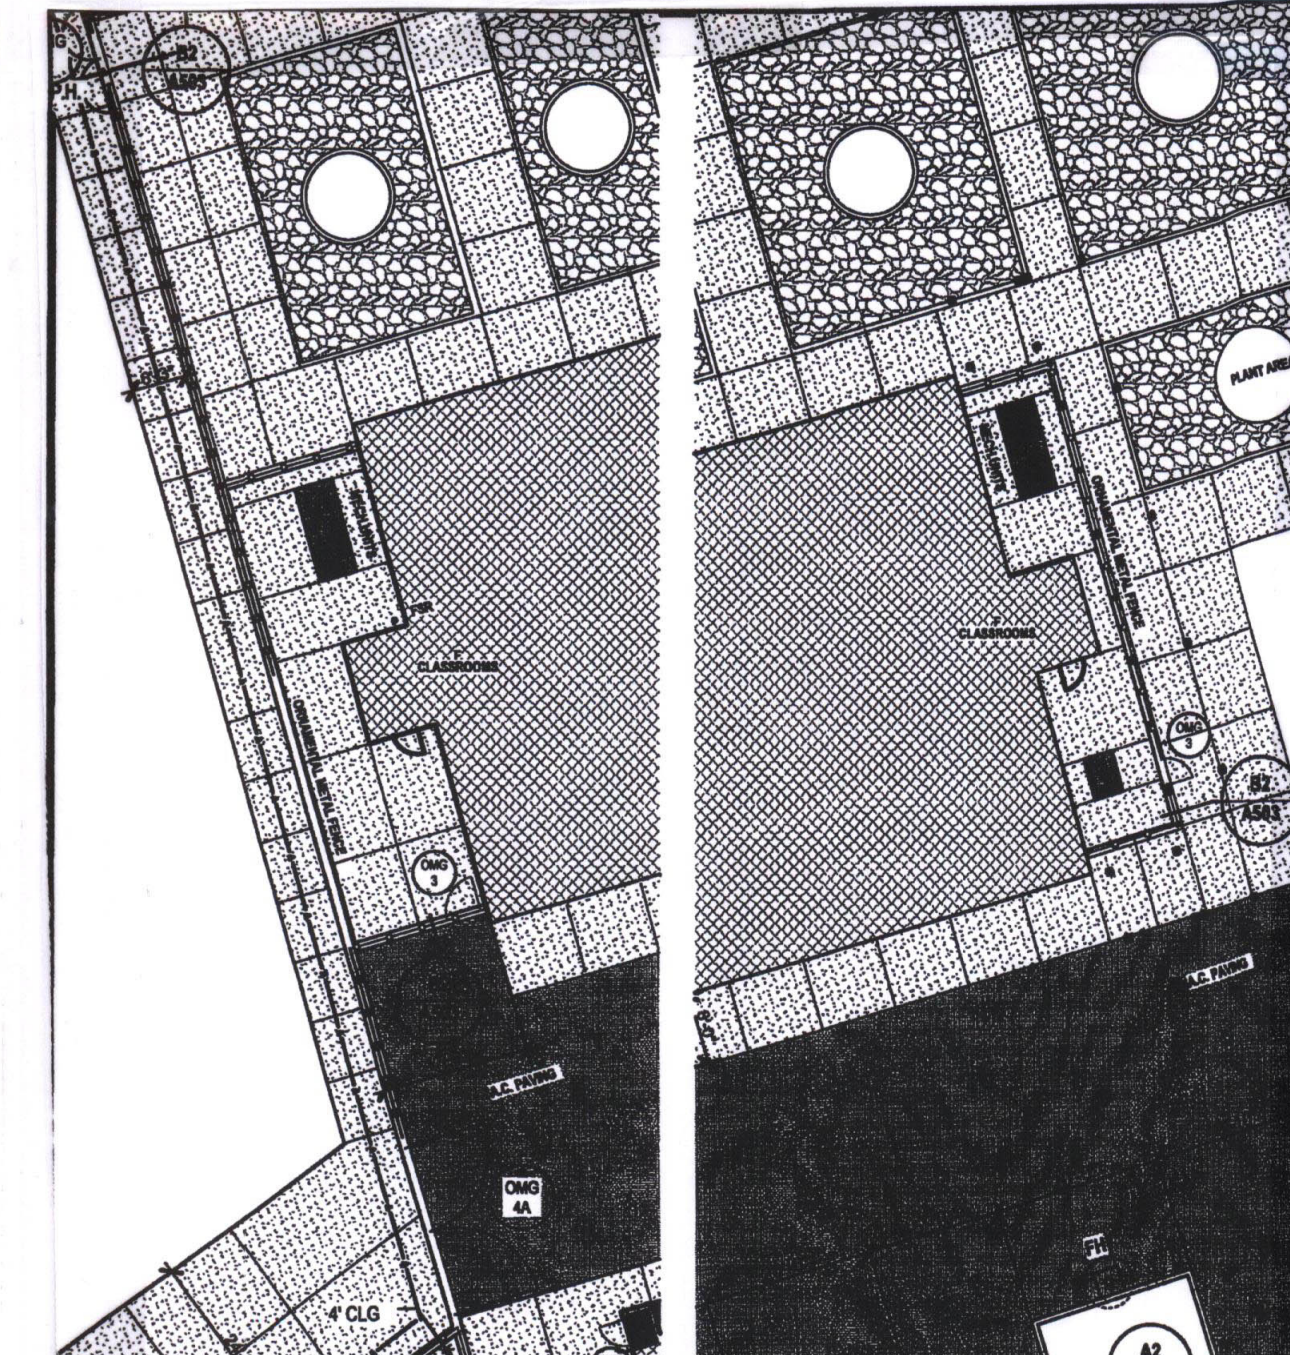

2 BLDG F - YARD WEST
SCALE: 1" = 20'

1 BLDG F - YARD EAST
SCALE: 1" = 20'

REFER TO ARCHITECTURAL SHEETS A-114
ARCHITECTS SUPPLEMENTAL INSTRUCTION

BLDG-F MECH YARDS

ORDIZ MELBY ARCHITECTS INC.


NEW MIDDLE / ELEMENTARY SCHOOL FOR
BAKERSFIELD CITY SCHOOL DISTRICT
1300 BAKER STREET
BAKERSFIELD CALIFORNIA 93305

ASI 21.4

JOB NUMBER 2009-1212
DATE MAY 21, 2013
FILE # 154
PERMITS 154

APPROVED ARCHITECT
No. C-14728
MAY 21, 2013
STATE OF CALIFORNIA

DATE 05/21/13

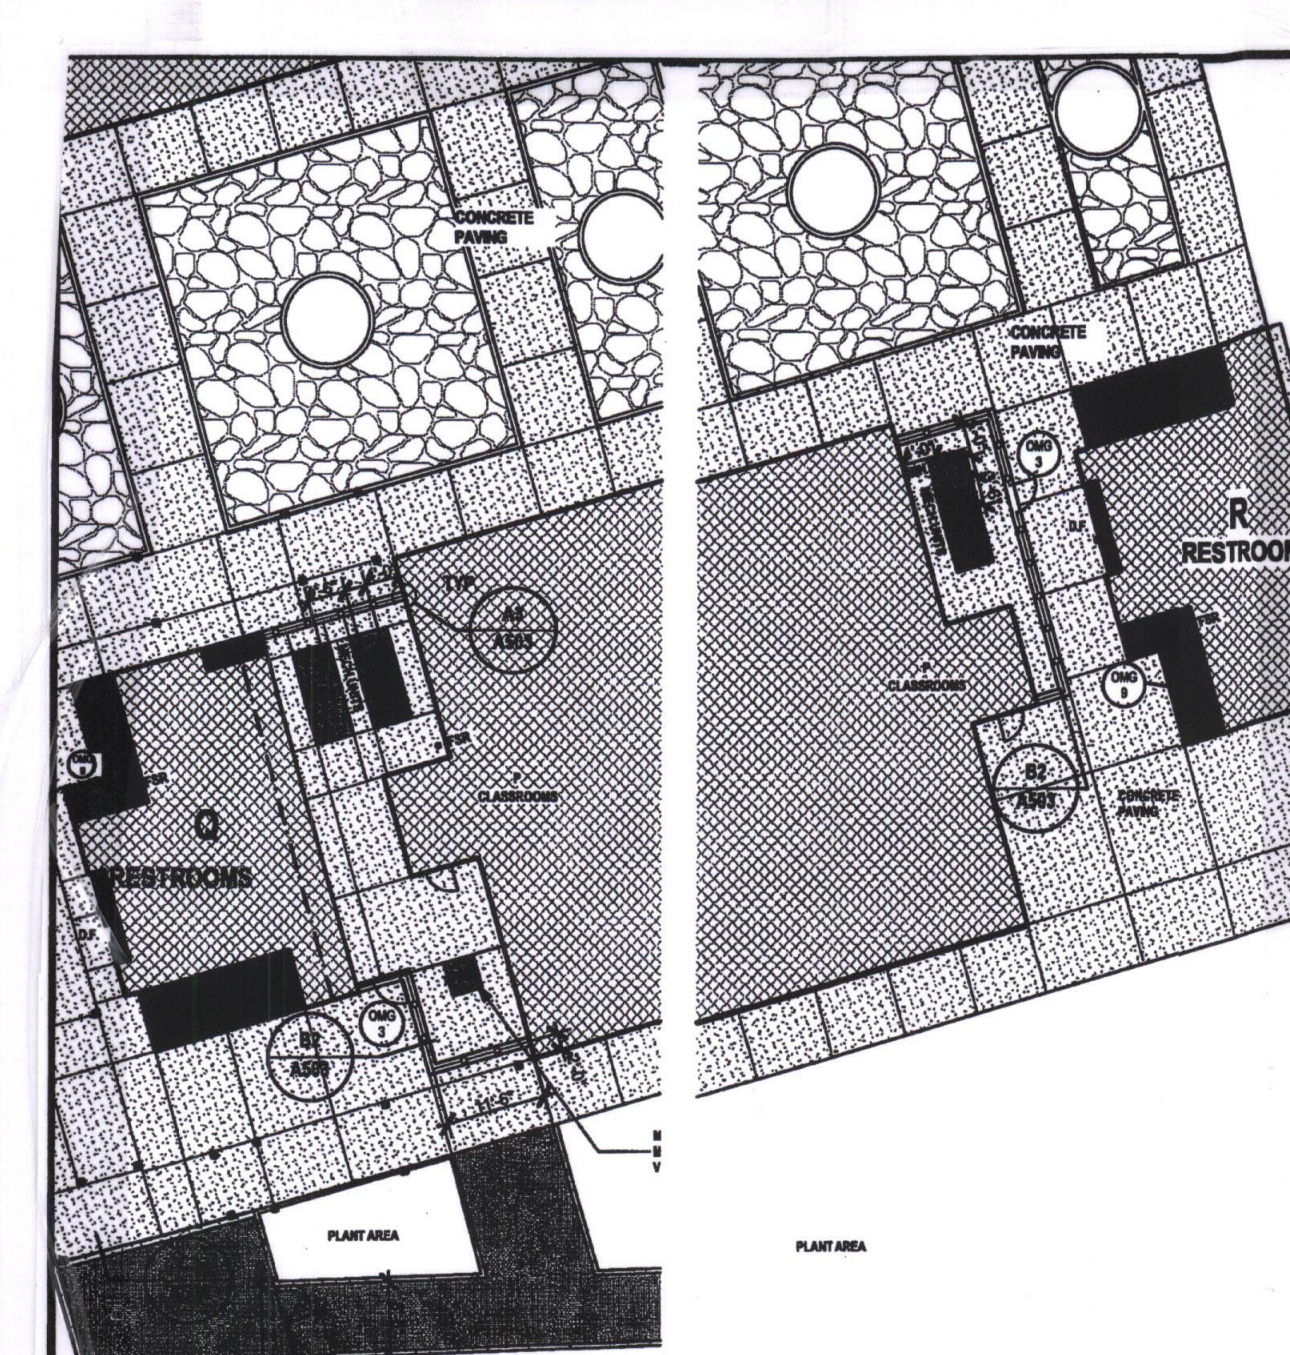

2 BLDG P - YARD WEST
SCALE: 1" = 20'

1 BLDG P - YARD EAST
SCALE: 1" = 20'

REFER TO ARCHITECTURAL SHEETS A-112
ARCHITECTS SUPPLEMENTAL INSTRUCTION

BLDG-P MECH YARD

ORDIZ MELBY ARCHITECTS INC.


NEW MIDDLE / ELEMENTARY SCHOOL FOR
BAKERSFIELD CITY SCHOOL DISTRICT
1300 BAKER STREET
BAKERSFIELD CALIFORNIA 93305

ASI 21.8


JOB NUMBER 2009-1212
DATE MAY 21, 2013
FILE # 154
PERMITS 154

APPROVED ARCHITECT
No. C-14728
MAY 21, 2013
STATE OF CALIFORNIA

DATE 05/21/13

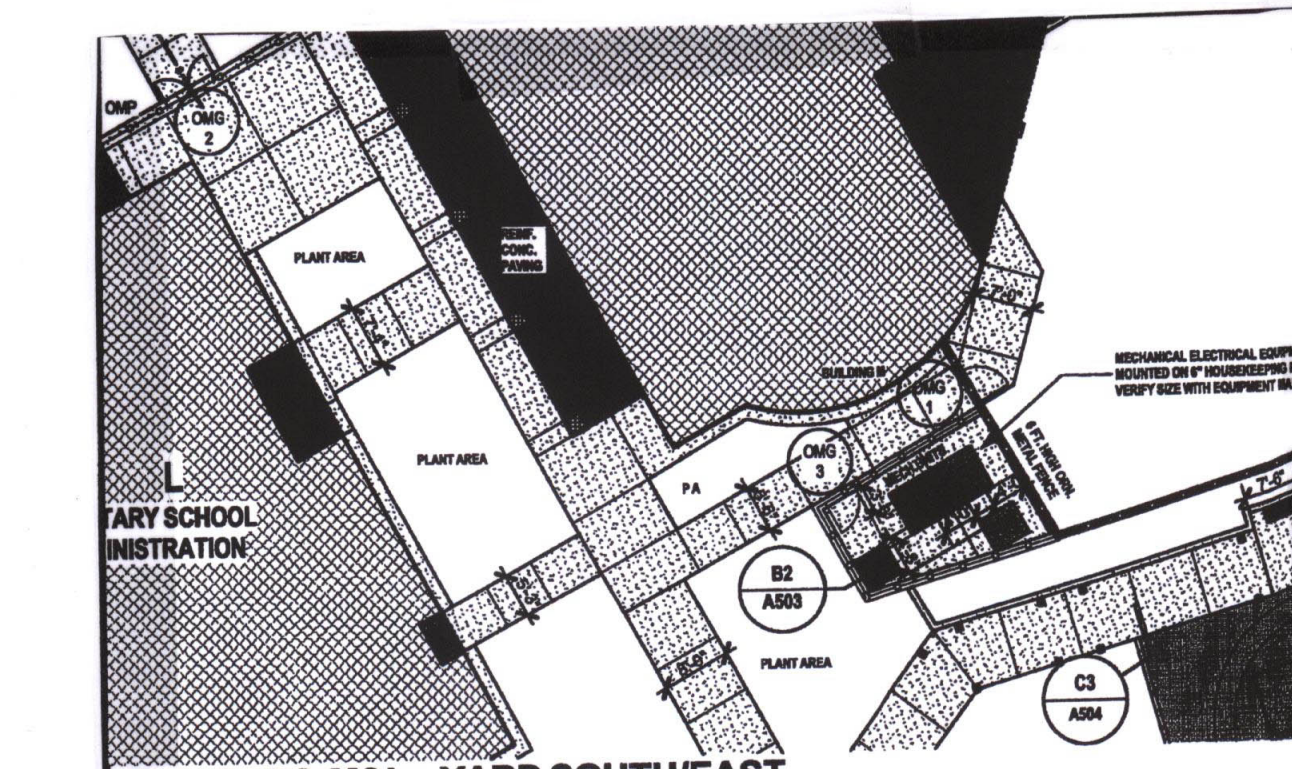

2 BLDG M&L - YARD SOUTH/EAST
SCALE: 1" = 20'

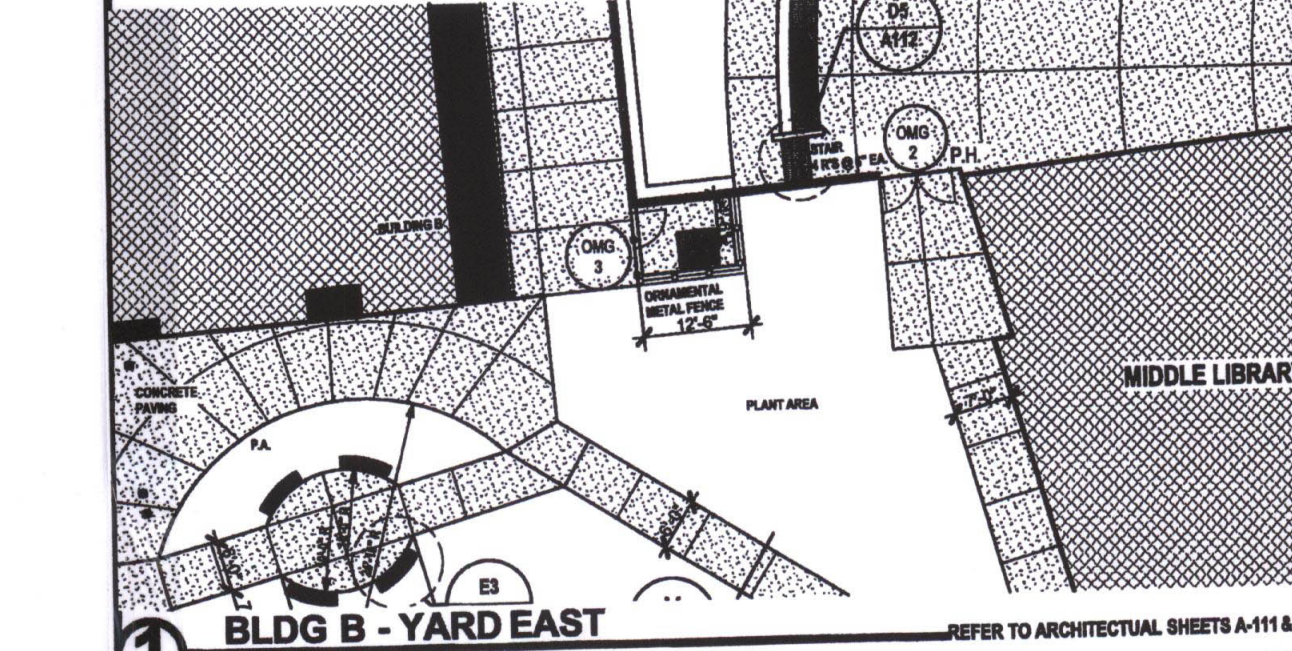

1 BLDG B - YARD EAST
SCALE: 1" = 20'

REFER TO ARCHITECTURAL SHEETS A-113 & A-115
ARCHITECTS SUPPLEMENTAL INSTRUCTION

BLDGS-B & L/M MECH YARDS

ORDIZ MELBY ARCHITECTS INC.


NEW MIDDLE / ELEMENTARY SCHOOL FOR
BAKERSFIELD CITY SCHOOL DISTRICT
1300 BAKER STREET
BAKERSFIELD CALIFORNIA 93305

ASI 21.6


JOB NUMBER 2009-1212
DATE MAY 21, 2013
FILE # 154
PERMITS 154

APPROVED ARCHITECT
No. C-14728
MAY 21, 2013
STATE OF CALIFORNIA

DATE 05/21/13

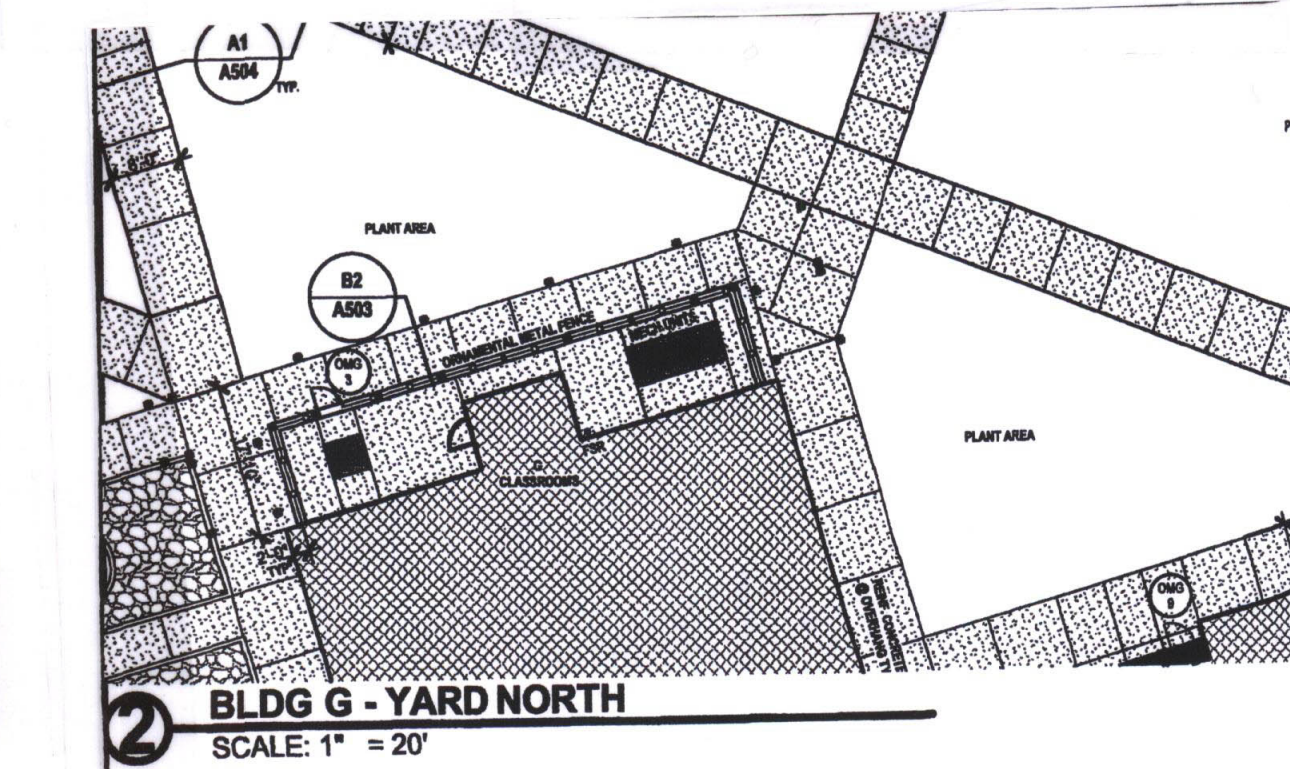

2 BLDG G - YARD NORTH
SCALE: 1" = 20'

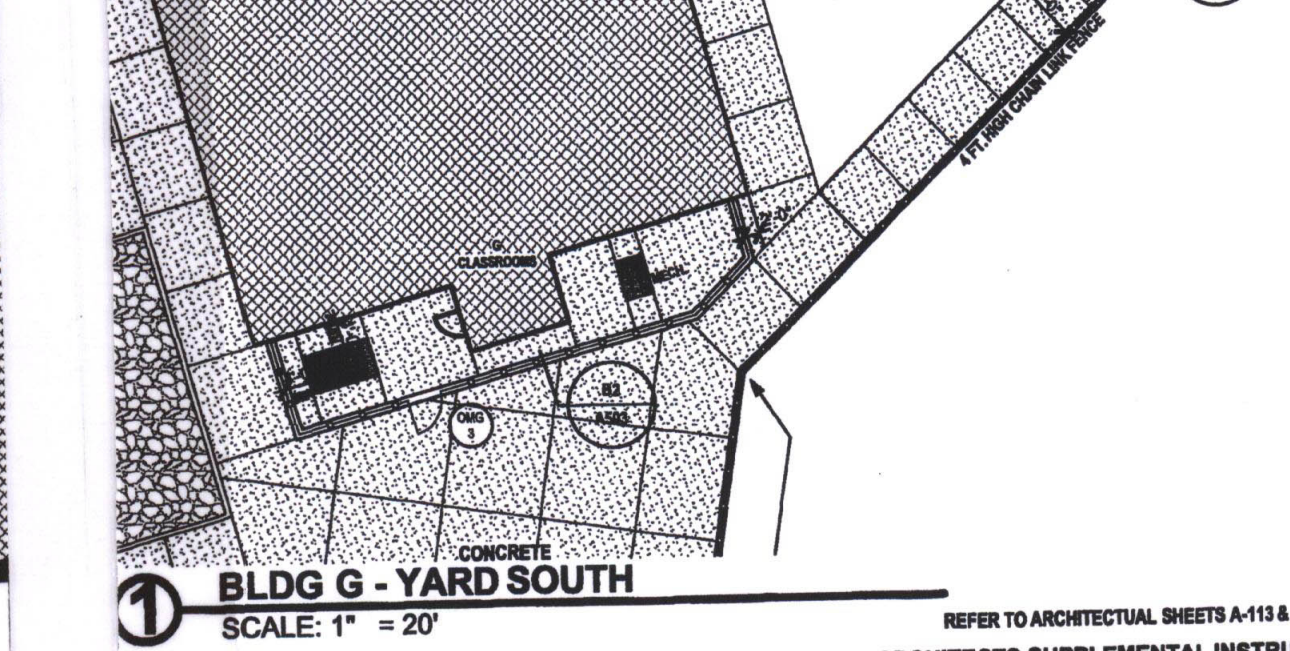

1 BLDG G - YARD SOUTH
SCALE: 1" = 20'

REFER TO ARCHITECTURAL SHEETS A-113 & A-115
ARCHITECTS SUPPLEMENTAL INSTRUCTION

BLDG-G MECH YARDS

ORDIZ MELBY ARCHITECTS INC.


NEW MIDDLE / ELEMENTARY SCHOOL FOR
BAKERSFIELD CITY SCHOOL DISTRICT
1300 BAKER STREET
BAKERSFIELD CALIFORNIA 93305

ASI 21.5

JOB NUMBER 2009-1212
DATE MAY 21, 2013
FILE # 154
PERMITS 154

APPROVED ARCHITECT
No. C-14728
MAY 21, 2013
STATE OF CALIFORNIA

DATE 05/21/13

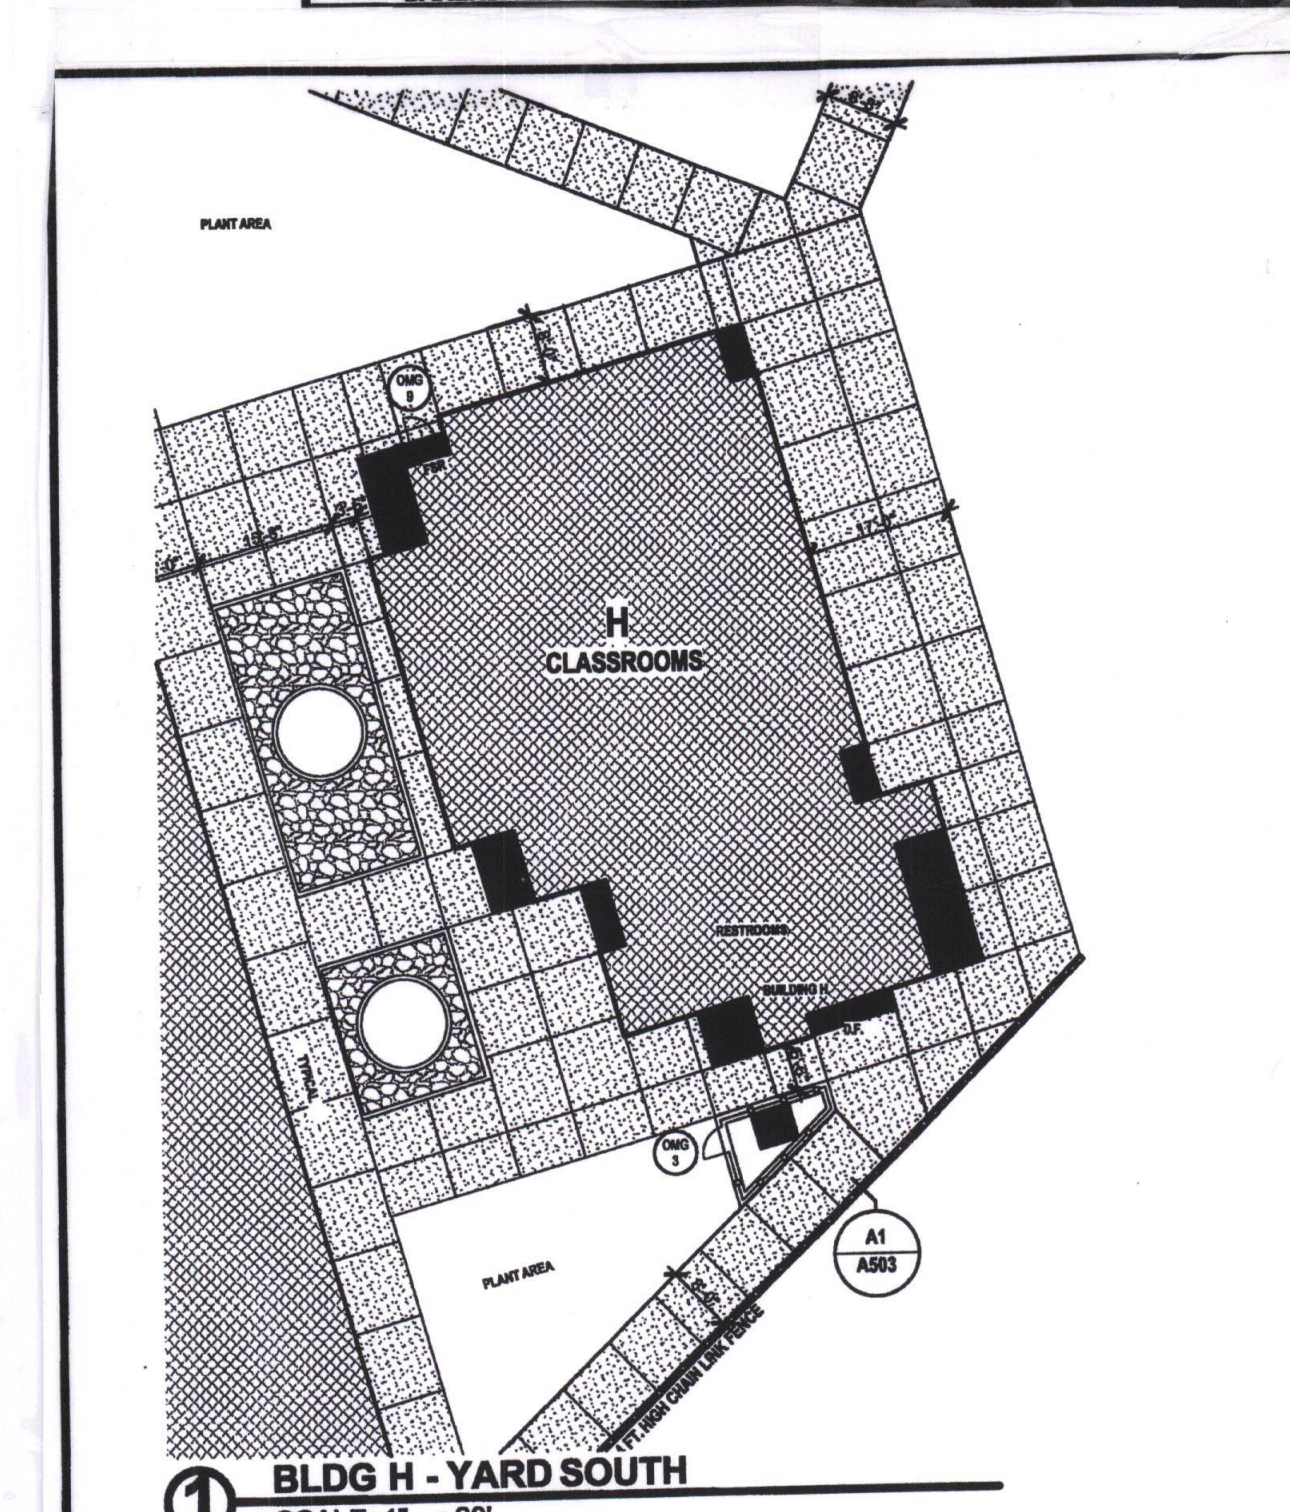

1 BLDG H - YARD SOUTH
SCALE: 1" = 20'

REFER TO ARCHITECTURAL SHEETS A-111
ARCHITECTS SUPPLEMENTAL INSTRUCTION

BLDG-H MECH YARD

ORDIZ MELBY ARCHITECTS INC.

NEW MIDDLE / ELEMENTARY SCHOOL FOR
BAKERSFIELD CITY SCHOOL DISTRICT
1300 BAKER STREET
BAKERSFIELD CALIFORNIA 93305

ASI 21.9

JOB NUMBER 2009-1212
DATE MAY 21, 2013
FILE # 154
PERMITS 154

APPROVED ARCHITECT
No. C-14728
MAY 21, 2013
STATE OF CALIFORNIA

DATE 05/21/13

Item #1 Refer to Architectural Drawings Sheet A-111 through A-117; Mechanical Drawings Sheet M-121 CEF, D, G, M, N, & P; Electrical Drawings Sheets E-111, E-122C, D, E, F, G, M, N, P;
A. Clarification: Provide arrangement of Electrical Transformers and HVAC Condensing Units in Utility Yards per Drawings ASI 21.1 through ASI 21.9 as attached.