


ORDIZ MELBY
ARCHITECTS, INC.

5500 MING AVENUE SUITE 280
BAKERSFIELD, CALIFORNIA 93309
TELEPHONE (861) 832-6258
FACSIMILE (861) 832-4291



DANNY E. ORDIZ, AIA
ARCHITECT C-14,728
WILLIAM J. MELBY, AIA
ARCHITECT C-16,835


CONSULTANT

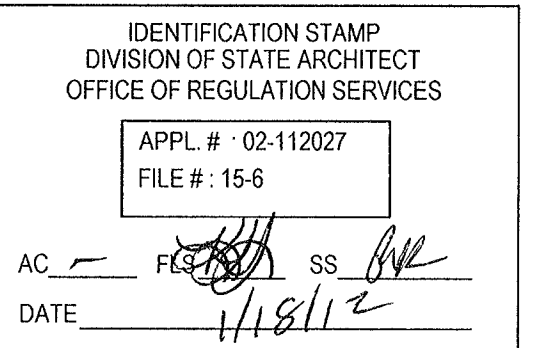

NEW ELEMENTARY SCHOOL
9801 HIGHLAND KNOLLS DR
BAKERSFIELD
CALIFORNIA
93305

NEW MIDDLE SCHOOL
4115 VINELAND ROAD
BAKERSFIELD
CALIFORNIA
93305

FOR:
BAKERSFIELD CITY SCHOOL
DISTRICT
1300 BAKER STREET
BAKERSFIELD
CALIFORNIA
93305

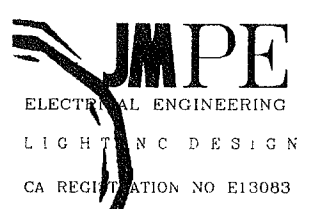

JMPE
ELECTRICAL ENGINEERING
1100 W. MING AVENUE
SUITE 280
BAKERSFIELD, CA 93309
861-832-7811
FAX 861-831-7812
www.jmpe.com



MARK DATE DESCRIPTION

△		
△		
△		
△		

20101244
CAD DRAWING FILE:

DRAWN BY:
AC
CHECKED BY:
PH

CHECK AND VERIFY ALL DIMENSIONS BEFORE
PROCEEDING WITH THE WORK.
REPORT DISCREPANCIES TO THE ARCHITECT.

THE DRAWINGS, IDEAS AND DESIGNS
REPRESENTED ON THIS SHEET ARE THE
PROPERTY OF THE ARCHITECT.

COPYRIGHT
ORDIZ-MELBY ARCHITECTS, INC. 2010

SHEET TITLE

**FIRE ALARM
SITE PLAN**


SHEET IDENTIFICATION NUMBER

E-113

SHEET OF



FIRE ALARM SITE PLAN

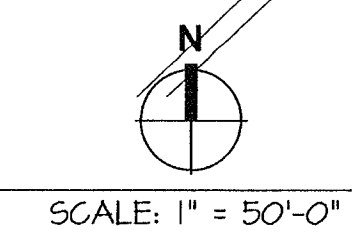

CABLE LEGEND	
D	WESTPENN AQ294 (SLC)
E	WESTPENN AQ294 (SPEAKER)
F	WESTPENN AQC432 (MICROPHONE)
G	(2)#12 THWN (STROBE)

JMPE\JOB\10244\DATE\12-08-11 AC