


CONSULTANT

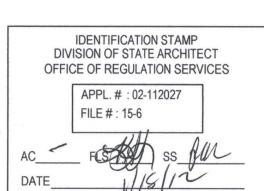


NEW ELEMENTARY SCHOOL CALIFORNIA

> **NEW MIDDLE SCHOOL** BAKERSFIELD **CALIFORNIA**

DISTRICT

CALIFORNIA 93305

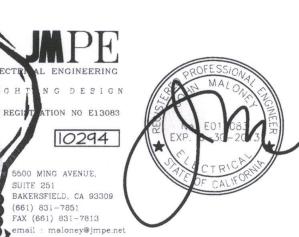

CAD DRAWING FILE:

CHECKED BY: CHECK AND VERIFY ALL DIMENSIONS BEFORE PROCEEDING WITH THE WORK.

REPORT DESCREPANCIES TO THE ARCHITECT. THE DRAWINGS, IDEAS, AND DESIGNS REPRESENTED ON THIS SHEET ARE THE PROPERTY OF THE ARCHITECT.

COPYRIGHT ORDIZ-MELBY ARCHITECTS, INC. 2010

SHEET TITLE

LIGHTING SITE PLAN

SHEET IDENTIFICATION NUMBER