

NEW ELEMENTARY SCHOOL
 9801 HIGHLAND KNOLLS DR
 BAKERSFIELD CALIFORNIA 93306


NEW MIDDLE SCHOOL
 4115 VINELAND ROAD
 BAKERSFIELD CALIFORNIA 93306

FOR:
BAKERSFIELD CITY SCHOOL DISTRICT
 1300 BAKER STREET
 BAKERSFIELD CALIFORNIA 93305

CONNECT DUCT TO ANGLE RING w/ #8 SOCKET DRIVE BUTTON HEAD SCREW, POLISHED STAINLESS STEEL w/ POLISHED STAINLESS STEEL WASHERS, TYP-12.

POLISHED STAINLESS STEEL ANGLE RING.

SECURE TO END OF WALL WITH 1/4"x3/4" STAINLESS STEEL TAP CON SCREWS, WITH POLISHED STAINLESS STEEL WASHERS TO COVER 5/8"x1/16" OVAL SCREW OPENING, TYP-12.

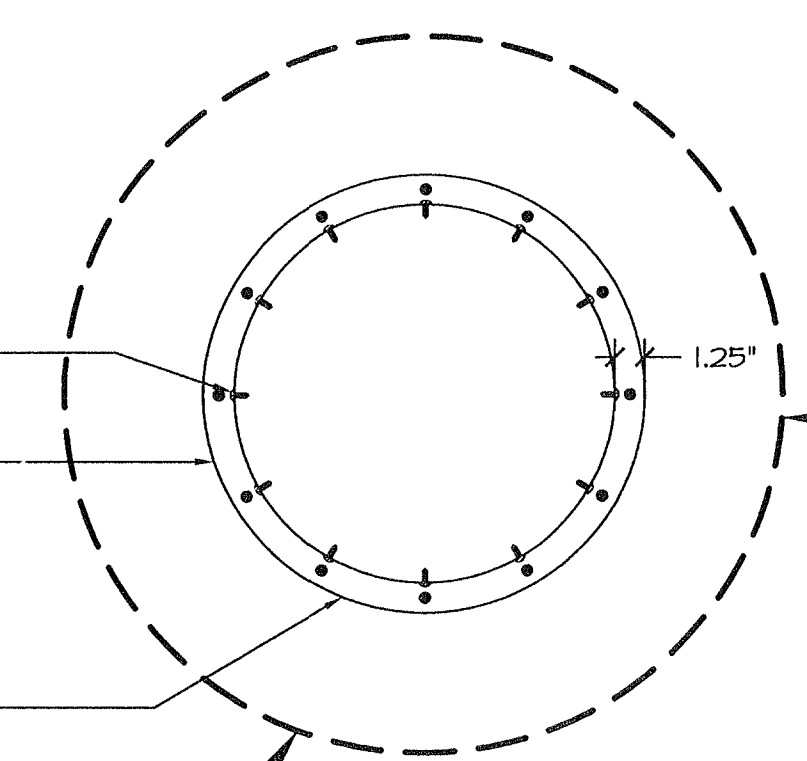

28"x20" SUPPLY DUCT THRU WALL w/ 2" ACOUSTICAL LINER, TYPICAL.

TITUS 9552RL 22"x22" ZERO DEFLECTION RETURN GRILLE ON EA. SIDE OF RETURN TEE.



28"x20" RETURN DUCT THRU WALL w/ 2" ACOUSTICAL LINER, TYPICAL.

TEE FITTING w/ 20"x20" DUCT EA. WAY, TYPICAL.


ETCH PRIME COAT & PAINT w/ TWO COATS DUCTWORK AND HANGERS, COLOR AS DIRECTED BY ARCHITECT. PAINT ALL VISIBLE SURFACES BEHIND GRILLES FLAT BLACK.

D5-1 SPIRAL MOUNTED SUPPLY GRILLE, 36"x12", 1820 GPM, TYPICAL OF FOUR PER AC SYSTEM SERVING GYM, LOCATED AT 30' OFF OF HORIZONTAL. CLEAR ANODIZE FINISH.


NOTE: EXPOSED DUCTS TO BE HIGHEST QUALITY IN TERMS OF APPEARANCE. NO DENTS, DINGS, OR OTHER IMPERFECTIONS WILL BE ACCEPTED.

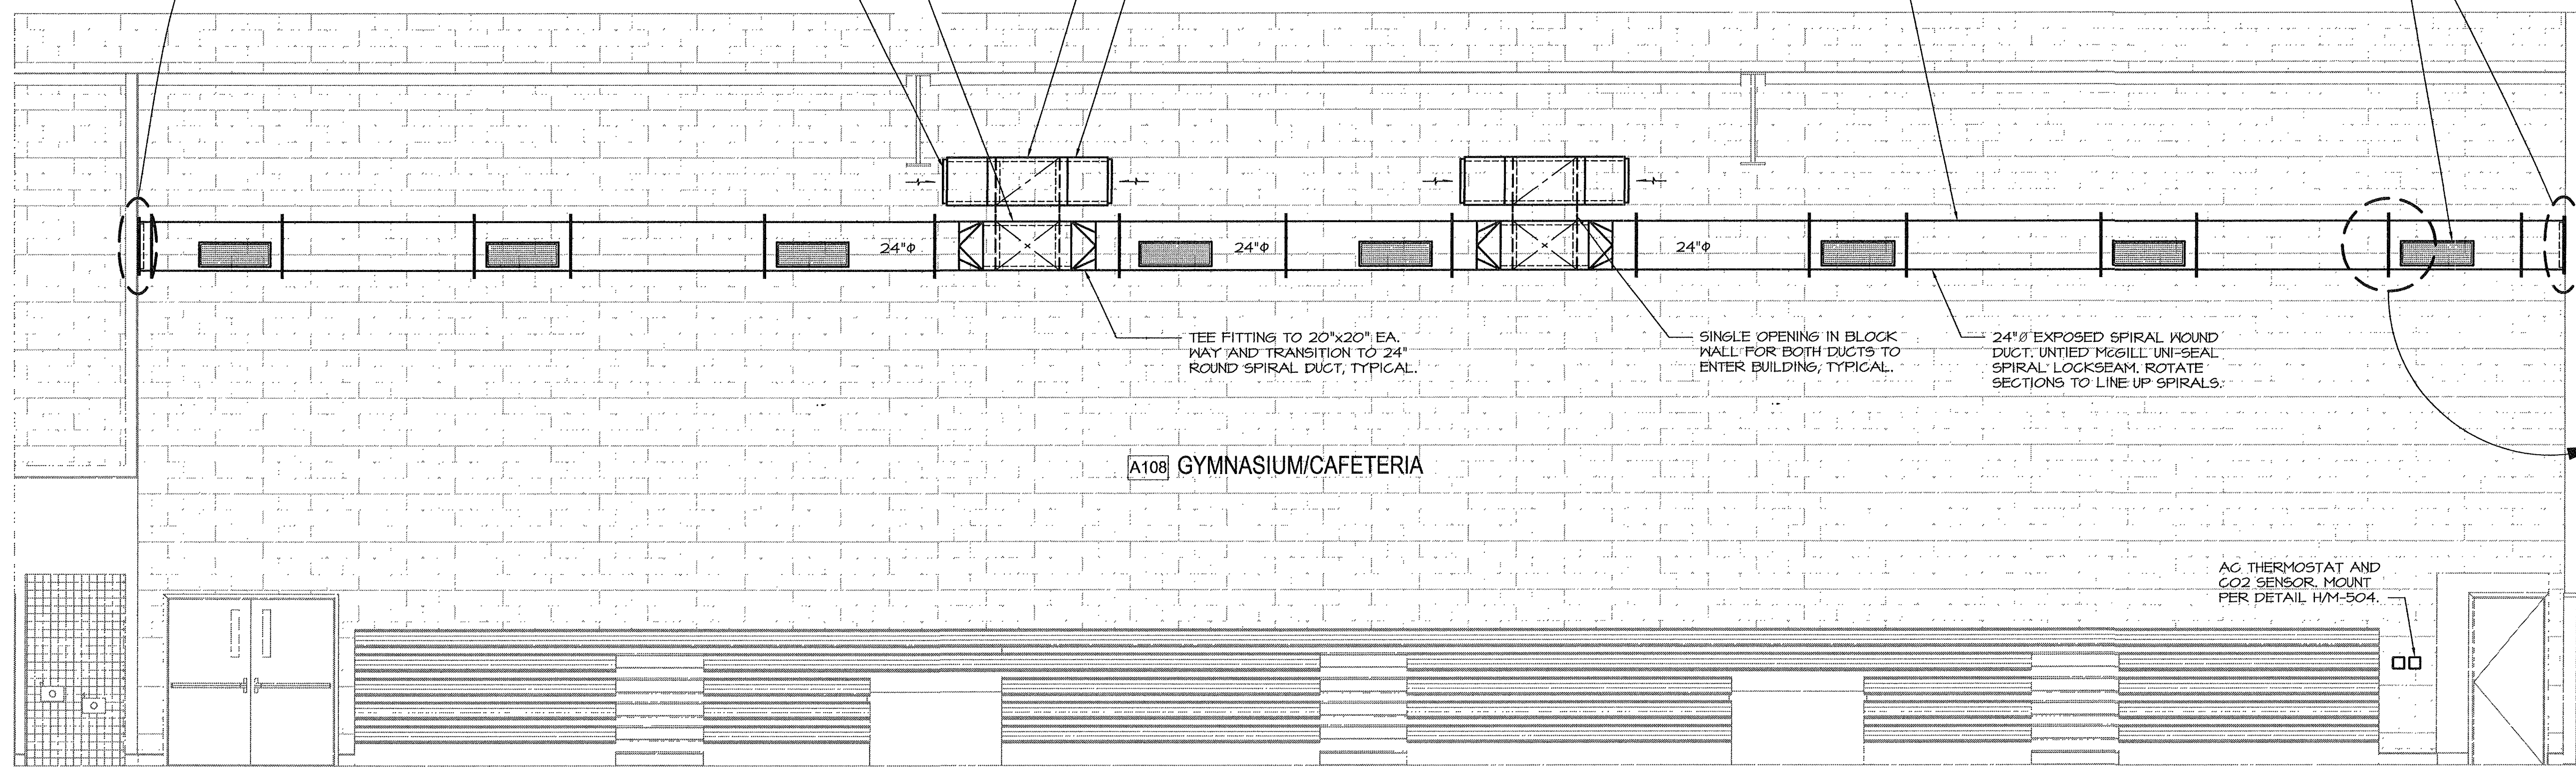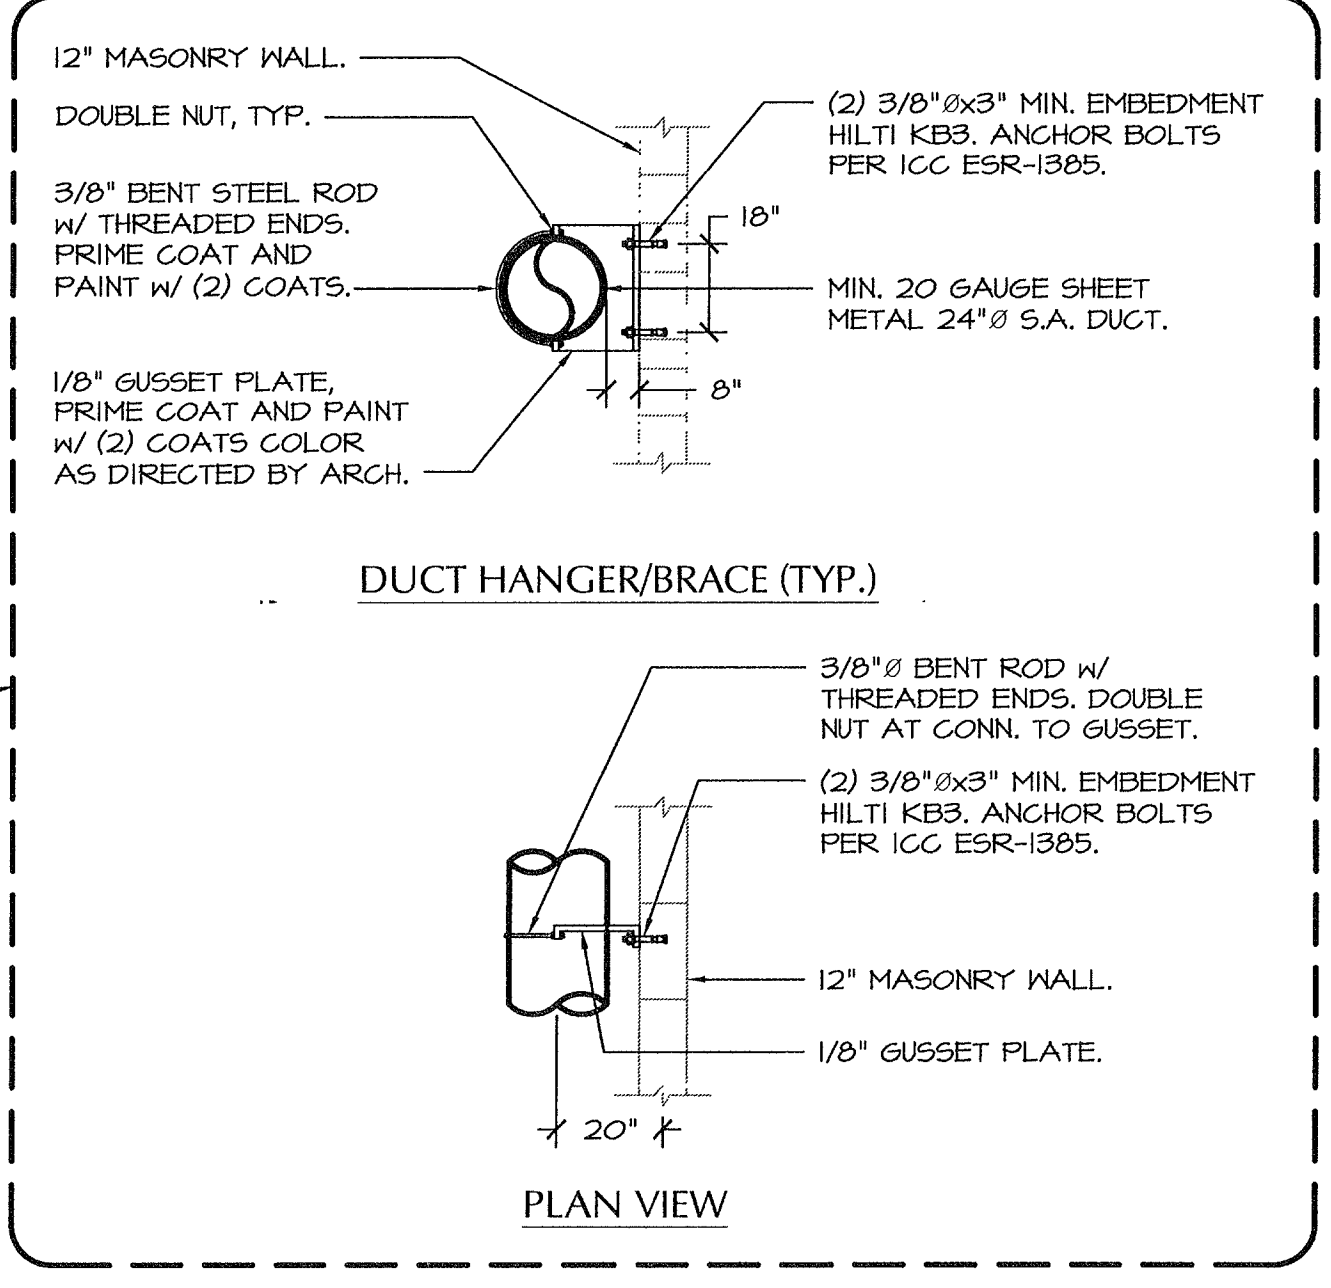

MECHANICAL INTERIOR ELEVATION - GYMNASIUM/CAFETERIA
 SCALE 3/16"=1'-0"

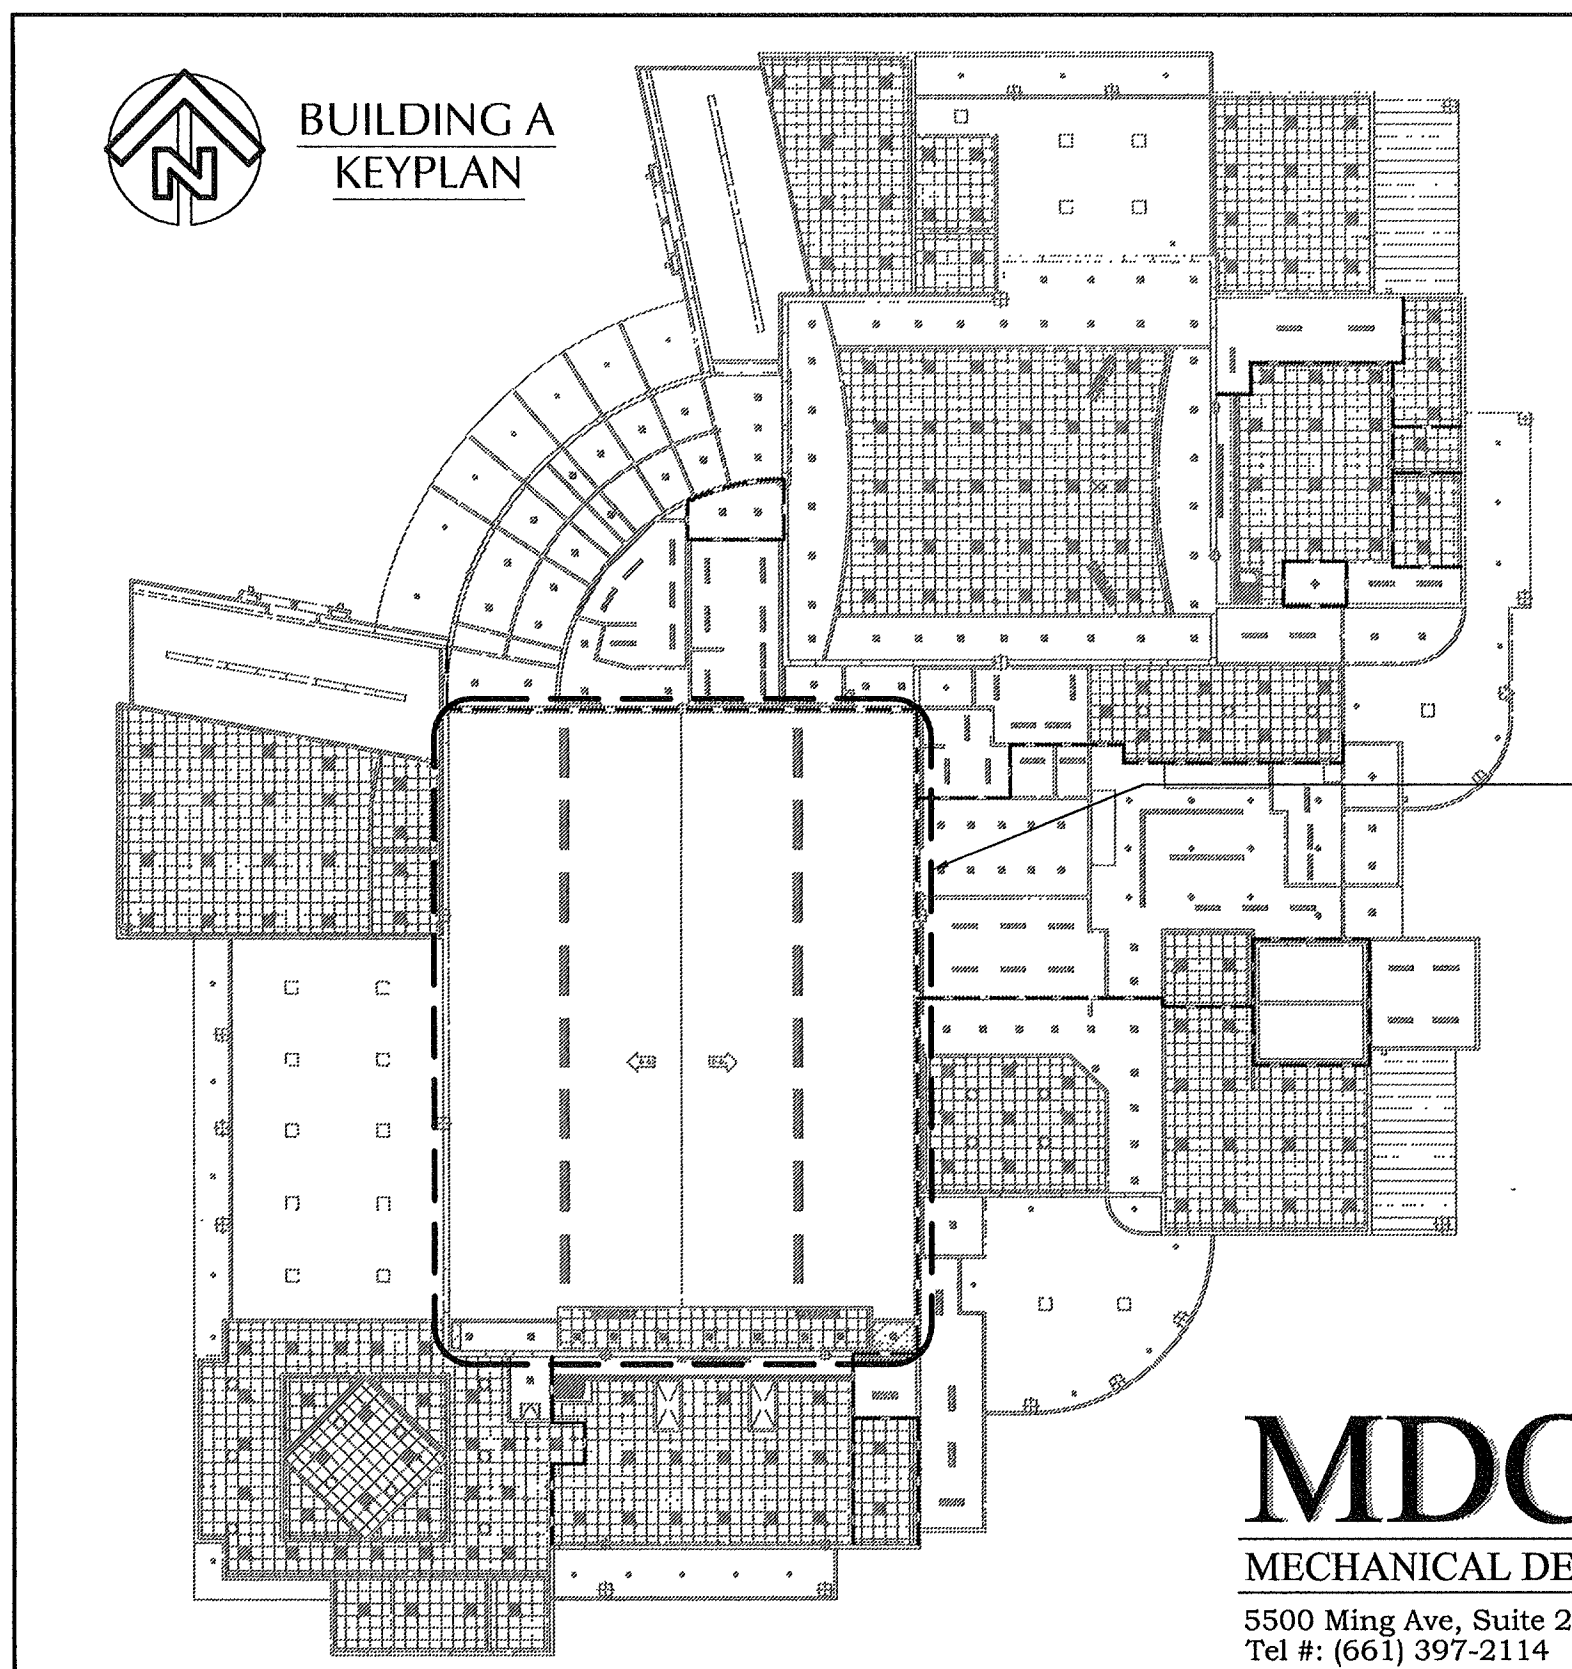

MDC
 MECHANICAL DESIGN CONCEPTS, INC.
 5500 Ming Ave, Suite 251 Bakersfield, CA 93309
 Tel #: (661) 397-2114 FAX #: (661) 397-2116
 Job: 09091 Pjt: 1-11-12

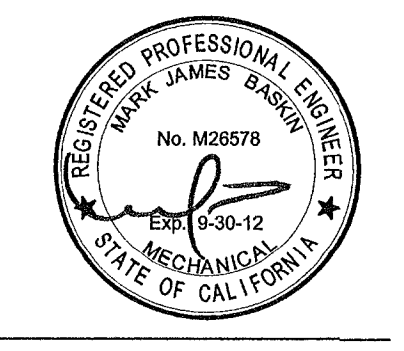

MARK	DATE	DESCRIPTION
△		
△		
△		
△		

CON NUMBER
200101244
 CAD DRAWING FILE:
 DRAWN BY:
KW
 CHECKED BY:
MB
 CHECK AND VERIFY ALL DIMENSIONS BEFORE PROCEEDING WITH THE WORK. REPORT DISCREPANCIES TO THE ARCHITECT.
 THE DRAWINGS, IDEAS, AND DESIGN REPRESENTED ON THIS SHEET ARE THE PROPERTY OF THE ARCHITECT.
 COPYRIGHT
 ORDIZ-MELBY ARCHITECTS, INC. 2010
 SHEET TITLE

MECHANICAL INTERIOR ELEVATION - BUILDING A
 SHEET IDENTIFICATION NUMBER
M-231A