



William J. Melby
DANNY E. ORDIZ, AIA
ARCHITECT C-14,728
WILLIAM J. MELBY, AIA
ARCHITECT C-16,835

IDENTIFICATION STAMP
DIVISION OF STATE ARCHITECT
OFFICE OF REGULATION SERVICES
APPL # 02-112027
FILE # 15-6
AC - FL - SS - M
DATE 11/01/12

PTN # 63321-112

NEW ELEMENTARY SCHOOL
9801 HIGHLAND KNOLLS DR
BAKERSFIELD CALIFORNIA 93306

NEW MIDDLE SCHOOL
4115 VINELAND ROAD
BAKERSFIELD CALIFORNIA 93306

FOR:

BAKERSFIELD CITY SCHOOL DISTRICT
1300 BAKER STREET
BAKERSFIELD CALIFORNIA 93305

DESIGNATION	AC-A13	AC-A14, A16, A1C, A1D	AC-7A, 7B	AC-A3	AC-4	AC-A2, A11	AC-A9	AC-A5	AC-A8	AC-H1, H2	AC-A6	AC-A10, A12
TONS	20	15	15	12.5	8.5	7.5	7.5	6	6	5	4	3
VOLTS/PHASE	460/3	460/3	460/3	460/3	460/3	460/3	460/3	460/3	460/3	460/3	460/3	460/3
F.L.A./M.C.A.	61.0/57.6	38.0/38.9	45.0/42.5	32.0/30.4	21.0/20.0	21.0/19.7	21.0/19.7	18.0/18.1	18.0/18.1	15.0/14.7	14.0/13.7	13.0/12.8
SEER/EER @ ARI	-/12.0	-/12.0	-/12.0	-/12.0	-/12.0	-/12.0	-/12.0	15.2/12.45	-/12.00	15.2/12.45	15.6/13.0	15.0/12.5
BLOWER												
SUPPLY AIR (CFM)	7,000	3,000 - 5,250 (V.A.V.)	3,000 - 5,250 (V.A.V.)	4,375	2,975	2,625	2,625	2,100	2,100	1,750	1,400	1,050
EXT. S.P. (IN. WC)	0.60	0.60	0.60	0.60	0.60	0.60	0.60	0.60	0.60	0.62	0.60	0.53
MIN. O.S.A. (CFM)	SEE PLANS	SEE PLANS	SEE PLANS	SEE PLANS	SEE PLANS	SEE PLANS	SEE PLANS	SEE PLANS	SEE PLANS	SEE PLANS	SEE PLANS	SEE PLANS
BHP	4.80	2.63	1.79	1.59	1.16	0.90	0.90	0.91	0.91	0.81	0.59	0.33
RPM	840	708	688	626	757	714	714	648	648	-	-	-
DRIVE	BELT	BELT	BELT	BELT	BELT	BELT	BELT	BELT	BELT	DIRECT	DIRECT	DIRECT
COOLING												
SENSIBLE (MBH)	175.2	129.3	129.3	110.5	75.6	67.4	67.4	53.3	53.3	44.7	35.7	26.5
TOTAL (MBH)	244.6	179.7	179.7	148.5	101.6	91.4	91.4	73.6	73.6	59.3	49.5	36.5
EAD/EAWB (OF)	ARI CONDITIONS	ARI CONDITIONS	ARI CONDITIONS	ARI CONDITIONS	ARI CONDITIONS	ARI CONDITIONS	ARI CONDITIONS	ARI CONDITIONS	ARI CONDITIONS	ARI CONDITIONS	ARI CONDITIONS	ARI CONDITIONS
AMBIENT AIR (OF)	ARI CONDITIONS	ARI CONDITIONS	ARI CONDITIONS	ARI CONDITIONS	ARI CONDITIONS	ARI CONDITIONS	ARI CONDITIONS	ARI CONDITIONS	ARI CONDITIONS	ARI CONDITIONS	ARI CONDITIONS	ARI CONDITIONS
COMPRESSORS	2	2	2	2	2	2	2	1	1	1	1	1
HEATING												
INPUT CAPACITY (MBH)	310.0	220.0	220.0	180.0	125.0	125.0	125.0	72.0	72.0	60.0	60.0	60.0
OUTPUT CAPACITY (MBH)	251.0	178.0	178.0	146.0	103.0	103.0	103.0	59.0	59.0	50.0	50.0	50.0
FUEL	NATURAL GAS	NATURAL GAS	NATURAL GAS	NATURAL GAS	NATURAL GAS	NATURAL GAS	NATURAL GAS	NATURAL GAS	NATURAL GAS	NATURAL GAS	NATURAL GAS	NATURAL GAS
AJFUE (%)	81%	81%	81%	81%	82%	82%	82%	82%	82%	81%	81%	81%
STAGES	2	2	2	2	2	2	2	2	2	1	1	1
FILTER												
AREA (SQ. FT.)	25.00	20.83	20.83	18.00	11.11	11.11	11.11	8.89	8.89	7.11	7.11	5.55
TYPE	2" PLEATED MERV 8	2" PLEATED MERV 8	2" PLEATED MERV 8	2" PLEATED MERV 8	2" PLEATED MERV 8	2" PLEATED MERV 8	2" PLEATED MERV 8	2" PLEATED MERV 8	2" PLEATED MERV 8	2" PLEATED MERV 8	2" PLEATED MERV 8	2" PLEATED MERV 8
MANUFACTURER	CARRIER	CARRIER	CARRIER	CARRIER	CARRIER	CARRIER	CARRIER	CARRIER	CARRIER	CARRIER	CARRIER	CARRIER
TYPE	GASELECTRIC	GASELECTRIC	GASELECTRIC	GASELECTRIC	GASELECTRIC	GASELECTRIC	GASELECTRIC	GASELECTRIC	GASELECTRIC	GASELECTRIC	GASELECTRIC	GASELECTRIC
MODEL NUMBER	48HCE17	48HCE17	48HCE17	48HCE14	48HCE14	48HCE17	48HCE17	48HCE17	48HCE17	48HCE17	48HCE17	48HCE17
OPER. WT. (LBS)	2,900	2,550	2,550	1,850	1,220	1,220	1,220	980	980	765	755	670
ACCESSORIES	1, 3 THRU 8, 10, 12, 13	2 THRU 13	1 THRU 10, 12, 13	1 THRU 8, 12, 13	1, 3 THRU 8, 12, 13	1 THRU 8, 12, 13	1 THRU 8, 12, 13	1, 3 THRU 8, 12, 13	1 THRU 8, 12, 13	1 THRU 8, 12, 13	1 THRU 8, 12, 13	1 THRU 8, 12, 13


- INTEGRATED ECONOMIZER WITH DRY BULB CONTROLS AND POWER EXHAUST FAN.
- WALL MOUNTED CO2 SENSOR AND ASSOCIATED IAQ CONTROLS PACKAGE TO OVERRIDE ECONOMIZER FUNCTION.
- MINIMUM 1/8 GAUGE FULLY WELDED ROOF CURB (CONFORM WITH) WITH INSULATION FAN BELOW COMPRESSORS.
- THROUGH THE BOTTOM SERVICE GAS AND ELECTRICAL CONNECTIONS (COORDINATE WITH ELECTRICAL & PLUMBING TRADES PRIOR TO ORDERING).
- HINGED ACCESS DOORS WITH 1/4 TURN LATCHES AND TIEBACKS.
- INTERNAL HIGH AND LOW PRESSURE COMPRESSOR PROTECTION.
- "XV" REFRIGERANT METERING DEVICE ON EACH CIRCUIT.
- FLUE DISCHARGE DEFLECTOR.
- SINGLE ZONE V.A.V. CONTROLLER. FAN SPEED AND COOLING / HEATING CAPACITY SHALL RESPOND TO DEMAND REPRESENTED AT WALL MOUNTED THERMOSTAT AND SHALL INTEGRATE WITH CO2 SPACE SENSOR TO SATISFY DEMAND CONTROL VENTILATION.
- PREMIUM EFFICIENCY INDOOR FAN MOTOR OPTION.
- HORIZONTAL SUPPLY AND RETURN CONFIGURATION WITH ECONOMIZER. REMOTE EXHAUST FAN USED FOR POWER EXHAUST. SEE EXHAUST FAN SCHEDULE.
- COMFORT LINK CONTROL PANEL WITH SCROLLING MARQUEE TO DISPLAY UNIT DIAGNOSTICS.
- FILTERS TO BE CAMFILFARR AP11, 89" W.C. CLEAN STATIC PRESSURE DROP AT 250 FPM.

DESIGNATION	KEF A1, A2, A3, A4-A, A4-B	EF A1-A1, A1-A2, A1-B1, A1-B2, A1-C1, A1-C2, A1-D1, A1-D2	EF H1	EF A4, A5, A6	EF J1, J2, K1, K2, Q1, Q2, R1, R2	EF A7, D1, G1, N1	EF M1, M2	EF M3	EF H2, H3
CFM		2,500	700	400 - 650	450 - 600	96	119	300	96
EXT. S.P. (IN. WC)		0.50	0.50	0.50	0.50	0.50	0.15	0.40	0.20
BHP/WHIRTS		SEE CAPTIVE	0.62 / 0.25 / -	0.16 / 0.25 / -	0.12 / 0.125 / -	- / - / 49	- / - / 53	0.05 / 0.05 / -	- / - / 49
VOLTS/PHASE		AIR SHEETS	115/1	115/1	115/1	115/1	115/1	115/1	115/1
RPM		M505 THRU	1,496	1,610	1,550	950	1,100	1,425	950
SONES (dBA)		M511	15.9	12.0	8.1	8.1	0.8	1.2	0.8
DRIVE		DIRECT	DIRECT	DIRECT	DIRECT	DIRECT	DIRECT	DIRECT	DIRECT
MOUNTING		ROOF	ROOF	ROOF	ROOF	CEILING	CEILING	ROOF	CEILING
MANUFACTURER		GREENHECK	GREENHECK	GREENHECK	GREENHECK	GREENHECK	GREENHECK	GREENHECK	GREENHECK
TYPE		CENTRIFUGAL	CENTRIFUGAL	CENTRIFUGAL	CENTRIFUGAL	CENTRIFUGAL	CENTRIFUGAL	CENTRIFUGAL	CENTRIFUGAL
MODEL NUMBER		G-143-VG	CUE-098-A	CUE-095-D	CUE-095-D	SP-A110	SP-A125	CUE-095-D	SP-A110
OPER. WT. (LBS)		73	48	27	27	15	15	23	15
START/STOP INTERLOCK WITH		SEE NOTE 10.	SEE NOTE 9.	SEE NOTE 7	SEE NOTE 9.	LIGHT CIRCUIT	LIGHT CIRCUIT	SEE NOTE 8.	MOTION SENSOR
ACCESSORIES		1, 2, 3	1, 2, 3, 6	1, 2, 3, 6	1, 2, 3, 6	1, 3, 4, 5	1, 3, 4, 5	1, 2, 3	1, 3, 4, 5


- NEMA-1 TOGGLE MOUNTED AND WIRED SWITCH.
- 1/8 GAUGE SLOPED ROOF CURB.
- BACK DRAFT DAMPER.
- INSULATED HOUSING.
- FULL SIZE DISCHARGE TO ROOF CAP.
- UNIT MOUNTED SPEED CONTROLLER. FIELD MOUNTED AND WIRED.
- INTERLOCK START/STOP WITH AC UNIT SERVING THE AREA SERVED BY EXHAUST FAN. OPERATE FAN WITH AC UNIT SUPPLY FAN VIA RELAY INTERLOCK.
- INTERLOCK START/STOP WITH WALL SWITCH ADJACENT TO LIGHT SWITCH. PROVIDE ETCHED PLASTIC LABEL INDICATING SERVICE.
- INTERLOCK WITH MOTION SENSOR IN EACH ROOM SERVED BY FAN. WHEN MOTION SENSOR IN ANY SPACE IS SENSING OCCUPANT, FAN SHALL RUN. FAN SHALL CONTINUE RUNNING FOR A MINIMUM PROGRAMMABLE TIME PERIOD OF FIFTEEN MINUTES.
- INTERLOCK WITH ADJUSTABLE STATIC PRESSURE SENSOR IN GYM, LOCATED BELOW CEILING. FANS SHALL MODULATE TO SATISFY STATIC PRESSURE SENSOR 0 - 10 VOLT SIGNAL.

DESIGNATION	CU B11, L8, M7	CU C11, C12, D11, D12, E11, E12, F11, F12, G13, G14, N21, N22, P16, P17
MCA	17	13
VOLTS/PHASE	208/230/1	208/230/1
ARI COOLING CAPACITY (MBH)	24	15
SEER	17.5	16.0
MANUFACTURER	MITSUBISHI	MITSUBISHI
TYPE	AIR COOLED	AIR COOLED
MODEL NUMBER	MUY-GA24NA	MUY-A15ANA
OPER. WT. (LBS)	117	89
ACCESSORIES	1 THRU 4	1 THRU 4

- INSULATED SUCTION AND LIQUID LINE SET.
- AUTO RESTART UPON POWER FAILURE.
- ANTI SHORT CYCLE TIMER.
- EXTEND CONTROL WIRING TO INDOOR UNIT.

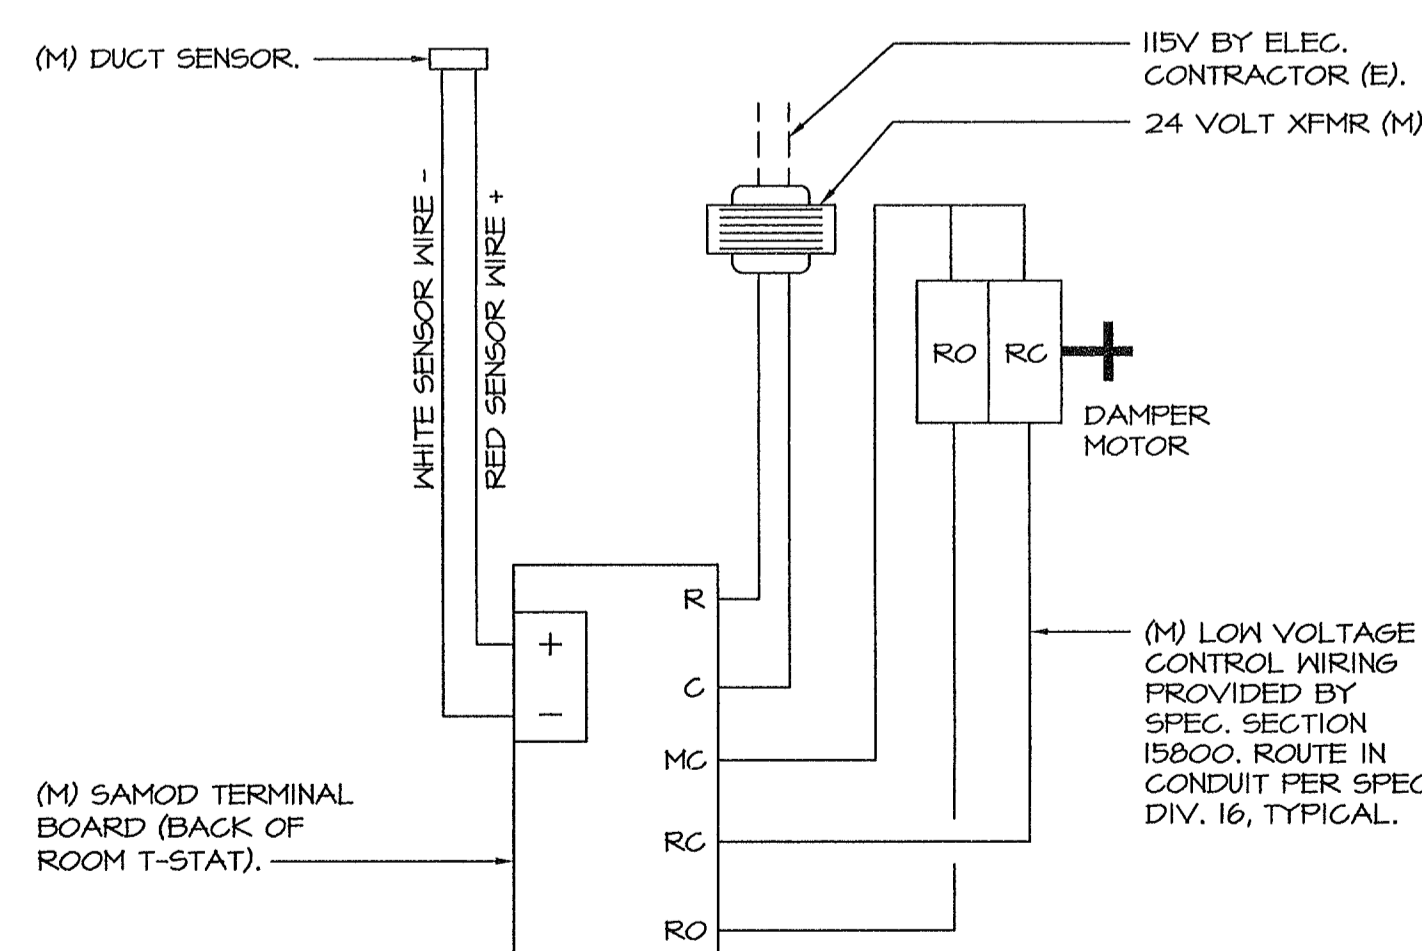

VAV DAMPER
DIAGRAMMATIC

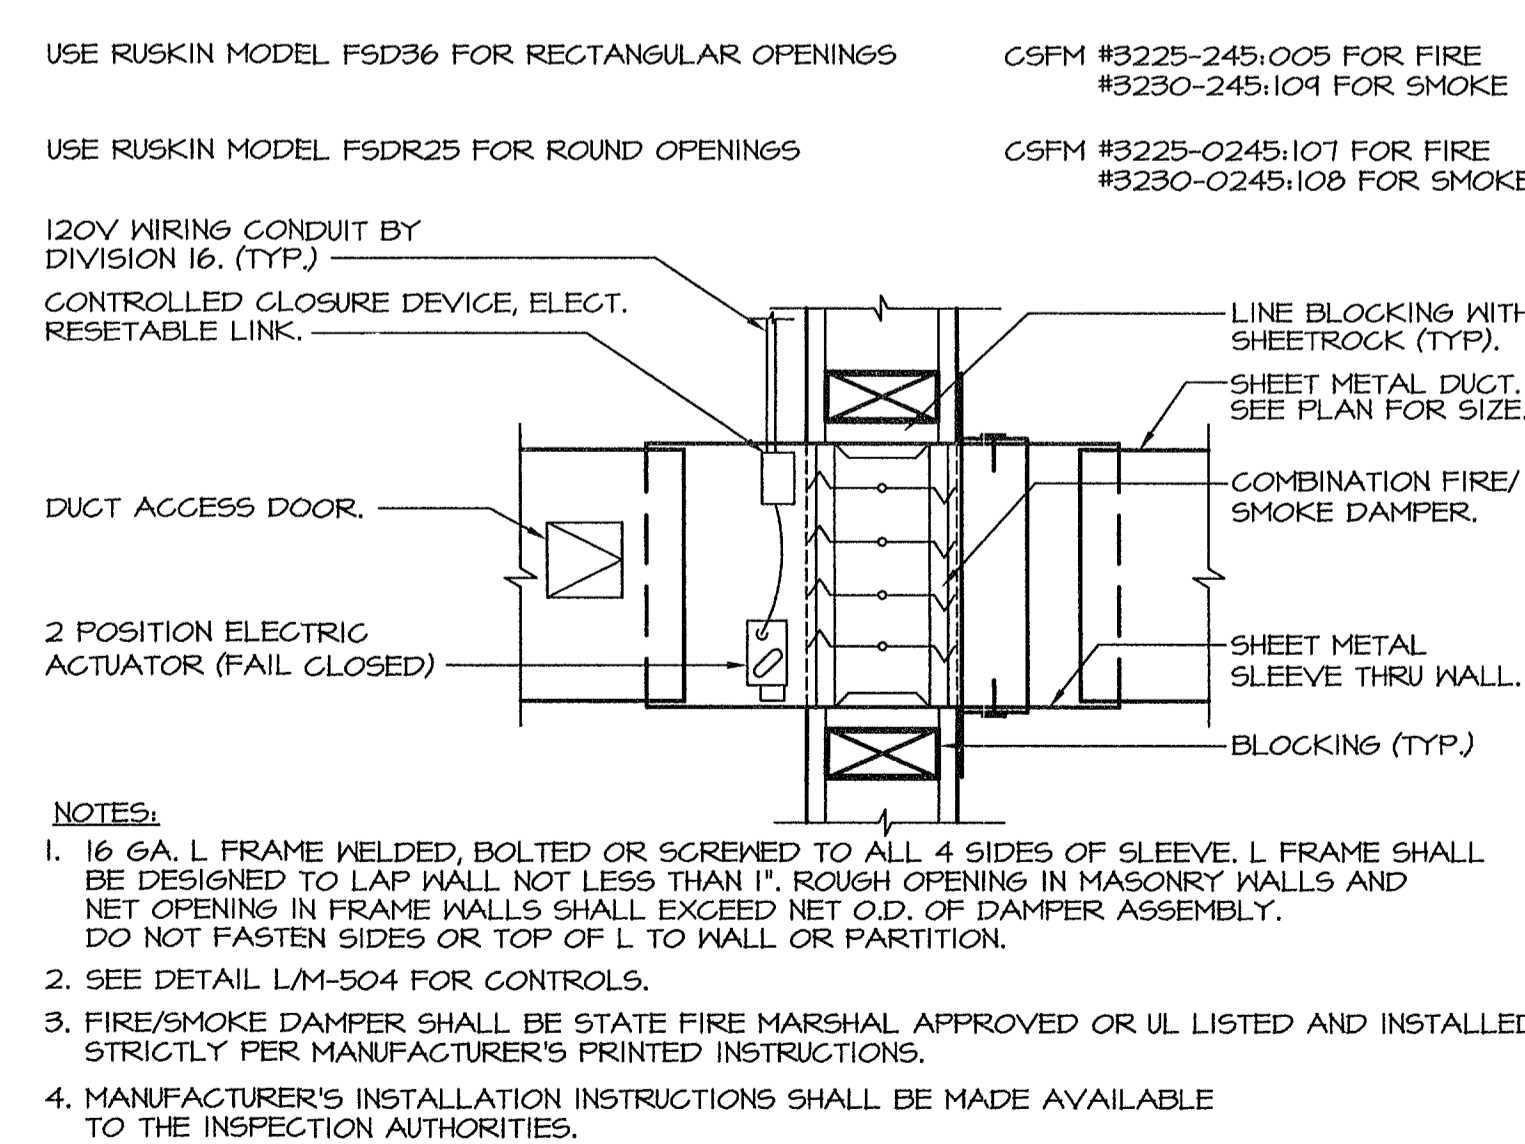

SMOKE/FIRE DAMPER

MARK	DATE	DESCRIPTION
△		
△		
△		
△		

200101244
CAD DRAWING FILE:

DRAWN BY: KW
CHECKED BY: MB

CHECK AND VERIFY ALL DIMENSIONS BEFORE PROCEEDING WITH THE WORK. REPORT DISCREPANCIES TO THE ARCHITECT. THE DRAWINGS, SEALS AND STAMPS REPRESENTED ON THIS SHEET ARE THE PROPERTY OF THE ARCHITECT.

COPYRIGHT
ORDIZ-MELBY ARCHITECTS, INC. 2010
SHEET TITLE

MECHANICAL SCHEDULES

SHEET IDENTIFICATION NUMBER

M-501

