




INTAKE HOOD ON ROOF (N)

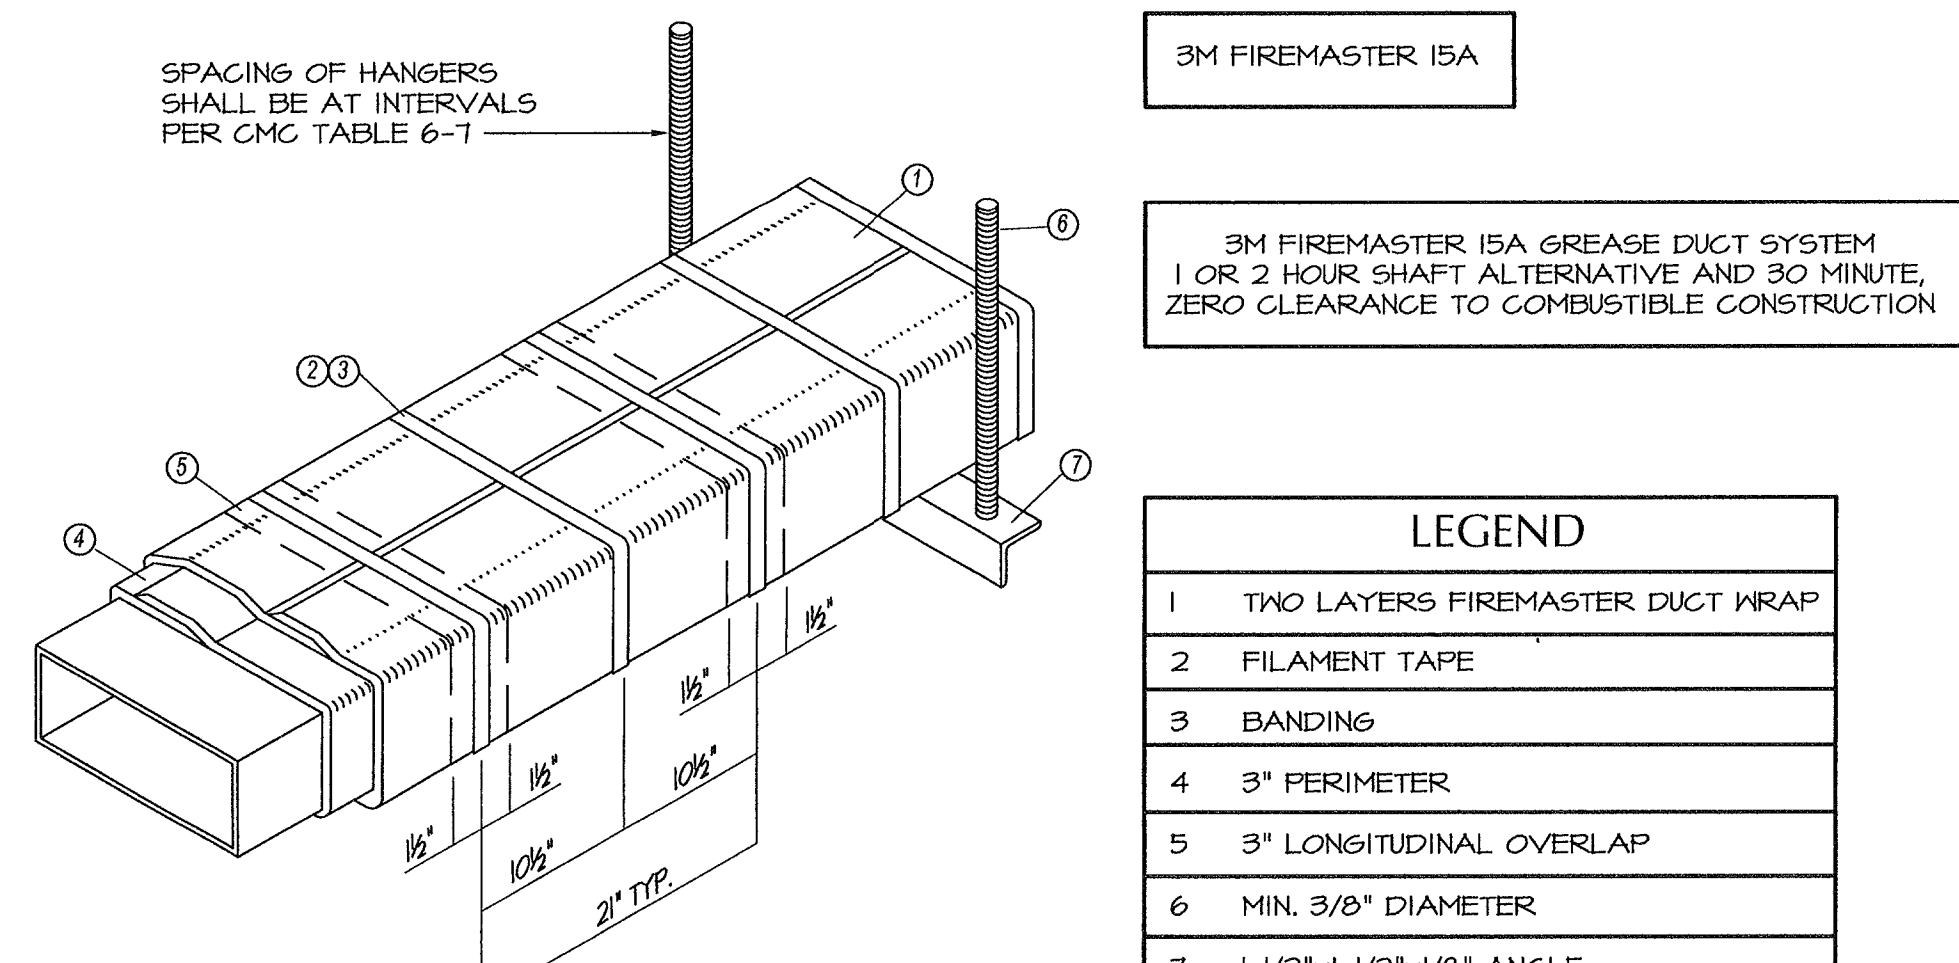


3M FIREMASTER - DUCT WRAP & HANGERS (J)

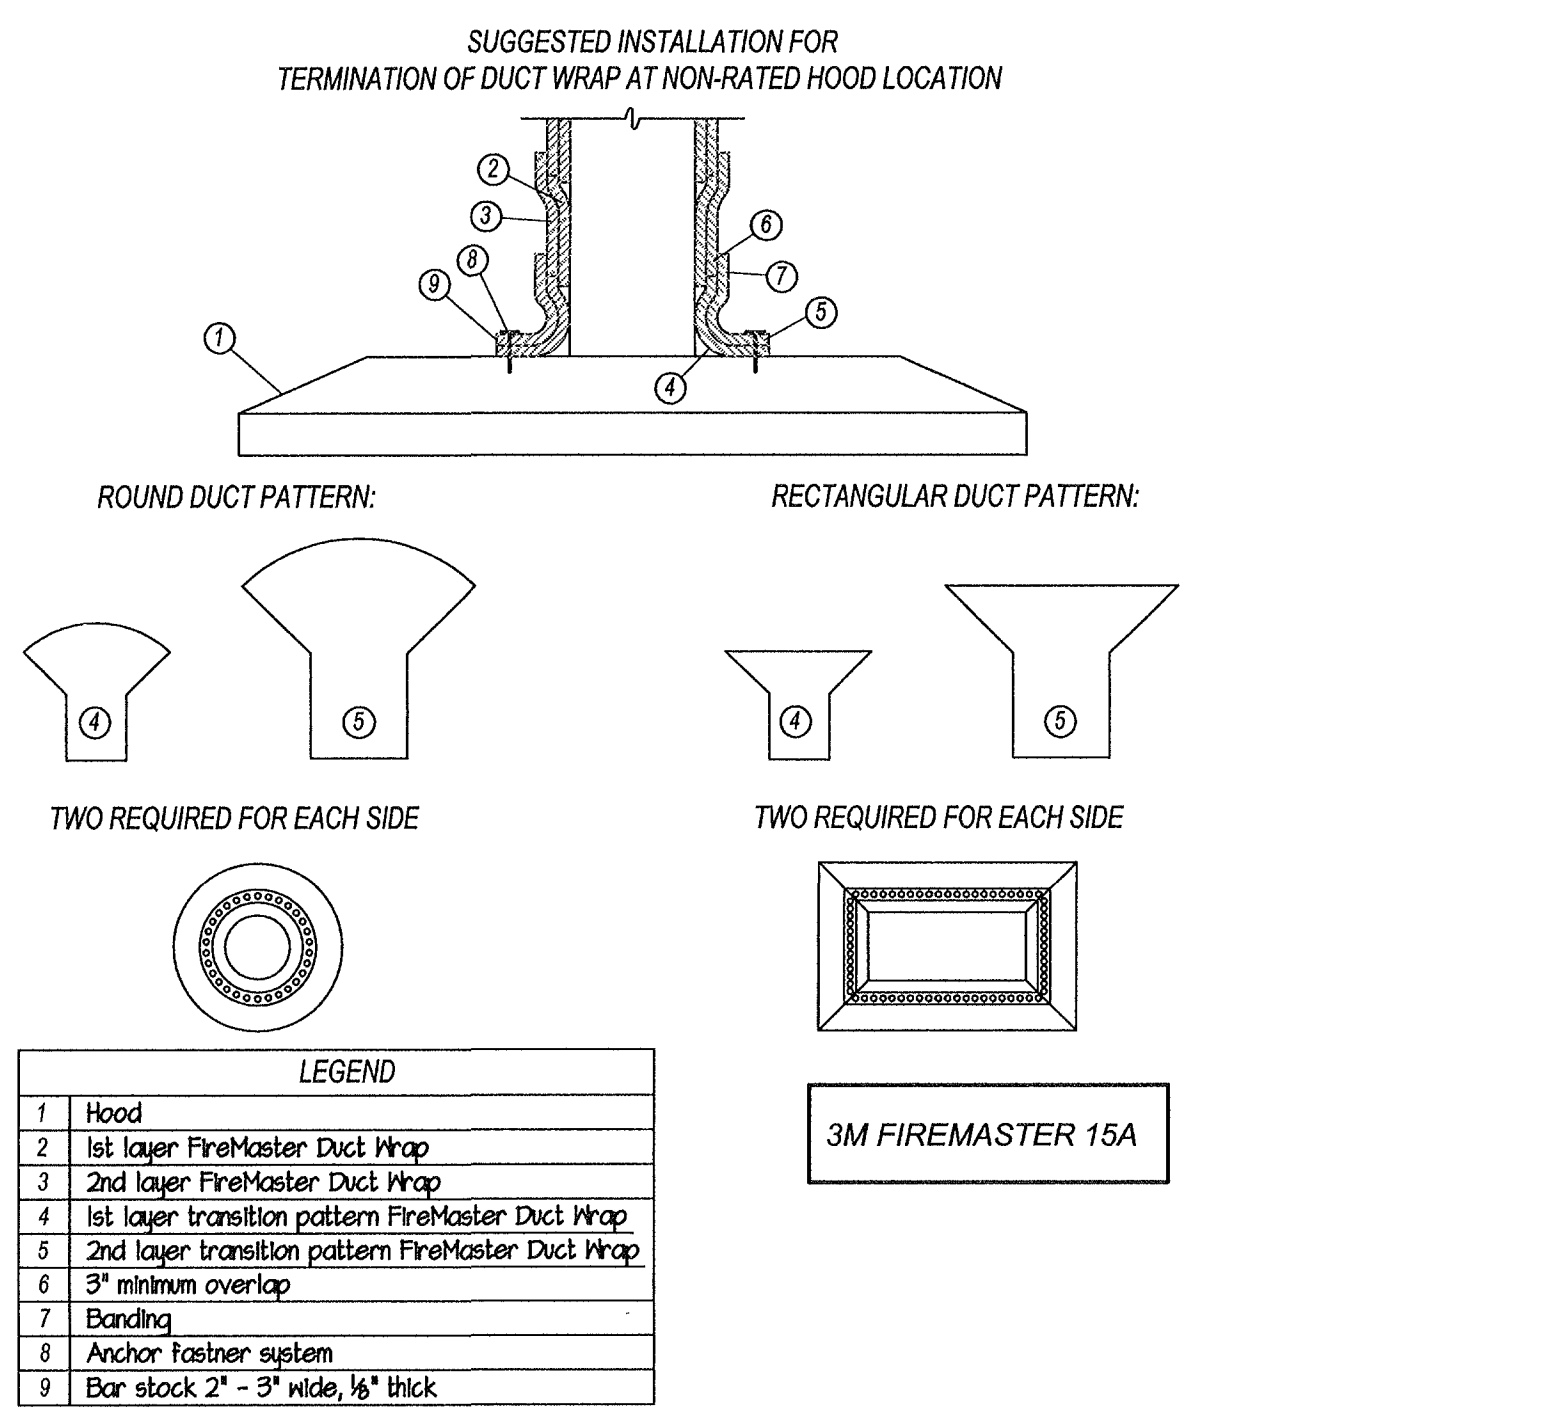


3M FIREMASTER - DUCT WRAP TERMINATION (K)

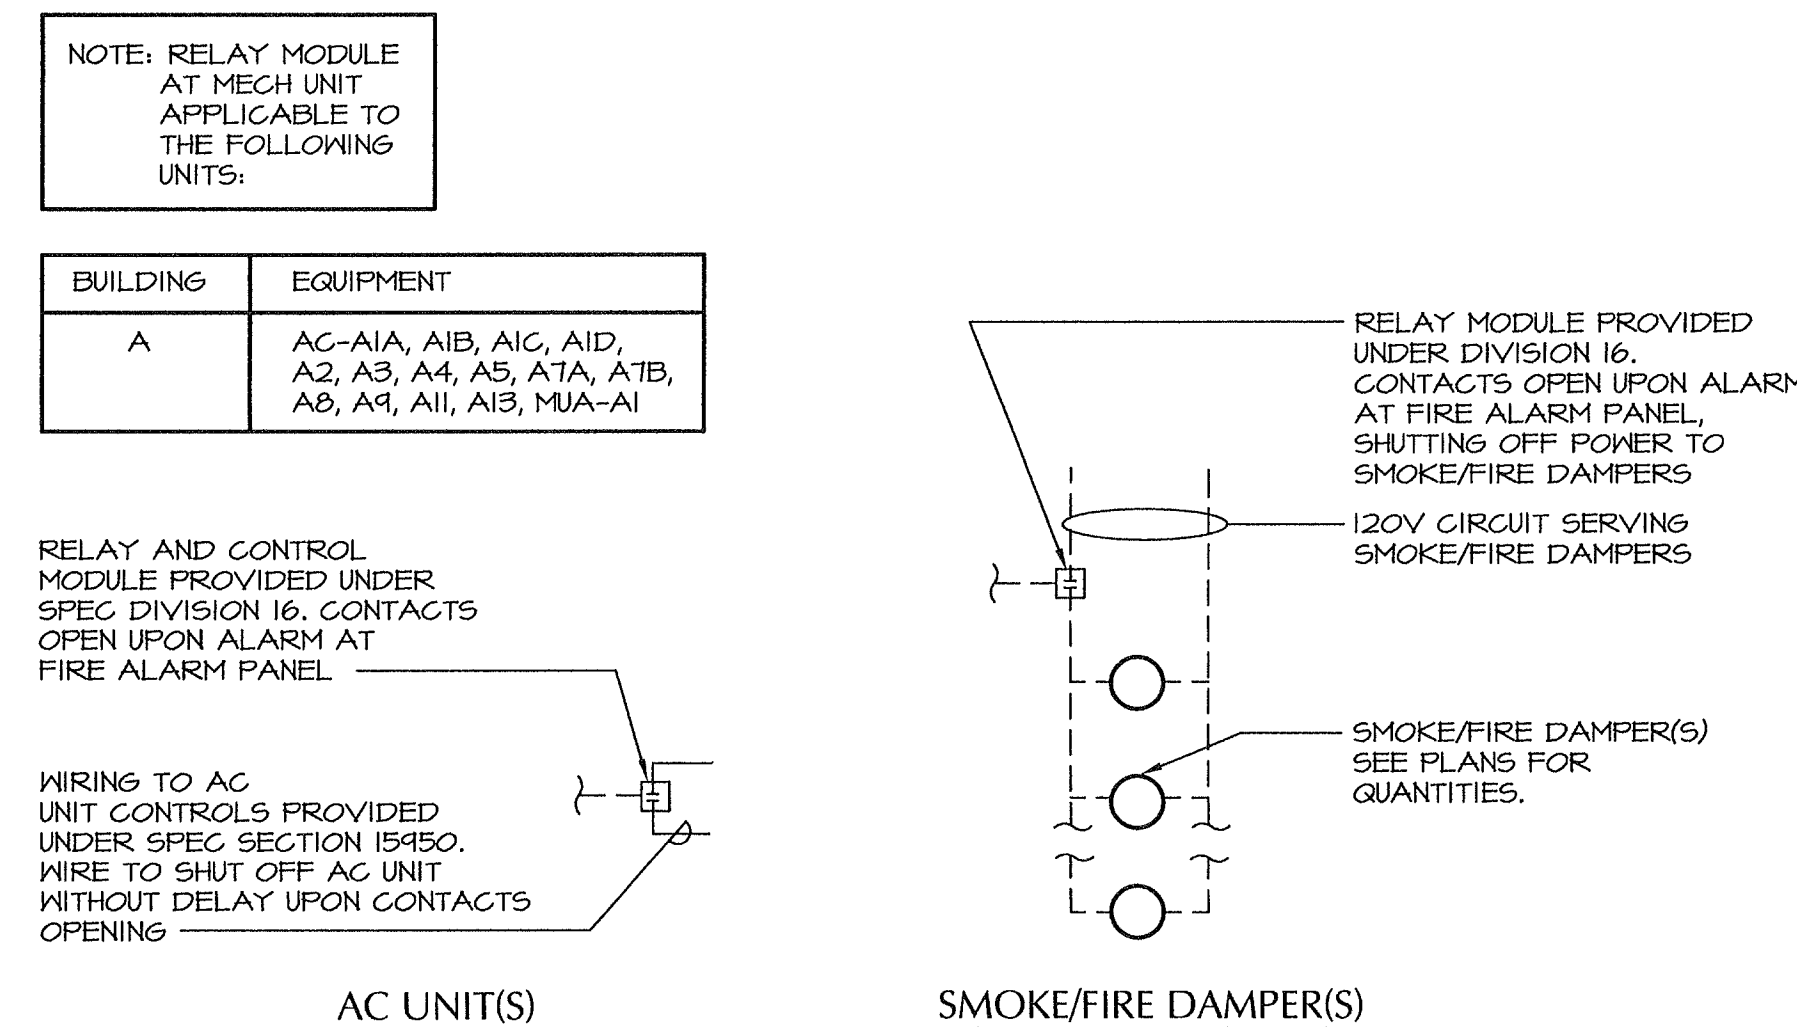


AC UNIT INTERLOCKS WITH FIRE ALARM PANEL (L)

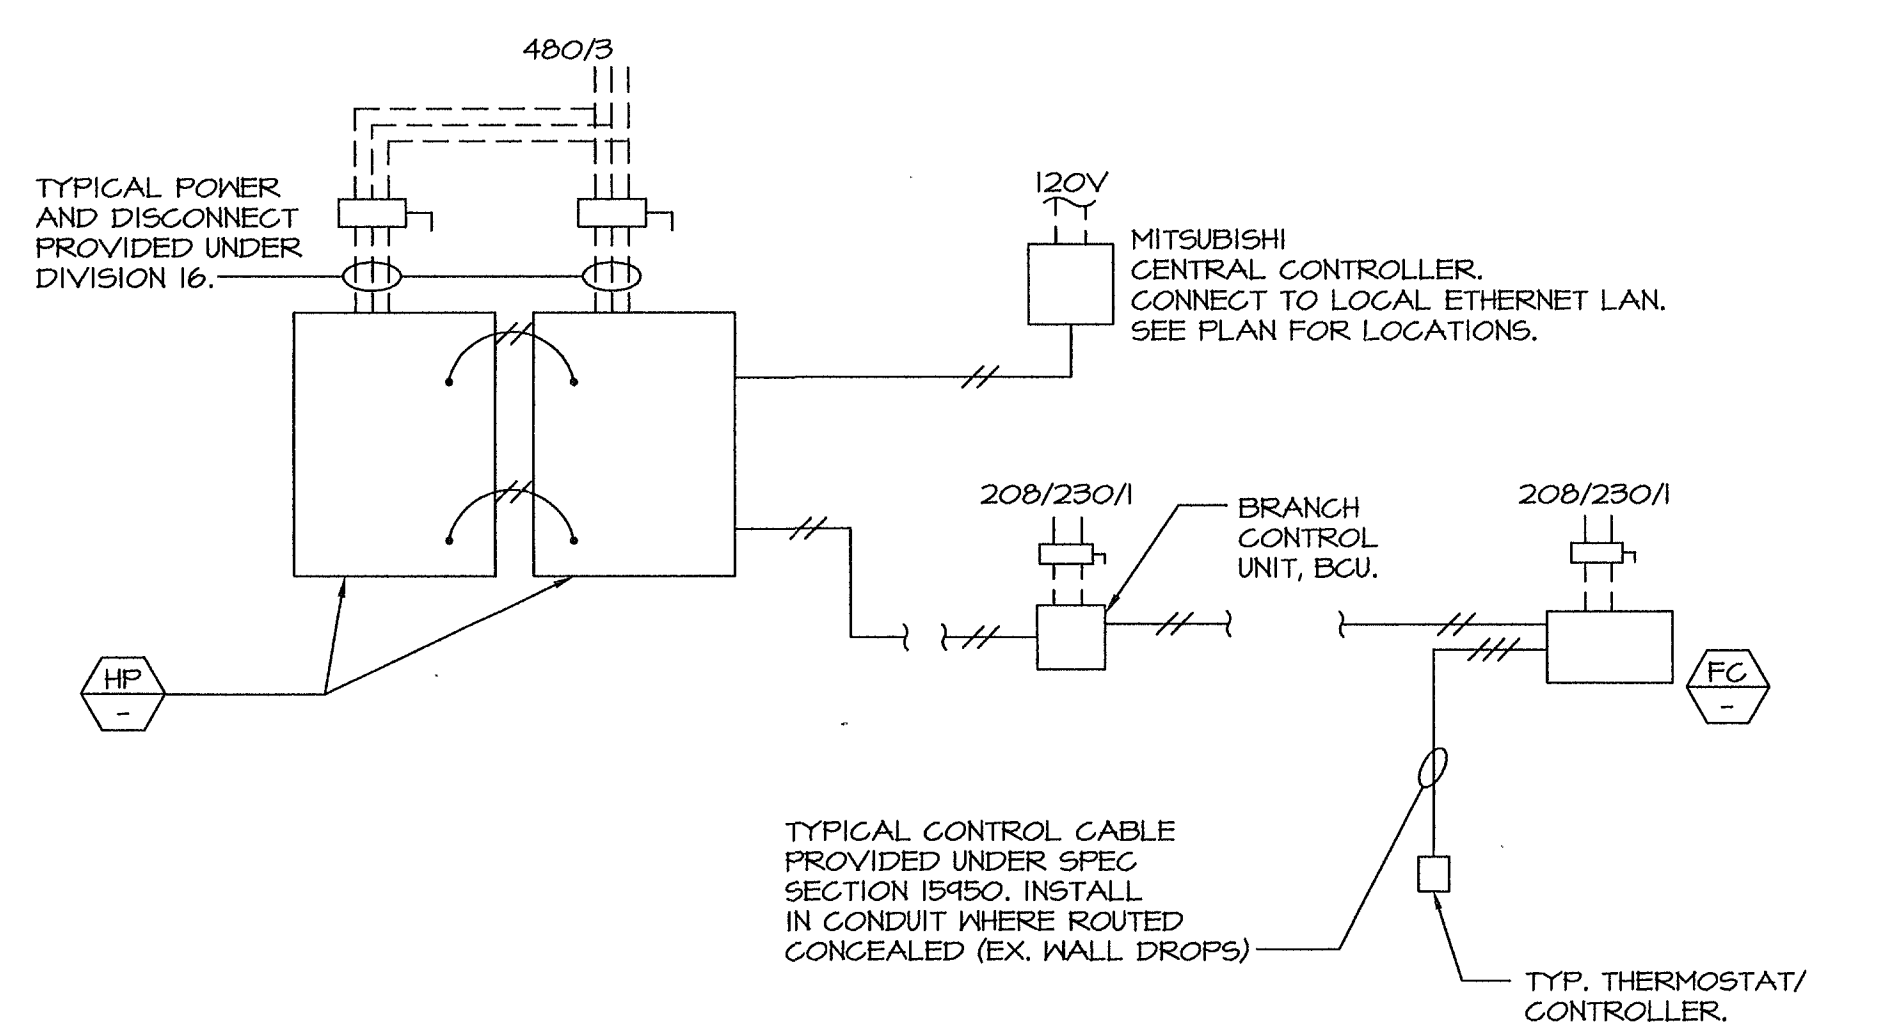


HEAT PUMP WIRING SCHEMATIC (M)

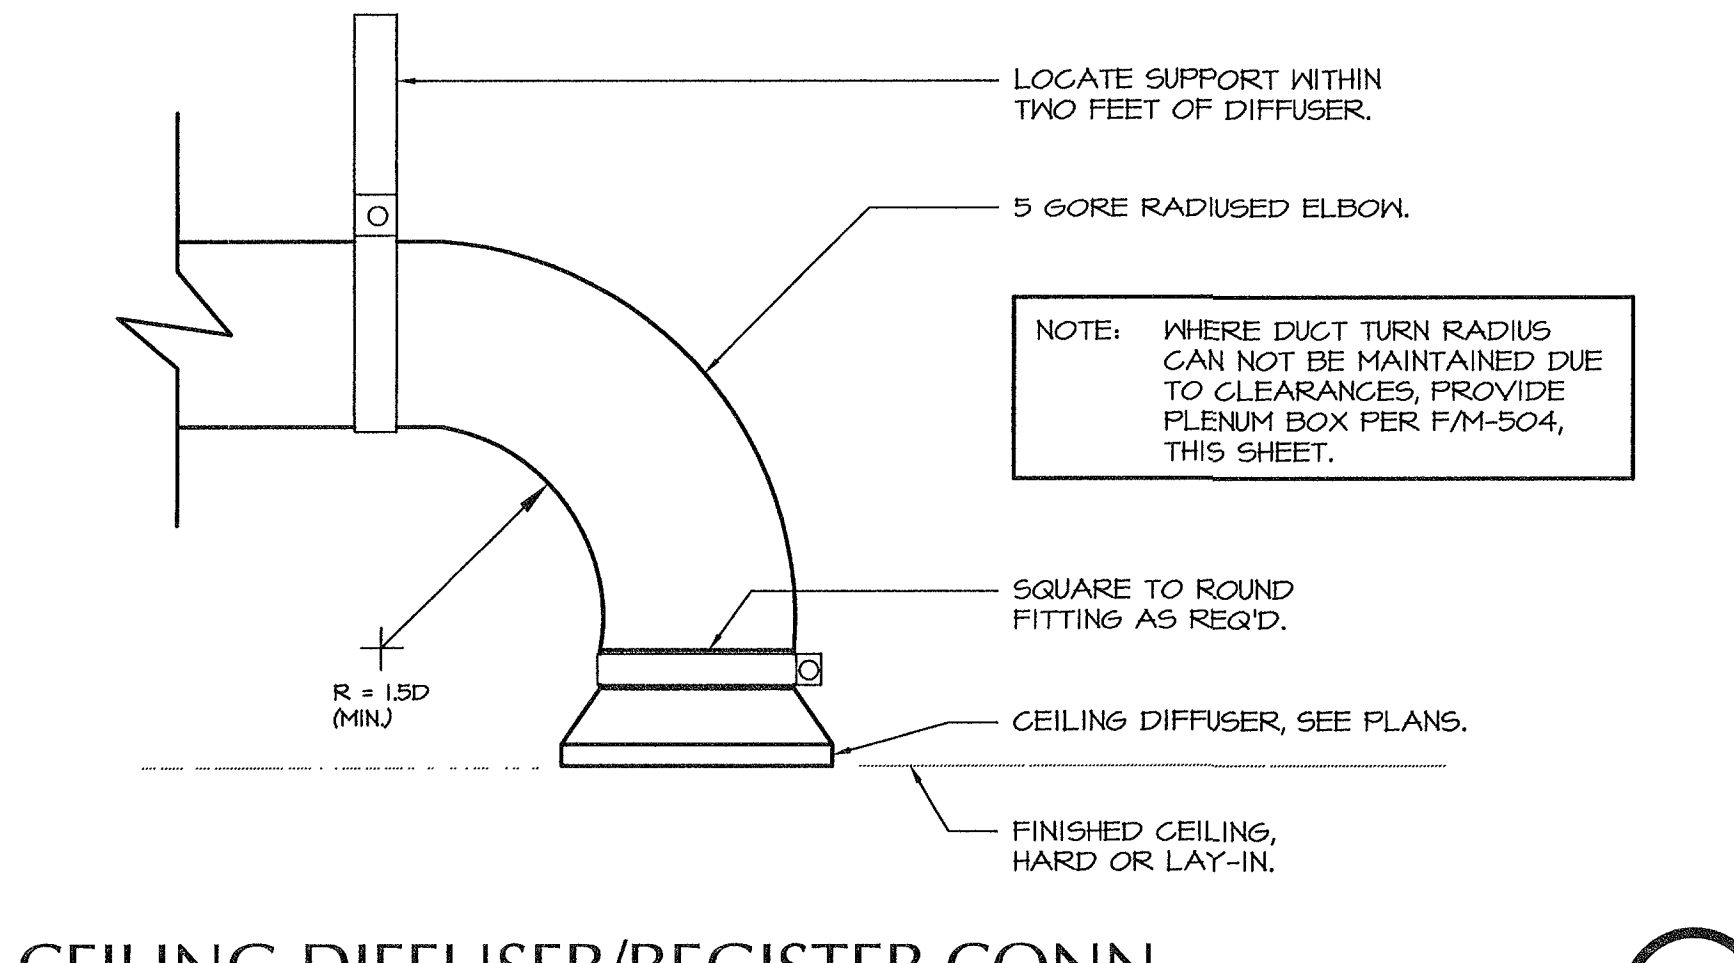


CEILING DIFFUSER/REGISTER CONN. (E)

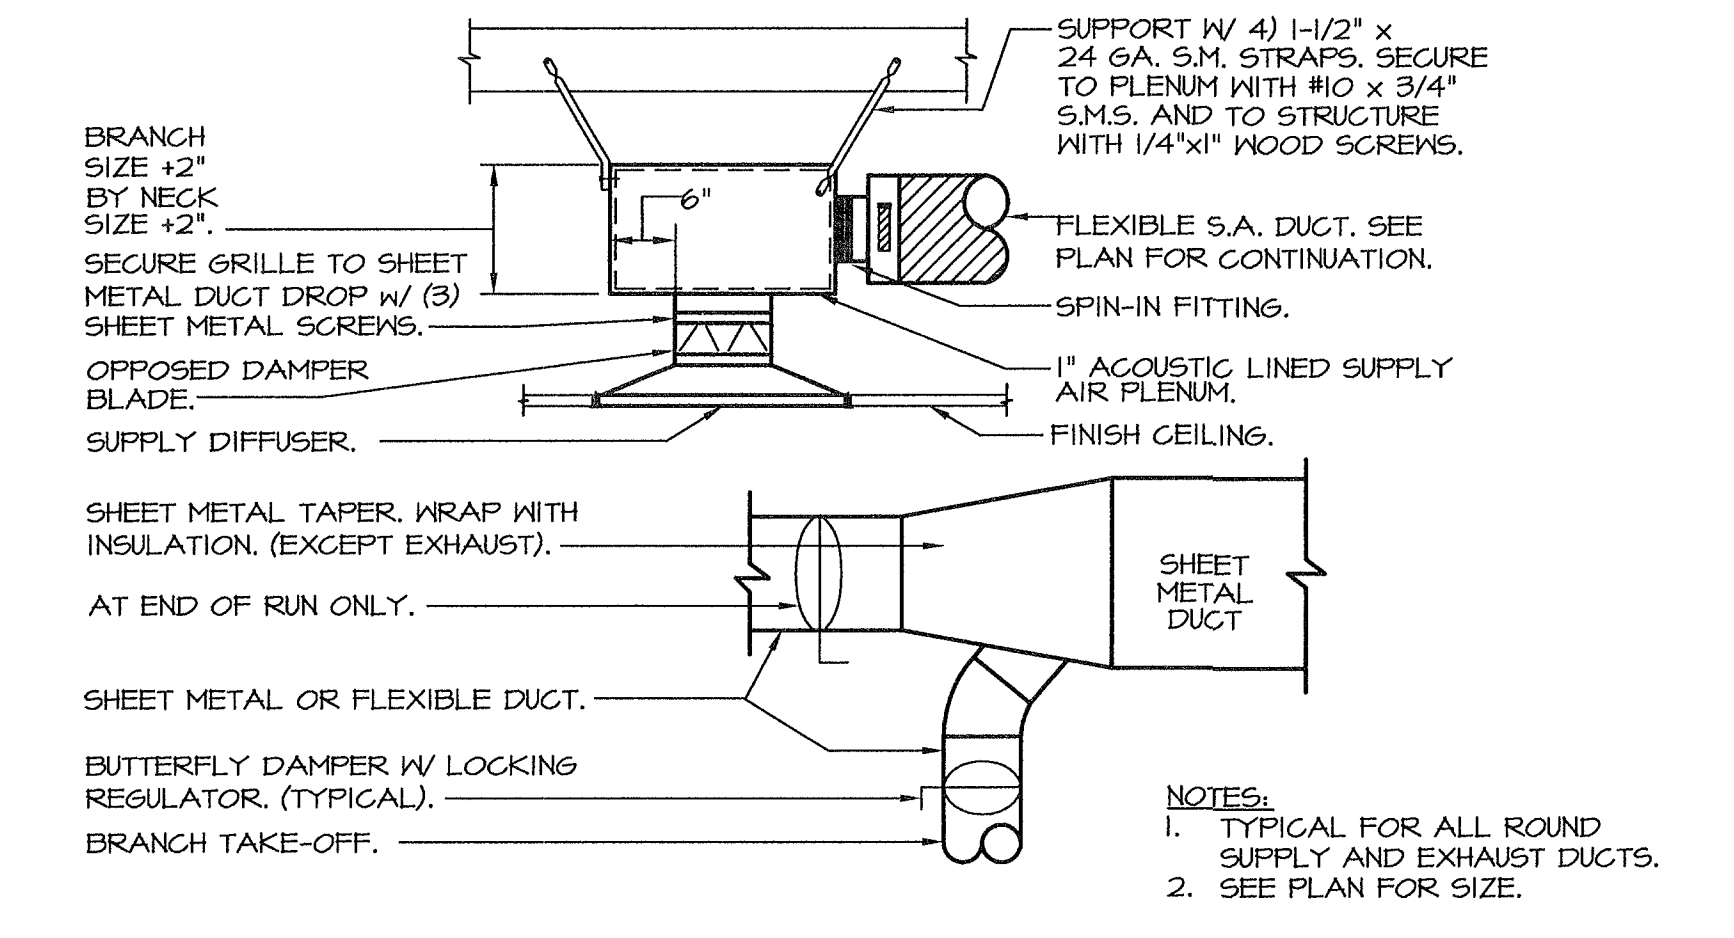


SUPPLY AIR PLENUM AND BRANCH TAKE-OFFS (F)

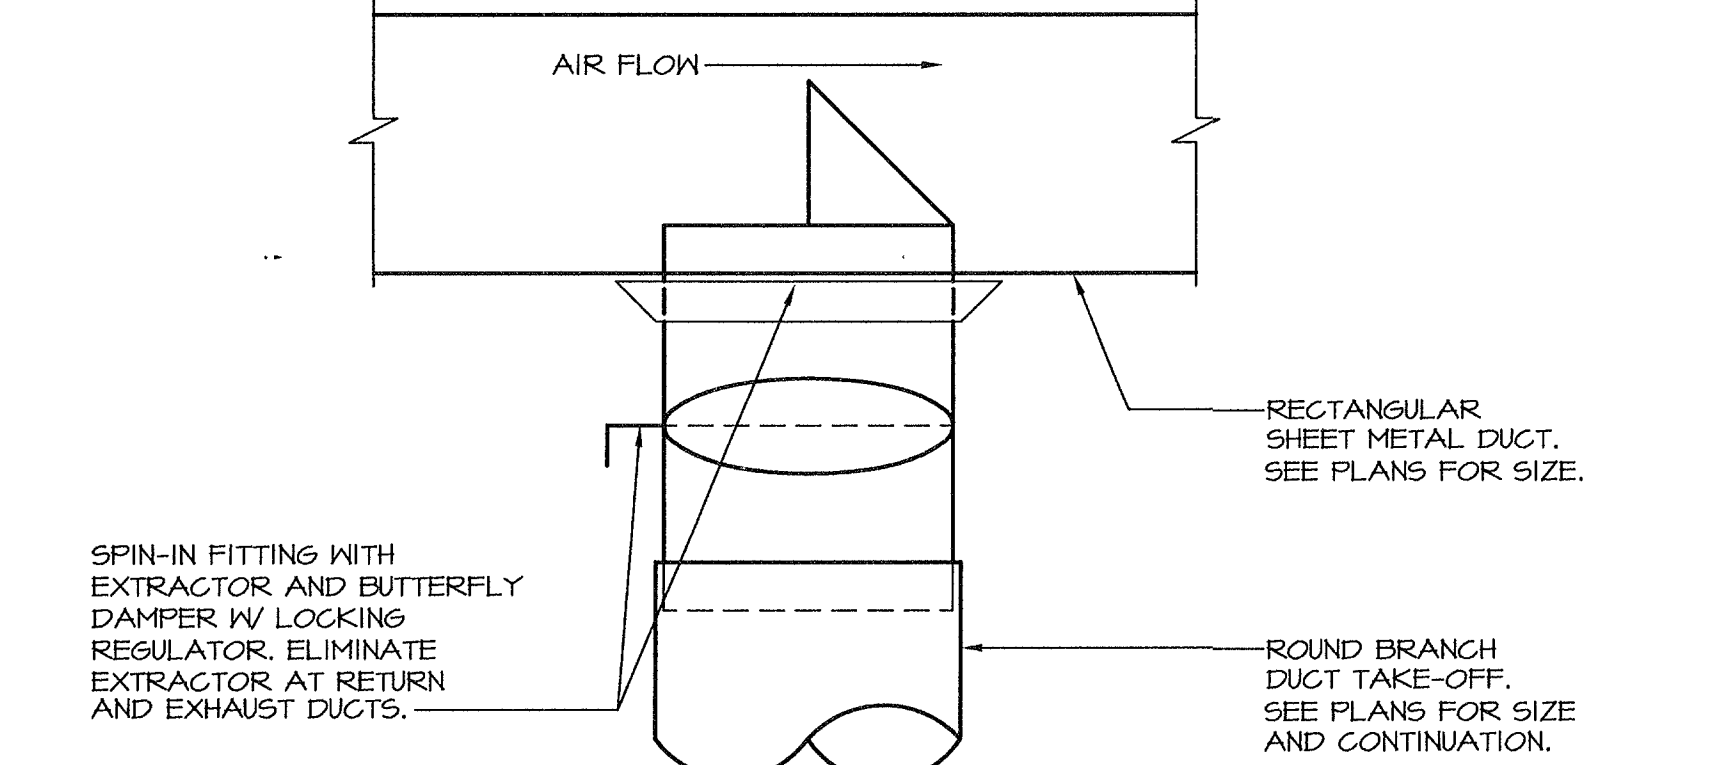


SPIN-IN TAKE OFF (G)

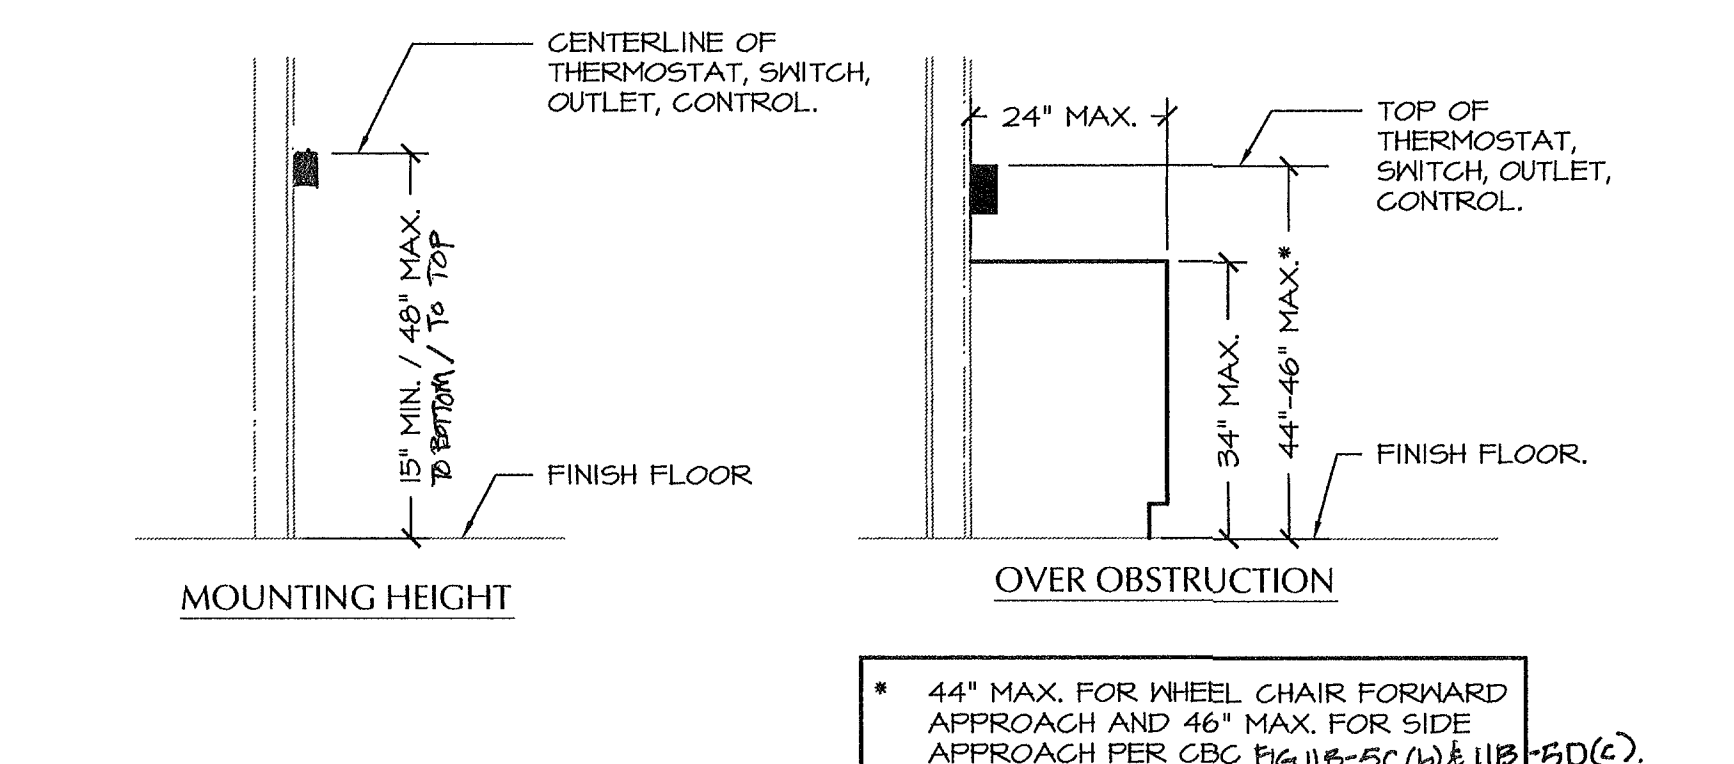


THERMOSTAT LOCATIONS (H)

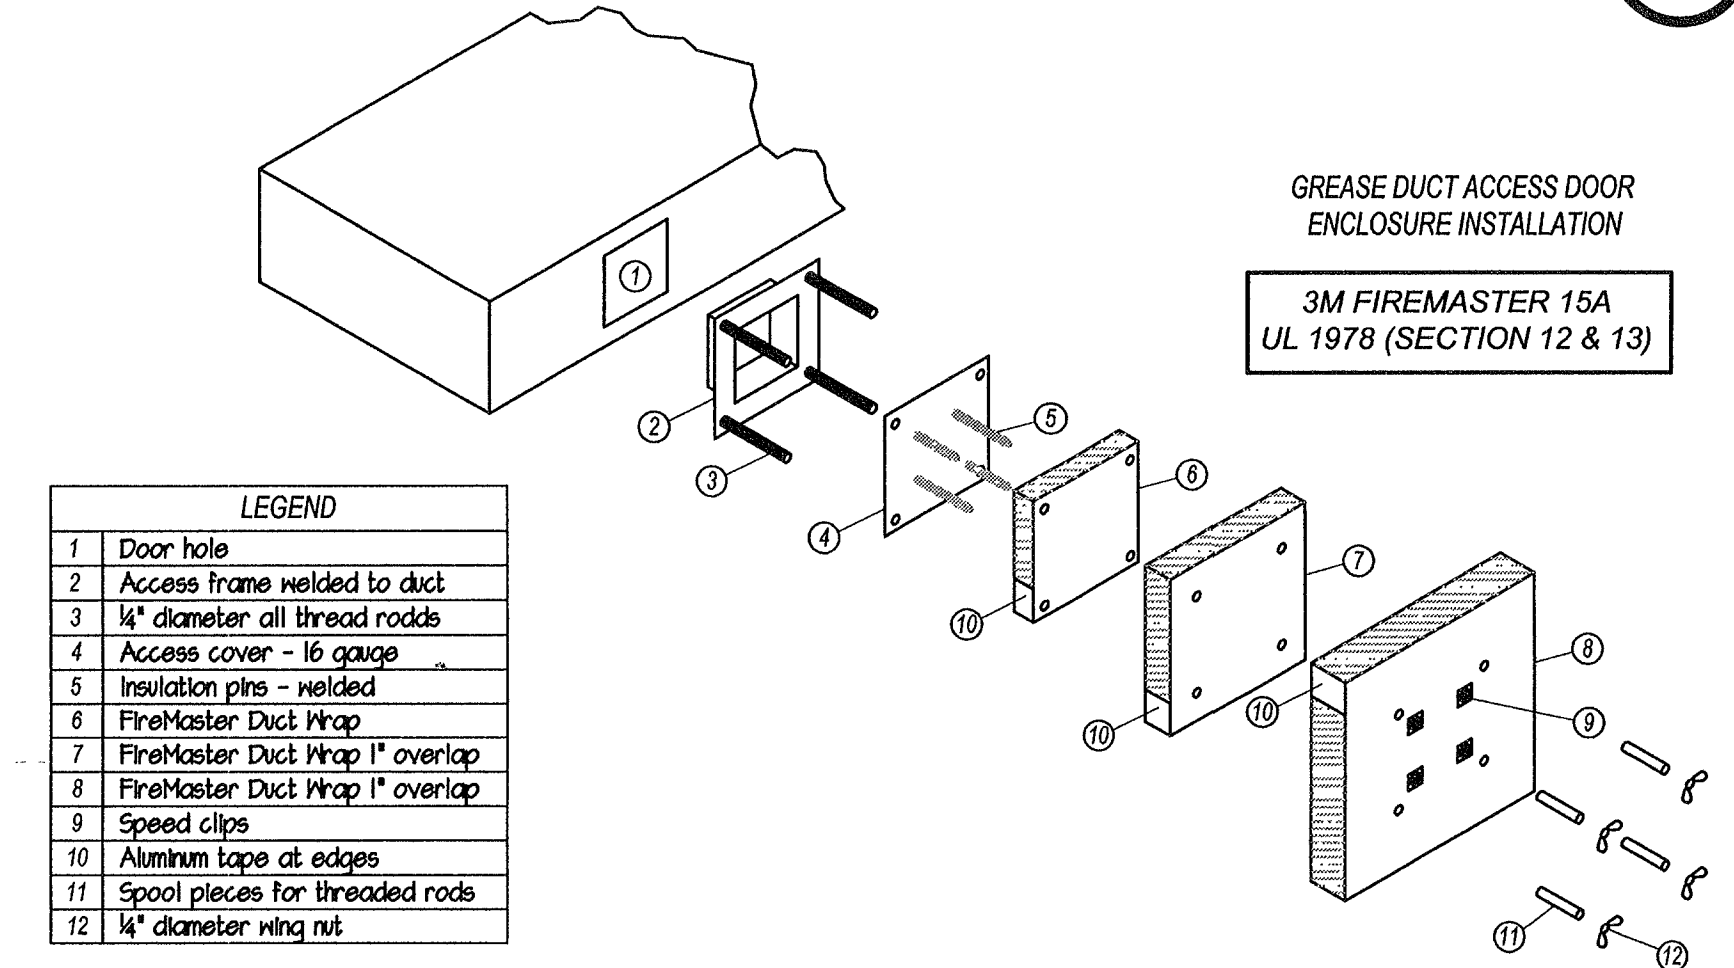


3M FIRE MASTER - ACCESS DOOR (I)

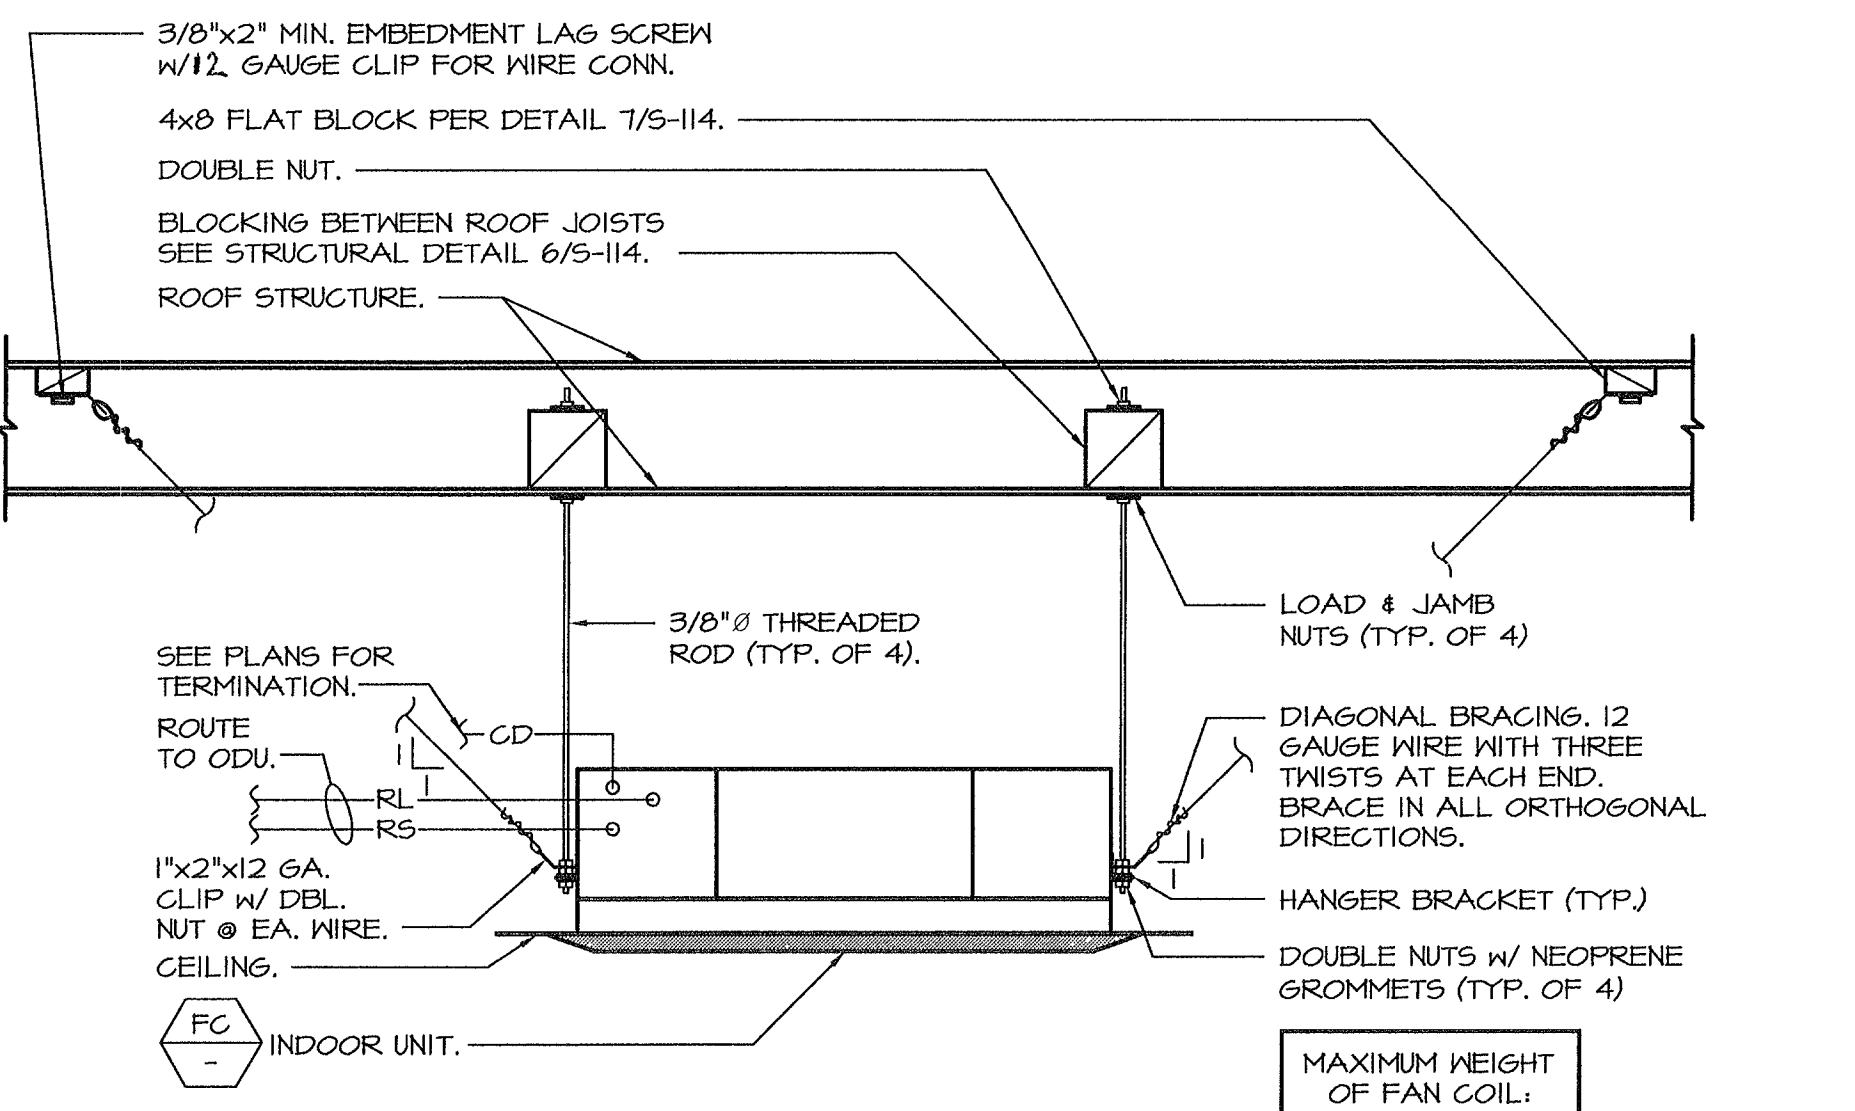


FAN COIL UNIT - CEILING CASSETTE (A)

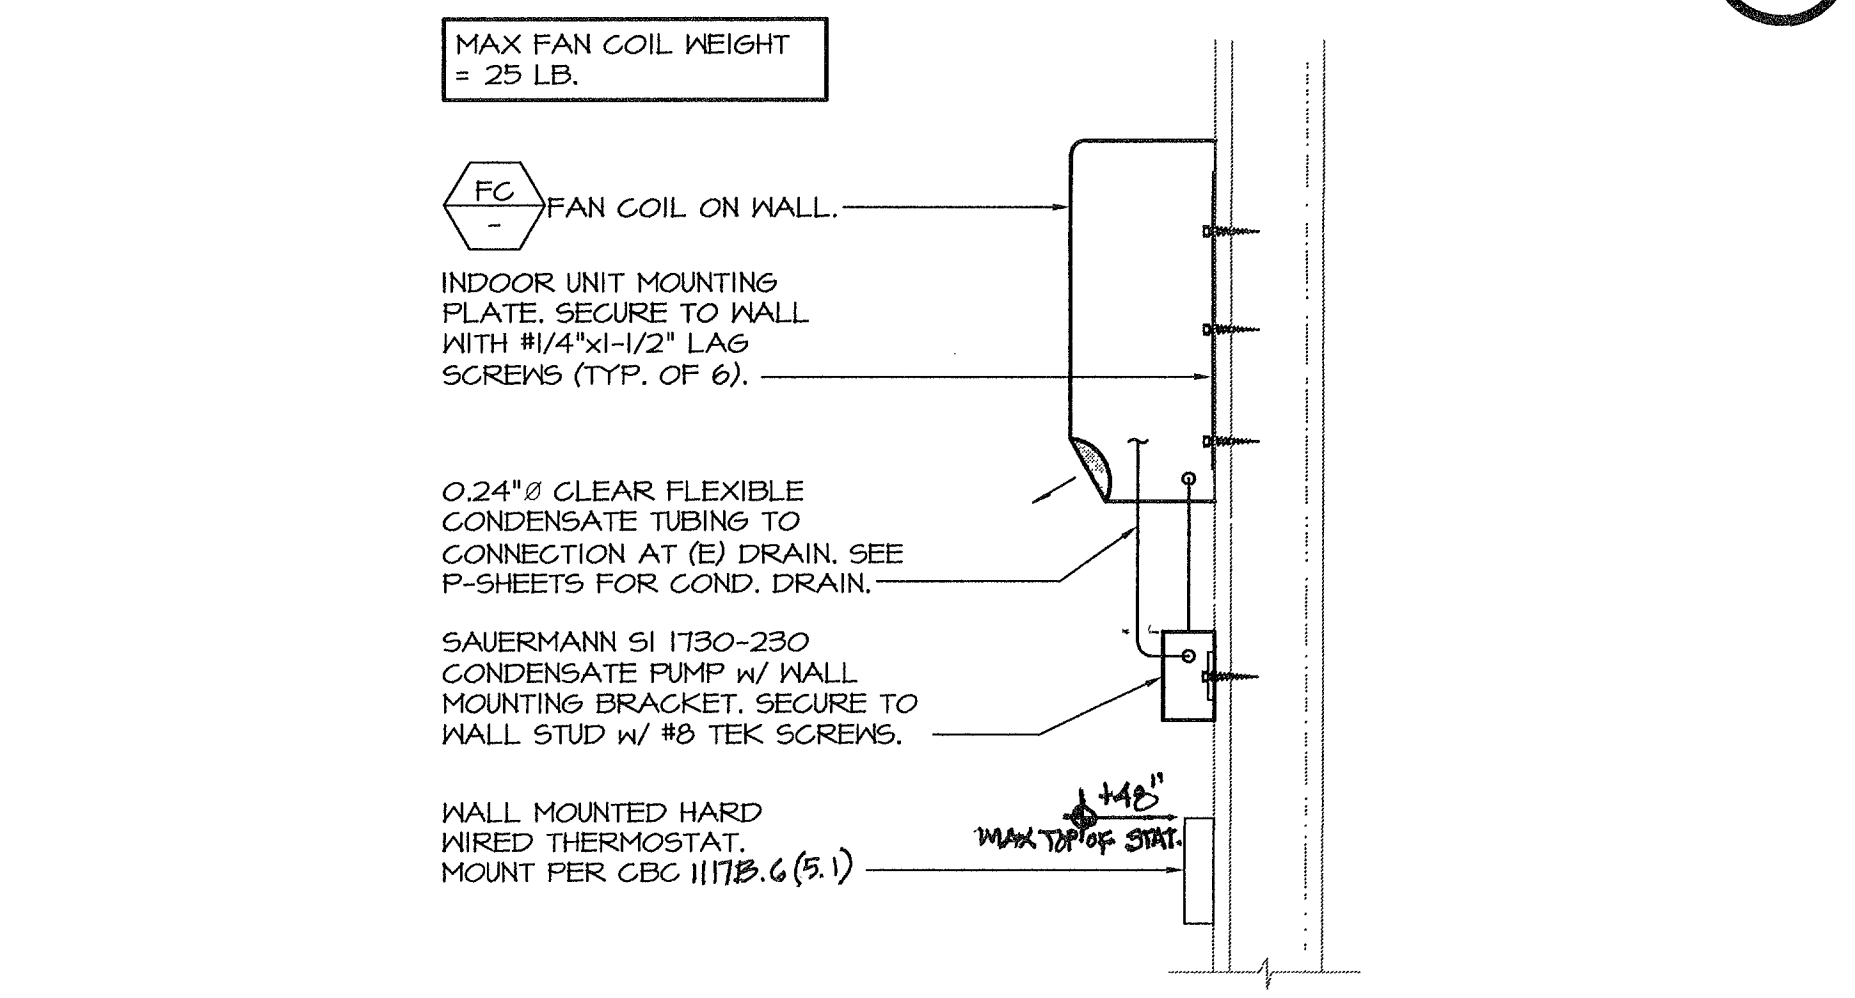

FAN COIL UNIT - WALL CASSETTE (B)

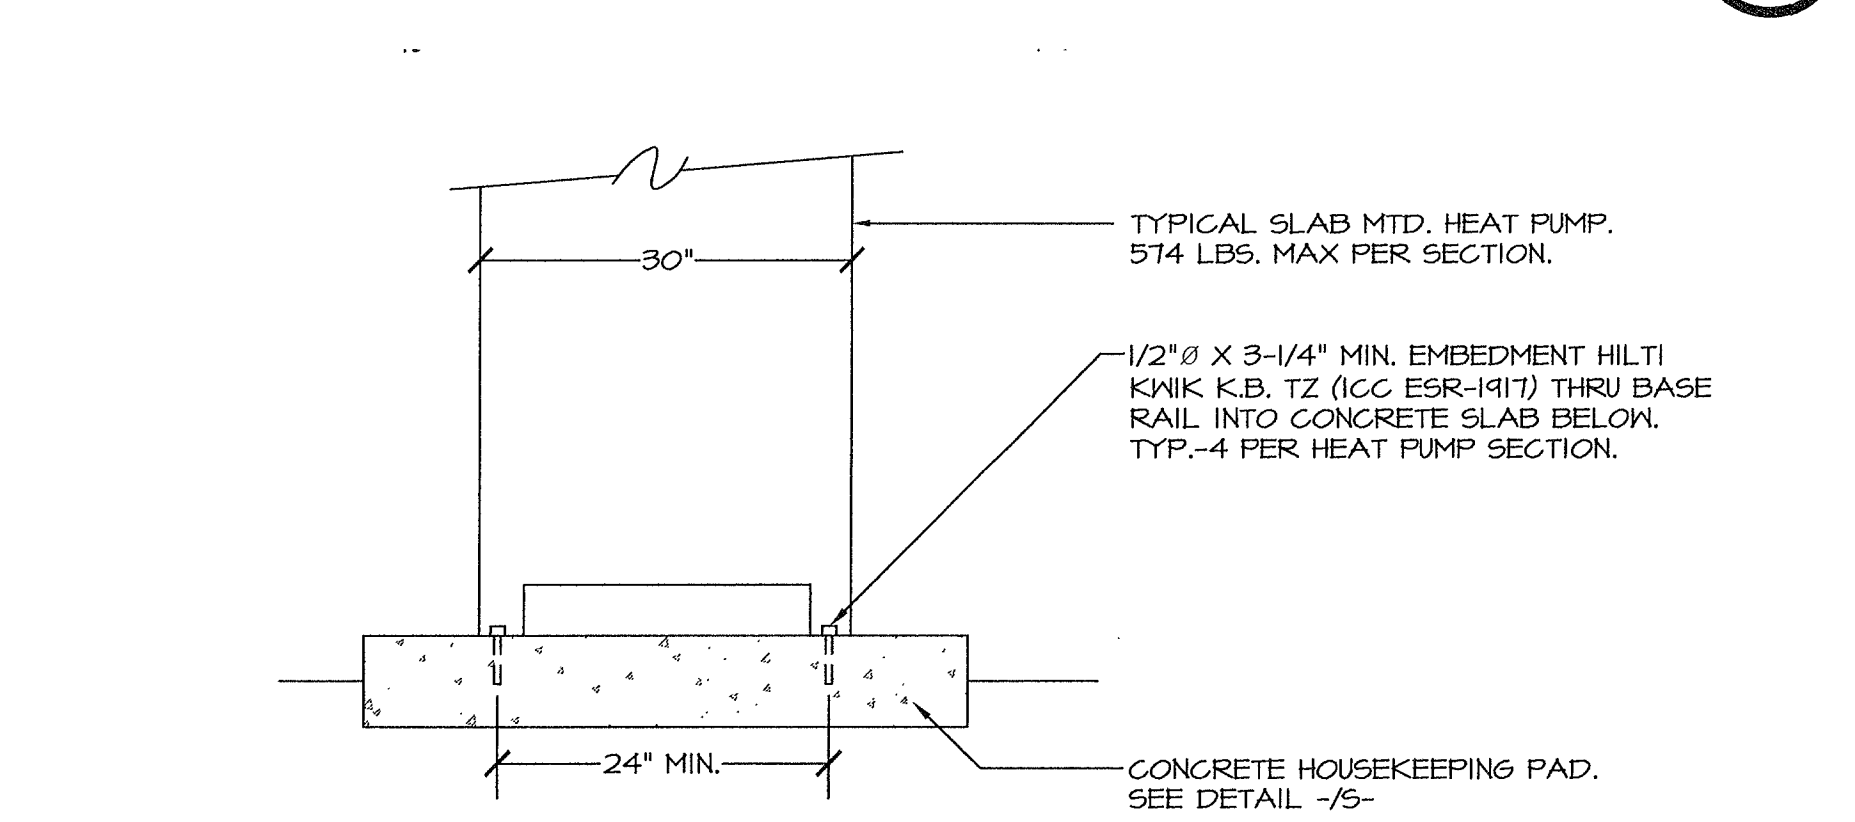

HEAT PUMP ON CONCRETE PAD - CLASSROOM BUILDINGS (C)

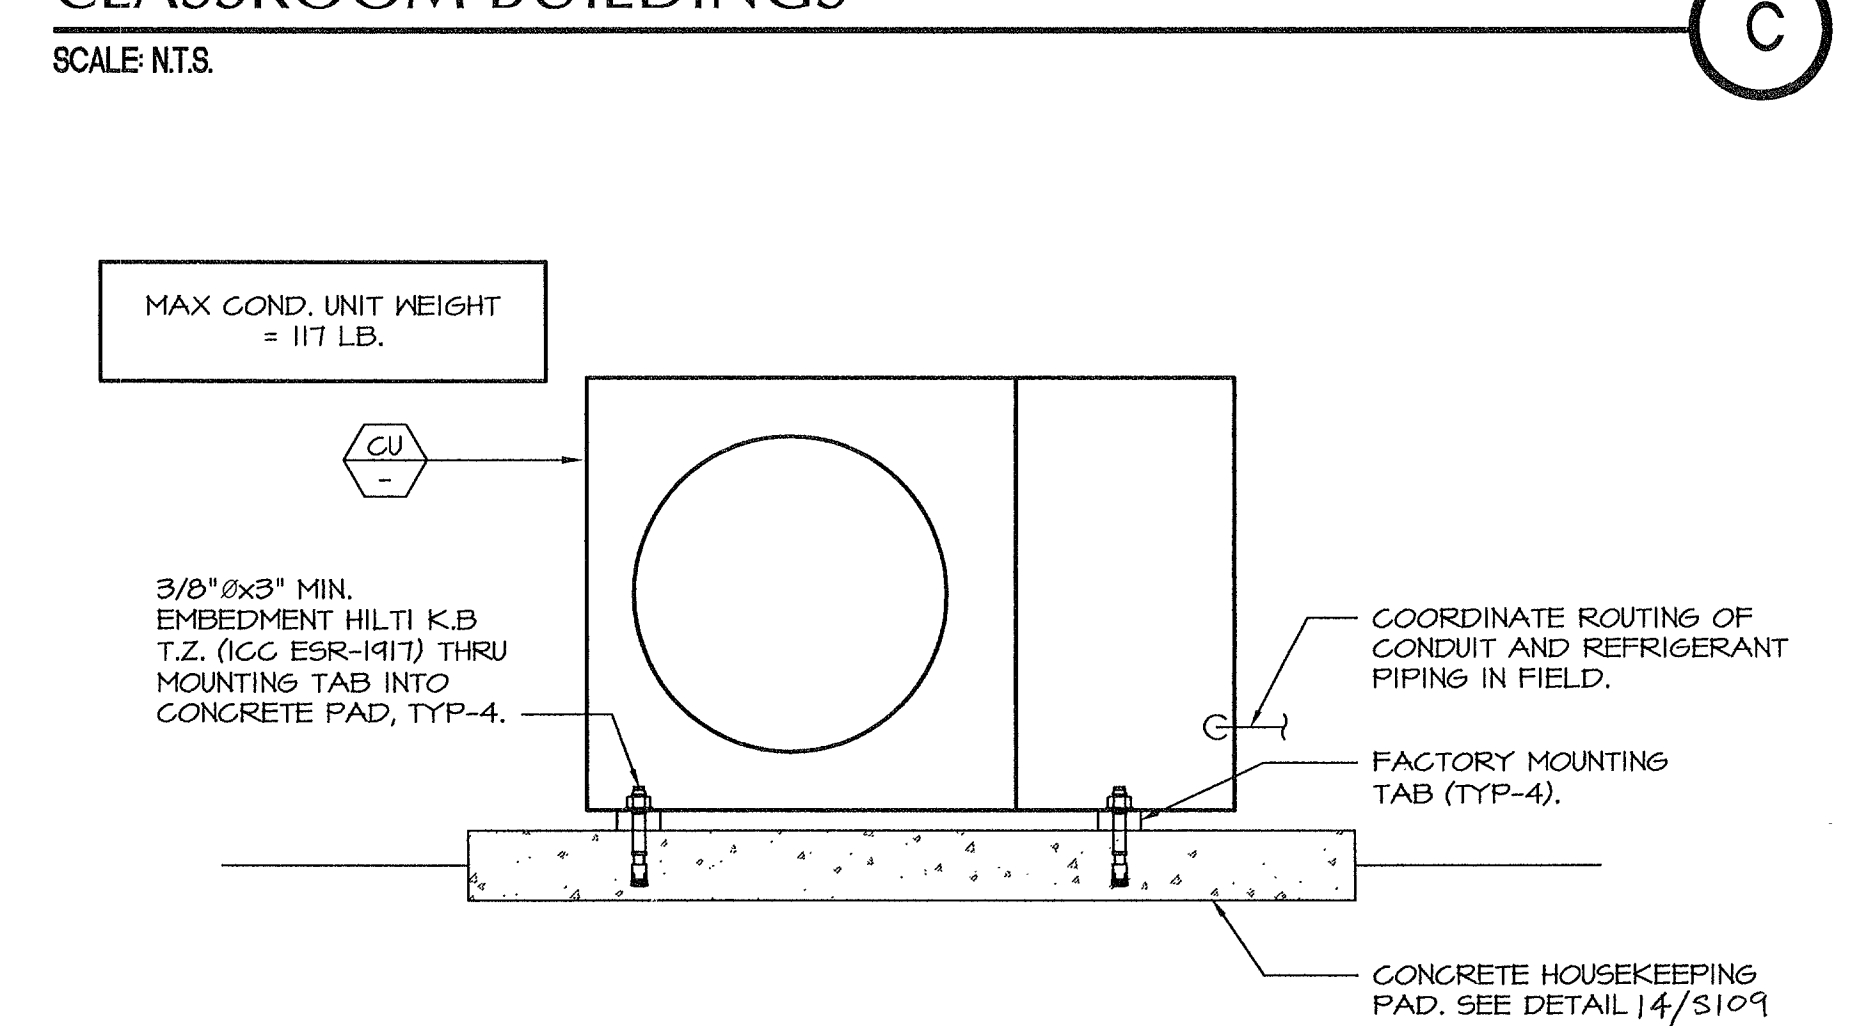

CONDENSING UNIT ON CONCRETE PAD (D)

MARK	DATE	DESCRIPTION
△		
△		
△		
△		