



ARCHITECTS, INC. 5500 MING AVENUE SUITE 280 BAKERSFIELD, CALIFORNIA

LIGHTING PLAN NOTES

1 LUTRON WALL CONTROL STATION #DN-X-WH

RDM Electric - 10/19/12

John Maloney - JMPE - 11/2/12


Workroom lights are on motion sensors.

Reference Sheets E-132C, E-132D, E-132E, E-132F & E-132N
On the Electrical Plans for Buildings C, D, E, F and N, Plan Note #4 calls out for a Lutron
Energi Savr Node #DN-277V-0/10V-WH. In Rooms C110, C111, D110, D111, E110, E111,
F110, F111 and N122, Plan Note #4 is shown next to a motion sensor symbol. Are the lighting
controls in these rooms to be Lutron Energi Savr Nodes or are they to be motion sensors?

2 > LUTRON PHOTO SENSOR #DN-PS-WH

3 > LUTRON MOTION SENSOR #DN-MS-WH

(661) 832-5258

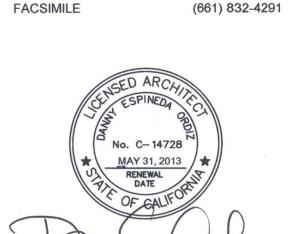

DANNY E. ORDIZ, AIA WILLIAM J. MELBY, AIA ARCHITECT C-16,835

CONSULTANT

IDENTIFICATION STAMP DIVISION OF STATE ARCHITECT OFFICE OF REGULATION SERVICES APPL. #: 02-112027 FILE #: 15-6

NEW ELEMENTARY SCHOOL 9801 HIGHLAND KNOLLS DR **BAKERSFIELD CALIFORNIA**


93306

NEW MIDDLE SCHOOL 4115 VINELAND ROAD BAKERSFIELD **CALIFORNIA** 93306

FOR:

BAKERSFIELD CITY SCHOOL DISTRICT 1300 BAKER STREET **BAKERSFIELD**

CALIFORNIA 93305

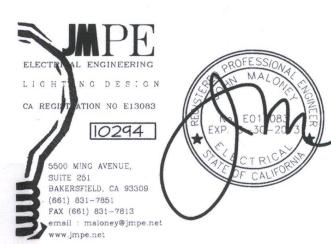

MARK DATE DESCRIPTION

	$ \triangle $			
	\triangle			
	\triangle			
	\triangle			
1	\triangle			
		-		

JOB NUMBER: #PIn

CAD DRAWING FILE: DRAWN BY:

CHECKED BY:

CHECK AND VERIFY ALL DIMENSIONS BEFORE REPORT DESCREPANCIES TO THE ARCHITECT. THE DRAWINGS, IDEAS, AND DESIGNS REPRESENTED ON THIS SHEET ARE THE PROPERTY OF THE ARCHITECT.

ORDIZ-MELBY ARCHITECTS, INC. 2010 SHEET TITLE

LIGHTING PLAN BUILDING C

SHEET IDENTIFICATION NUMBER