




*Danny E. Ordiz*  
DANNY E. ORDIZ, AIA  
ARCHITECT C-14,728  
WILLIAM J. MELBY, AIA  
ARCHITECT C-16,835  
CONSULTANT

IDENTIFICATION STAMP  
DIVISION OF STATE ARCHITECT  
OFFICE OF REGULATION SERVICES  
APPL. # : 02-112027  
FILE # : 15-6  
AC: [Signature] SS: [Signature]  
DATE: 1/18/12

NEW ELEMENTARY SCHOOL  
9801 HIGHLAND KNOLLS DR  
BAKERSFIELD  
CALIFORNIA  
93306

NEW MIDDLE SCHOOL  
4115 VINELAND ROAD  
BAKERSFIELD  
CALIFORNIA  
93306

FOR:  
BAKERSFIELD CITY SCHOOL  
DISTRICT  
1300 BAKER STREET  
BAKERSFIELD  
CALIFORNIA  
93305

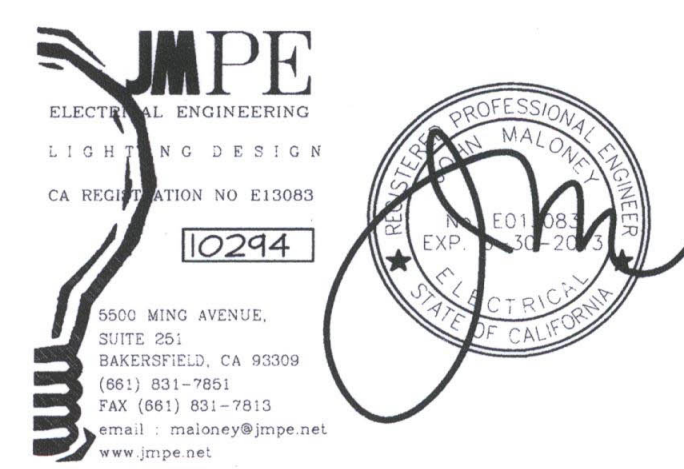

MARK	DATE	DESCRIPTION

JOB NUMBER:  
#P11  
CAD DRAWING FILE:  
DRAWN BY:  
AC  
CHECKED BY:  
PH

CHECK AND VERIFY ALL DIMENSIONS BEFORE  
PROCEEDING WITH THE WORK.  
REPORT DISCREPANCIES TO THE ARCHITECT.


THE DRAWINGS, DEAS, AND DESIGNS  
REPRESENTED ON THIS SHEET ARE THE  
PROPERTY OF THE ARCHITECT.

COPYRIGHT  
ORDIZ-MELBY ARCHITECTS, INC. 2010

SHEET TITLE  
**LIGHTING PLAN  
BUILDING D**  
SHEET IDENTIFICATION NUMBER  
**E-132D**  
SHEET OF

**LIGHTING PLAN NOTES**

- 1 LUTRON WALL CONTROL STATION #DN-X-WH
- 2 LUTRON PHOTO SENSOR #DN-PS-WH
- 3 LUTRON MOTION SENSOR #DN-MS-WH
- 4 LUTRON ENERGI SAVR NODE #DN-27TV-0/10V-WH
- 5 LV CABLE TO ENERGI SAVR NODE
- 6 HOMERUN VIA ENERGI SAVR NODE
- 7 CONNECT SKYLIGHT MOTORIZED SHUTTER
- 8 HOMERUN VIA ENERGI SAVR NODE SWITCH
- 9 LUTRON ENERGI SAVR NODE SWITCH #DN-120V-SW-WH

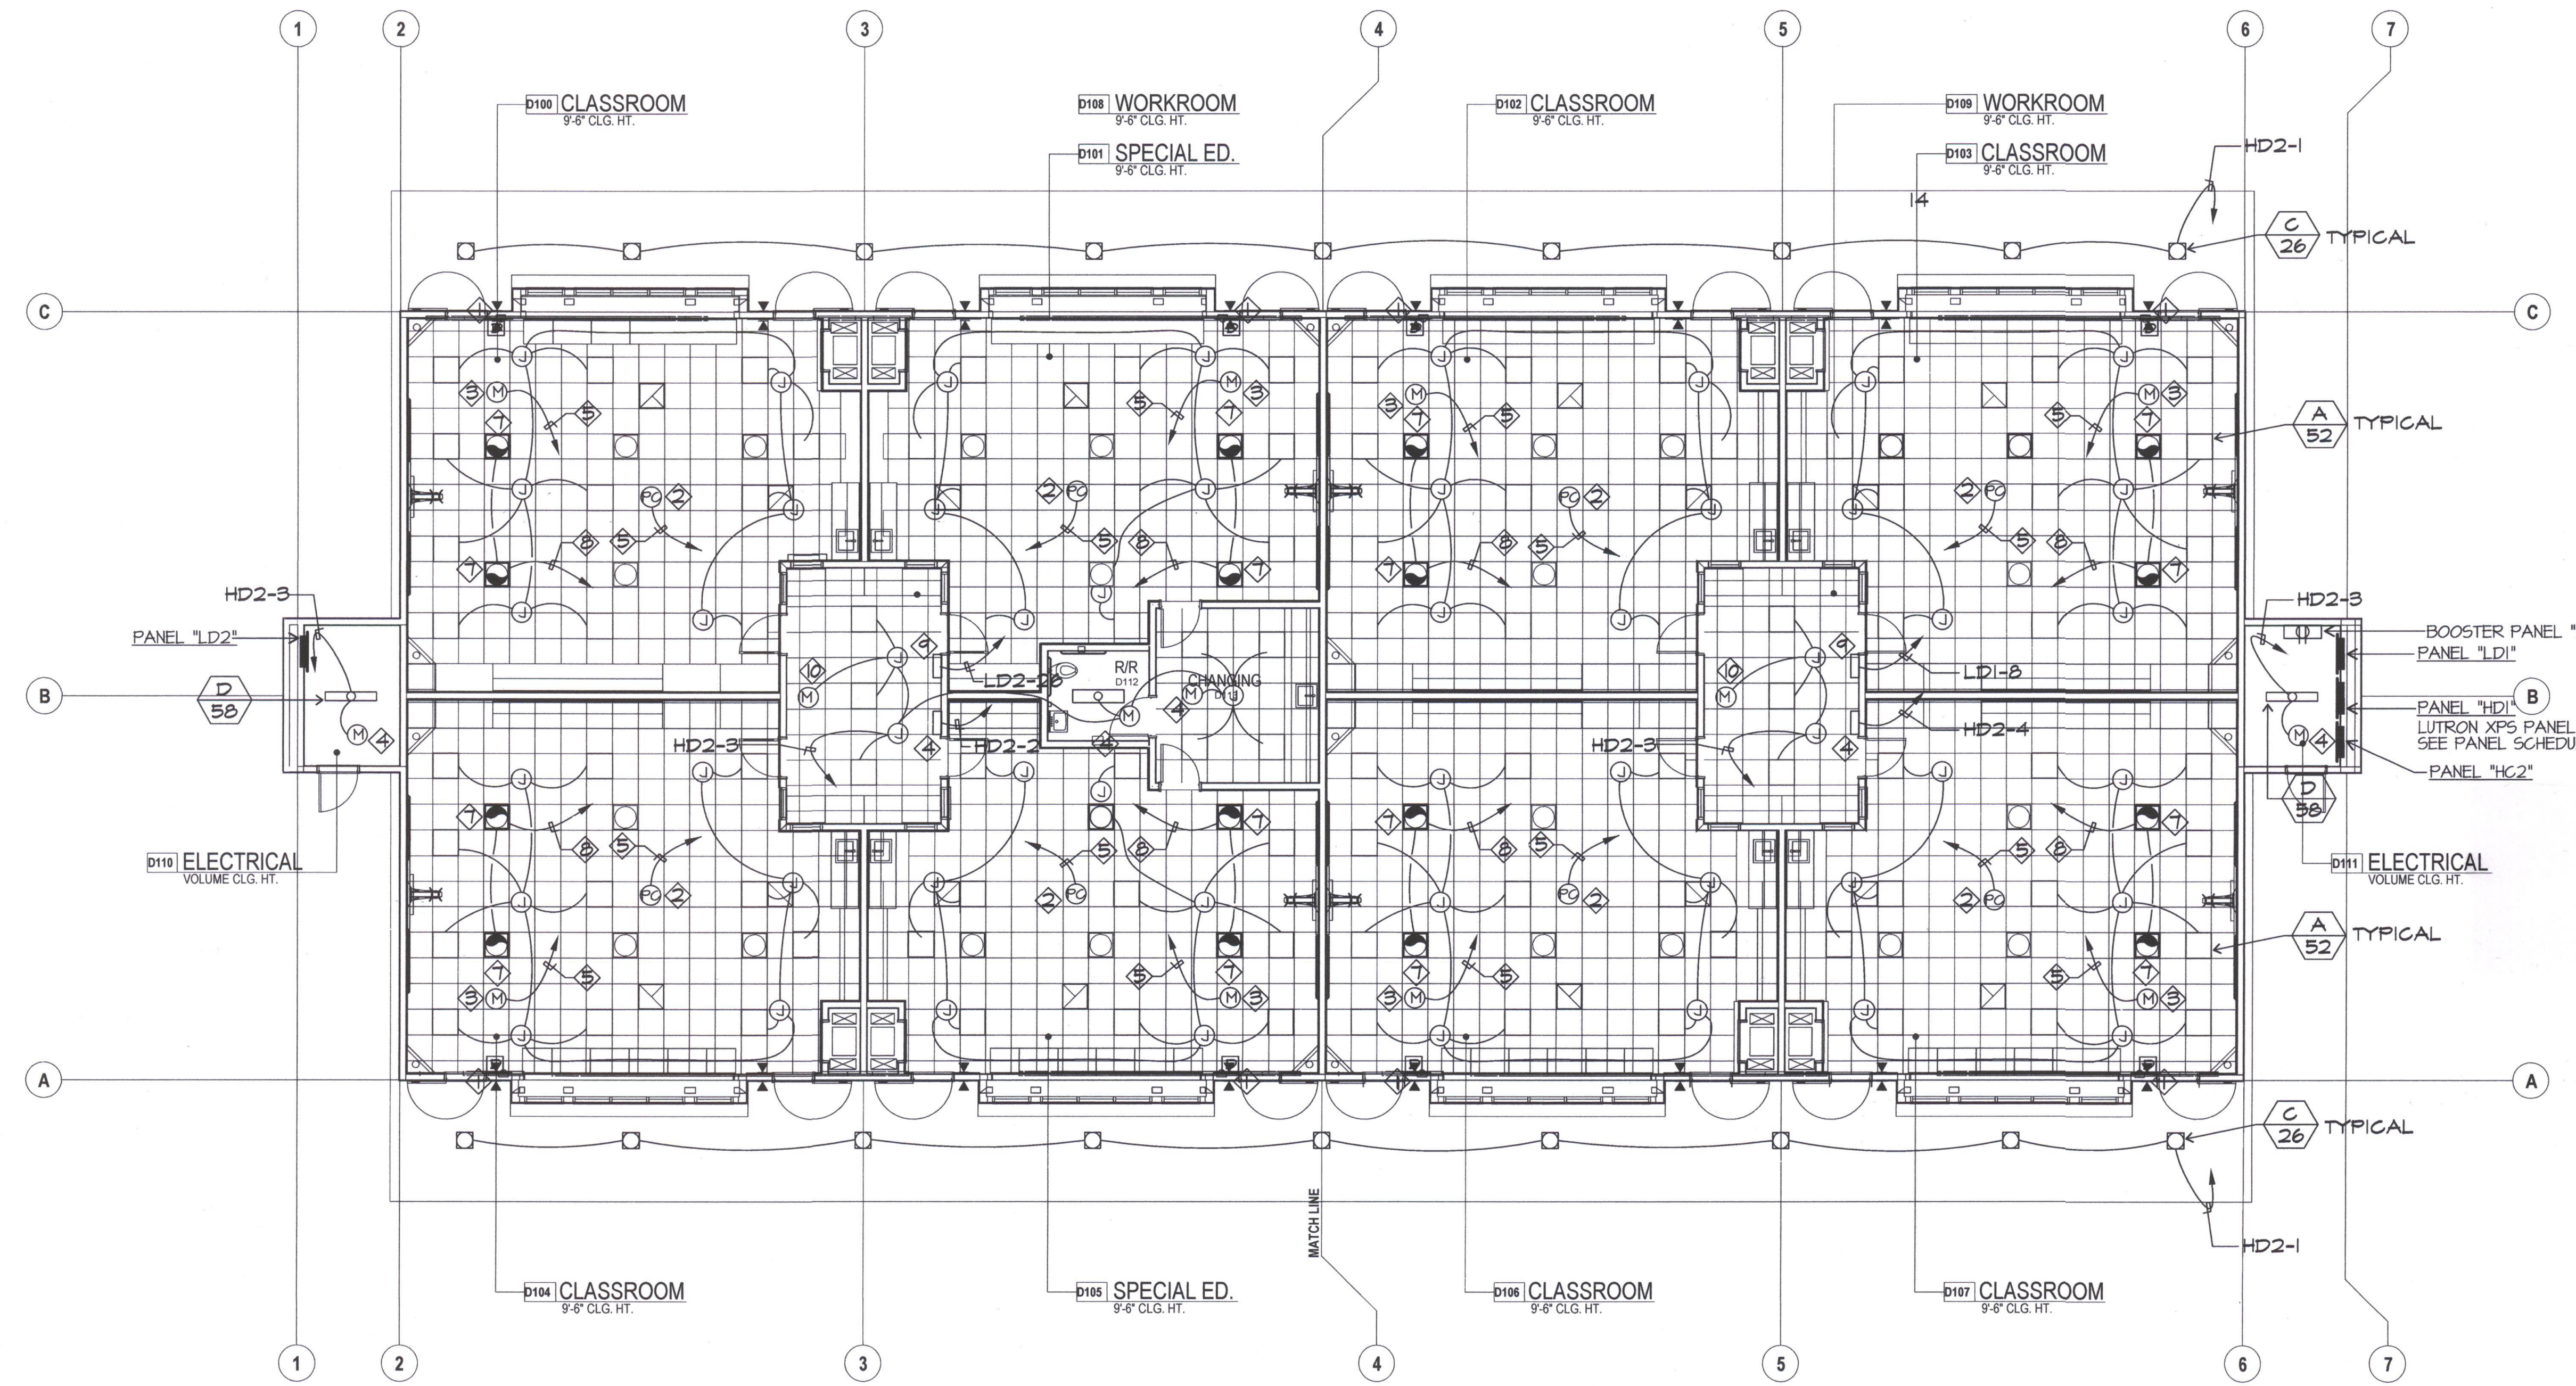

**RFI 163**

Request:  
RDM Electric - 12/9/12  
Reference Sheets E-000, E-132C, E-132D, E-132E, E-132F, E-132G, E-132H, E-132I & Lighting Submittal  
The General Notes on the Electrical Plans show the lighting dimmers to be installed for the lighting at 48" to top of box and the light switches to be installed at 42". A 5 button Lutron wall station is shown to be installed for the lighting controls in the classrooms. Please provide mounting height (elevation) for the classroom lighting control wall stations.

Answer:  
Joseph W. Covington - Ordiz-Melby (12/12/12)  
Install all switches and dimmers at 42" to the center of the box.

**RFI 241**

Request:  
RDM Electric - 1/3/13  
Reference Sheets A131D & E132D  
The Electrical Plan for Building D shows (4) Type A light fixtures, which are 2x2 linear fixtures, to be installed in Room D113. The Architectural Plan for Building D shows (4) 1x4 light fixtures to be installed in a hard ceiling in Room D113. Should these (4) light fixtures in Room D113 be Type D and not Type A? Please advise.

Answer:  
Ed Smith - OMA - 1/3/13  
All ceilings in Special Ed restrooms and changing rooms are hard ceilings, therefore, all fixtures in Special Ed restrooms and changing rooms are to be Type D surface mount.

**RFI 376**

RDM Electric - 9/18/13  
Reference RFI #292 & Sheets E132C, E132D, E132E, E132F, E132G, E132H, E132I, E132J & E132K  
For the response to RFI #292, the schedules in the classrooms are to be controlled via an Energi Savr Node. However, per the attached cut sheets, the schedules appear to need separate DC switching to be controlled, which is not shown on the drawings. The plan only shows to supply 120V to the schedules via the Energi Savr Node. Do the classrooms need DC switching to be added as a means of controlling the schedules? If so, please advise on the requirements.

John Heston - JMPE - 9/18/13  
Contact classroom on Energi Savr Node will operate schedule shutter. We verified this with Substube and Lutron.

LIGHTING PLAN BUILDING D

