


IDENTIFICATION STAMP
DIVISION OF STATE ARCHITECTS
OFFICE OF REGULATION SERVICES
APPL. # : 02-112027
FILE # : 15-6
AC: [Signature]
DATE: 11/9/12

NEW ELEMENTARY SCHOOL
9801 HIGHLAND KNOLLS DR
BAKERSFIELD
CALIFORNIA
93306
NEW MIDDLE SCHOOL
4115 VINELAND ROAD
BAKERSFIELD
CALIFORNIA
93306

FOR:
BAKERSFIELD CITY SCHOOL DISTRICT
1300 BAKER STREET
BAKERSFIELD
CALIFORNIA
93305

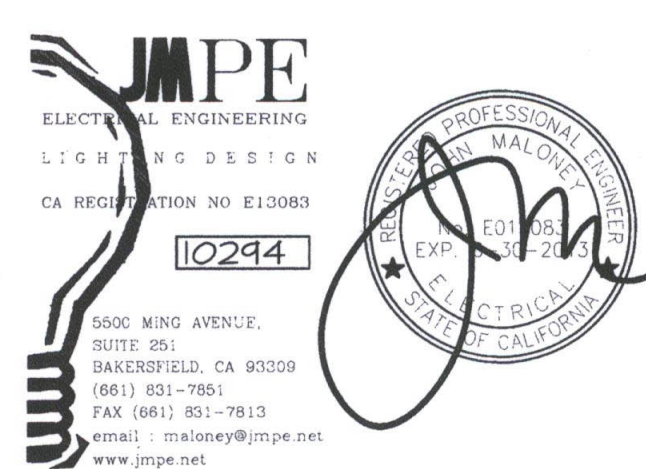

MARK	DATE	DESCRIPTION
△		
△		
JOB NUMBER:
20101244
CAD DRAWING FILE:
DRAWN BY:
AC
CHECKED BY:
PH
CHECK AND VERIFY ALL DIMENSIONS BEFORE
PROCEEDING WITH THE WORK.
REPORT DISCREPANCIES TO THE ARCHITECT.
THE DRAWINGS, IDEAS, AND DESIGNS
PRESENTED ON THIS SHEET ARE THE
PROPERTY OF THE ARCHITECT.
COPYRIGHT
ORDIZMELBY ARCHITECTS, INC. 2010
SHEET TITLE
LIGHTING PLAN
BUILDING E
SHEET IDENTIFICATION NUMBER
E-132E
SHEET OF

- LIGHTING PLAN NOTES**
- 1 LUTRON WALL CONTROL STATION #DN-X-WH
 - 2 LUTRON PHOTO SENSOR #DN-PS-WH
 - 3 LUTRON MOTION SENSOR #DN-MS-WH
 - 4 LUTRON ENERGI SAVR NODE #DN-27V-0/10V-WH
 - 5 LV CABLE TO ENERGI SAVR NODE
 - 6 HOMERUN VIA ENERGI SAVR NODE
 - 7 CONNECT SKYLIGHT MOTORIZED SHUTTER
 - 8 HOMERUN VIA ENERGI SAVR NODE SWITCH
 - 9 LUTRON ENERGI SAVR NODE SWITCH #DN-120V-SW-WH
 - 10 SENSOR SWITCH #CMR-PDT-277


RFI 163

Request:
RDM Electric - 10/9/12
Reference Sheets E-000, E-132C, E-132D, E-132E, E-132F, E-132G, E-132H, E-132P & Lighting Submittal
The General Notes on the Electrical Plans show the lighting dimmers to be installed for the lighting at +42" to top of box and the light switches to be installed at +42". A 5-button Lutron wall station is shown to be installed for the lighting controls in the classrooms. Please provide mounting height (elevations) for the classroom lighting control wall stations.

Answer:
Joseph W. Covington - Ordiz Melby (10/12/12)
Install all switches and dimmers at +42" to the center of the box.

RFI 163
RDM Electric - 9/18/13
Reference RFI #202 & Sheets E-132C, E-132D, E-132E, E-132F, E-132G, E-132H, E-132P & E-132Q
For the response to RFI #202, the switches in the classrooms are to be controlled via an Energi Savr Node. However, per the attached cut sheets, the switches appear to need separate O.C. switching to the controls, which is not shown on the drawings. The plans only show to supply 120V to the switches via the Energi Savr Nodes. Do the classrooms need O.C. switching to be added as a means of controlling the switches? If so, please advise on the requirements.

John Maloney - JMPE - 9/18/13
Contact closure on Energi Savr Node will operate skylight shutter. We verified this with Submittal and Lutron.

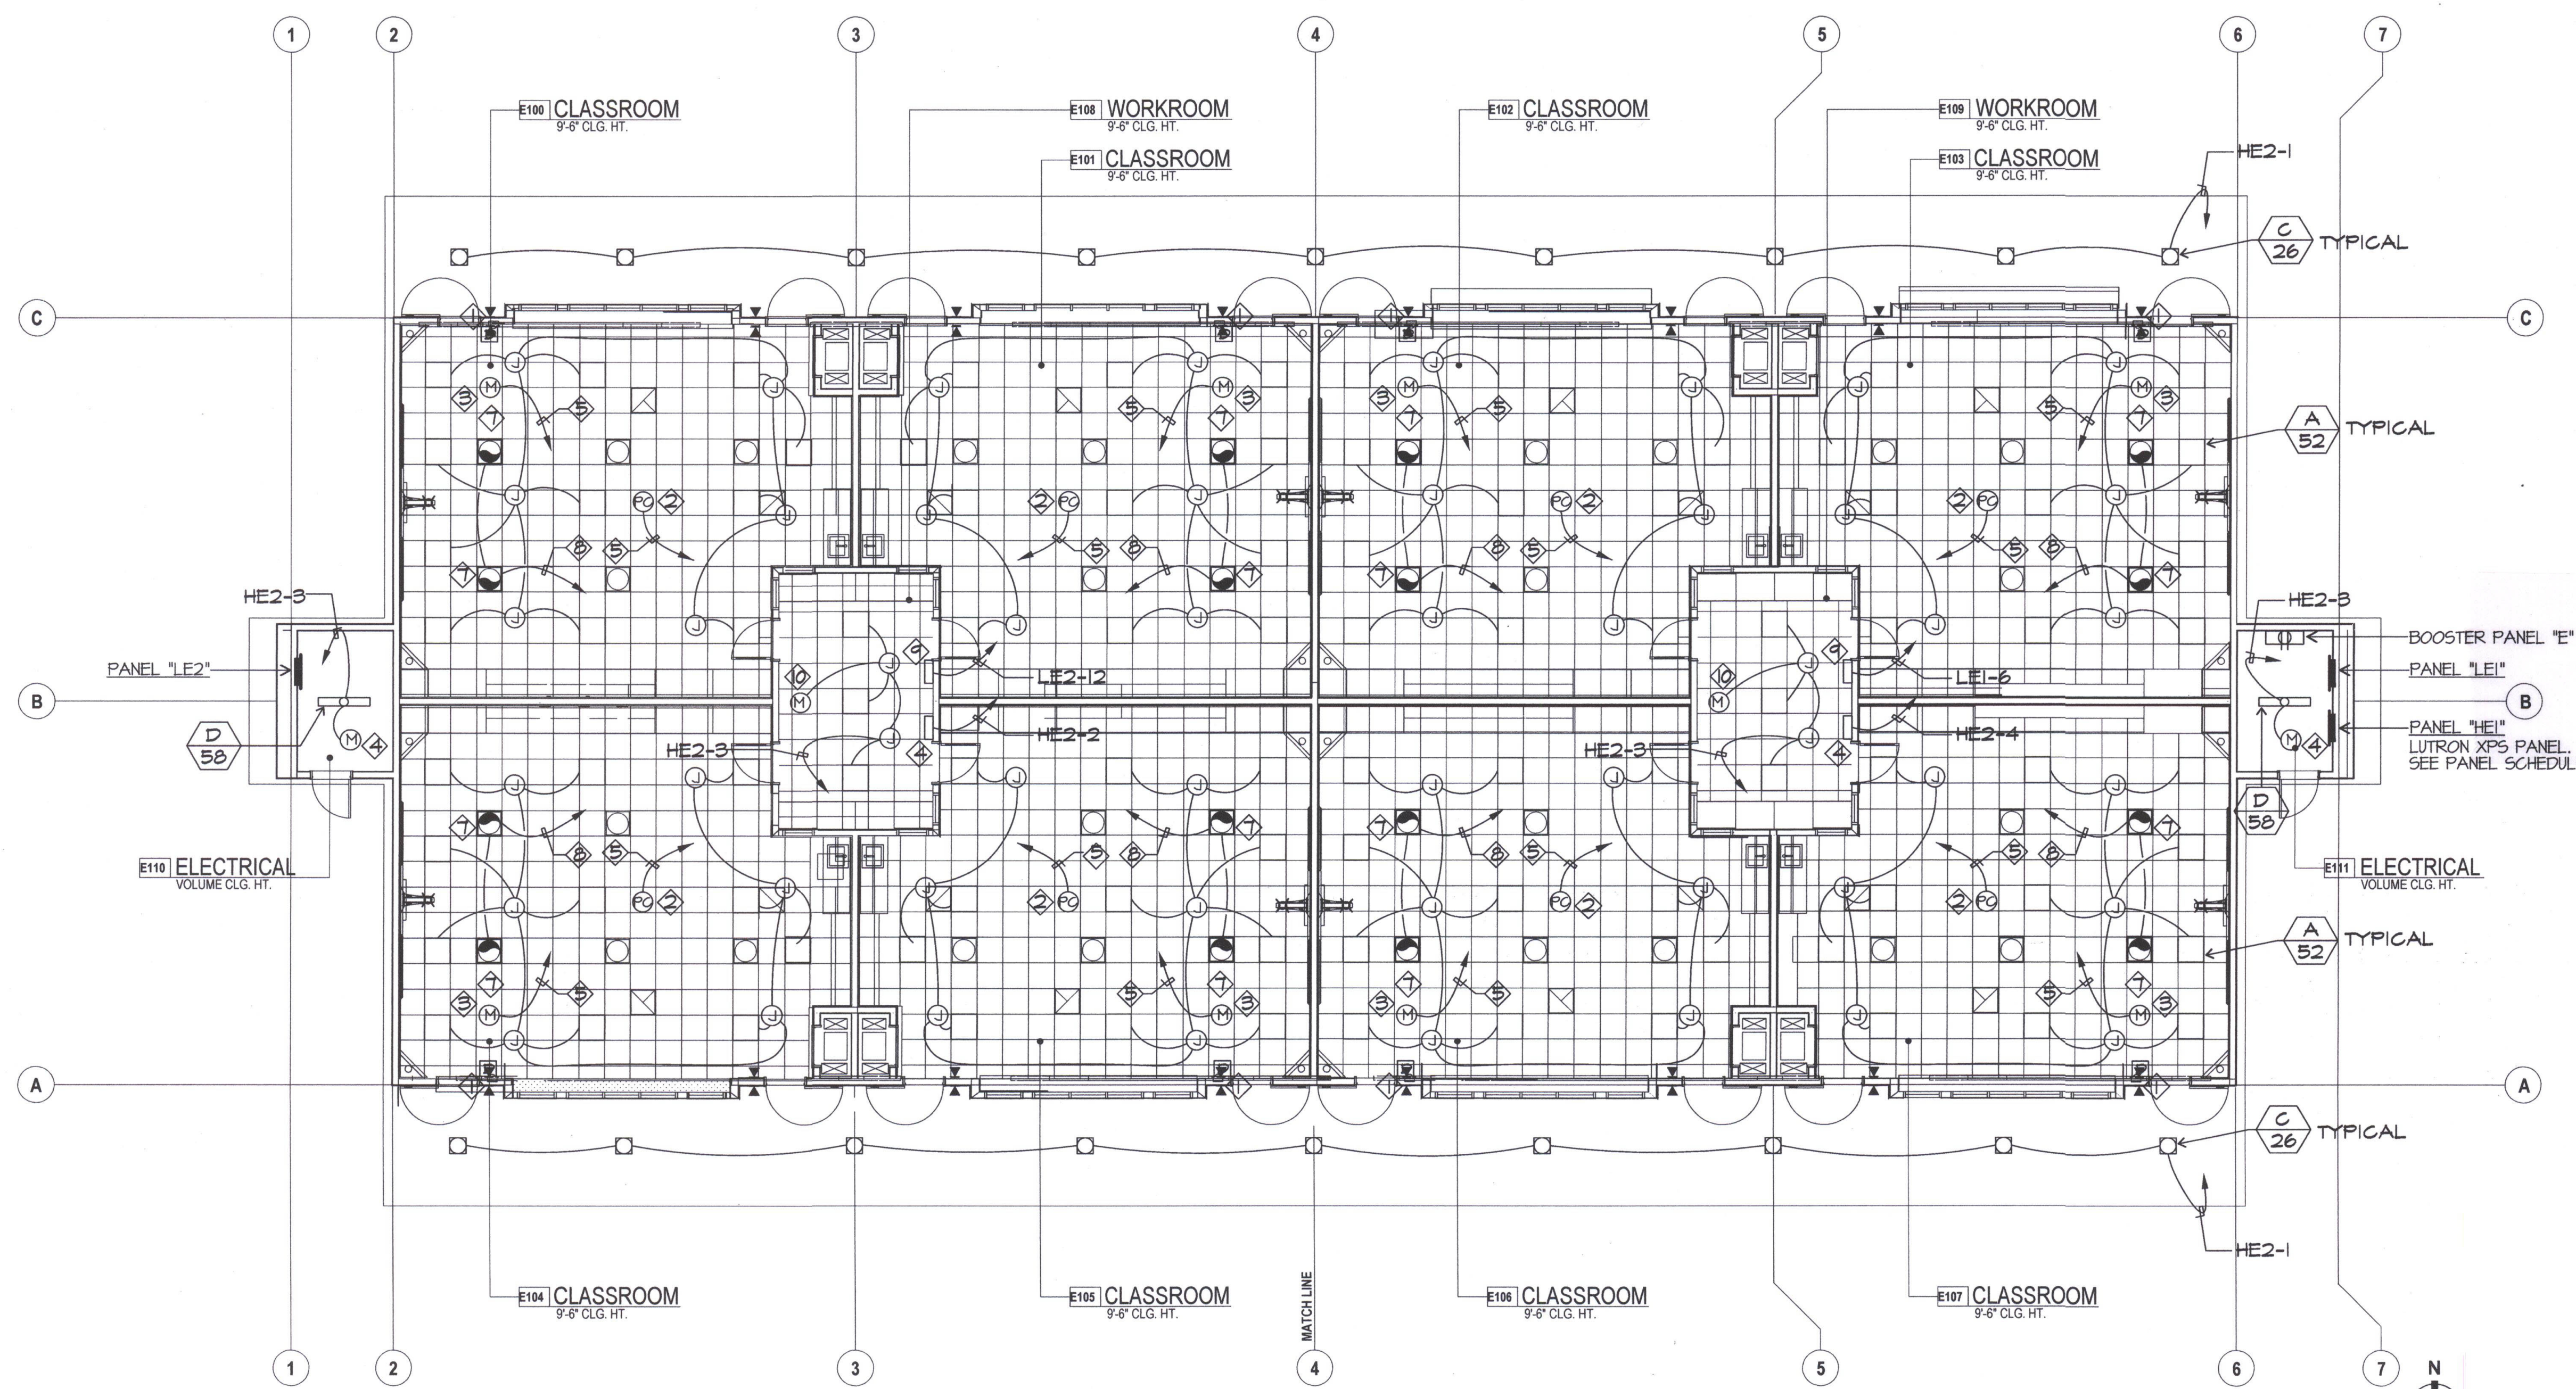

LIGHTING PLAN BUILDING E

SCALE: 1/8" = 1'-0"