




*Danny E. Ordiz*  
DANNY E. ORDIZ, AIA  
ARCHITECT C-14,728  
WILLIAM J. MELBY, AIA  
ARCHITECT C-16,835  
CONSULTANT

IDENTIFICATION STAMP  
DIVISION OF STATE ARCHITECT  
OFFICE OF REGULATION SERVICES  
APPL. # : 02-112027  
FILE # : 15-6  
AC: [Signature] SS: [Signature]  
DATE: 11/8/12

NEW ELEMENTARY SCHOOL  
9801 HIGHLAND KNOLLS DR  
BAKERSFIELD  
CALIFORNIA  
93306

NEW MIDDLE SCHOOL  
4115 VINELAND ROAD  
BAKERSFIELD  
CALIFORNIA  
93306

FOR:  
BAKERSFIELD CITY SCHOOL  
DISTRICT  
1300 BAKER STREET  
BAKERSFIELD  
CALIFORNIA  
93305

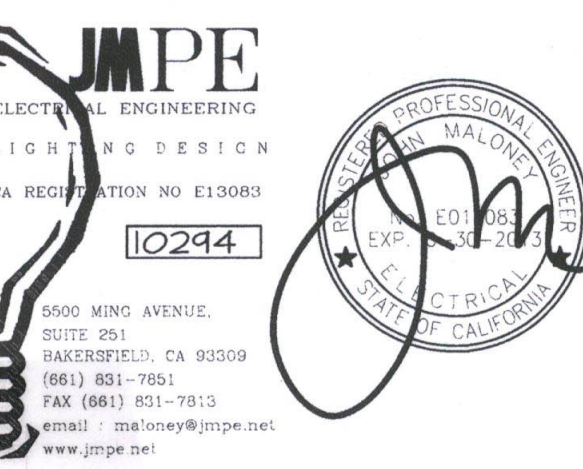


MARK	DATE	DESCRIPTION
△		
△		
△		
△		

JOB NUMBER:  
20101244  
CAD DRAWING FILE:  
DRAWN BY:  
AC  
CHECKED BY:  
PH  
CHECK AND VERIFY ALL DIMENSIONS BEFORE  
PROCEEDING WITH THE WORK.  
REPORT DISCREPANCIES TO THE ARCHITECT.  
THE DRAWINGS, IDEAS, AND DESIGNS  
REPRESENTED ON THIS SHEET ARE THE  
PROPERTY OF THE ARCHITECT.  
COPYRIGHT  
ORDIZ MELBY ARCHITECTS, INC. 2010  
SHEET TITLE  
**LIGHTING PLAN  
BUILDING G**

SHEET IDENTIFICATION NUMBER  
**E-132G**  
SHEET OF

**LIGHTING PLAN NOTES**

- 1 LUTRON WALL CONTROL STATION #DN-X-WH
- 2 LUTRON PHOTO SENSOR #DN-PS-WH
- 3 LUTRON MOTION SENSOR #DN-MS-WH
- 4 LUTRON ENERGI SAVR NODE #DN-277V-0/10V-WH
- 5 LV CABLE TO ENERGI SAVR NODE
- 6 HOMERUN VIA ENERGI SAVR NODE
- 7 CONNECT SKYLIGHT MOTORIZED SHUTTER
- 8 HOMERUN VIA ENERGI SAVR SWITCH
- 9 LUTRON ENERGI SAVR NODE SWITCH #DN-120V-SW-WH
- 10 SENSOR SWITCH #CMR-PDT-277
- 11 0-10V WALL BOX DIMMER, LUTRON #DVSCVT-WH

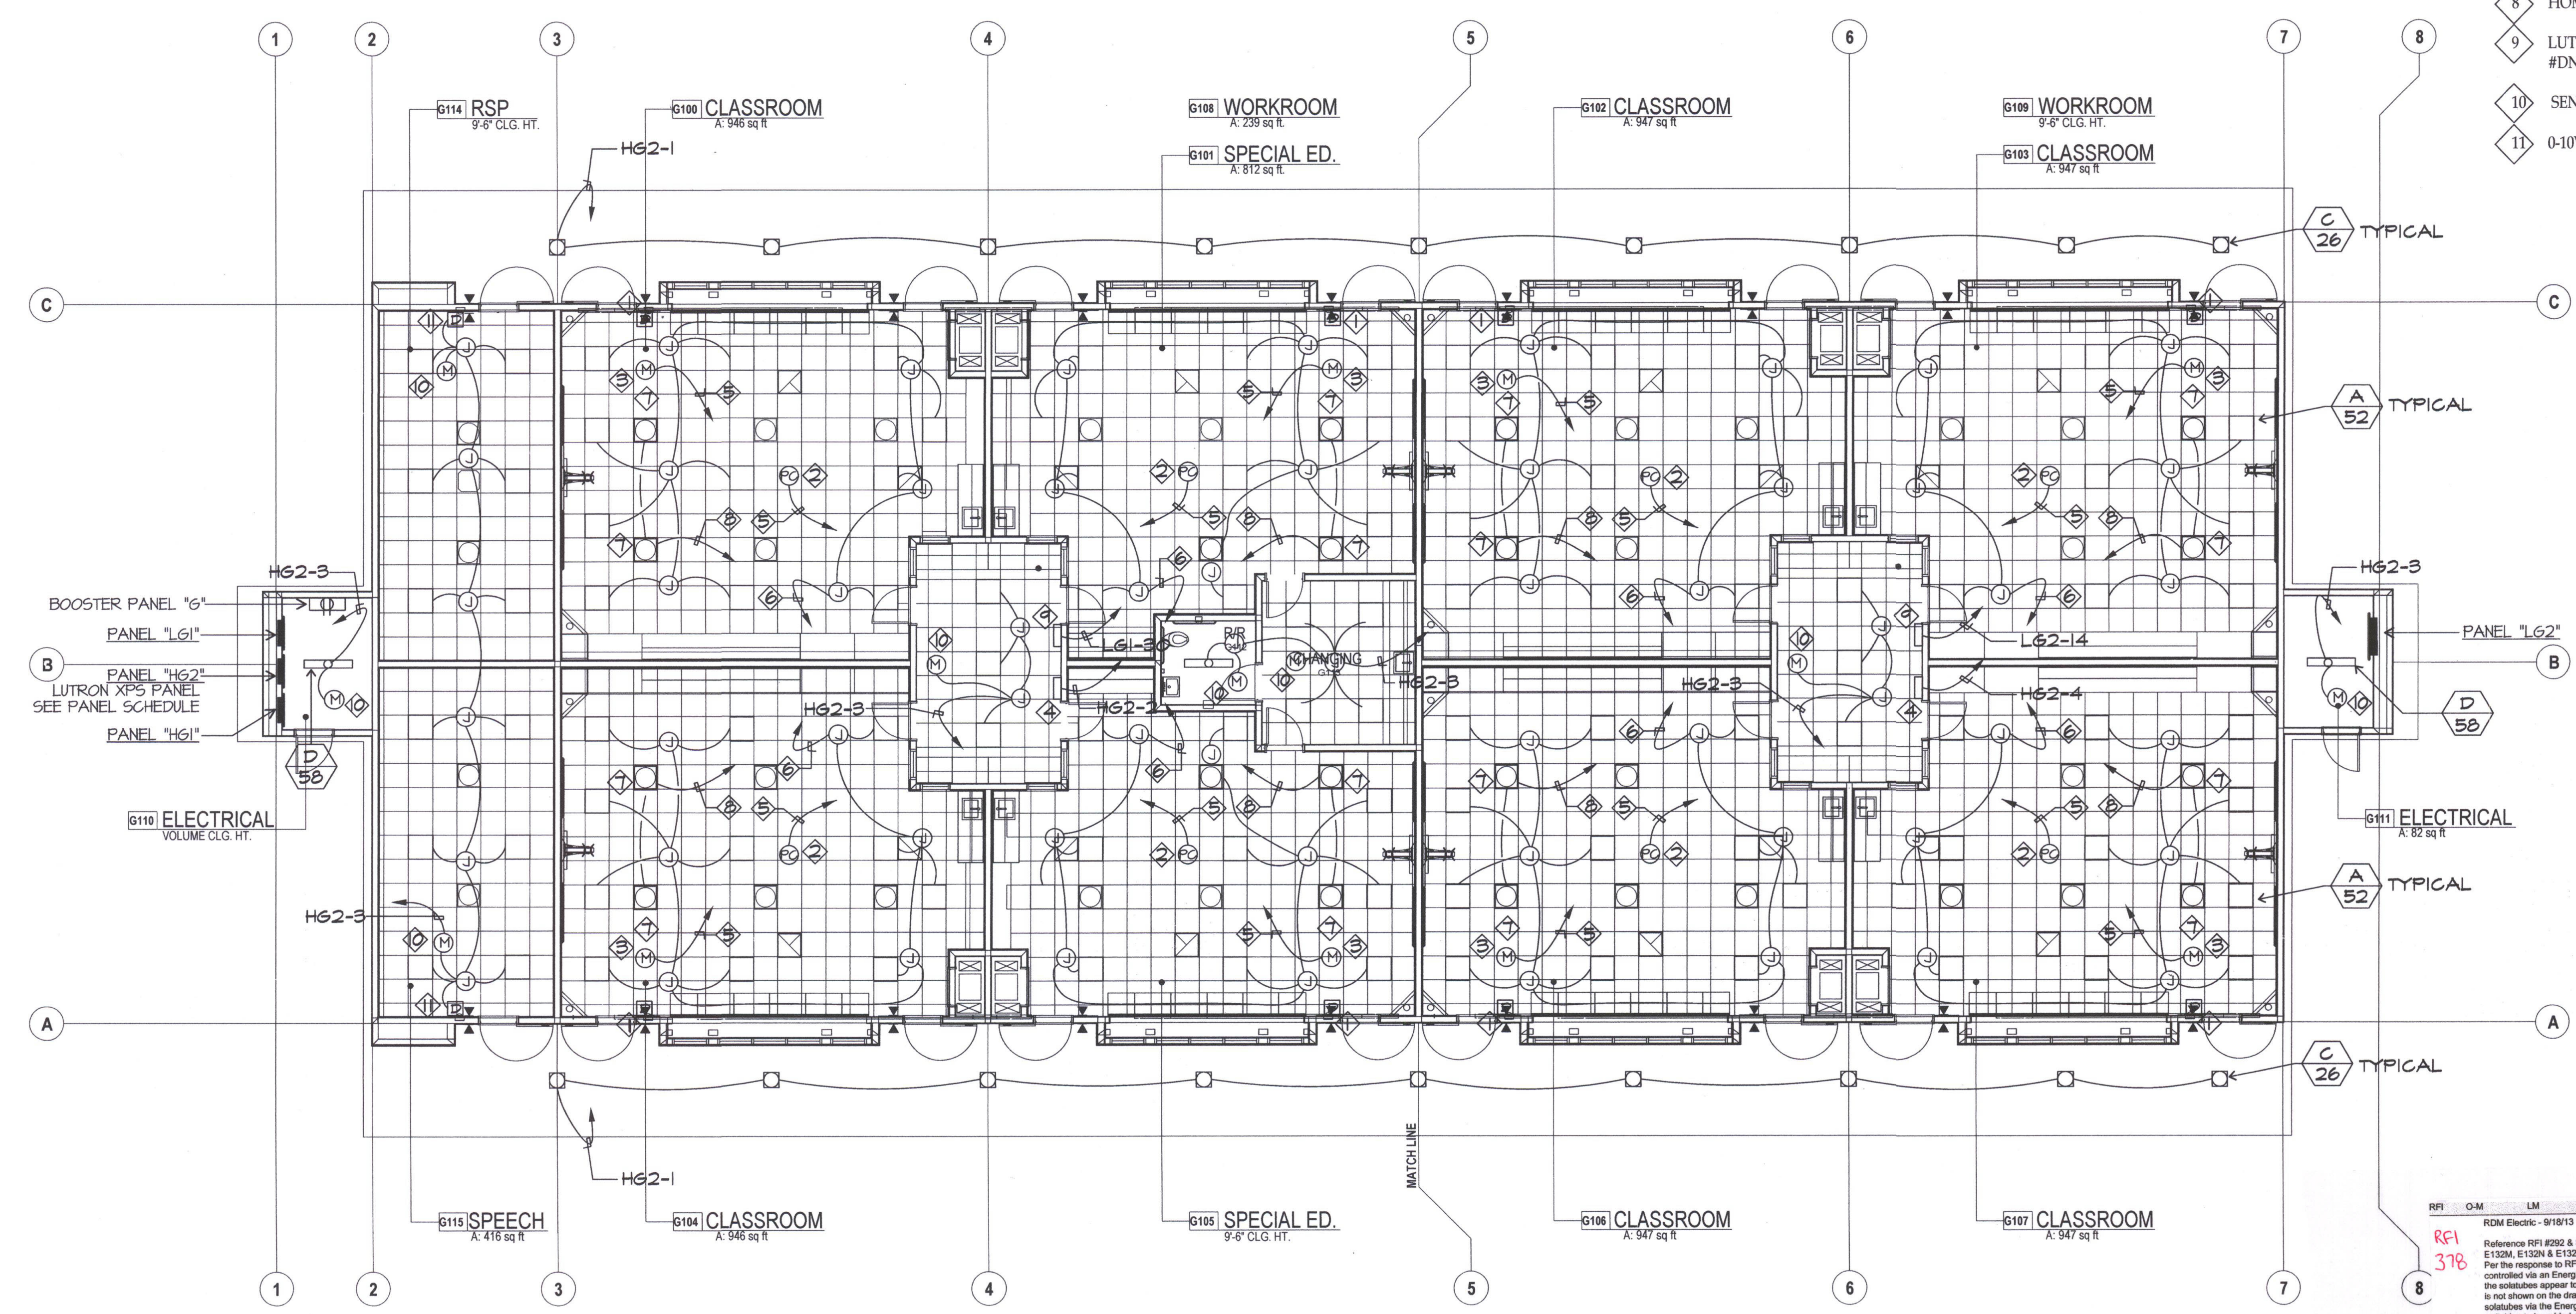

**RFI 163**

Request:  
RDM Electric - 10/9/12  
Reference Sheets E-100, E-132C, E-132D, E-132E, E-132F, E-132G, E-132H, E-132I, E-132J, E-132K, E-132L, E-132M, E-132N, E-132P & Lighting Submittal  
The General Notes on the Electrical Plans show the lighting dimmers to be installed for the lighting at 44" to top of box and the light switches to be installed at 42". A 5-Button Lutron wall station is shown to be installed for the lighting controls in the classrooms. Please provide mounting height (levation) for the classroom lighting control wall stations.

Answer:  
Joseph W. Covington - Ordiz Melby (10/11/12)  
Install all switches and dimmers at 42" to the center of the box.


**RFI 332**

Totomark Builders - 9/17/13  
Reflected Ceiling Plans at Buildings D & G Classrooms do not show the same Skylight Control quantities as that which are shown on Electrical Drawings Sheet E-131D and E-130J. Our Submittal submission was based on the design details shown on the Reflected Ceiling Plans. Please advise.

Joe Covington - OMA - 9/17/13  
After review of Architectural Plans it has been determined that the Building D and G refer to one Classroom in Building D100 as "TYPICAL MIDDLE SCHOOL" classroom.  
The Reflected ceiling plan for this one classroom indicates the dimmer provided for the skylights as required for the "TYPICAL MIDDLE SCHOOL" classroom.  
Whether or not they are shown on other reflected ceiling plans should have raised the question prior to bid.  
The fact that the Electrical documents indicate the required electrical connections to be provided for all the locations considered TYPICAL should also have raised the question concerning which skylights are provided with dimmers shown all documents are to be reviewed and coordinated prior to bid.  
Elementary and Middle rooms were designed with the same exact same layout and amenities, and no statements providing direction of EXCEPTIONS was provided for this use.  
Any questions regarding discrepancies or requests for clarification should have been submitted prior to bid.

RFI 378  
RDM Electric - 9/18/13  
Reference RFI #202 & Sheets E-132C, E-132D, E-132E, E-132F, E-132G, E-132H, E-132I & E-132P  
Per the response to RFI #202, the submittals in the classrooms are to be controlled via an Energi Savr Node. However, per the attached cut sheets, the submittals appear to need separate DC switching to be controlled, which is not shown on the drawings. The plans only show to supply 120V from the submittals via the Energi Savr Nodes. Do the classrooms have DC switching to be added as a means of controlling the submittals? If so, please advise on the requirements.  
Contact closure on Energi Savr Node will operate submittal shutter. We verified this with Totomark and Lutron.  
John Moberly - JMPE - 9/19/13

LIGHTING PLAN BUILDING G

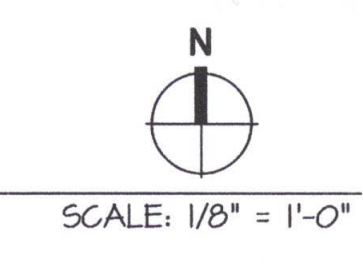

TEL: 08/10/2014 DATE: 12-14-11 AC