| CERTIFICATE OF COMP FIELD INSPECTION EN | | • | Part 1 of 4) |) | MECH-10 |
|--|---|---|---------------|------------|---|
| Project Name BCSD School Bld F Classrooms | MOI OILON | | | | Date 1/5/2012 |
| Project Address | | Climate Zone | Total Cond. | Floor Area | Addition Floor Are |
| Bakersfield | | 13 | 8,3 | n/a | |
| GENERAL INFORMATION | | | | | |
| Building Type: 🔯 No | nresidential | ☐ High-Rise Resider | itial 🗀 Ho | | luest Room |
| ☐ Schools (Public School) ☐ Re | ocatable Public Schoo | Bldg. 🖾 Conditione | ed Spaces - f | ☐ Uncon | ditioned Spaces |
| Phase of Construction | w Construction | ☐ Addition | □ Alt | eration | • |
| | mponent | Overall Envelope | TDV 🖂 Un | conditione | d (file affidavit) |
| | | Energy | | | ,, |
| Front Orientation N. E, S W or in Degree | ees: 0 deg | | | | #51/61/E51/1/10 |
| HVAC SYSTEM DETAILS | | | | | RGY CHECKLIS |
| | | and the second | | · | equirements escribe Reason |
| Equipment ² Item or System Tags | Inspec | tion Criteria | Pass | ran - D | |
| (i e. AC-1, RTU-1, HP-1) | CU/FC F-1, 2 | | | | |
| Equipment Type ³ : | Split DX | | | | |
| Number of Systems | 2 | | | | |
| Max Allowed Heating Capacity ¹ | 18,000 Btu/hr | | | | |
| Minimum Heating Efficiency ¹ | n/a | **** | | | |
| Max Allowed Cooling Capacity ¹ | 15,000 Btu/hr | | | | |
| Cooling Efficiency ¹ | 16.0 SEER / 13.0 | EER | <u> </u> | | |
| Duct Location/ R-Value | n/a | | | ļ | |
| When duct testing is required, submit MECH-4A & MECH-4-HERS | No | | | | |
| Economizer | No Economizer | | | İ | Ö |
| Thermostat | Setback Required | | | | |
| Fan Control | Constant Volume | *************************************** | | | |
| | | | FIELD INSPEC | TION ENE | RGY CHECKLIS |
| Equipment ² | Inspec | tion Criteria | Pass | Fail - D | escribe Reason |
| Item or System Tags (i.e. AC-1, RTU-1, HP-1) | | | | | |
| Equipment Type ³ : | | | | | |
| Equipment Type . Number of Systems | | | | l | |
| Max Allowed Heating Capacity ¹ | | | | | |
| Minimum Heating Efficiency ¹ | | | | | |
| Max Allowed Cooling Capacity ¹ | | | | | П |
| Cooling Efficiency ¹ | | | О | | |
| Duct Location/ R-Value | | | | | O |
| When duct testing is required, submit MECH-4A & MECH-4-HERS | | ALLEST OF PRINCIPALITY V | | | |
| Economizer | | | | | |
| Thermostat | | | | | |
| Fan Control | | | | L | |
| If the Actual installed equipment performar the building plans) the responsible party shall. For additional detailed discrepancy use Pas. Indicate Equipment Type. Gas (Pkg or, Spi | all resubmit energy comp ge 2 of the Inspection Ch | liance to include the new cha ecklist Form Compliance fail | inges | | bmittal or from |
| EnergyPro 5:1 by EnergySoft User Numbe | | 2012-01-05713:26:36 | ID: 09091 | | Page 16 of |

| CERTIFICATE OF COMPLIANCE and FIELD INSPECTION ENERGY CHECKLIST | (Part 2 of 4) | MECH-1C |
|--|--|------------------|
| Project Name BCSD School Bld F Classrooms | | Date 1/5/2012 |
| Discrepancies: | | |
| | | |
| | | |
| | , | |
| | | |
| | | |
| The state of the s | | |
| | | |
| | | |
| | | |
| | | ***** |
| | | |
| | | |
| | A SAME AND | |
| | August Au | |
| EnergyPro 5.1 by EnergySoft User Number, 6232 RunCode: 2012-01-05 | T13:26:36 ID: 09091 | Page 17 of 2 |

| CERTIFICATE OF COMP | LIAN | ICE and | FIELD IN | ISPECTI | ON ENE | RGY CH | IECKLIS | ST (F | art 3 of | 4) M | ECH-1C |
|---|--|--|---|---|--|--|--|---|--|---|--|
| Project Name | | | | | | | | | | Date | E/0040 |
| BCSD School Bld F Classrooms | | | | | | | ····· | | | 1/3 | 5/2012 |
| Required Acceptance Tests | | | | | | | | | | | |
| Designer: This form is to be used by the designer boxes by all acceptance tests that apply the number of systems. The NA number part of the plans, completion of this sect | and liste designa | ed all equipments | nt that required in the Appen | s an acceptar | ice test, If all en presidential Re | equipment of eference App | a certain typ endices Mai | e requires a | test, list the e | equipment des | scription and |
| Building Departments: Systems Acceptance: Before occupan normal use, all control devices serving to Systems Acceptance: Before occupan The MECH-1C form is not considered a person performing the test (Example: Hi checked-off forms are required for ALL specifications, installation, certificates, a properly filled out and signed forms before | ne building permit complet VAC instruction in the contraction in the c | ng or space shit is granted. All ed form and is alter, TAB cont stalled equipmenting and maint | all be certified I newly installent not to be accertactor, control ent. In addition tenance information | as meeting the dead HVAC equippled by the best secontractor, as Certificate nation meet the dead of the secontractor. | ne Acceptance ipment must be uilding depart PE in charge of Acceptance | e Requireme ne tested usin iment unless of project) an e forms shali | nts for Code ng the Accep the correct to d what Acce be submitte | Compliance trance Requipoxes are chieptance test red to the build | rements. ecked. The ecual to the condition of the conditi | quipment requucted. The follont that certifie | uring testing, lowing es plans, |
| property mied out and signed forms bere | | anding can rece | Sive fires occu | perioy. | | | | | | | |
| | | | | y | , | | | , | | Ţ | |
| TEST DESCRIPTION Foundment Requiring Testing or Verification | City. | MECH-2A Outdoor Ventilation For VAV & CAV | MECH-3A Constant Volume & Single-Zone Unitary | MECH-4A Air Distribution Ducts | MECH-5A Economizer Controls | MECH-6A Demand Control Ventilation DCV | MECH-7A Supply Fan VAV | MECH-8A Valve Leakage Test | MECH-9A Supply Water Temp, Beset | MECH-10A Hydronic System Variable Flow Control | Automatic Demand Shed |
| TEST DESCRIPTION Equipment Requiring Festing or Verification PUHY-P192 Run as Standard Heat Pump | City. | Outdoor Ventilation | Constant Volume & | Air | | Demand Control | Supply | Valve | Supply Water | Hydronic System Variable | Automatic Demand Shed |
| Equipment Requiring Testing or Verification | | Outdoor Ventilation For VAV & CAV | Constant Volume & Single-Zone Unitary | Air Distribution Ducts | Economizer Controls | Demand Control Ventilation DCV | Supply Fan VAV | Valve Leakage Test | Supply Water Temp. Reset | Hydronic System Variable Flow Control | Automatic Demand Shed Control |
| Equipment Requiring Testing or Verification PUHY-P192 Run as Standard Heat Pump | 2 | Outdoor Ventilation For VAV & CAV | Constant Volume & Single-Zone Unitary | Air Distribution Ducts | Economizer Controls | Demand Control Ventilation DCV | Supply Fan VAV | Valve Leakage Test | Supply Water Temp, Reset | Hydronic System Variable Flow Control | Automatic Demand Shed Control |
| Equipment Requiring Testing or Verification PUHY-P192 Run as Standard Heat Pump | 2 | Outdoor Ventilation For VAV & CAV | Constant Volume & Single-Zone Unitary | Air Distribution Ducts | Economizer Controls IZ) | Demand Control Ventilation DCV | Supply Fan VAV | Valve Leakage Test | Supply Water Temp, Reset | Hydronic System Variable Flow Control | Automatic Demand Shed Control |
| Equipment Requiring Testing or Verification PUHY-P192 Run as Standard Heat Pump | 2 | Outdoor Ventilation For VAV & CAV | Constant Volume & Single-Zone Unitary | Air Distribution Ducts | Economizer Controls Z) | Demand Control Ventilation DCV | Supply Fan VAV □ □ □ □ | Valve Leakage Test □ □ □ □ | Supply Water Temp. Reset | Hydronic System Variable Flow Control | Automatic Demand Shed Control |
| Equipment Requiring Testing or Verification PUHY-P192 Run as Standard Heat Pump | 2 | Outdoor Ventilation For VAV & CAV | Constant Volume & Single-Zone Unitary | Air Distribution Ducts | Economizer Controls Z | Demand Control Ventilation DCV | Supply Fan VAV □ □ □ □ □ □ | Valve Leakage Test □ □ □ □ □ | Supply Water Temp. Reset | Hydronic System Variable Flow Control | Automatic Demand Shed Control |
| Equipment Requiring Testing or Verification PUHY-P192 Run as Standard Heat Pump | 2 | Outdoor Ventilation For VAV & CAV | Constant Volume & Single-Zone Unitary | Air Distribution Ducts | Economizer Controls Ø | Demand Control Ventilation DCV | Supply Fan VAV □ □ □ □ □ □ □ | Valve Leakage Test | Supply Water Temp. Reset | Hydronic System Variable Flow Control | Automatic Demand Shed Control |
| Equipment Requiring Testing or Verification PUHY-P192 Run as Standard Heat Pump | 2 | Outdoor Ventilation For VAV & CAV | Constant Volume & Single-Zone Unitary | Air Distribution Ducts | Economizer Controls Z) | Demand Control Ventilation DCV | Supply Fan VAV □ □ □ □ □ □ □ □ □ □ □ □ □ □ □ □ □ | Valve Leakage Test □ □ □ □ □ □ □ □ □ □ □ □ □ □ □ □ □ □ | Supply Water Temp. Reset | Hydronic System Variable Flow Control | Automatic Demand Shed Control |
| Equipment Requiring Testing or Verification PUHY-P192 Run as Standard Heat Pump | 2 | Outdoor Ventilation For VAV & CAV | Constant Volume & Single-Zone Unitary | Air Distribution Ducts | Economizer Controls | Demand Control Ventilation DCV | Supply Fan VAV □ □ □ □ □ □ □ □ □ □ □ □ □ □ □ □ □ | Valve Leakage Test | Supply Water Temp. Reset | Hydronic System Variable Flow Control | Automatic Demand Shed Control |
| Equipment Requiring Testing or Verification PUHY-P192 Run as Standard Heat Pump | 2 | Outdoor Ventilation For VAV & CAV | Constant Volume & Single-Zone Unitary | Air Distribution Ducts | Economizer Controls 77 | Demand Control Ventilation DCV | Supply Fan VAV | Valve Leakage Test | Supply Water Temp. Reset | Hydronic System Variable Flow Control | Automatic Demand Shed Control |
| Equipment Requiring Testing or Verification PUHY-P192 Run as Standard Heat Pump | 2 | Outdoor Ventilation For VAV & CAV | Constant Volume & Single-Zone Unitary | Air Distribution Ducts | Economizer Controls | Demand Control Ventilation DCV | Supply Fan VAV | Valve Leakage Test | Supply Water Temp. Reset | Hydronic System Variable Flow Control | Automatic Demand Shed Control |
| Equipment Requiring Testing or Verification PUHY-P192 Run as Standard Heat Pump | 2 | Outdoor Ventilation For VAV & CAV | Constant Volume & Single-Zone Unitary | Air Distribution Ducts | Economizer Controls | Demand Control Ventilation DCV | Supply Fan VAV | Valve Leakage Test | Supply Water Temp. Reset | Hydronic System Variable Flow Control | Automatic Demand Shed Control |
| Equipment Requiring Testing or Verification PUHY-P192 Run as Standard Heat Pump | 2 | Outdoor Ventilation For VAV & CAV | Constant Volume & Single-Zone Unitary | Air Distribution Ducts | Economizer Controls | Demand Control Ventilation DCV | Supply Fan VAV | Valve Leakage Test | Supply Water Temp. Reset | Hydronic System Variable Flow Control | Demand Shed Control |


| CERTIFICATE OF COM | PLIAN | CE and F | IELD INSP | ECTION E | NERGY CH | ECKLIST | (Part 4 of 4) | MECH-1 |
|--|------------|--|---|--|---|---|--|--|
| Project Name BCSD School Bld F Classrooms | | | | | | | | Date 1/5/2012 |
| TEST DESCRIPTION | | MECH-12A | MEGUADA | MECH-14A | MEGULATA | | *************************************** | 1/5/2012 |
| Equipment Requiring Testing | Qty. | Fault Detection & Diagnostics for DX Units | MECH-13A Automatic Fault Detection & Diagnostics for Air & Zone | Distributed Energy Storage DX AC Systems | MECH-15A Thermal Energy Storage (TES) Systems | | Test Performed By. | |
| PUHY-P192 Run as Standard Heat Pump | 2 | 図 | | | | | | , |
| Mitsubishi MUY-A15NA / MSY-A15NA | 2 | | | | | | | |
| | | | | | | | | |
| | | | О | | | | | |
| | | | | | | | | |
| | | | | | | | | |
| The state of the s | | | | | | | MATTER LAND CONTRACTOR MATERIAL CONTRACTOR ACCORDING | |
| | | | | | | | ************************************** | |
| | | | | | | | | |
| | | | | | | | | - |
| | | D D | | | | | | THE PERSON NAMED OF THE PERSON NAMED AND THE PERSON |
| | 1 | | 0 | | | | | |
| | | | | | | | | |
| | | | | | | | | |
| | | | 0 | | | | | |
| | | | | | | | | M 78 78 18 1880788883888388388388888888 |
| | | | | | | | | |
| | | | | | | | | |
| | | | | | | | | |
| | - | П | | | | | | |
| | | | | | | | | |
| | | | | | | | | |
| | | | | | | | '' | |
| | | | | | | *************************************** | | |
| | T | | | | | | | *************************************** |
| , , , , , , , , , , , , , , , , , , , | | | | | | | | · |
| | | | | | | | | |
| | | | | | | | | |
| | | | | | | | | |
| EnergyPro 5 1 by EnergySoft Use | er Number. | 5232 | F | unCode: 2012-01- | 05T13:26:36 | ID- 09091 | | Page 19 of |

| Project Name BCSD School Bld F Classro | ooms | | | Date 1/5/2012 |
|---|----------------|--------------------------|-----------------------------|------------------------|
| | | ate Air Systems Type (Ce | ntral, Single Zone, Package | e, VAV, or etc) |
| Item or System Tags (re: AC-1, RTU-1, HP-1) | | HP F-1 | HP F-2 | CU/FC F-1, 2 |
| Number of Systems | 4943,478 | 1 | 1 | 2 |
| | Indicate Pag | e Reference on Plans or | Schedule and indicate the | applicable exception(s |
| MANDATORY MEASURES | T-24 Sections | | | |
| Heating Equipment Efficiency | 112(a) | 3 20 COP | 3 20 COP | n/a |
| Cooling Equipment Efficiency | 112(a) | 10 6 EER | 10 6 EER | 16.0 SEER / 13 0 EER |
| HVAC Heat Pump Thermostat | 112(b), 112(c) | Yes | Yes | n/a |
| Furnace Controls/Thermostat | 112(c), 115(a) | n/a | n/a | n/a |
| Natural Ventilation | 121(b) | | | |
| Mechanical Ventilation | 121(b) | 1,555 cfm | 1,555 cfm | 26 cfm |
| VAV Minimum Pasition Control | 121(c) | No | No | No |
| Demand Control Ventilation | 121(c) | Yes | Yes | No |
| Time Control | 122(e) | Programmable Switch | Programmable Switch | Programmable Switch |
| Setback and Setup Control | 122(a) | Setback Required | Setback Required | Setback Required |
| Outdoor Damper Control | 122(1) | Auto | Aulo | Auto |
| Isolation Zones | 122(g) | nla | n/a | n/a |
| Pipe Insulation | 123 | Refrigerant | Refrigerant | |
| Duct Location/ R-value | 124 | Attic, Roof Ins / 4.2 | Attic, Roof Ins / 4.2 | n/a |
| PRESCRIPTIVE MEASURES Calculated Design Heating Load | 144(a & b) | n/a | n/a | n/a |
| Proposed Heating Capacity | 144(a & b) | 124,915 Btu/hr | 124,915 Blu/hr | 0 Btu/hr |
| Calculated Design Cooling Load | 144(a & b) | n/a | n/a | n/a |
| Proposed Cooling Capacity | 144(a & b) | 190,478 Btu/hr | 190,484 Btu/hr | 21,199 Blu/hi |
| Fan Control | 144(c) | Variable Speed | Variable Speed | Constant Volume |
| DP Sensor Location | 144(c) | | | |
| Supply Pressure Reset (DDC only) | 144(c) | | | |
| Simultaneous Heat/Cool | 144(d) | No | No | No |
| Economizer | 144(e) | Diff Temp (Integrated) | Diff. Temp (Integrated) | No Economizer |
| Heat Air Supply Reset | 144(f) | Coldest Zone | Coldest Zone | Constant Temp |
| Cool Air Supply Reset | 144(f) | Warmest Zone | Warmest Zone | Constant Temp |
| Electric Resistance Heating | 144(g) | | | |
| Air Cooled Chiller Limitation | 144(i) | | | |
| Duct Leakage Sealing. If Yes, a MECH-4-A must be submitted | 144(k) | No | No | No |
| | | | | |

| MECHA | VICAL VEN | VILATIO | N AND | REHE | AT | | | | | | | | MEC |)H-3C |
|---|--|--|-------------------------------|-----------------------------|--|-----------------------------|---------------------------------|---------------------------|-------------------------------|--|---------------------------------------|--------------------------------|---------------------------------------|-----------------|
| Project Name | ol Bld F Class | ~ r'~ c+ h~ r+ | | | | | | | | | | | Date 1/5/2 | 0019 |
| DC2D 2010 | or bio r Class | | | | | | | | | | | | | .012 |
| \$444 4 5 - 4 - 1 - 1 - 1 - 1 - 1 - 1 - 1 - 1 - 1 | | | | VENTILATION | | | | | | REHE | | TION (§144 | (d)) | |
| | | ······································ | EA BASIS | <i></i> | | CUPANCY | | | | | VAV MIN | IMUM | · · · · · · · · · · · · · · · · · · · | |
| | Α | В | C | D | E | F | G Min CFM | H REQ'D | l Design | J 50% of | ĸ | Max, of | M Design | N |
| Zone/ | System | Gondillón Area (it²) | CFM per fi ² | Min CFM By Area B X C | Number Of People | CFM per Person | by Occupant EXF | V.A. Max of D or G | Ventilation Air OFM | Design Zone Supply CFM | BX 0.4 CFM / B ² | Columns H, J, K, 300 CFM | Mînimum Air Setpoint | Transfer Air |
| Classroom 100 | | 963 | 0,38 | 366 | | | | 360 | 366 | | | | | |
| Classroom 101 | | 963 | Q 38 | 366 | | | | 366 | 366 | | | | | |
| Classroom 102 | | 963 | <i>0 38</i> | 366 | | | | 366 | 368 | | | | | |
| Classroom 103 | | 963 | <i>0.38</i> | 356 | | | | 386 | 368 | | | | | |
| Work Room 108 | | 240 | 0.38 | 91 | | } | | 91 | 9/1 | | | | | |
| HP F-1 | | | | | | | Total | 1,855 | 1,555 | | | | | |
| Classroom 104 | | 9 63 | 0.38 | 366 | | | | 366 | 366 | | · · · · · · · · · · · · · · · · · · · | ******* | | |
| Classroom 105 | | 963 | 0.38 | 366 | | | | 366 | 366 | | | | <u>}</u> | |
| Classroom 106 | | 963 | 0,38 | 366 | | | | 365 | 366 | | | | | |
| Çlassroom 107 | | 963 | 0.38 | 366 | | | | 366 | 366 | | | | | . , |
| Work Room 109 | · | 240 | 0.38 | 91 | TO THE OWNER OF THE OWNER OF THE OWNER | | | 91 | 91 | | | | | |
| HP F-2 | | | | | | | Total | 1,555 | 1,555 | | | · | | . . |
| Electrical Room | \$ | 176 | 0.15 | 26 | | | | 26 | 26 | .,,,,,,,,,,,,,,,,,,,,,,,,,,,,,,,,,,,,,, | | | | |
| ÇU/FC F-1, 2 | | | | | | | Total | 26 | 26 | | | | | |
| | | | | | | | <u></u> | | | | | | | |
| | | | | Totals | |] | | | | Column I Total | Design Ven | tilation Air | | <u> </u> |
| | | | | | | | | •••• | | | | | | |
| С | Minimum ventifali | ion rate per Section | on §121, T | able 121×A. | | | | | | | | | ,, <u>.</u> | |
| E | Based on fixed se | aat or the greater | of the expe | cted number | of occupant | is and 50% | of the CBC oc | cupant load | for egress pu | rposes for space | s without fix | ed seating. | | |
| H | Required Ventifat | ion Air (REQ'D V | .A.) is the l | arger of the ve | ıntilation rat | es calculat | ed on an AREA | BASIS or | OCCUPANCY | BASIS (Column | D or G). | | | |
| <u> </u> | Must be grèater t | han or equal to H | , or use Tra | inster Air (coli | ımn N) to n | rake up the | difference. | | | | | | | |
| J | Design fan suppl | y CFM (Fan CFM |) x 50%; or | lhe design zo | ne autdoor | airflow rate | per §121. | | | ,,,,,,,,,,,,,,,,,,,,,,,,,,,,,,,,,,,,, | | | | |
| К | Condition area (ff | 2) x 0.4 GFM / R2; | 01 | | | | | . , | | | | | | |
| L | Maximum of Colu | ımns H. J. K. or 3 | ga CFM | | | | , | y | | | | | | ··· |
| М | This must be less | than or equal to | Column L | and greater th | an or equal | to the sum | of Columns H | plus N. | | 0 | | | | |
| N | Transfer Air must equal to the differ | be provided whe rence between th | re the Hegi le Réquired | uired Ventilation A | an Air (Golu ìr (Column l | mn H) is gt H) and lbe i | eater than the Design Minimu | nesign Min m Air (Calu | imum Air (Col mn M), Colum | umri M), Where in H minus M | required, trar | isier air most | na diestet t | an or |
| EnergyPro 5.1 | | User Numi | | | 1 | | te: 2012-01-05 | | | 10: 09091 | | | Pa | ge 21 of 25 |

| ENVEL | OPE MANDATORY MEASURES: NONRESIDENTIAL | EN |
|--------------|--|-----------------------------------|
| Project Name | hool Bld F Classrooms | Date 1/3 |
| DESCRI | | |
| | invelope Measures: | |
| §118(a): | Installed insulating material shall have been certified by the manufacturer to comply with the Califo Standards for insulating material, Title 20 Chapter 4, Article 3. | ornia Quality |
| §118(c)· | All Insulating Materials shall be installed in compliance with the flame spread rating and smoke de Sections 2602 and 707 of Title 24, Part 2. | |
| §118(f) | The opaque portions of framed demising walls in nonresidential buildings shall have insulation with of no less than R-13 between framing members. | |
| §117(a): | All Exterior Joints and openings in the building that are observable sources of air leakage shall be weatherstripped or otherwise sealed | |
| §116(a) 1: | Manufactured fenestration products and exterior doors shall have air infiltration rates not exceeding window area, 0.3 cfm/ft.² of door area for residential doors, 0.3 cfm/ft.² of door area for nonresidential double doors (swinging), and 1.0 cfm/ft.² for nonresidential double doors (swinging). | ng 0.3 cfm/ft. htial single de |
| §116(a) 2: | Fenestration U factor shall be rated in accordance with NFRC 100, or the applicable default U-factor | |
| §116(a) 3: | Fenestration SHGC shall be rated in accordance with NFRC 200, or NFRC 100 for site-built fenes applicable default SHGC. | |
| §116(b): | Site Constructed Doors, Windows and Skylights shall be caulked between the unit and the building weatherstripped (except for unframed glass doors and fire doors). | g, and shall |
| | | |
| | | |
| Project Name | pol Bld F Classrooms | Date 1/5/2012 |
|----------------|---|---|
| | nt and System Efficiencies | |
| §111: | Any appliance for which there is a California standard established in the Appliance Efficiency Regulat with the applicable standard. | ions will comply |
| §115(a) | Fan type central furnaces shall not have a pilot light. | |
| §123 | Pipling, except that conveying fluids at temperatures between 60 and 105 degrees Fahrenheit, or with equipment, shall be insulated in accordance with Standards Section 123. | |
| §124. | Air handling duct systems shall be installed and insulated in compliance with Sections 601, 602, 603. the CMC Standards. | 604, and 605 c |
| Controls | | |
| §122(e): 1A | Each space conditioning system shall be installed with one of the following: Each space conditioning system serving building types such as offices and manufacturing facilities (a explicitly exempt from the requirements of Section 112 (d)) shall be installed with an automatic time is accessible manual override that allows operation of the system during off-hours for up to 4 hours. The shall be capable of programming different schedules for weekdays and weekends and have program capabilities that prevent the loss of the device's program and time setting for at least 10 hours if power | witch with an e time switch backup |
| 18. | An occupancy sensor to control the operating period of the system; or | |
| 1C. | A 4-hour timer that can be manually operated to control the operating period of the system. | |
| 2. | Each space conditioning system shall be installed with controls that temporarily restart and temporaril system as required to maintain a setback heating and/or a setup cooling thermostat setpoint. | |
| §122(g) | Each space conditioning system serving multiple zones with a combined conditioned floor area more square feet shall be provided with isolation zones. Each zone: shall not exceed 25,000 square feet; with isolation devices, such as valves or dampers that allow the supply of heating or cooling to be set independently of other isolation areas, and shall be controlled by a time control device as described as | shall be provid back or shut of bove. |
| §122(c): | Thermostats shall have numeric setpoints in degrees Fahrenheit (F) and adjustable setpoint stops act authorized personnel. | |
| §122(b). | Heat pumps shall be installed with controls to prevent electric resistance supplementary heater opera heating load can be met by the heat pump alone | |
| §122(a&b): | Each space conditioning system shall be controlled by an individual thermostat that responds to temp zone. Where used to control heating, the control shall be adjustable down to 55 degrees F or lower, control shall be adjustable up to 85 degrees F or higher. Where used for both heating and cooling, the capable of providing a deadband of at least 5 degrees F within which the supply of heating and coolin reduced to a minimum. | For cooling, the control shall: |
| Ventilatio | n | |
| §121(e): | Controls shall be provided to allow outside air dampers or devices to be operated at the ventilation ration these plans. | tes as specified |
| §122(f): | All gravity ventilating systems shall be provided with automatic or readily accessible manually operate openings to the outside, except for combustion air openings. | |
| §121(f)· | Ventilation System Acceptance. Before an occupancy permit is granted for a newly constructed building new ventilating system serving a building or space is operated for normal use, all ventilation systems building or space shall be certified as meeting the Acceptance Requirements for Code Compliance | ng or space, or serving the |
| Service V | /ater Heating Systems | |
| §113(c) | Installation | |
| 3. | Temperature controls for public lavatories. The controls shall limit the outlet Temperature to 110°F. | _1 |
| 2. | Circulating service water-heating systems shall have a control capable of automatically turning off the when hot water is not required. | circulating pur |
| | | |
| | | |

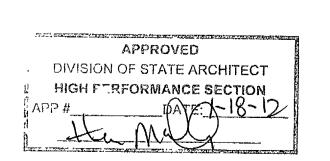






ARCHITECTS, INC.

5500 MING AVENUE SUITE 280
BAKERSFIELD, CALIFORNIA 93309
TELEPHONE (661) 832-5258
FACSIMILE (661) 832-4291

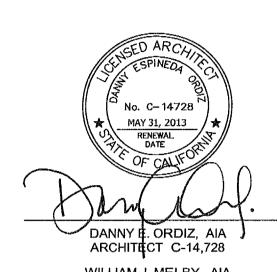

ARCHITECT C-16,835

PTN # 63321-112

NEW ELEMENTARY

SCHOOL 9801 HIGHLAND KNOLLS DR BAKERSFIELD CALIFORNIA 93306

NEW MIDDLE SCHOOL 4115 VINELAND ROAD BAKERSFIELD CALIFORNIA 93306

FOR:

BAKERSFIELD CITY SCHOOL DISTRICT 1300 BAKER STREET BAKERSFIELD

CALIFORNIA 93305

MARK DATE DESCRIPTION

...

JOB NUMBER: 200101244

CAD DRAWING FILE:

DRAWN BY:

KW

CHECKED BY:

MB

CHECK AND VERIFY ALL, DIMENSIONS BEFORE PROCEEDING WITH THE WORK.
REPORT DISCREPANCIES TO THE ARCHITECT.

THE DRAWINGS, IDEAS, AND DESIGNS REPRESENTED ON THIS SHEET ARE THE

THE DRAWINGS, IDEAS, AND DESIGNS
REPRESENTED ON THIS SHEET ARE THE
PROPERTY OF THE ARCHITECT.

COPYRIGHT
ORDIZ-MELBY ARCHITECTS, INC. 2010

SHEET TITLE

TITLE 24

BUILDING "F"

SHEET IDENTIFICATION NUMBER

M-525