



**ELECTRICAL PLAN NOTES**



- 1 PROVIDE SENSOR SWITCH MOTION SENSOR, CMR-PDT-9. CONNECT IN PARALLEL TO EXHAUST FAN THAT SERVES AREA.
- 2 AT WALLS ABLE TO RESIST THE PASSAGE OF SMOKE, CAULK ALL PENETRATIONS.

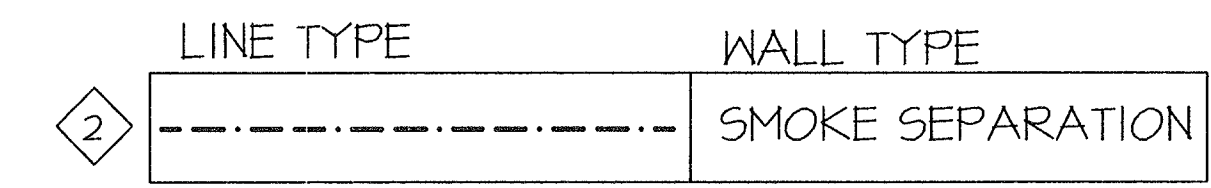

ELECTRICAL MECHANICAL PLAN BUILDING H

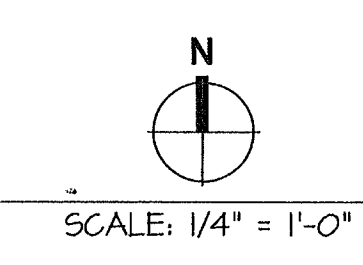

5500 MING AVENUE SUITE 280  
 BAKERSFIELD, CALIFORNIA 93309  
 TELEPHONE (805) 832-5258  
 FACSIMILE (805) 832-4281

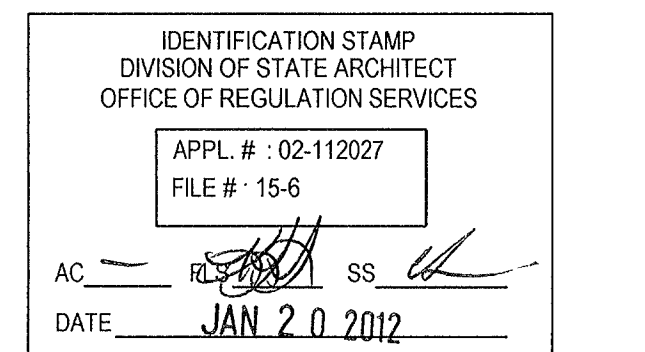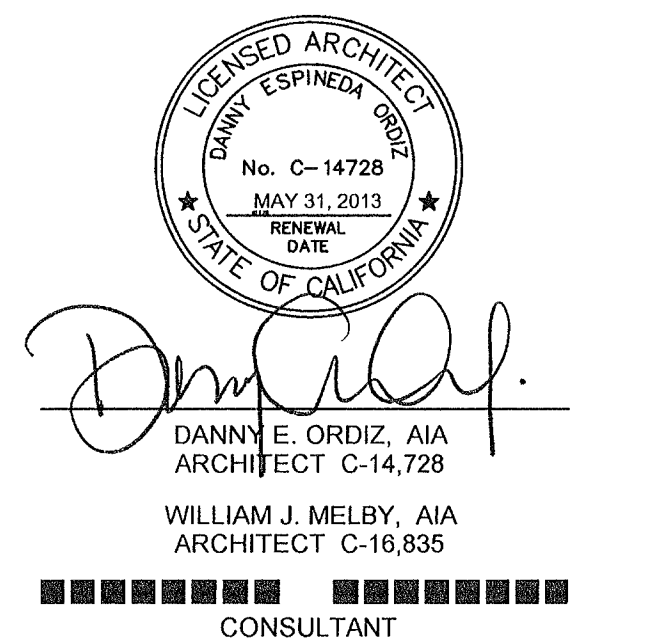

NEW ELEMENTARY SCHOOL  
 8801 HIGHLAND KNOLLS DR  
 BAKERSFIELD  
 CALIFORNIA  
 93306

NEW MIDDLE SCHOOL  
 4115 VINELAND ROAD  
 BAKERSFIELD  
 CALIFORNIA  
 93306

FOR:  
 BAKERSFIELD CITY SCHOOL  
 DISTRICT  
 1300 BAKER STREET  
 BAKERSFIELD  
 CALIFORNIA  
 93305



MARK	DATE	DESCRIPTION


JOB NUMBER  
 20101244  
 CAD DRAWING FILE:  
 DRAWN BY:  
 AC  
 CHECKED BY:  
 PH

CHECK AND VERIFY ALL DIMENSIONS BEFORE  
 PROCEEDING WITH THE WORK.  
 REPORT DISCREPANCIES TO THE ARCHITECT

THE DRAWINGS, IDEAS, AND DESIGNS  
 REPRESENTED ON THIS SHEET ARE THE  
 PROPERTY OF THE ARCHITECT

COPYRIGHT  
 ORDIZ-MELBY ARCHITECTS, INC 2010

SHEET TITLE:  
**ELECTRICAL MECHANICAL  
 PLAN BUILDING H**

SHEET IDENTIFICATION NUMBER  
**E-122H**  
 SHEET OF