

PTN # 63321-112

NEW ELEMENTARY SCHOOL
9801 HIGHLAND KNOLLS DR
BAKERSFIELD CALIFORNIA 93306
NEW MIDDLE SCHOOL
4115 VINELAND ROAD
BAKERSFIELD CALIFORNIA 93306

FOR:

BAKERSFIELD CITY SCHOOL DISTRICT
1300 BAKER STREET
BAKERSFIELD CALIFORNIA 93305

| MARK | DATE | DESCRIPTION |
|------|------|-------------|
| △ | | |
| △ | | |
| △ | | |
| △ | | |

20010244
CAD DRAWING FILE:
DRAWN BY: KW
CHECKED BY: MB
CHECK AND VERIFY ALL DIMENSIONS BEFORE PROCEEDING WITH THE WORK. REPORT DISCREPANCIES TO THE ARCHITECT.
THE DRAWINGS, IDEAS, AND DESIGNS REPRESENTED ON THIS SHEET ARE THE PROPERTY OF THE ARCHITECT.
COPYRIGHT
ORDIZ-MELBY ARCHITECTS, INC. 2010
SHEET TITLE
TITLE 24 BUILDING "H"
SHEET IDENTIFICATION NUMBER
M-529

| AIR SYSTEM REQUIREMENTS (Part 1 of 2) | | MECH-2C | |
|---|---|-------------------------|-------------------------|
| Project Name | | Date | |
| BCSD School Building H Exersize Rooms | | 1/5/2012 | |
| Item or System Tags (i.e. AC-1, RTU-1, HP-1) | Indicate Air Systems Type (Central, Single Zone, Package, VAV, or etc...) | AC H-1 | AC H-2 |
| Number of Systems | | 1 | 1 |
| Indicate Page Reference on Plans or Schedule and indicate the applicable exception(s) | | | |
| MANDATORY MEASURES | | | |
| T-28 Sections | | | |
| Heating Equipment Efficiency | 112(a) | 81% AFUE | 81% AFUE |
| Cooling Equipment Efficiency | 112(b) | 15.2 SEER / 12.5 EER | 15.2 SEER / 12.5 EER |
| HVAC Heat Pump Thermostat | 112(b), 112(c) | n/a | n/a |
| Furnace Controls/Thermostat | 112(c), 115(a) | n/a | n/a |
| Natural Ventilation | 121(b) | 190 cfm | 217 cfm |
| Mechanical Ventilation | 121(b) | No | No |
| VAV Minimum Position Control | 121(c) | No | No |
| Demand Control Ventilation | 121(c) | Yes | Yes |
| Time Control | 122(a) | Programmable Switch | Programmable Switch |
| Setback and Setup Control | 122(a) | Setback Required | Setback Required |
| Outdoor Damper Control | 122(b) | Auto | Auto |
| Isolation Zones | 122(b) | n/a | n/a |
| Pipe Insulation | 123 | n/a | n/a |
| Duct Location R-value | 124 | Attic, Roof Ins / 4.2 | Attic, Roof Ins / 4.2 |
| PRESCRIPTIVE MEASURES | | | |
| Calculated Design Heating Load | 144(a & b) | n/a | n/a |
| Proposed Heating Capacity | 144(a & b) | 50,000 Btu/hr | 50,000 Btu/hr |
| Calculated Design Cooling Load | 144(a & b) | n/a | n/a |
| Proposed Cooling Capacity | 144(a & b) | 36,713 Btu/hr | 36,684 Btu/hr |
| Fan Control | 144(c) | Constant Volume | Constant Volume |
| DP Sensor Location | 144(c) | | |
| Supply Pressure Reset (DDC only) | 144(c) | | |
| Simultaneous Heat/Cool | 144(d) | No | No |
| Economizer | 144(d) | Fixed Temp (Integrated) | Fixed Temp (Integrated) |
| Heat Air Supply Reset | 144(d) | Constant Temp | Constant Temp |
| Cool Air Supply Reset | 144(d) | Constant Temp | Constant Temp |
| Electric Resistance Heating | 144(d) | | |
| Air Cooled Chiller Limitation | 144(d) | | |
| Duct Leakage Sealing, if Yes, a MECH-4-A must be submitted | 144(d) | No | No |

1. Total installed capacity (Btu/hr) of all electric heat on this project exclusive of electric auxiliary heat for heat pumps. If electric heat is used explain which exception(s) is/are applicable.

EnergyPro 5.1 by EnergySoft User Number: 5232 RunCode: 2012-01-05114-20-03 ID: 09091 Page 17 of 21


| CERTIFICATE OF COMPLIANCE and FIELD INSPECTION ENERGY CHECKLIST (Part 3 of 4) | | MECH-1C | |
|---|-----------------------------------|-----------------------------------|------------------------|
| Project Name | | Date | |
| BCSD School Building H Exersize Rooms | | 1/5/2012 | |
| Required Acceptance Tests | | | |
| Designer: This form is to be used by the designer and attached to the plans. Listed below are all the acceptance tests for mechanical systems. The designer is required to check the applicable boxes by all acceptance tests that apply and listed all equipment that requires an acceptance test. If all equipment of a certain type requires a test, list the equipment description and the number of systems. The NA number designates the Section in the Appendix of the Nonresidential Reference Appendix Manual that describes the test. Since this form will be part of the plans, completion of this section will allow the responsible party to budget for the scope of work appropriately. | | | |
| Building Departments: Systems Acceptance: Before occupancy permit is granted for a newly constructed building or space, or a new space-conditioning system serving a building or space is operated for normal use, all control devices serving the building or space shall be certified as meeting the Acceptance Requirements for Code Compliance. Systems Acceptance: Before occupancy permit is granted, all newly installed HVAC equipment must be tested using the Acceptance Requirements. The MECH-1C form is not considered a completed form and is not to be accepted by the building department unless the correct boxes are checked. The equipment requiring testing, person performing the test (Example: HVAC installer, TAB contractor, controls contractor, PE in charge of project) and what Acceptance test must be conducted. The following checked-off forms are required for ALL newly installed equipment. In addition a Certificate of Acceptance form shall be submitted to the building department that certifies plans, specifications, installation, certificates, and operating and maintenance information meet the requirements of §10-103(b) and Title-24 Part 6. The building inspector must receive the properly filled out and signed forms before the building can receive final occupancy. | | | |
| TEST DESCRIPTION | MECH-2A | MECH-3A | MECH-4A |
| Equipment Requiring Testing or Verification | Outdoor Ventilation For VAV & CAV | Constant Volume & Single-Zone VAV | Air Distribution Ducts |
| 48VCL06 | 2 | 0 | 0 |
| EnergyPro 5.1 by EnergySoft User Number: 5232 RunCode: 2012-01-05114-20-03 ID: 09091 Page 18 of 21 | | | |

| CERTIFICATE OF COMPLIANCE and FIELD INSPECTION ENERGY CHECKLIST (Part 4 of 4) | | MECH-1C | |
|--|--|--|--------------------------------------|
| Project Name | | Date | |
| BCSD School Building H Exersize Rooms | | 1/5/2012 | |
| TEST DESCRIPTION | MECH-12A | MECH-13A | MECH-14A |
| Equipment Requiring Testing | Fault Detection & Diagnostics for DX Units | Automatic Fault Detection & Diagnostics for Air & Zone | Thermal Energy Storage (TES) Systems |
| 48VCL06 | 2 | 0 | 0 |
| EnergyPro 5.1 by EnergySoft User Number: 5232 RunCode: 2012-01-05114-20-03 ID: 09091 Page 18 of 21 | | | |


| MECHANICAL VENTILATION AND REHEAT | | MECH-3C | |
|--|--|-----------------------------|---------------------------------------|
| Project Name | | Date | |
| BCSD School Building H Exersize Rooms | | 1/5/2012 | |
| MECHANICAL VENTILATION (§121(b)(2)) | | REHEAT LIMITATION (§144(d)) | |
| AREA BASIS | | OCCUPANCY BASIS | |
| A | B | C | D |
| Zone/System | Condition Area (ft²) | CFM per ft² | Min CFM By Area B X C |
| Exersize #1 | 1,254 | 0.15 | 188 |
| Exersize #2 | 1,437 | 0.15 | 216 |
| ACH-2 | | | |
| Totals | | | Column 1 Total Design Ventilation Air |
| C | Minimum ventilation rate per Section §121, Table 121-A. | | |
| E | Based on fixed seat or the greater of the expected number of occupants and 50% of the CBC occupant load for gross purposes for spaces without fixed seating. | | |
| H | Required Ventilation Air (REQD V.A.) is the larger of the ventilation rates calculated on an AREA BASIS or OCCUPANCY BASIS (Column D or E). | | |
| F | Must be greater than or equal to H, or use Transfer Air (column N) to make up the difference. | | |
| J | Design fan supply CFM (Fan CFM) is 50% of the design zone outdoor airflow rate per §121. | | |
| K | Condition area (ft²) is 1.4 CFM/ft². | | |
| L | Maximum of Columns H, J, K, or 300 CFM. | | |
| M | This must be less than or equal to Column L and greater than or equal to the sum of Column H plus N. | | |
| N | Transfer Air must be provided where the Required Ventilation Air (Column H) is greater than the Design Minimum Air (Column M). Where required, transfer air must be greater than or equal to the difference between the Required Ventilation Air (Column H) and the Design Minimum Air (Column M). Column N must be greater than or equal to the difference between the Required Ventilation Air (Column H) and the Design Minimum Air (Column M). | | |
| EnergyPro 5.1 by EnergySoft User Number: 5232 RunCode: 2012-01-05114-20-03 ID: 09091 Page 18 of 21 | | | |

| ENVELOPE MANDATORY MEASURES: NONRESIDENTIAL | | ENV-MM | |
|--|---|----------|--|
| Project Name | | Date | |
| BCSD School Building H Exersize Rooms | | 1/5/2012 | |
| DESCRIPTION | | | |
| Building Envelope Measures: | | | |
| §118(a) | Installed insulating material shall have been certified by the manufacturer to comply with the California Quality Standards for Insulating Material, Title 20 Chapter 4, Article 3. | | |
| §118(c) | All Insulating Materials shall be installed in compliance with the flame spread rating and smoke density requirements of Sections 2002 and 707 of Title 24, Part 2. | | |
| §118(b) | The opaque portions of framed demising walls in nonresidential buildings shall have insulation with an installed R-value of no less than R-13 between framing members. | | |
| §117(a) | All exterior joints and openings in the building that are observable sources of air leakage shall be caulked, gasketed, weatherstripped or otherwise sealed. | | |
| §116(a) 1 | Manufactured fenestration products and exterior doors shall have an infiltration rates not exceeding 0.3 cfm/ft² of window area, 0.3 cfm/ft² of door area for residential doors, 0.3 cfm/ft² of door area for nonresidential single doors (swing-in set sliding), and 1.0 cfm/ft² for nonresidential double doors (swing-in). | | |
| §116(a) 2 | Fenestration U-factor shall be rated in accordance with NFRC 100, or the applicable default U-factor. | | |
| §116(a) 3 | Fenestration SHGC shall be rated in accordance with NFRC 200, or NFRC 100 for site-built fenestration, or the applicable default SHGC. | | |
| §116(b) | Site Constructed Doors, Windows and Skylights shall be caulked between the unit and the building, and shall be weatherstripped (except for unit-framed glass doors and fire doors). | | |
| EnergyPro 5.1 by EnergySoft User Number: 5232 RunCode: 2012-01-05114-20-03 ID: 09091 Page 20 of 21 | | | |

| MECHANICAL MANDATORY MEASURES: NONRESIDENTIAL | | MECH-MM | |
|--|--|----------|--|
| Project Name | | Date | |
| BCSD School Building H Exersize Rooms | | 1/5/2012 | |
| Equipment and System Efficiencies | | | |
| §111. | Any appliance for which there is a California standard established in the Appliance Efficiency Regulations will comply with the applicable standard. | | |
| §115(a) | Fan type central furnaces shall not have a pilot light. | | |
| §123. | Piping, except that conveying fluids at temperatures between 50 and 105 degrees Fahrenheit, or within HVAC equipment, shall be insulated in accordance with Standards Section 123. | | |
| §124. | Air handling duct systems shall be installed and insulated in compliance with Sections 601, 602, 603, 604, and 605 of the CMC Standards. | | |
| Controls | | | |
| §122(a) | Each space conditioning system shall be installed with one of the following: 1A. Each space conditioning system serving building types such as offices and manufacturing facilities (and all others not explicitly exempt from the requirements of Section 112 (d)) shall be installed with an automatic time switch with an accessible manual override that allows operation of the system during off-hours for up to 4 hours. The time switch shall be capable of programming different schedules for weekdays and weekends and have program backup capabilities that prevent the loss of the device's program and time setting for at least 10 hours if power is interrupted, or 1B. An occupancy sensor to control the operating period of the system; or 1C. A 4-hour timer that can be manually operated to control the operating period of the system. | | |
| §122(b) | Each space conditioning system shall be installed with controls that temporarily restart and temporarily operate the system as required to maintain a setback heating and/or a setup cooling thermostat setpoint. | | |
| §122(g) | Each space conditioning system serving multiple zones with a combined conditioned floor area more than 25,000 square feet shall be provided with isolation zones. Each zone shall not exceed 25,000 square feet, shall be provided with isolation devices, such as valves or dampers that allow the supply of heating or cooling to be setback or shut off independently of other isolation areas, and shall be controlled by a time control device as described above. | | |
| §122(c) | Thermostats shall have numeric setpoints in degrees Fahrenheit (F) and adjustable setpoint stops accessible only to authorized personnel. | | |
| §122(b) | Heat pumps shall be installed with controls to prevent electric resistance supplementary heater operation when the heating load can be met by the heat pump alone. | | |
| §122(a)(b) | Each space conditioning system shall be controlled by an individual thermostat that responds to temperature within the zone. Where used to control heating, the control shall be adjustable down to 55 degrees F or lower. For cooling, the control shall be adjustable up to 85 degrees F or higher. Where used for both heating and cooling, the control shall be capable of providing a deadband of at least 5 degrees F within which the supply of heating and cooling is shut off or reduced to a minimum. | | |
| Ventilation | | | |
| §121(e) | Controls shall be provided to allow outside air dampers or devices to be operated at the ventilation rates as specified on these plans. | | |
| §122(i) | All gravity ventilating systems shall be provided with automatic or readily accessible manually operated dampers on all openings to the outside, except for combustion air openings. | | |
| §121(f) | Ventilation System Acceptance: Before an occupancy permit is granted for a newly constructed building or space, or a new ventilating system is installed in a building or space is operated for normal use, all ventilating systems serving the building or space shall be certified as meeting the Acceptance Requirements for Code Compliance. | | |
| Service Water Heating Systems | | | |
| §113(c) | Installation 3. Temperature controls for public lavatories. The controls shall limit the outlet temperature to 110° F. 2. Circulating service water-heating systems shall have a control capable of automatically turning off the circulating pump when hot water is not required. | | |
| EnergyPro 5.1 by EnergySoft User Number: 5232 RunCode: 2012-01-05114-20-03 ID: 09091 Page 21 of 21 | | | |

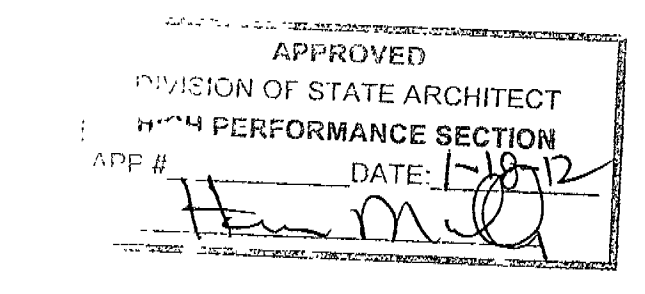

MDC
MECHANICAL DESIGN CONCEPTS, INC.
5500 Ming Ave, Suite 251
Tel #: (661) 397-2114
Job: 09091

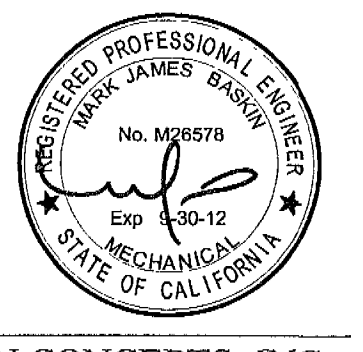

Bakersfield, CA 93309
FAX #: (661) 397-2116
PIT: 1-11-12