


NEW ELEMENTARY SCHOOL  
9801 HIGHLAND KNOLLS DR  
BAKERSFIELD  
CALIFORNIA  
93306

NEW MIDDLE SCHOOL  
4115 VINELAND ROAD  
BAKERSFIELD  
CALIFORNIA  
93306

FOR:  
BAKERSFIELD CITY SCHOOL DISTRICT  
1300 BAKER STREET  
BAKERSFIELD  
CALIFORNIA  
93305

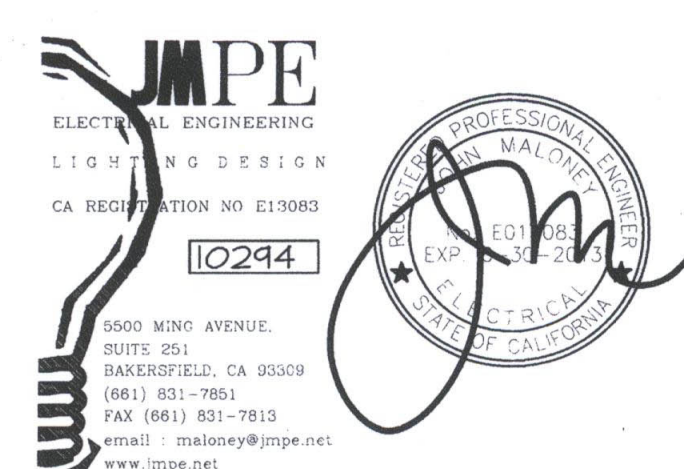

MARK	DATE	DESCRIPTION
△		
△		
△		
△		

JOB NUMBER:  
20101244  
CAD DRAWING FILE:  
DRAWN BY:  
AC  
CHECKED BY:  
PH  
CHECK AND VERIFY ALL DIMENSIONS BEFORE  
PROCEEDING WITH THE WORK.  
REPORT DISCREPANCIES TO THE ARCHITECT.  
THE DRAWINGS, IDEAS, AND DESIGNS  
REPRESENTED ON THIS SHEET ARE THE  
PROPERTY OF THE ARCHITECT.  
COPYRIGHT  
ORDIZ-MELBY ARCHITECTS, INC. 2010  
SHEET TITLE  
**LIGHTING PLAN**  
**BUILDING N**

SHEET IDENTIFICATION NUMBER  
**E-132N**  
SHEET OF

LIGHTING PLAN NOTES

- 1 LUTRON WALL CONTROL STATION #DN-X-WH
- 2 LUTRON PHOTO SENSOR #DN-PS-WH
- 3 LUTRON MOTION SENSOR #DN-MS-WH
- 4 LUTRON ENERGI SAVR NODE #DN-277V-0/10V-WH
- 5 LV CABLE TO ENERGI SAVR NODE
- 6 HOMERUN VIA ENERGI SAVR NODE
- 7 CONNECT SKYLIGHT MOTORIZED SHUTTER
- 8 HOMERUN VIA ENERGI SAVR SWITCH
- 9 LUTRON ENERGI SAVR NODE SWITCH #DN-120V-SW-WH
- 10 SENSOR SWITCH #CMR-PDT-277-WH
- 11 SENSOR SWITCH #CMR-PDT-WH CONNECT EF

**Rfi 163**



Request:  
RDM Electric - 10/9/12  
Reference Sheets E-000, E-132C, E-132D, E-132E, E-132F, E-132G, E-132H, E-132P & Lighting Submittal  
The General Notes on the Electrical Plans show the lighting dimmers to be installed for the lighting at +48" to top of box and the light switches to be installed at +42". A 5 button Lutron wall station is shown to be installed for the lighting controls in the classrooms. Please provide mounting height (elevation) for the classroom lighting control wall stations.

Answer:  
Joseph W. Covington - Ordiz-Melby (10/11/12)  
Install all switches and dimmers at +42" to the center of the box.


RFI C-AM LM 00078 DC Switching for Classroom Stations CLO 9/18/2013 9/20/2013 9/25/2013

RDM Electric - 9/18/13  
Reference RFI #822 & Sheets E-132C, E-132D, E-132E, E-132F, E-132G, E-132H, E-132P & E-132P  
For the references in RFI #822, the solutions in the classrooms are to be controlled via an Energi Savr Node. However, per the attached cut sheets, the solutions appear to need separate DC switching to be controlled, which is not shown on the drawings. The plans only show to supply 120V to the solution via the Energi Savr Nodes. Do the classrooms need DC switching to be added as a means of controlling the solution? If so, please advise on the requirements.

John Mackony - JMPE - 9/19/13  
Contact closure on Energi Savr Node will operate shutter. We verified this with Skatube and Lutron.

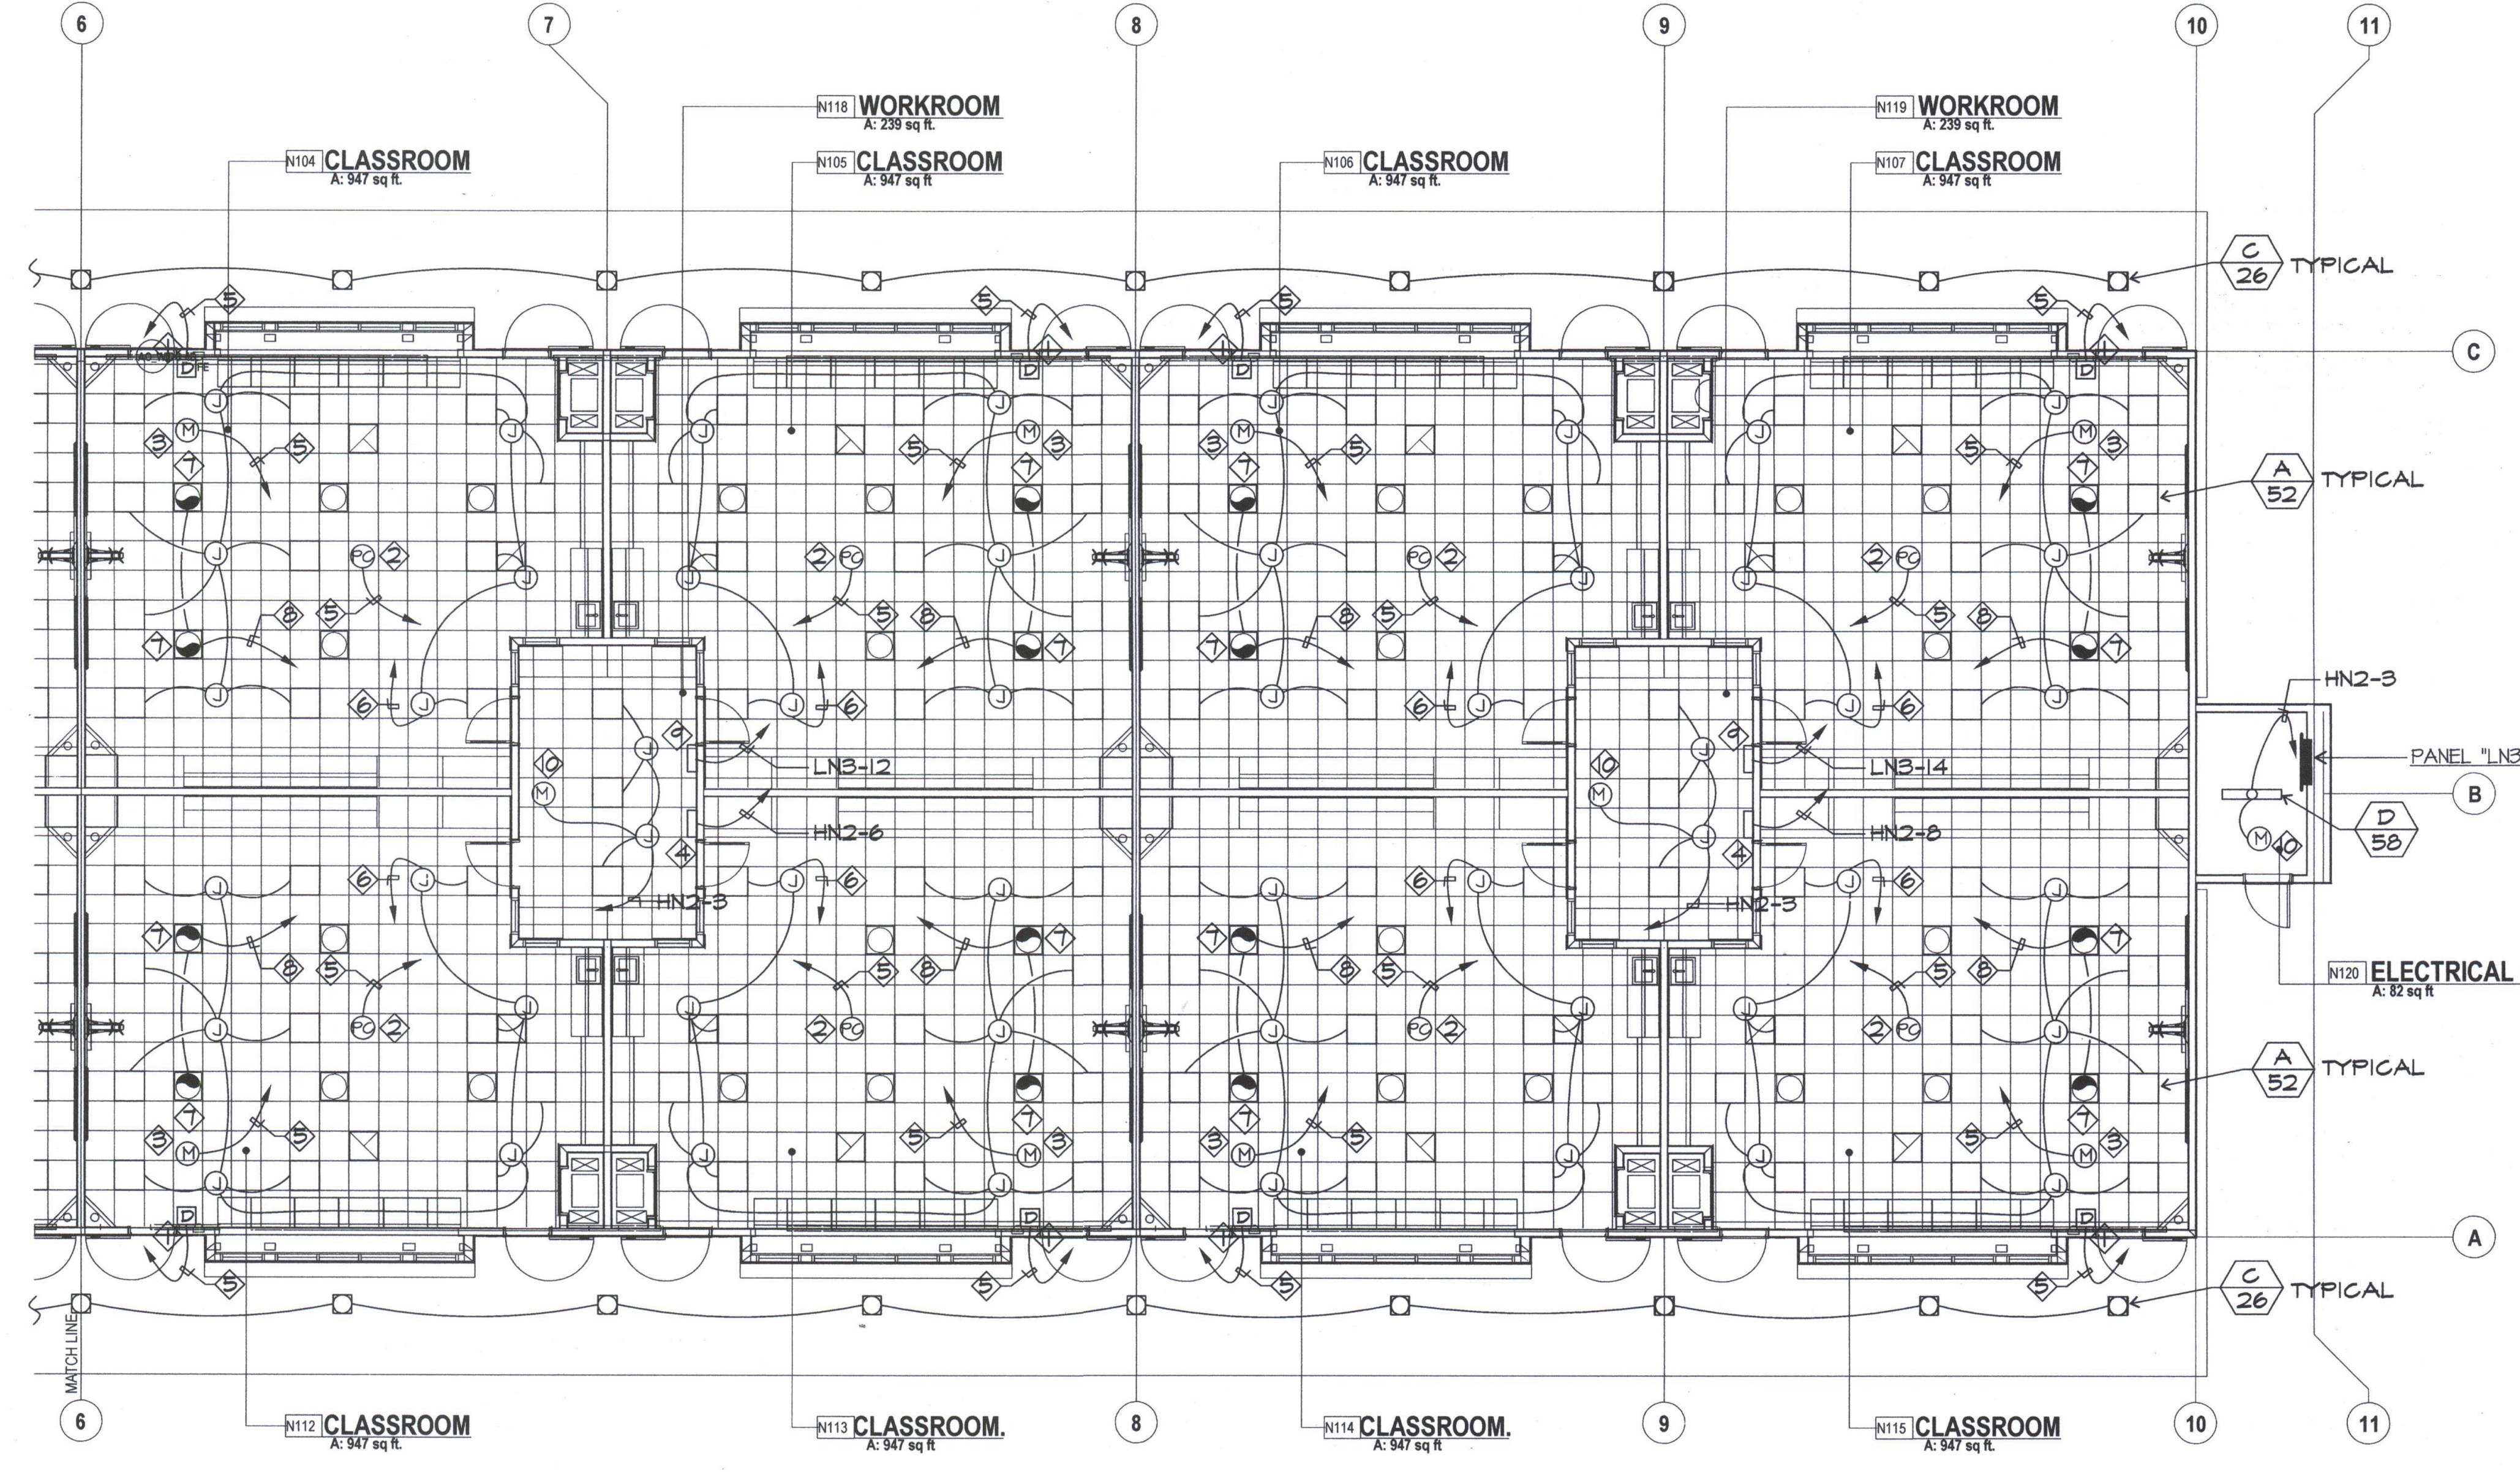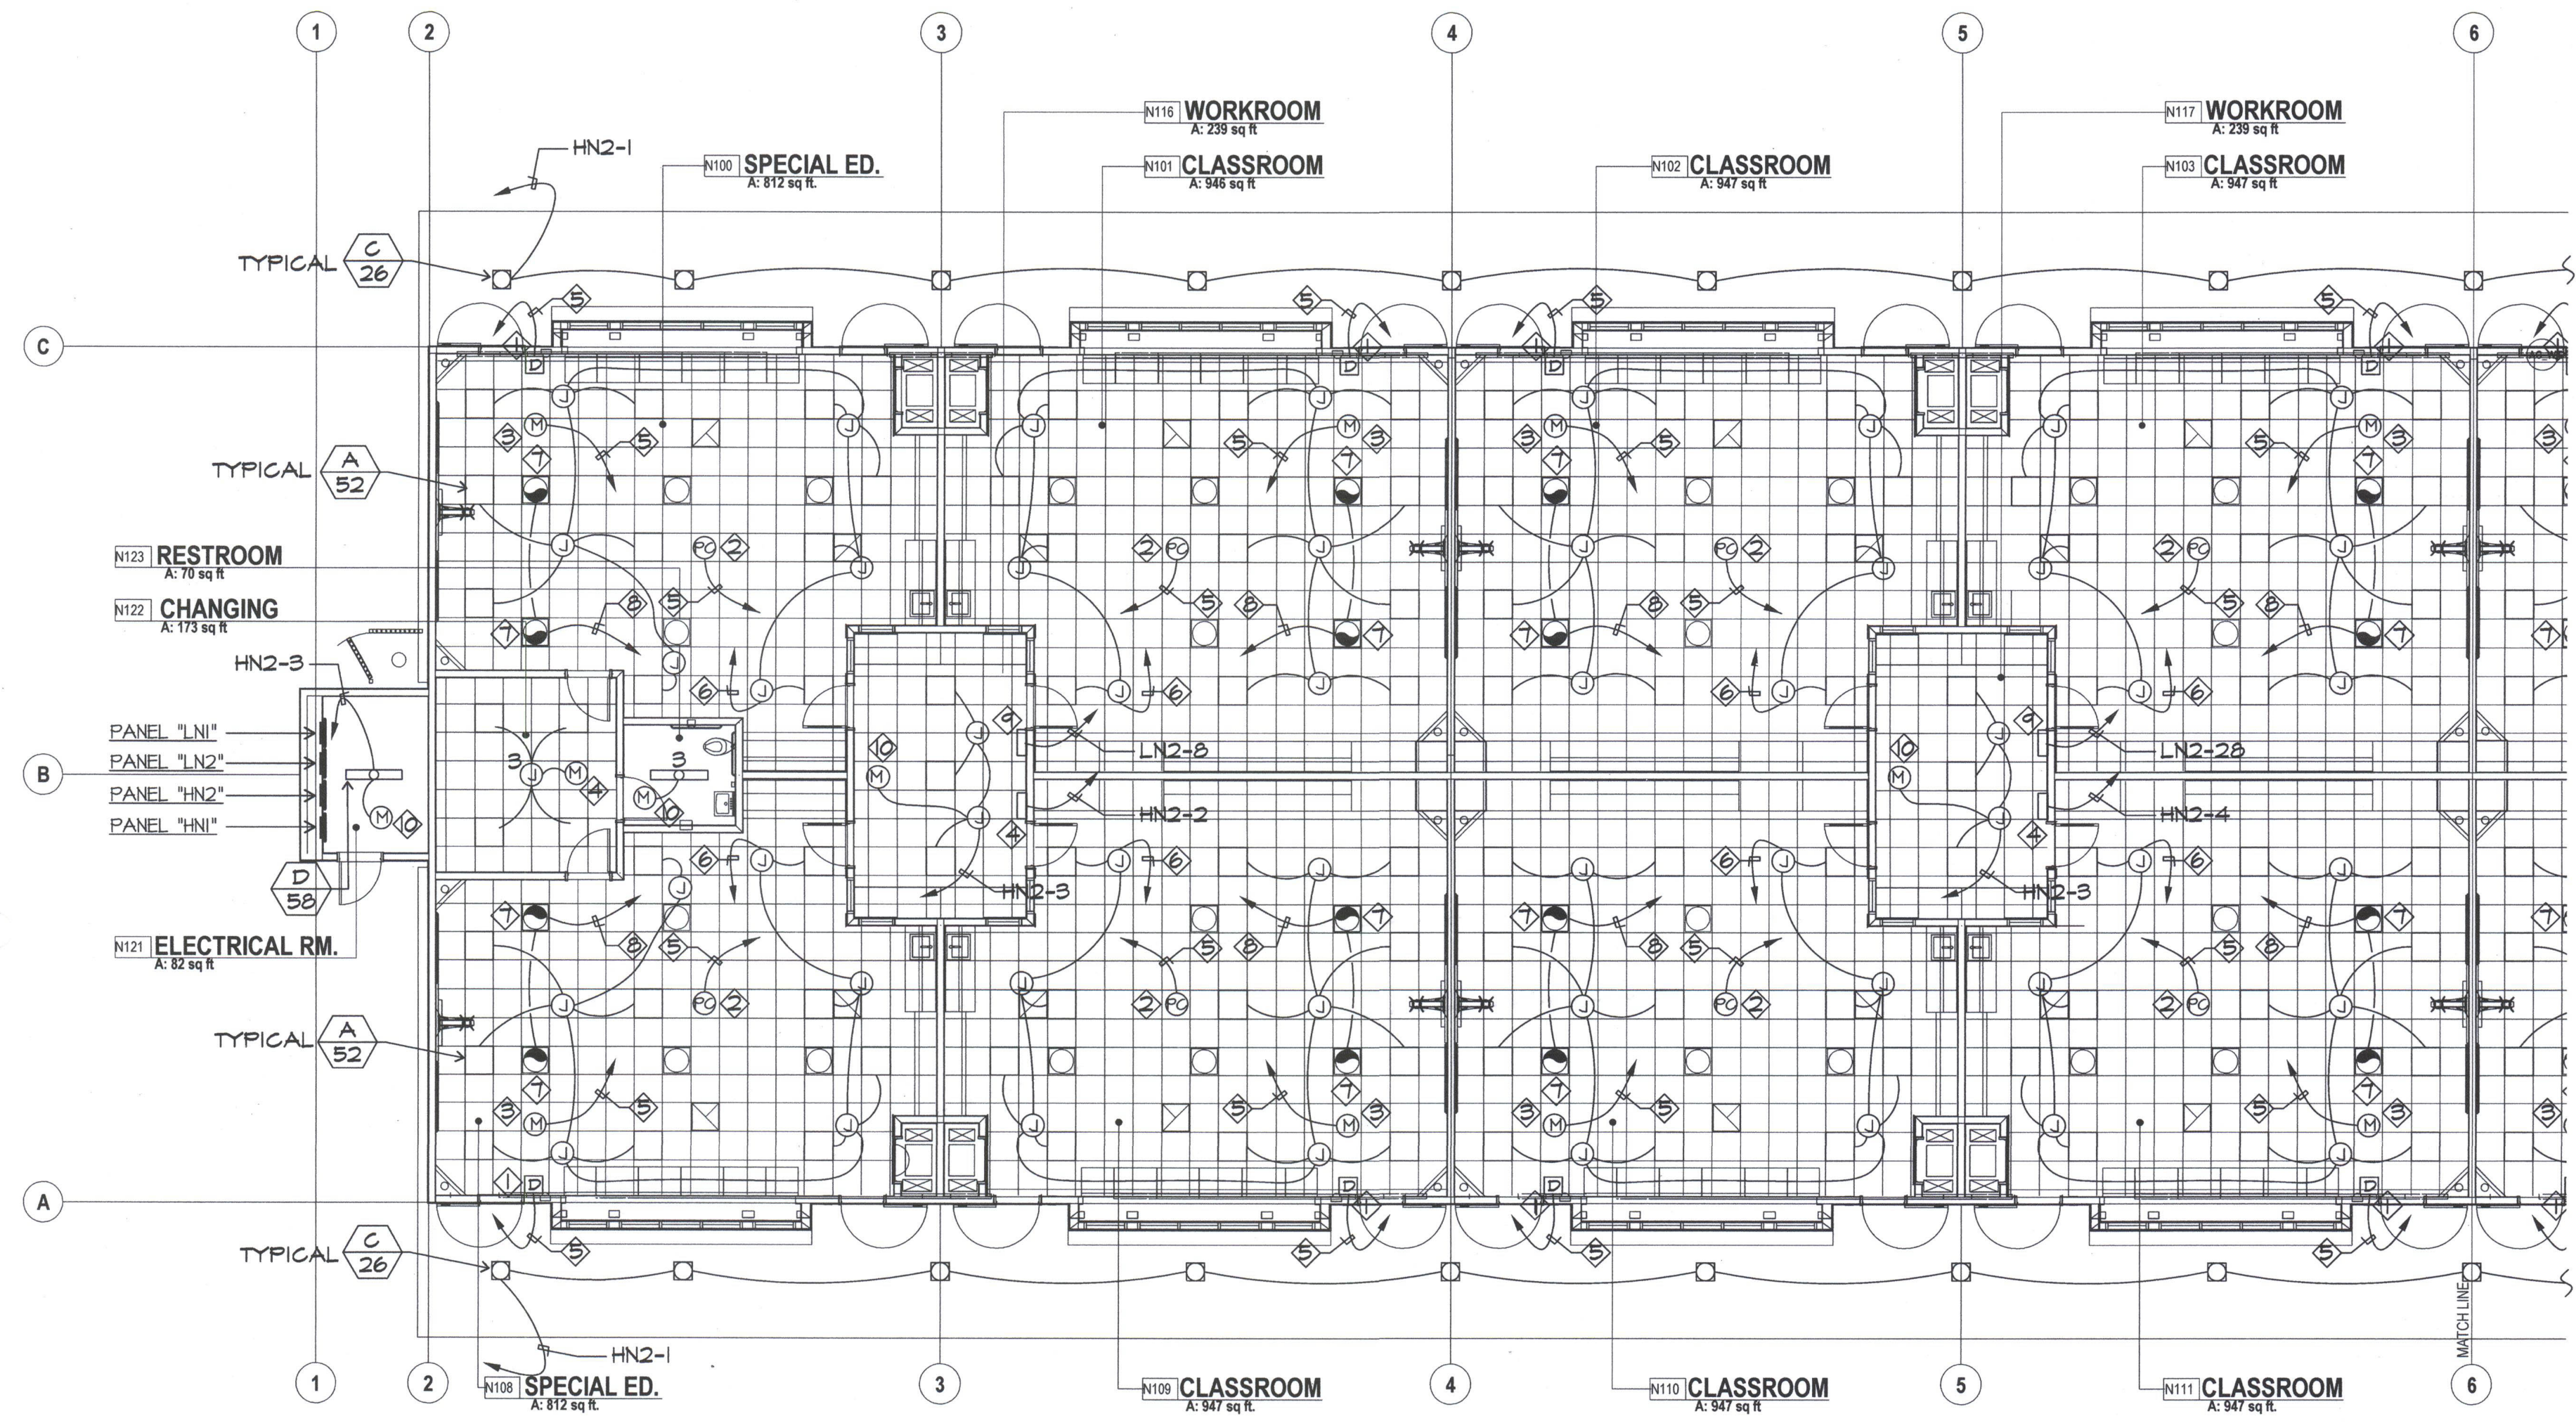

LIGHTING PLAN BUILDING N

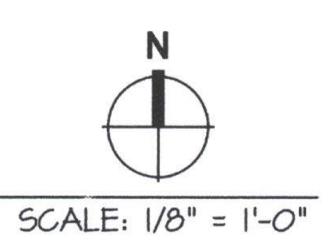

\*FILED 10/24/12 DATE: 10-20-11 AC