

ORDIZ MELBY
ARCHITECTS, INC.

5500 MING AVENUE SUITE 280
BAKERSFIELD, CALIFORNIA 93309
TELEPHONE (661) 832-5258
FACSIMILE (661) 832-4291



MANNY E. ORDIZ, AIA
ARCHITECT C-14,728

WILLIAM J. MELBY, AIA
ARCHITECT C-16,835
CONSULTANT

IDENTIFICATION STAMP
DIVISION OF STATE ARCHITECT
OFFICE OF REGULATION SERVICES


APPL. # : 02-112827
FILE # : 154

AC: [Signature]
DATE: 1/15/12

NEW ELEMENTARY SCHOOL
9801 HIGHLAND KNOLLS DR
BAKERSFIELD
CALIFORNIA
93306

NEW MIDDLE SCHOOL
4115 VINELAND ROAD
BAKERSFIELD
CALIFORNIA
93306

FOR:
BAKERSFIELD CITY SCHOOL DISTRICT
1300 BAKER STREET
BAKERSFIELD
CALIFORNIA
93305

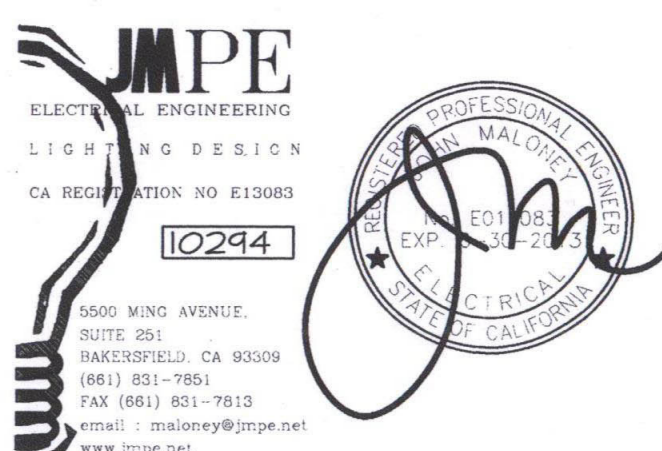

MARK DATE DESCRIPTION

△		
△		
△		
△		

JOB NUMBER:
20101244
CAD DRAWING FILE:

DRAWN BY:
AC
CHECKED BY:
PH

CHECK AND VERIFY ALL DIMENSIONS BEFORE
PROCEEDING WITH THE WORK.
REPORT DISCREPANCIES TO THE ARCHITECT.

THE DRAWINGS, IDEAS, AND DESIGNS
REPRESENTED ON THIS SHEET ARE THE
PROPERTY OF THE ARCHITECT.

COPYRIGHT:
ORDIZ MELBY ARCHITECTS, INC. 2010

SHEET IDENTIFICATION NUMBER

E-132P
SHEET OF


LIGHTING PLAN NOTES

- 1 LUTRON WALL CONTROL STATION #DN-X-WH
- 2 LUTRON PHOTO SENSOR #DN-PS-WH
- 3 LUTRON MOTION SENSOR #DN-MS-WH
- 4 LUTRON ENERGI SAVR NODE #DN-27V-0/10V-WH
- 5 LV CABLE TO ENERGI SAVR NODE
- 6 HOMERUN VIA ENERGI SAVR NODE
- 7 CONNECT SKYLIGHT MOTORIZED SHUTTER
- 8 HOMERUN VIA ENERGI SAVR NODE SWITCH
- 9 LUTRON ENERGI SAVR NODE SWITCH #DN-120V-SW-WH
- 10 SENSOR SWITCH #CMR-PDT-277-WH

RFI 163

Request:
RDM Electric - 10/9/12
Reference Sheets E-000, E132C, E-132D, E132E, E-132F, E-132G, E-132H, E-132P & Lighting Submittal
The General Notes on the Electrical Plans show the lighting dimmers to be installed at +48" to top of box and the light switches to be installed at +42". A 5-button Lutron wall station is shown to be installed for the lighting controls in the classrooms. Please provide mounting height (elevation) for the classroom lighting control wall stations.

Answer:
Joseph W. Covington - Ordiz-Melby (10/11/12)
Install all switches and dimmers at +42" to the center of the box.

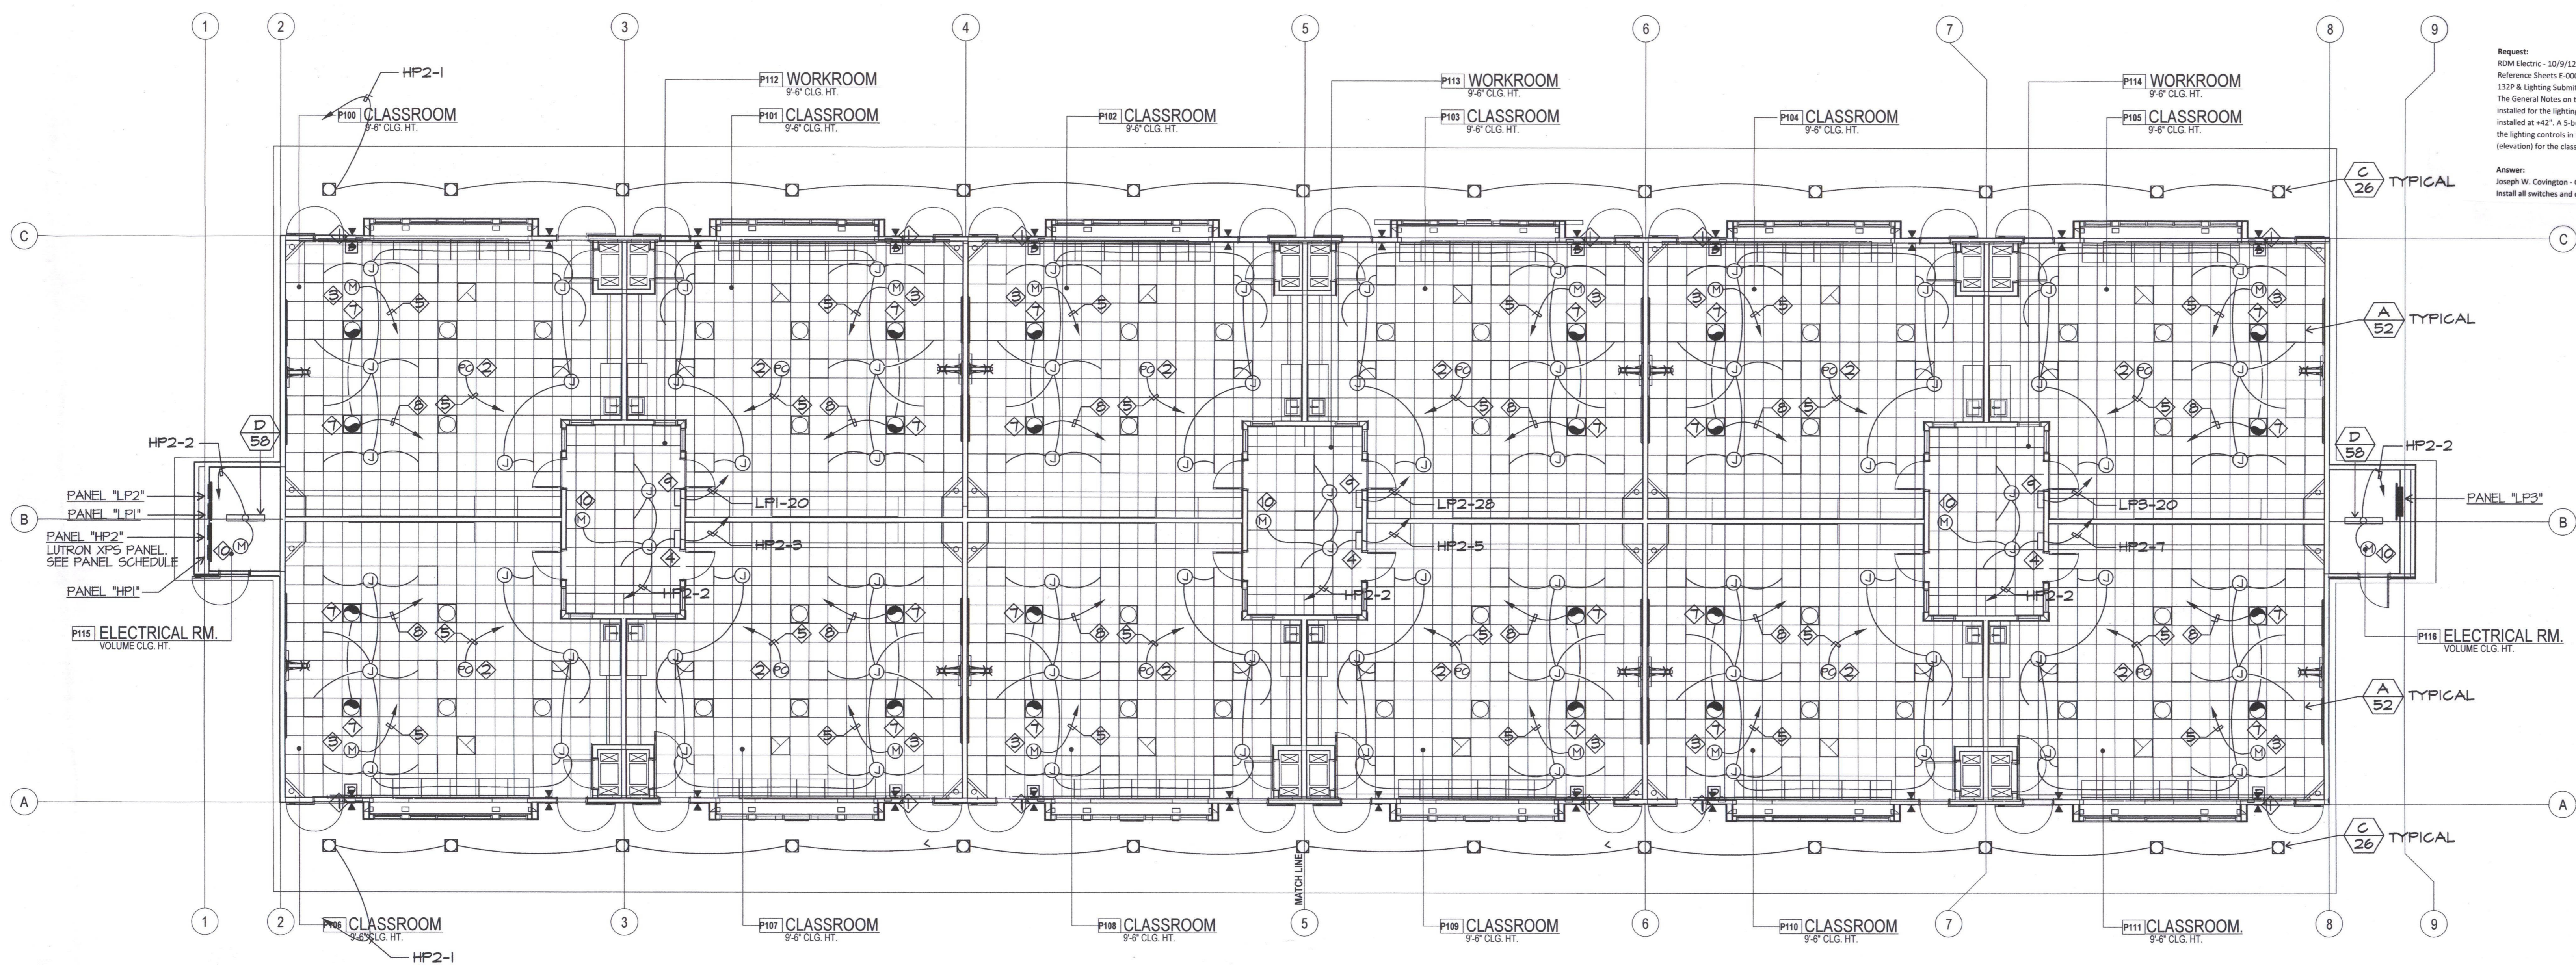


LIGHTING PLAN BUILDING P

RFI O-M LM 05378 DC Switching for Classroom Schedules CLO 8/18/2013 9/20/2013 9/25/2013

RDM Electric - 9/19/13
John Maloney - JMPE - 9/19/13
Contact closure on Energi Savr Node will operate skylight shutter. We verified this with Sotabue and Lutron.

Reference RFI #252 & Sheets E132C, E132D, E132E, E132F, E132G, E132H, E132I & E132P
For the response to RFI #252, the skylights in the classrooms are to be controlled via an Energi Savr Node. However, per the electrical code, the skylights appear to need separate DC switching to be controlled, which is not shown on the drawings. The plans only show to supply 120V to the skylights via the Energi Savr Nodes. Do the classrooms need DC switching to be added as a means of controlling the skylights? If so, please advise on the requirements.

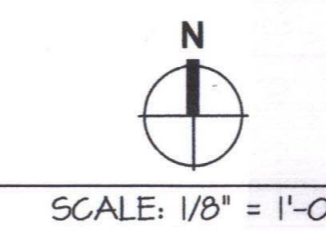

P:\E\JOB\1024\DATE\12-13-11 AC