
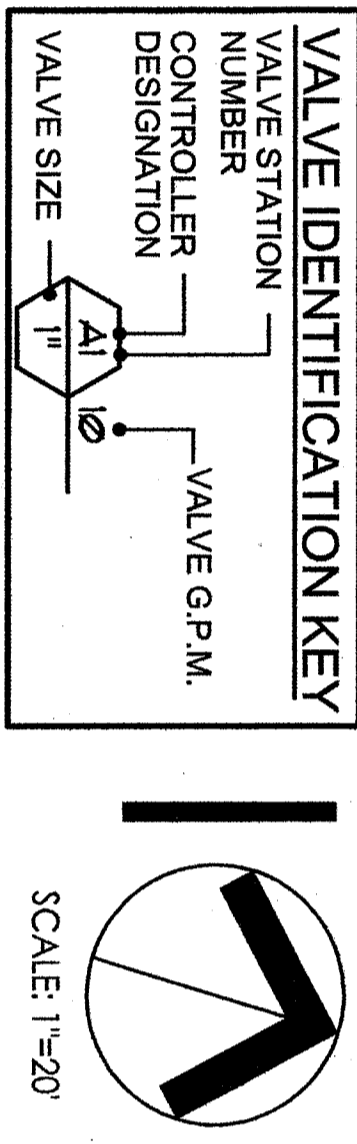


MATCHLINE, SEE SHEET H

MATCHLINE, SEE SHEET F

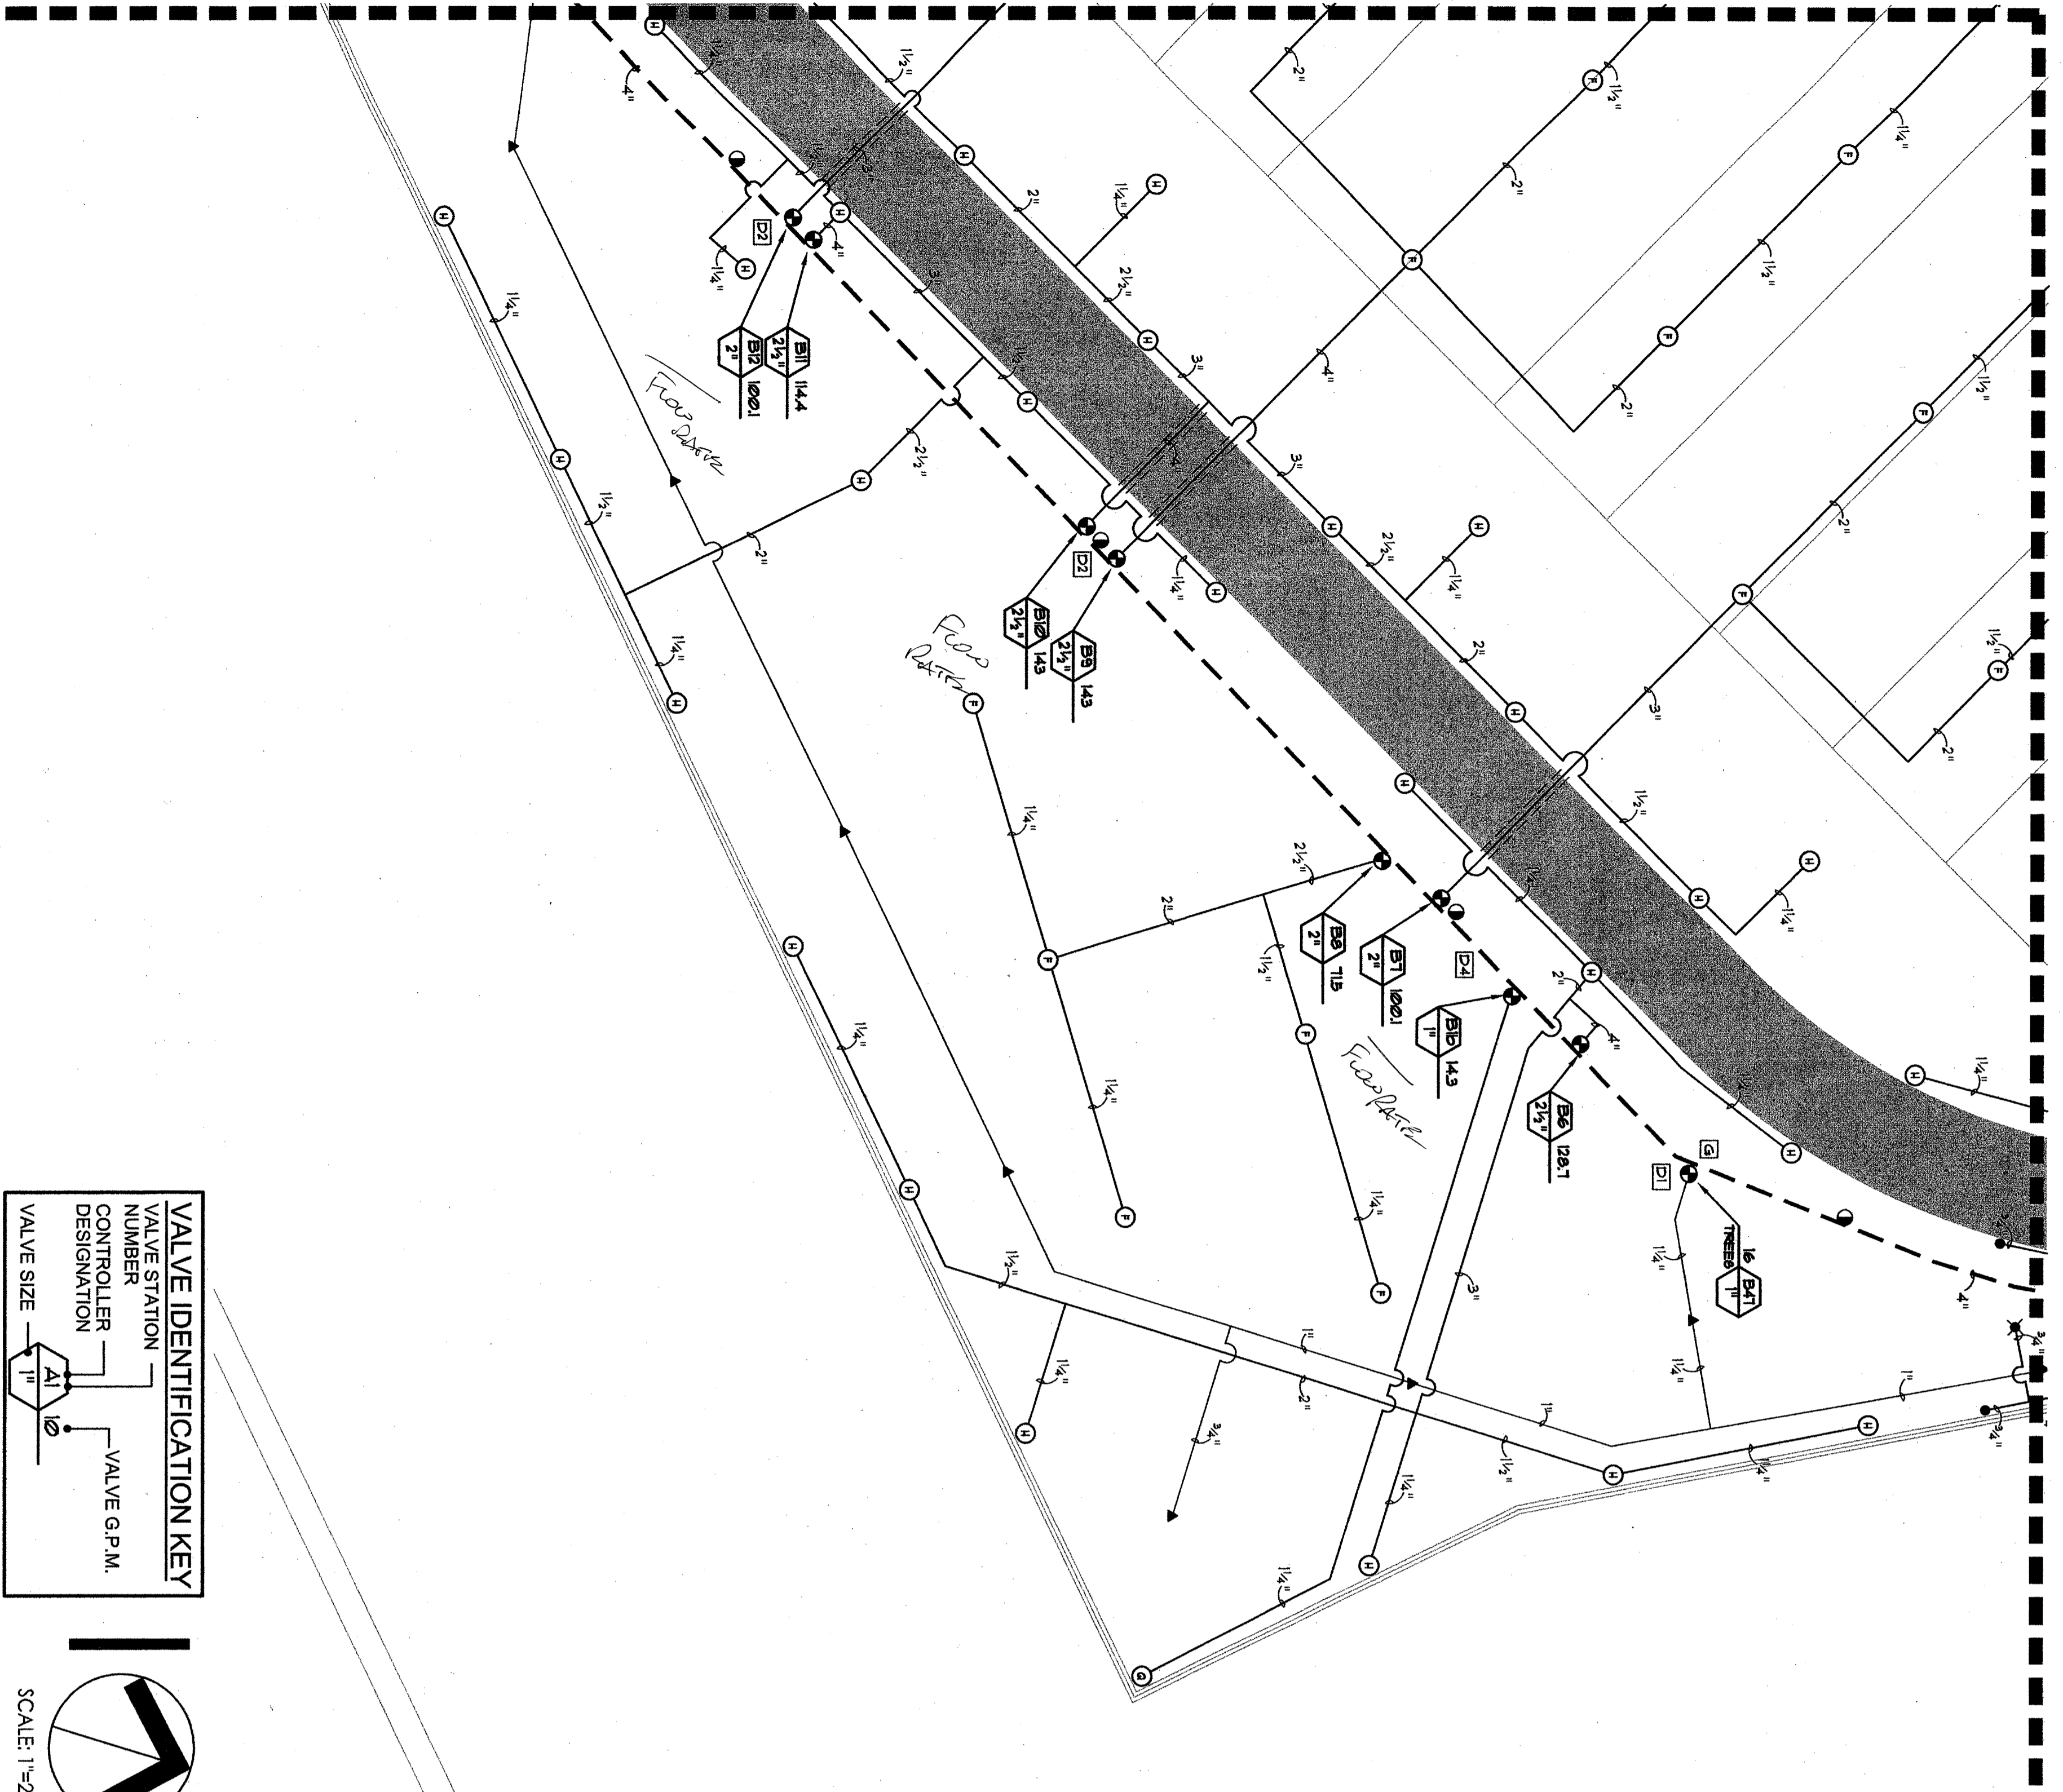

SCALE: 1"=20'

IRRIGATION PLAN NOTES

CONTRACTOR SHALL PROVIDE ALL LABOR, MATERIALS, AND EQUIPMENT NEEDED FOR THE INSTALLATION AND MAINTENANCE OF THE IRRIGATION SYSTEM...

CONTRACTOR SHALL FLUSH ALL LINES AND ADJUST ALL HEADS FOR OPTIMUM PERFORMANCE IN ACCORDANCE WITH THE SPECIFICATIONS AND TO PREVENT OVERSPRAY ONTO HARDSCAPE AREAS OR...

SYSTEM DESIGN IS BASED ON A MINIMUM OPERATING PRESSURE (P.S.I.) AND A MAXIMUM DEMAND (G.P.M.) AS SHOWN AT EACH POINT OF CONNECTION ON THE DRAWINGS...

EQUIPMENT SHOWN IN HARDSCAPE AREAS ARE FOR DESIGN CLARIFICATION ONLY AND SHALL BE INSTALLED WHENEVER POSSIBLE WITHIN PLANTED AREAS...

UNLESS OTHERWISE NOTED ON THE DRAWINGS, CONTRACTOR SHALL INSTALL AND MAINTAIN HARDSCAPE AREAS IN P.V.C. SCHEDULE 40 PIPES AND FITTINGS IN ACCORDANCE WITH APPLICABLE CODES...

EACH CONTROLLER SHALL HAVE ITS OWN INDEPENDENT GROUND WIRE. SPlicing OF 24 VOLT WIRES WILL NOT BE PERMITTED EXCEPT IN VALVE BOXES...

FINAL LOCATION FOR BACKFLOW PREVENTION DEVICES SHALL BE APPROVED BY THE DISTRICTS AUTHORIZED REPRESENTATIVE PRIOR TO INSTALLING AND TESTING OF INSTALLED BACKFLOW PREVENTION DEVICES...

CONTRACTOR SHALL INSTALL ANTI-DRAIN CHECK VALVES AS NECESSARY TO PREVENT LOW HEAD DRAINAGE. IRRIGATION HEADS SHALL BE SET PERPENDICULAR TO FINISH GRADE OF THE AREA TO BE IRRIGATED...

IRRIGATION LEGEND


Table with 4 columns: SYMBOL, MANUF., ITEM DESCRIPTION, and DETAILSHEET. Lists various irrigation components like Hunter valves, FESCO, and Grundfos pumps with their respective detailsheets.

NOTE: HUNTER INDUSTRIES WILL BE PROVIDING THE IRRIG2000 CENTRAL CONTROL SOFTWARE TO THE SCHOOL DISTRICT AS PER PRE-DETERMINED AGREEMENT.

NOTES REFER TO SHEET 111, 112 & 113 FOR IRRIGATION DETAILS.



ROS DESIGN STUDIO LANDSCAPE ARCHITECTURE & DESIGN 3850 ORANGE AVENUE BAKERSFIELD, CALIFORNIA 93309

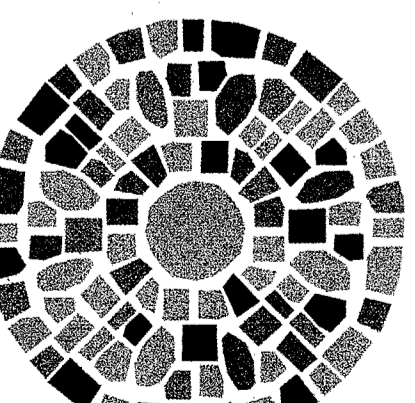

ORDIZ MELBY ARCHITECTS, INC. 5600 KING AVENUE BAKERSFIELD, CALIFORNIA 93309

DIVISION OF STATE ARCHITECT OFFICE OF REGULATION SERVICES APP# 402-12027 FILE #: 15-6 DATE: JAN 2, 2012

NEW ELEMENTARY SCHOOL 9801 HIGHLAND ROAD BAKERSFIELD CALIFORNIA 93306

NEW MIDDLE SCHOOL 4115 VINELAND ROAD BAKERSFIELD CALIFORNIA 93306

BAKERSFIELD CITY SCHOOL DISTRICT 1300 BAKER STREET BAKERSFIELD CALIFORNIA 93305

Table with 2 columns: MARK, DESCRIPTION. Lists various symbols used in the drawing.

IRRIGATION PLAN, LEGEND AND NOTES SHEET IDENTIFICATION NUMBER L10

14444444 A (MULTIPURPOSE)-CD.rvt