


MATCHLINE, SEE SHEET D

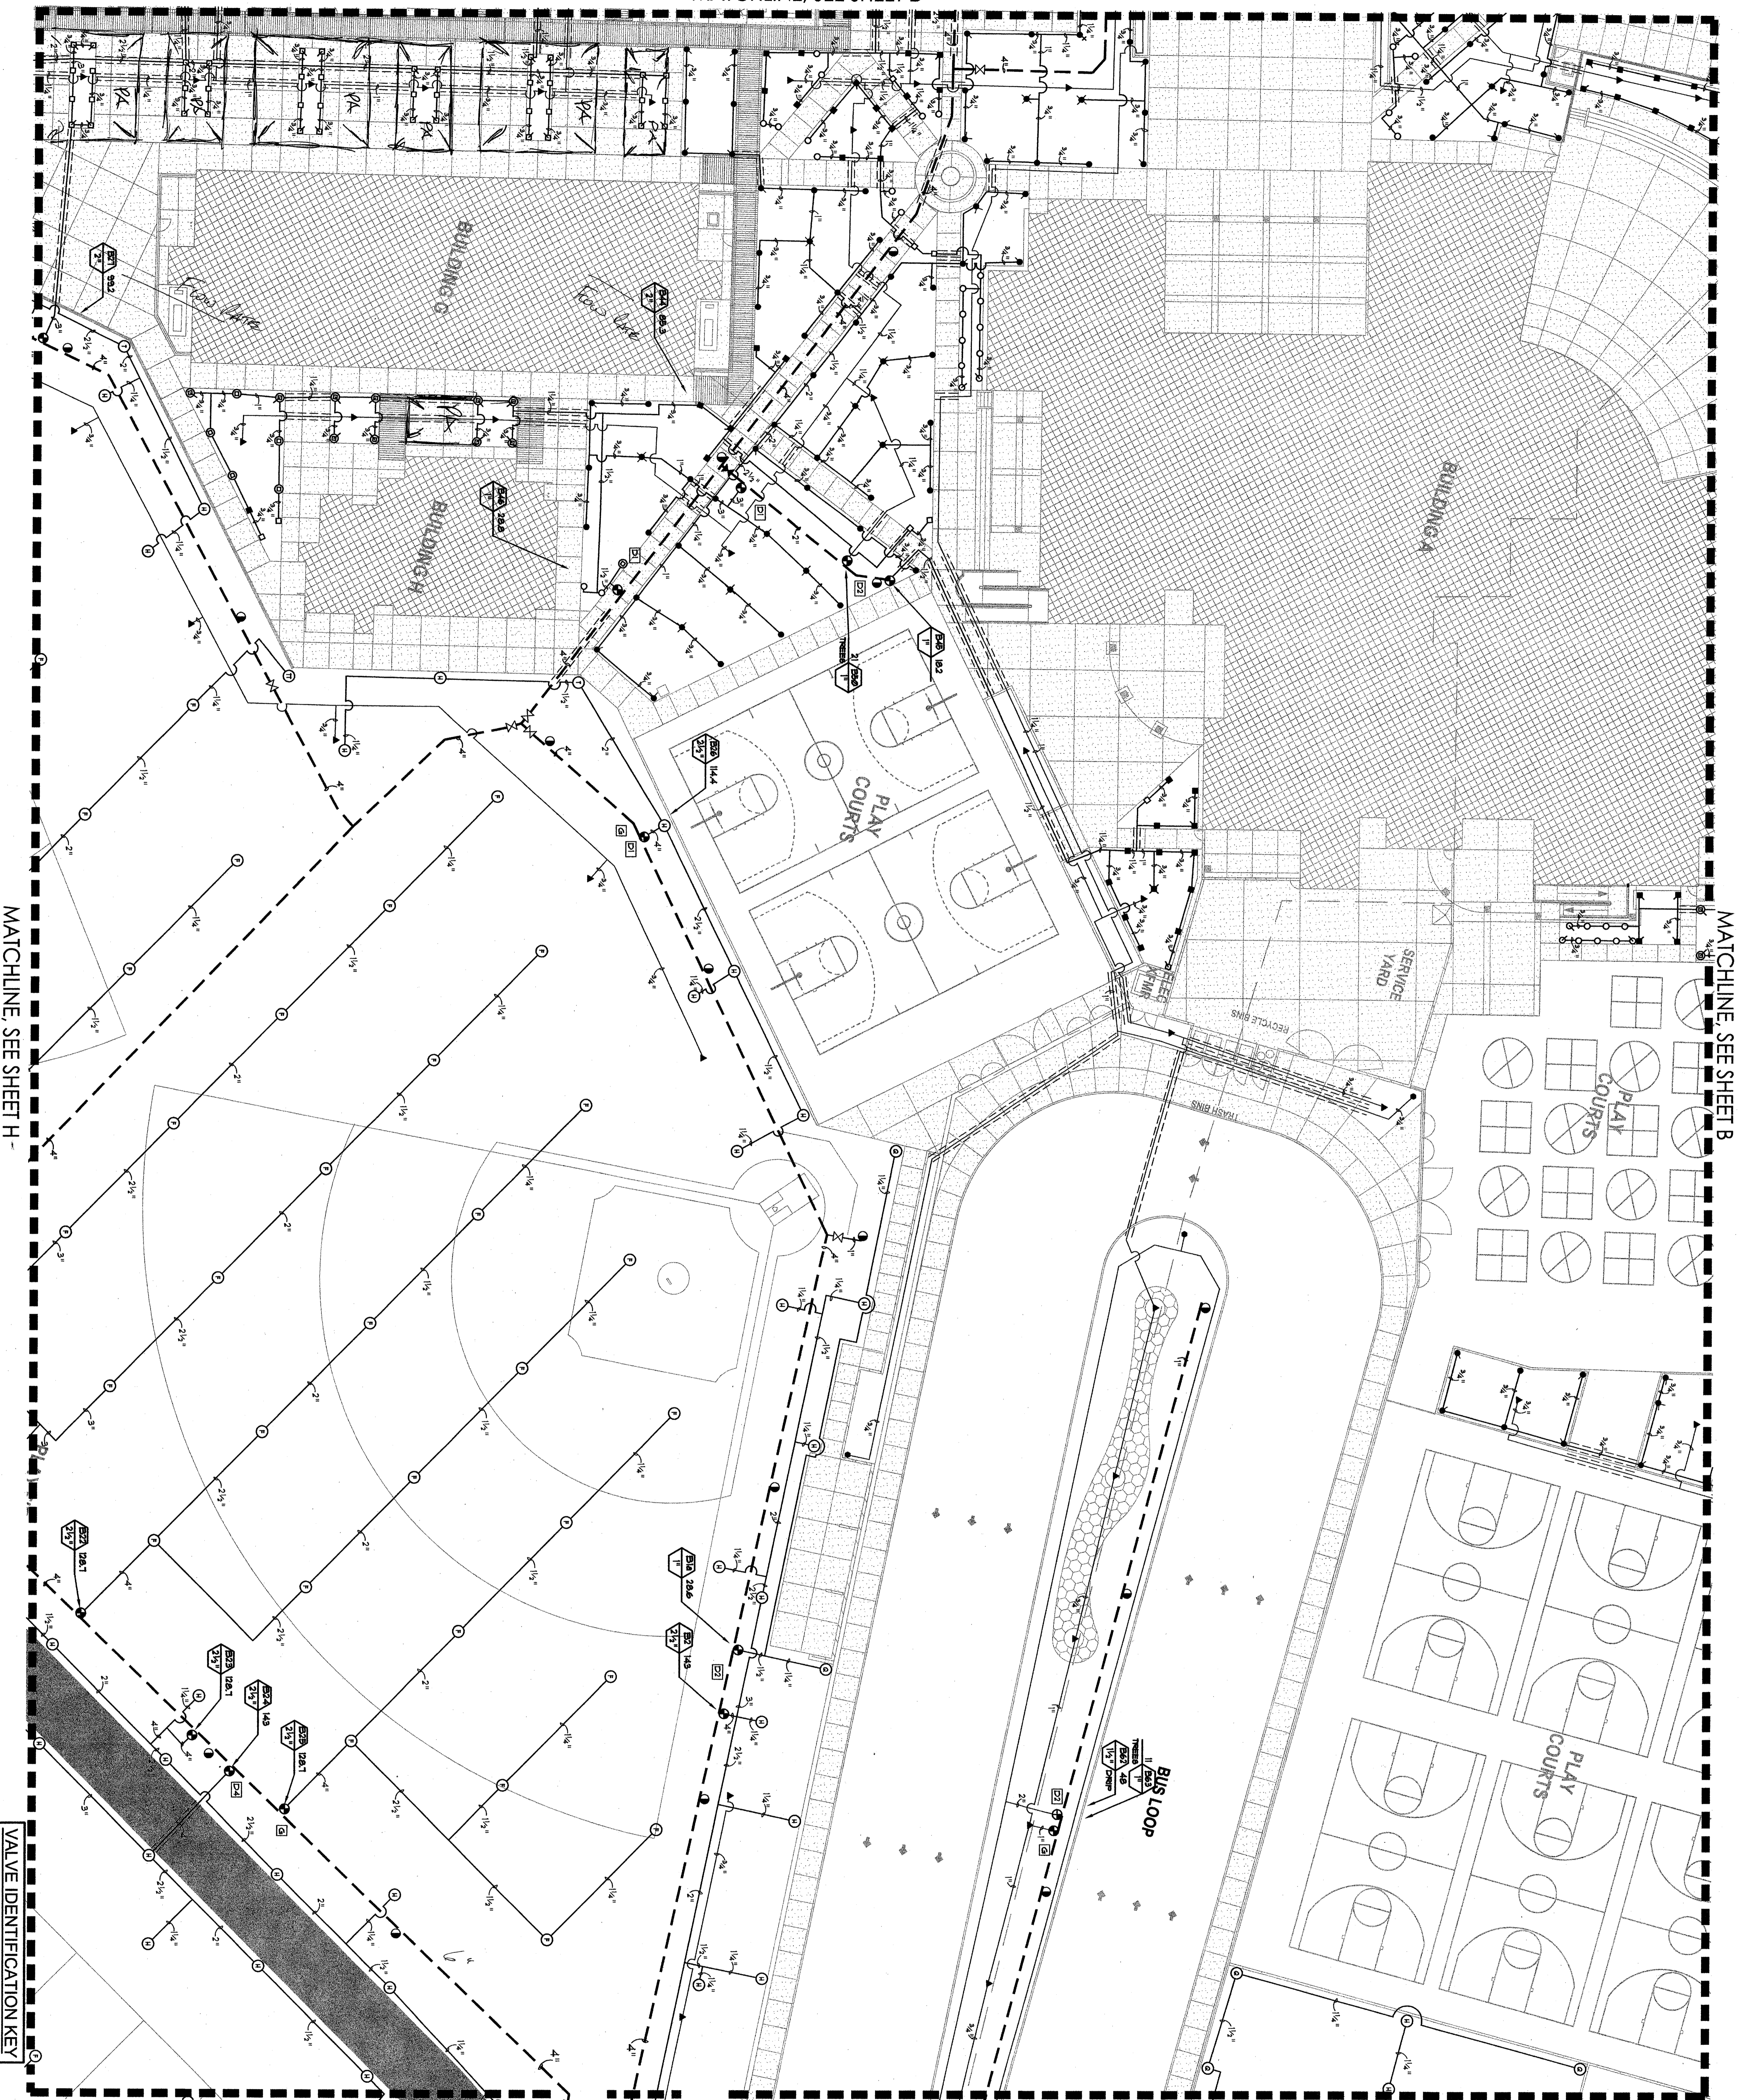


MATCHLINE, SEE SHEET B


MATCHLINE, SEE SHEET H

MATCHLINE, SEE SHEET F


NOTES
 REFER TO SHEET L10 FOR
 IRRIGATION LEGEND AND NOTES
 REFER TO SHEET L11, L12 & L13
 FOR IRRIGATION DETAILS.

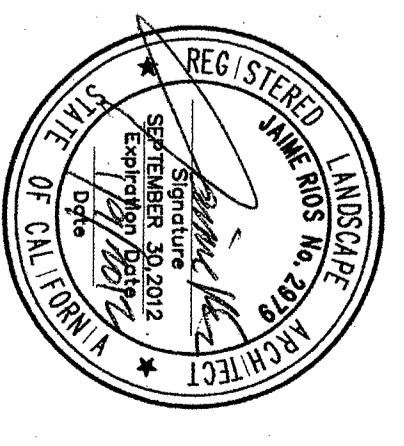

RIO'S DESIGN STUDIO
 LANDSCAPE ARCHITECTURE & DESIGN
 3805 OAK VISTA AVENUE
 93309
 P: 661.835.9259
 F: 661.327.5284

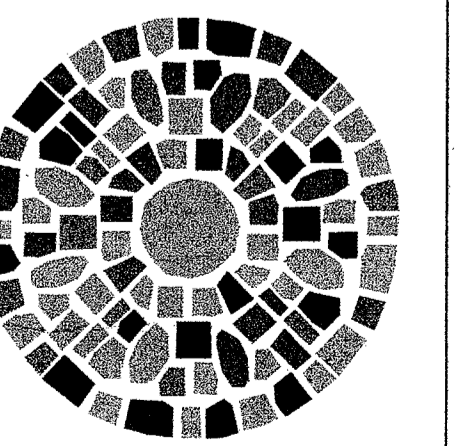

ORDIZ MELBY ARCHITECTS, INC.
 5600 KING AVENUE SUITE 200
 BAKERSFIELD, CALIFORNIA 93309
 TELEPHONE (805) 832-2255
 FACSIMILE (805) 832-2251

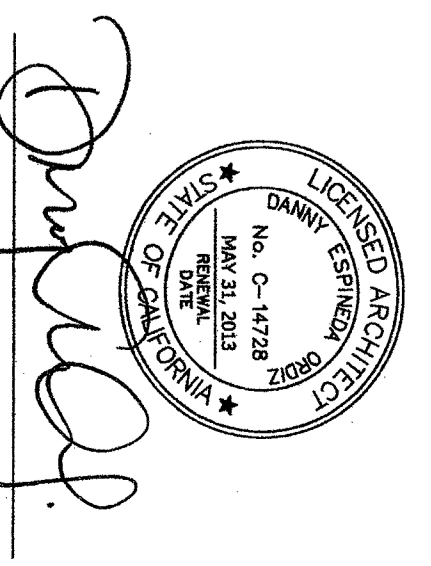

REGISTRATION NUMBER
 DIVISION OF REGULATION SERVICES
 APPL. #02-112027
 FILE #: 15-6
 FEB 21 2012
 DATE JAN 20 2012
 FPN # 8321-112

FOR:
 NEW ELEMENTARY SCHOOL
 9801 HIGHLAND KNOLLS DR
 BAKERSFIELD CALIFORNIA 93306
 NEW MIDDLE SCHOOL
 4115 VINELAND ROAD
 BAKERSFIELD CALIFORNIA 93306

BAKERSFIELD CITY SCHOOL DISTRICT
 1300 BAKER STREET
 BAKERSFIELD CALIFORNIA 93305


MARK	DATE	DESCRIPTION
△		
△		
△		
△		

DESIGNED BY:
 DANIEL A. WILSON
 200101244
 134444.DWG A (MULTIPURPOSE) CD.dwg
 10/24/2011
 10:38 AM

CHECKED BY:
 GREGORY L. HARRIS
 10/24/2011
 10:38 AM

PROJECT:
 BAKERSFIELD CITY SCHOOL DISTRICT
 1300 BAKER STREET
 BAKERSFIELD, CALIFORNIA 93305

SHEET TITLE:
 IRRIGATION PLAN

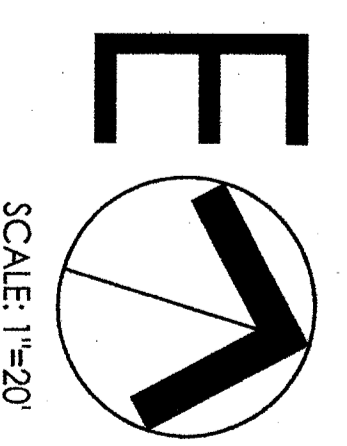

SCALE: 1"=20'

IRRIGATION PLAN
 SHEET IDENTIFICATION NUMBER
L6