


LANDING FRAME

12


SCALE: NTS

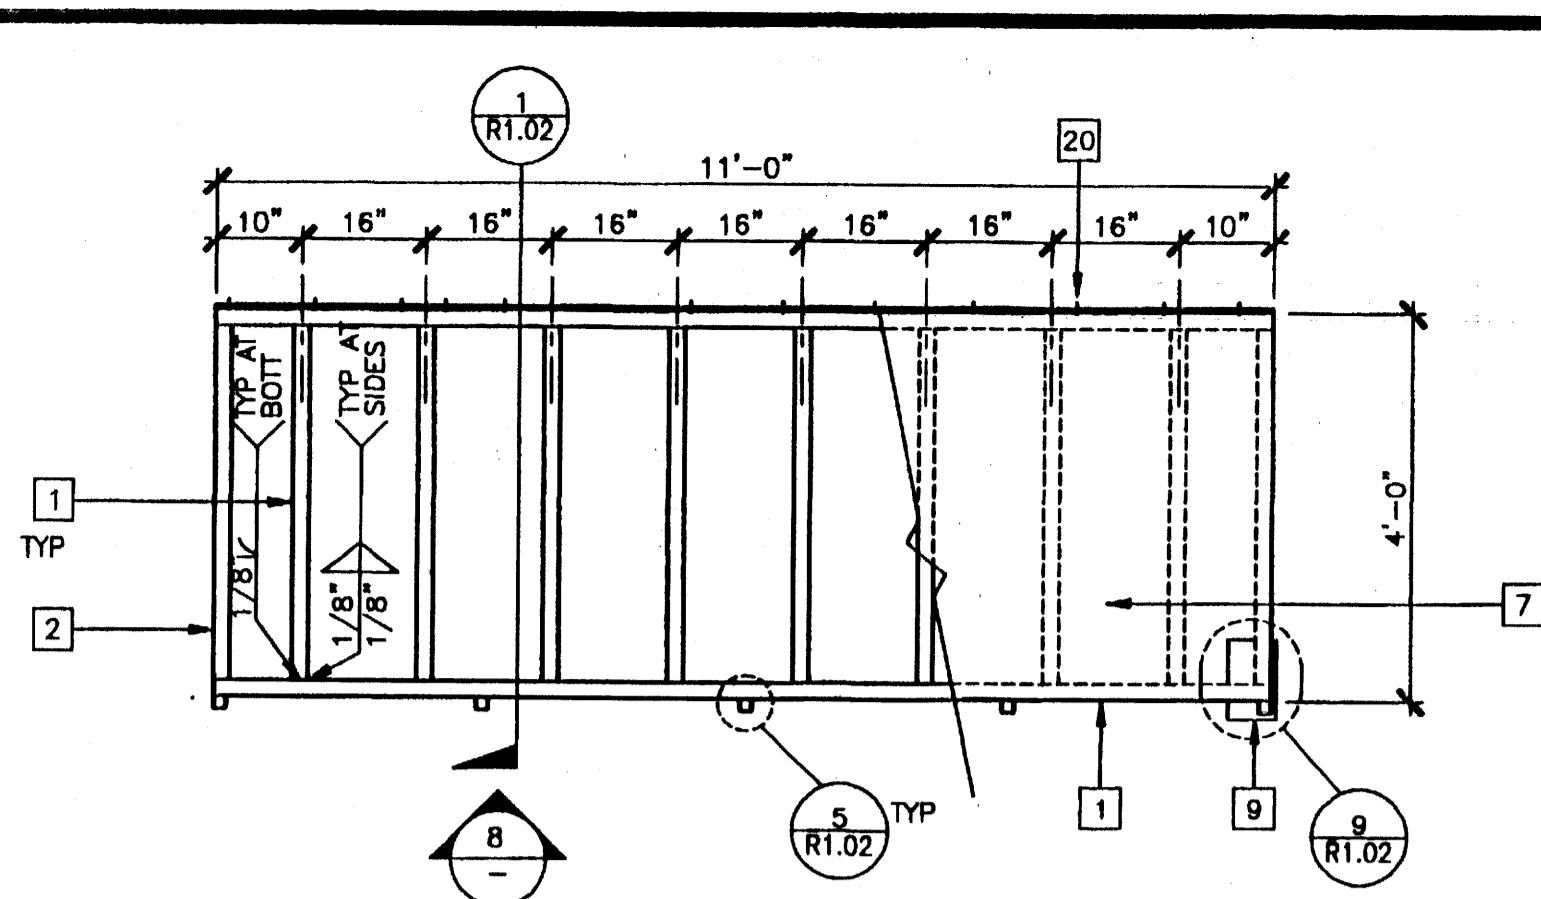

RAMP FRAME


7

SCALE: 3/8"=1'-0"

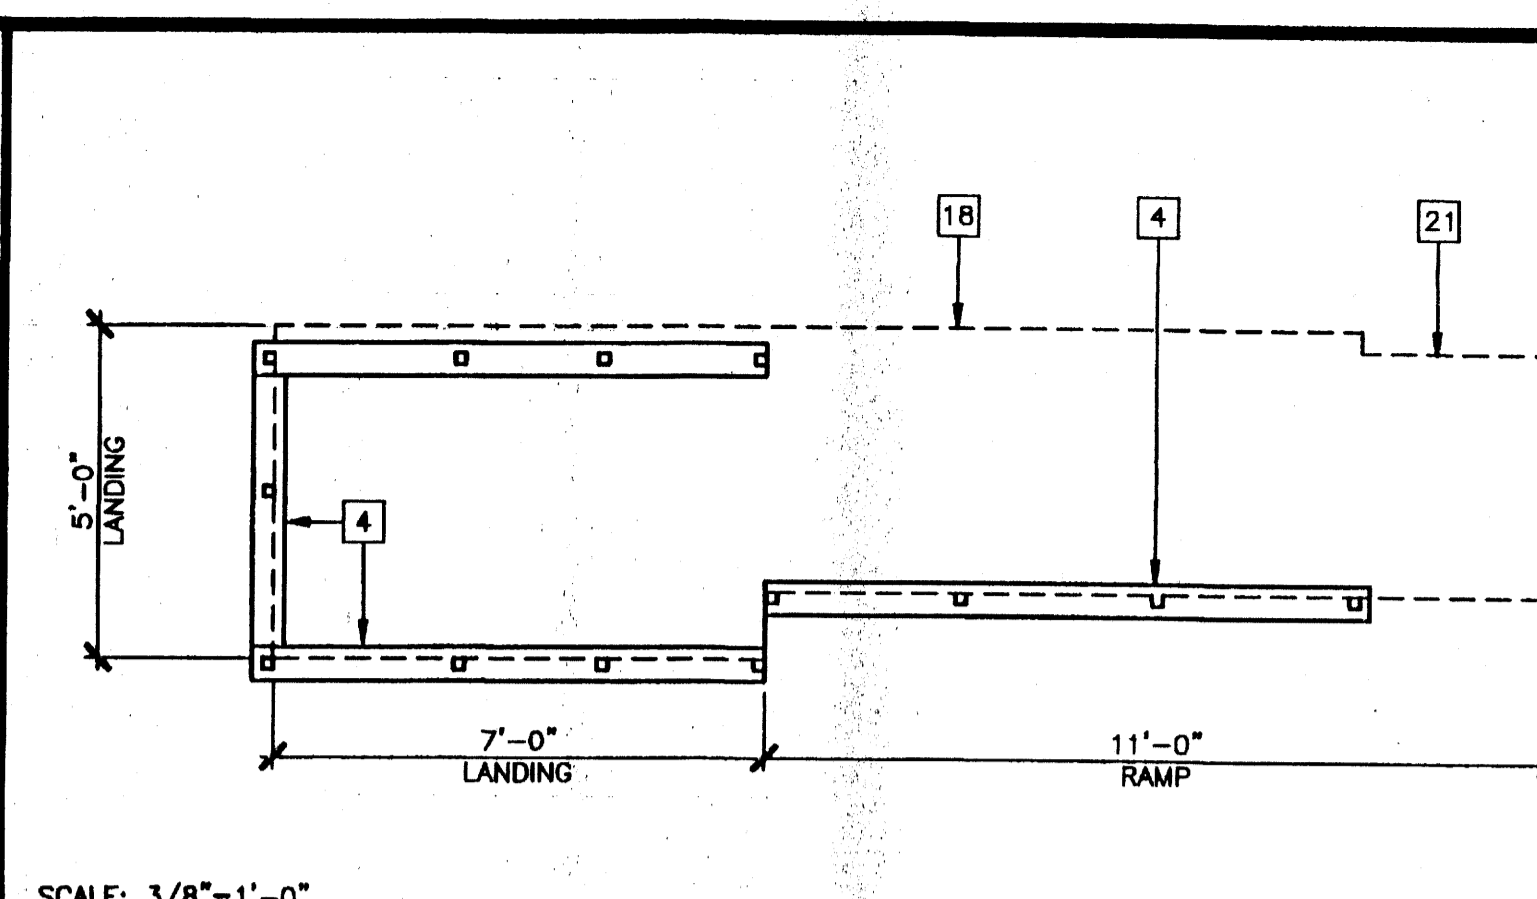

SILL PLAN FOR RAMP AND LANDING


1

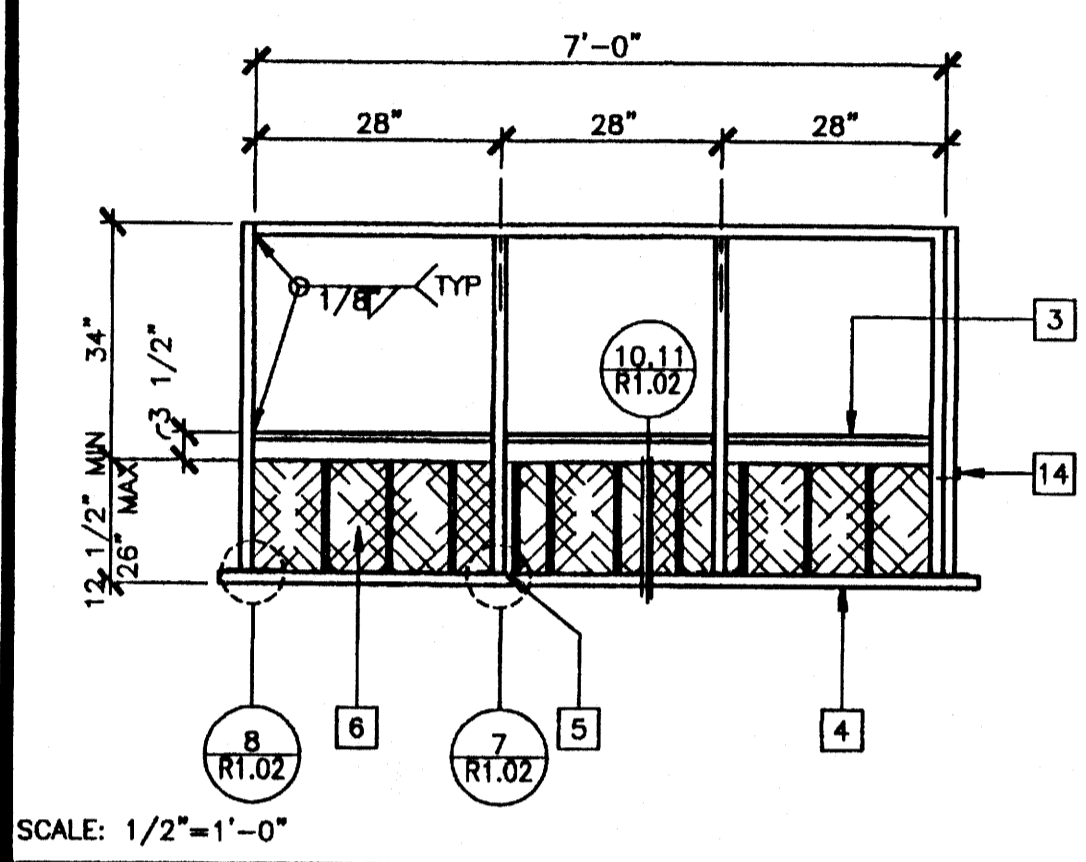

LANDING ELEVATION

13


SCALE: 1/2"=1'-0"

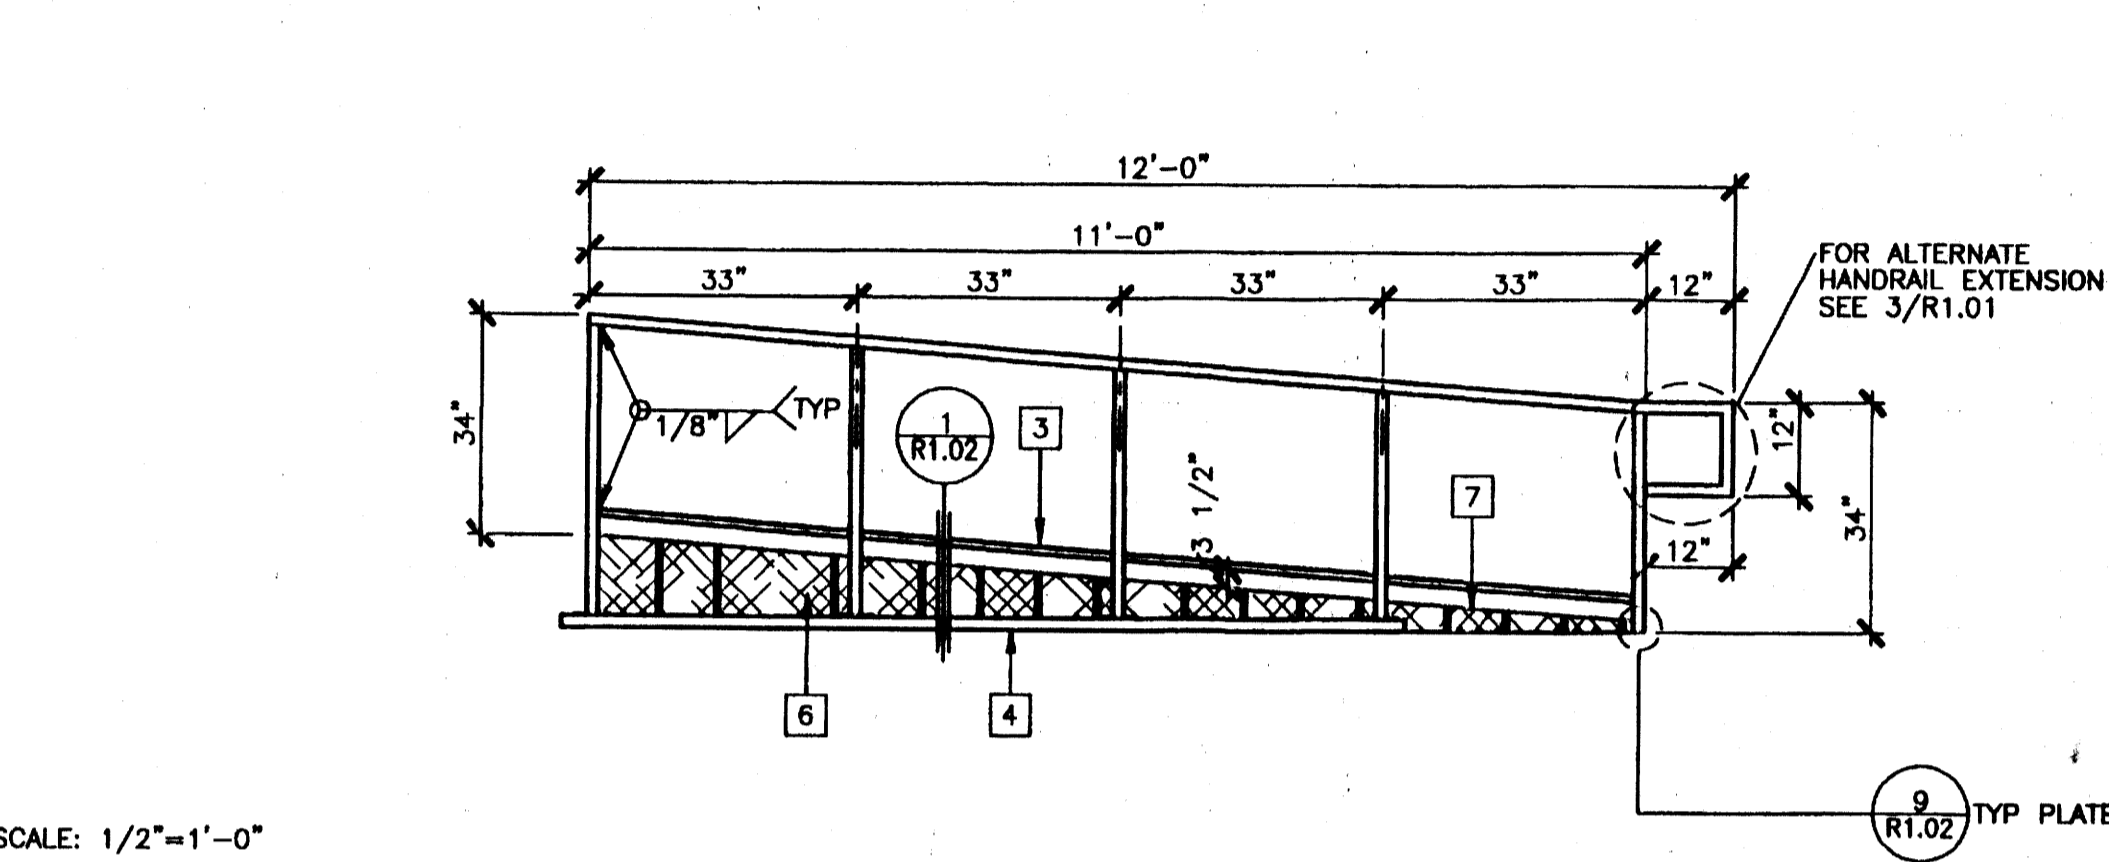

RAMP ELEVATION

8


SCALE: 1/2"=1'-0"

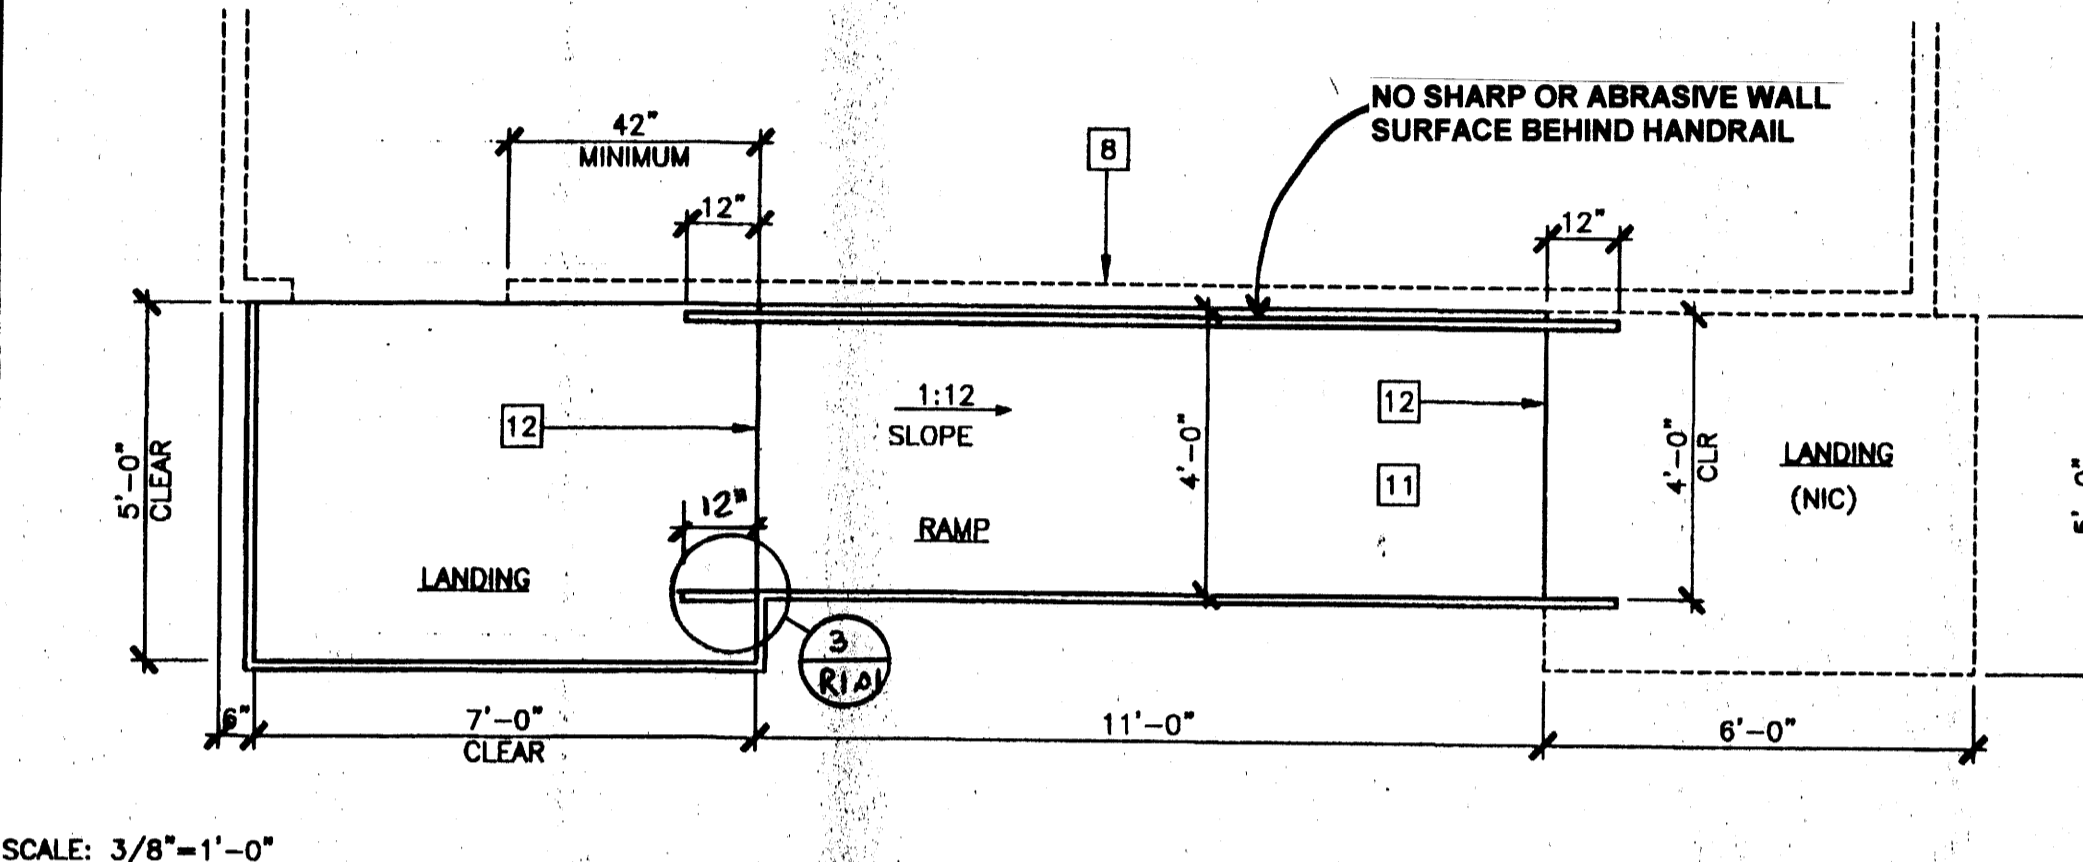

RAMP AND LANDING AT BUILDING

2


SCALE: 3/8"=1'-0"

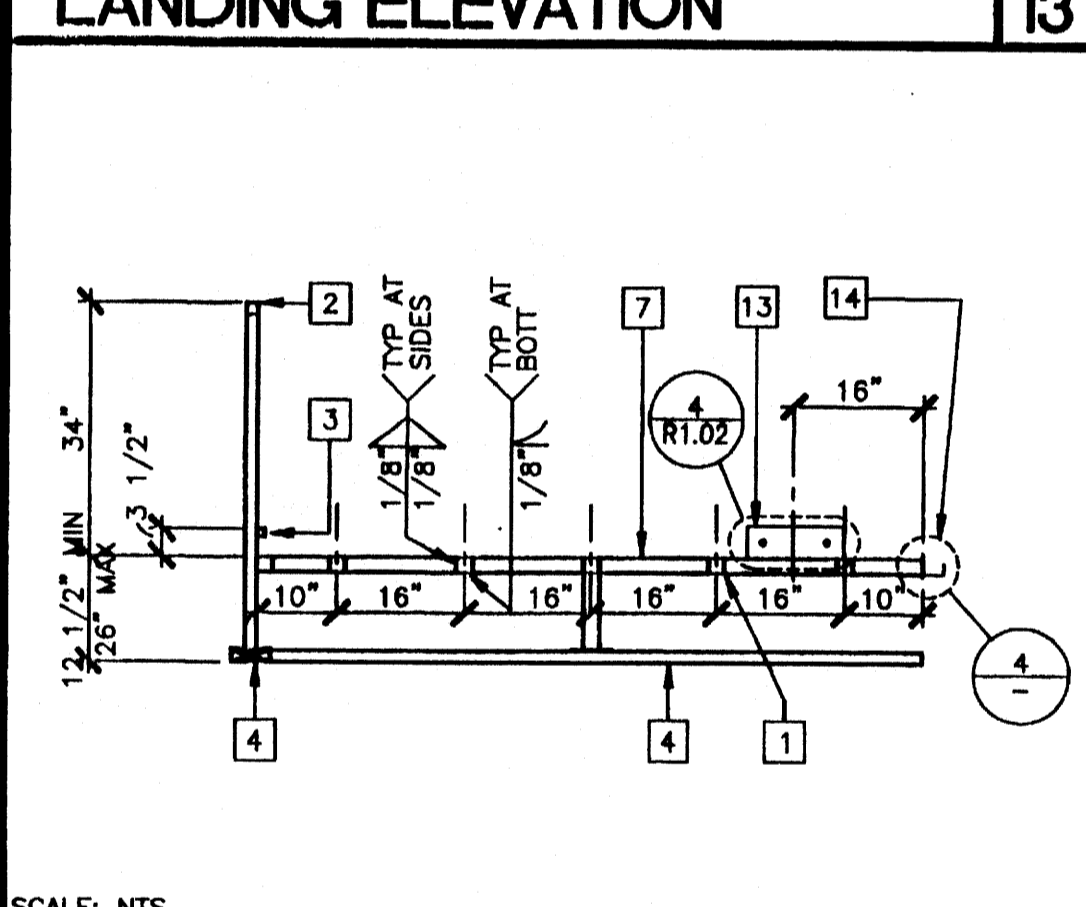

SECTION AT LANDING

14


SCALE: NTS

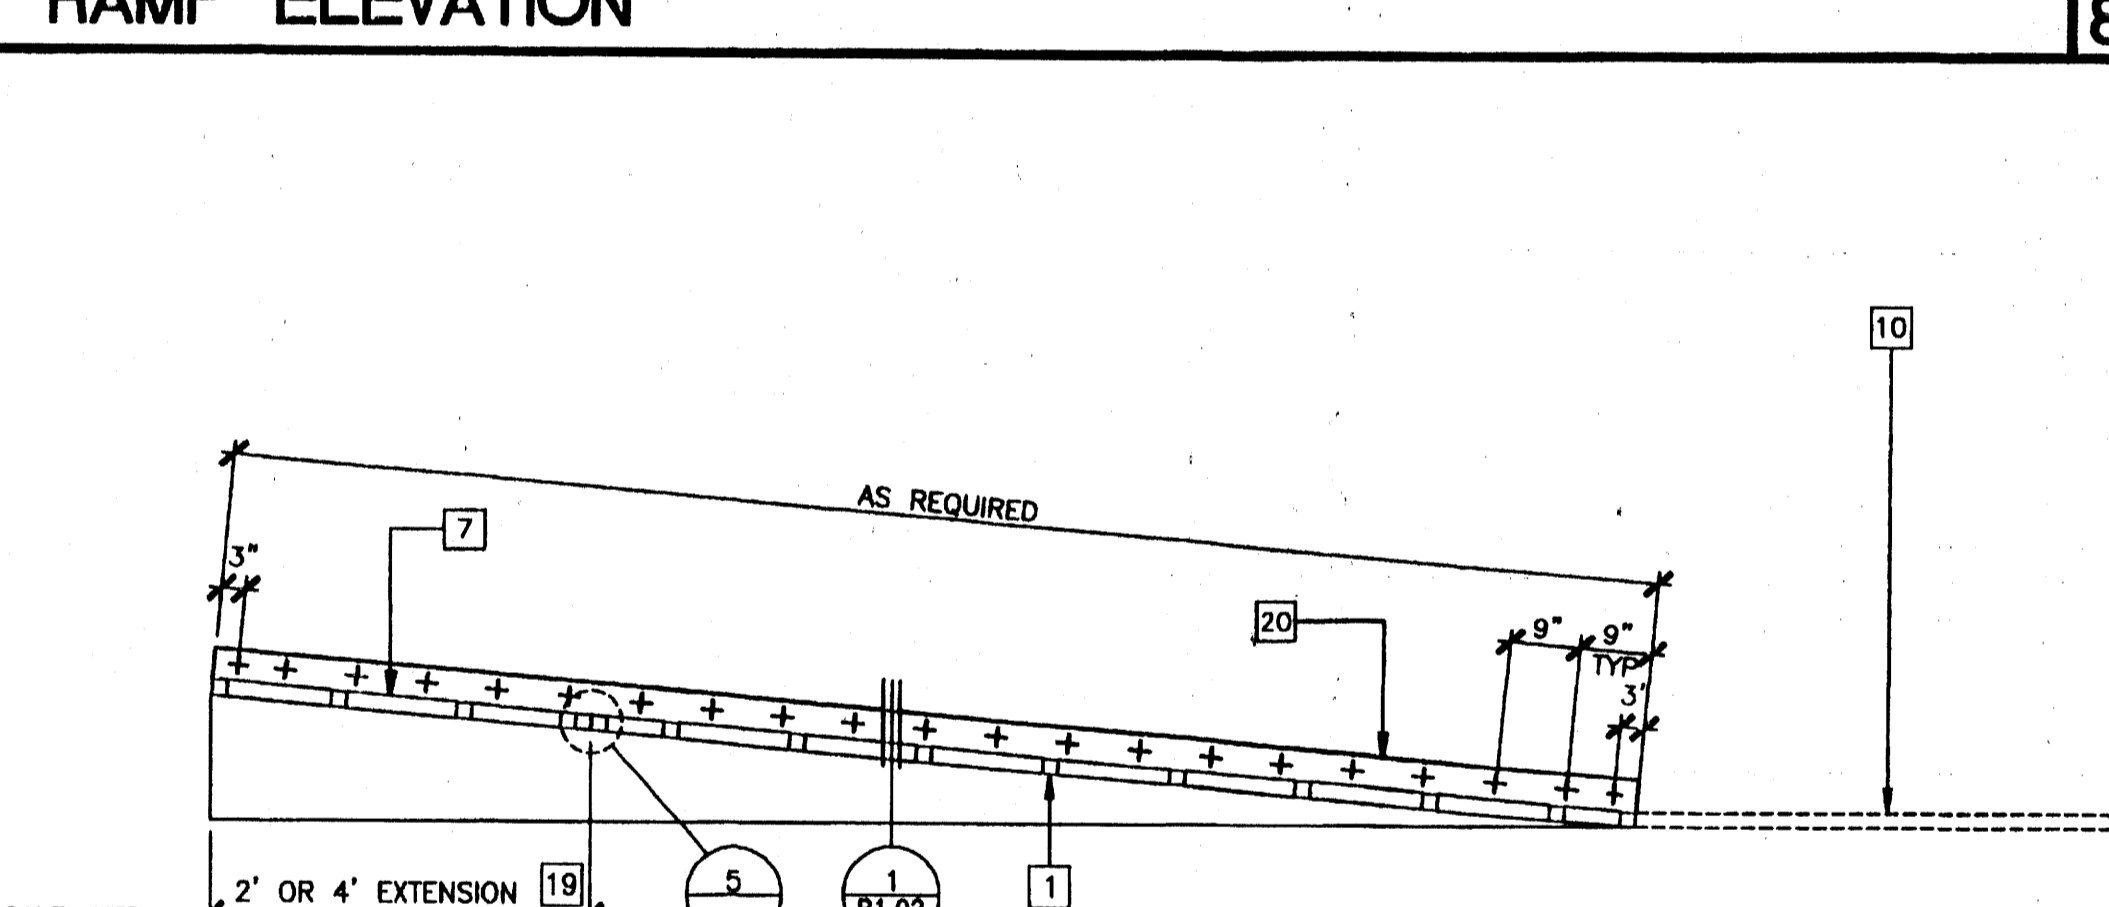

LONGITUDINAL SECTION AT RAMP

9


SCALE: NTS

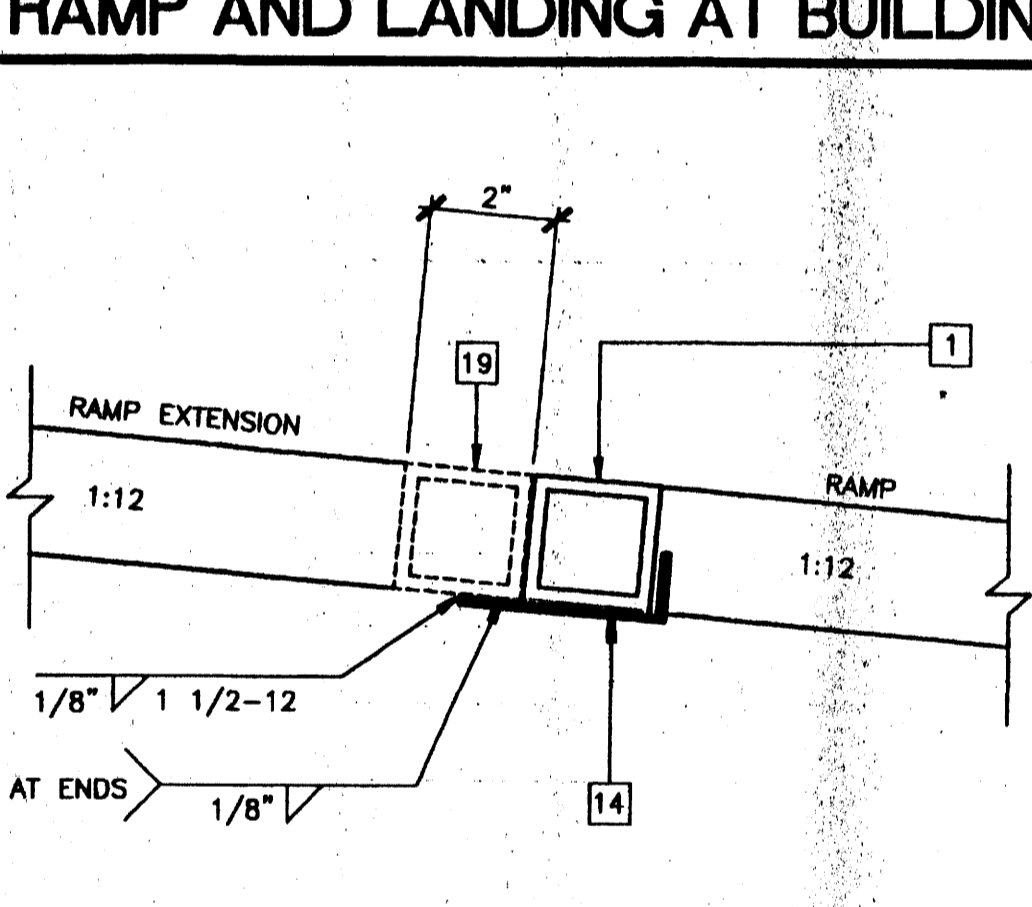

RAMP EXTENSION TO RAMP


5

SCALE: NTS

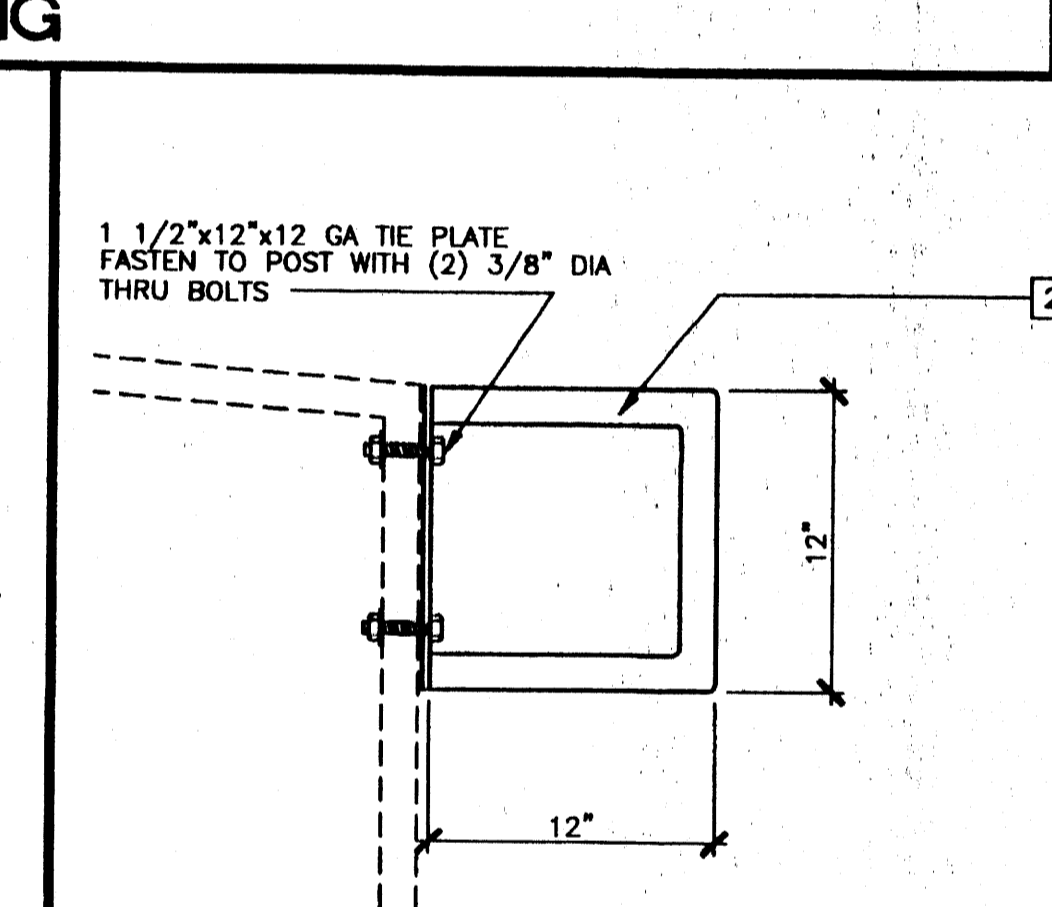

ALTERNATE GUARD RAIL EXTENSION


3

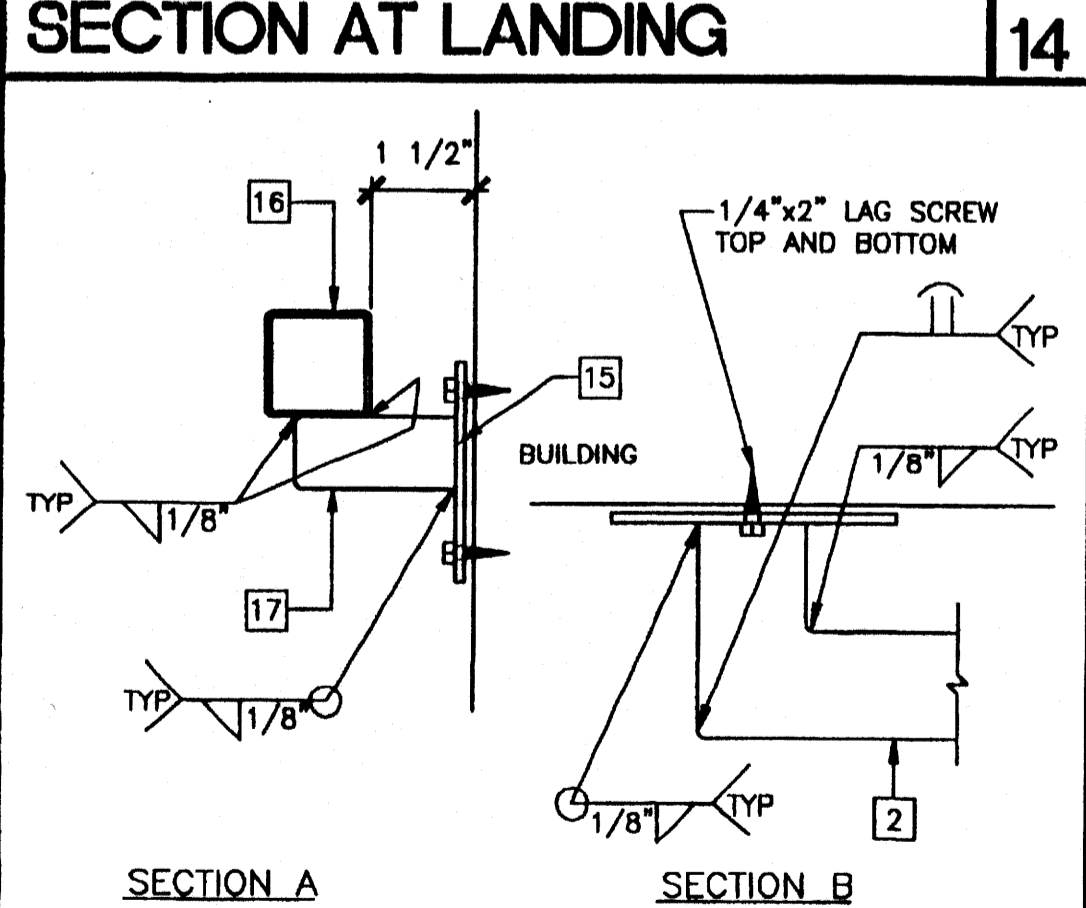

HANDRAIL CONNECTION

15


SCALE: NTS

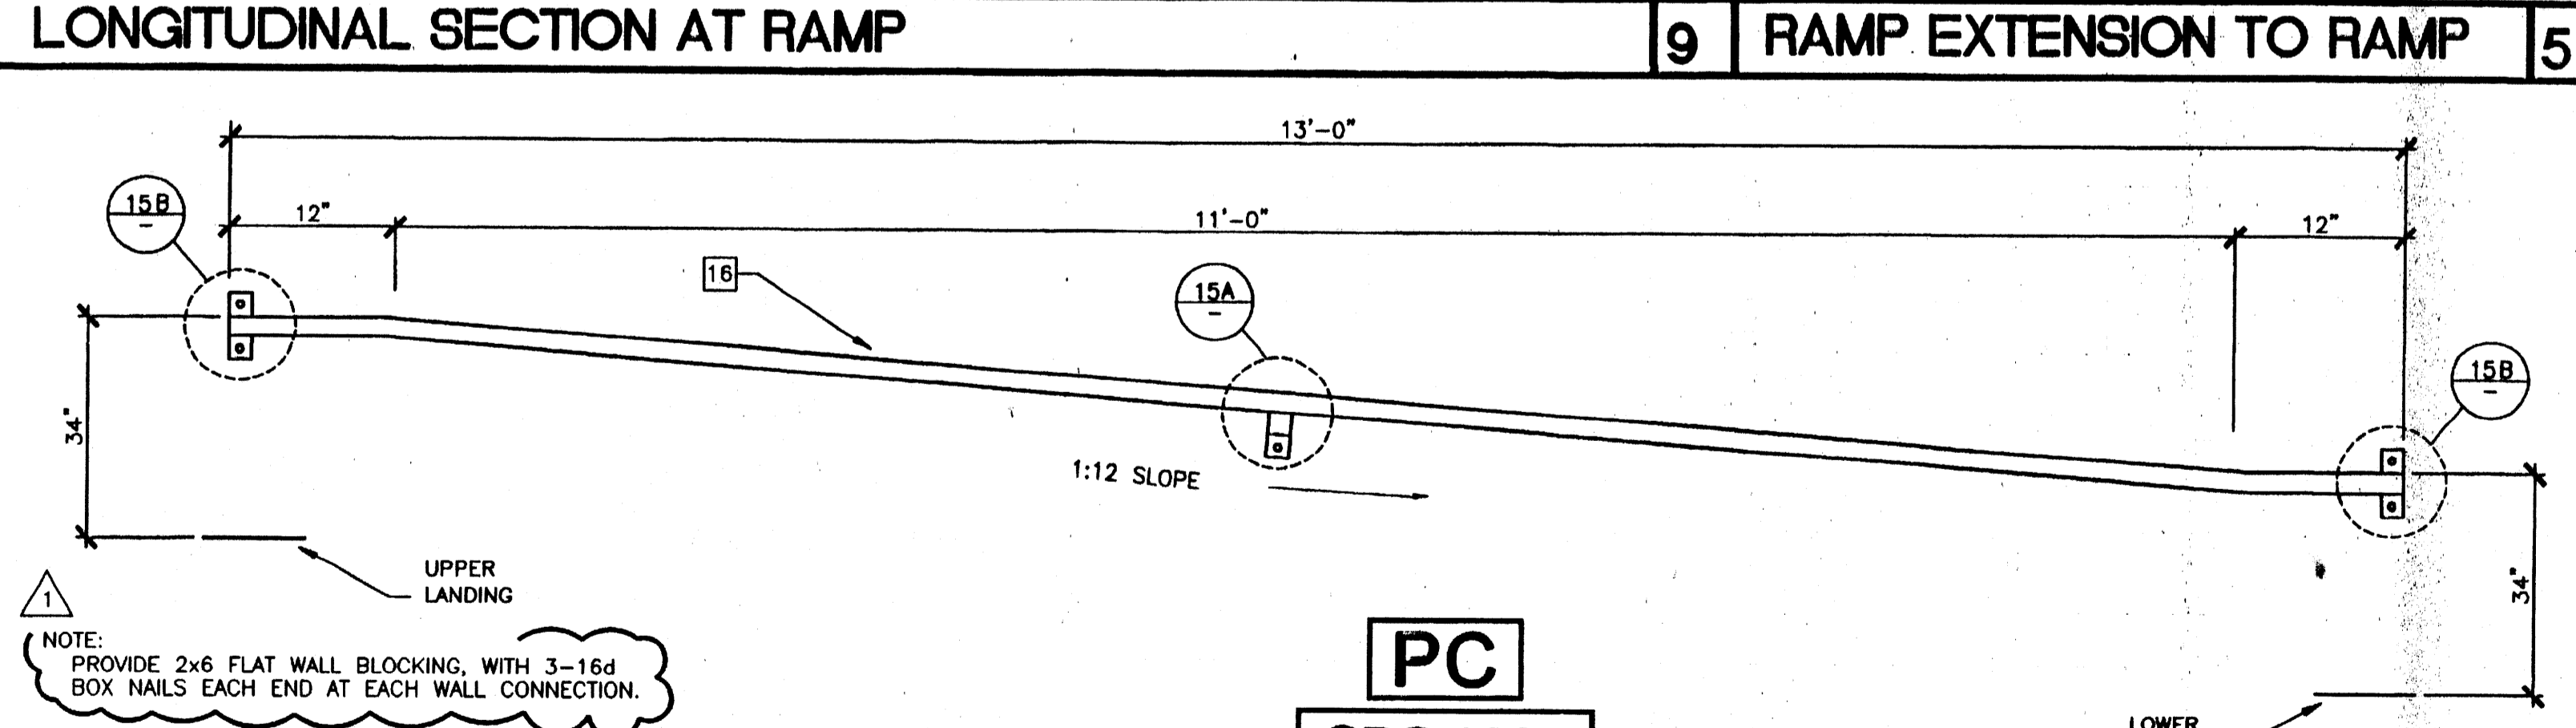

HANDRAIL ATTACHED TO BUILDING (OPTIONAL)

6

SCALE: NTS

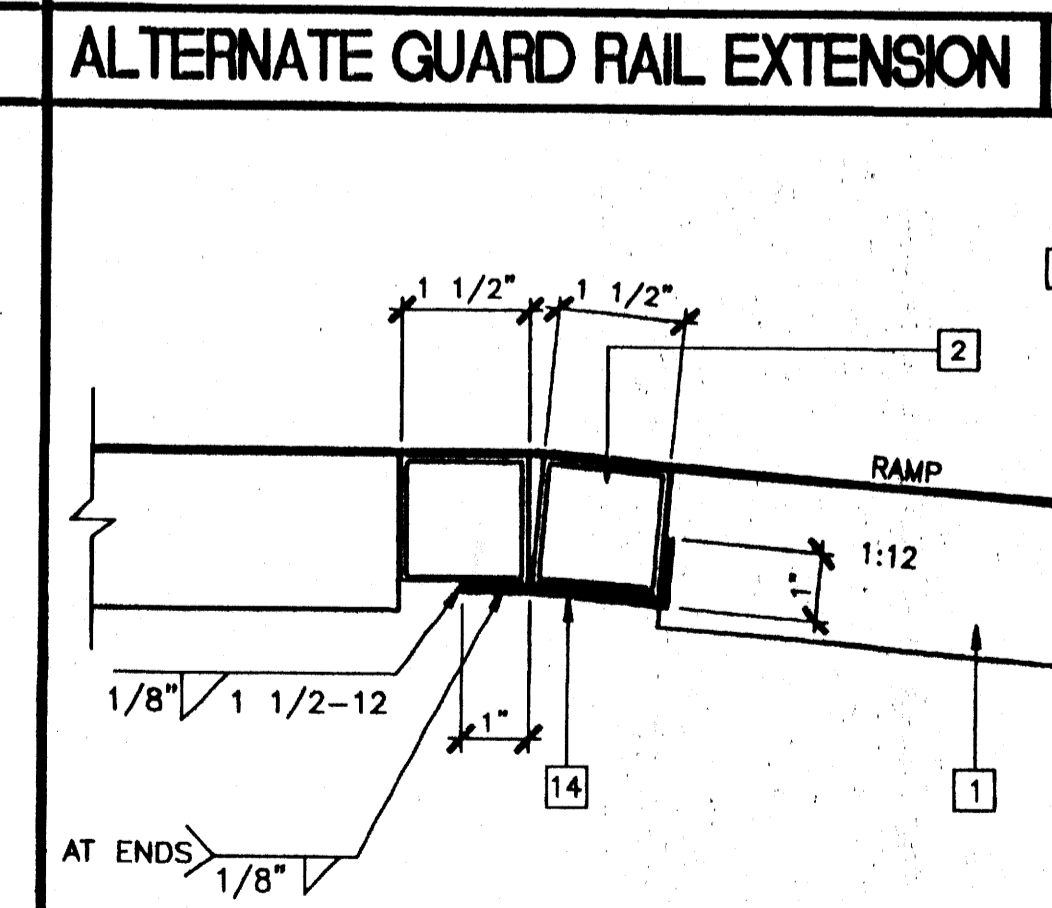

RAMP AT LANDING

4

SCALE: NTS

KEY NOTES

- 1 TS 2"x2"x14 GA
- 2 TS 1 1/2"x1 1/2"x14 GA (Fy = 39KSI). ROUNDED OR BEVELED AT CORNERS.
- 3 TS 1"x1"x16 GA WHEELCHAIR GUIDE
- 4 2"x6" PRESSURE TREATED SILL PLATE
- 5 2"x4"x12 GA BASE PLATE WITH (2) 1/4"x1" LAGS
- 6 SKIRTING: PLYWOOD TO MATCH BUILDING SIDING. BLOCK ALL EDGES. ATTACH WITH 8d AT 6" OC EDGES AND 12" OC FIELD. AT EDGE CONNECTION TO TUBE STEEL USE #14x2" TEK SCREWS AT 6" OC
- 7 12 GA METAL DECK: NON-SLIP SURFACE. DESIGN COEFFICIENT OF FRICTION GREATER THAN 6%. MAINTAINABLE FOR 1 YEAR
- 8 EXISTING BUILDING
- 9 6"x10"x12 GA BASE PLATE AT RAMP TOE
- 10 LOWER LANDING BY DISTRICT
- 11 RAMP BY MODTECH
- 12 FLUSH TRANSITION
- 13 6"x12"x10 GA PLATE WITH (2) 1/4"x3" LAGS TO STRUCTURAL FRAME OF BUILDING
- 14 3"x1"x3'-0"x10 GA BENT PLATE
- 15 2"x4"x 1/8" PLATE
- 16 TS 1 1/2"x1 1/2"x14 GA HANDRAIL - CONTINUOUS AND UNINTERRUPTED ROUNDED OR BEVELED AT CORNERS.
- 17 TS 1"x1"x16 GA
- 18 LINE OF RAMP/LANDING ABOVE
- 19 RAMP EXTENSION FRAME
- 20 6"x10 GA CONTINUOUS PLATE WITH 1/4"x2" TEK SCREWS AT 9" OC INTO WOOD OR FOUNDATION BLOCKS OR #14x2" TEK SCREWS INTO STEEL AT 9" OC
- 21 NOTCH BOTTOM PLATE (MUD SILL) AS REQUIRED TO CLEAR RAMP TOE. MAX NOTCH 1 1/2"x4'-0" LONG.
- 22 NOTCH BOTTOM PLATE (MUD SILL) AS REQUIRED TO CLEAR RAMP TOE. MAX NOTCH 1 1/2"x4'-0" LONG.

NOTES

1. RAMP: RAMP SHALL NOT SLOPE MORE THAN 1" IN 12"
2. HANDRAILS: HANDRAILS AT BOTH SIDES OF RAMP AT 34" HEIGHT.
3. SURFACE: LANDING & RAMP TO HAVE NON-SLIP SURFACE AMCOR GRIP II AS MANUFACTURED BY AMERICAN CHEMICAL COMPANY (OR EQUAL)
4. GROUNDING: PROVIDE GROUNDING OF RAMP TO BUILDING FRAME WITH #8 COPPER TO BOTH GROUND LUGS.
5. ARCHITECT SITE/RAMP/LANDING PLANNING: DUE TO VARYING SITE CONDITIONS THE MAXIMUM HEIGHT OF FINISH FLOOR FROM GRADE IS 26". THEREFORE IT IS POSSIBLE THAT THE ACCESS RAMP ATTACHED TO THE BUILDING COULD BE 26'-0" AT A SLOPE OF 1:12. ARCHITECT MUST TAKE INTO ACCOUNT THAT THE RAMP SUPPLIED BY MODTECH INC. IS 11'-0" AT A SLOPE OF 1:12. THEREFORE THE ARCHITECT WILL HAVE TO DESIGN AND PROVIDE DETAILS OF RAMP EXTENSIONS AND BOTTOM LANDING DEPENDING ON PARTICULAR SITE CONDITIONS. IN NO WAY IS MODTECH INC RESPONSIBLE FOR ANY RAMP EXTENSION EXCEEDING THE ORIGINAL PLAN AS SHOWN ON THIS SHEET
6. ALL 1 1/4" AND 1 1/2" TUBE STEEL TO BE OF ASTM A500 GRADE A STEEL (Fy = 39 KSI)

REVISIONS		
NO.	DESCRIPTION	DATE
1	MODTECH ENGINEERING CHANGE	09/28/00
2		
3		
4		
5		

Electrical Engineer's Seal

Mechanical Engineer's Seal

Structural Engineer's Seal

Architect's Seal

IDENTIFICATION STAMP
DIV. OF THE STATE ARCHITECT
OFFICE OF REGULATION SERVICES
PC-04
101268
REVISED OCT 0


MODTECH INC.
2830 BARRETT AVENUE
PERRIS, CALIF. 92572
PH (909) 943-4014
FAX (909) 940-0427

PROJECT NUMBER: 4373, 4378, 4438, 4438 © MODTECH, INC. 2002
4474, 4505, 4525


DRAWN BY: KK
DATE: 11/19/02
CHECKED BY: STKP-67
DATE: 4/12/12
MODTECH Index No.
R1.01

RAMP/LANDING


FILE PATH: Z:\440-RT.01.DWG PROJECT NO. 4373 PC-04-101268

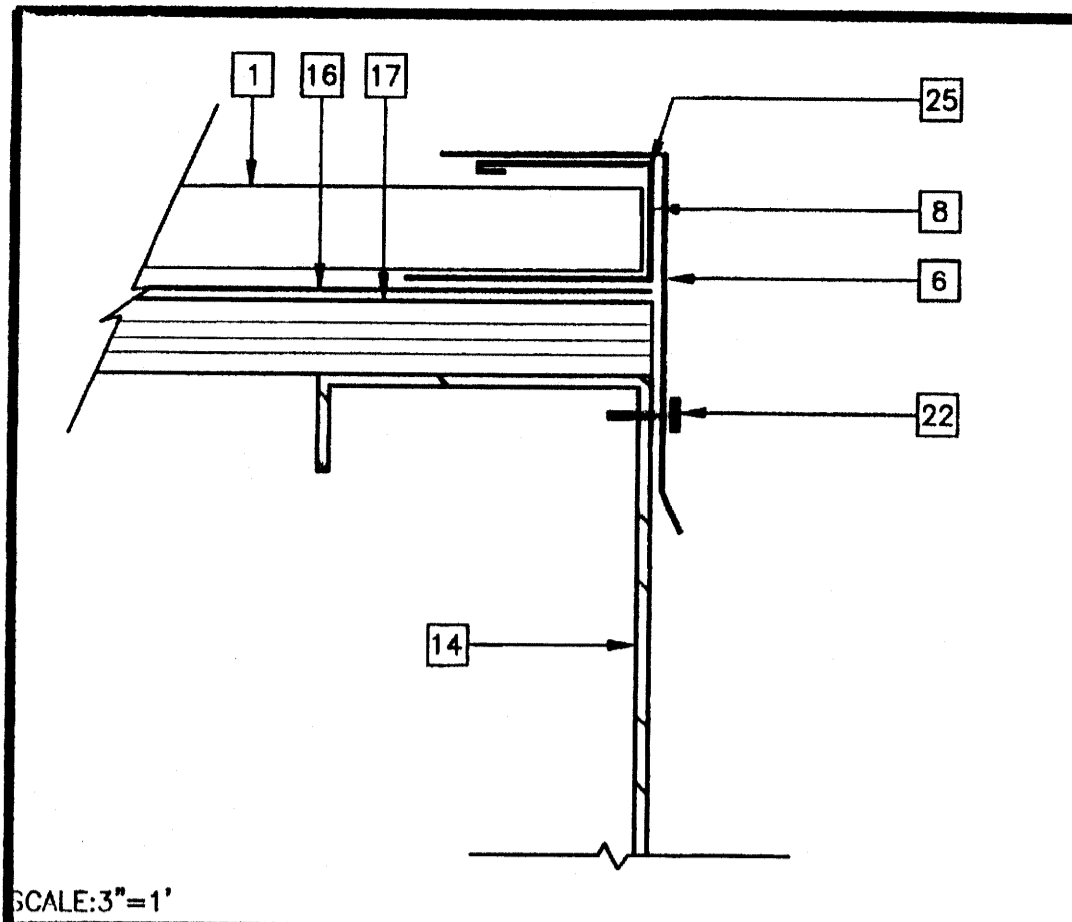


SCALE: 3"=1'
ROOF FLASHING AT HIGH SIDE 17

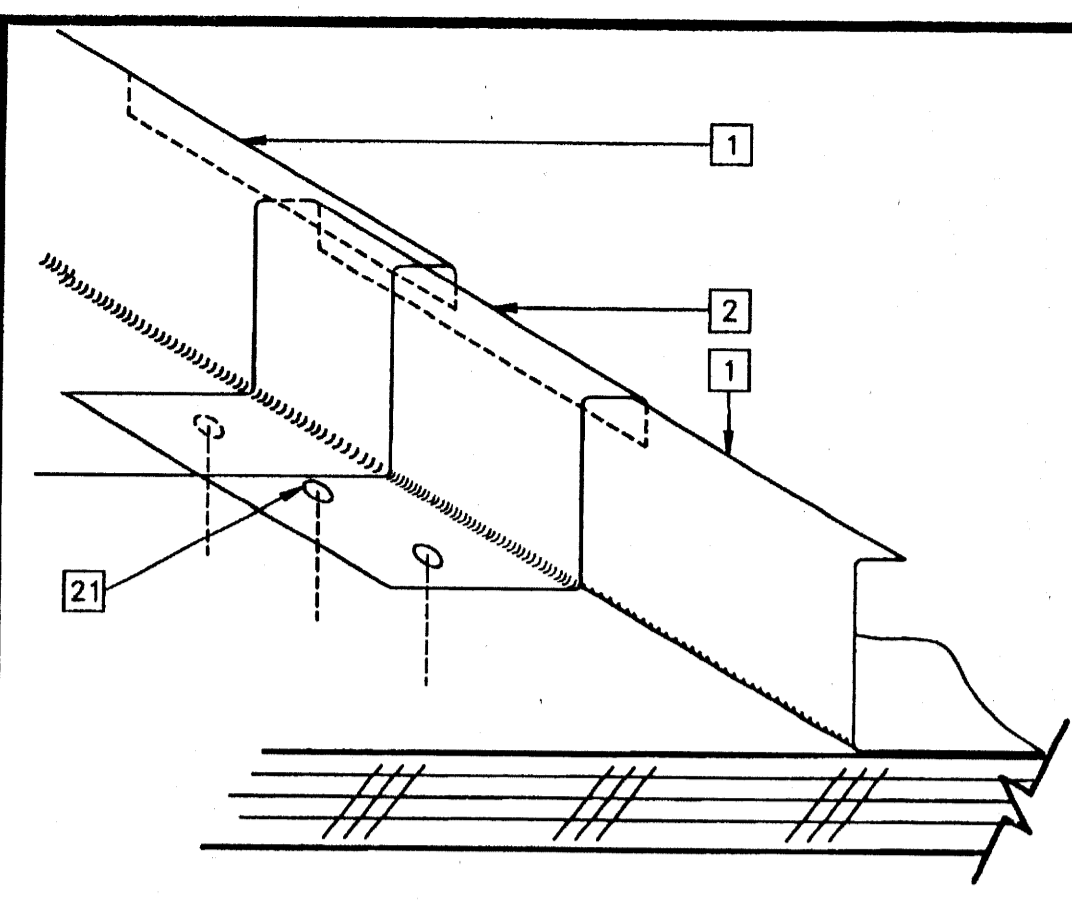


SCALE: 3"=1'
ROOF STANDING SEAM 13

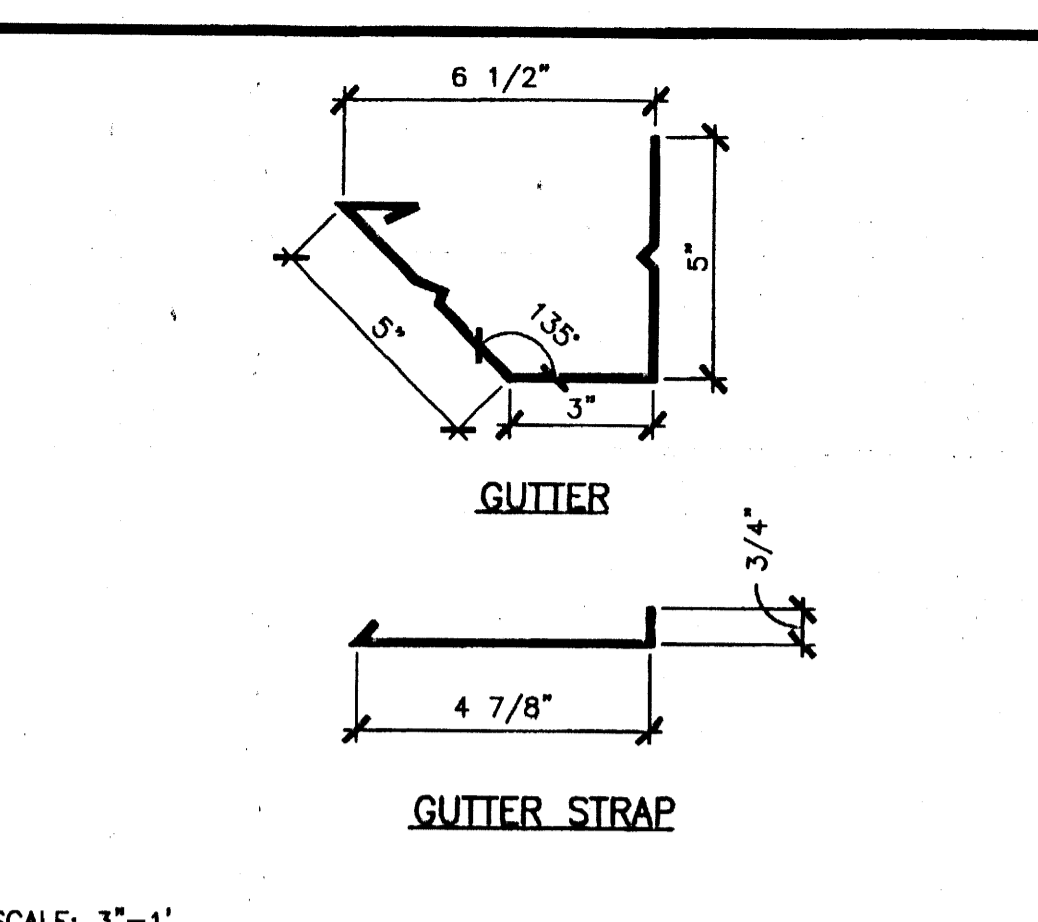

SCALE: 3"=1'
26 GA GUTTER AND GUTTER STRAP 9

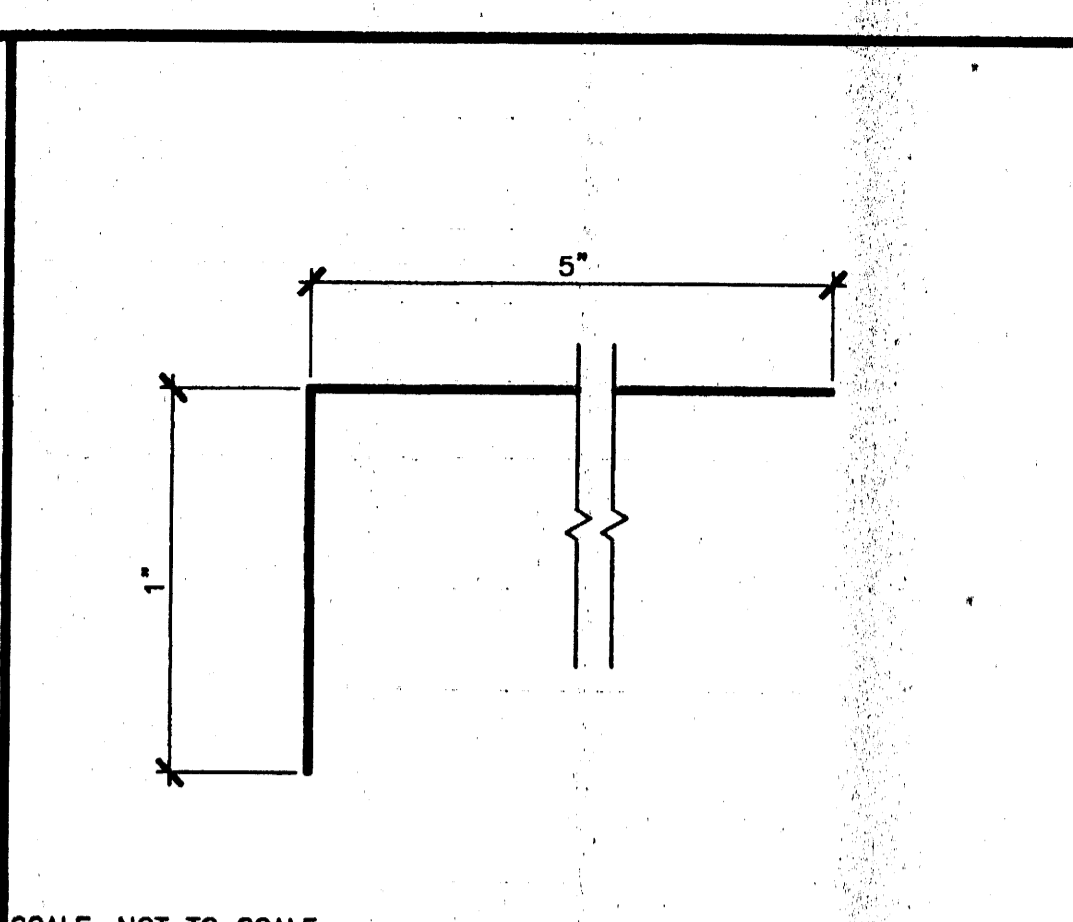


SCALE: NOT TO SCALE
FLASHING AT MODLINE WALL 5

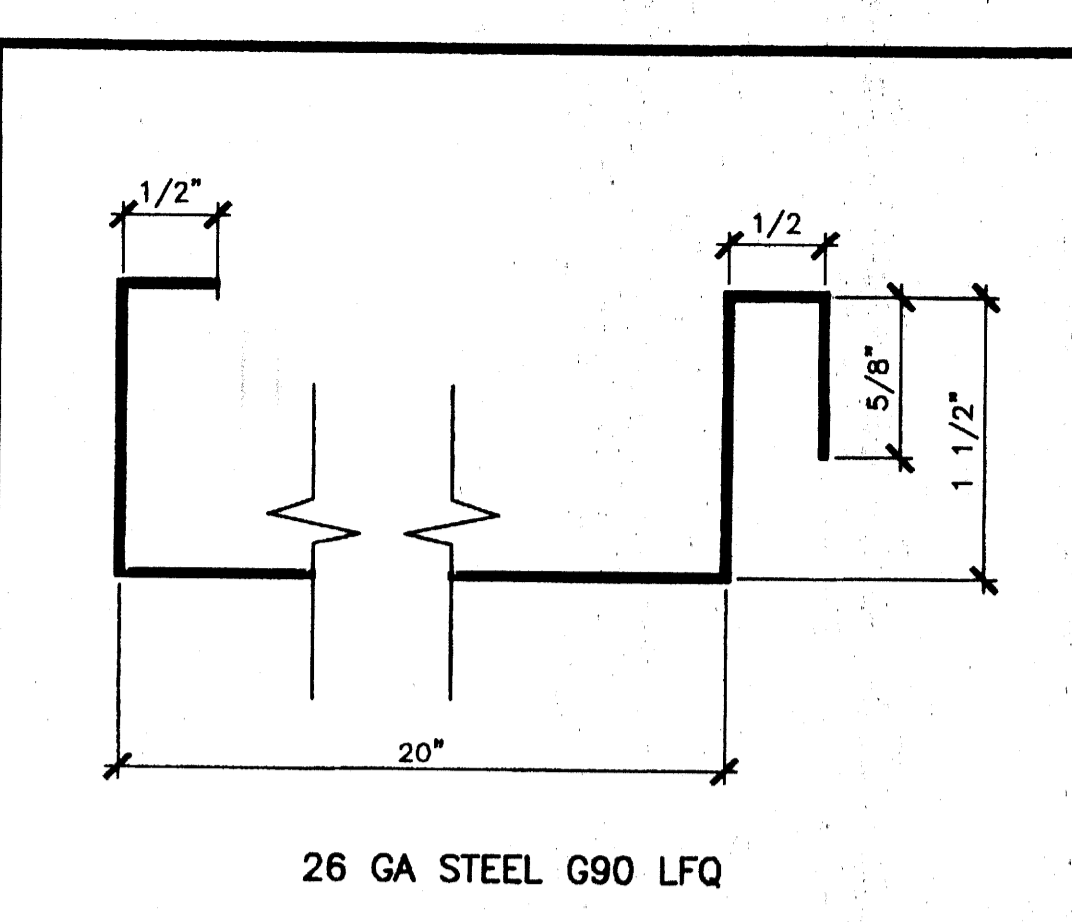


SCALE: FULL
ROOF PAN 1


- KEY NOTES**
- 1 26 GA STANDING SEAM ROOF PAN - 1/A2.03
 - 2 26 GA ROOF CLIP - 2/A2.03 - AT 24" OC MAX AND 6" MAX FROM END OF ROOF
 - 3 22 GA GALVANIZED IRON FLASHING AT SIDEWALL 3/A2.03
 - 4 22 GA GALVANIZED IRON FLASHING AT LOW END OF ROOF - 4/A2.03
 - 5 22 GA GALVANIZED STEEL FLASHING AT MODLINE WALL - 5/A2.03
 - 6 22 GA GALVANIZED STEEL FLASHING AT HIGH END OF ROOF - 6/A2.03
 - 7 26 GA ROOF CAP AT MODLINE - 7/A2.03
 - 8 26 GA FLASHING AT HIGH SIDE - 8/A2.03
 - 9 26 GA CONTINUOUS GUTTER - 9/A2.03
 - 10 DOWN SPOUT
 - 11 ROOF CLIP MOUNTED UPSIDE-DOWN, BEND CLIP HEAD UP AND OVER ROOF PAN
 - 12 ROOF BEAM (STR)
 - 13 COLUMN
 - 14 ROOF FASCIA (STR)
 - 15 NOT USED
 - 16 WEATHER PROOF MEMBRANE (25-30 LBS ASPHALT COATED)
 - 17 PLYWOOD ROOF SHEATHING (STR)
 - 18 TYPICAL EXTERIOR FINISH
 - 19 NOT USED
 - 20 ATTACHMENT BRACKET TYPICAL (3) PLACES, TOP, BOTTOM AND MIDSPAN - ATTACH TO SIDING WITH (2) #10 STSMS
 - 21 (3) .080 x 1 1/2" SCREW SHANK NAILS - ROOF CLIP TO ROOF DECKING
 - 22 #10 STSMS WITH NEOPRENE WASHER AT 24" OC
 - 23 TWO FASTENERS AT EACH SIDE OF BRACKET
 - 24 1/4" BEAD OF SEALANT ALONG ENTIRE LENGTH OF BOTH MODLINE RIBS
 - 25 SEALANT AT END OF SEAM
 - 26 CONTINUOUS BEAD OF SEALANT AT JOINT BETWEEN MODLINE FLASHING AND END PAN AND AT EACH END PAN ROOF CLIP
 - 27 GUTTER STRAP - 9/A2.03
 - 28 MODLINE
 - 29 CONTINUOUS SEALANT AT MODLINE JOINT
 - 30 #10 STSMS WITH NEOPRENE WASHERS AT 36" OC ON "WET" SIDE OF SEALANT
 - 31 #10 STSMS WITH NEOPRENE WASHERS AT EACH SIDE

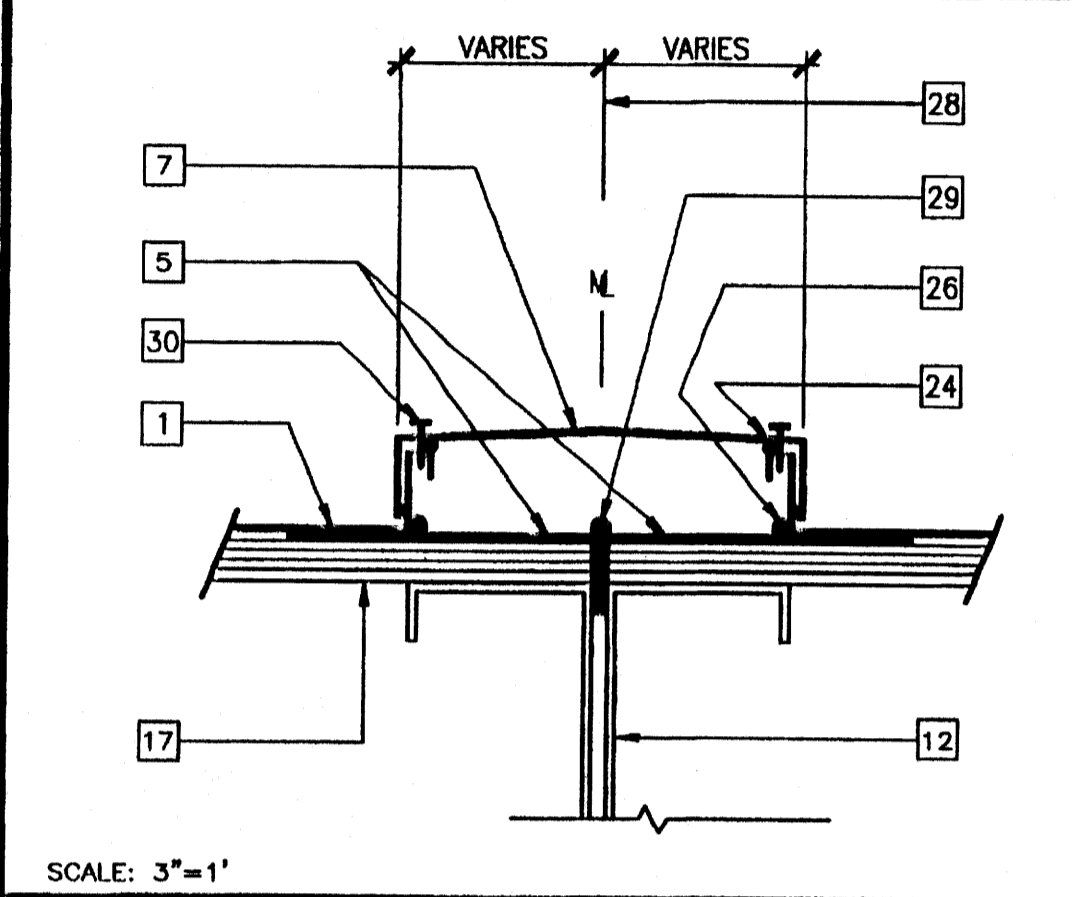


SCALE: 3"=1'
MODLINE ROOF CAP 18

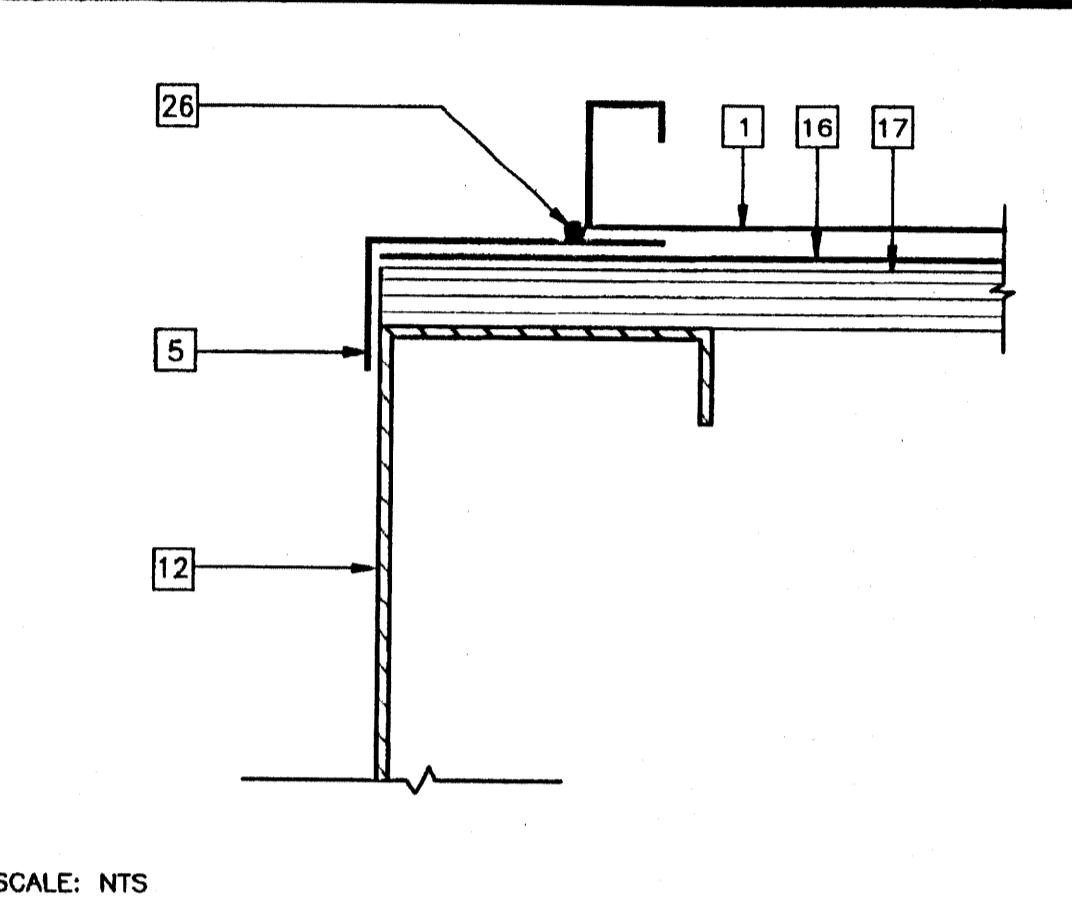


SCALE: NTS
END ROOF PAN CONNECTION 14

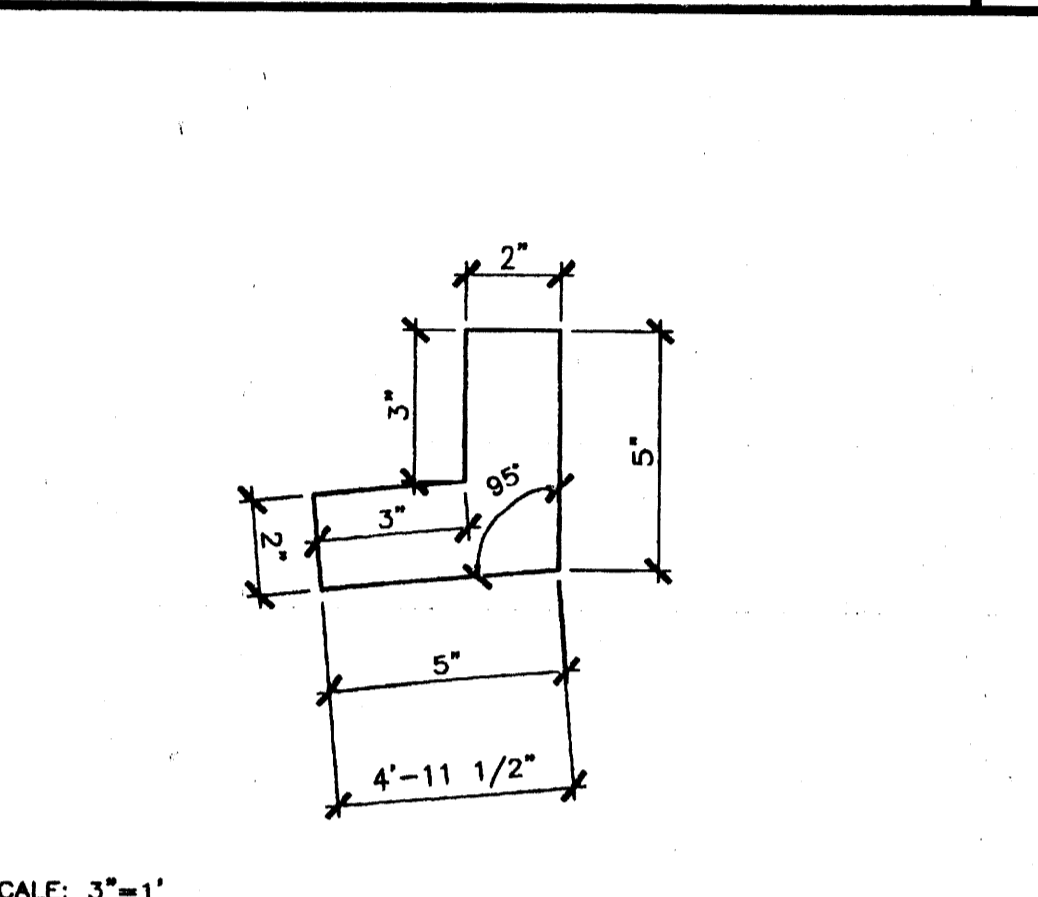


SCALE: 3"=1'
DOWNSPOUT AT BEND 10

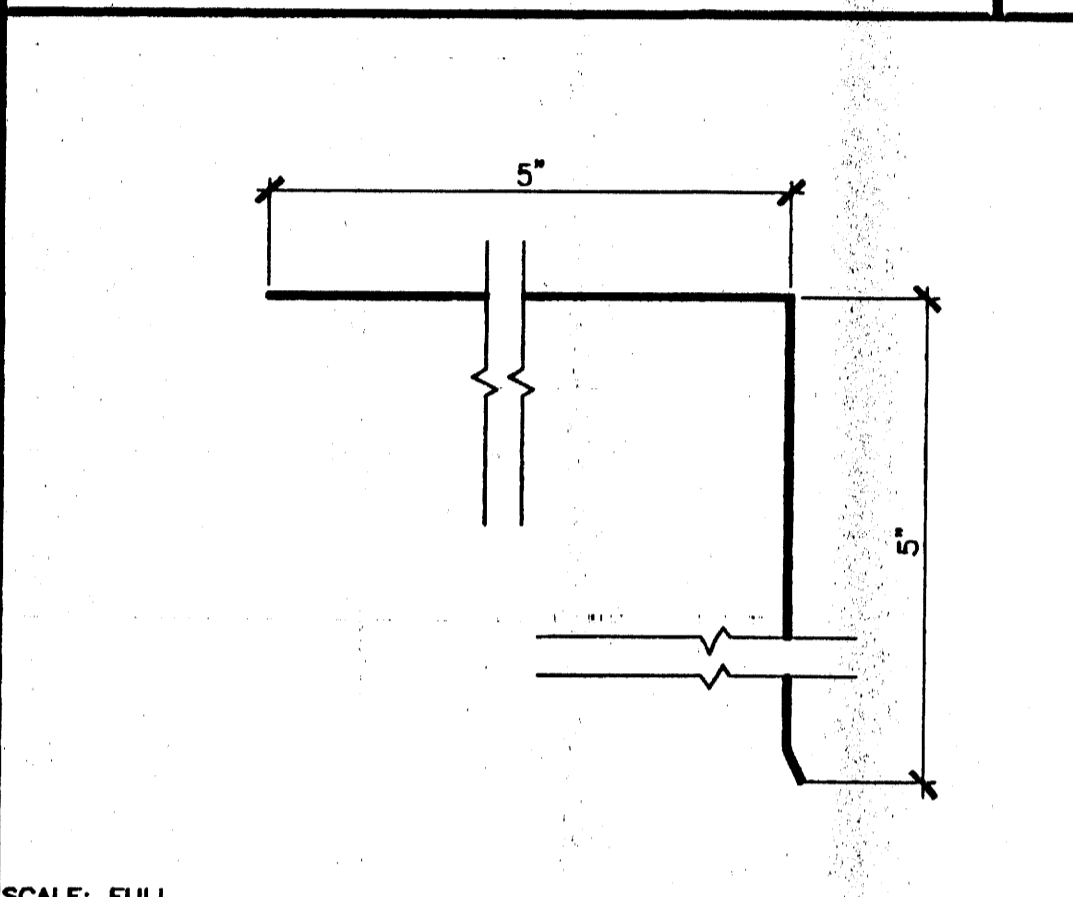


SCALE: FULL
ROOF FLASHING AT HIGH SIDE 6

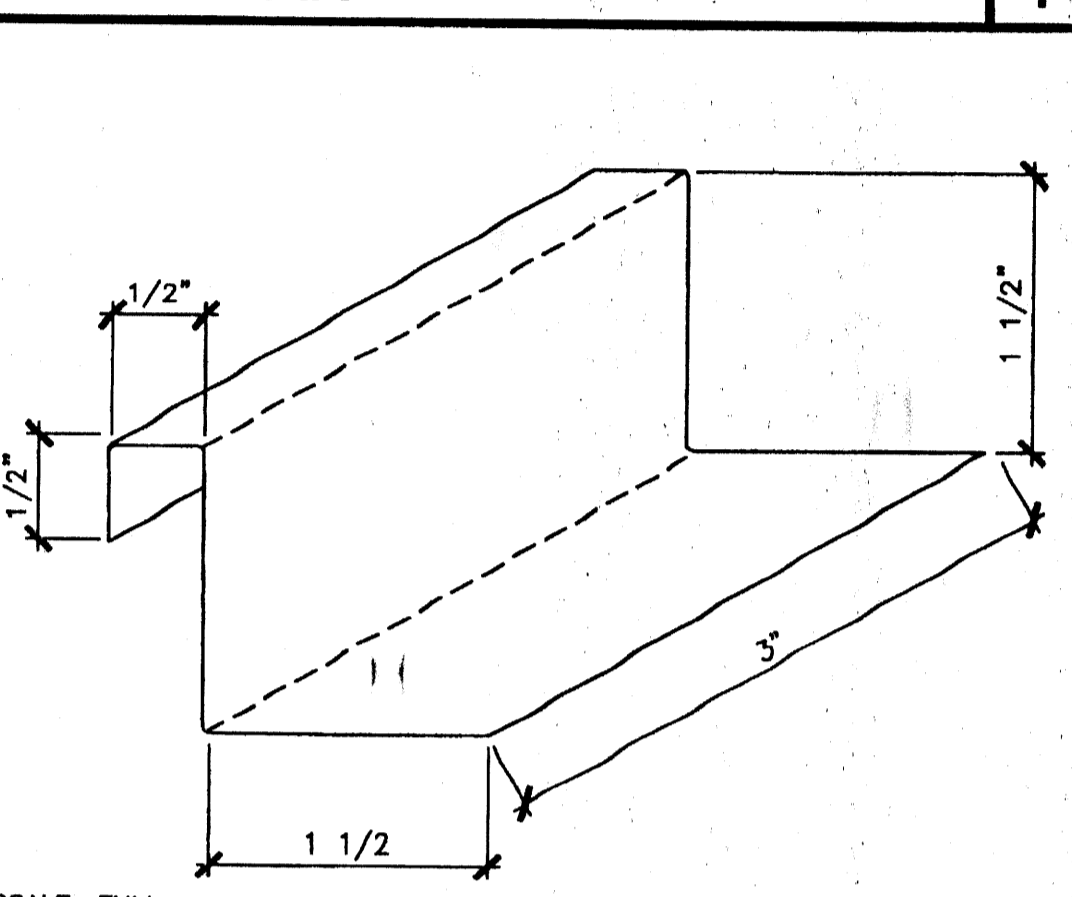


SCALE: FULL
ROOF CLIP 2

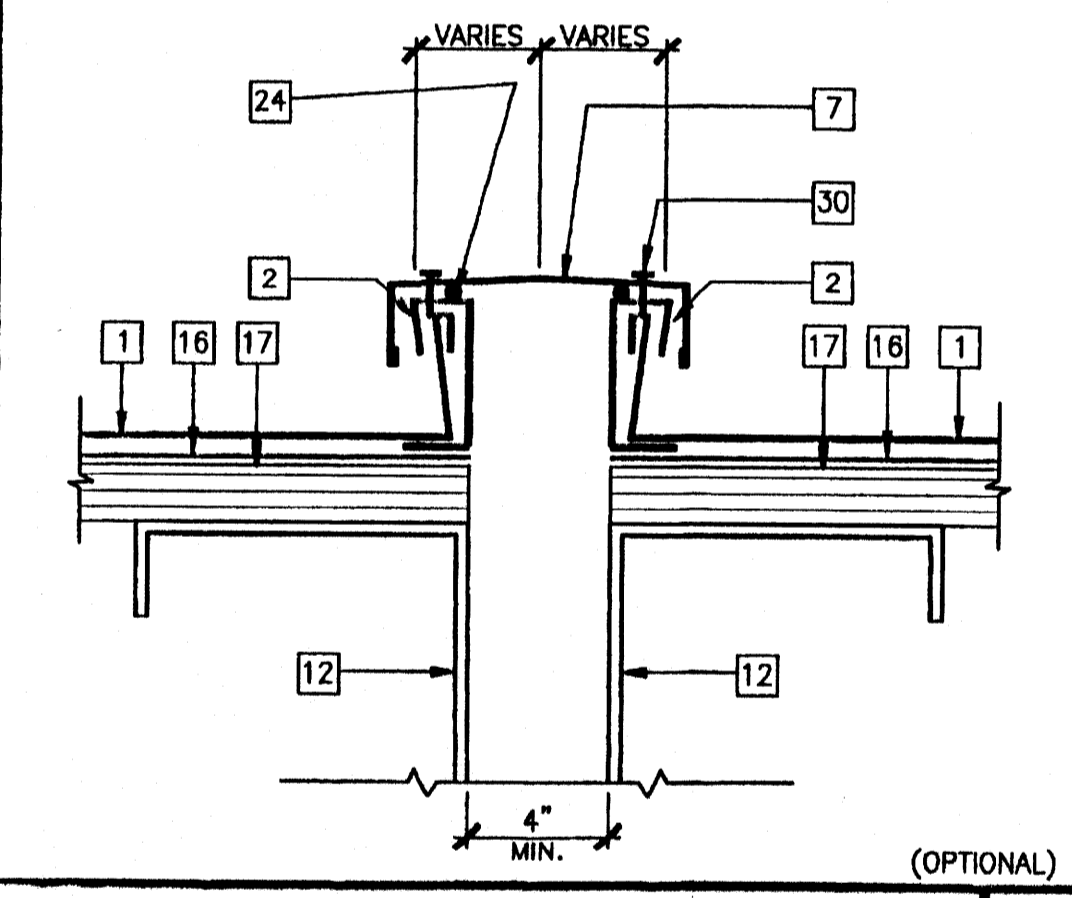


SCALE: 3"=1'
ROOF CAP AT 4' SEPARATION 19

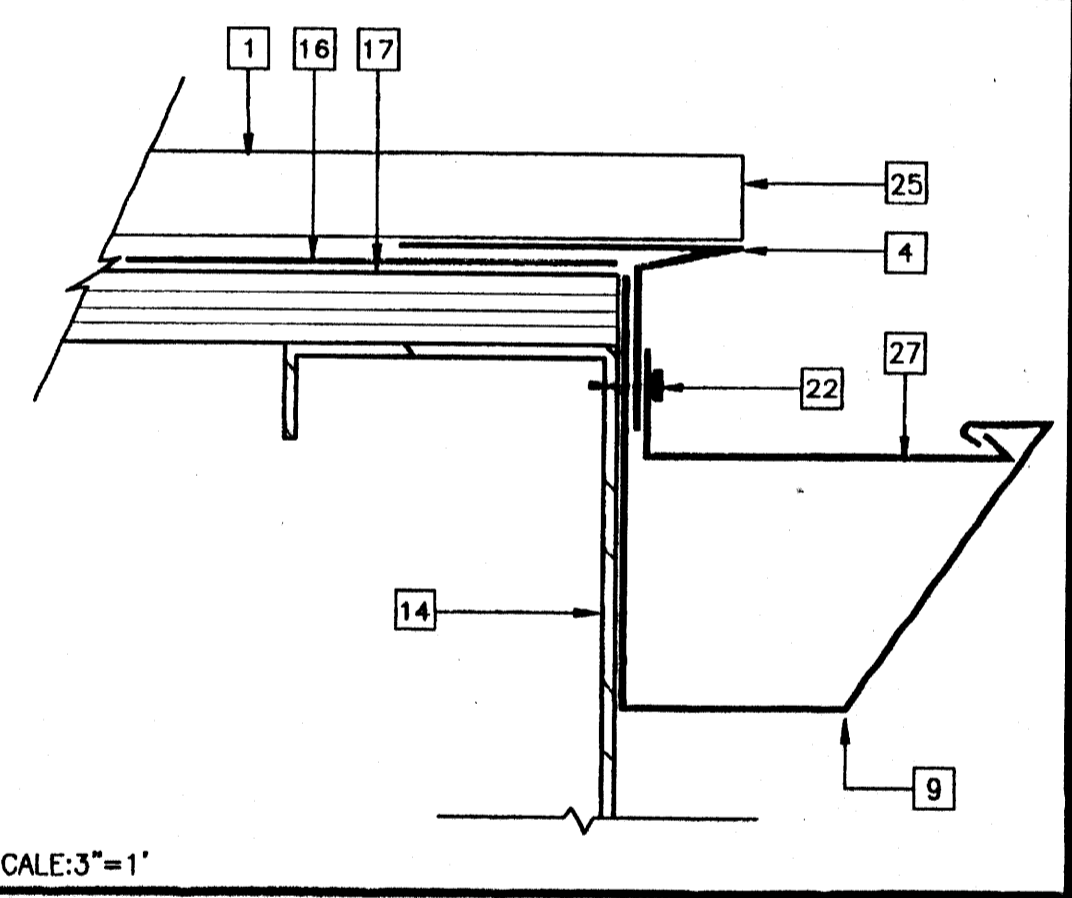


SCALE: 3"=1'
GUTTER AT ROOF FASCIA BEAM 15

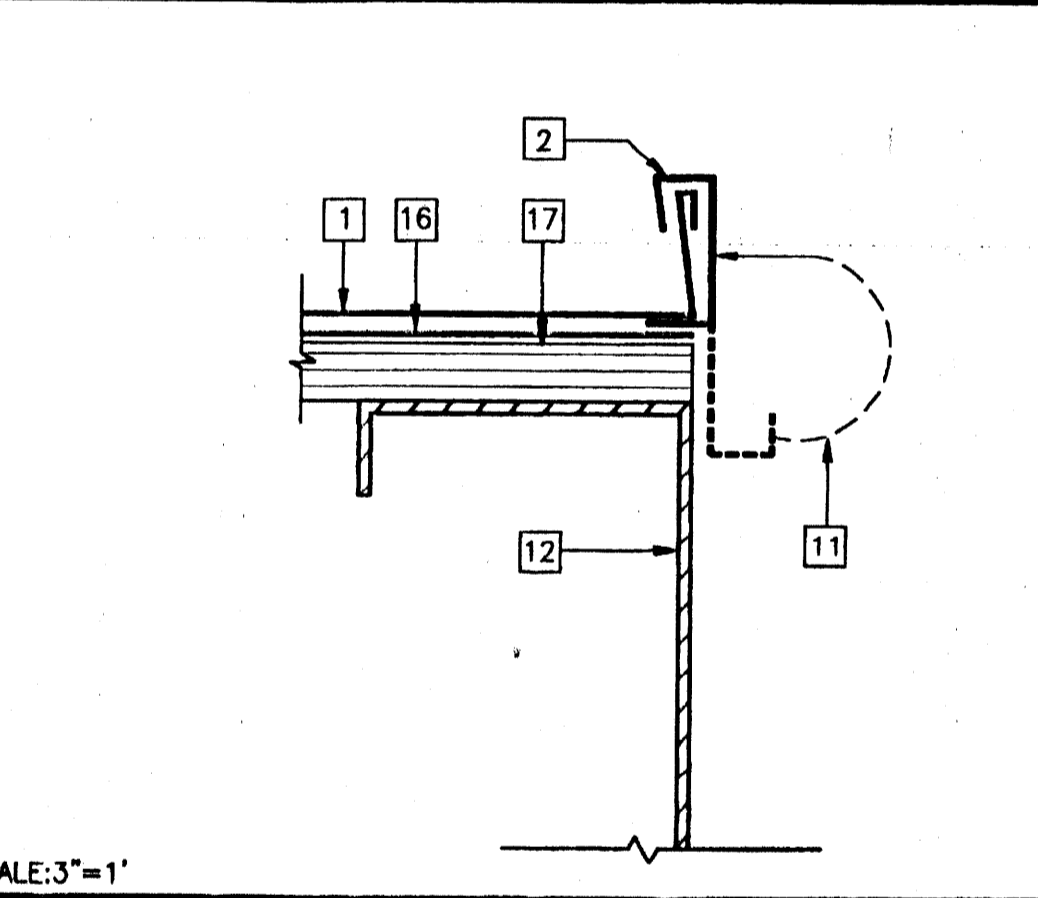


SCALE: 3"=1'
STARTER ROOF PAN CONNECTION 11

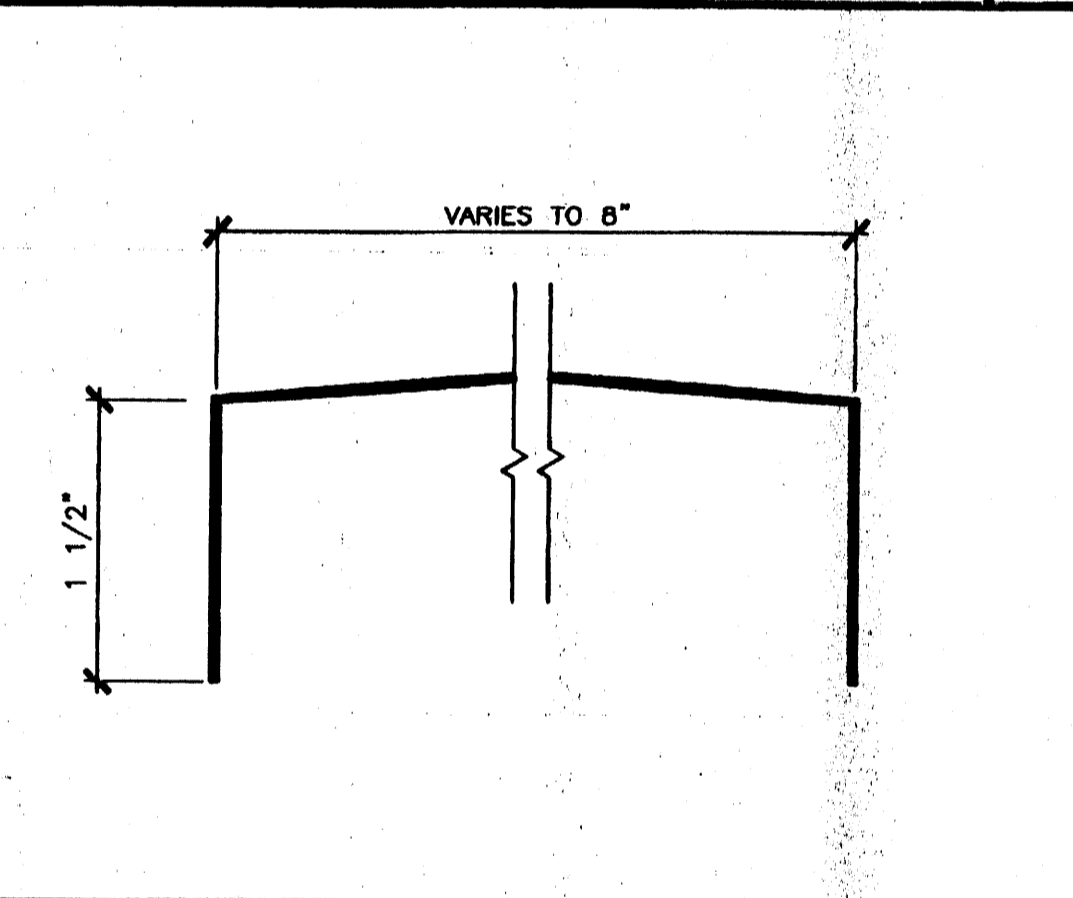


SCALE: FULL
26 GA ROOF CAP AT MODLINE 7

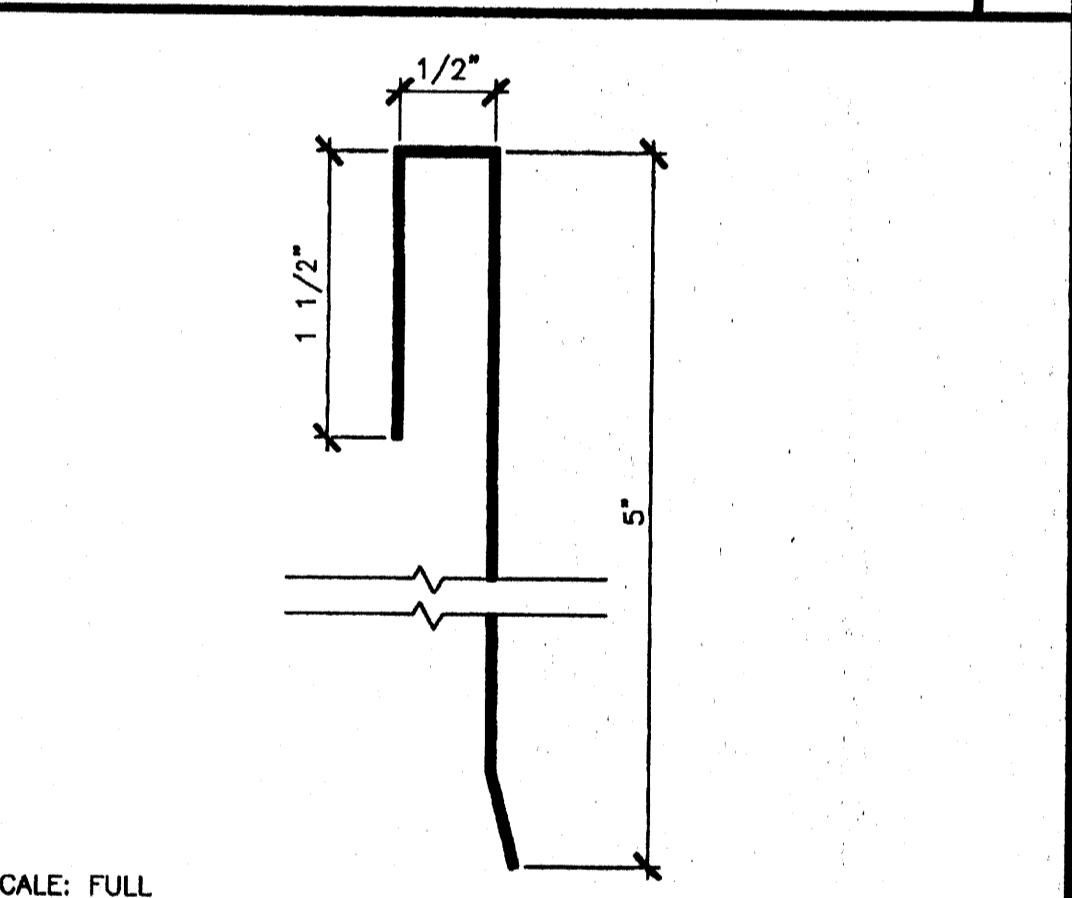


SCALE: FULL
FLASHING AT SIDE WALL 3

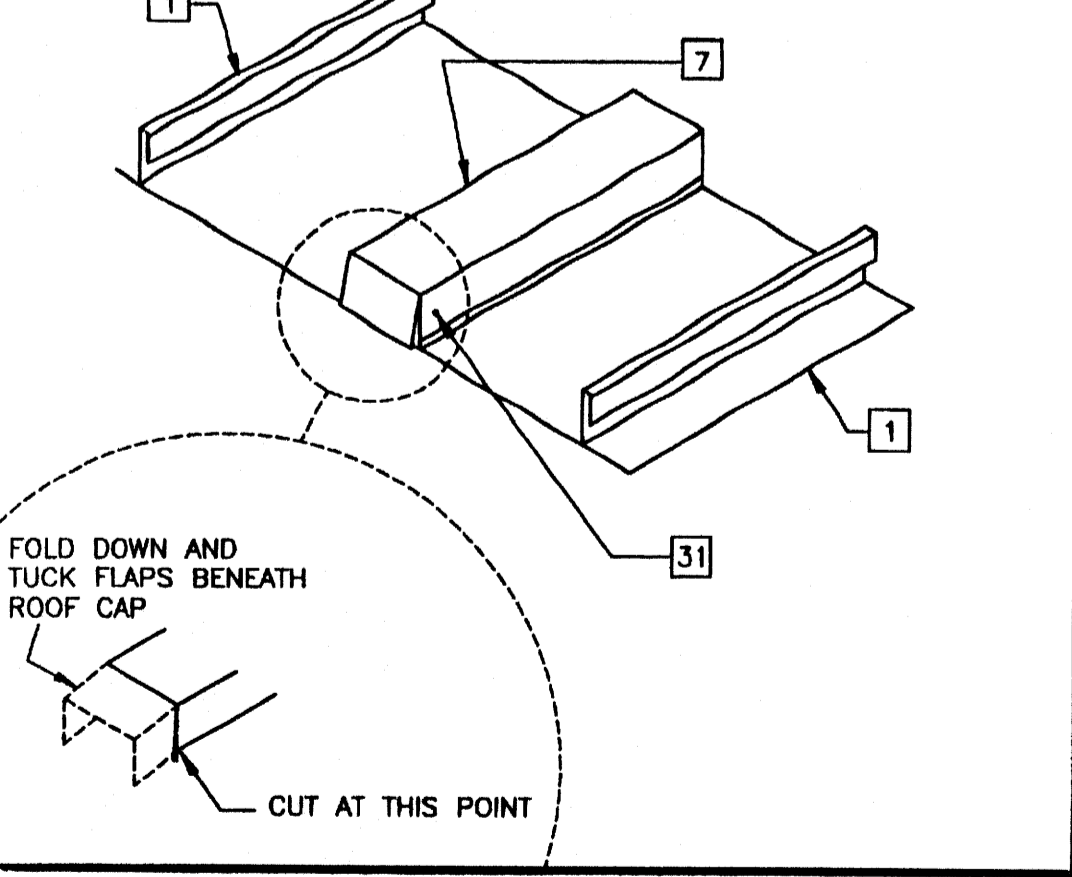


SCALE: 4"=1'
MODLINE ROOF CAP 20

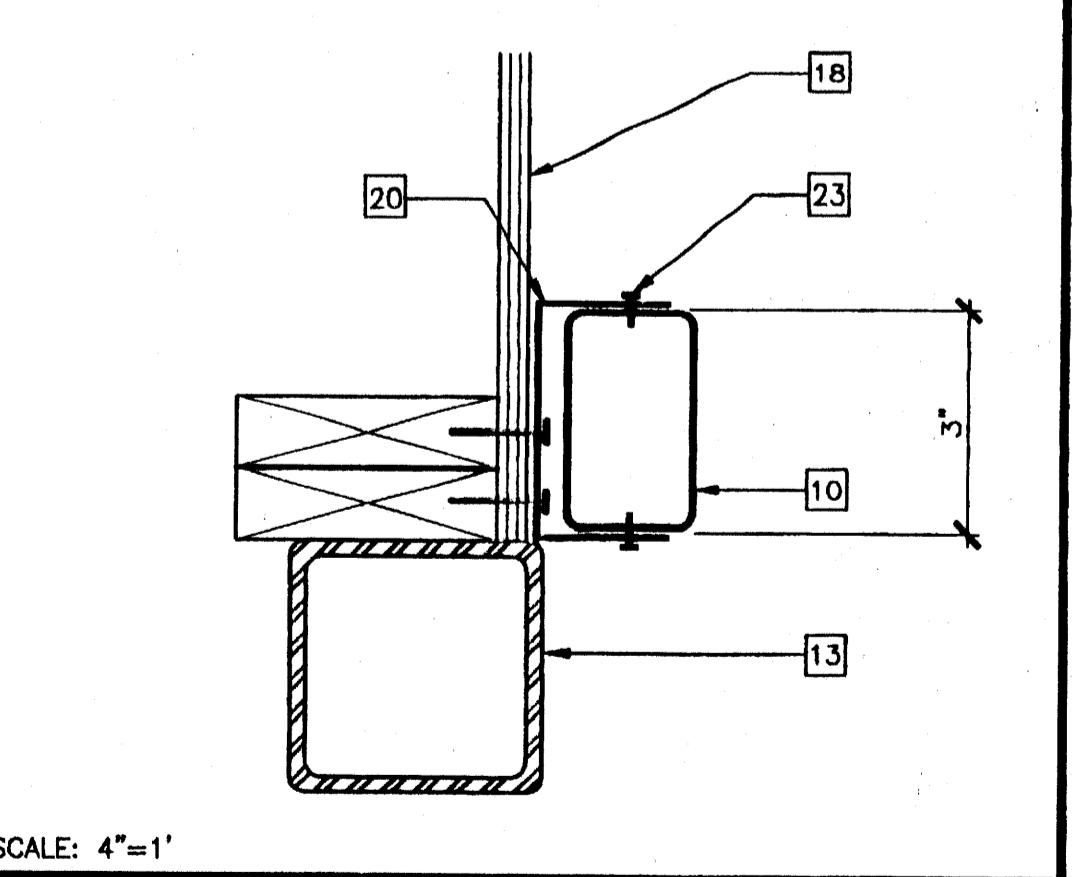


SCALE: 3"=1'
DOWNSPOUT ATTACHMENT 16

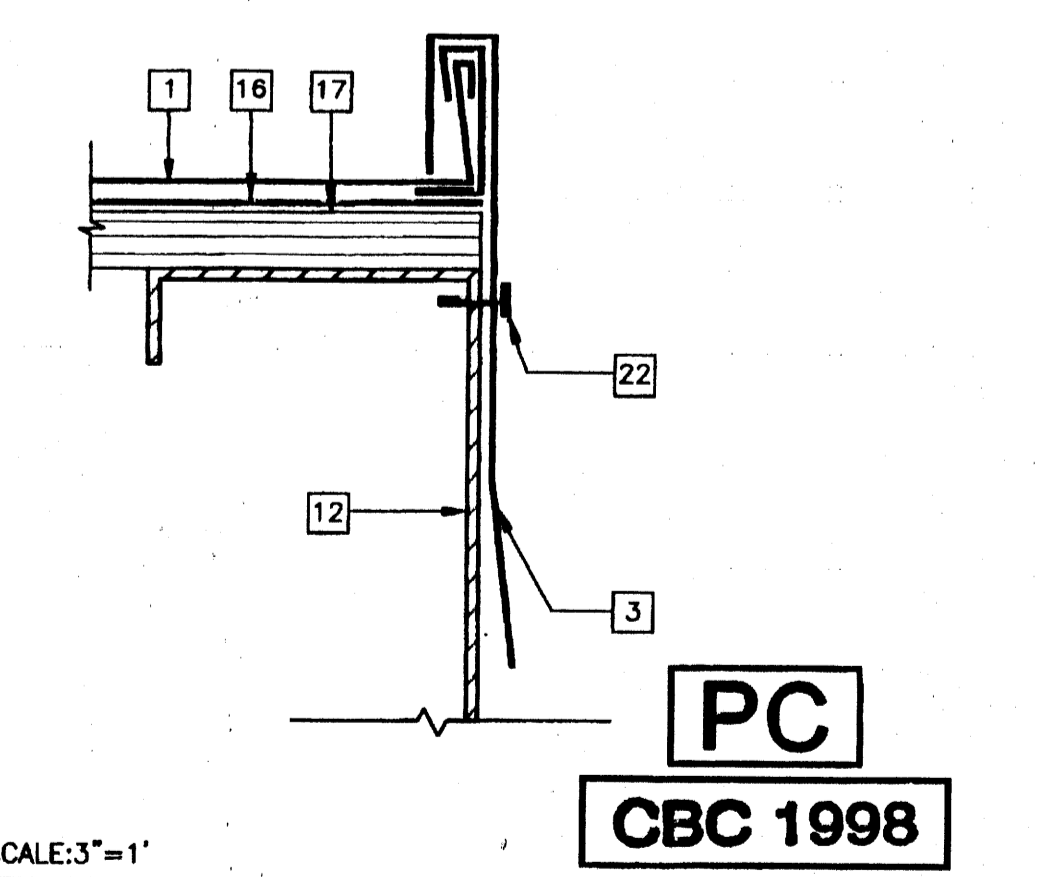

SCALE: 3"=1'
ROOF FLASHING AT SIDE WALL 12

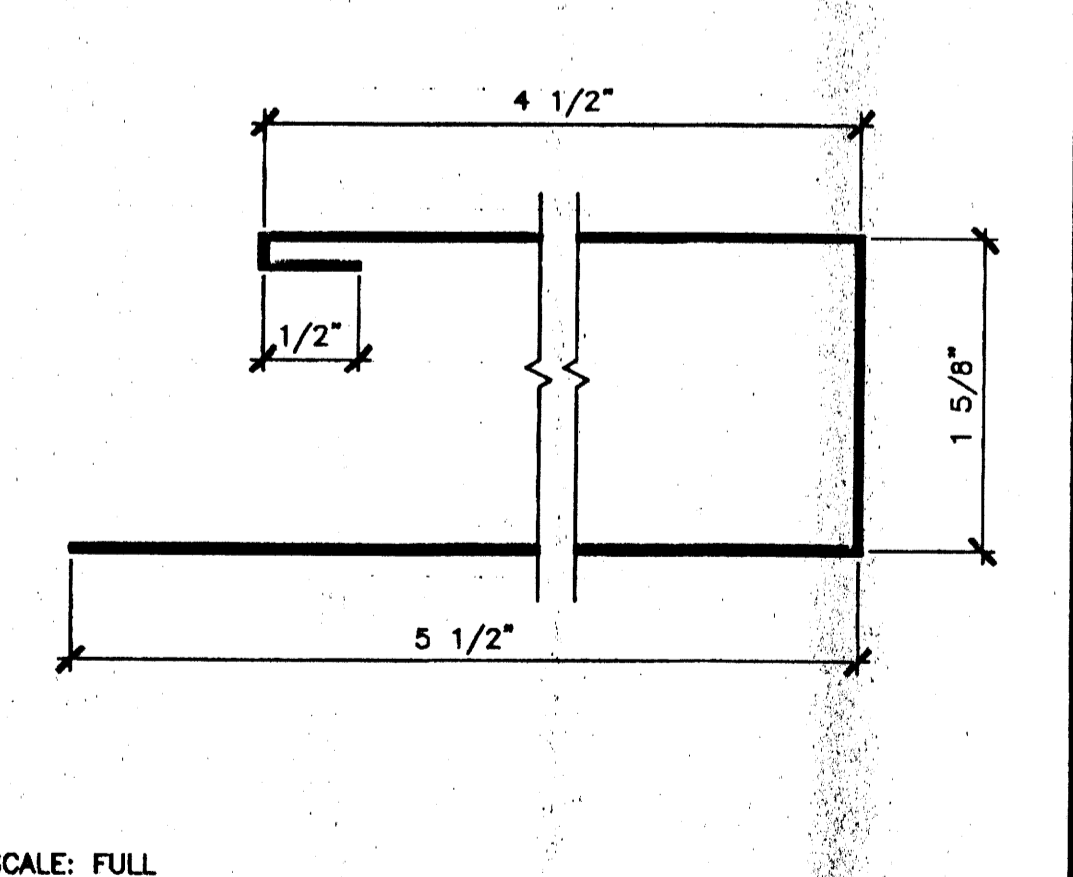

SCALE: FULL
FLASHING AT ROOF 8

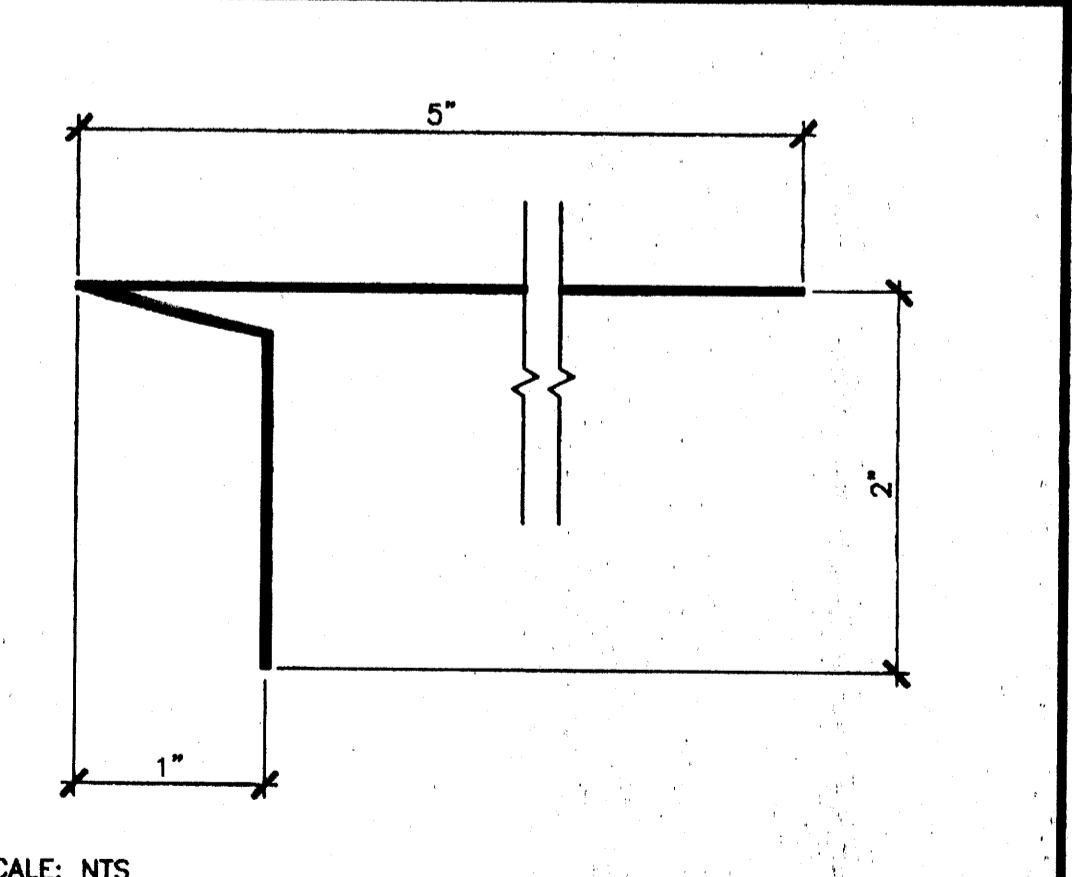

SCALE: NTS
FLASHING AT ROOF LOW SIDE(S) 4

REVISIONS

1		
2		
3		
4		
5		

Electrical Engineer's Seal
 Mechanical Engineer's Seal
 Structural Engineer's Seal
 Architects Seal

IDENTIFICATION STAMP
 DIV. OF THE STATE ARCHITECT
 OFFICE OF REGULATION SERVICES
 PC-04
 101268
 DATE: SEP 07 1999

MODTECH INC.
 2830 BARRETT AVENUE
 PERRIS, CALIF. 92572
 PH (909) 943-4014
 FAX (909) 940-0427

PROJECT NUMBER: 4373
 COLTON U.S.D.
 © MODTECH, INC. 2002

DRAWN BY: KK
 DATE: 11/19/02
 CHECKED BY: STKP-67
 DATE: 4/12-124
 MODTECH Index No.
A2.03

FILE PATH: 2440-A2.03.DWG PROJECT NO. 4373

MODTECH DESIGN MT-2440

PC 04-101268

JOB #4373A

CLASS LEASING INC STOCKPILE #67

100- 24x40 CLASSROOM BUILDINGS

4012-124-12/05/2002-80 MPH

BCSD - Cesar Chavez
STKP# 67
S/N's: 47529-01/02

BUILDING DATA

STRUCTURAL DESIGN: RIGID FRAME
TYPE OF CONSTRUCTION: V-N
WIND LOAD (EXP C): 70 MPH, 80 MPH
FLOOR LIVE LOAD: 60 PSF, 50+20 PSF, 400 PSF, 105 PSF
ROOF LIVE LOAD: 20 PSF
OCCUPANCY: 24'x40' CLASSROOM - E-2
~~30'x40' CLASSROOM - E-2~~
~~48'x40' CLASSROOM - E-2~~

BUILDING AREA:
24'x40' BUILDING - 960 SF
~~30'x40' BUILDING - 1440 SF~~
~~48'x40' BUILDING - 2016 SF~~
60'x40' BUILDING - 2400 SF
70'x40' BUILDING - 2800 SF
84'x40' BUILDING - 3360 SF

APPLICABLE CODES

1998 BUILDING STANDARDS ADMINISTRATIVE CODE, PART 1, TITLE 24 CCR
1998 CALIFORNIA BUILDING CODE (CBC), PART 2, TITLE 24 CCR (1997 UNIFORM BUILDING CODE VOLUMES 1-3 AND 1998 CALIFORNIA AMENDMENTS)
1998 CALIFORNIA ELECTRICAL CODE (CEC), PART 3, TITLE 24 CCR (1996 NATIONAL ELECTRICAL CODE AND 1998 CALIFORNIA AMENDMENTS)
1998 CALIFORNIA MECHANICAL CODE (CMC), PART 4, TITLE 24 CCR (1997 UNIFORM MECHANICAL CODE AND 1998 CALIFORNIA AMENDMENTS)
1998 CALIFORNIA PLUMBING CODE (CPC), PART 5, TITLE 24 CCR (1997 UNIFORM PLUMBING CODE AND 1998 CALIFORNIA AMENDMENTS)
1998 CALIFORNIA FIRE CODE (CFC), PART 9, TITLE 24 CCR (1997 UNIFORM FIRE CODE AND 1998 CALIFORNIA AMENDMENTS)
1998 CALIFORNIA REFERENCE STANDARDS, PART 12, TITLE 24 CCR (1990 TITLE 19 CCR, PUBLIC SAFETY, STATE FIRE MARSHAL REGULATIONS)

APPLICABLE STANDARDS

NFPA 13 - AUTOMATIC SPRINKLER SYSTEMS - 1996 EDITION
NFPA 14 - STANDPIPE SYSTEMS - 1993 EDITION
NFPA 17A - WET CHEMICAL SYSTEMS - 1990 EDITION
NFPA 24 - PRIVATE FIRE MAINS - 1992 EDITION
NFPA 72 - NATIONAL FIRE ALARM CODE (CALIFORNIA AMENDED) - 1996 EDITION (NOTE: SEE UL STANDARD 1971 FOR "VISUAL DEVICES")
NFPA 253 - CRITICAL RADIANT FLUX OF FLOOR COVERING SYSTEMS - 1989 EDITION
NFPA 2001 - CLEAN AGENT FIRE EXTINGUISHING SYSTEMS - 1994 EDITION (REFERENCE CODE SECTION FOR NFPA STANDARDS - CBC (SFM) 3504.1)

LEGEND

SYMBOL	DESCRIPTION
(1)	DETAIL (1) ON SAME SHEET AS SYMBOL
(1/2)	DETAIL (1) ON SHEET (2)
1	KEY NOTE (1) ON SAME SHEET AS SYMBOL
A	SECTION "A" ON SHEET (2)
1	REVISION/CHANGE IN DRAWING. (1) IS FIRST REVISION
CLOUD	HIGHLIGHTS CHANGED AREA
1	DOOR REFERENCE
A	WINDOW REFERENCE
EL	ELECTRICAL ITEM(S) SEE ELECTRICAL DRAWINGS
HV	HEATING/VENTILATING & AIR CONDITIONING ITEM(S) SEE MECHANICAL DRAWINGS
PLG	PLUMBING ITEM(S) SEE MECHANICAL DRAWINGS
STR	STRUCTURAL ITEM(S) SEE STRUCTURAL DRAWINGS
FIN	FINISH ITEM(S) SEE FINISH SCHEDULE
RAMP	RAMP - SEE RAMP DRAWINGS

WITH THE SIGNING OF THESE DRAWINGS, WE ACKNOWLEDGE THAT WE HAVE REVIEWED THESE PLANS AND SPECIFICATIONS AND HAVE FOUND THEM TO BE IN GENERAL COMPLIANCE WITH THE BID DRAWINGS, SPECIFICATIONS AND ASSOCIATED ADDENDA. WHEN THESE PLANS AND SPECIFICATIONS HAVE BEEN APPROVED BY THE DIVISION OF THE STATE ARCHITECT, THEY SHALL PRESEDE OVER CONFLICTING AREAS IN THE BID DRAWINGS AND SPECIFICATIONS, AND ANY ADDENDA THERETO.

CONFIDENTIAL - THIS DOCUMENT AND THE INFORMATION CONTAINED HEREIN ARE THE PROPERTY OF MODTECH, INC. UNAUTHORIZED COPYING, DISCLOSURE OR OTHER UNAUTHORIZED USES ARE PROHIBITED.

PROJECT NUMBER: 4373-M, 4378-M, 4380-M © MODTECH, INC. 1999
4438, 4474, 4505, 4525

COVER SHEET

SHEET INDEX

ARCHITECTURAL	
A0.01	COVER SHEET
A1.01	FLOOR PLAN - 24'x40'
A1.02	FLOOR PLAN - 30'x40'
A1.03	FLOOR PLAN - 48'x40'
A1.11	FLOOR PLAN - INDIVIDUAL MODULES
A1.12	FLOOR PLAN - INDIVIDUAL MODULES
A1.21	TYPICAL MULTIPLE UNIT LAYOUTS
A2.01	ROOF PLAN - 26 GA - DUAL PITCH
A2.02	ROOF PLAN - 26 GA - MONO PITCH
A2.03	ROOF DETAILS - 26 GA
A2.11	ROOF PLAN - 22 GA - DUAL PITCH
A2.12	ROOF PLAN - 22 GA - MONO PITCH
A2.13	ROOF DETAILS - 22 GA
A2.21	ROOF PLAN - BUILT UP ROOF - DUAL PITCH
A2.22	ROOF PLAN - BUILT UP ROOF - MONO PITCH
A3.01	EXTERIOR ELEVATIONS - 26 GA - DUAL PITCH - 24'x40'
A3.02	EXTERIOR ELEVATIONS - 26 GA - DUAL PITCH - 30'x40'
A3.03	EXTERIOR ELEVATIONS - 26 GA - DUAL PITCH - 48'x40'
A3.11	EXTERIOR ELEVATIONS - 26 GA - MONO PITCH - 24'x40'
A3.12	EXTERIOR ELEVATIONS - 26 GA - MONO PITCH - 30'x40'
A3.13	EXTERIOR ELEVATIONS - 26 GA - MONO PITCH - 48'x40'
A3.21	EXTERIOR ELEVATIONS - 22 GA - DUAL PITCH - 24'x40'
A3.22	EXTERIOR ELEVATIONS - 22 GA - DUAL PITCH - 30'x40'
A3.23	EXTERIOR ELEVATIONS - 22 GA - DUAL PITCH - 48'x40'
A3.31	EXTERIOR ELEVATIONS - 22 GA - MONO PITCH - 24'x40'
A3.32	EXTERIOR ELEVATIONS - 22 GA - MONO PITCH - 30'x40'
A3.33	EXTERIOR ELEVATIONS - 22 GA - MONO PITCH - 48'x40'
A3.41	EXTERIOR ELEVATIONS - TYPICAL
A4.01	INTERIOR ELEVATIONS - 24'x40'
A4.02	INTERIOR ELEVATIONS - 30'x40'
A4.03	INTERIOR ELEVATIONS - 48'x40'
A5.01	DOOR, WINDOW, FINISH, HARDWARE SCHEDULES
A6.01	ARCHITECTURAL DETAILS - WOOD STUDS
A6.11	ARCHITECTURAL DETAILS - METAL STUDS
A6.21	ARCHITECTURAL DETAILS - STUDS
A7.01	REFLECTED CEILING PLAN - 24'x40'
A7.02	REFLECTED CEILING PLAN - 30'x40'
A7.03	REFLECTED CEILING PLAN - 48'x40'
A7.04	REFLECTED CEILING PLAN - 24'x40'
A7.05	REFLECTED CEILING PLAN - 30'x40'
A7.06	REFLECTED CEILING PLAN - 48'x40'
A7.11	REFLECTED CEILING DETAILS
A8.01	MISCELLANEOUS OPTIONS

STRUCTURAL

F1.01	FOUNDATION PLAN - WOOD - 24'x40' - 50, 50+20, 100 PSF
F1.02	FOUNDATION PLAN - WOOD - 30'x40' - 50, 50+20, 100 PSF
F1.03	FOUNDATION PLAN - WOOD - 48'x40' - 50, 50+20, 100 PSF
F1.04	FOUNDATION PLAN - WOOD - 24'x40' - 105 PSF
F1.05	FOUNDATION PLAN - WOOD - 30'x40' - 105 PSF
F1.06	FOUNDATION PLAN - WOOD - 48'x40' - 105 PSF
F1.11	FOUNDATION DETAILS - 125 PSF
F1.12	FOUNDATION DETAILS - 100 PSF
F2.01	FOUNDATION PLAN - AGC - 50, 50+20, 100 PSF
F2.02	FOUNDATION PLAN - AGC - 100, 125 PSF
F2.11	FOUNDATION DETAILS - AGC
F3.01	FOUNDATION PLAN - BGC - 50, 50+20 PSF
F3.02	FOUNDATION PLAN - BGC - 100, 125 PSF
F3.11	FOUNDATION DETAILS - BGC
S1.01	FLOOR FRAMING PLAN - WOOD DECK
S2.01	ROOF FRAMING PLAN - 26 GA - DUAL PITCH
S2.02	ROOF FRAMING PLAN - 26 GA - MONO PITCH
S2.11	ROOF FRAMING PLAN - 22 GA - DUAL PITCH
S2.12	ROOF FRAMING PLAN - 22 GA - MONO PITCH
S3.01	STRUCTURAL FRAMING - 26 GA - DUAL PITCH
S3.02	STRUCTURAL FRAMING - 26 GA - MONO PITCH
S3.11	STRUCTURAL FRAMING - 22 GA - DUAL PITCH
S3.12	STRUCTURAL FRAMING - 22 GA - MONO PITCH
S4.01	WALL FRAMING - WOOD STUDS
S4.02	WALL FRAMING DETAILS - WOOD STUDS
S4.11	WALL FRAMING - STEEL STUDS
S4.12	WALL FRAMING DETAILS - STEEL STUDS

MECHANICAL

M1.01	HVAC PLAN - 24'x40'
M1.02	HVAC PLAN - 30'x40'
M1.03	HVAC PLAN - 48'x40'
M1.04	HVAC PLAN - 24'x40'
M1.05	HVAC PLAN - 30'x40'
M1.06	HVAC PLAN - 48'x40'

ELECTRICAL

E1.01	ELECTRICAL PLAN - 24'x40'
E1.02	ELECTRICAL PLAN - 30'x40'
E1.03	ELECTRICAL PLAN - 48'x40'
E1.04	ELECTRICAL PLAN - 24'x40'
E1.05	ELECTRICAL PLAN - 30'x40'
E1.06	ELECTRICAL PLAN - 48'x40'

RAMP

R1.01	RAMP/LANDING PLAN
R1.02	RAMP/STAIRS DETAILS
R2.01	OFFSET RAMP/LANDING PLAN
R2.02	OFFSET RAMP/STAIRS DETAILS
R3.01	FULL LENGTH RAMP/LANDING AND DETAILS
R4.01	CONCRETE RAMP/LANDING
R4.02	CONCRETE RAMP/LANDING

STKP-67
DRAWN BY: KK 12/5/02
DATE: 11/19/02
CHECKED BY:
DATE: 4012-124
MODTECH Index No.

A0.01

REVISE A0.01 COVER SHEET: ADD NEW SHEET NUMBERS

A1.01C FLOOR PLANS FOR BLDG: C/ WITH STUDENT TOILETS
A3.11C EXTERIOR ELEVATIONS BLDG: C
A4.01C INTERIOR ELEVATIONS BLDG: C
A7.01C REFLECTED CEILING PLANS: C
M1.01C MECHANICAL PLAN BLDG: C
E1.01C ELECTRICAL PLAN BLDG: C
R2.01 OFFSET RAMP/LANDING PLAN
R2.02 OFFSET RAMP/STAIR DETAILS

DEC 13 2002
REVISED
IDENTIFICATION STAMP
DIV. OF THE STATE ARCHITECT
OFFICE OF REGULATION SERVICES
04 104812
DATE DEC 5 2002
U.D.P. J. Schable
F.W. P. L. L. L. L. L.
S.S. CRIST

"AS ALTERNATE FOR ALL SHOT PIN ATTACHMENTS, USE #10 S.T.M.S. AT THE SAME SPACING."
#10 USE MAX. 3/8" MATERIAL
#12 USE MAX. 1/2" MATERIAL

ABBREVIATIONS

AGC = ABOVE GRADE CONCRETE
BGC = BELOW GRADE CONCRETE
DIA = DIAMETER
CLR = CLEAR
GA = GAUGE
SIM = SIMILAR
MAX = MAXIMUM
MIN = MINIMUM
NIC = NOT IN CONTRACT
NTS = NOT TO SCALE
OC = ON CENTER
OD = OUTSIDE DIAMETER
OSB = ORIENTED STRAND BOARD
SIM = SIMILAR
STS = SELF TAPPING SCREW
STSMS = SELF TAPPING SHEET METAL SCREW
TYP = TYPICAL
UON = UNLESS OTHERWISE NOTED

REVISED NOV 09 2000

CBC 1998

CHANGES TO THE APPROVED DRAWINGS & SPECIFICATIONS SHALL BE MADE BY AN ADDENDUM OR A CHANGE ORDER APPROVED BY THE DIVISION OF THE STATE ARCHITECT, AS REQUIRED BY SECTION 4-338, PART 2, TITLE 24, CCR. A PROJECT INSPECTOR EMPLOYED BY THE OWNER AND APPROVED BY THE OFFICE P.S.A. SHALL PROVIDE CONTINUOUS INSPECTION OF THE WORK. THE DUTY OF THE INSPECTOR ARE DEFINED IN SECTION 4-338, PART 2, TITLE 24, CCR.

REVISIONS	SP	ADDED ALT NOTE/AND ELECT SHEETS	11/9/00
1			
2			
3			
4			
5			

Electrical Engineer's Seal
Mechanical Engineer's Seal
Structural Engineer's Seal
Architect's Seal

IDENTIFICATION STAMP
DIV. OF THE STATE ARCHITECT
OFFICE OF REGULATION SERVICES
PC-04
101268
DATE SEP 17 1999
ACAD. P. L. L. L. L.

MODTECH INC.
2830 BARRETT AVENUE
PERRIS, CALIF. 92572
PH (909) 943-4014
FAX (909) 940-0427


FILE PATH: 2440-A0-01.DWG PROJECT NO. 4373 PC-04-101268

KEY NOTES

- 1 ROOF OVERHANG
- 2 HVAC UNIT (HV)
- 3 MODLINE (M)
- 4 FINISH FLOORING (FIN)
- 5 INTERIOR FINISH (FIN)
- 6 ELECTRICAL PANEL (EL)
- 7 2- 8'x4' MARKER BOARDS (SEE SPECIFICATIONS FOR TYPE)
- 8 FIRE EXTINGUISHER - 5 POUNDS DRY CHEMICAL WITH 2A - 10BC UL RATING ON WALL MTD BRACKET, HANDLE AT 48" AFF
- 9 RAMP/LANDING (RAMP)
- 10 SIGNAGE PROVIDED AND INSTALLED BY DISTRICT PRIOR TO OCCUPANCY. 5/AS.01

NOTES

- 1. PLACE (2) PERMANENT METAL IDENTIFICATION LABELS ON EACH MODULE. (1) LABEL AT REAR EXTERIOR AND (1) LABEL ABOVE CEILING LINE AT INTERIOR FRAME. LABELS WILL BE MECHANICALLY FASTENED AND SHOW THE DSA APPLICATION NUMBER, MANUFACTURERS NAME AND SERIAL NUMBER, DESIGN LIVE LOAD FOR ROOF AND FLOOR FRAMING, WIND SPEED AND EXPOSURE CATEGORY.
- 2. INSULATION MATERIALS INSTALLED WITHIN FLOOR/CEILING ASSEMBLIES, ROOF-CEILING ASSEMBLIES, WALLS, CRAWL SPACES OR ATTICS SHALL HAVE A FLAME SPREAD RATING NOT TO EXCEED 25 AND A SMOKE DENSITY NOT TO EXCEED 450. EXCEPTIONS:
 (1) FOAM PLASTIC INSULATION SHALL COMPLY WITH SECTION 2602
 (2) WHEN MATERIALS ARE INSTALLED IN CONCEALED SPACES OF TYPES III, IV, AND V CONSTRUCTION, THE FLAME SPREAD AND SMOKE-DEVELOPED LIMITATIONS DO NOT APPLY TO FACINGS IF THE FACING IS INSTALLED IN SUBSTANTIAL CONTACT WITH THE UNEXPOSED SURFACE OF THE CEILING, FLOOR OR WALL FINISH (CBC SECTION 707.3)
 (3) CELLULOSE LOOSE FILL INSULATION SHALL COMPLY WITH CPSC 16 CFR PARTS 1209 AND 1404
- 3. INTERIOR SIDE WALLS MAY BE LOCATED ON EITHER SIDE OF MODLINE
- 4. DISTRICT TO PROVIDE OCCUPANT LOAD SIGN PRIOR TO OCCUPANCY.

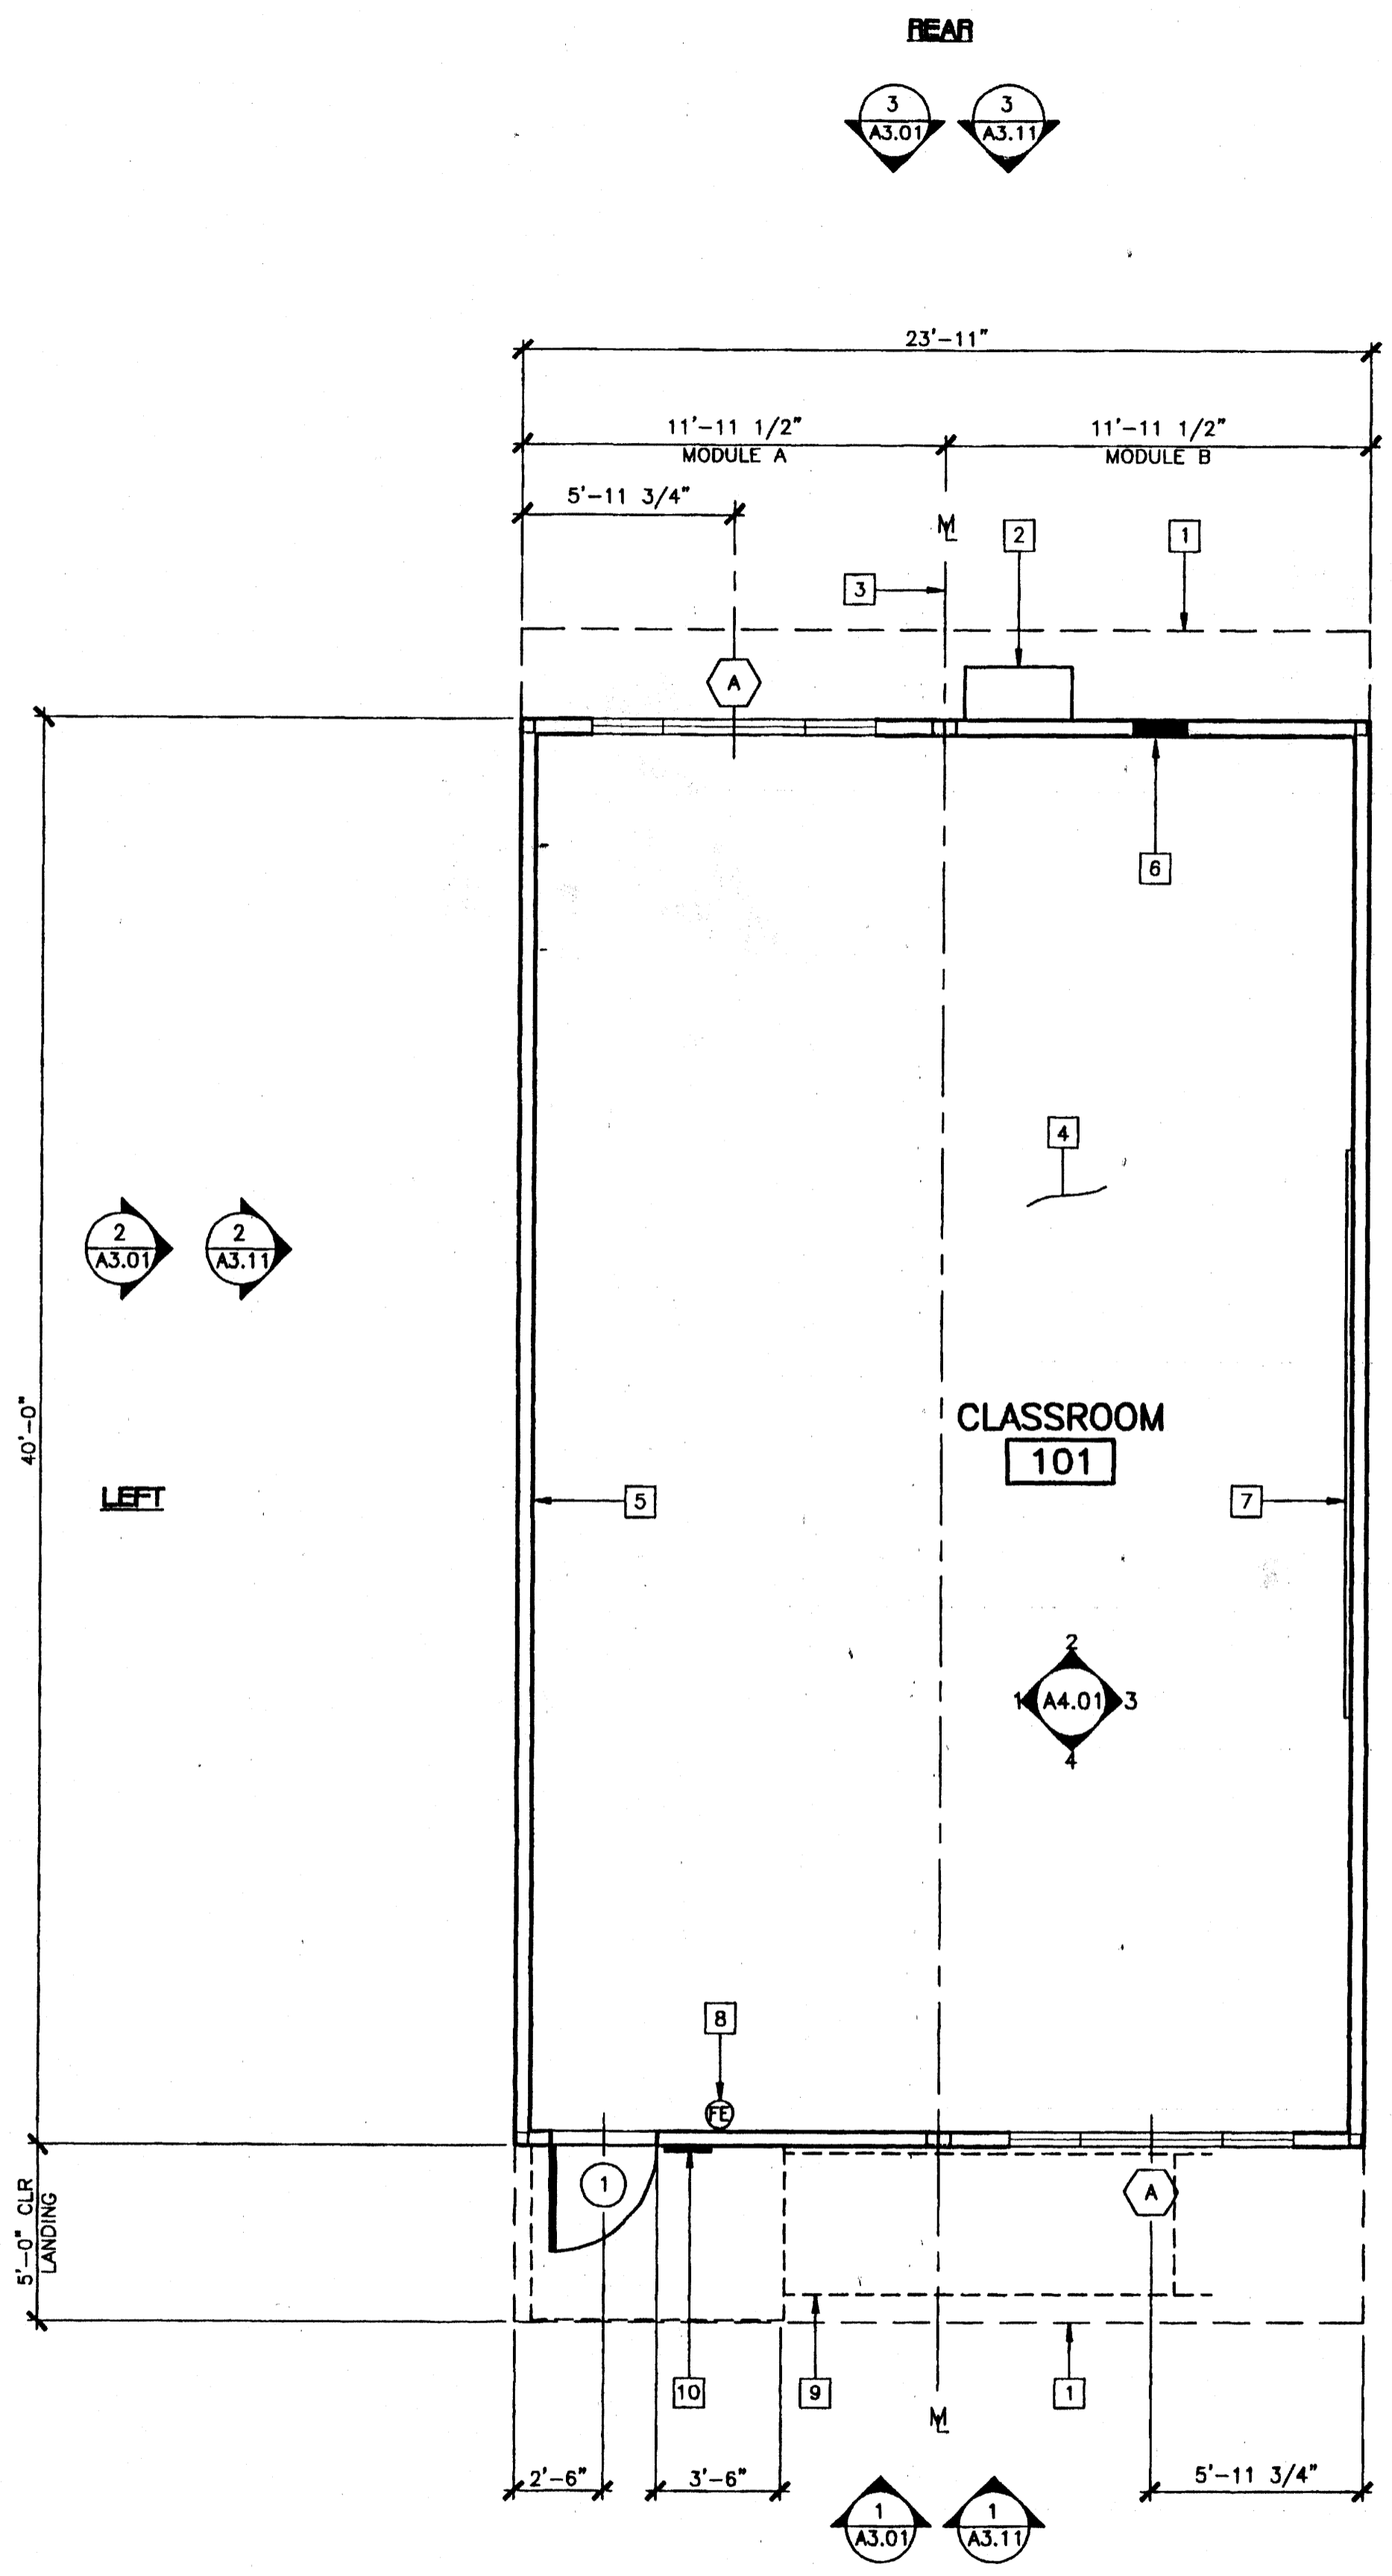

PC
CBC 1998

FLOOR PLAN

(24'x40')
SCALE: 1/4" = 1'-0"

REVISIONS	Electrical Engineer's Seal	Mechanical Engineer's Seal	Structural Engineer's Seal	Architect's Seal	IDENTIFICATION STAMP	MODTECH INC.	PROJECT NUMBER:	DRAWN BY:

Electrical Engineer's Seal

Mechanical Engineer's Seal

Structural Engineer's Seal

Architect's Seal

IDENTIFICATION STAMP
DIV. OF THE STATE ARCHITECT
OFFICE OF REGULATION SERVICES
PC-04
101268
DATE SEP 07 1999

MODTECH INC.
2830 BARRETT AVENUE
PERRIS, CALIF. 92572
PH (909) 943-4014
FAX (909) 940-0427

PROJECT NUMBER: 4373, 4378, 4438 4474 © MODTECH, INC. 2002
4505, 4525

DRAWN BY: KK
DATE: 11/19/02
CHECKED BY: STKP-67
DATE: 4012-124
MODTECH Index No.


FLOOR PLAN

24'x40'


A1.01

FILE PATH: 2440-A1.01.DWG PROJECT NO. 4373 PC-04-101268


- HARDWARE SET #7A(PANIC)**
- LOCKSET - VON DUPRIN 99L PANIC HARDWARE OR EQUAL BARD W/ KEYPED CYLINDER AT EXT AND HEX KEY DOGGING AT INT., INSTALLED W/ THRU HEX BOLTS CYLINDERS KEYPED PER DISTRICT DIRECTION.
 - BUTTS - 1 1/2" PAIR HAGER BB1279 4 1/2"x4 1/2" NRP 260 OR EQUAL.
 - CLOSER - LCN 4041
 - THRESHOLD - PEMCO 271A OR EQUAL.
 - DOOR BOTTOM - PEMCO 218AV OR EQUAL.
 - WEATHER-STRIP - PEMCO 228AV OR EQUAL.
 - TRIM CLIP - 110 MD
 - TRIMCO PULL - 111A
 - RHM CYLINDER SCHLAGE - 20-022

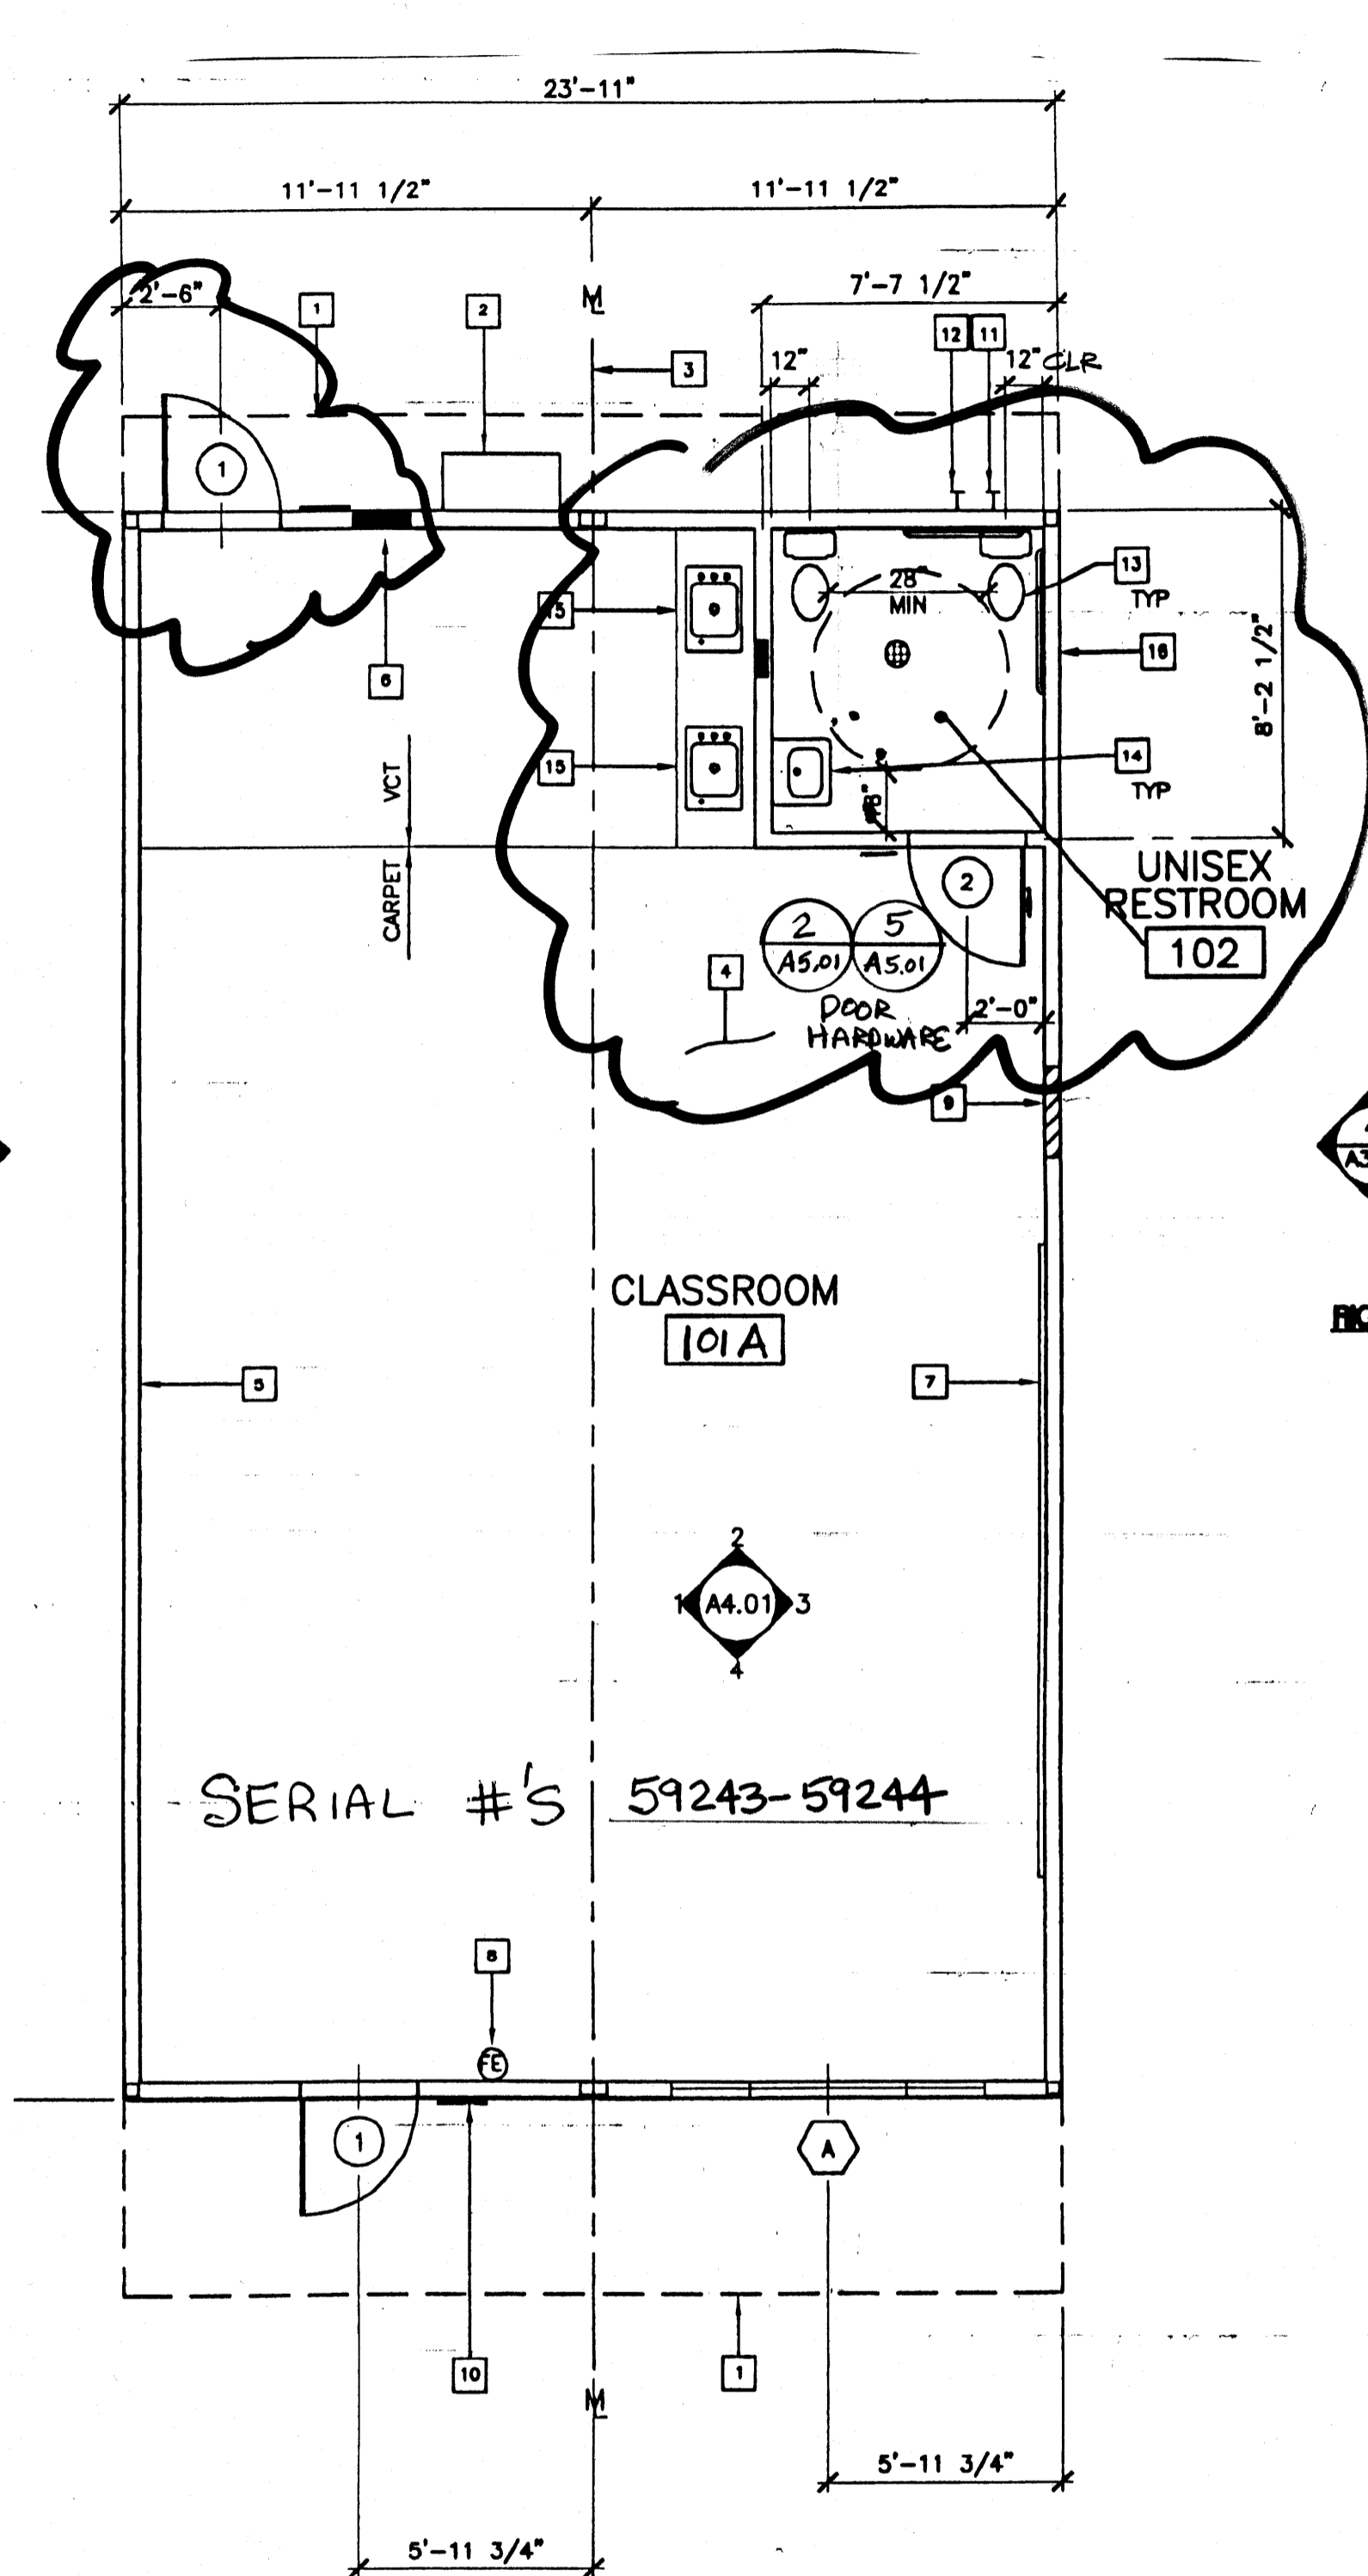


FLOOR PLAN "C"

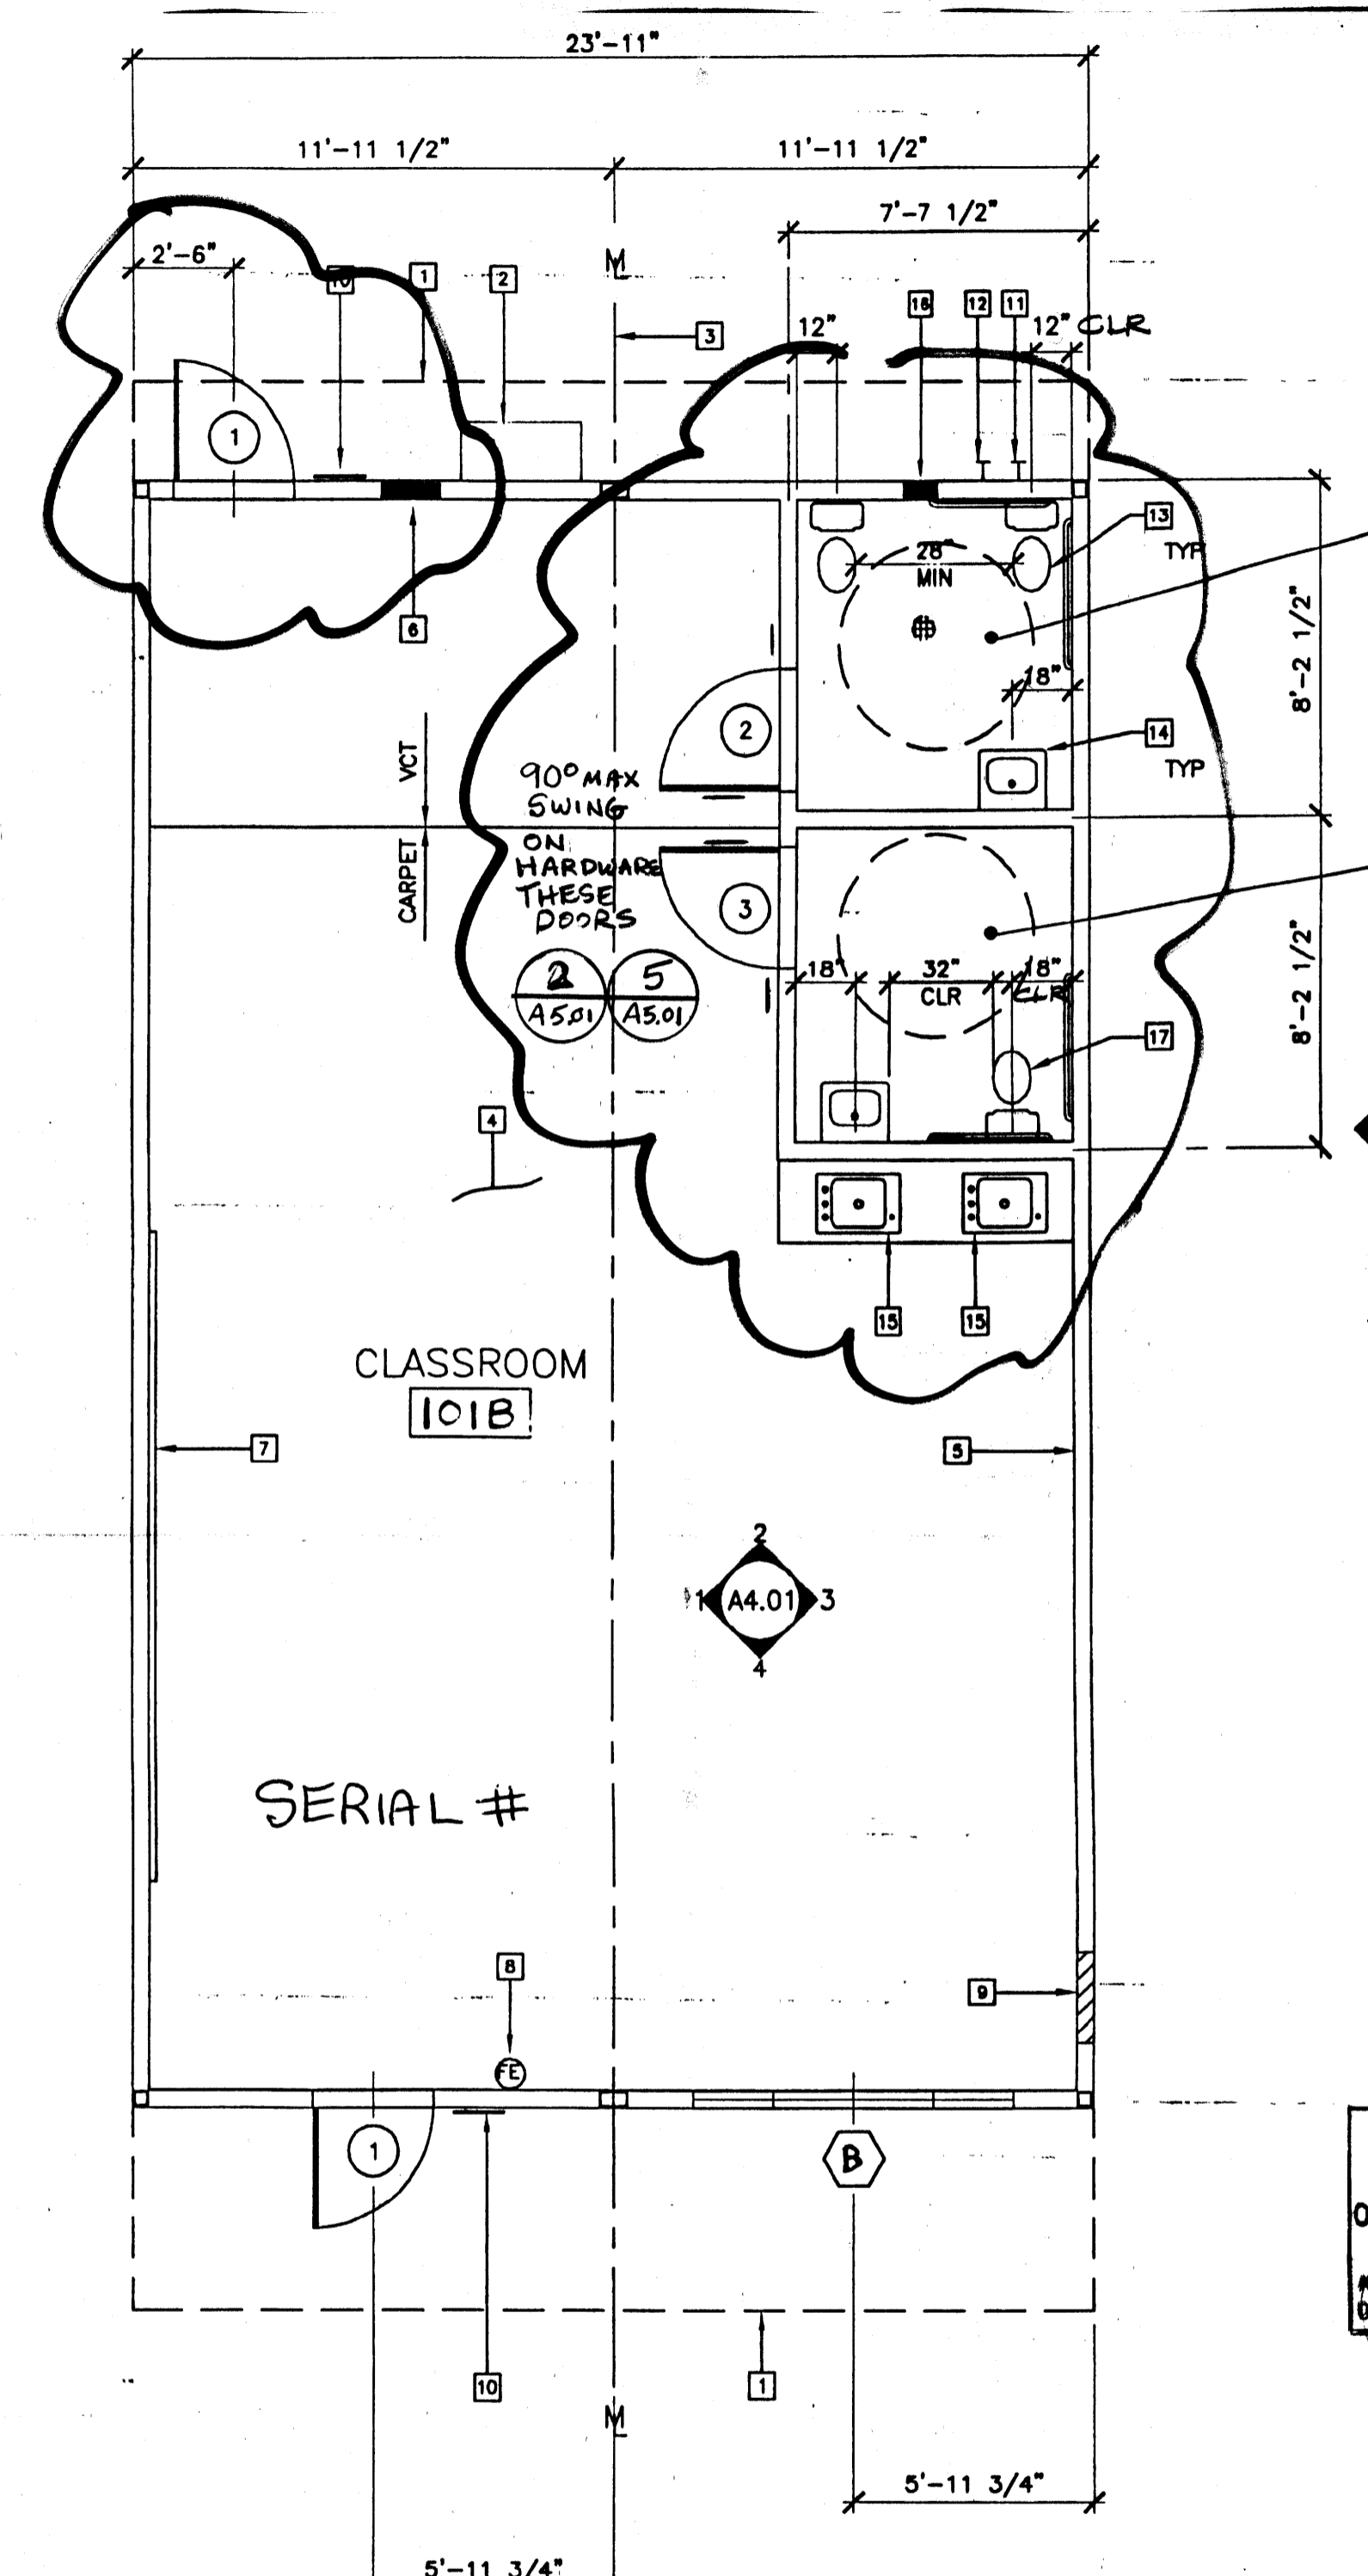


FLOOR PLAN "C-1"

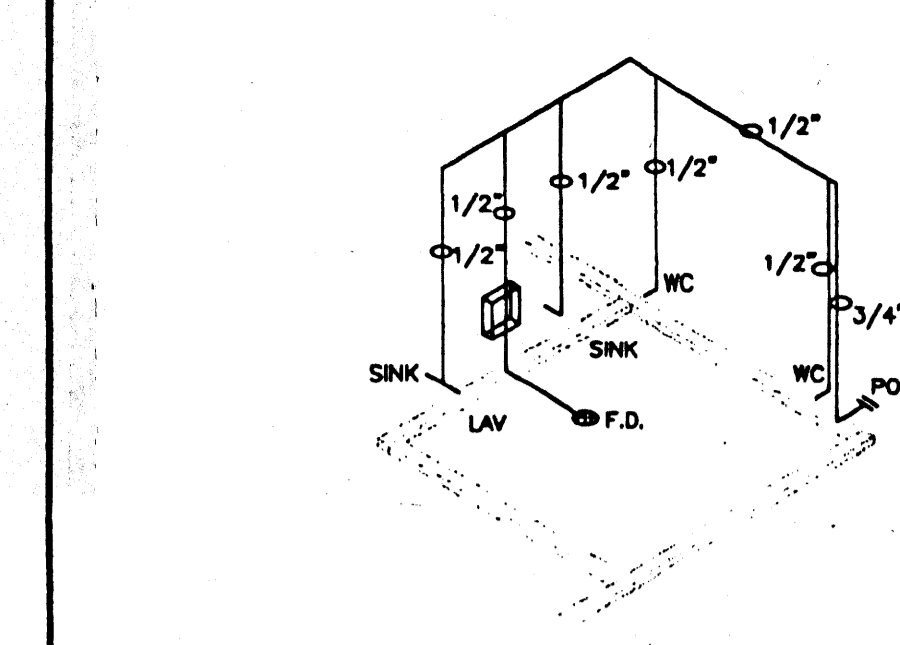


C.W. SUPPLY @ Rm 102

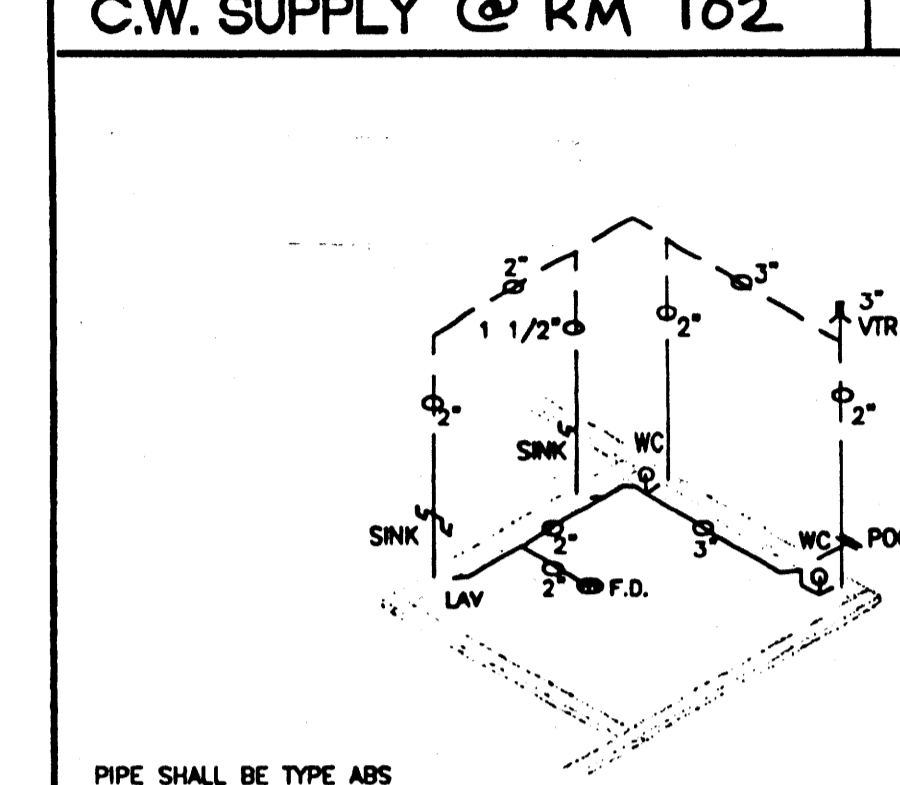

WASTE AND VENT @ Rm 102

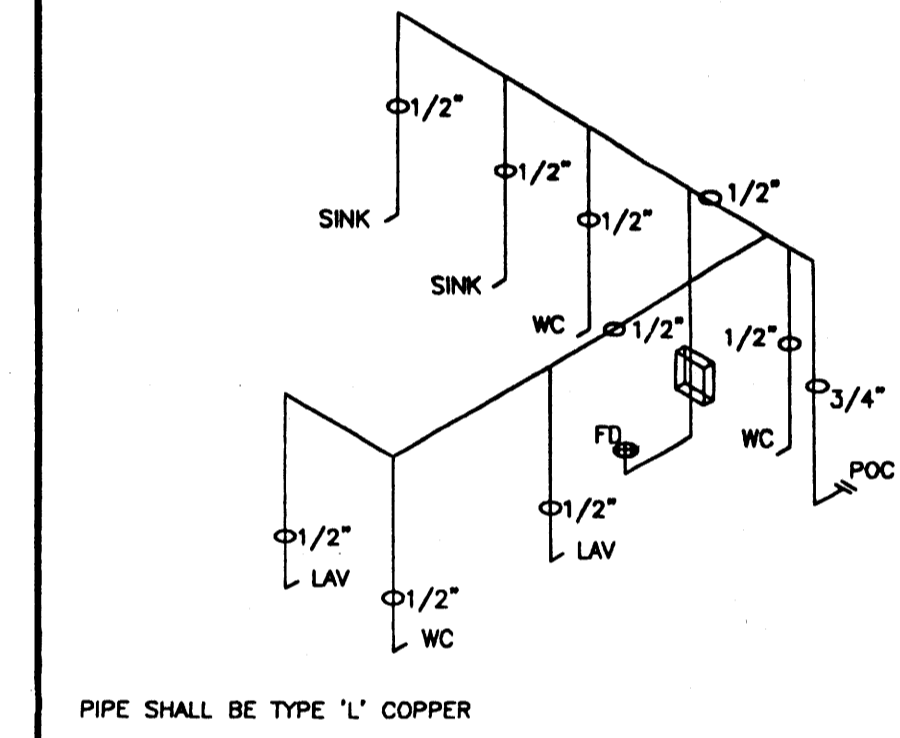

C.W. SUPPLY @ Rm 103/104

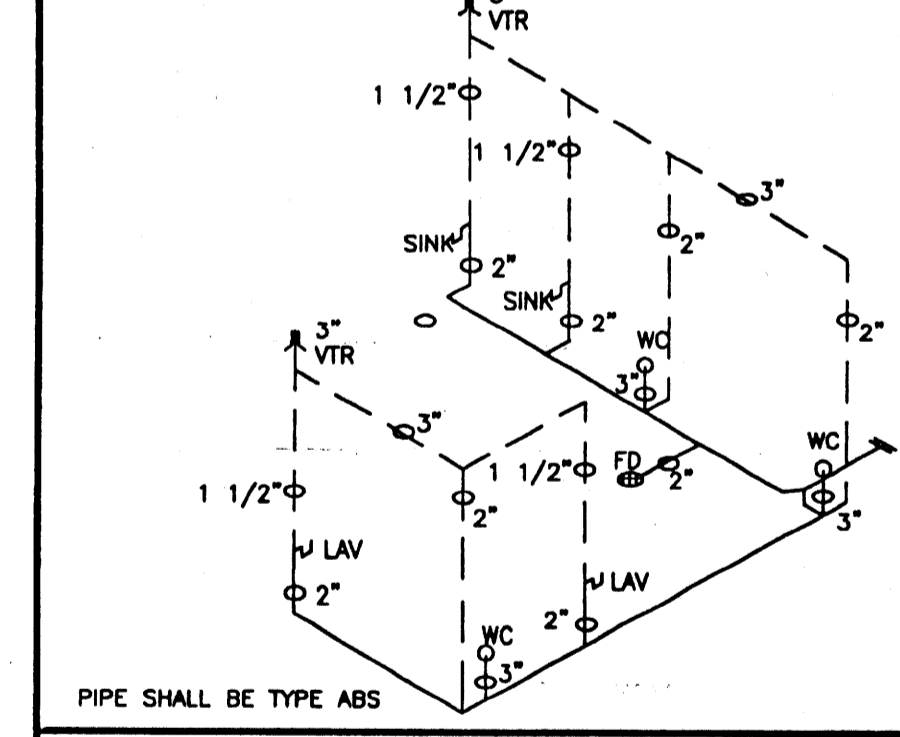

WASTE AND VENT @ Rm 103/104

KEY NOTES

- ROOF OVERHANG
- HVAC UNIT (HV)
- MODLINE (M)
- FINISH FLOORING (FN)
- INTERIOR FINISH (FIN)
- ELECTRICAL PANEL (EL)
- 2- 8'x4' MARKER BOARDS (SEE SPECIFICATIONS FOR TYPE)
- FIRE EXTINGUISHER - 5 POUNDS DRY CHEMICAL WITH 2A - 10BC UL RATING ON WALL MTD BRACKET, HANDLE AT 48" AFF
- PROVIDE BLOCKING FOR FUTURE TV BRACKET, SEE SHEET A4.01
- SIGNAGE PROVIDED AND INSTALLED BY DISTRICT PRIOR TO OCCUPANCY, 5/A5.01
- C.W. POC
- WASTE POC
- WC-1 CRANE C3-811 SEAT OLSONITE #120
- LV-1 CRANE C1-412V/FAUCET-FREEDOM 1208A-01/CARRIER-1725 DRAIN TRAP-GRID/ANGLE STOP-114SCR19
- CABINET W/JUST CRADA1725/FAUCET-FREEDOM 1208A-01 BUBBLER-JUST JSB-10
- TRAP PRIMER FOR 2" ZURN FLOOR DRAIN
- WC-2 CRANE C3-392, SEAT OLSONITE 126

NOTES

- METAL TAG ON ALL MODULES. MECHANICALLY ATTACHED TO REAR EXTERIOR OF BUILDING. SHOW DSA APPLICATION NUMBER, MANUFACTURER'S NAME AND SERIAL NUMBER, ROOF AND FLOOR DESIGN LIVE LOAD AND DESIGN WIND LOAD
- INSULATION MATERIALS INSTALLED WITHIN FLOOR/CEILING ASSEMBLIES, ROOF-CEILING ASSEMBLIES, WALLS, CRAWL SPACES OR ATTICS SHALL HAVE A FLAME SPREAD RATING NOT TO EXCEED 25 AND A SMOKE DENSITY NOT TO EXCEED 450. EXCEPTIONS:
 (1) FOAM PLASTIC INSULATION SHALL COMPLY WITH SECTION 2602
 (2) WHEN MATERIALS ARE INSTALLED IN CONCEALED SPACES OF TYPES III, IV, AND V CONSTRUCTION, THE FLAME SPREAD AND SMOKE-DEVELOPED LIMITATIONS DO NOT APPLY TO FACINGS IF THE FACING IS INSTALLED IN SUBSTANTIAL CONTACT WITH THE UNEXPOSED SURFACE OF THE CEILING, FLOOR OR WALL FINISH
 (3) CELLULOSE LOOSE FILL INSULATION SHALL COMPLY WITH CPSC 16 CFR PARTS 1209 AND 1404
- INTERIOR SIDE WALLS MAY BE LOCATED ON EITHER SIDE OF MODLINE

WINDOW SCHEDULE

WINDOW NUMBER	WINDOW TYPE	QUANTITY	FRAME OPENING		FINISH	REMARKS
			WIDTH	HEIGHT		
1	1	1	8'-0"	2'-0"	ANODIZED	

DOOR SCHEDULE

DOOR NUMBER	DOOR TYPE	QUANTITY	FRAME OPENING		DOOR MATERIAL	FIRE RATING	HARDWARE SET NO.	FRAME MATERIAL	JAMB THROAT	REMARK
			WIDTH	HEIGHT						
1	A	2	3'-0"	6'-8"	HM	7	HM	5-1/8"		
2	B	1	3'-0"	6'-8"	HM	2	HM	5-1/8"		

ROOM FINISH SCHEDULE

ROOM NUMBER	ROOM NAME	FLOOR	BASE	FINISHES				CEILING	CEILING HEIGHT
				NORTH	EAST	SOUTH	WEST		
101	CLASSROOM	A/C	0	0	0	0	0	0	8'-0"
102*	UNISEX RESTROOM	B	E	N	N	N	N	0	8'-0"
103	"	B	E	N	N	N	N	0	8'-0"
104*	"	B	E	N	N	N	N	0	8'-0"

- A - CARPET PER STATE OF CALIF SPEC COMPLYING WITH GROUP 1, TYPE A OR TYPE B, CLASS 2, DENSITY 4600, DIRECT GLUE DOWN
- B - VINYL SHEET FLOORING
- VCT - ARMSTRONG STANDARD OR EXCELON
- TOP SET BASE - 4"
- TOP SET BASE - 6"
- SELF COXE BASE - 6"
- 1/2" VINYL TACKBOARD CLASS 1 OVER 1/2" GYP BOARD BACKING
- 1/8" MARLITE OVER 1/2" GYP BOARD OR 3/8" MARLITE FLAME SPREAD CLASS 3
- 1/2" WR GYP BOARD, TAPE, TEXTURE, PAINTED FINISH
- 3/8" WR GYP BOARD, TAPE, TEXTURE, PAINTED FINISH
- 1/2" GYP BOARD, TAPE, TEXTURE, PAINTED FINISH
- 3/8" GYP BOARD, TAPE, TEXTURE, PAINTED FINISH
- 3/32" FRP OVER 1/2" WR GYP BOARD
- NO FINISH
- ACOUSTICAL LAY IN GRID CEILING PANELS (SEE SPECIFICATIONS)

REVISIONS

Electrical Engineer's Seal
 Mechanical Engineer's Seal
 Structural Engineer's Seal
 Architect's Seal

IDENTIFICATION STAMP
 DIV. OF THE STATE ARCHITECT
 OFFICE OF REGULATION SERVICES
 PC-04
 104812
 DATE DEC 19 2002

MODTECH INC.
 2830 BARRETT AVENUE
 PERRIS, CALIF. 92572
 PH (909) 943-4014
 FAX (909) 940-0427

PROJECT NUMBER: **6004**
 CHINO
 CLASS LEASING
 © MODTECH, INC. 1999
 CLASS LEASING INC STOCKPILE # 67
 100-24 x 40 CLASSROOM BUILDINGS
 4012-124 12/05/2002 80 MPH

DRAWN BY: SW
 DATE: 6/26/01
 CHECKED BY:
 DATE:
 MODTECH Index No.
A1.01c

FLOOR PLAN 24'x40'


FILE PATH: 2440-A1.01.DWG PROJECT NO. 3683

KEY NOTES



- 1 ROOF OVERHANG
- 2 HVAC UNIT (HV)
- 3 MODLINE (M)
- 4 FINISH FLOORING (FIN)
- 5 INTERIOR FINISH (FIN)
- 6 ELECTRICAL PANEL (EL)
- 7 2- 8'x4' MARKER BOARDS (SEE SPECIFICATIONS FOR TYPE)
- 8 FIRE EXTINGUISHER - 5 POUNDS DRY CHEMICAL WITH 2A - 10BC UL RATING ON WALL MTD BRACKET, HANDLE AT 48" AFF
- 9 RAMP/LANDING (RAMP)
- 10 SIGNAGE PROVIDED AND INSTALLED BY DISTRICT PRIOR TO OCCUPANCY. 5/AS.01

NOTES

- 1. PLACE (2) PERMANENT METAL IDENTIFICATION LABELS ON EACH MODULE. (1) LABEL AT REAR EXTERIOR AND (1) LABEL ABOVE CEILING LINE AT INTERIOR FRAME. LABELS WILL BE MECHANICALLY FASTENED AND SHOW THE DSA APPLICATION NUMBER, MANUFACTURERS NAME AND SERIAL NUMBER, DESIGN LIVE LOAD FOR ROOF AND FLOOR FRAMING, WIND SPEED AND EXPOSURE CATEGORY.
- 2. INSULATION MATERIALS INSTALLED WITHIN FLOOR/CEILING ASSEMBLIES, ROOF-CEILING ASSEMBLIES, WALLS, CRAWL SPACES OR ATTICS SHALL HAVE A FLAME SPREAD RATING NOT TO EXCEED 25 AND A SMOKE DENSITY NOT TO EXCEED 450. EXCEPTIONS:
 (1) FOAM PLASTIC INSULATION SHALL COMPLY WITH SECTION 2602
 (2) WHEN MATERIALS ARE INSTALLED IN CONCEALED SPACES OF TYPES III, IV, AND V CONSTRUCTION, THE FLAME SPREAD AND SMOKE-DEVELOPED LIMITATIONS DO NOT APPLY TO FACINGS IF THE FACING IS INSTALLED IN SUBSTANTIAL CONTACT WITH THE UNEXPOSED SURFACE OF THE CEILING, FLOOR OR WALL FINISH (CBC SECTION 707.3)
 (3) CELLULOSE LOOSE FILL INSULATION SHALL COMPLY WITH CPSC 16 CFR PARTS 1209 AND 1404
- 3. INTERIOR SIDE WALLS MAY BE LOCATED ON EITHER SIDE OF MODLINE
- 4. DISTRICT TO PROVIDE OCCUPANT LOAD SIGN PRIOR TO OCCUPANCY.

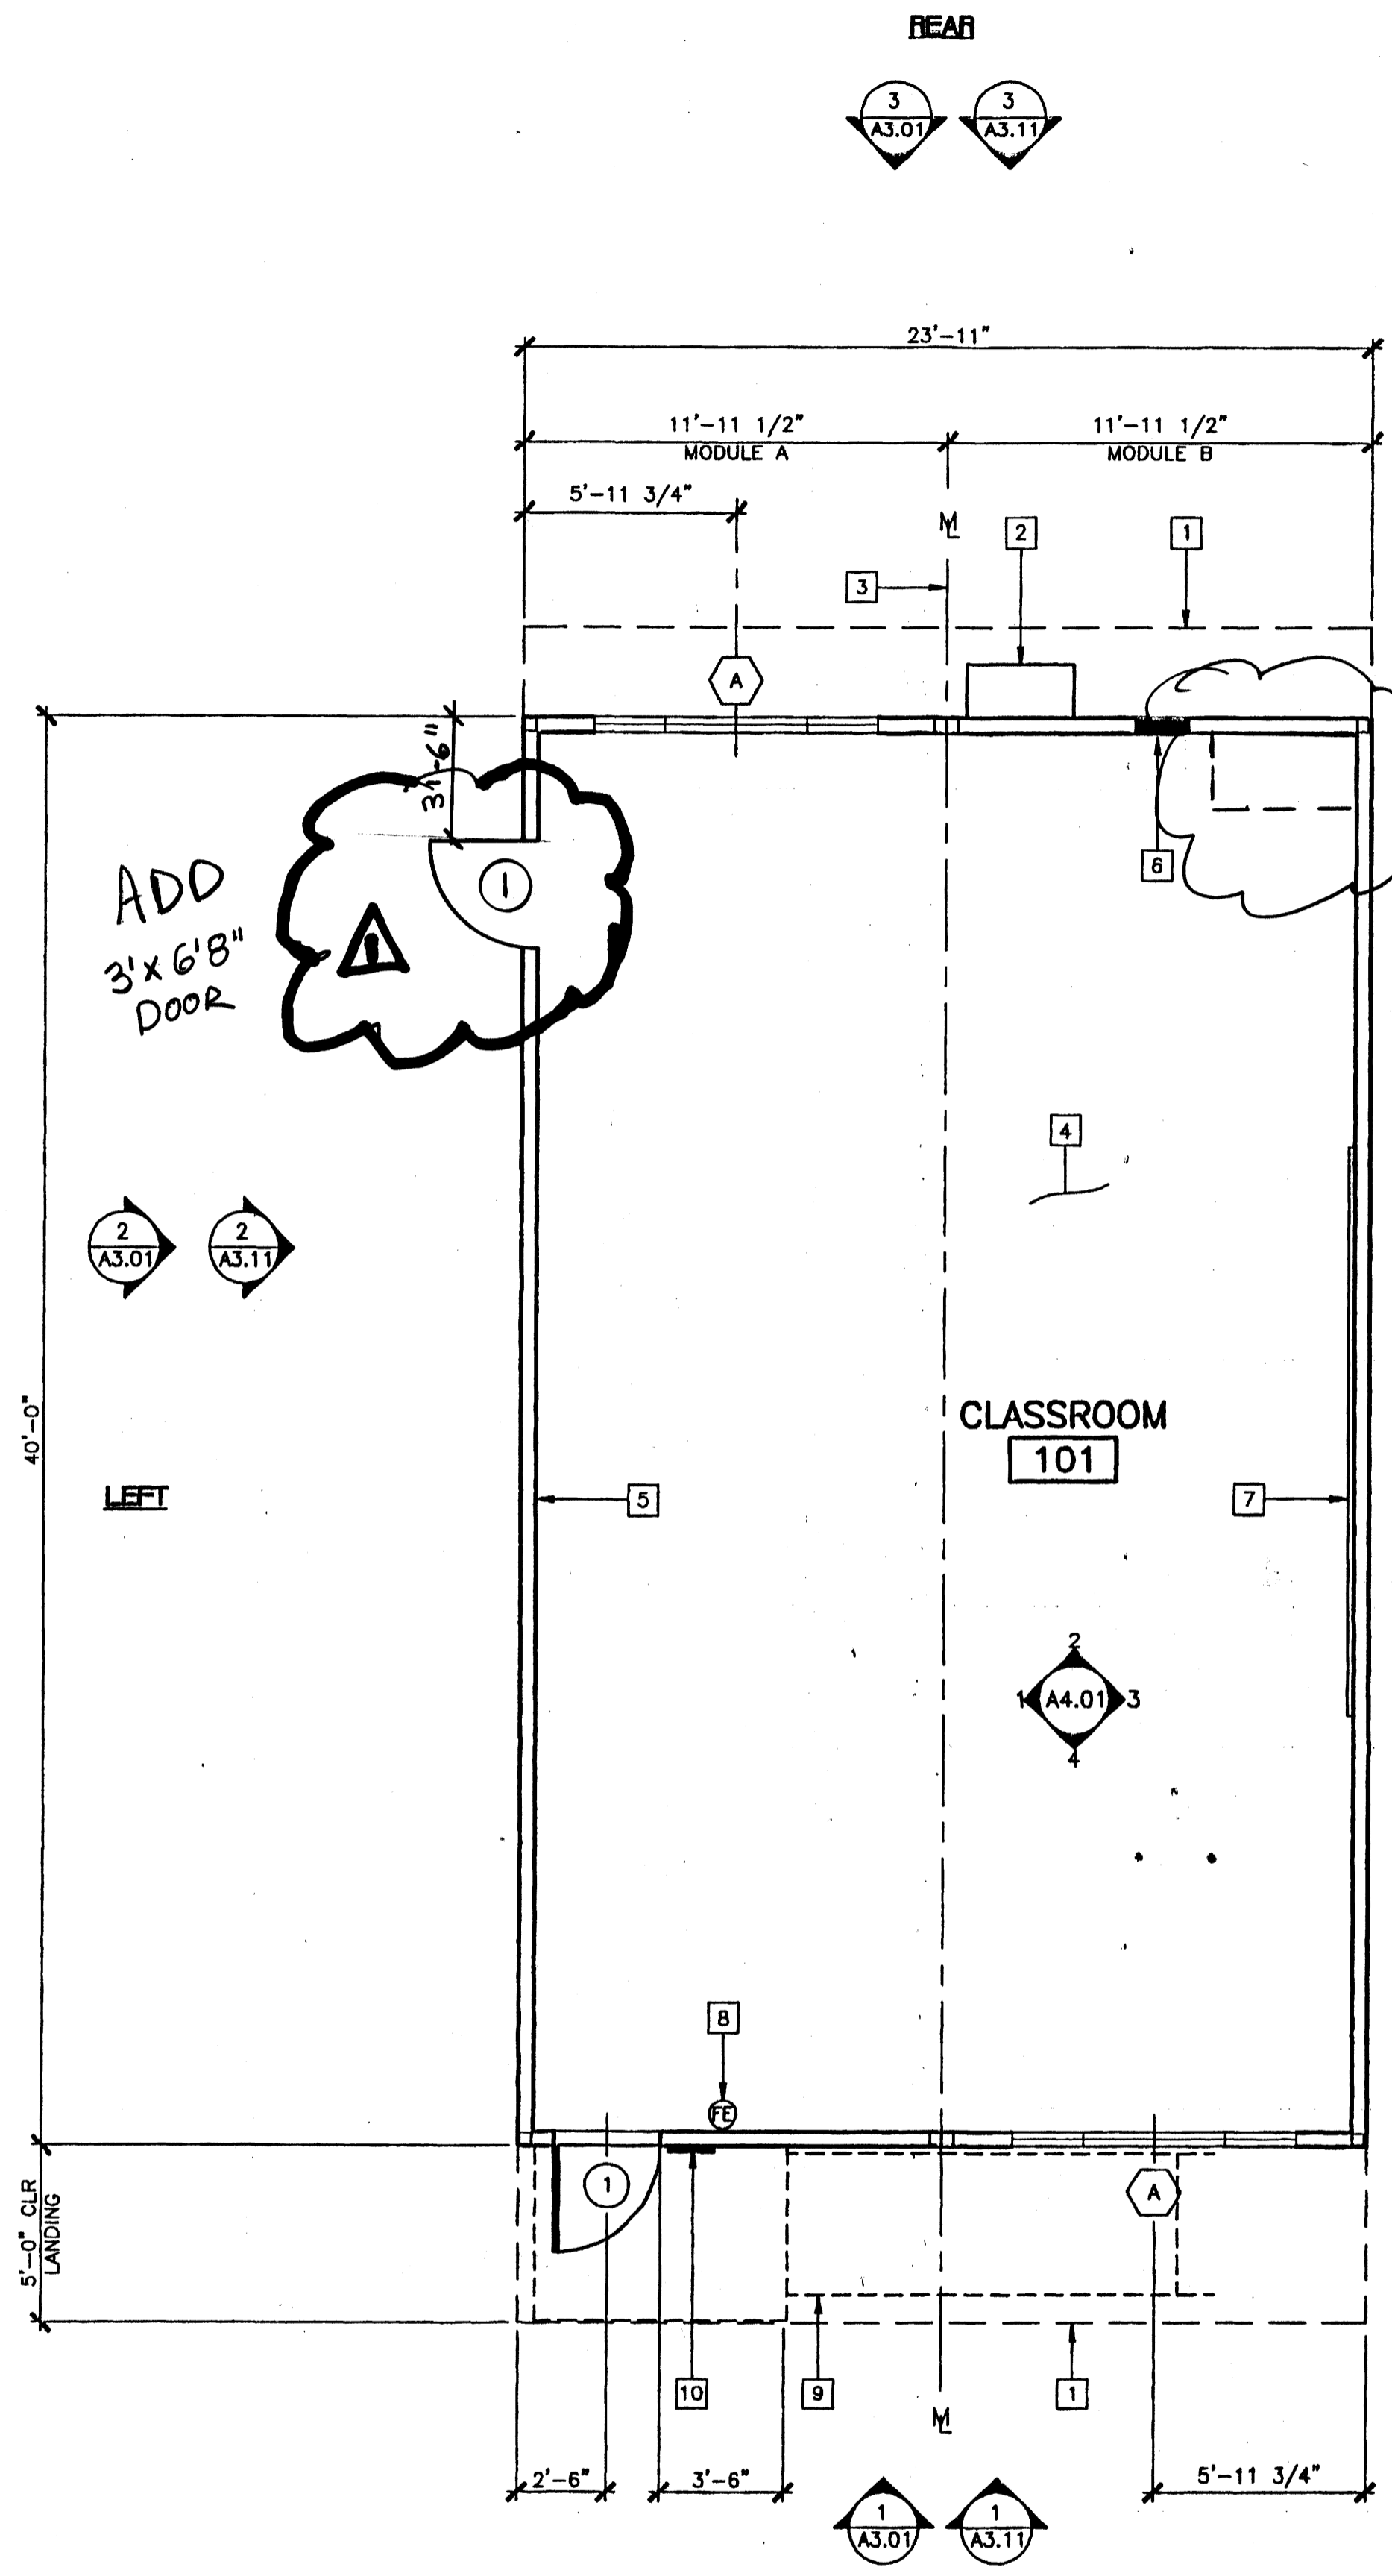

ADD CABINETS

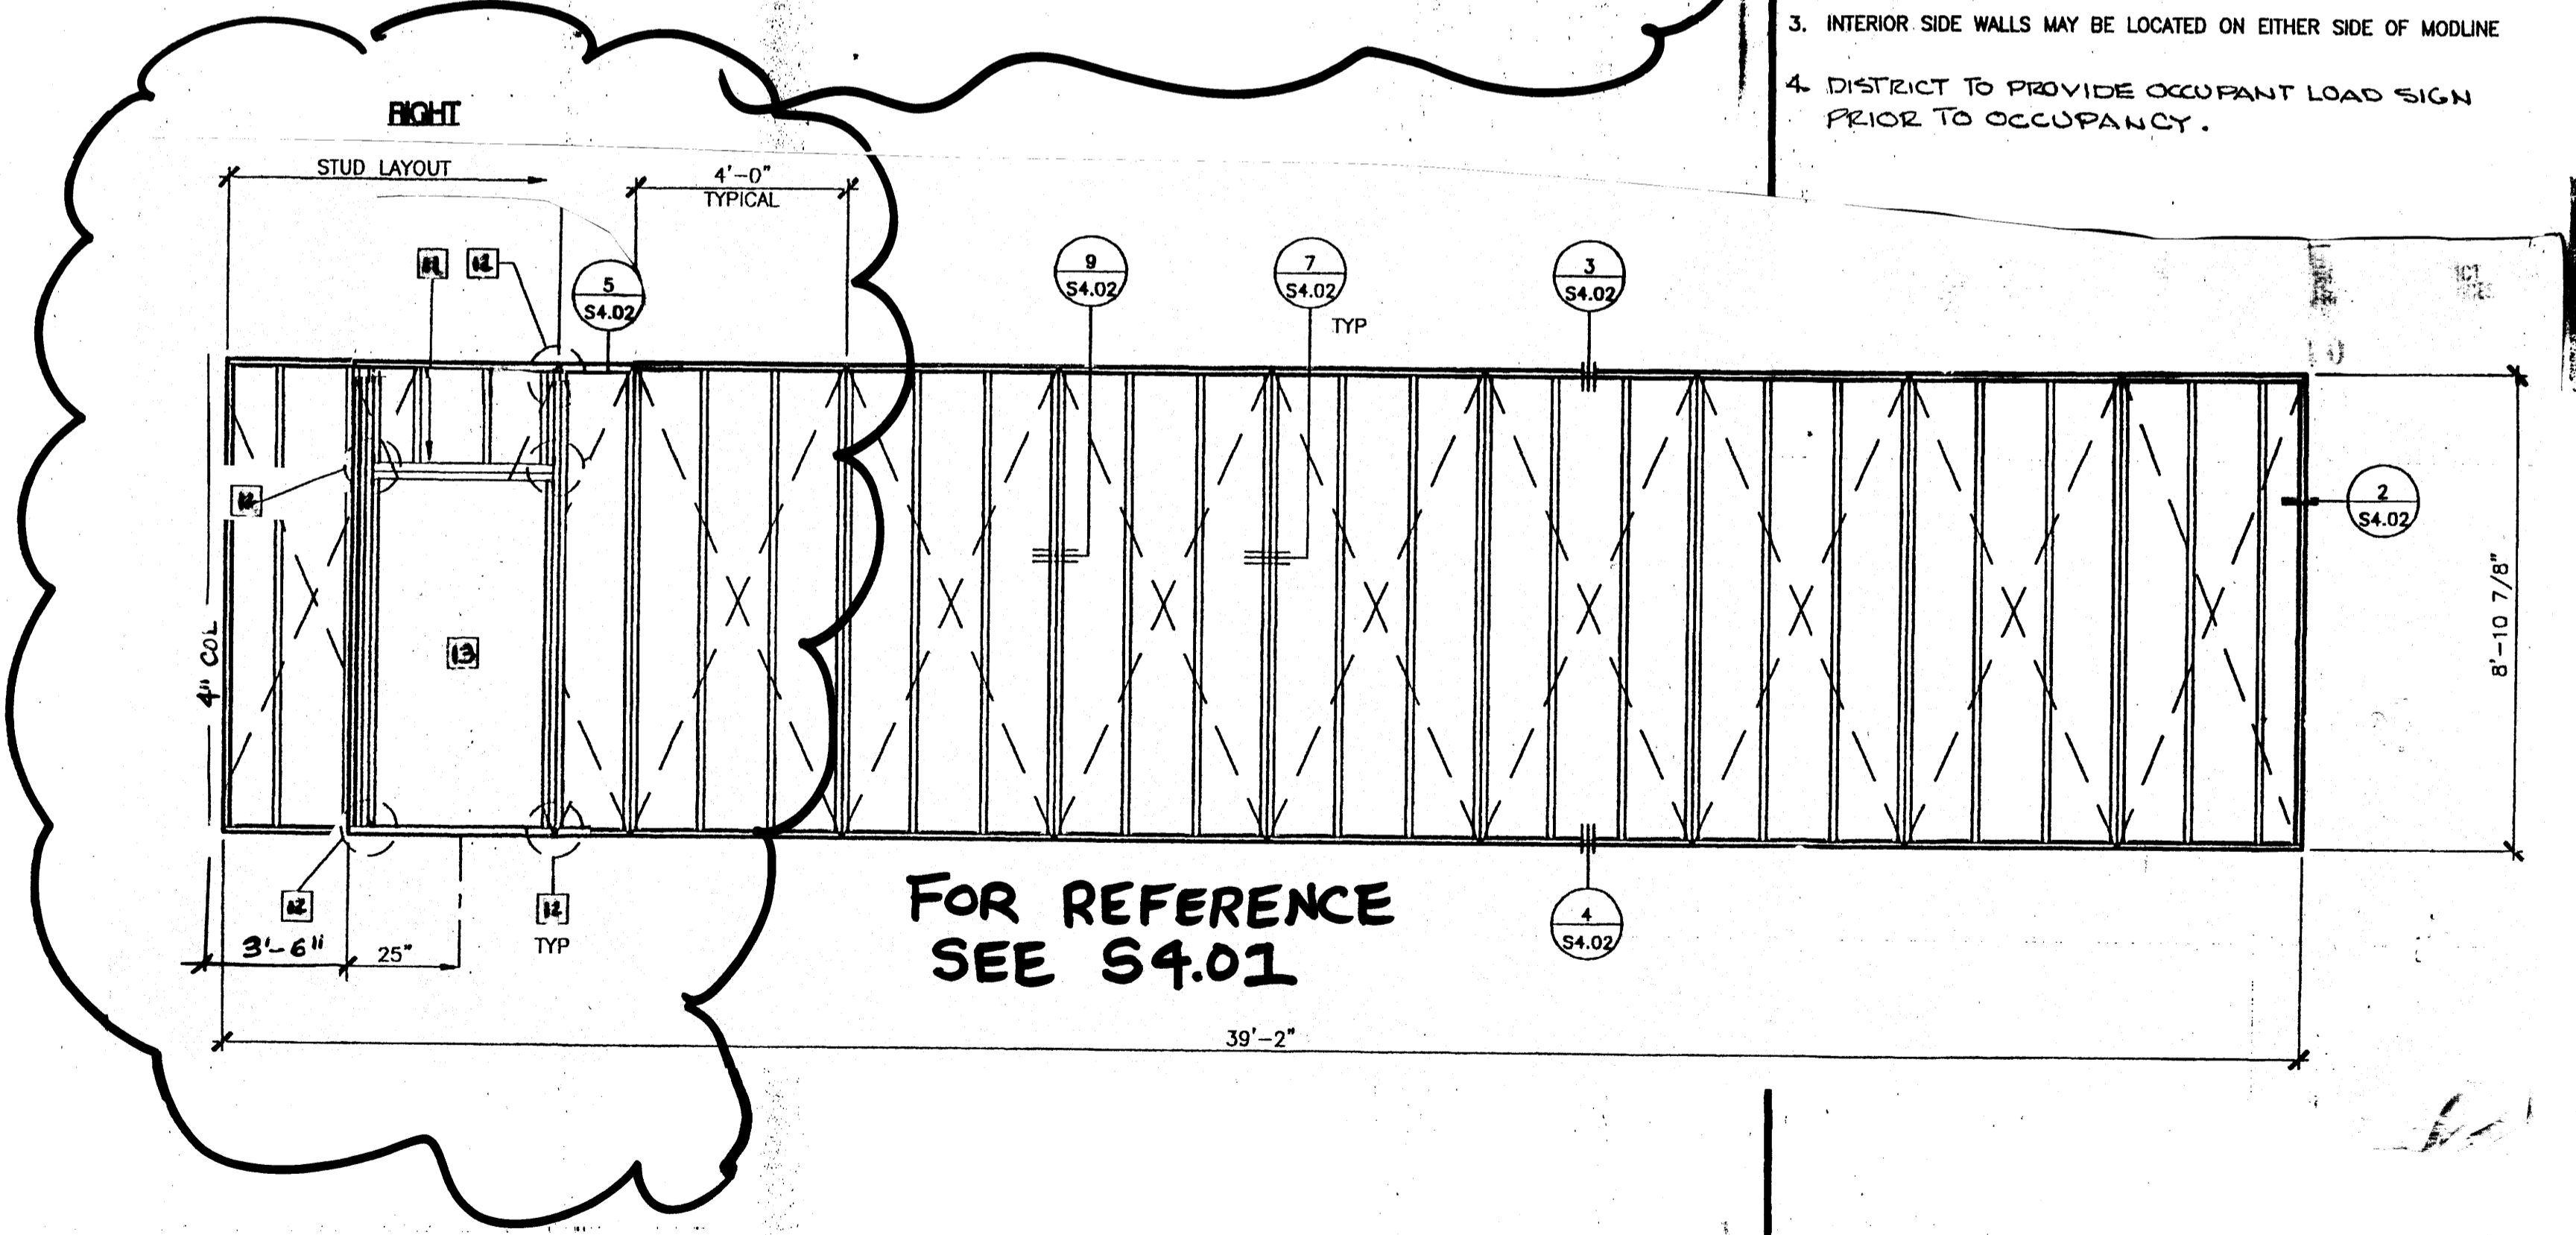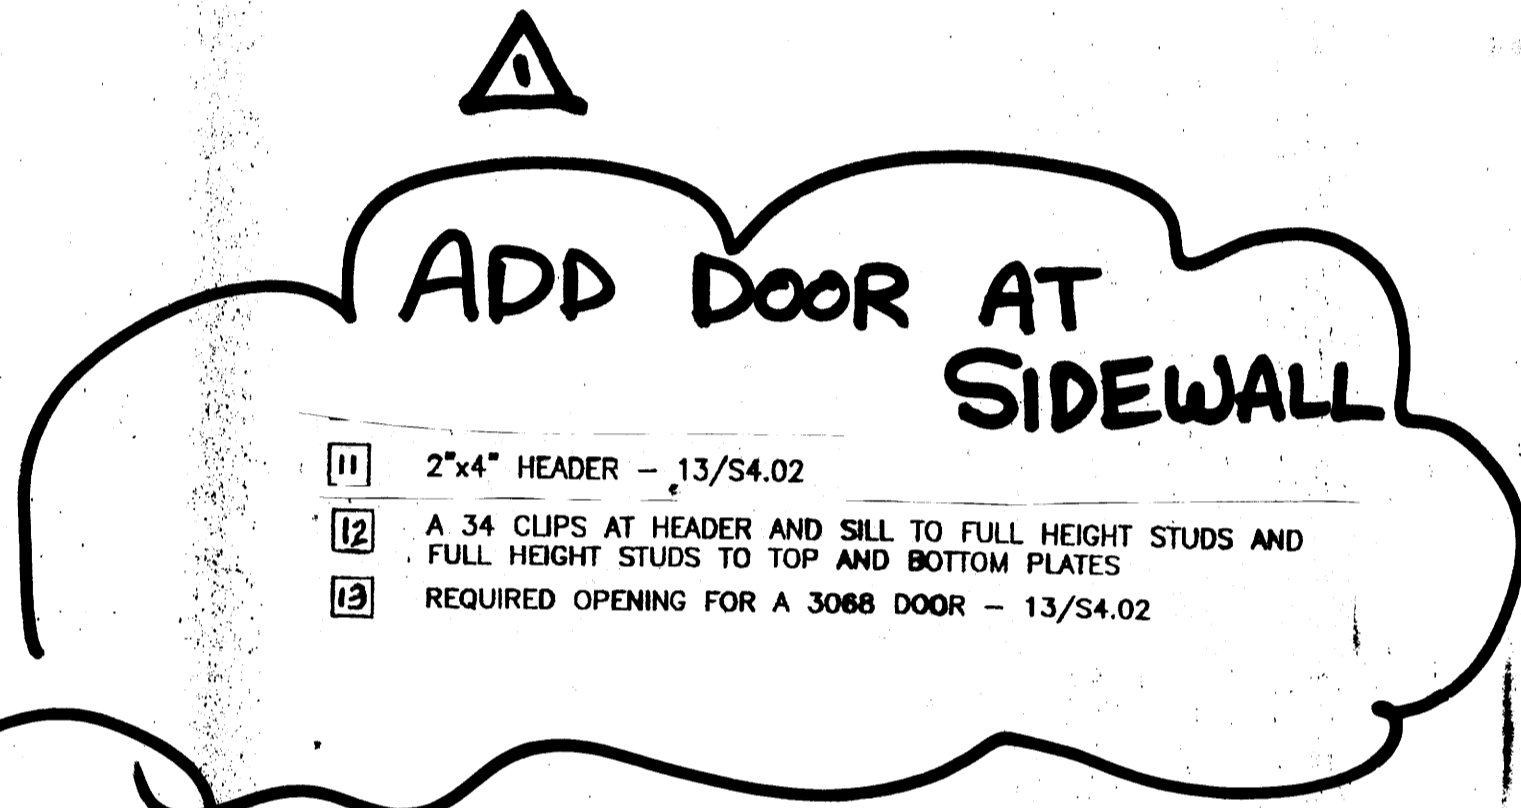

PC
CBC 1998

FLOOR PLAN

(24'x40')
SCALE: 1/4" = 1'-0"

MODIFIED

REVISIONS	Electrical Engineer's Seal	Mechanical Engineer's Seal	Structural Engineer's Seal	Architect's Seal
1				
2				
3				
4				

IDENTIFICATION STAMP
 DIV. OF THE STATE ARCHITECT
 OFFICE OF REGULATION SERVICES
 PC-04
 101268
 DATE: SEP 07 1999

MODTECH INC.
 2830 BARRETT AVENUE
 PERRIS, CALIF. 92572
 PH (909) 943-4014
 FAX (909) 940-0427

PROJECT NUMBER: 4373, 4378, 4438 4474 © MODTECH, INC. 2002
 4505, 4525
1- 24x40 CLASSROOM A#04-104812 STKP-67
#CL 2443 SERIAL # 59195-96 3/14/05
EDISON E.S.D. AT ORANGEWOOD ELEMENTARY

FLOOR PLAN
 24'x40'

DRAWN BY: KK
 DATE: 11/19/02
 CHECKED BY: STKP-67
 DATE: 4012-124
A1.01M



FILE PATH: 2440-A1.01.DWG PROJECT NO. 4373 PC-04-101268

KEY NOTES

- 1 DOWNSPOUT - SEE A3.03 FOR SPECIFIC LOCATIONS.
- 2 CONTINUOUS GUTTER 26GA.
- 3 26GA MIN-INTERLOCKING ROOF PANELS OVER AQUA BAR 15 (MH) ROOFING UNDERLAYMENT (RADCO LISTING #1109) OVER 3/4" CDX PLYWOOD - CLASS A ROOFING SYSTEM
- 4 AS AN ALTERNATE TO 3/4" CDX PLYWOOD USE 3/4" LOUISIANA PACIFIC OSB, SEE SPECIFICATIONS.
- 5 MODLINE (M)
- 6 RIDGELINE



NOTES

- 1. BUILDINGS HOUSING GROUP E OCCUPANCIES SHALL HAVE ROOF COVERINGS AS SPECIFIED IN CBC TABLE 15A - CLASS A OR B.

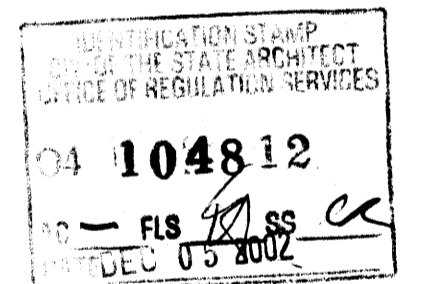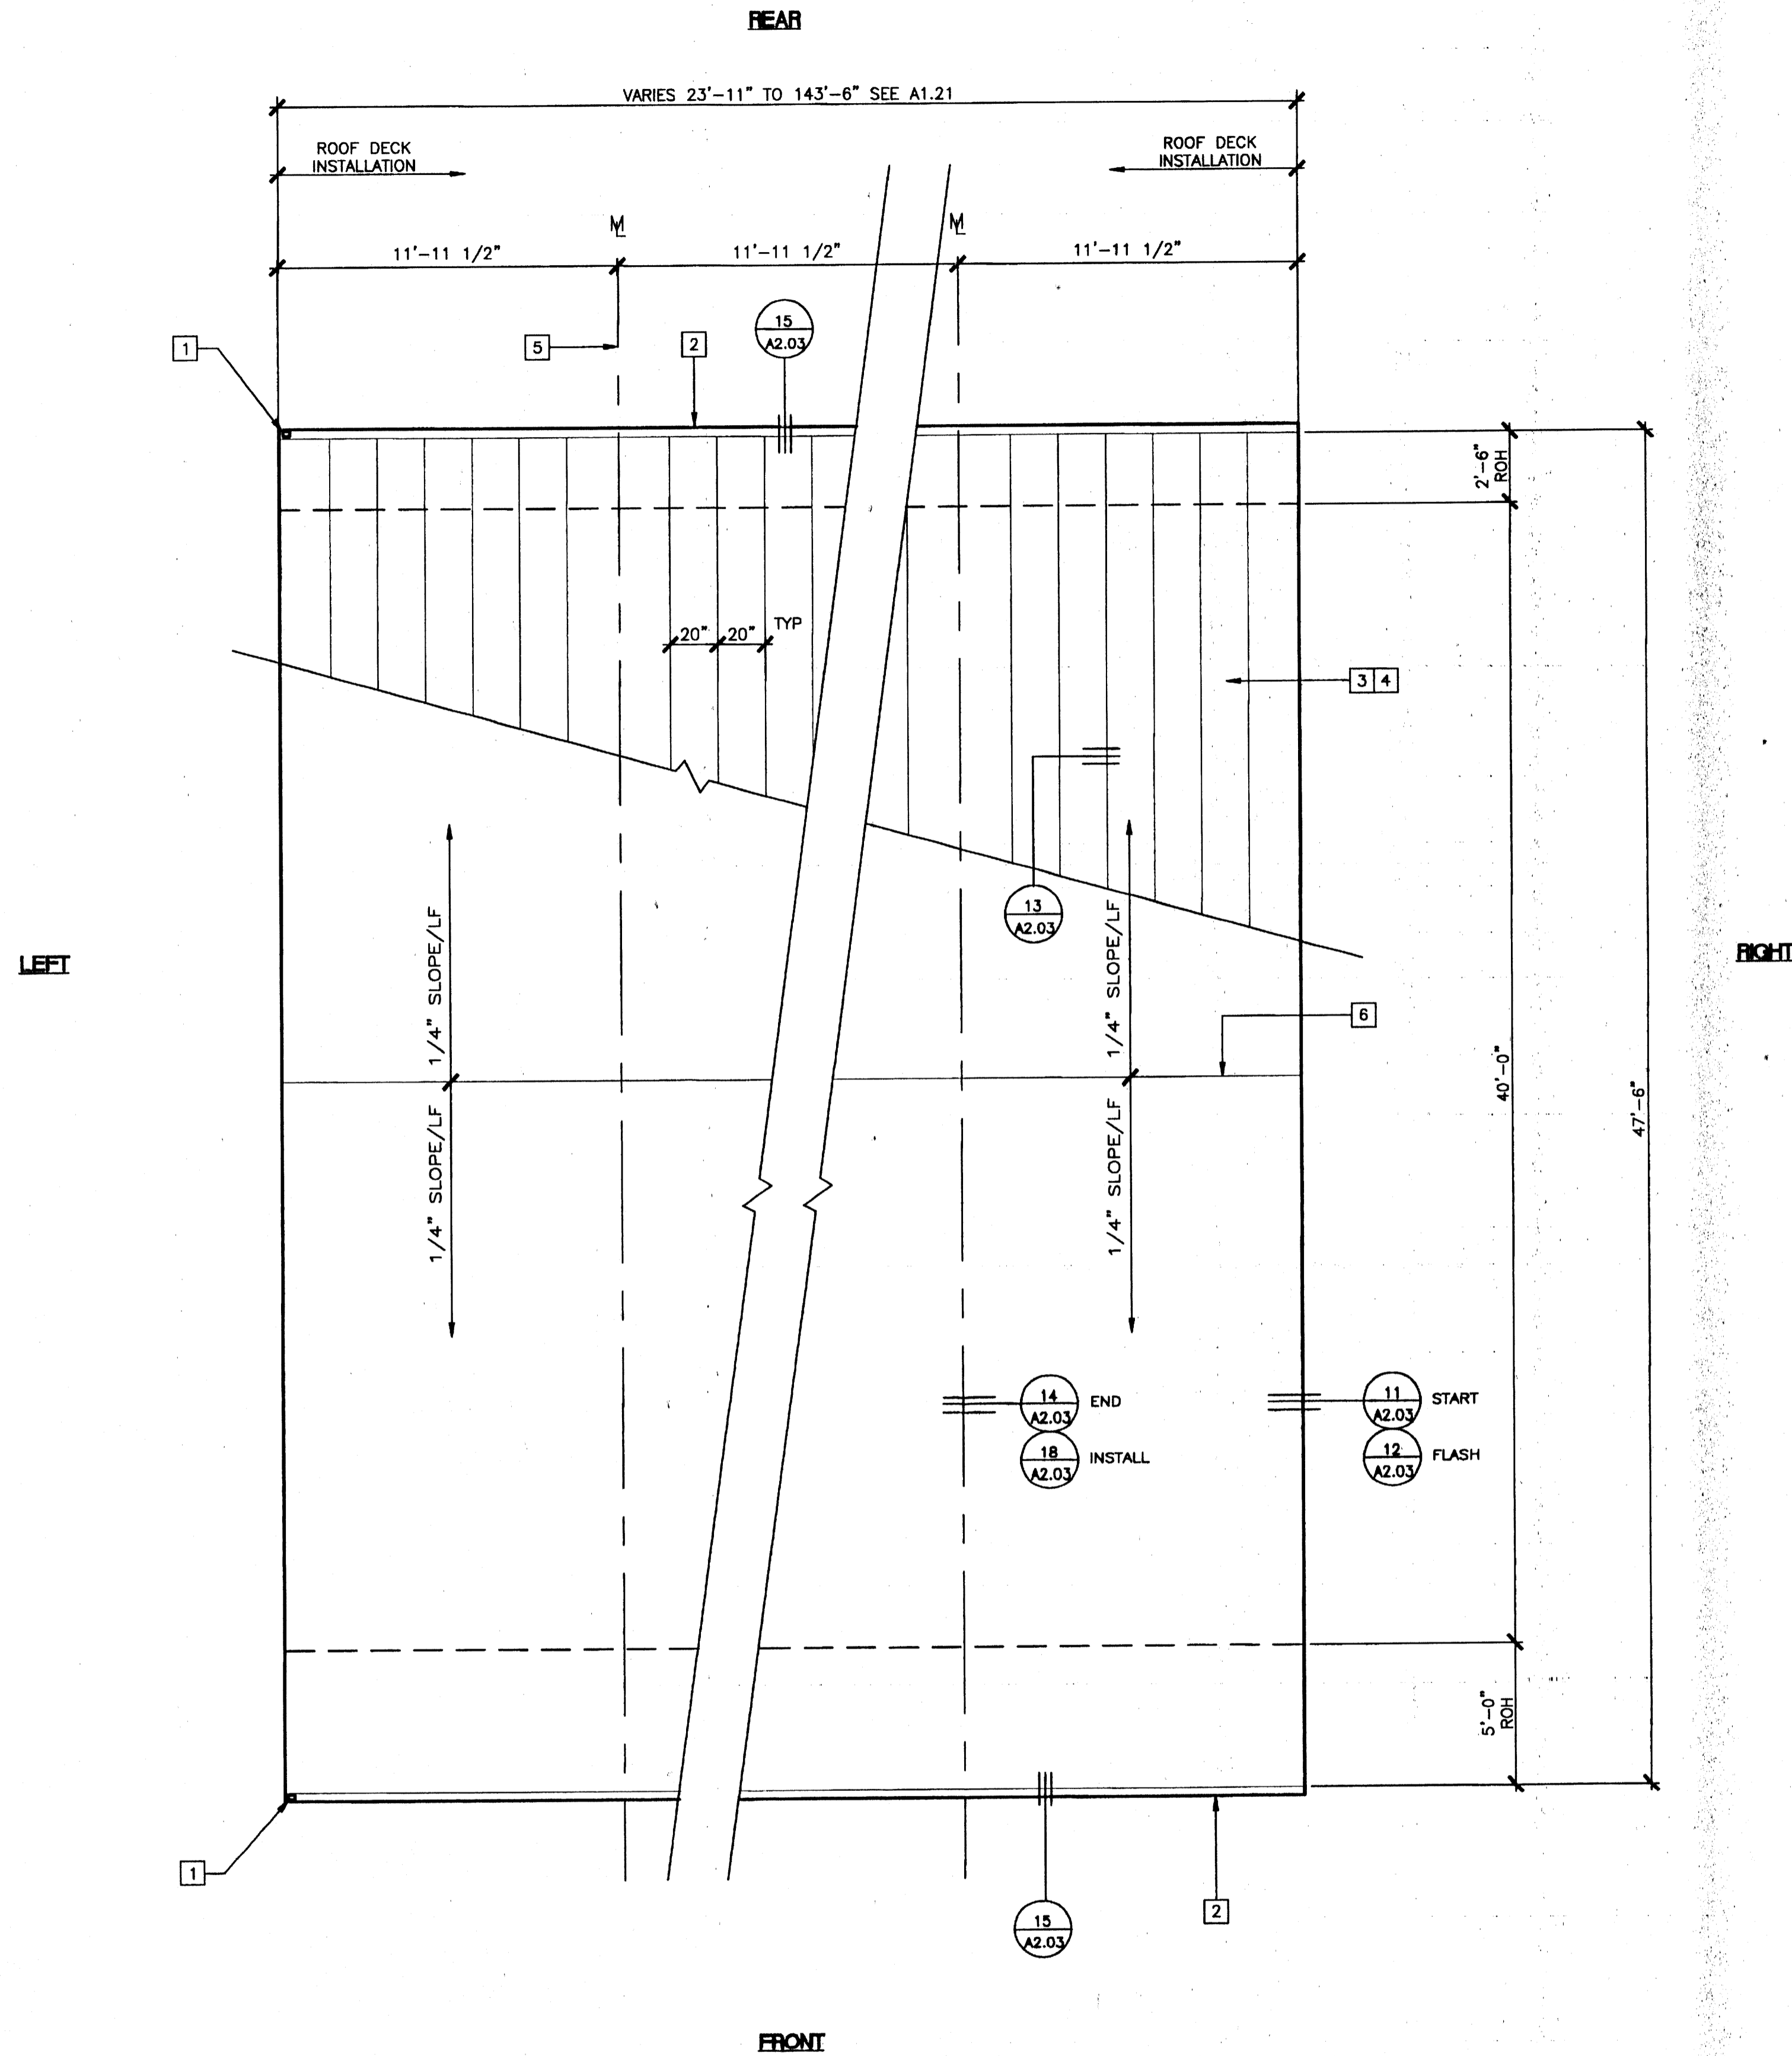

ROOF PLAN

26 GA DUAL PITCH - (23'-11" TO 143'-6")
SCALE: 1/4" = 1'-0"

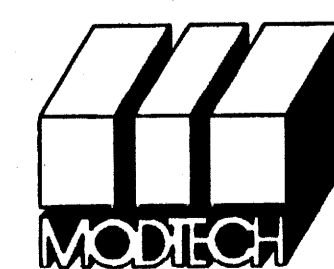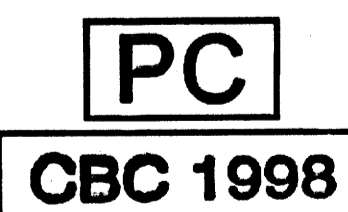

MODTECH INC.
2830 BARRETT AVENUE
PERRIS, CALIF. 92572
PH (909) 943-4014
FAX (909) 940-0427

PROJECT NUMBER: 4373
COLTON U.S.D.

© MODTECH, INC. 2002

DRAWN BY: KK
DATE: 11/19/02
CHECKED BY: STKP-67
DATE: 4/12-124

REVISIONS	

Electrical Engineer's Seal

Mechanical Engineer's Seal

Structural Engineer's Seal

Architect's Seal
L. C. Edwards
STATE OF CALIFORNIA

IDENTIFICATION STAMP
DIV. OF THE STATE ARCHITECT
OFFICE OF REGULATION SERVICES
PC-04
101268
AC [Signature]
DATE SEP 11 1999

ROOF PLAN


26 GA DUAL PITCH

A2.01

FILE PATH: 2440-A2.01.DWG

PROJECT NO. 4373

PC-04-101268

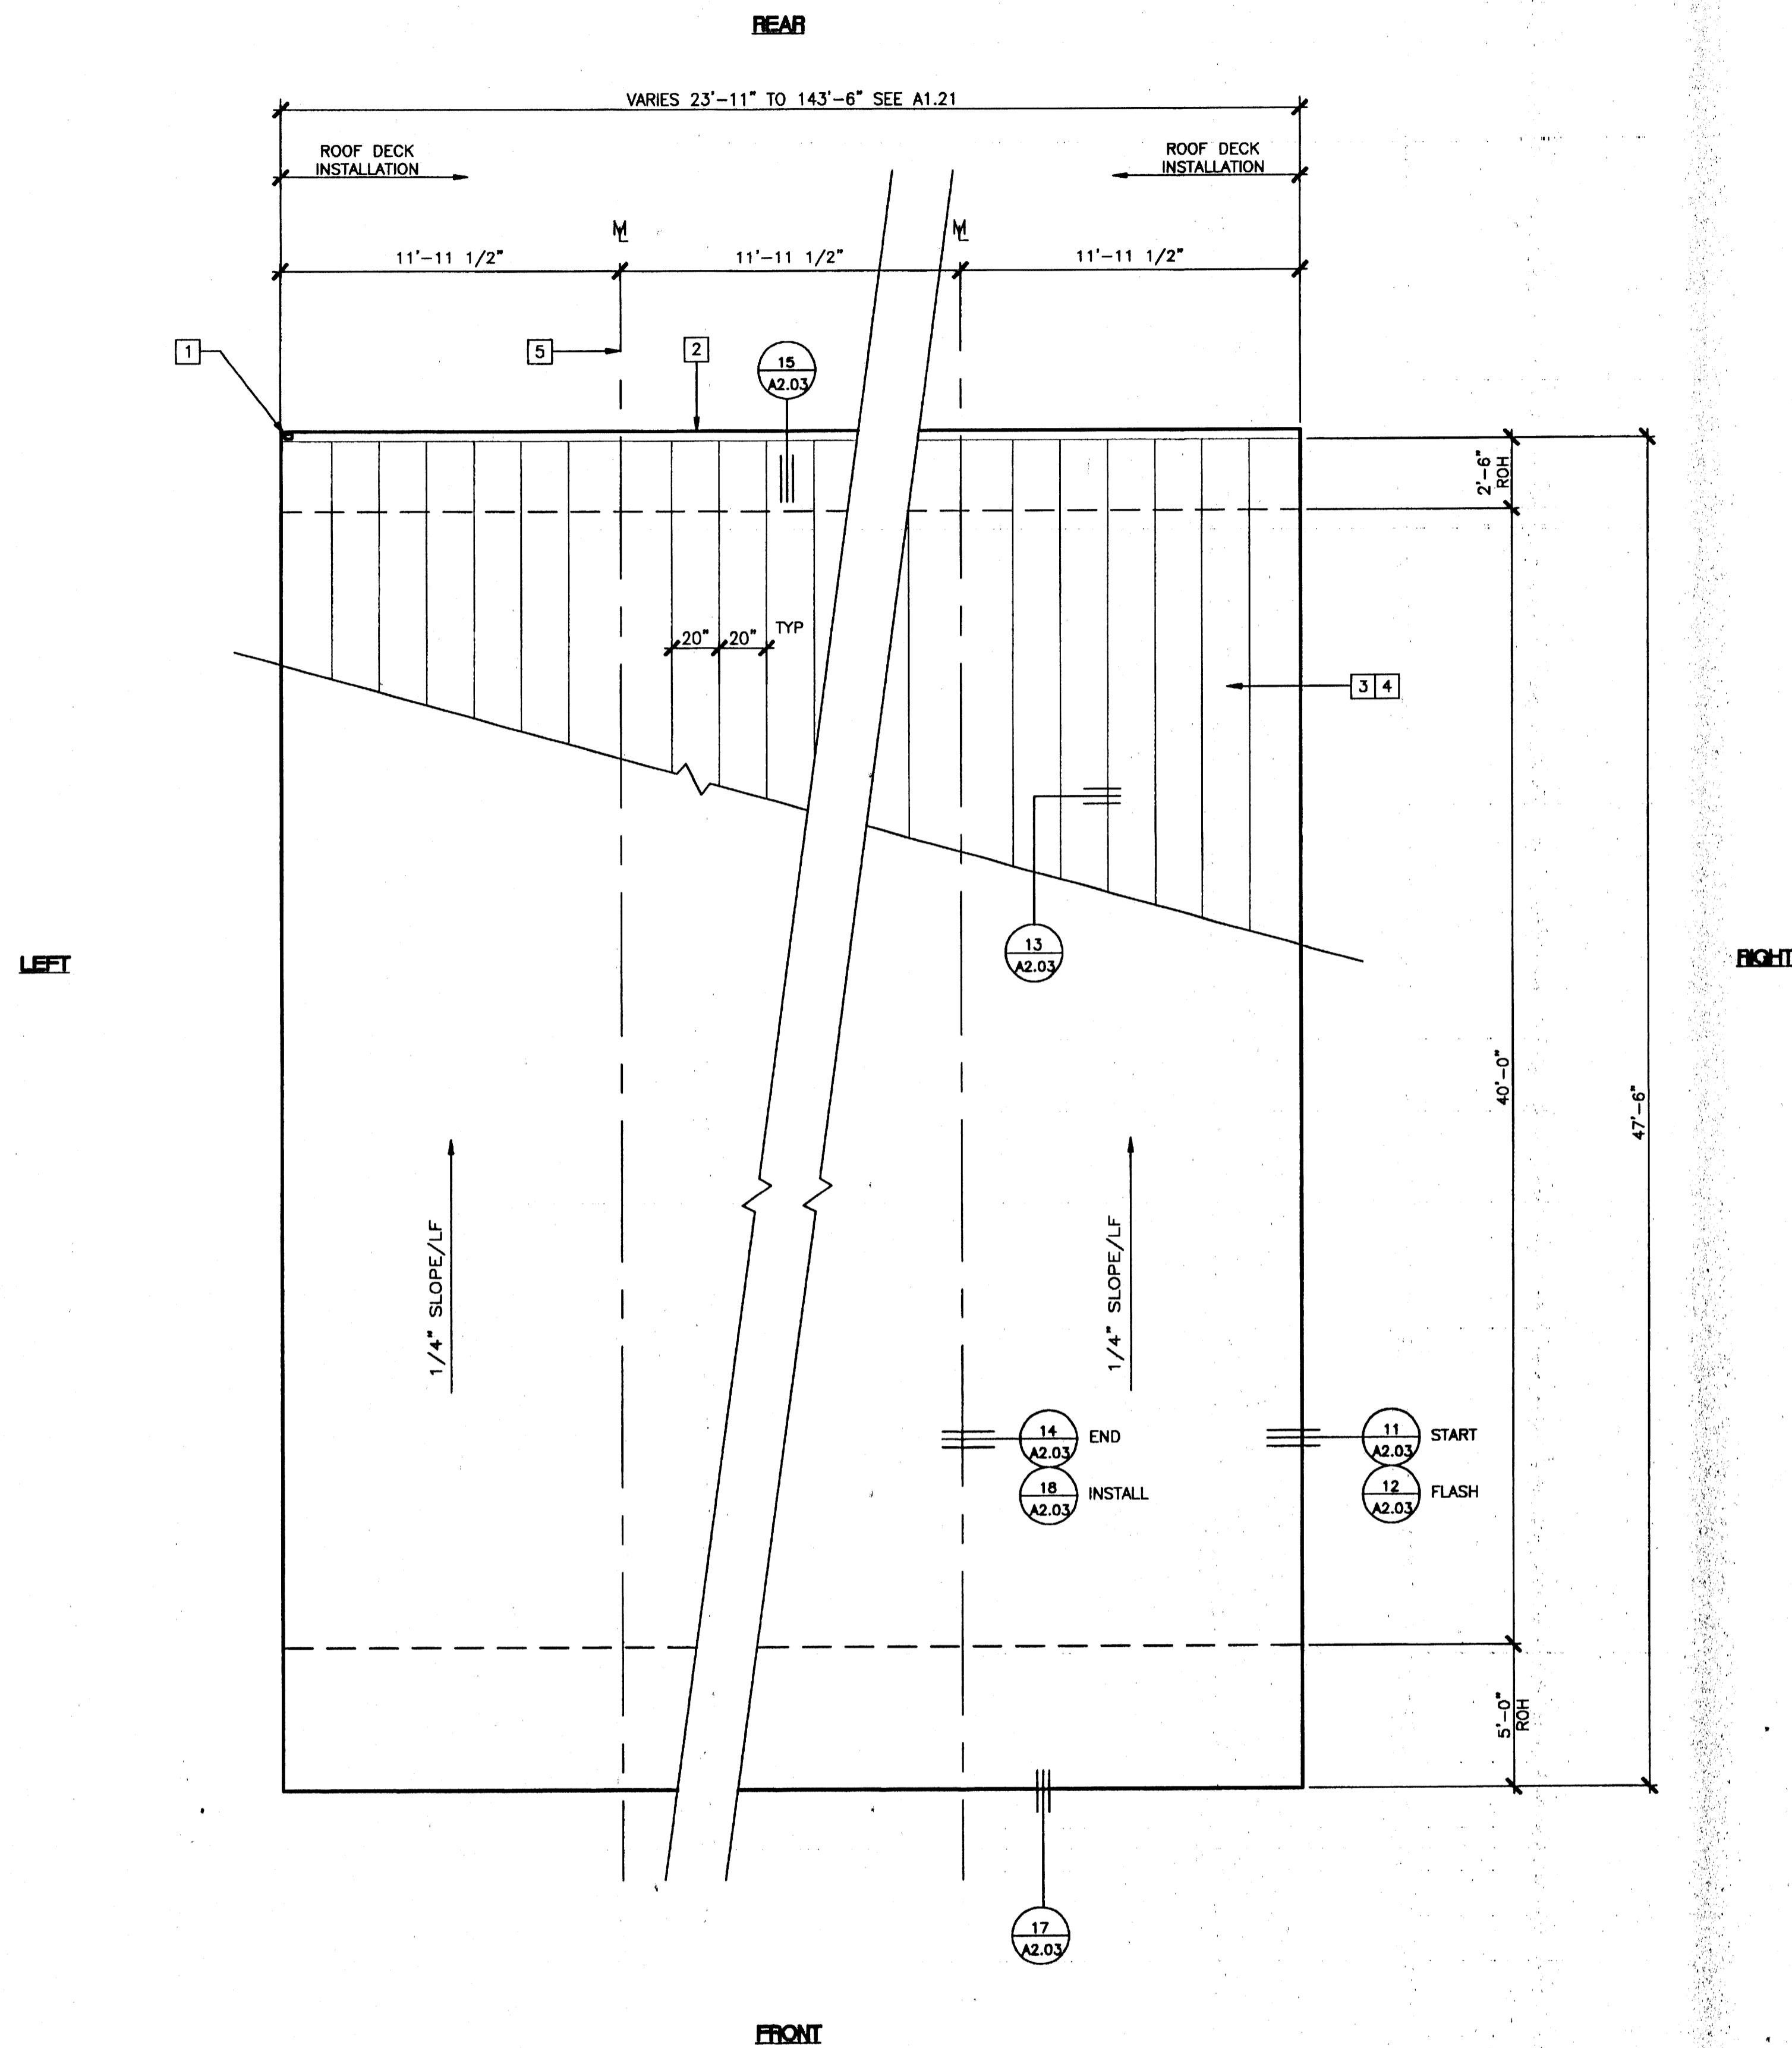

ROOF PLAN

26 GA MONO PITCH - (23'-11" TO 143'-6")
SCALE: 1/4" = 1'-0"

PC
CBC 1998

KEY NOTES

- 1 DOWNSPOUT - SEE A1.21 FOR SPECIFIC LOCATIONS.
- 2 CONTINUOUS GUTTER 26GA.
- 3 26GA. MIN.-INTERLOCKING ROOF PANELS OVER AQUA BAR 15 (MHI) ROOFING UNDERLAYMENT (RADCO LISTING #1109) OVER 3/4" CDX PLYWOOD - CLASS A ROOFING SYSTEM
- 4 AS AN ALTERNATE TO 3/4" CDX PLYWOOD USE 3/4" LOUISIANA PACIFIC OSB, SEE SPECIFICATIONS.
- 5 MODLINE (M)

NOTES

1. BUILDINGS HOUSING GROUP E OCCUPANCIES SHALL HAVE ROOF COVERINGS AS SPECIFIED IN CBC TABLE 15A - CLASS A OR B.

REGISTRATION STAMP
DIV. OF THE STATE ARCHITECT
OFFICE OF REGULATION SERVICES
04 104812
PC - FLS
DATE DEC 04 2002

REVISIONS	
1	
2	
3	
4	
5	


Electrical Engineer's Seal

Mechanical Engineer's Seal

Structural Engineer's Seal

Architects Seal

IDENTIFICATION STAMP
 DIV. OF THE STATE ARCHITECT
 OFFICE OF REGULATION SERVICES
 PC-04
 101268
 DATE SEP 07 2000

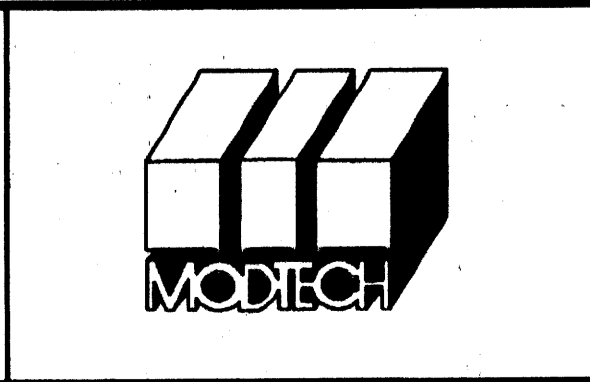

MODTECH INC.
 2830 BARRETT AVENUE
 PERRIS, CALIF. 92572
 PH (909) 943-4014
 FAX (909) 940-0427

PROJECT NUMBER: 4373
 COLTON U.S.D.

© MODTECH, INC. 2002


DRAWN BY: KK
 DATE: 11/19/02
 CHECKED BY: STKP-67
 DATE: 10/2-124
 MODTECH Index No.

A2.02


ROOF PLAN

26 GA MONO PITCH


FILE PATH: 2440-A2.02.DWG PROJECT NO. 4373 PC-04-101268

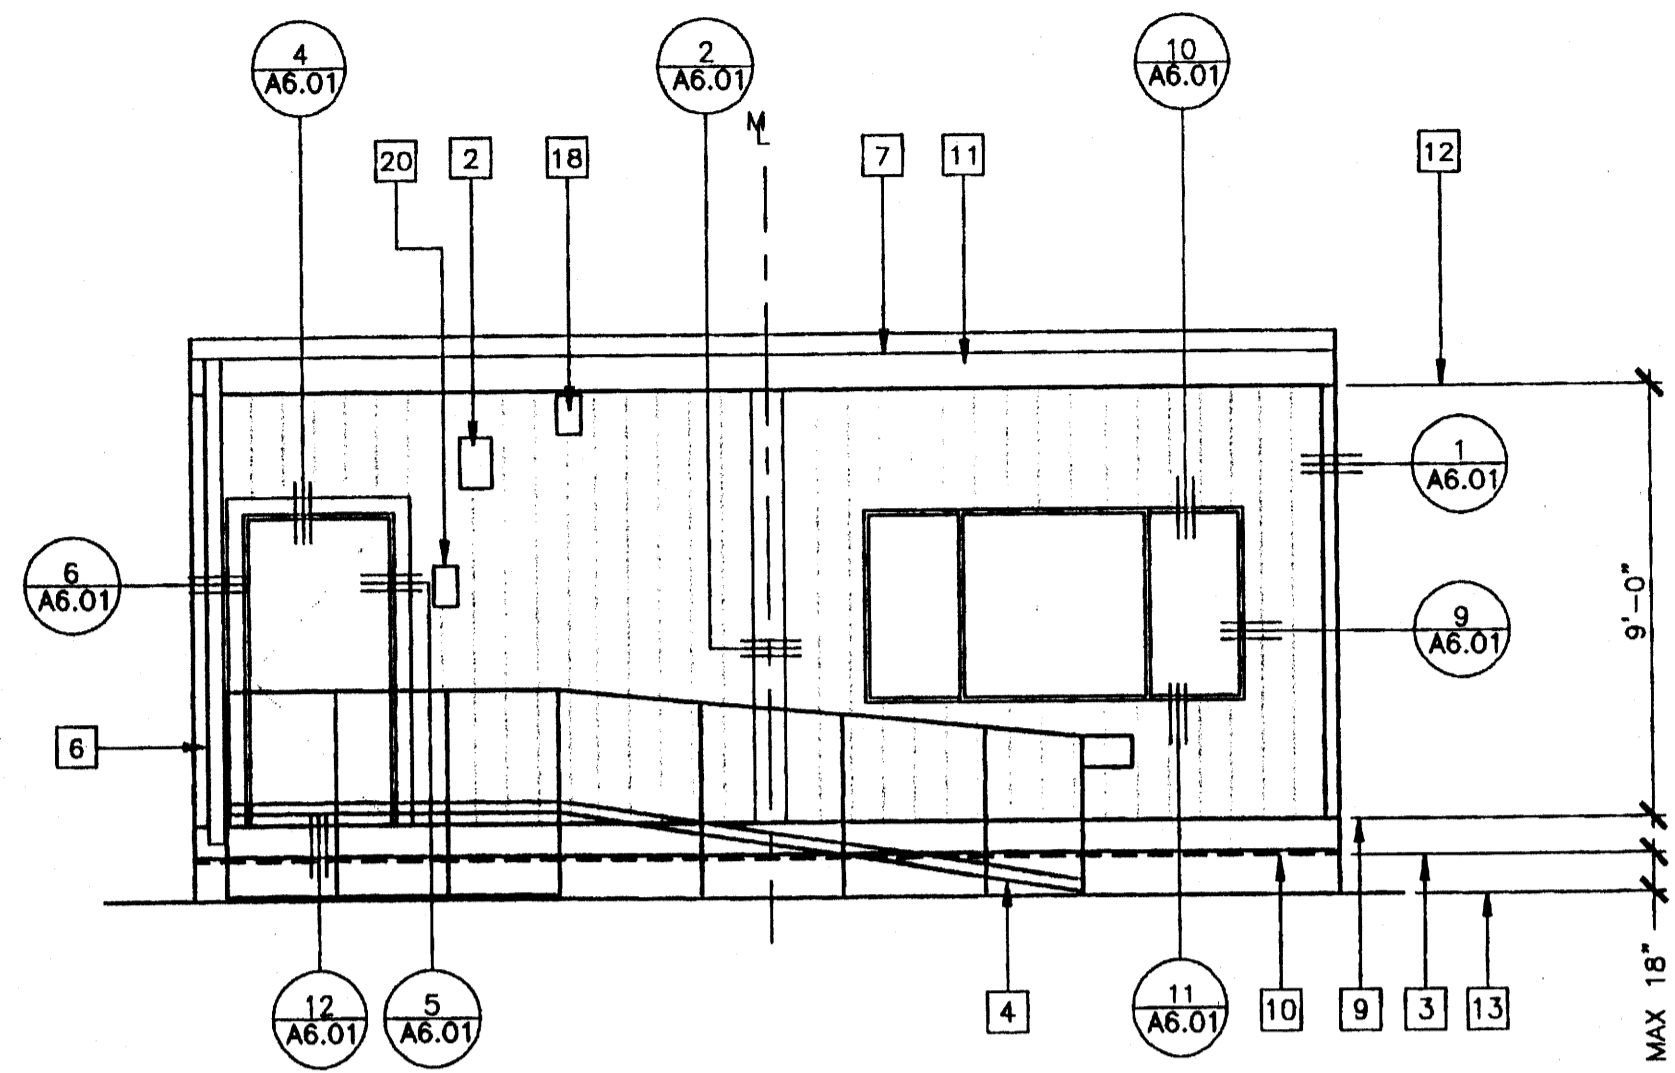


1 FRONT ELEVATION

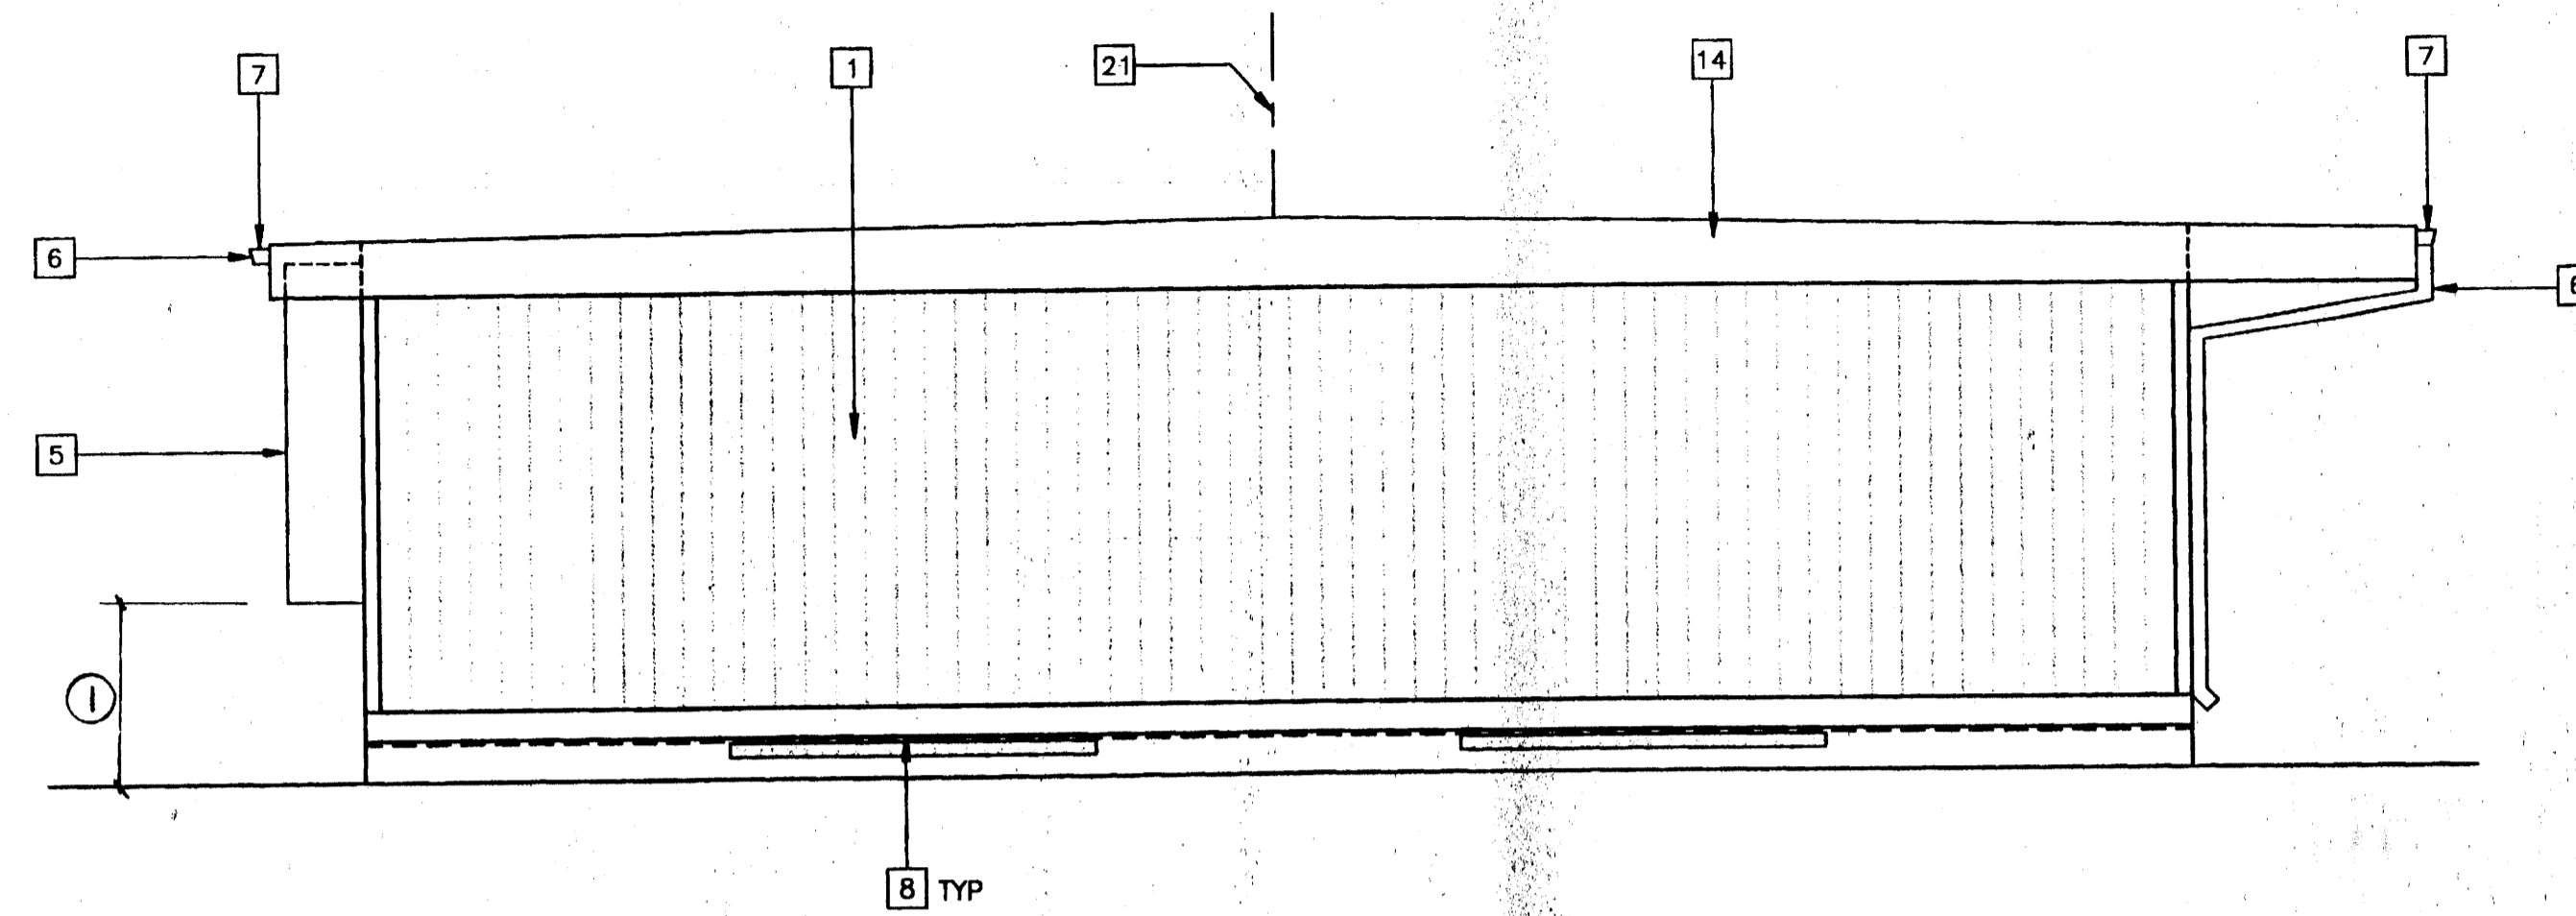

2 LEFT SIDE ELEVATION

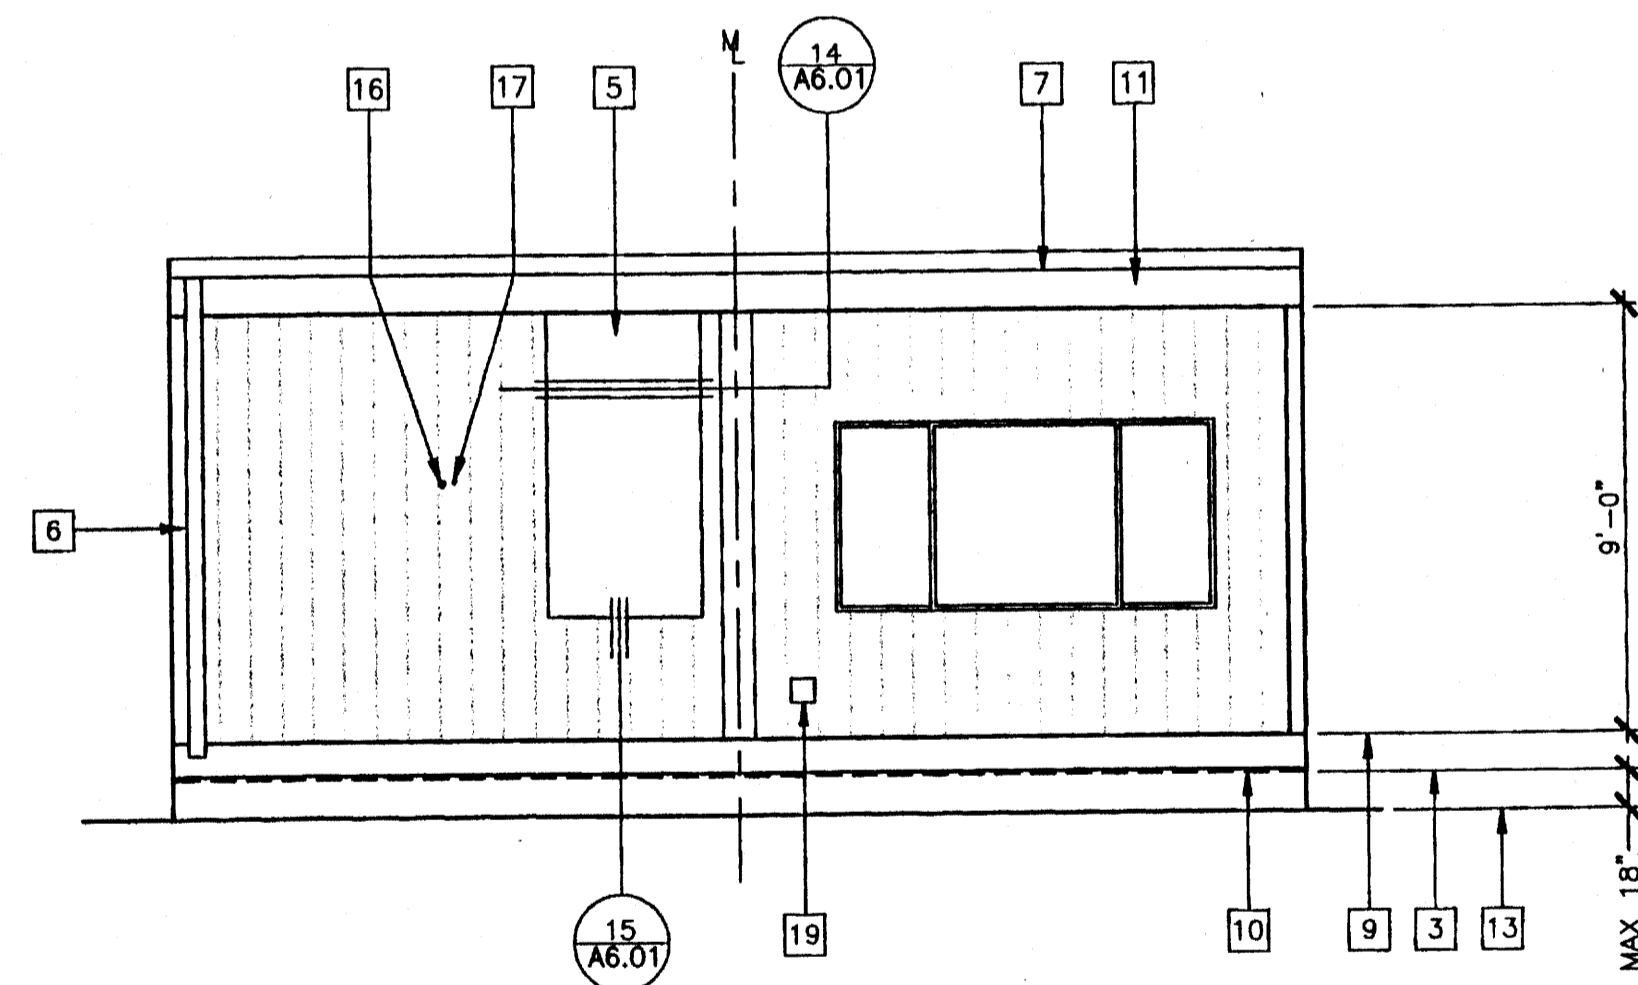

3 REAR ELEVATION

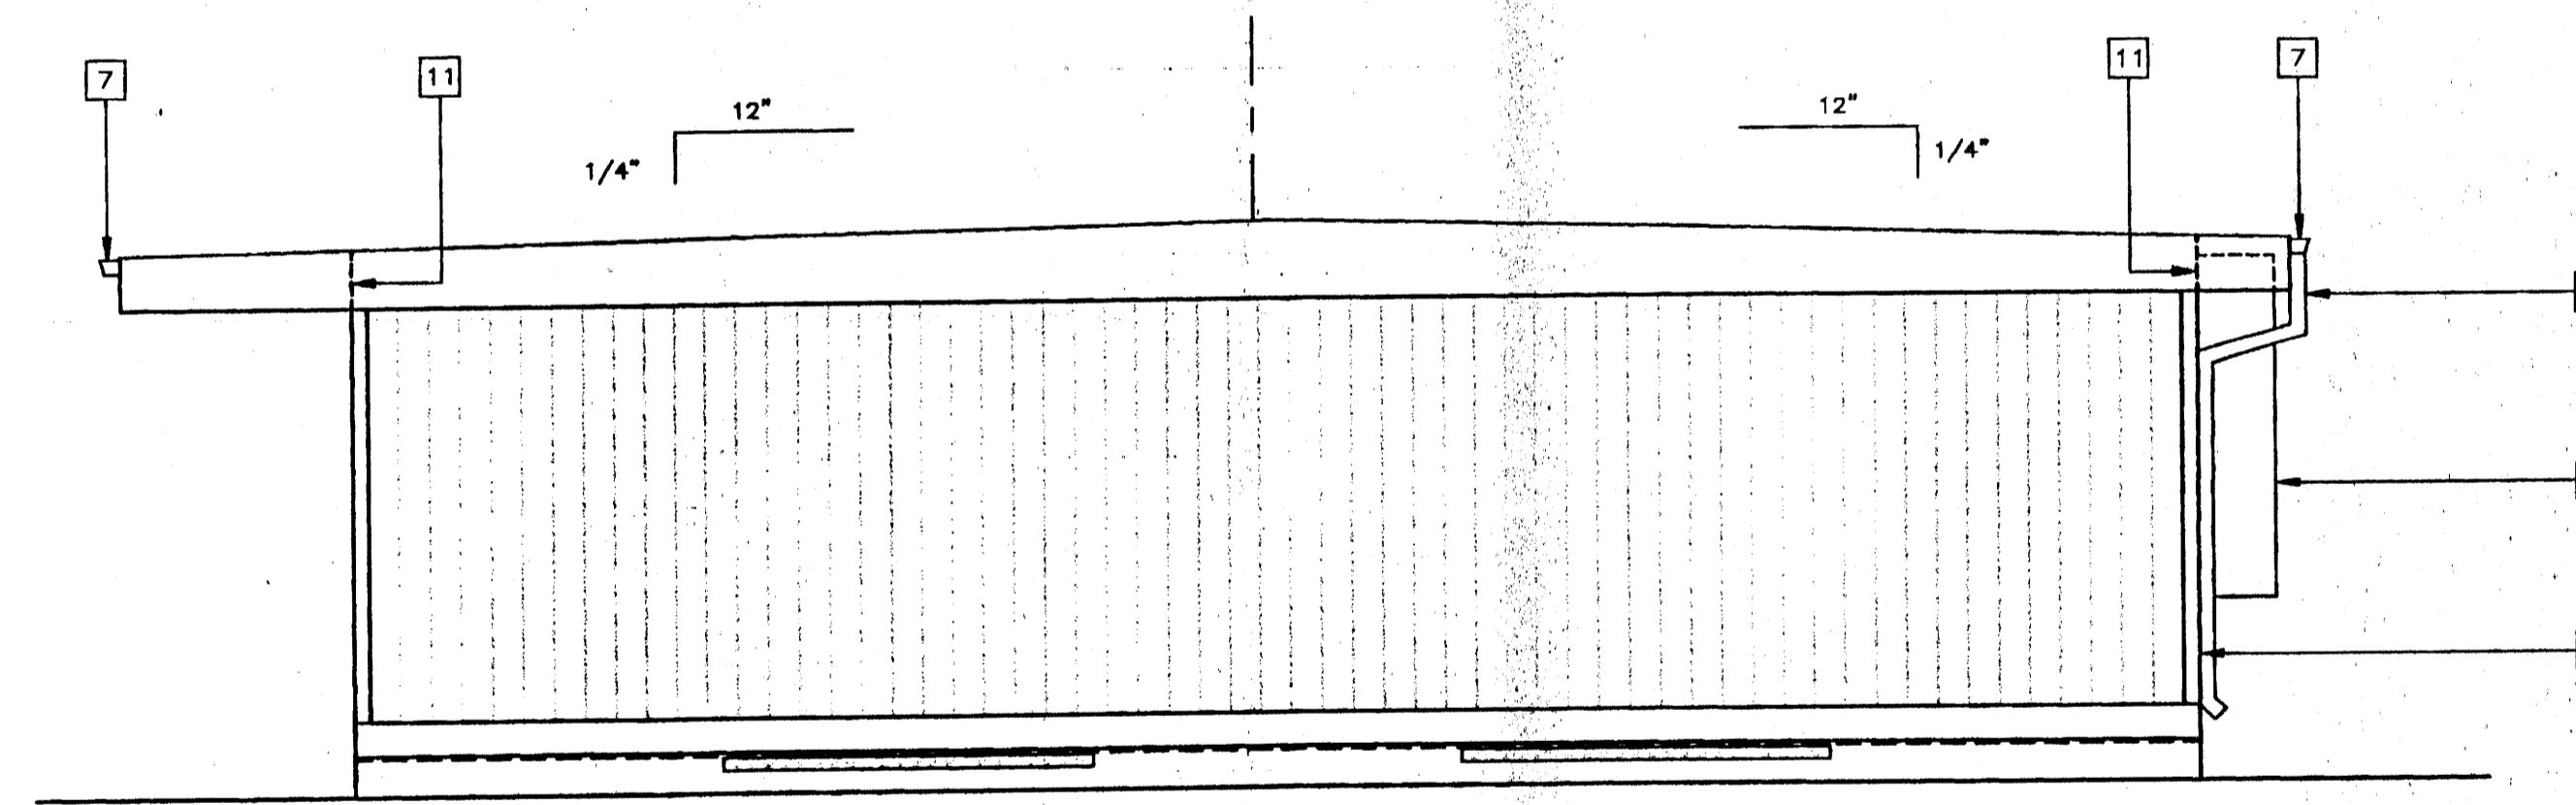

4 RIGHT SIDE ELEVATION

KEY NOTES

- 1 TYPICAL EXTERIOR FINISH SEE EXTERIOR FINISH SCHEDULE BELOW.
- 2 EXTERIOR LIGHT FIXTURE (EL)
- 3 TOP OF SKIRTING
- 4 RAMP AND LANDING - R1.01
- 5 HVAC UNIT (HV)
- 6 DOWNSPOUT FASTEN TO BUILDING TYPICAL (3) PLACES - 16/A2.03
- 7 CONTINUOUS GUTTER WITH DOWNSPOUT (LOCATION OF DOWNSPOUT SHOWN ON ROOF PLAN)
- 8 FOUNDATION VENT (SEE FOUNDATION PLAN)
- 9 FINISH FLOOR LINE
- 10 FLOOR BEAM (STR)
- 11 ROOF HEADER (STR)
- 12 TOP OF COLUMN
- 13 FINISH GRADE
- 14 ROOF BEAM (STR)
- 15 COLUMN (STR)
- 16 ELECTRICAL STUB-OUT (EL)
- 17 GROUND STUB-OUT (EL)
- 18 J-BOX FOR EXTERIOR FIRE ALARM HORN (EL)
- 19 GUTTER BOX (EL)
- 20 SIGNAGE PROVIDED AND INSTALLED BY DISTRICT PRIOR TO OCCUPANCY. 5/A5.01
- 21 RIDGE

NOTES

- 1 IF HVAC UNIT IS LOCATED IN ANY PATH OF TRAVEL OR CIRCULATION AREA AND HEIGHT FROM GRADE TO BOTTOM OF UNIT EXCEEDS 27" PROTECTION MUST BE PROVIDED

EXTERIOR FINISH SCHEDULE


NOTE: SEE SPECIFICATIONS FOR DETAILED DESCRIPTION OF FINISH OPTIONS.

STANDARD - 5/8" PLYWOOD SIDING

OPTIONAL - 5/16" GROOVED FIBER CEMENT BOARD

OPTIONAL - 5/16" FIBER CEMENT BOARD WITH TEXTURED ELASTOMERIC COATING SYSTEM

OPTIONAL - EXTERIOR PLASTER OVER LATH

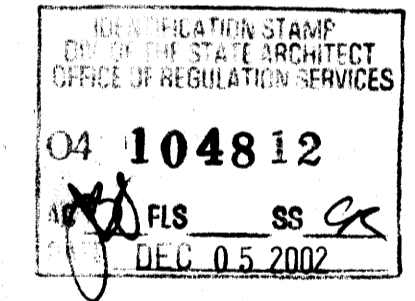

PC
CBC 1998

EXTERIOR ELEVATIONS

26 GA DUAL PITCH (24'x40')
SCALE: 1/4" = 1'-0"

REVISIONS	Electrical Engineer's Seal	Mechanical Engineer's Seal	Structural Engineer's Seal	Architect's Seal
1				
2				
3				
4				
5				

Electrical Engineer's Seal

Mechanical Engineer's Seal

Structural Engineer's Seal

Architect's Seal

IDENTIFICATION STAMP
DIV. OF THE STATE ARCHITECT
OFFICE OF REGULATION SERVICES
PC-04
101268
AC: J.F.L.S. SS: G.K.
DATE: SEP 07 1999

MODTECH INC.

2830 BARRETT AVENUE
PERRIS, CALIF. 92572
PH (909) 943-4014
FAX (909) 940-0427

PROJECT NUMBER: 4373 4505, 4525

COLTON U.S.D.

© MODTECH 2002

EXTERIOR ELEVATIONS 26 GA DUAL PITCH 24'x40'

DRAWN BY: KK
DATE: 11/19/02
CHECKED BY: STKP-67
DATE: 4012-124

MODTECH Index No. **A3.01**


FILE PATH: 2440-A3.01.DWG

4373


PC-04-101268

KEY NOTES


- 1 TYPICAL EXTERIOR FINISH SEE EXTERIOR FINISH SCHEDULE BELOW.
- 2 EXTERIOR LIGHT FIXTURE (EL)
- 3 TOP OF SKIRTING
- 4 RAMP AND LANDING. - R1.01
- 5 HVAC UNIT (HV)
- 6 DOWNSPOUT FASTEN TO BUILDING TYPICAL (3) PLACES - 16/A2.03
- 7 CONTINUOUS GUTTER WITH DOWNSPOUT (LOCATION OF DOWNSPOUT SHOWN ON ROOF PLAN)
- 8 FOUNDATION VENT (SEE FOUNDATION PLAN)
- 9 FINISH FLOOR LINE
- 10 FLOOR BEAM (STR)
- 11 ROOF HEADER (STR)
- 12 TOP OF COLUMN
- 13 FINISH GRADE
- 14 ROOF BEAM (STR)
- 15 COLUMN (STR)
- 16 ELECTRICAL STUB-OUT (EL)
- 17 GROUND STUB-OUT (EL)
- 18 J-BOX FOR EXTERIOR FIRE ALARM HORN (EL)
- 19 GUTTER BOX (EL)
- 20 SIGNAGE PROVIDED AND INSTALLED BY DISTRICT PRIOR TO OCCUPANCY. 5/A5.01

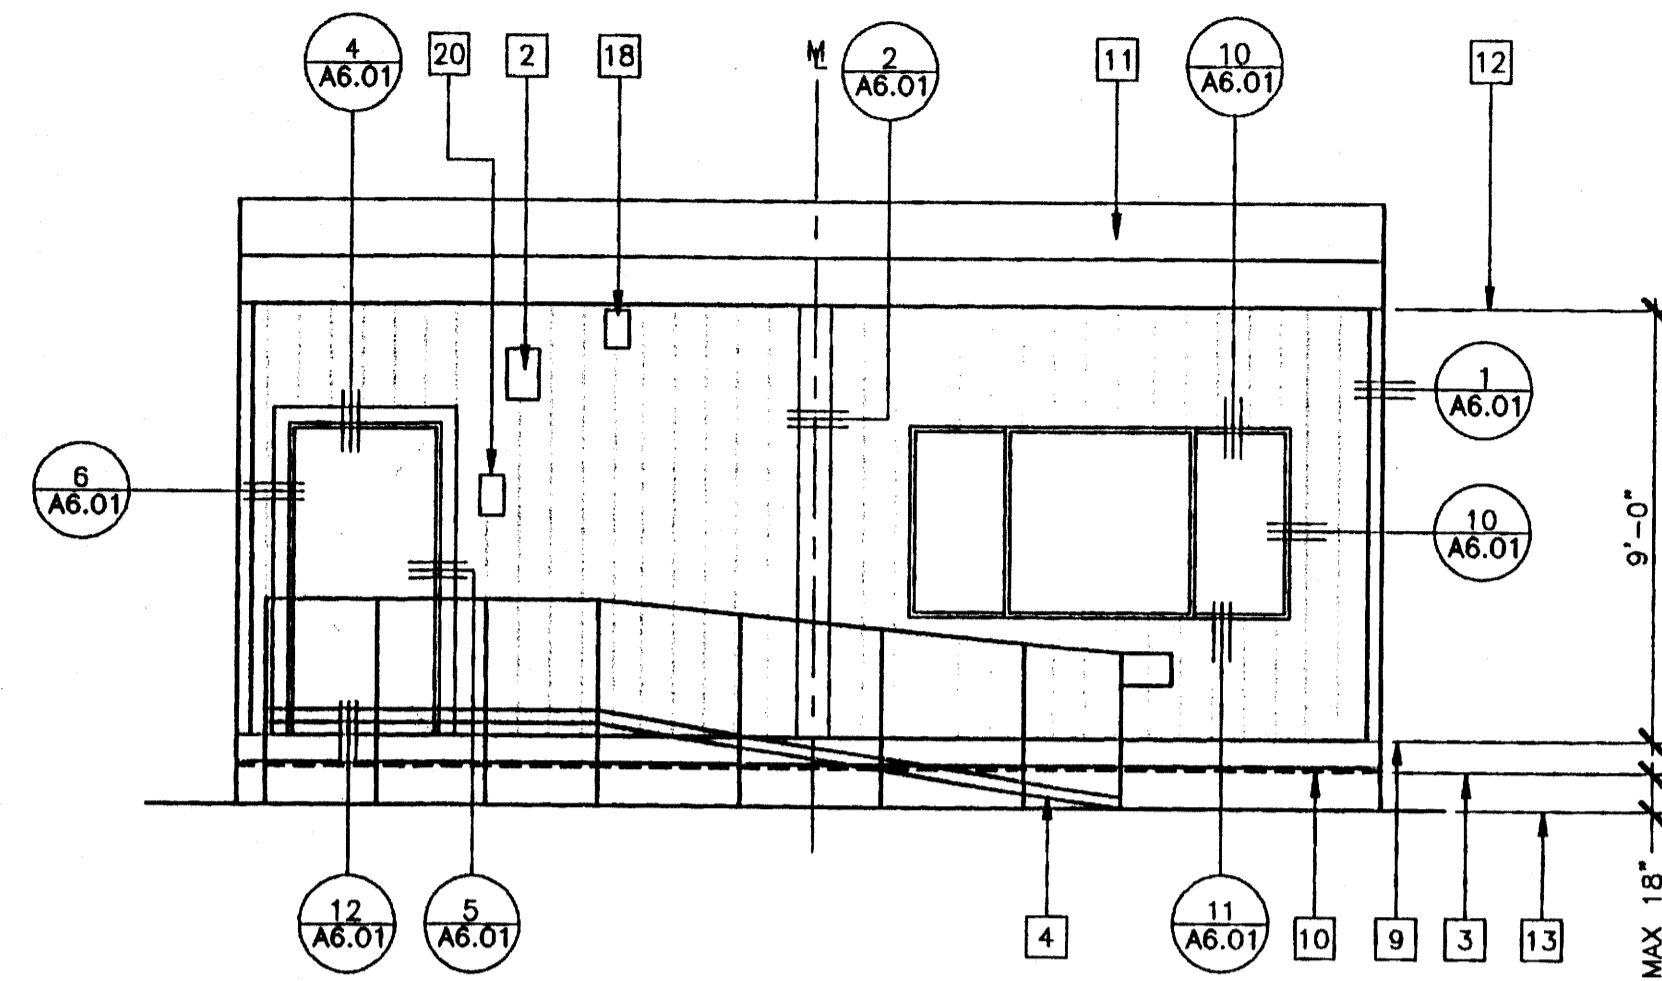


1 FRONT ELEVATION

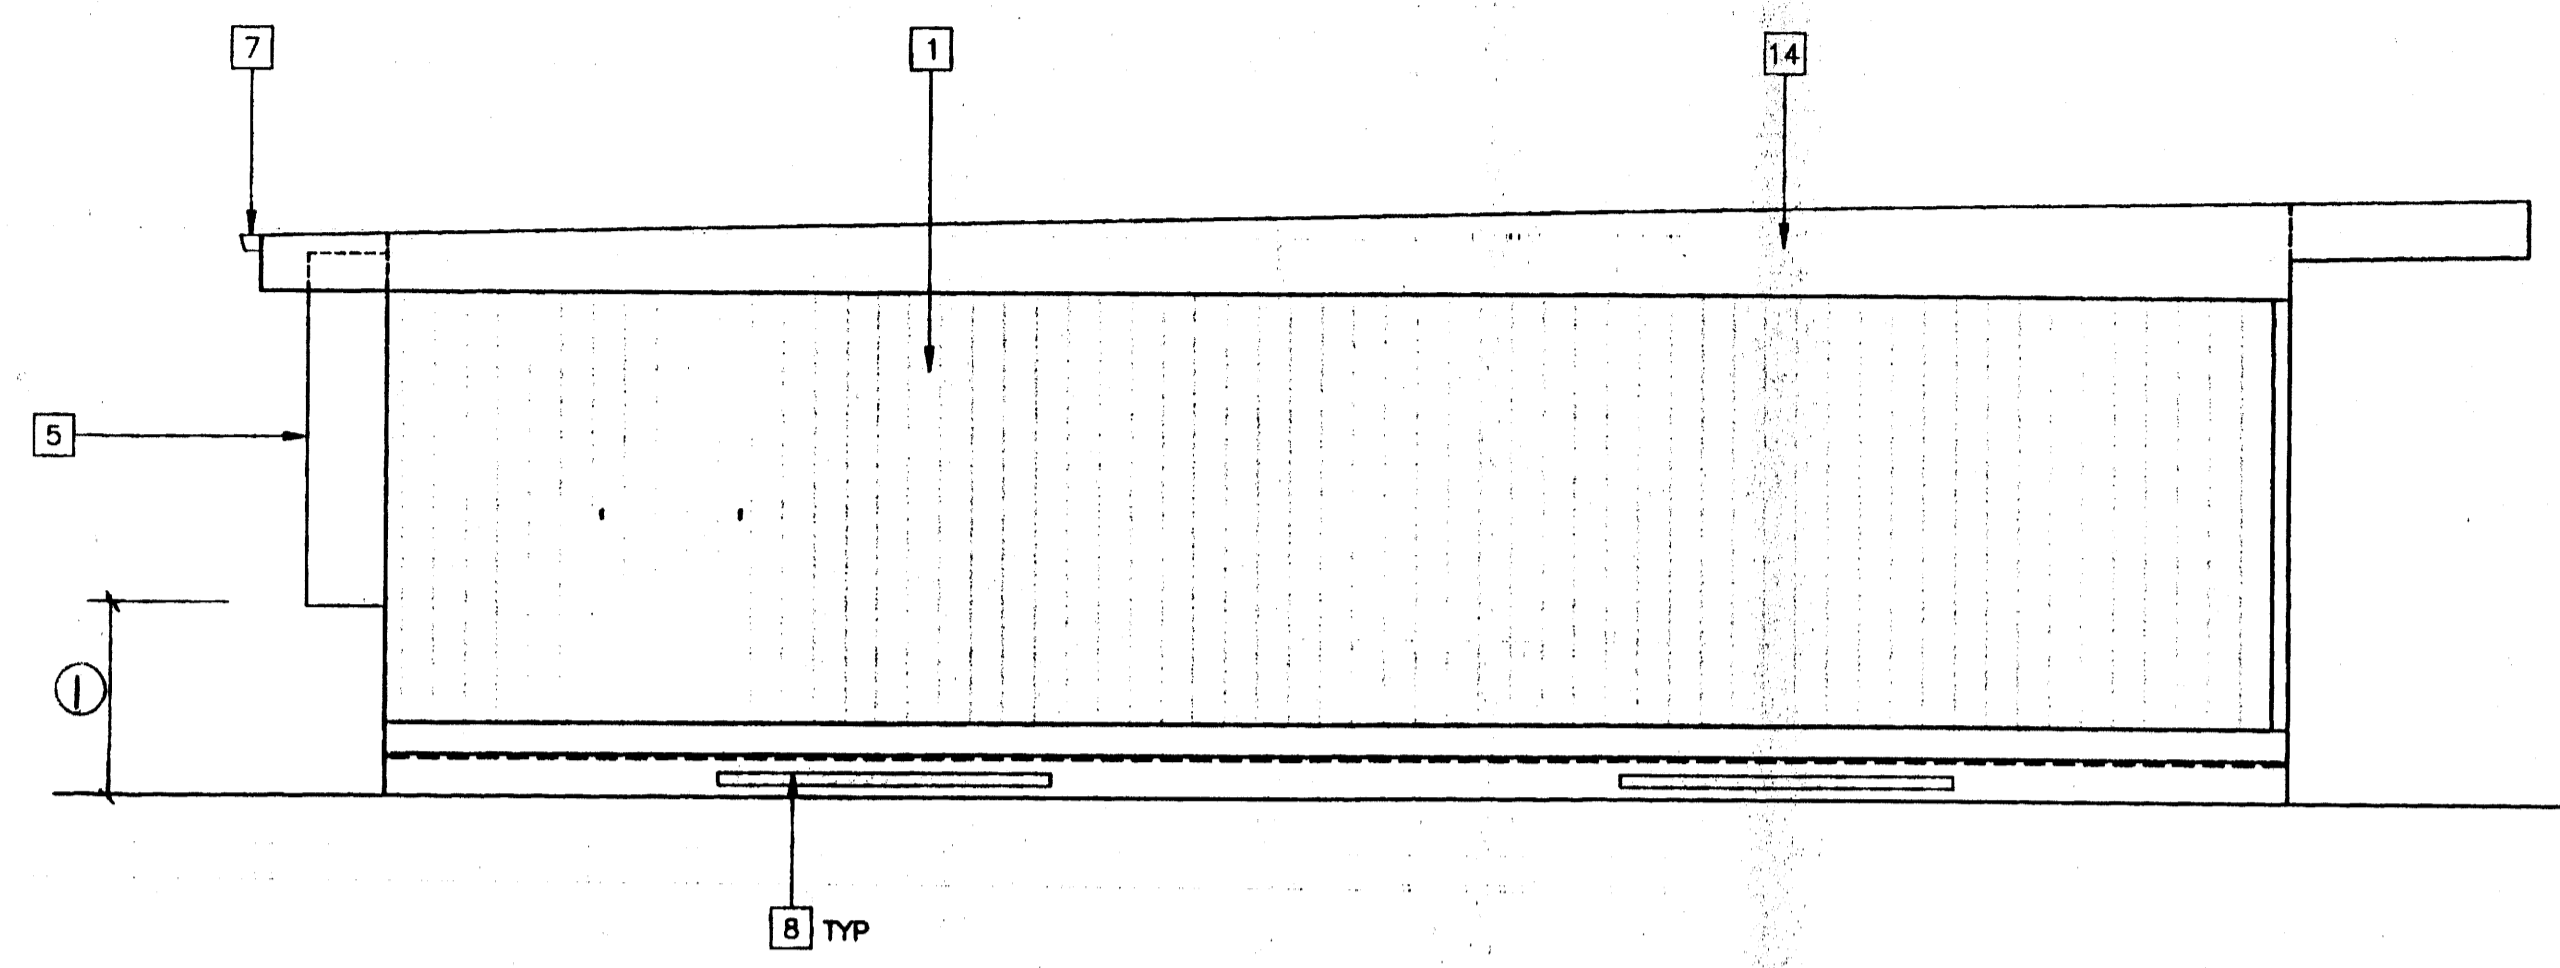

2 LEFT SIDE ELEVATION

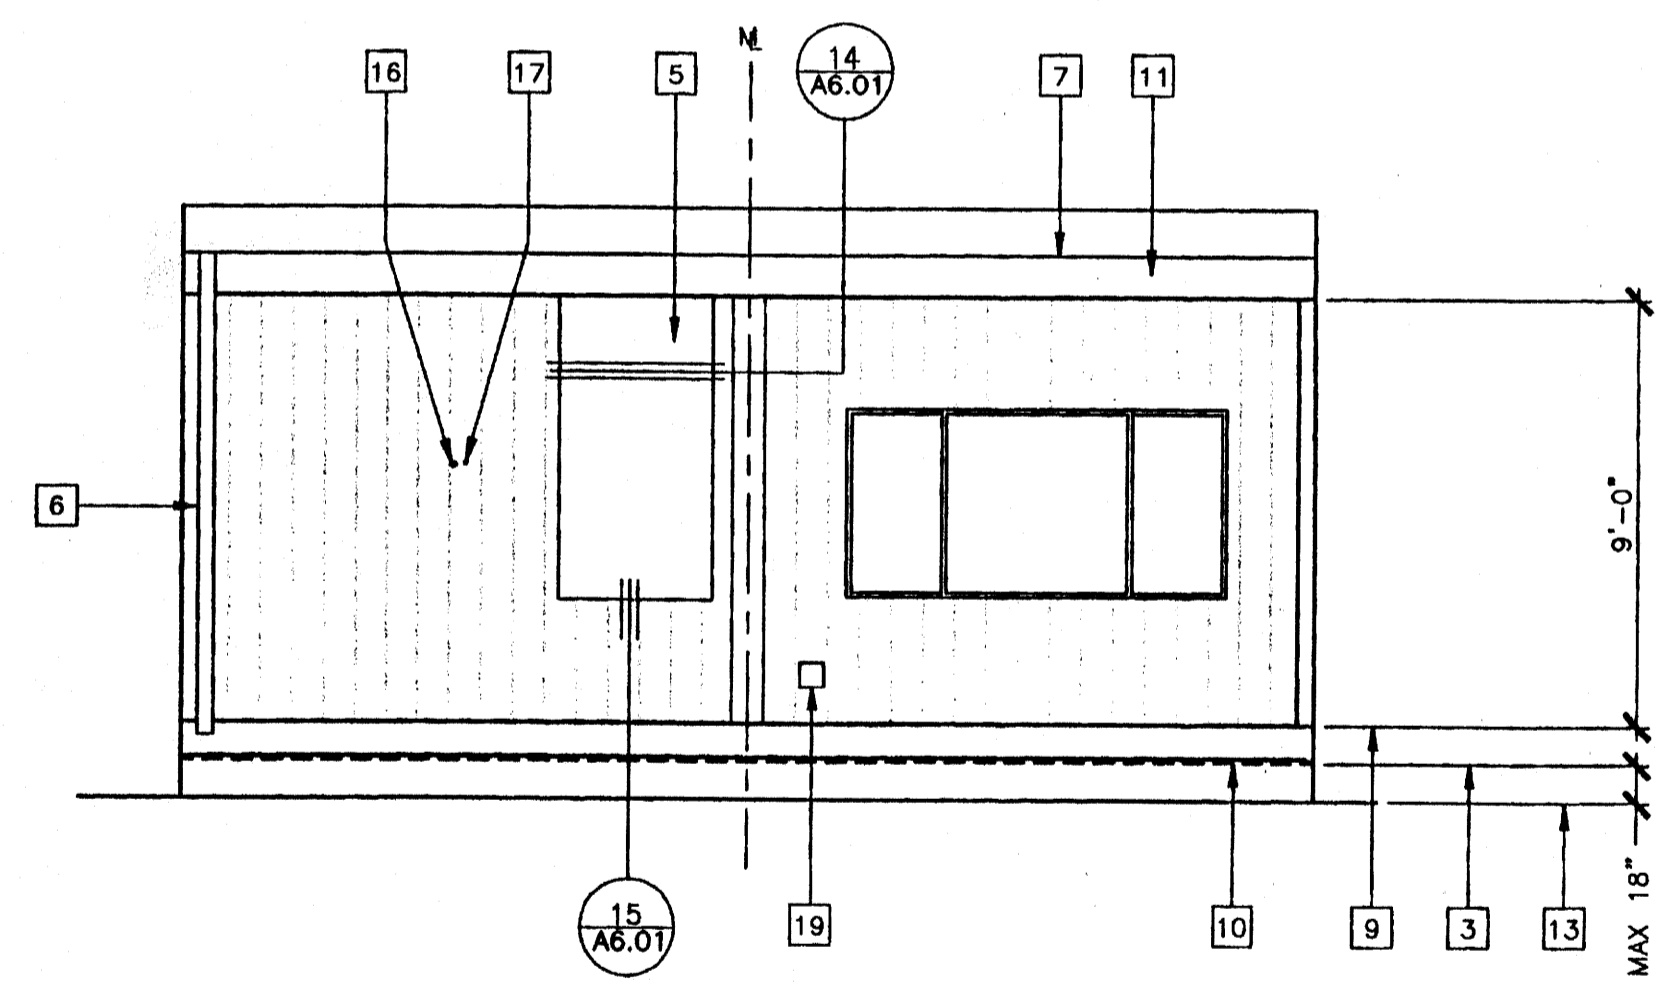

3 REAR ELEVATION

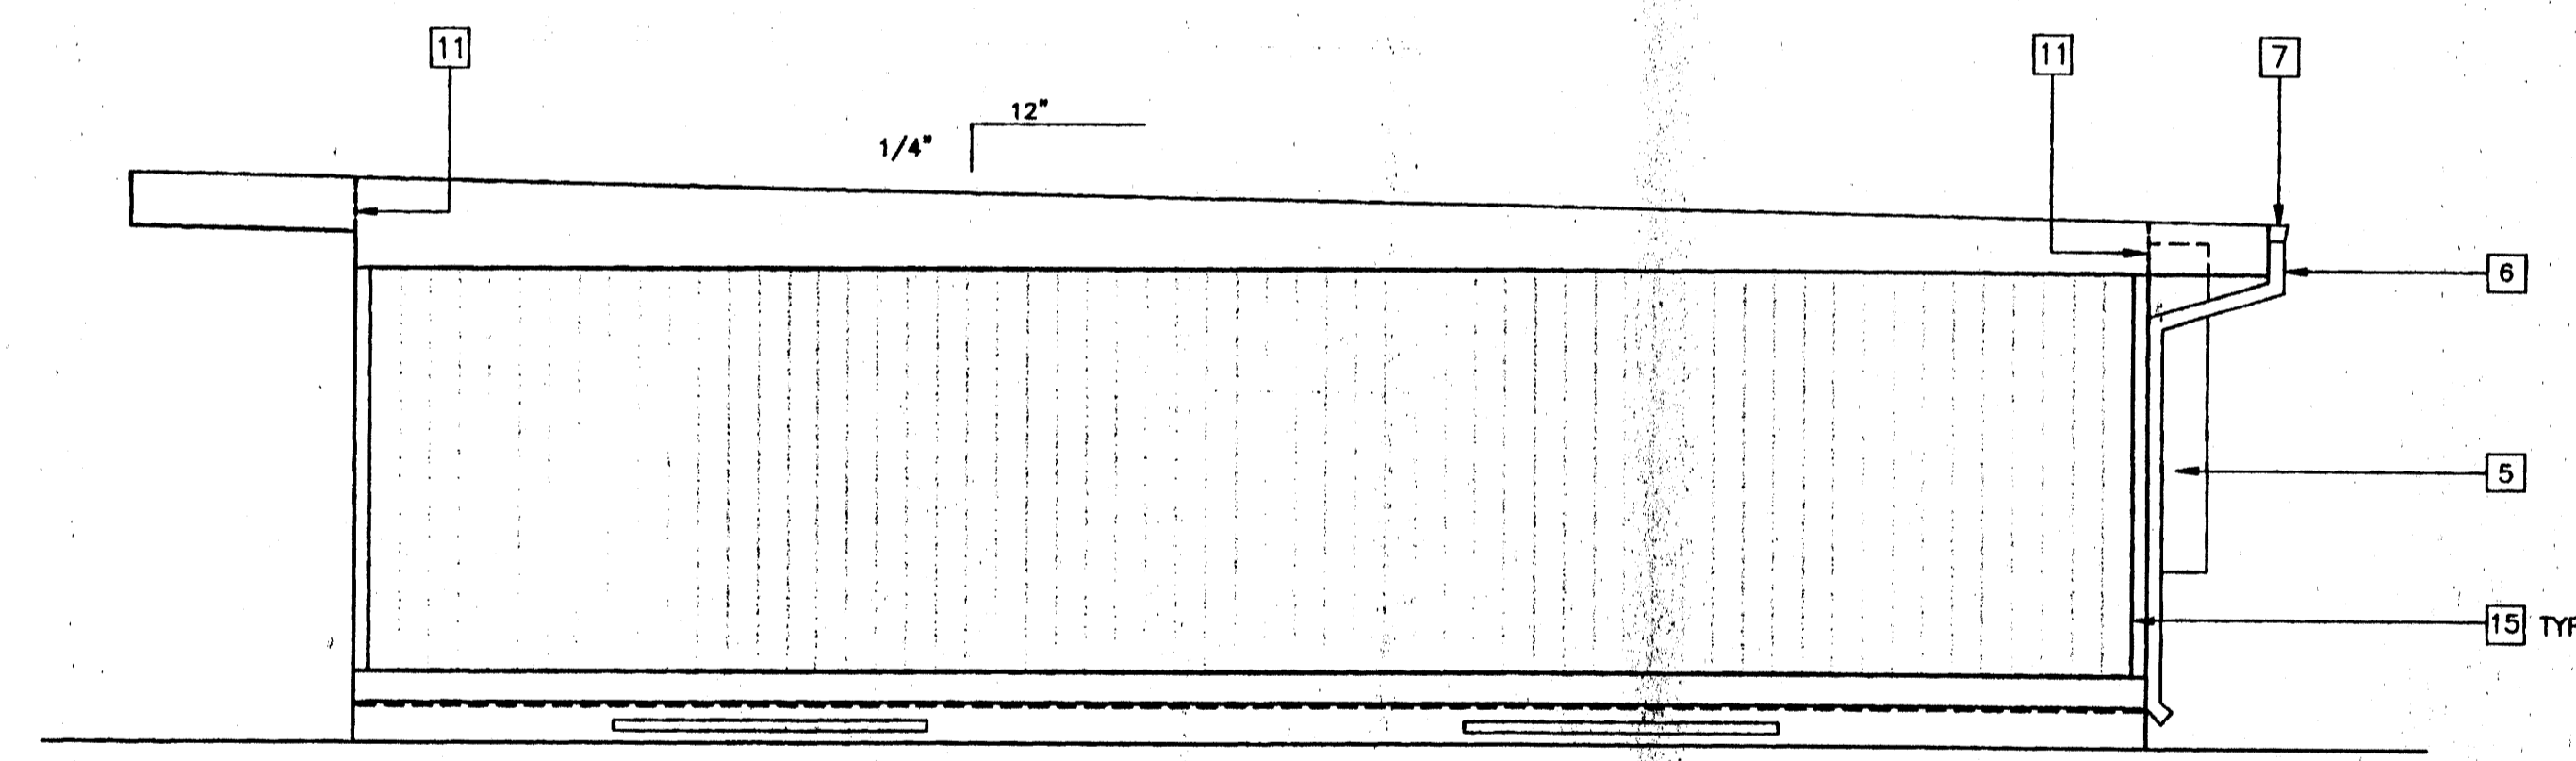


4 RIGHT SIDE ELEVATION

NOTES

- 1. IF HVAC UNIT IS LOCATED IN ANY PATH OF TRAVEL OR CIRCULATION AREA AND HEIGHT FROM GRADE TO BOTTOM OF UNIT EXCEEDS 27" PROTECTION MUST BE PROVIDED

EXTERIOR FINISH SCHEDULE

- NOTE: SEE SPECIFICATIONS FOR DETAILED DESCRIPTION OF FINISH OPTIONS.
- STANDARD - 5/8" PLYWOOD SIDING
 - OPTIONAL - 5/16" GROOVED FIBER CEMENT BOARD
 - OPTIONAL - 5/16" FIBER CEMENT BOARD WITH TEXTURED ELASTOMERIC COATING SYSTEM
 - OPTIONAL - EXTERIOR PLASTER OVER LATH

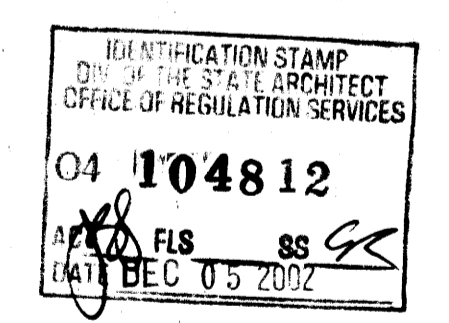

PC
CBC 1998

EXTERIOR ELEVATIONS

26 GA MONO PITCH (24'x40)
SCALE: 1/4" = 1'-0"

REVISIONS	Electrical Engineer's Seal	Mechanical Engineer's Seal	Structural Engineer's Seal	Architect's Seal	IDENTIFICATION STAMP	PROJECT NUMBER	DRAWN BY
1						4373-M, 4378-M, 4434, 4438	KK
2							DATE: 11/19/02
3							CHECKED BY: STKP-67
4							DATE: 4012-124
5							MODTECH Index No.


Electrical Engineer's Seal

Mechanical Engineer's Seal

Structural Engineer's Seal

Architect's Seal

IDENTIFICATION STAMP
DIV. OF THE STATE ARCHITECT
OFFICE OF REGULATION SERVICES
PC-04
101268
AC: J. FLS. SS. GK
DATE: SEP 07 1999

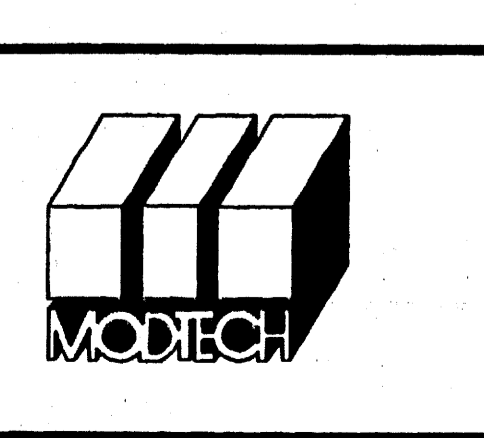

MODTECH INC.
2830 BARRETT AVENUE
PERRIS, CALIF. 92572
PH (909) 943-4014
FAX (909) 940-0427

PROJECT NUMBER: 4373-M, 4378-M, 4434, 4438 © MODTECH 2002
4474

EXTERIOR ELEVATIONS 26 GA MONO PITCH 24'x40'

DRAWN BY: KK
DATE: 11/19/02
CHECKED BY: STKP-67
DATE: 4012-124
MODTECH Index No.
A3.11

FILE PATH: 2440-AS.11.DWG PROJECT NO. 4373 PC-04-101268

KEY NOTES

- 1 TYPICAL EXTERIOR FINISH SEE EXTERIOR FINISH SCHEDULE BELOW.
- 2 EXTERIOR LIGHT FIXTURE (EL)
- 3 TOP OF SKIRTING
- 4 RAMP AND LANDING. - R1.01
- 5 HVAC UNIT (HV)
- 6 DOWNSPOUT FASTEN TO BUILDING TYPICAL (3) PLACES - 16/A2.03
- 7 CONTINUOUS GUTTER WITH DOWNSPOUT (LOCATION OF DOWNSPOUT SHOWN ON ROOF PLAN)
- 8 FOUNDATION VENT (SEE FOUNDATION PLAN)
- 9 FINISH FLOOR LINE
- 10 FLOOR BEAM (STR)
- 11 ROOF HEADER (STR)
- 12 TOP OF COLUMN
- 13 FINISH GRADE
- 14 ROOF BEAM (STR)
- 15 COLUMN (STR)
- 16 ELECTRICAL STUB-OUT (EL)
- 17 GROUND STUB-OUT (EL)
- 18 J-BOX FOR EXTERIOR FIRE ALARM HORN (EL)
- 19 GUTTER BOX (EL)
- 20 SIGNAGE PROVIDED AND INSTALLED BY DISTRICT PRIOR TO OCCUPANCY. 5/A5.01



NOTES

- 1. IF HVAC UNIT IS LOCATED IN ANY PATH OF TRAVEL OR CIRCULATION AREA AND HEIGHT FROM GRADE TO BOTTOM OF UNIT EXCEEDS 27" PROTECTION MUST BE PROVIDED


EXTERIOR FINISH SCHEDULE

NOTE: SEE SPECIFICATIONS FOR DETAILED DESCRIPTION OF FINISH OPTIONS.


STANDARD - 5/8" PLYWOOD SIDING
 OPTIONAL - 5/16" GROOVED FIBER CEMENT BOARD
 OPTIONAL - 5/16" FIBER CEMENT BOARD WITH TEXTURED ELASTOMERIC COATING SYSTEM
 OPTIONAL - EXTERIOR PLASTER OVER LATH

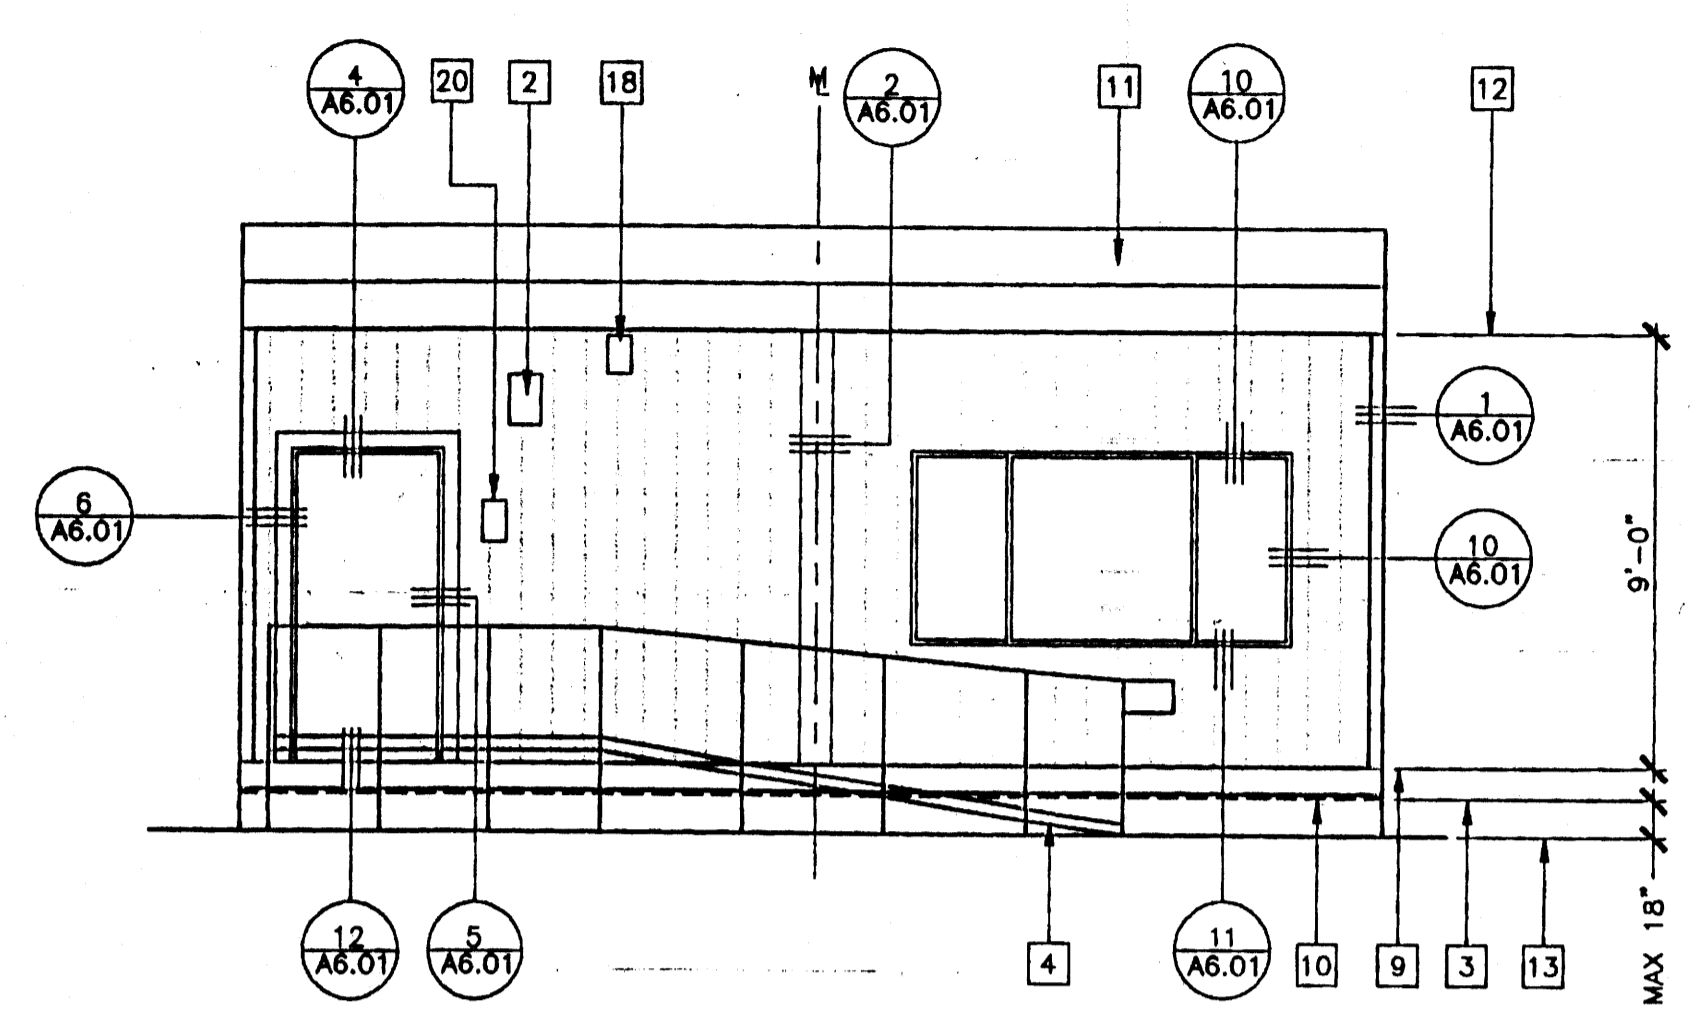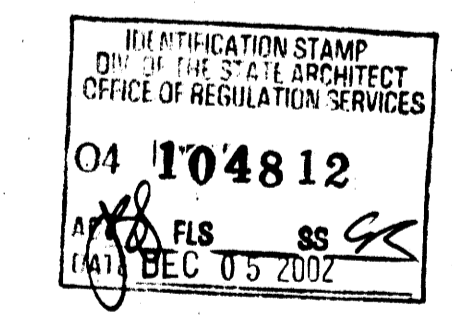


1 FRONT ELEVATION

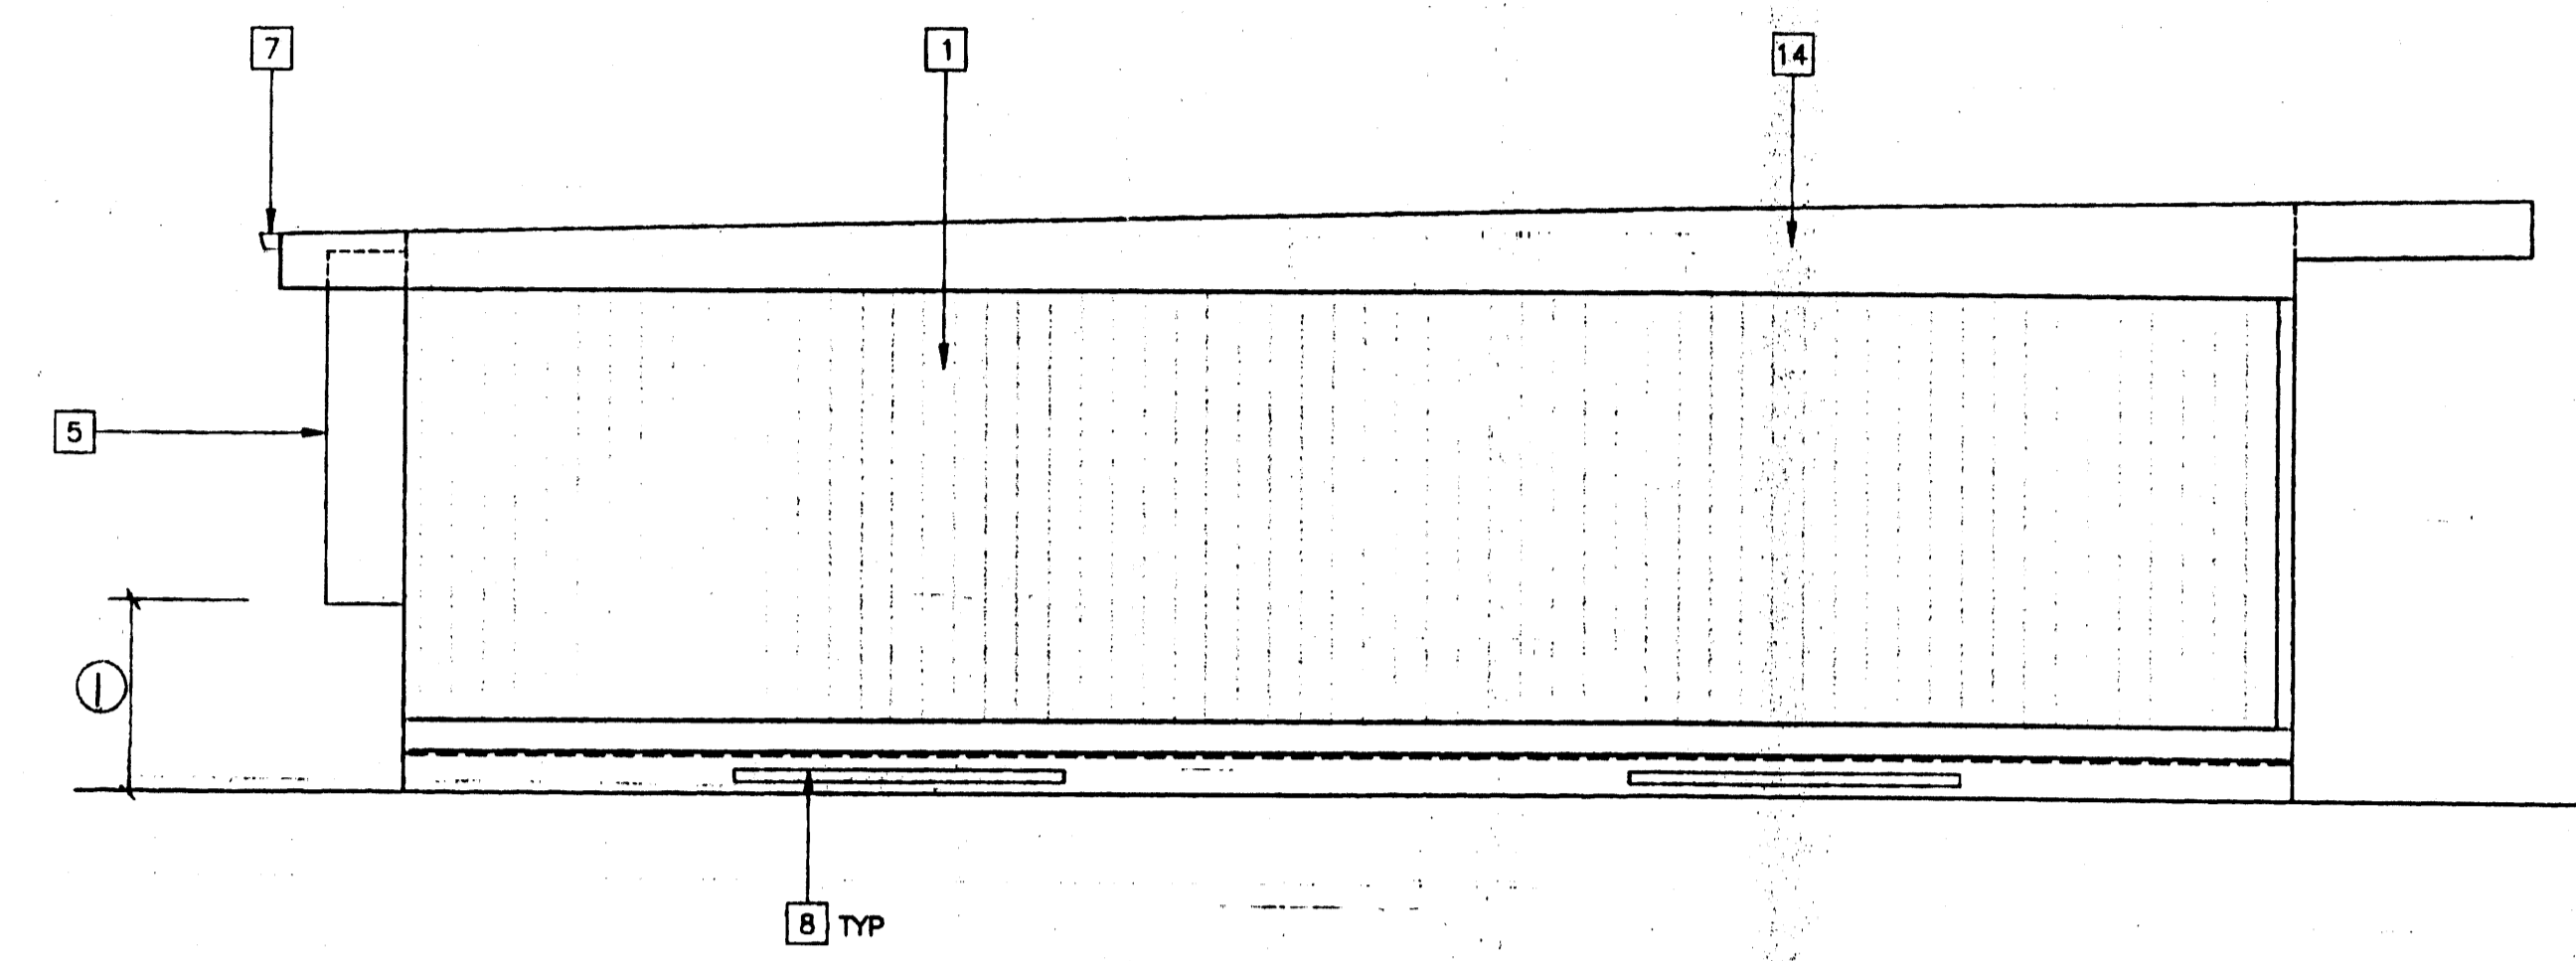

2 LEFT SIDE ELEVATION

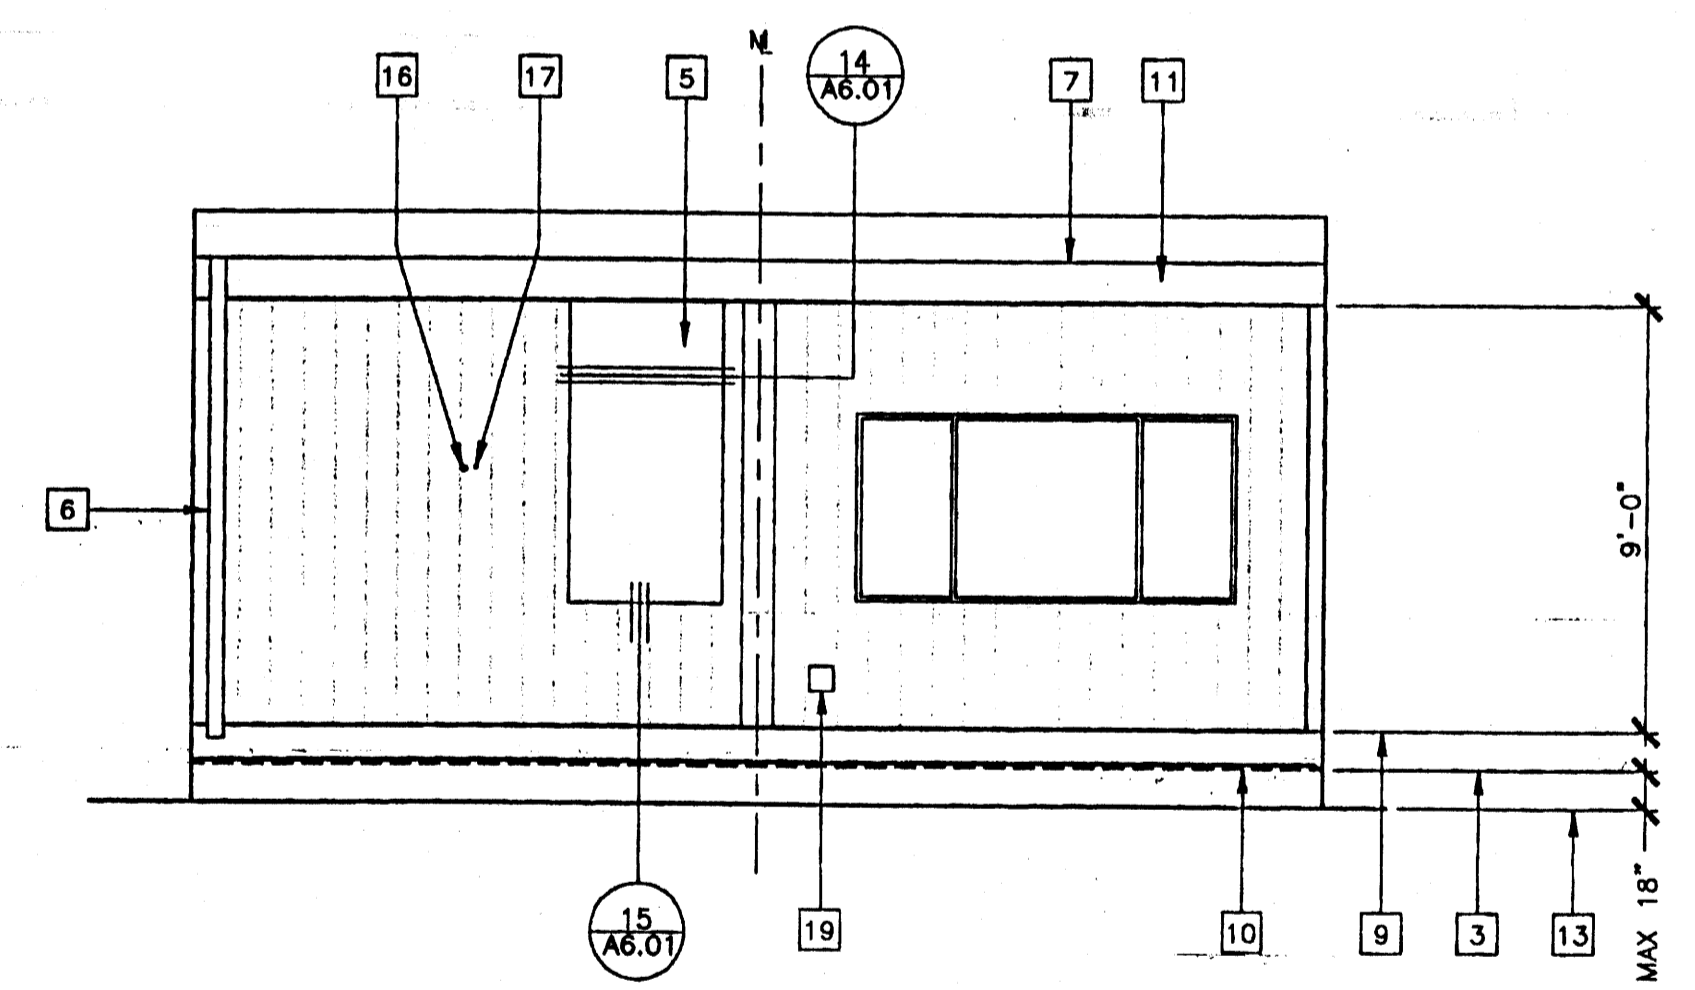

3 REAR ELEVATION

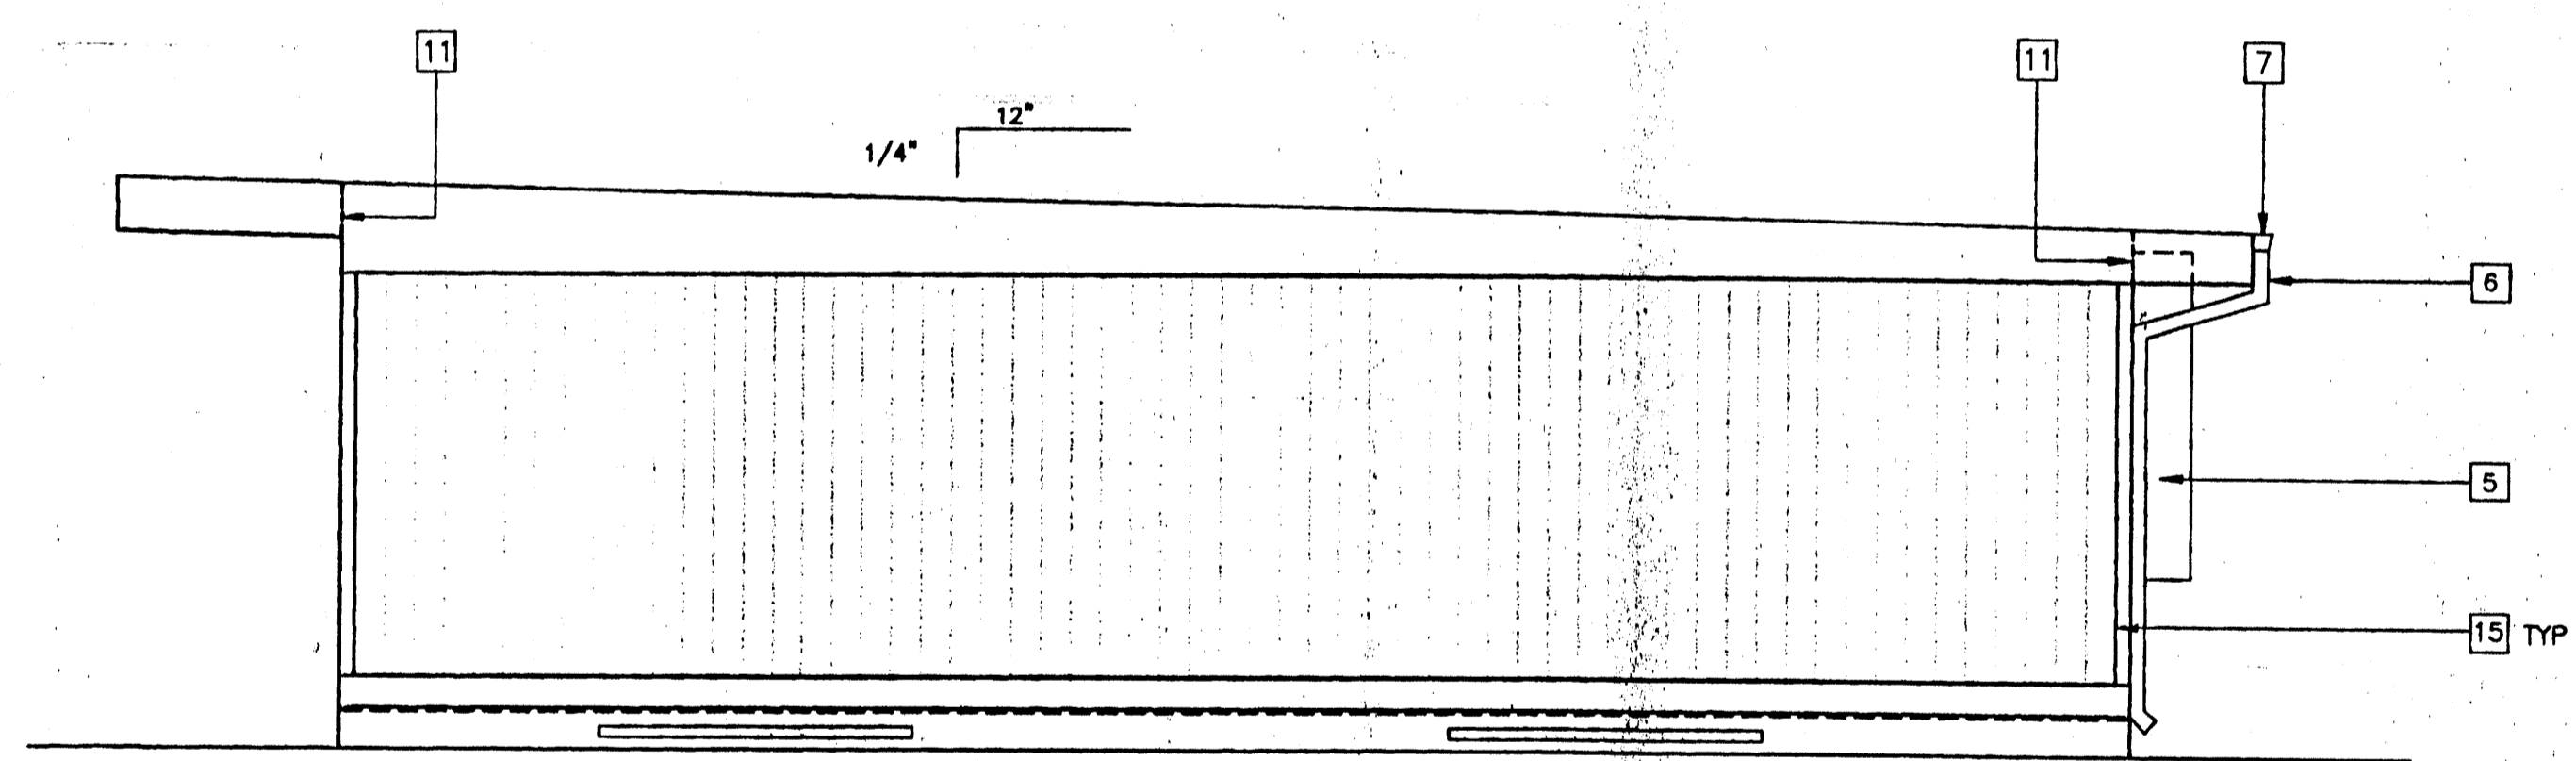

4 RIGHT SIDE ELEVATION

PC
CBC 1998


EXTERIOR ELEVATIONS

26 GA MONO PITCH (24'x40)
SCALE: 1/4" = 1'-0"

REVISIONS	Electrical Engineer's Seal	Mechanical Engineer's Seal	Structural Engineer's Seal	Architects Seal
1				
2				
3				
4				
5				

Professional seals for Electrical, Mechanical, and Structural Engineers, and the Architect's Seal for Modtech Inc.

IDENTIFICATION STAMP
 DIV. OF THE STATE ARCHITECT
 OFFICE OF REGULATION SERVICES
 PC-04
 101268
 AC: J. FLS. SS: [Signature]
 DATE: OCT 07 1999

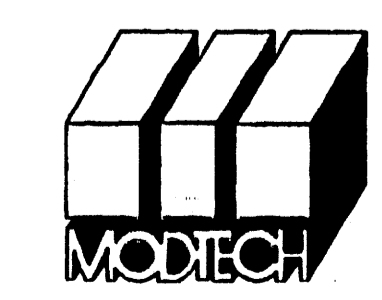

MODTECH INC.
 2830 BARRETT AVENUE
 PERRIS, CALIF. 92572
 PH (909) 943-4014
 FAX (909) 940-0427

PROJECT NUMBER: 4373-M, 4378-M, 4434, 4438 © MODTECH 2002
 4474-
 10- 24 x 40 CLASSROOMS A# 04-104812
 SERIAL # 46974-01/02 TO 46978-01/02
 SERIAL # 47176-01/02 TO 47176-01/02
 # 4474 STOCK-LATHROP STOCKPILE #67


DRAWN BY: KK
 DATE: 11/19/02
 CHECKED BY: STKP-67
 DATE: 4012-124
 MODTECH Index No.

EXTERIOR ELEVATIONS 26 GA MONO PITCH 24'x40'


A3.11

FILE PATH: 2440-A3.11.DWG


PROJECT NO. 4373
PC-04-101268

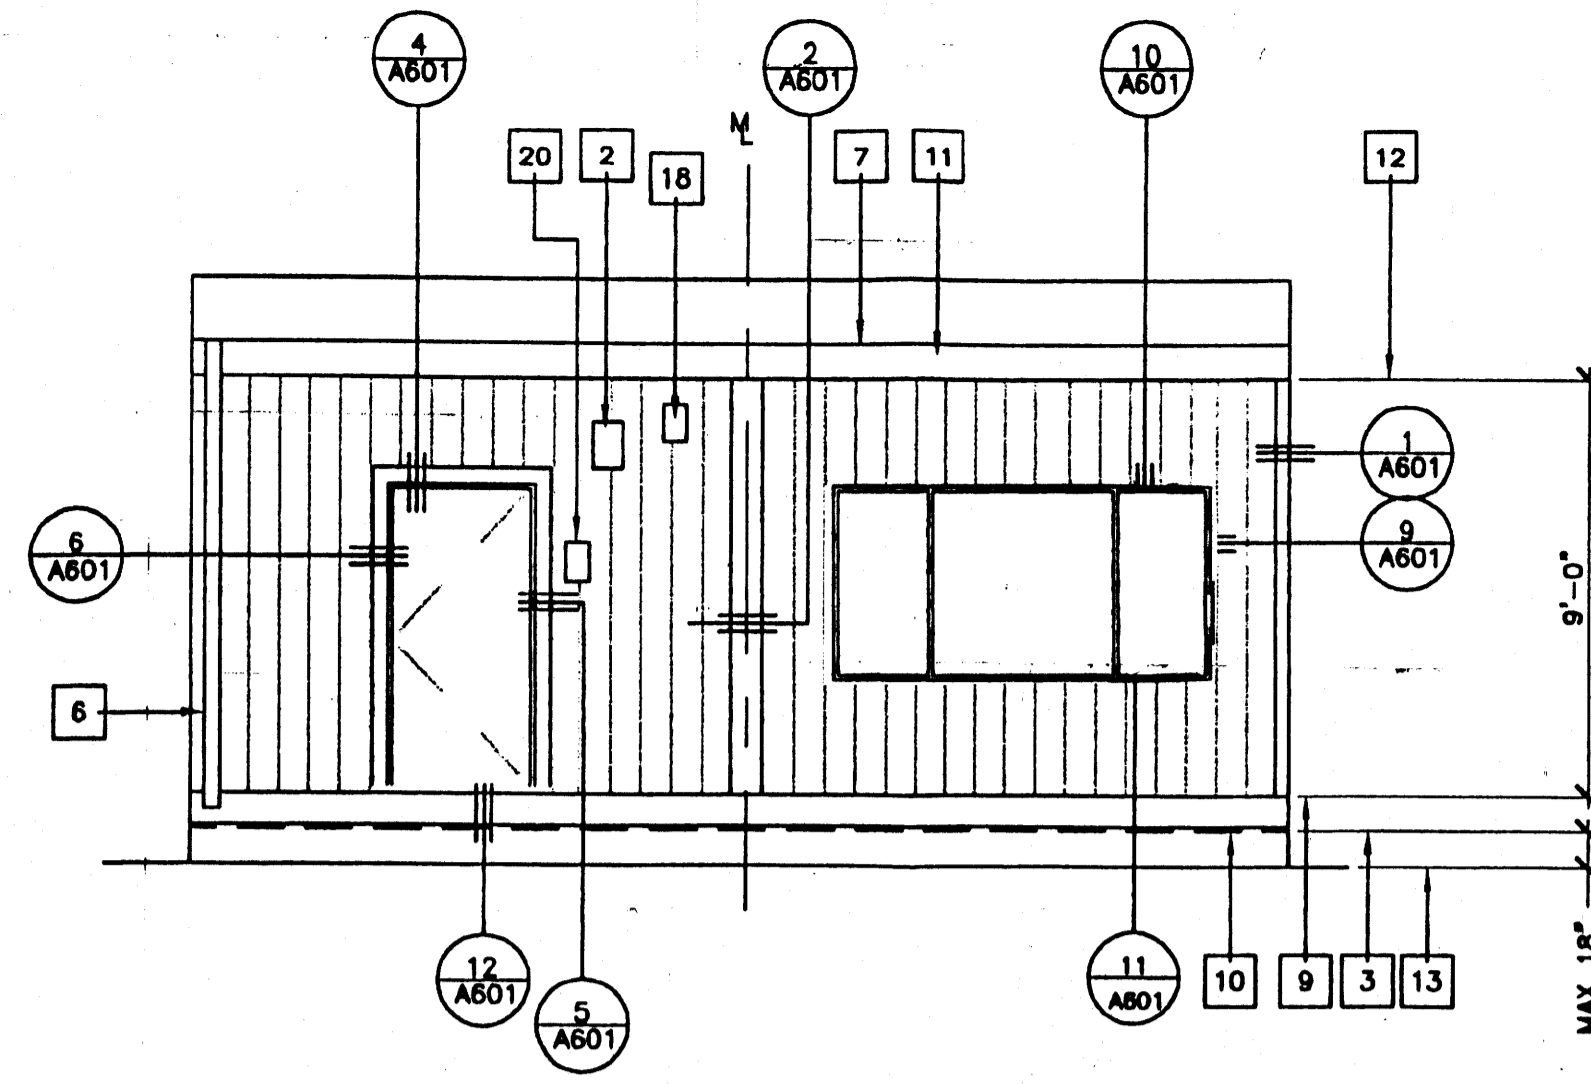


1 FRONT ELEVATION

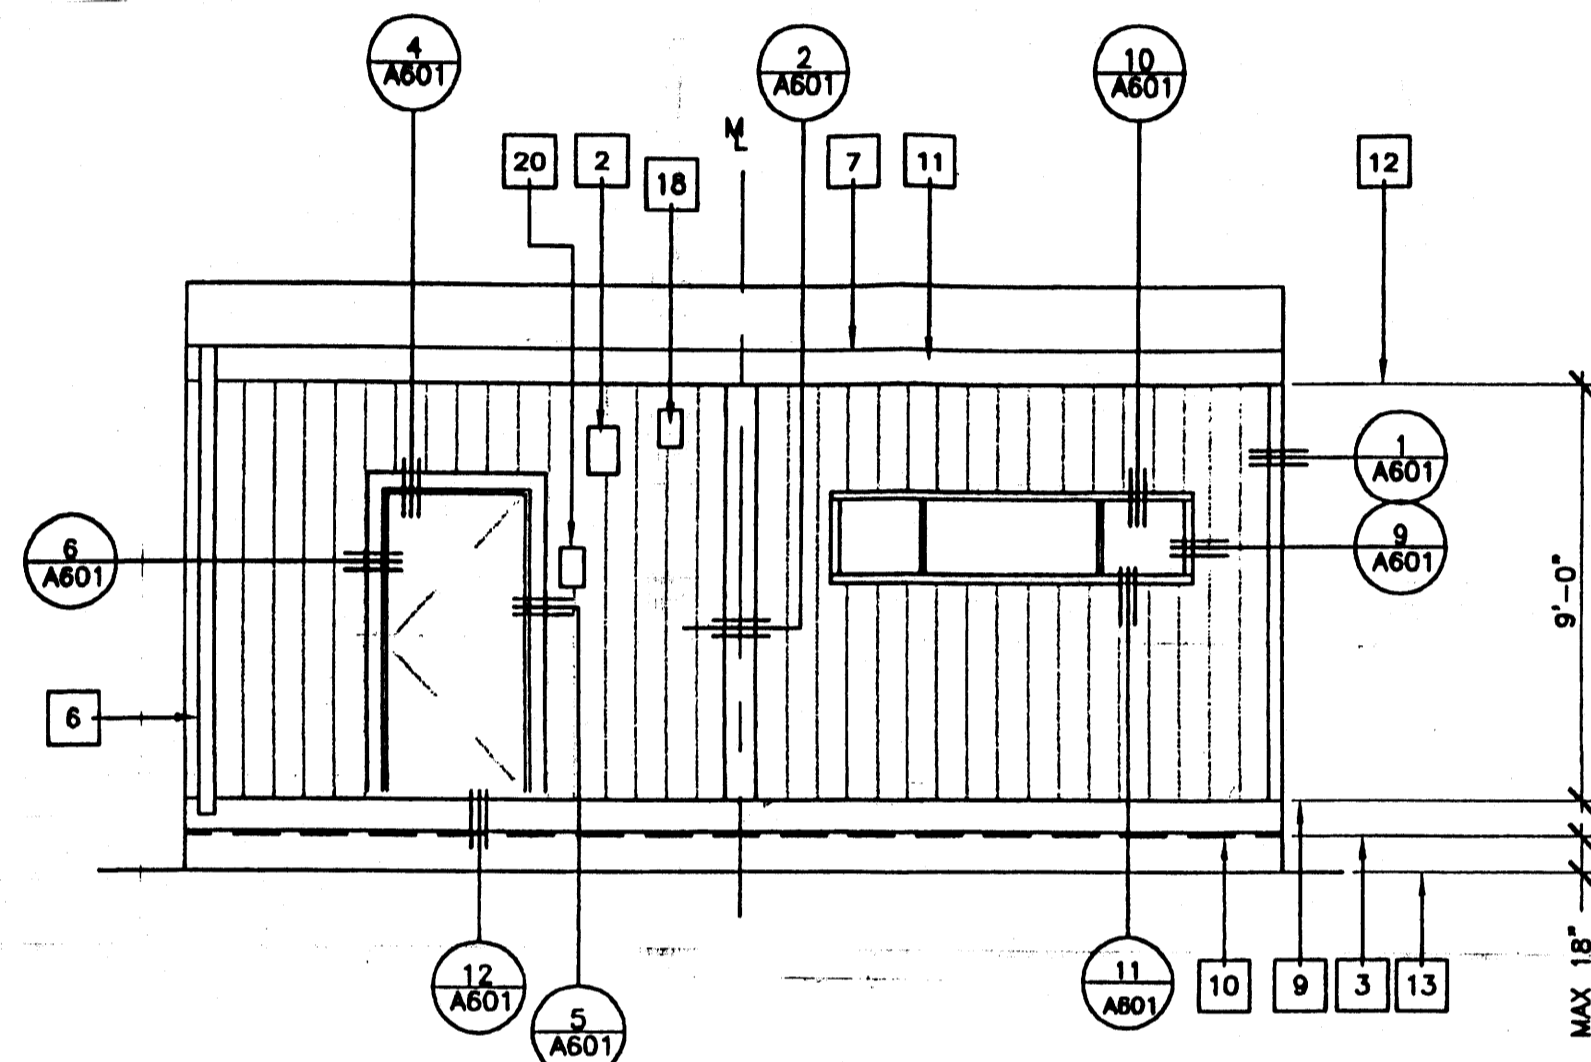


1A FRONT ELEVATION

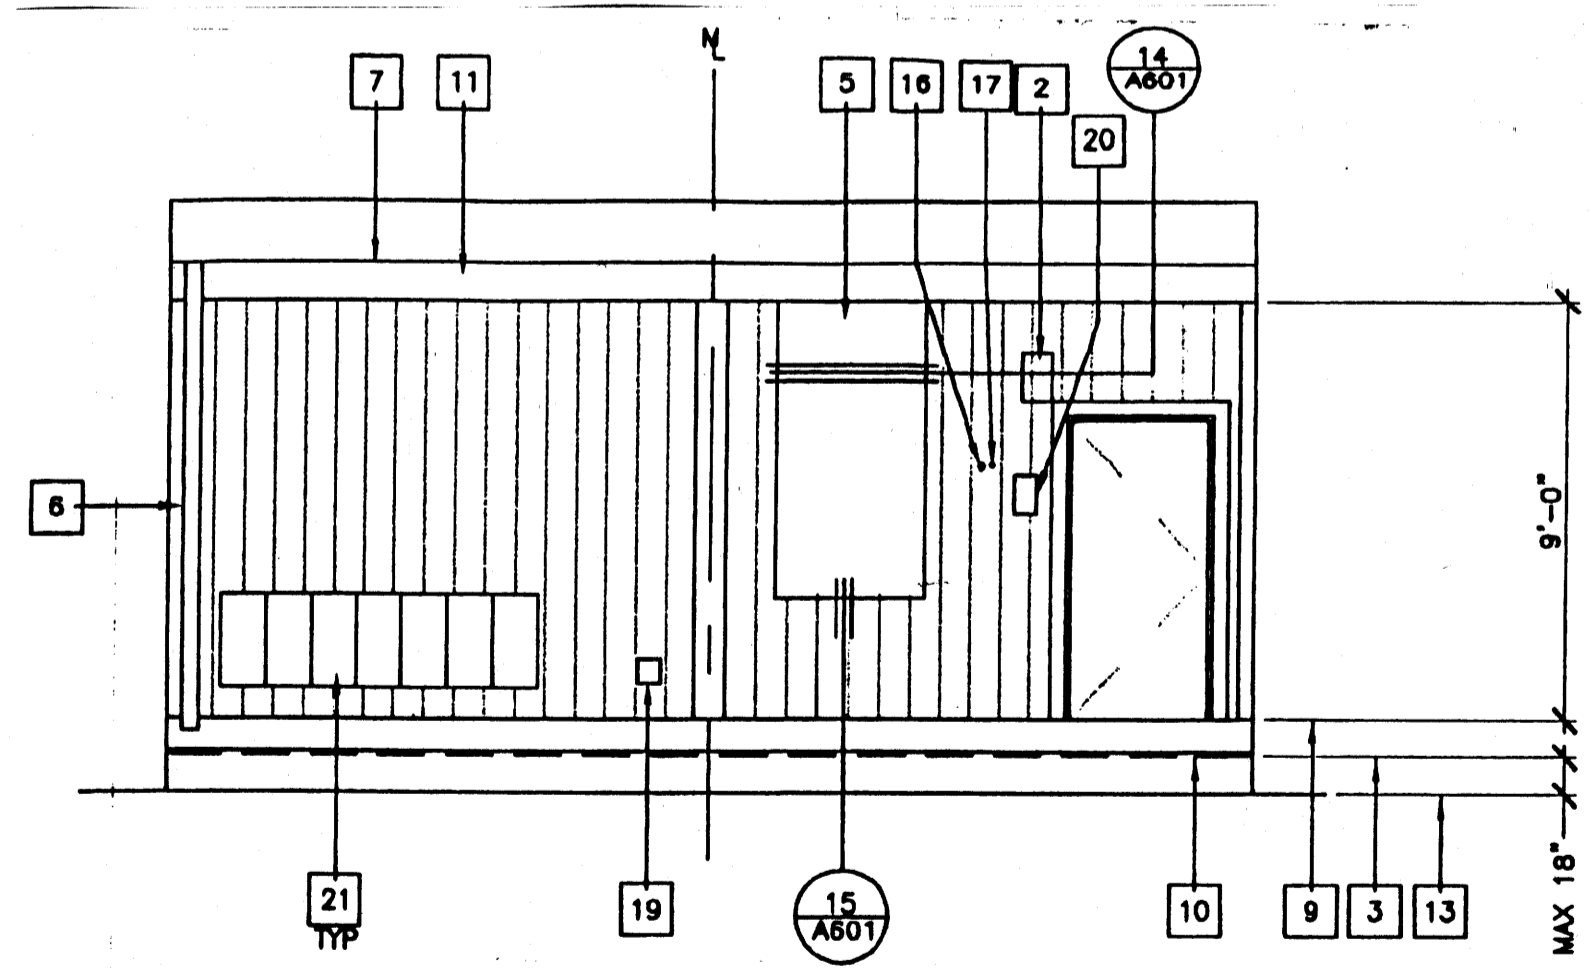

1B REAR ELEVATION

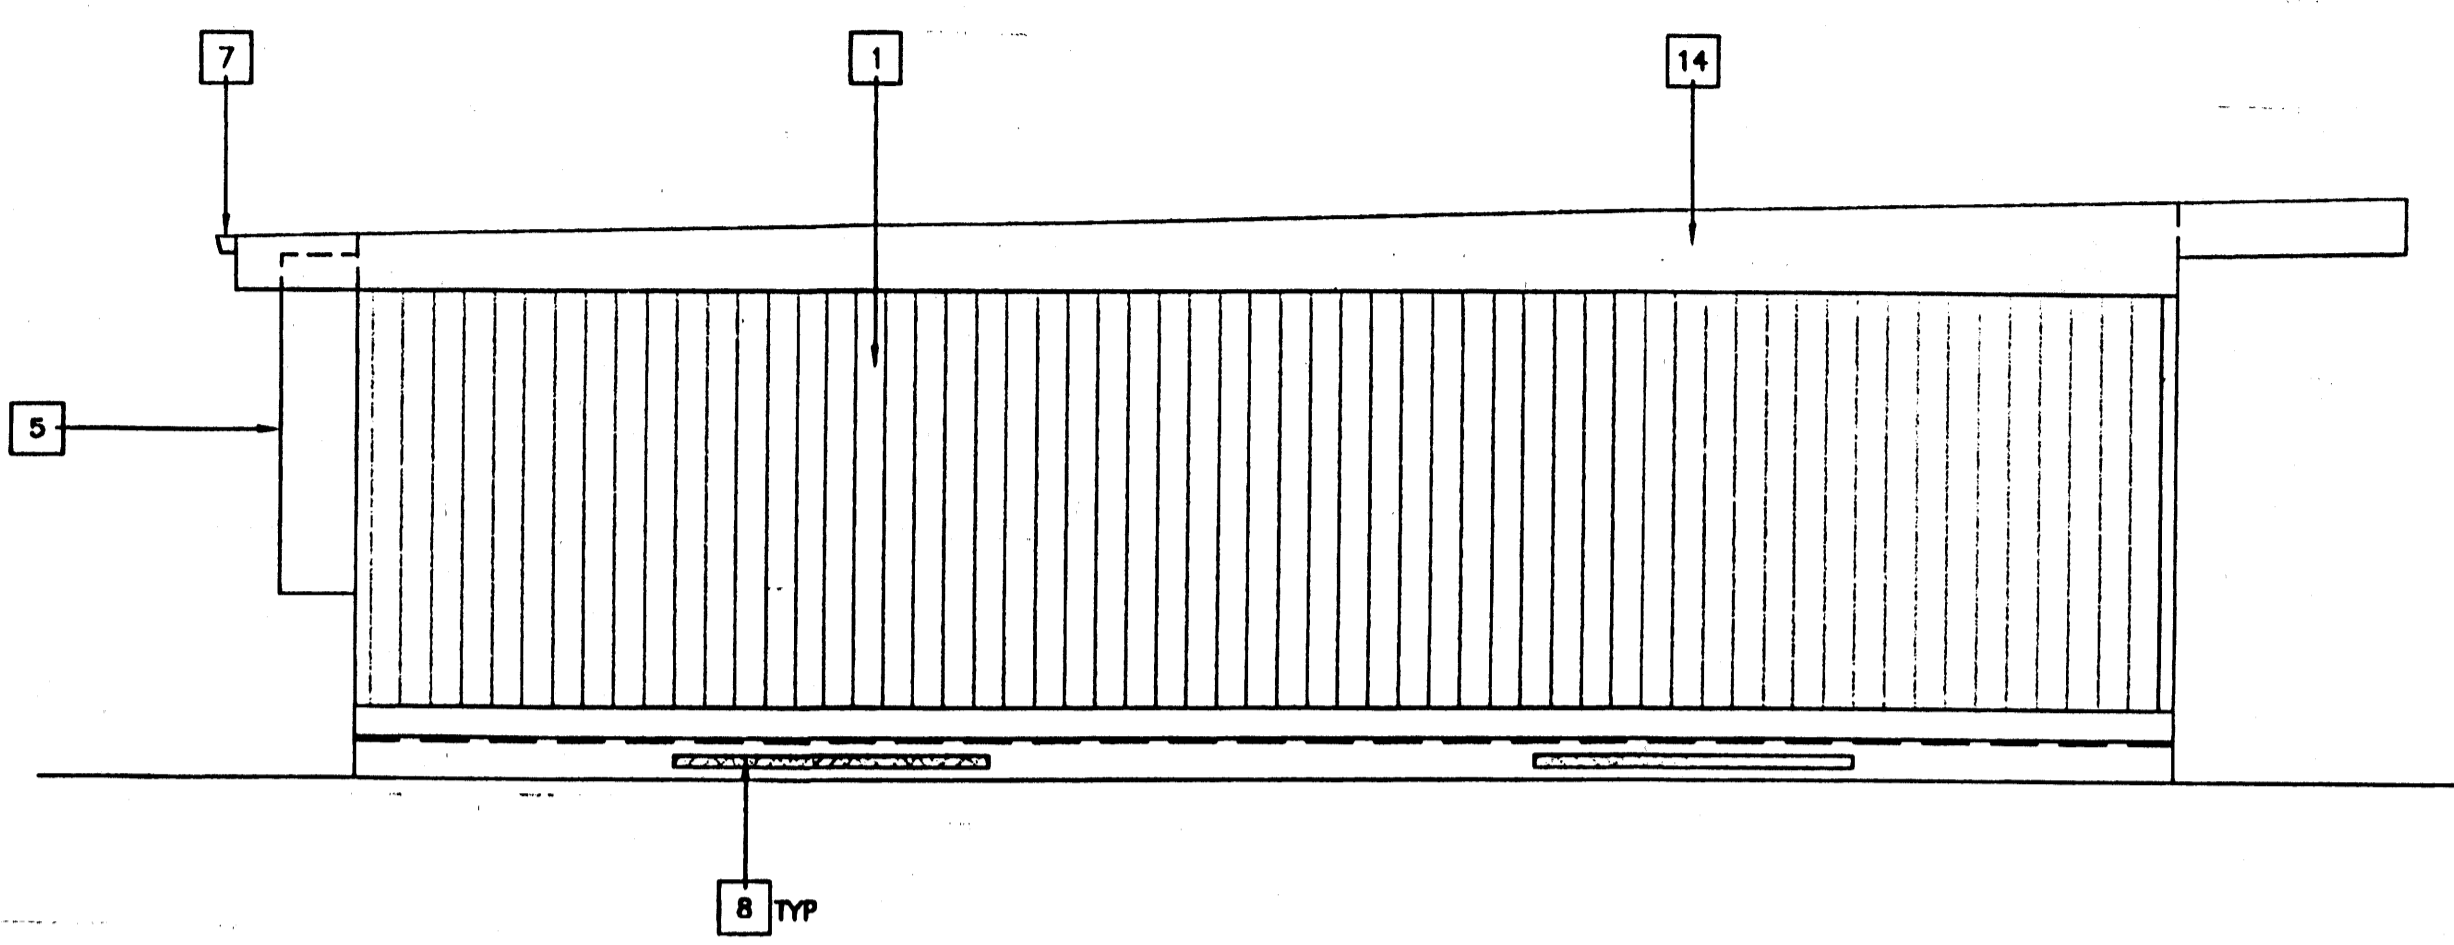

2 LEFT SIDE ELEVATION

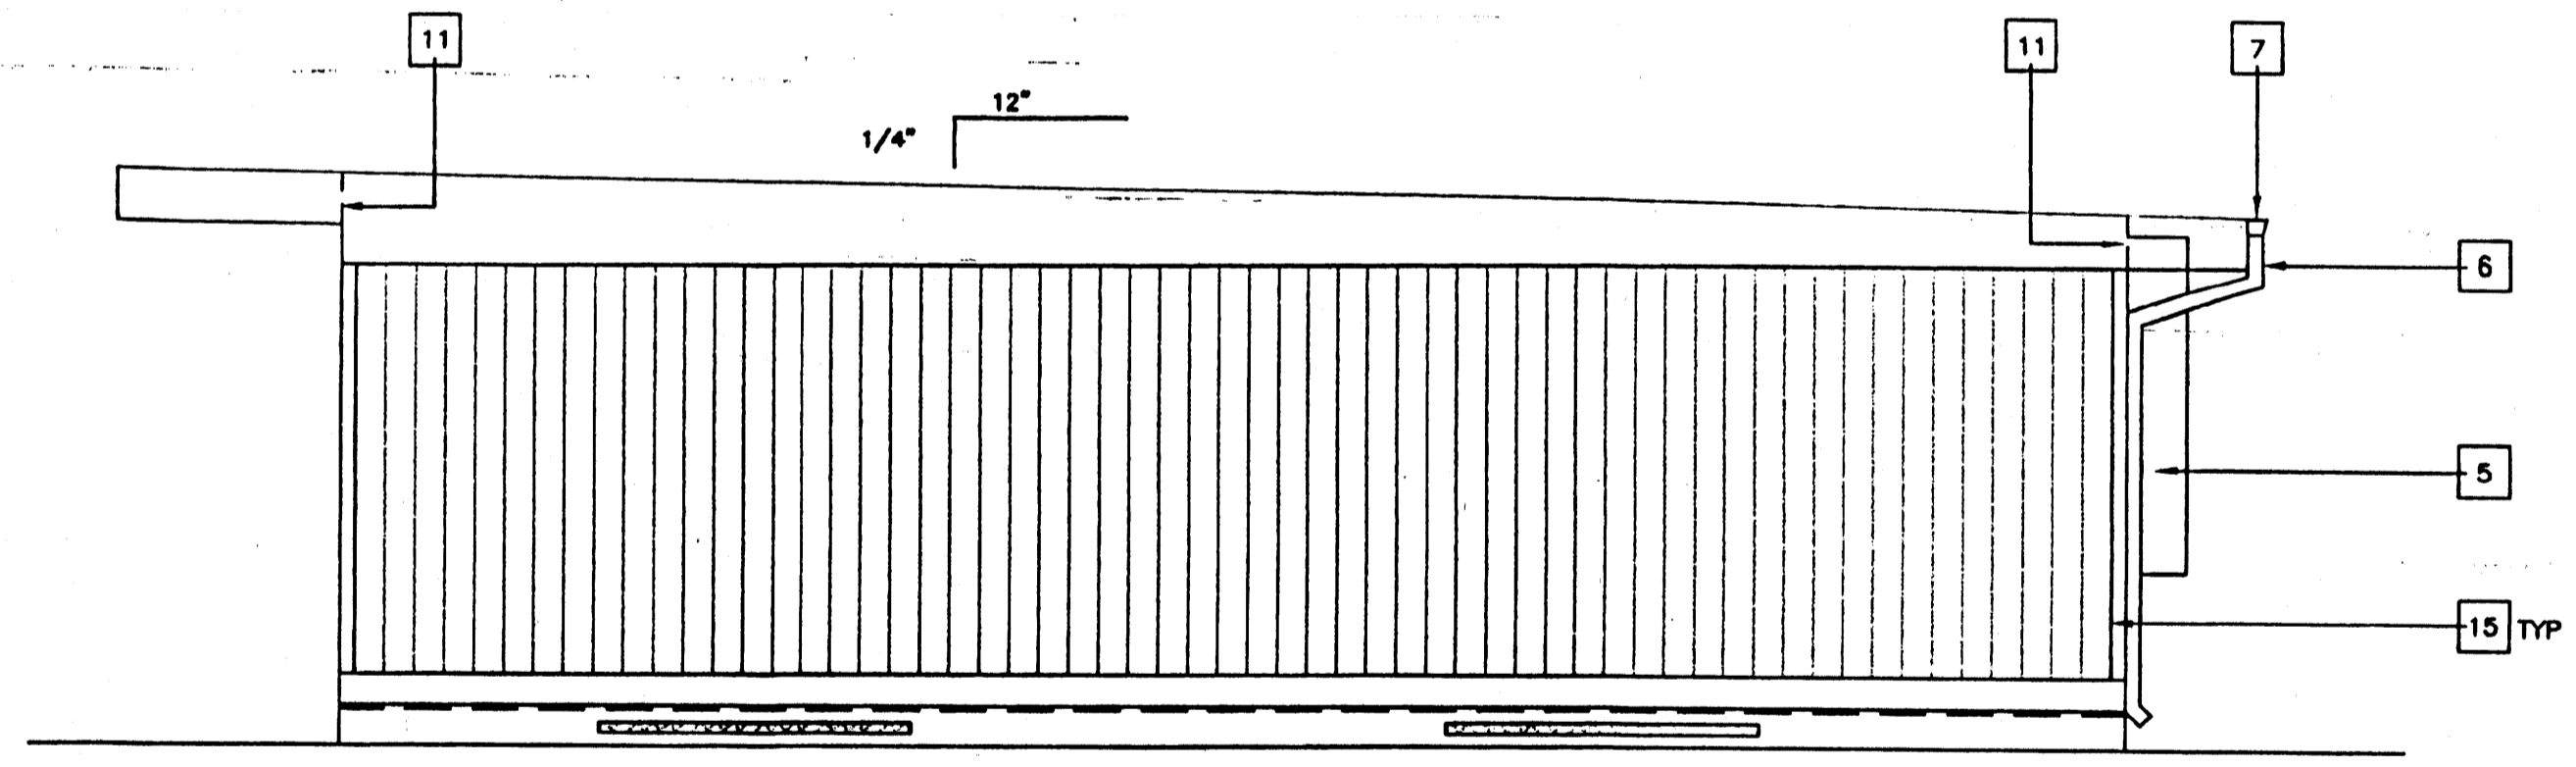

4 RIGHT SIDE ELEVATION

EXTERIOR ELEVATIONS 26 GA MONO PITCH (24'x40)
SCALE: 1/4" = 1'-0"

KEY NOTES

- 1 TYPICAL EXTERIOR FINISH SEE EXTERIOR FINISH SCHEDULE BELOW.
- 2 EXTERIOR LIGHT FIXTURE (EL)
- 3 TOP OF SKIRTING
- 4 NOT USED
- 5 HVAC UNIT (HV)
- 6 DOWNSPOUT FASTEN TO BUILDING TYPICAL (3) PLACES - 16/A2.03
- 7 CONTINUOUS GUTTER WITH DOWNSPOUT (LOCATION OF DOWNSPOUT SHOWN ON ROOF PLAN)
- 8 FOUNDATION VENT (SEE FOUNDATION PLAN)
- 9 FINISH FLOOR LINE
- 10 FLOOR BEAM (STR)
- 11 ROOF HEADER (STR)
- 12 TOP OF COLUMN
- 13 FINISH GRADE
- 14 ROOF BEAM (STR)
- 15 COLUMN (STR)
- 16 ELECTRICAL STUB-OUT (EL)
- 17 GROUND STUB-OUT (EL)
- 18 J-BOX FOR EXTERIOR FIRE ALARM HORN (EL)
- 19 GUTTER BOX (EL)
- 20 SIGNAGE PROVIDED AND INSTALLED BY DISTRICT PRIOR TO OCCUPANCY. 5/A5.01
- 21 12"W X 24"H X 6"D GUTTER BOXES

NOTES


1. IF HVAC UNIT IS LOCATED IN ANY PATH OF TRAVEL OR CIRCULATION AREA AND HEIGHT FROM GRADE TO BOTTOM OF UNIT EXCEEDS 27" PROTECTION MUST BE PROVIDED

EXTERIOR FINISH SCHEDULE

NOTE: SEE SPECIFICATIONS FOR DETAILED DESCRIPTION OF FINISH OPTIONS.


STANDARD - 5/8" PLYWOOD SIDING
 OPTIONAL - 5/16" GROOVED FIBER CEMENT BOARD
 OPTIONAL - 5/16" FIBER CEMENT BOARD WITH TEXTURED ELASTOMERIC COATING SYSTEM
 OPTIONAL - EXTERIOR PLASTER OVER LATH

REVISED

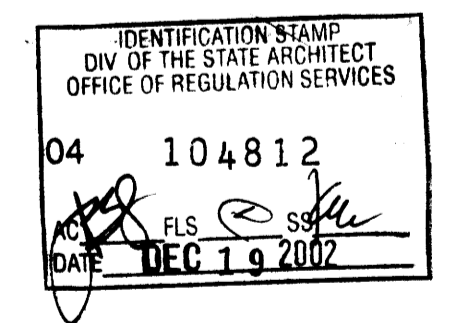


REVISIONS	Electrical Engineer's Seal	Mechanical Engineer's Seal	Structural Engineer's Seal	Architect's Seal
1				
2				
3				
4				
5				

Electrical Engineer's Seal
 Mechanical Engineer's Seal
 Structural Engineer's Seal

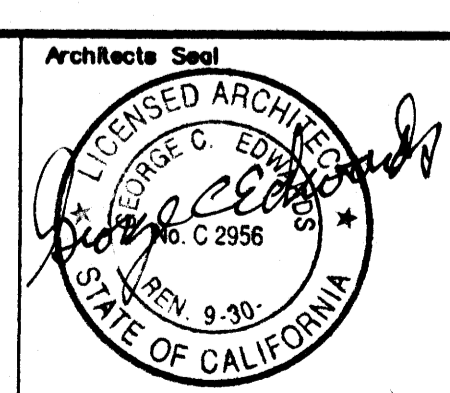

IDENTIFICATION STAMP
 DIV. OF THE STATE ARCHITECT
 OFFICE OF REGULATION SERVICES
 PC-04
 101268
 AC FLS SS
 DATE

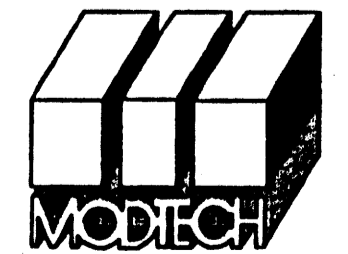

MODTECH INC.
 2830 BARRETT AVENUE
 PERRIS, CALIF. 92572
 PH (909) 943-4014
 FAX (909) 940-0427

PROJECT NUMBER: 4304
 CHINO
 CLASS LEASING

© MODTECH, INC. 1999
 CLASS LEASING INC STOCKPILE # 67
 100- 24 x 40 CLASSROOM BUILDINGS
 4012-124 12/05/2002 80 MPH

DRAWN BY: SW
 DATE: 6/26/01
 CHECKED BY:
 DATE:

EXTERIOR ELEVATIONS 26 GA MONO PITCH 24'x40'

MOOTECH Index No.
A3.11c


FILE PATH: 2440-A3.11.DWG

PROJECT NO. 3683
 PC-04-101268


FILE PATH: 2440-A3.11.DWG

KEY NOTES


- 1 TYPICAL EXTERIOR FINISH SEE EXTERIOR FINISH SCHEDULE BELOW.
- 2 EXTERIOR LIGHT FIXTURE (EL)
- 3 TOP OF SKIRTING
- 4 RAMP AND LANDING. - R1.01
- 5 HVAC UNIT (HV)
- 6 DOWNSPOUT FASTEN TO BUILDING TYPICAL (3) PLACES - 16/A2.03
- 7 CONTINUOUS GUTTER WITH DOWNSPOUT (LOCATION OF DOWNSPOUT SHOWN ON ROOF PLAN)
- 8 FOUNDATION VENT (SEE FOUNDATION PLAN)
- 9 FINISH FLOOR LINE
- 10 FLOOR BEAM (STR)
- 11 ROOF HEADER (STR)
- 12 TOP OF COLUMN
- 13 FINISH GRADE
- 14 ROOF BEAM (STR)
- 15 COLUMN (STR)
- 16 ELECTRICAL STUB-OUT (EL)
- 17 GROUND STUB-OUT (EL)
- 18 J-BOX FOR EXTERIOR FIRE ALARM HORN (EL)
- 19 GUTTER BOX (EL)
- 20 SIGNAGE PROVIDED AND INSTALLED BY DISTRICT PRIOR TO OCCUPANCY. 5/A5.01

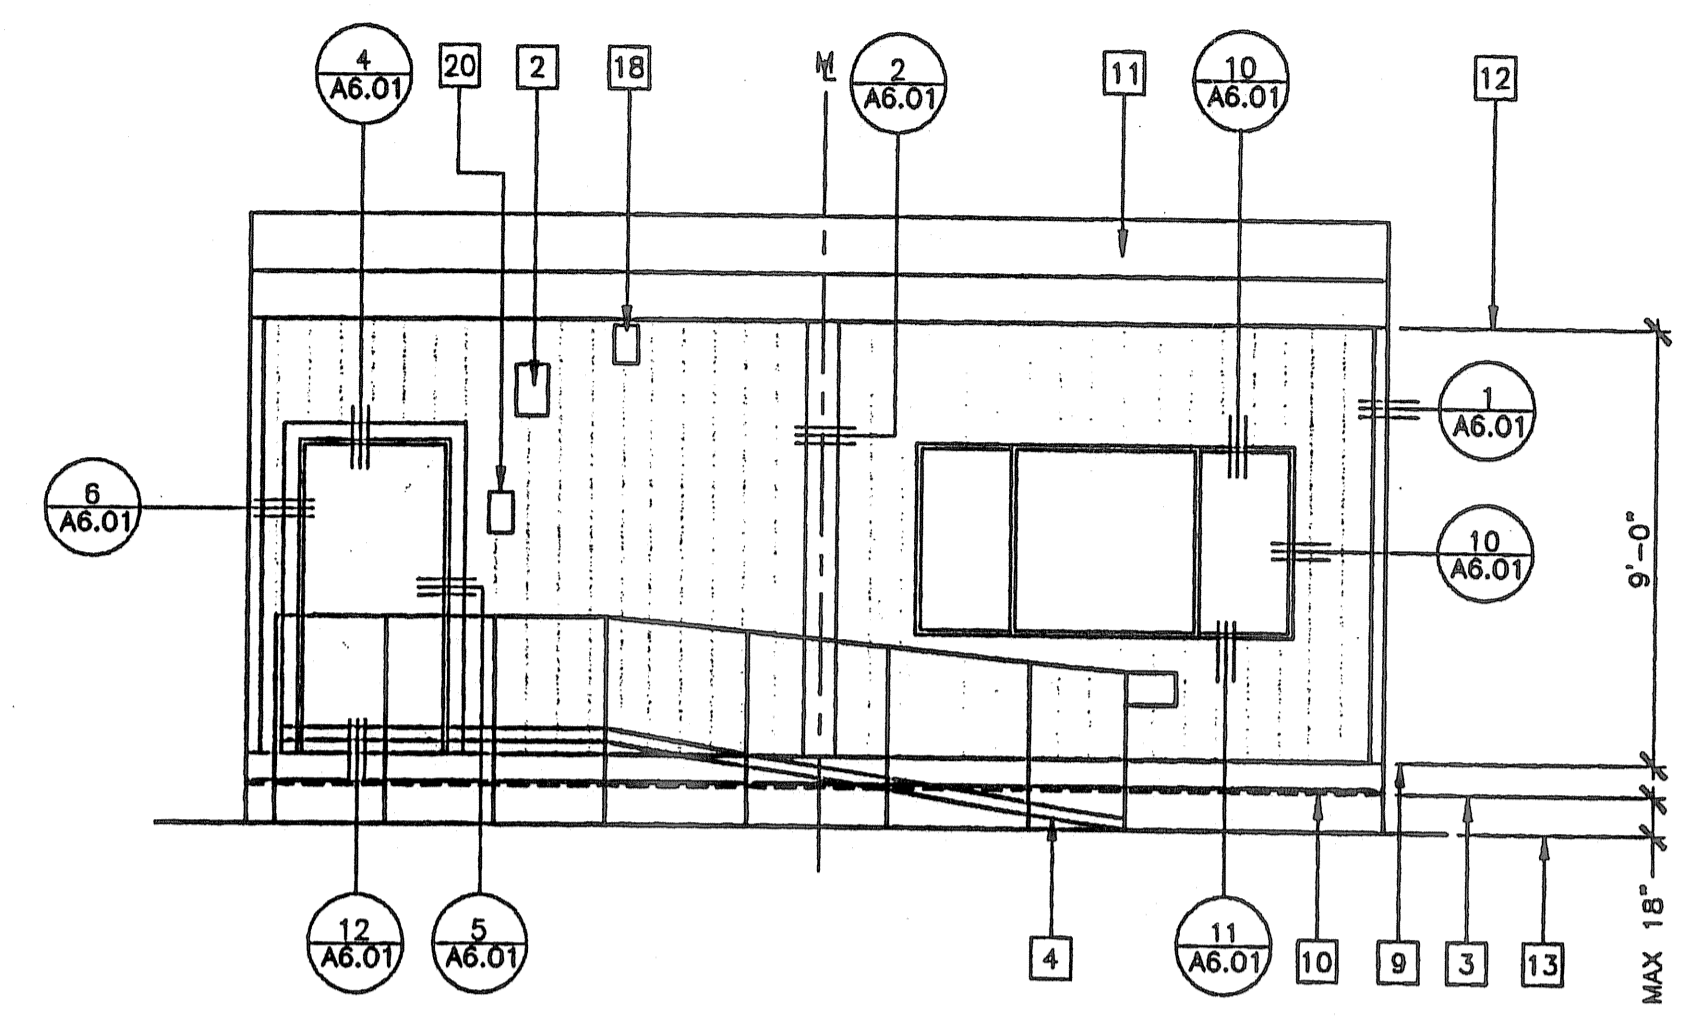


1 FRONT ELEVATION

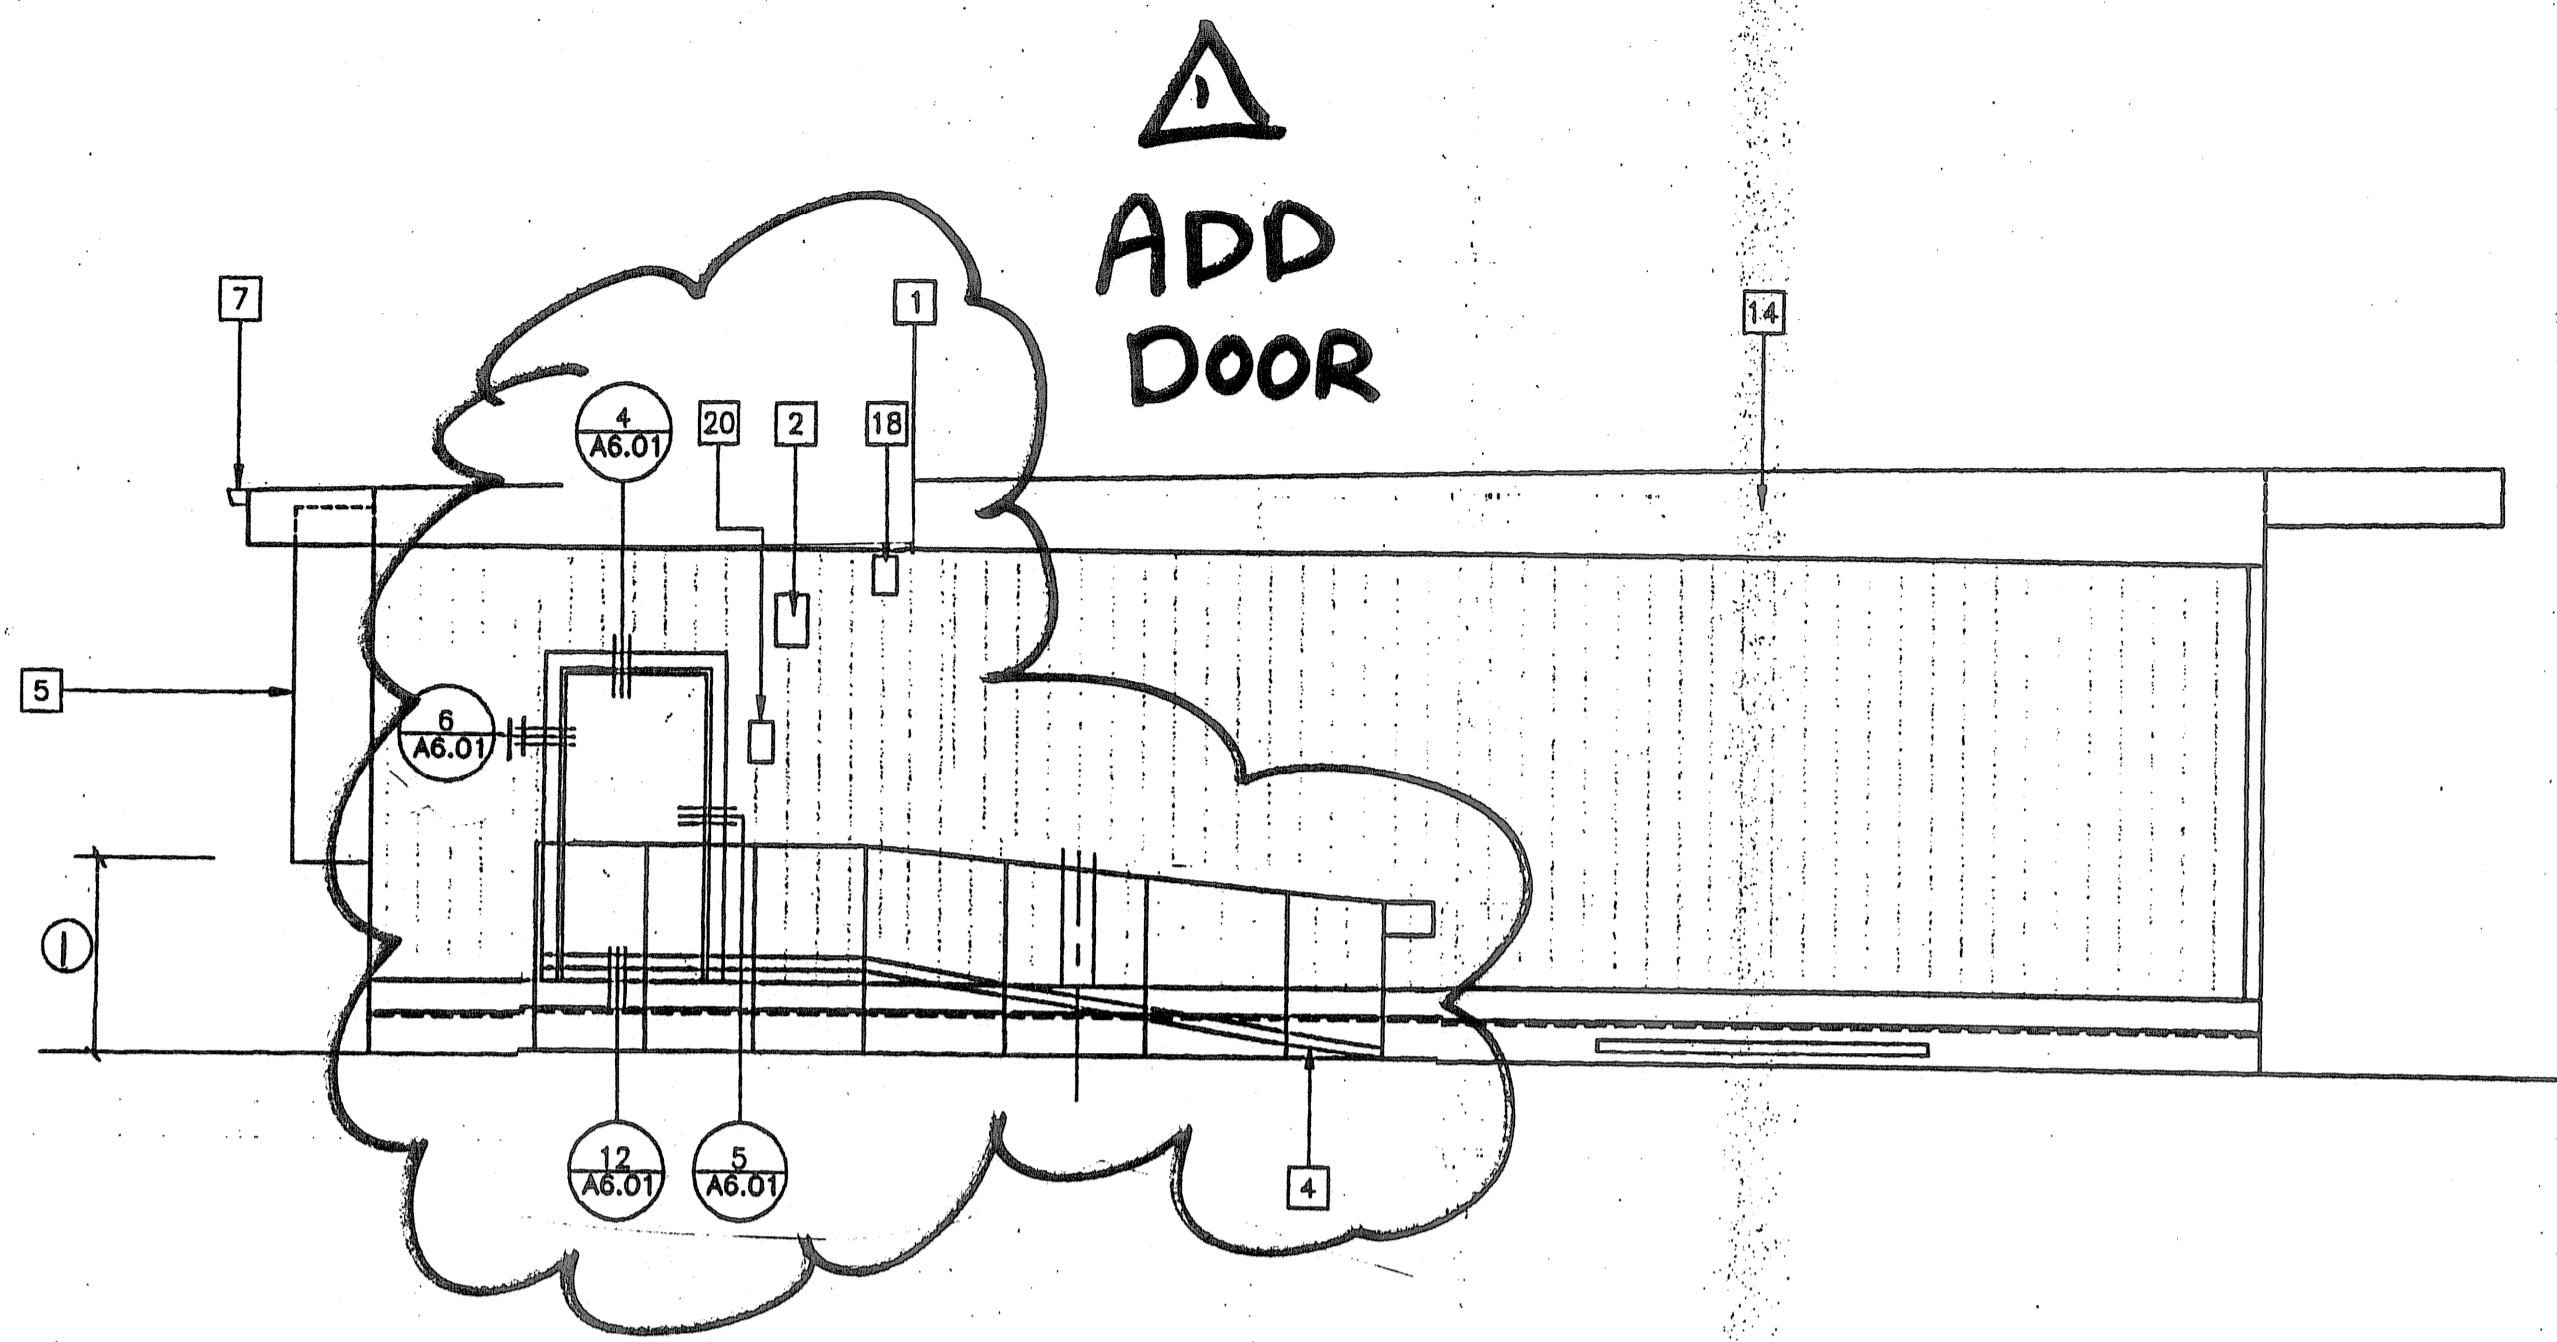

2 LEFT SIDE ELEVATION

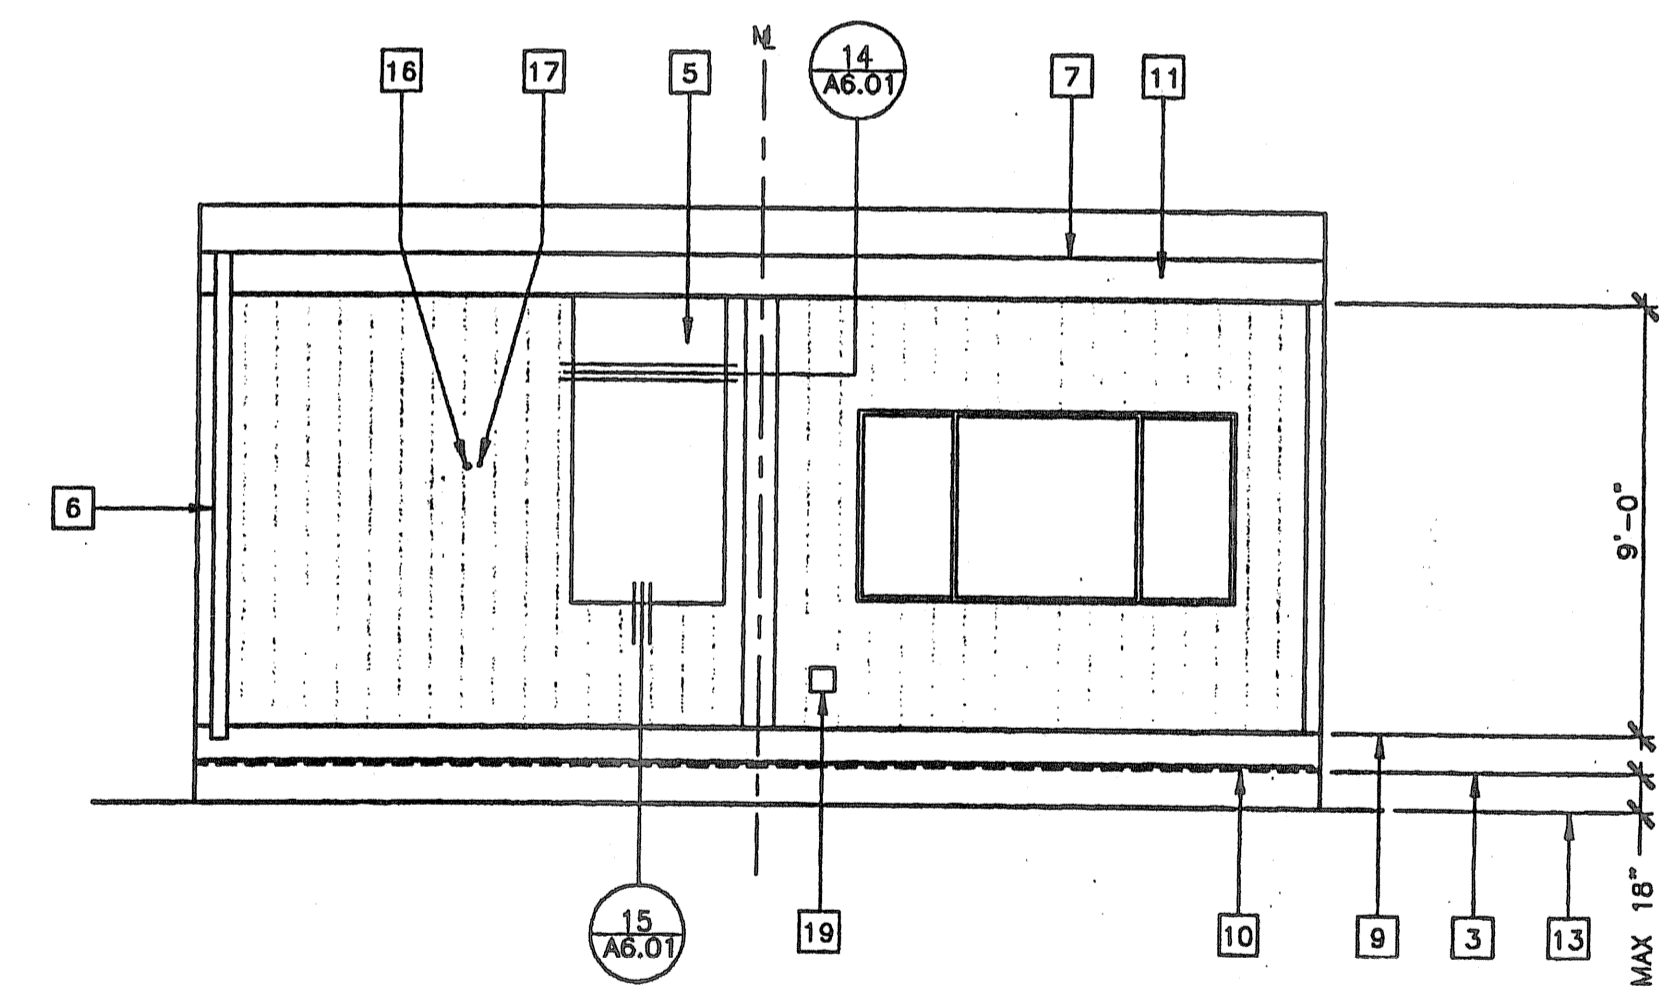

3 REAR ELEVATION

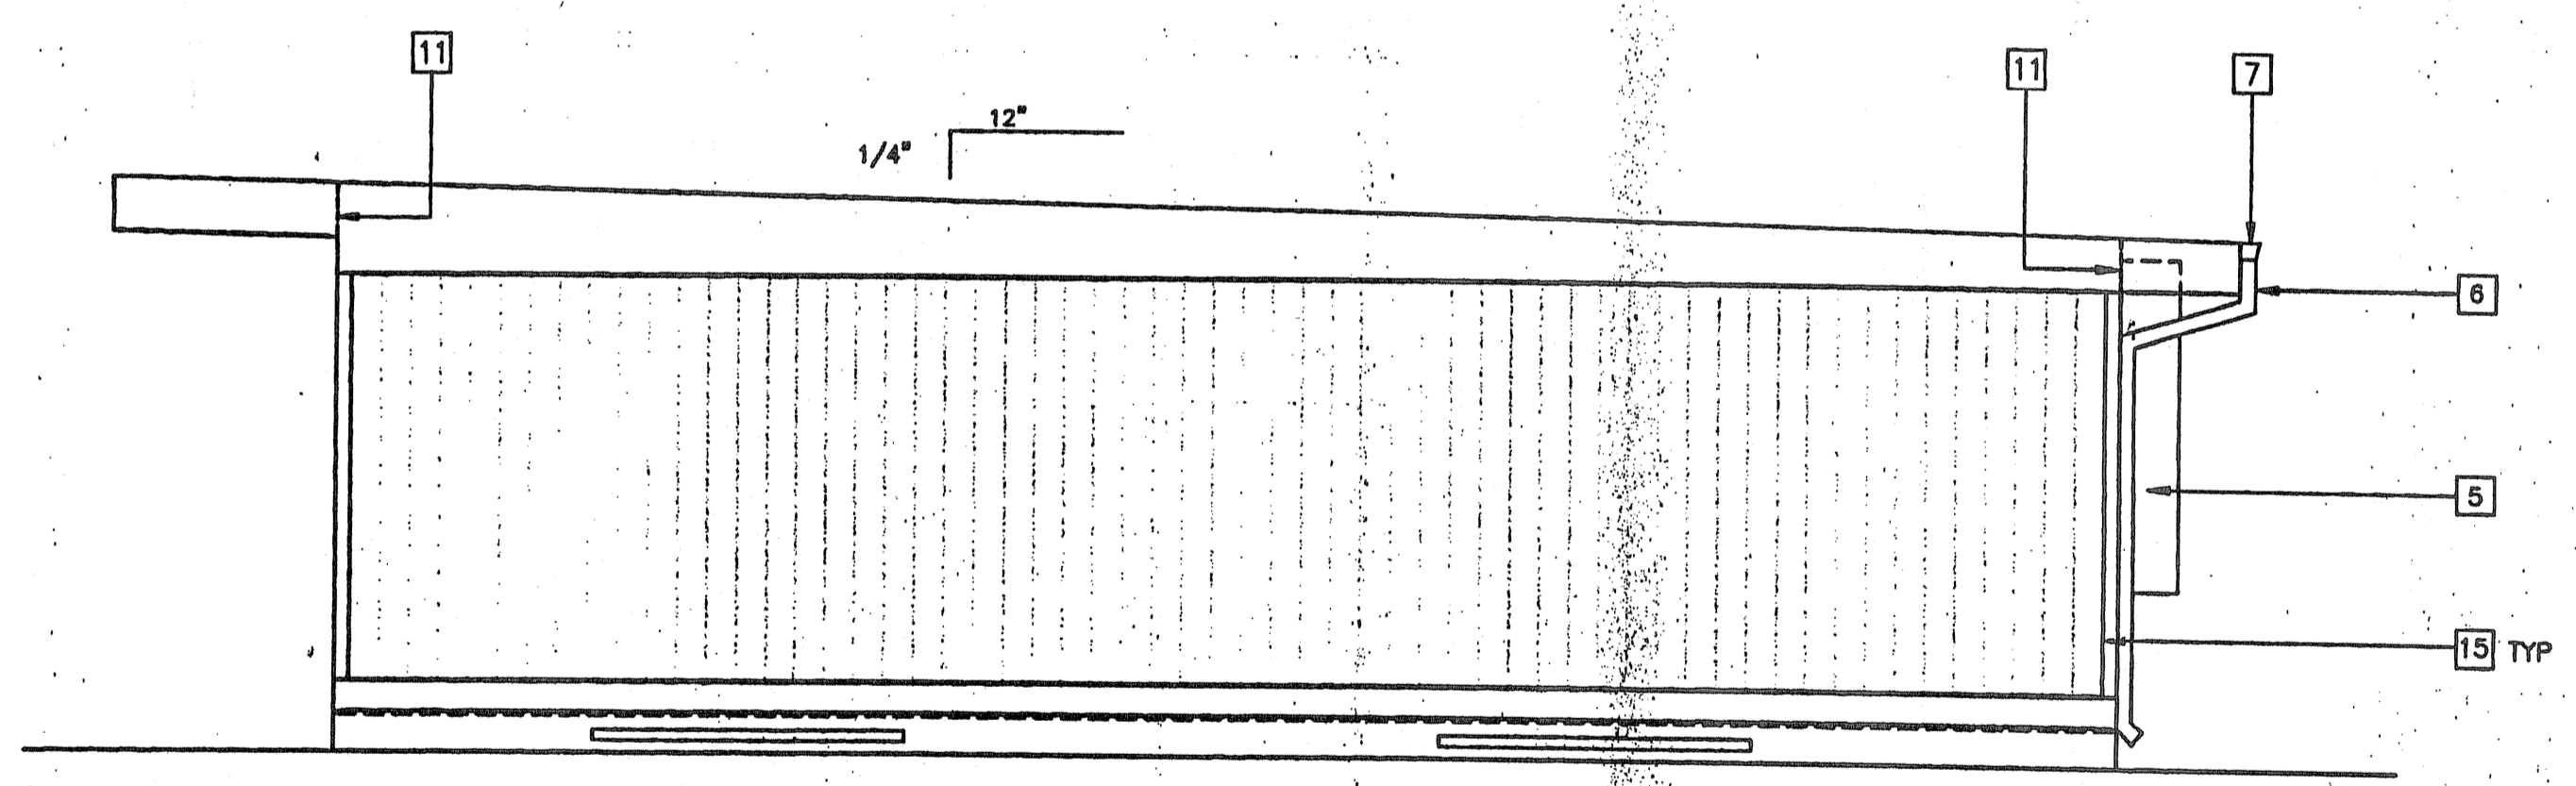

4 RIGHT SIDE ELEVATION

NOTES

- 1 IF HVAC UNIT IS LOCATED IN ANY PATH OF TRAVEL OR CIRCULATION AREA AND HEIGHT FROM GRADE TO BOTTOM OF UNIT EXCEEDS 27" PROTECTION MUST BE PROVIDED

EXTERIOR FINISH SCHEDULE


NOTE: SEE SPECIFICATIONS FOR DETAILED DESCRIPTION OF FINISH OPTIONS.

STANDARD - 5/8" PLYWOOD SIDING

OPTIONAL - 5/16" GROOVED FIBER CEMENT BOARD

OPTIONAL - 5/16" FIBER CEMENT BOARD WITH TEXTURED ELASTOMERIC COATING SYSTEM

OPTIONAL - EXTERIOR PLASTER OVER LATH

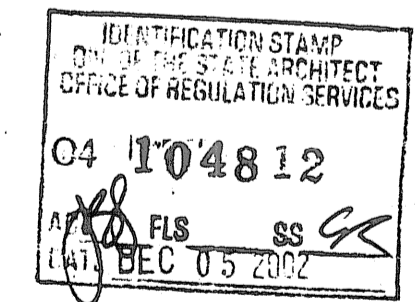

PC
CBC 1998

EXTERIOR ELEVATIONS

26 GA MONO PITCH (24'x40)
SCALE: 1/4" = 1'-0"

REVISIONS	Electrical Engineer's Seal	Mechanical Engineer's Seal	Structural Engineer's Seal	Architect's Seal


Electrical Engineer's Seal

Mechanical Engineer's Seal

Structural Engineer's Seal

Architect's Seal

IDENTIFICATION STAMP
 DIV. OF THE STATE ARCHITECT
 OFFICE OF REGULATION SERVICES
 PC-04
 101268
 AC: D PLS SS GK
 DATE: SEP 07 1999

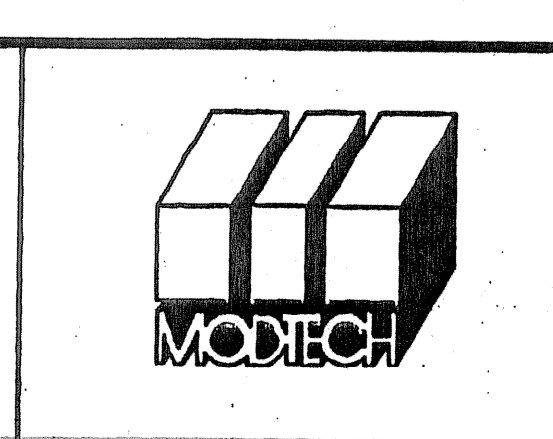

MODTECH INC.
 2830 BARRETT AVENUE
 PERRIS, CALIF. 92572
 PH (909) 943-4014
 FAX (909) 940-0427

PROJECT NUMBER: 4373-M, 4373-M, 4434, 4438 © MODTECH 2002
 4474
 1- 24x40 CLASSROOM A#04-104812 STKP-67
 #CL 2443 SERIAL # 59195-96 3/14/05
 EDISON E.S.D. AT ORANGEWOOD ELEMENTARY


DRAWN BY: KK
 DATE: 11/19/02
 CHECKED BY: STKP-67
 DATE: 4/02-124
 MODTECH Index No.
A3.11M

EXTERIOR ELEVATIONS 26 GA MONO PITCH 24'x40'


PROJECT NO. 4373
PC-04-101268

KEY NOTES


- 1 TYPICAL INTERIOR FINISH (FIN)
- 2 CLOSURE AT MODULAR JOINT
- 3 DUPLEX WALL RECEPTACLE (EL)
- 4 J-BOX FOR FIRE ALARM PULL STATION (EL)
- 5 LIGHT SWITCH (EL)
- 6 BASE
- 7 RETURN AIR GRILL
- 8 ELECTRICAL PANEL (EL)
- 9 FINISH FLOOR LINE (FIN)
- 10 THERMOSTAT (HV)
- 11 MODULAR JOINT
- 12 8040 MARKBOARD, TYPICAL FOR (2)
- 13 FIRE EXTINGUISHER: 5 LBS DRY CHEMICAL WITH 2A-10BC UL RATING ON WALL MOUNTED BRACKET, HANDLE AT 48" AFF
- 14 ELECTRIC CLOCK (EL)
- 15 PROVIDE BLOCKING FOR FUTURE TV BRACKET

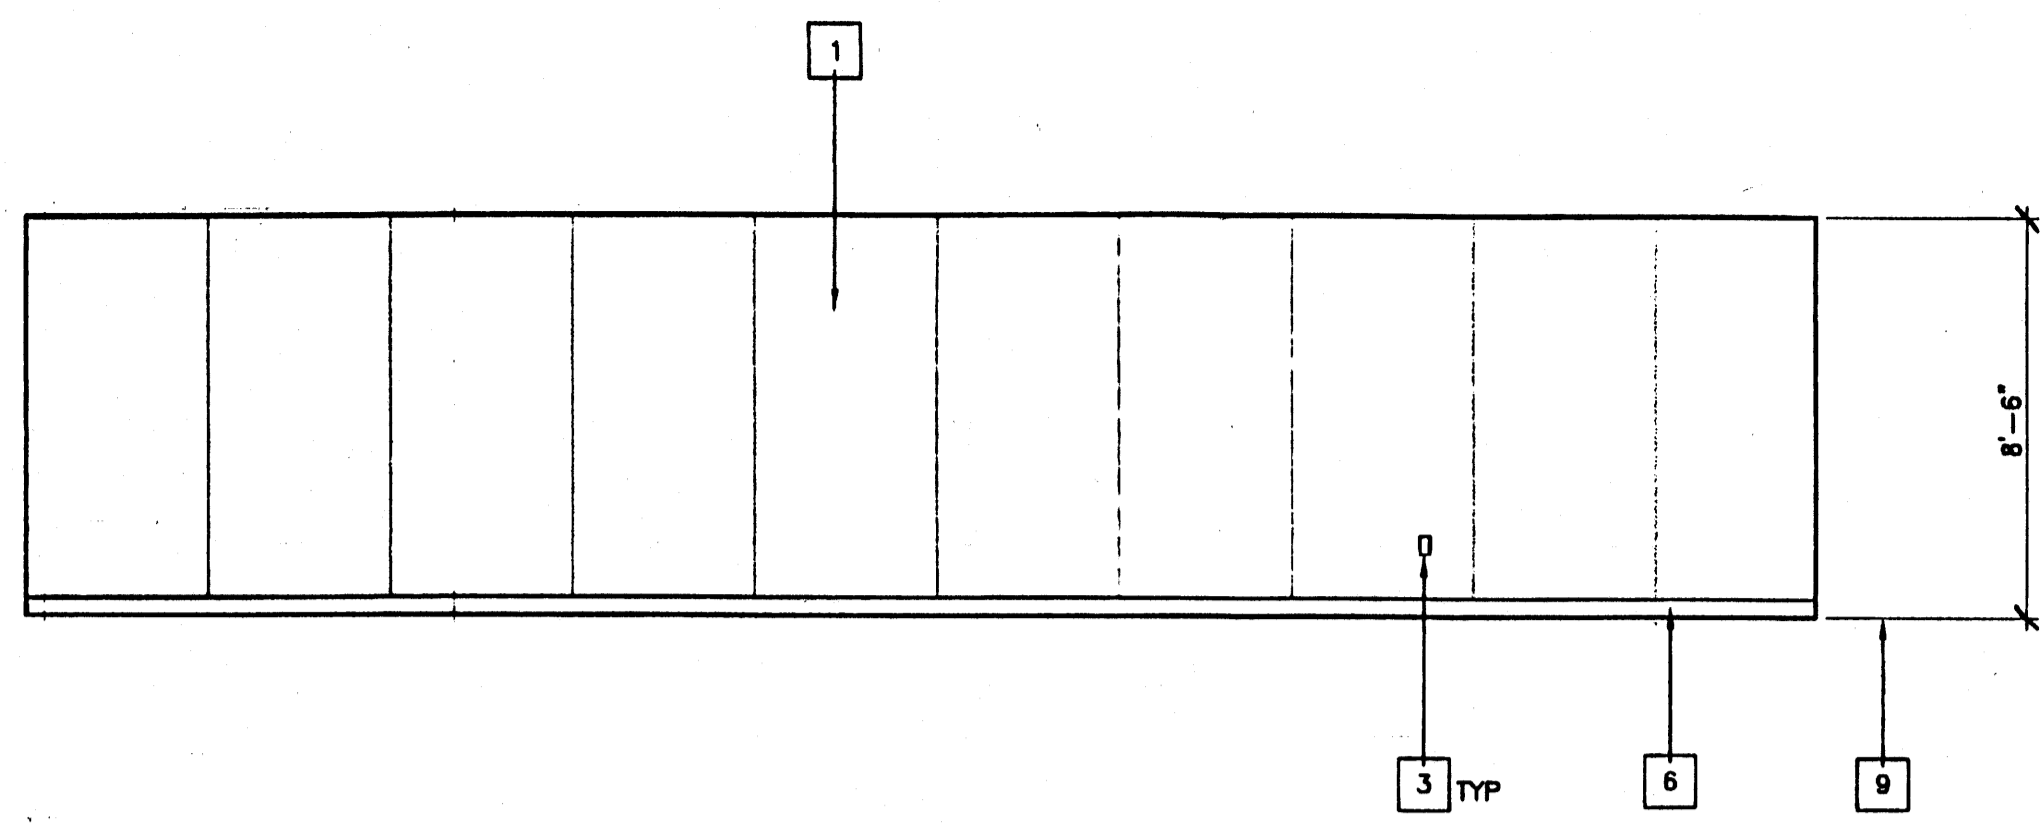


1 LEFT ELEVATION

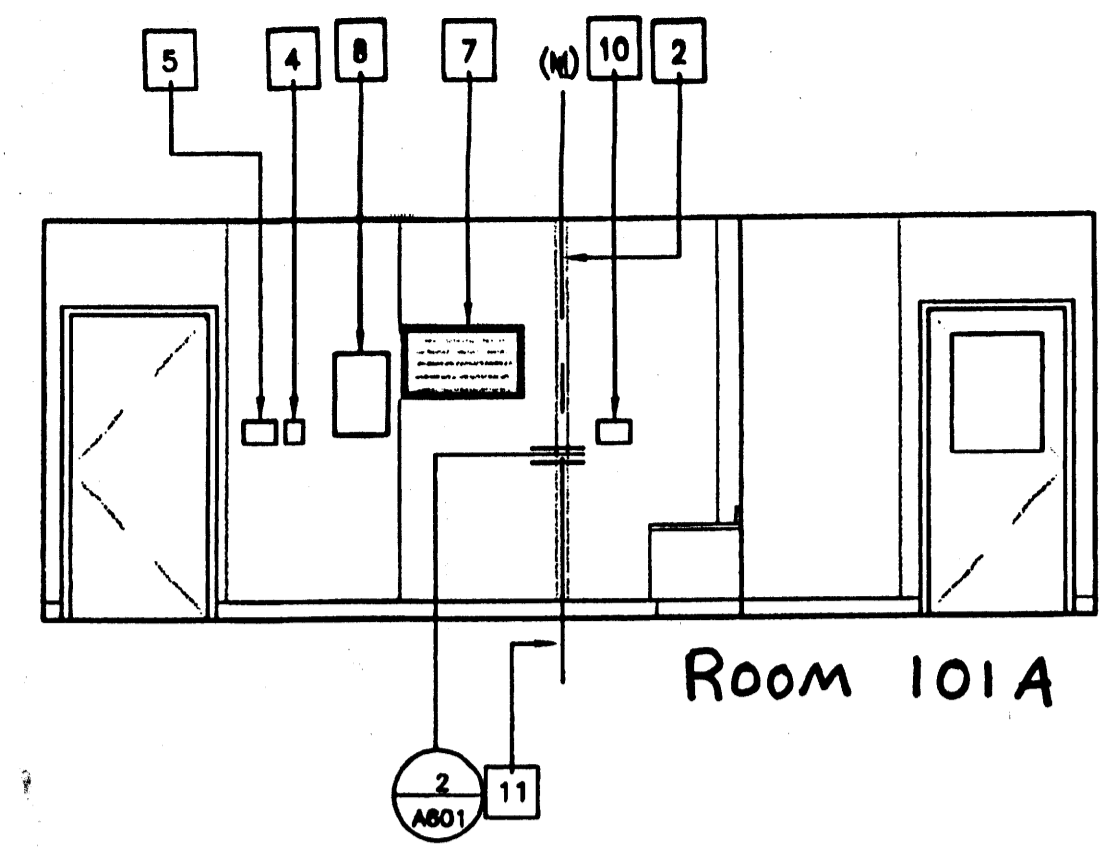


2 REAR ELEVATION

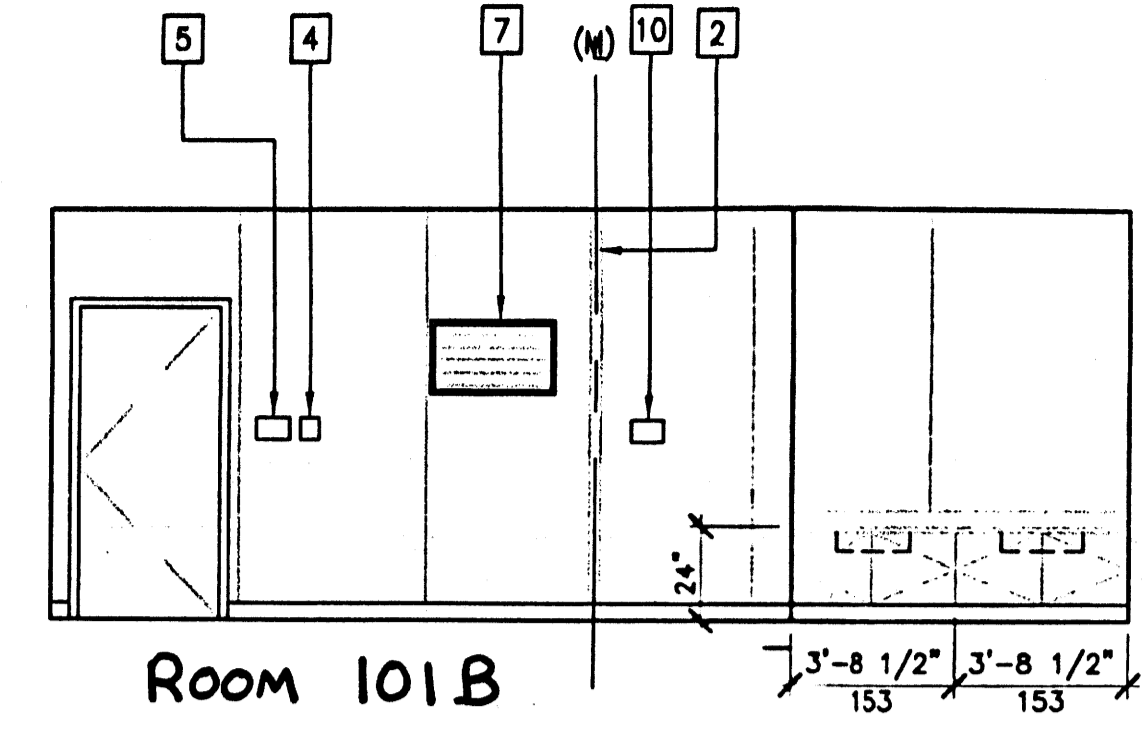

Room 101B

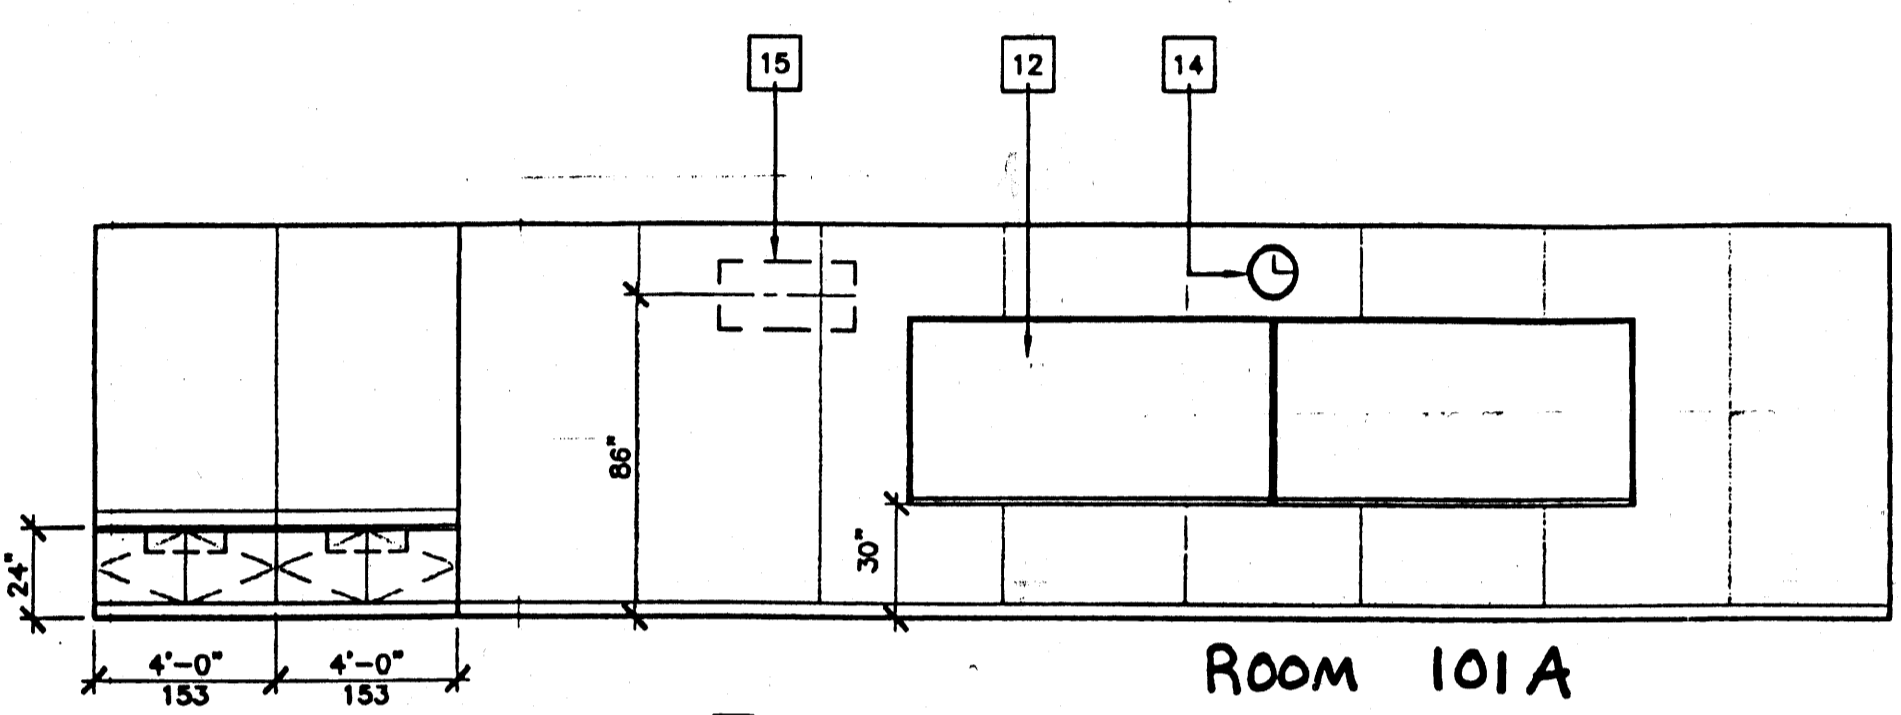


Room 101A

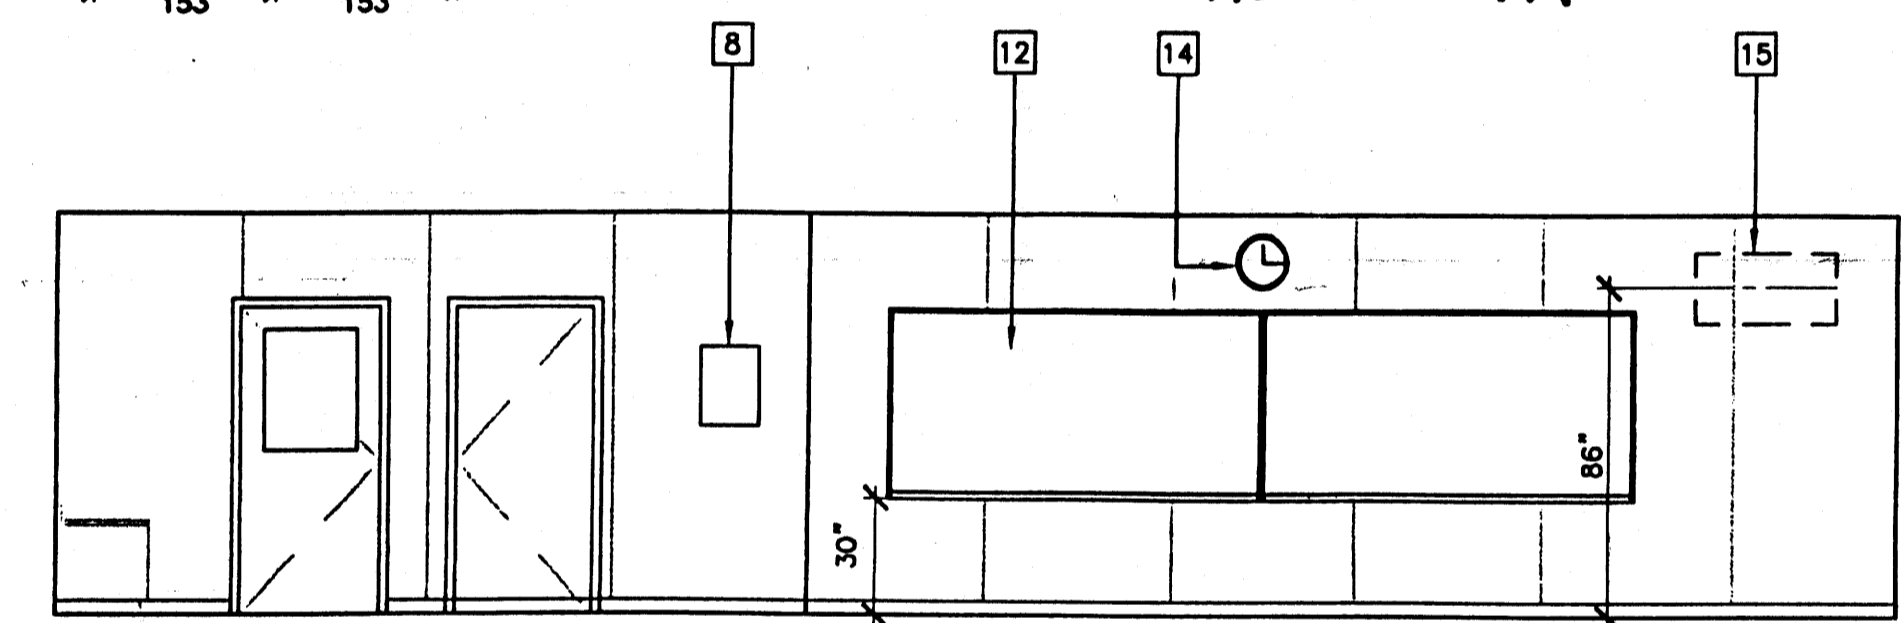


Room 101B


3 RIGHT SIDE ELEVATION

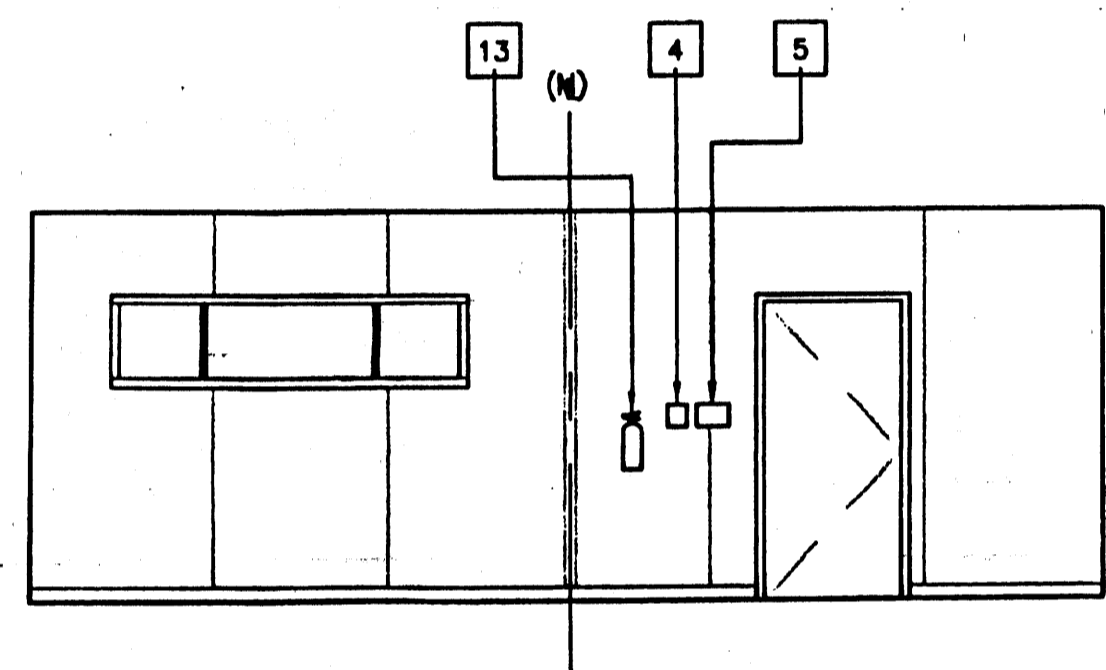


4 FRONT ELEVATION

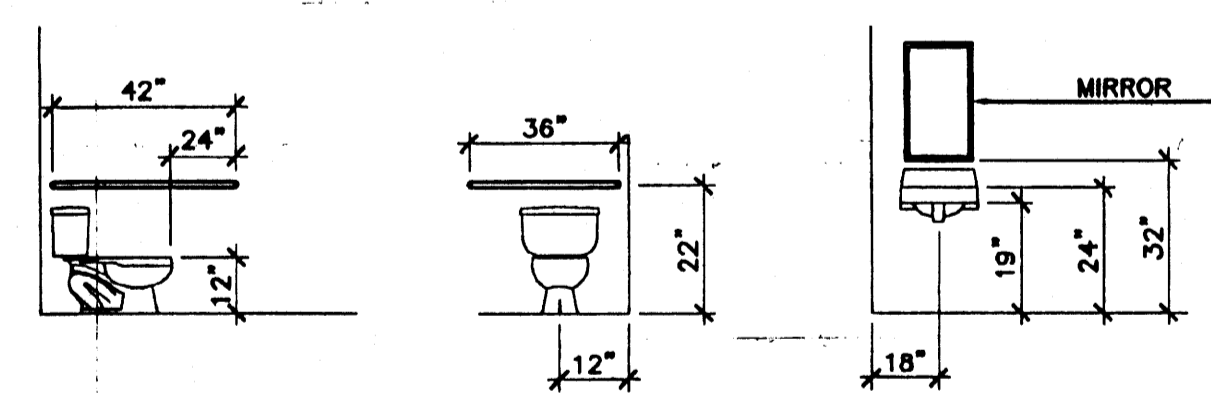

RESTROOM ELEVATION ROOM 102

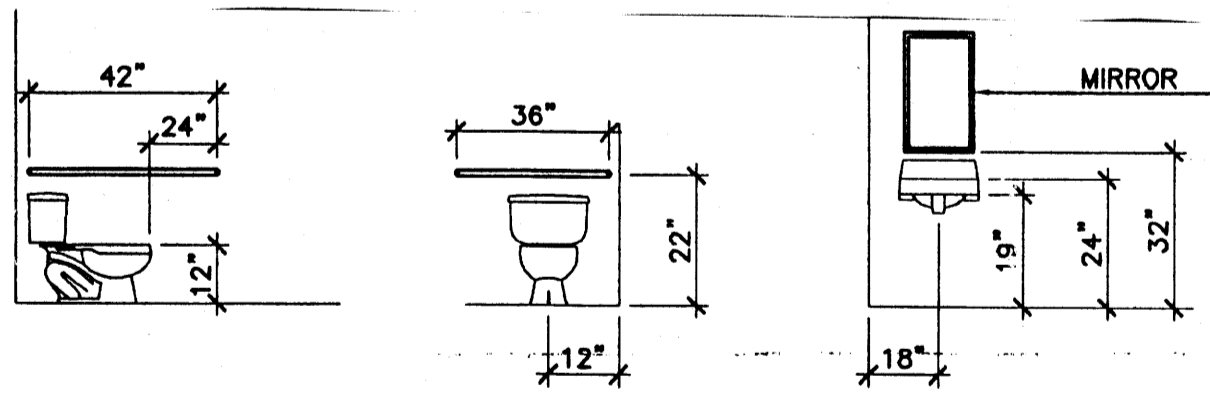

RESTROOM ELEVATION - ROOM 103

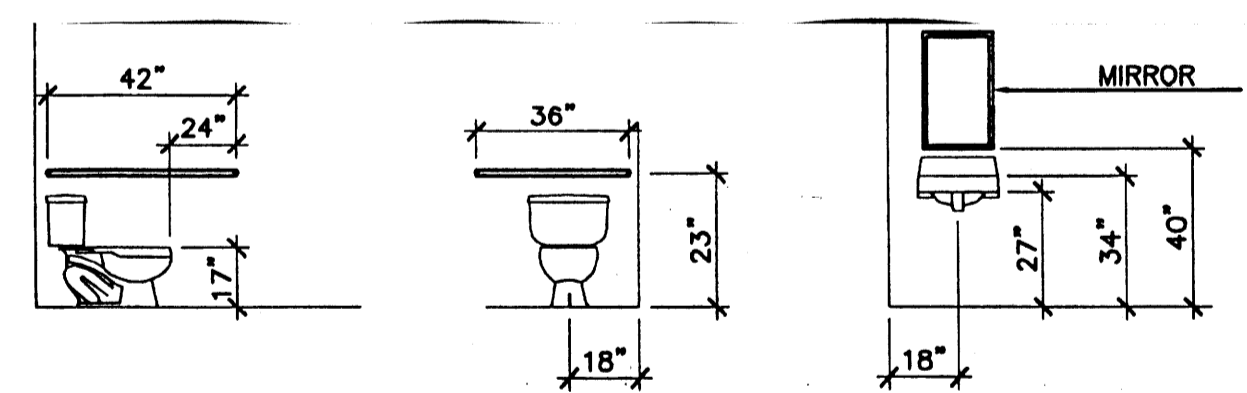

RESTROOM ELEVATION - ROOM 104

INTERIOR ELEVATIONS "C" (24'x40') SCALE: 1/4" = 1'-0"

REVISED

IDENTIFICATION STAMP
DIV. OF THE STATE ARCHITECT
OFFICE OF REGULATION SERVICES
04 104812
DATE DEC 7 9 2002


BASED ON PC04-101268

REVISIONS	Electrical Engineer's Seal	Mechanical Engineer's Seal	Structural Engineer's Seal	Architect's Seal

Electrical Engineer's Seal
Mechanical Engineer's Seal
Structural Engineer's Seal

ARCHITECT'S SEAL
C. EDWARDS
STATE OF CALIFORNIA
NOV 9 30

IDENTIFICATION STAMP
DIV. OF THE STATE ARCHITECT
OFFICE OF REGULATION SERVICES
PC-04 101268
DATE

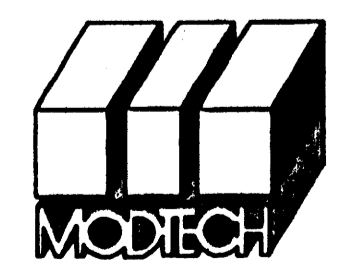

MODTECH INC.
2830 BARRETT AVENUE
PERRIS, CALIF. 92572
PH (909) 943-4014
FAX (909) 940-0427

PROJECT NUMBER: 4404
CHINO
CLASS LEASING

© MODTECH, INC. 1999
CLASS LEASING INC STOCKPILE # 67
100-24 x 40 CLASSROOM BUILDINGS
4012-124 12/05/2002 80 MPH


DRAWN BY: SW
DATE: 6/26/01
CHECKED BY:
DATE:

INTERIOR ELEVATIONS

24'x40'

A4.01 c


FILE PATH: 2440-A4.01.DWG PROJECT NO. 3883 PC-04-101268

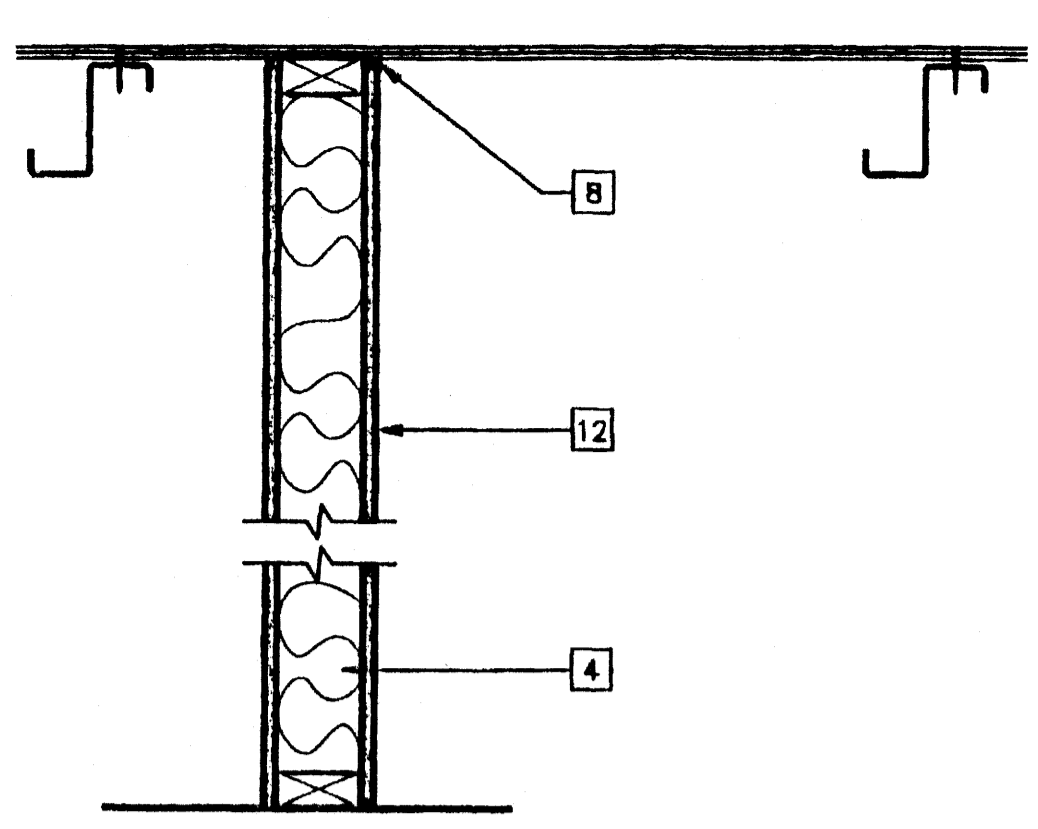

(SEE 14, 15/S4.02)

**GYPSUM WALL BOARD
WOOD STUDS**


ONE LAYER 5/8" TYPE X GYPSUM WALL BOARD OR GYPSUM VENEER BASE APPLIED PARALLEL OR AT RIGHT ANGLES TO EACH SIDE OF 2"x4" WOOD STUDS AT 24" OC WITH 6d COATED NAILS, 1 7/8" LONG, 0.0915 SHANK, 1/4" HEADS, 7" OC. JOINTS STAGGERED 24" ON OPPOSITE ENDS (LOAD BEARING)

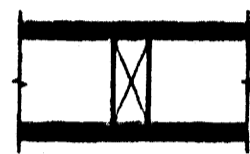

THICKNESS: 4 3/4"
APPROXIMATE WEIGHT: 7 PSF
FIRE TEST: UL R3501-47, -48, 9-17-65, DESIGN U309; UL R1319-129, 7-22-70, DESIGN U314


SOUND TEST: NGC 2404, 10-14-70

SCALE: 1 1/2"=1'-0" (OPTIONAL)

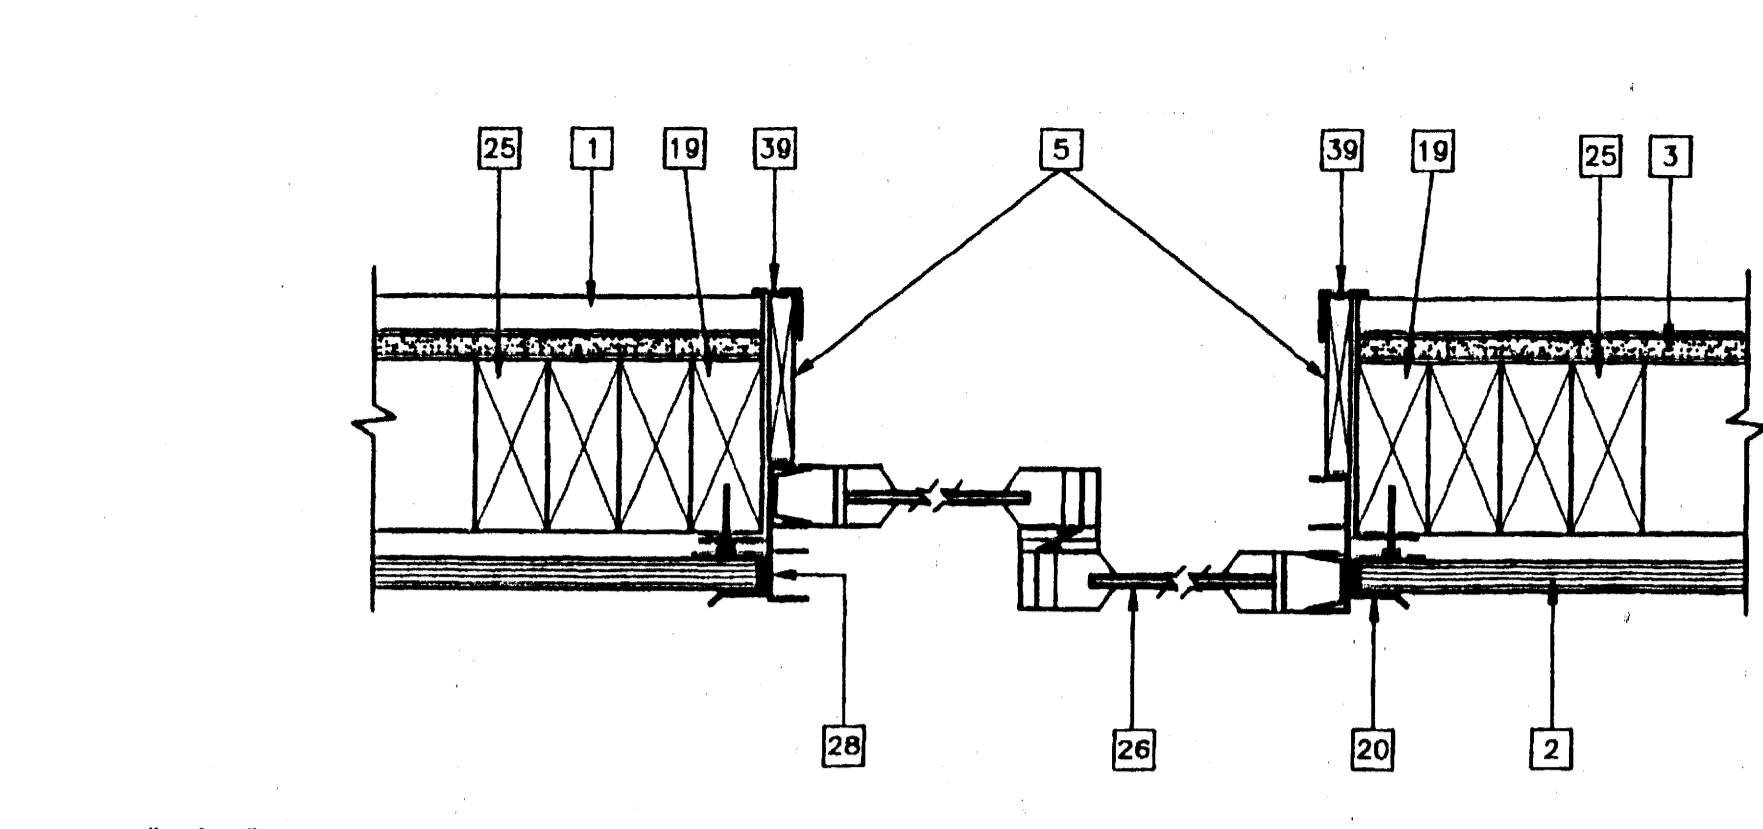


SCALE: 3"=1'-0"


WINDOWS SECTION AT JAMBS

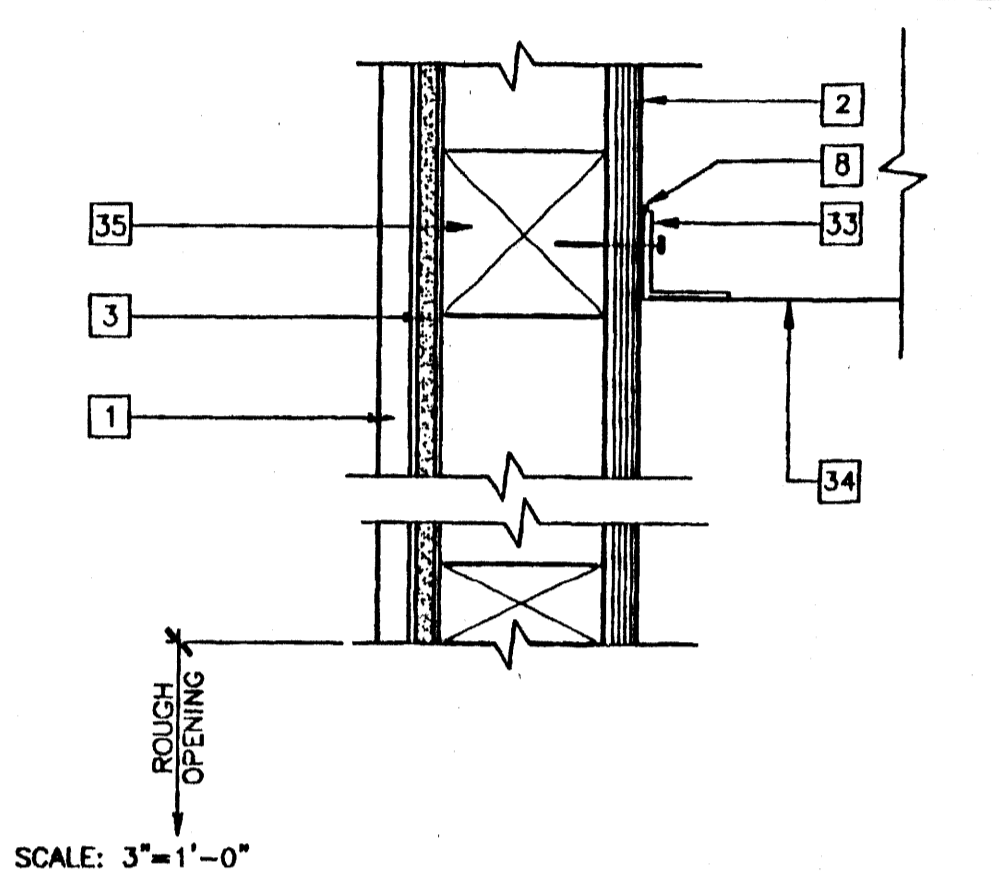

SCALE: 3"=1'-0"

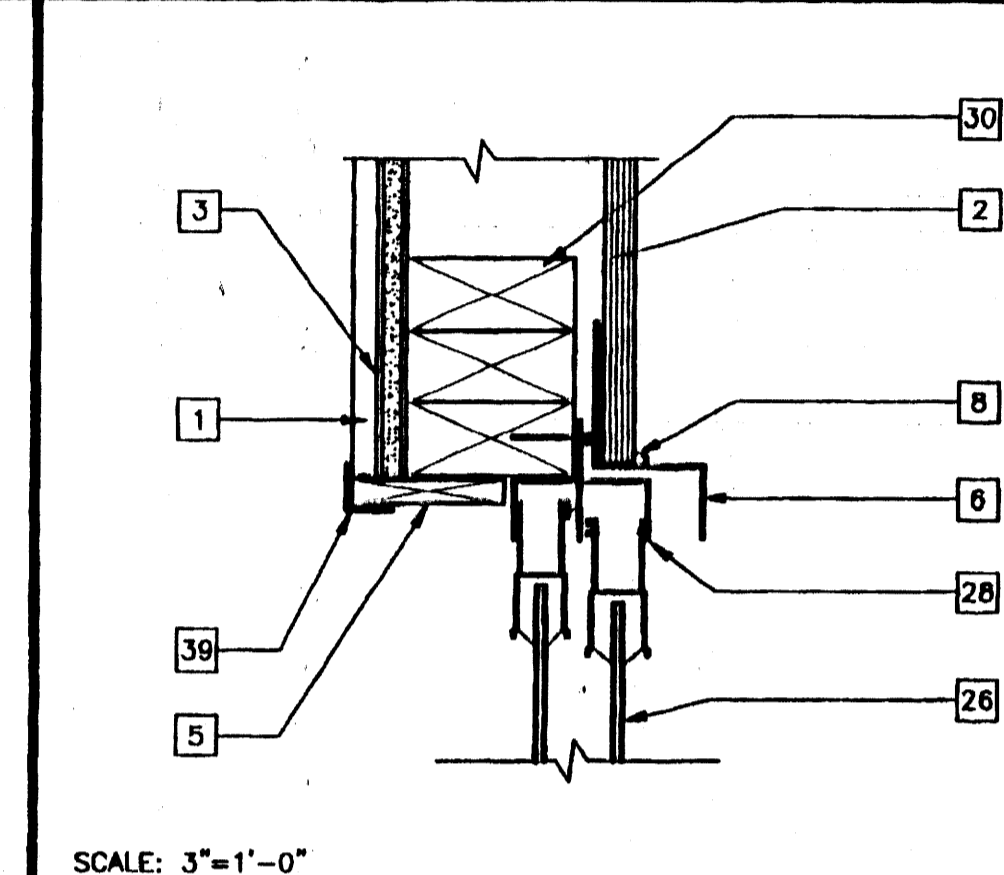


SCALE: 3"=1'-0"

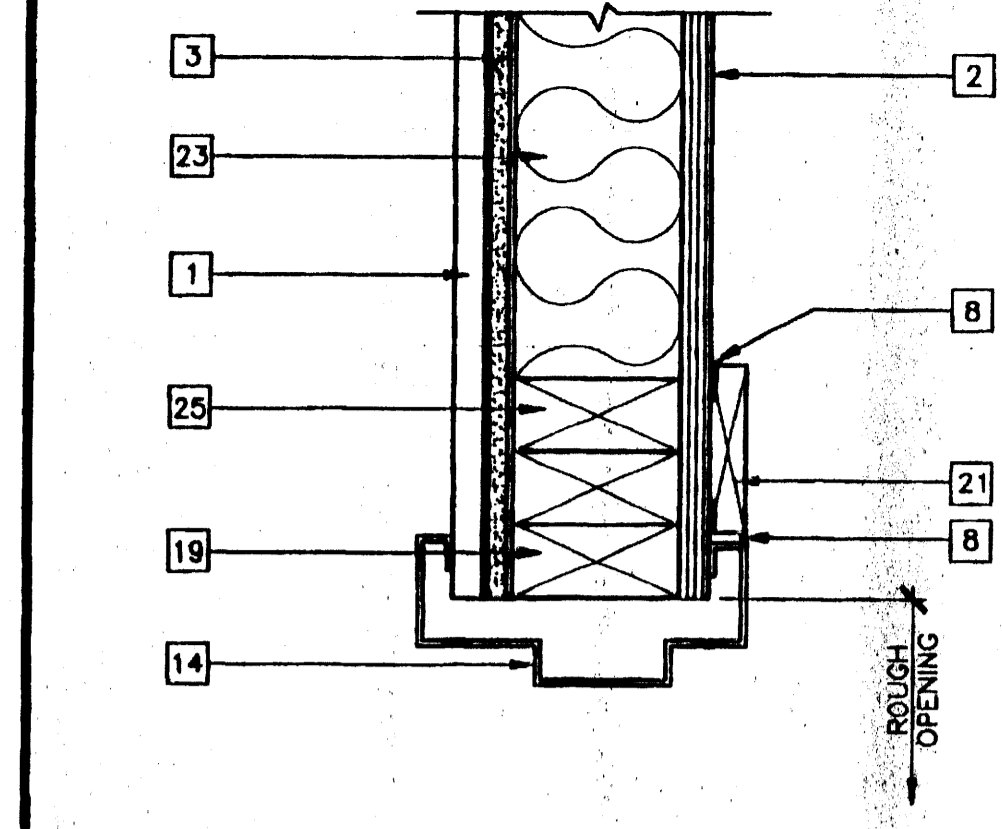


SCALE: 3"=1'-0"

EXTERIOR DOOR JAMB

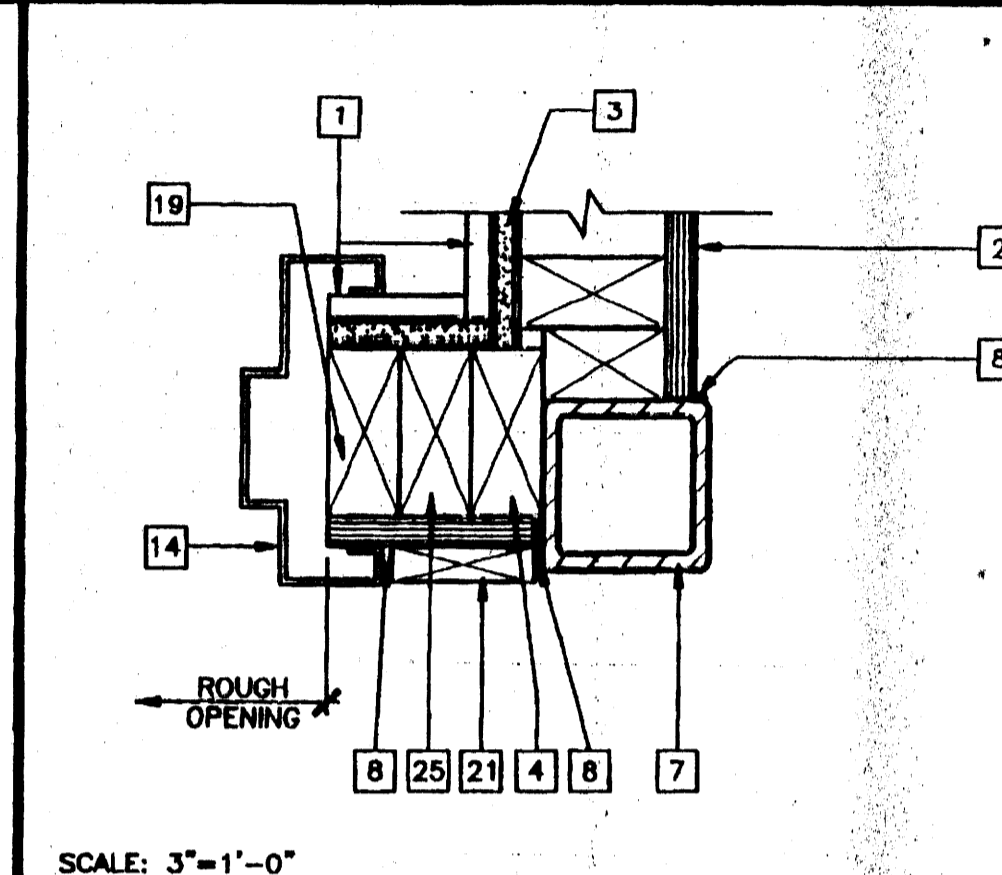


SCALE: 3"=1'-0"

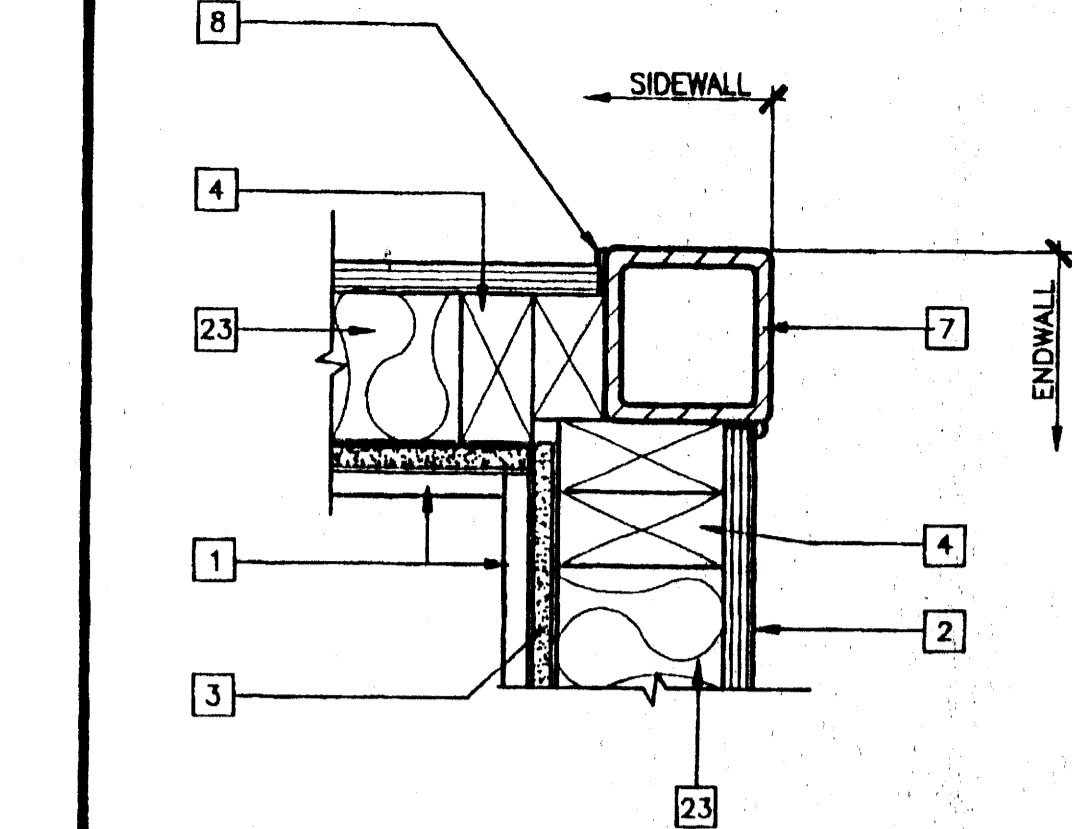

SCALE: 3"=1'-0"


COLUMN AT CORNER

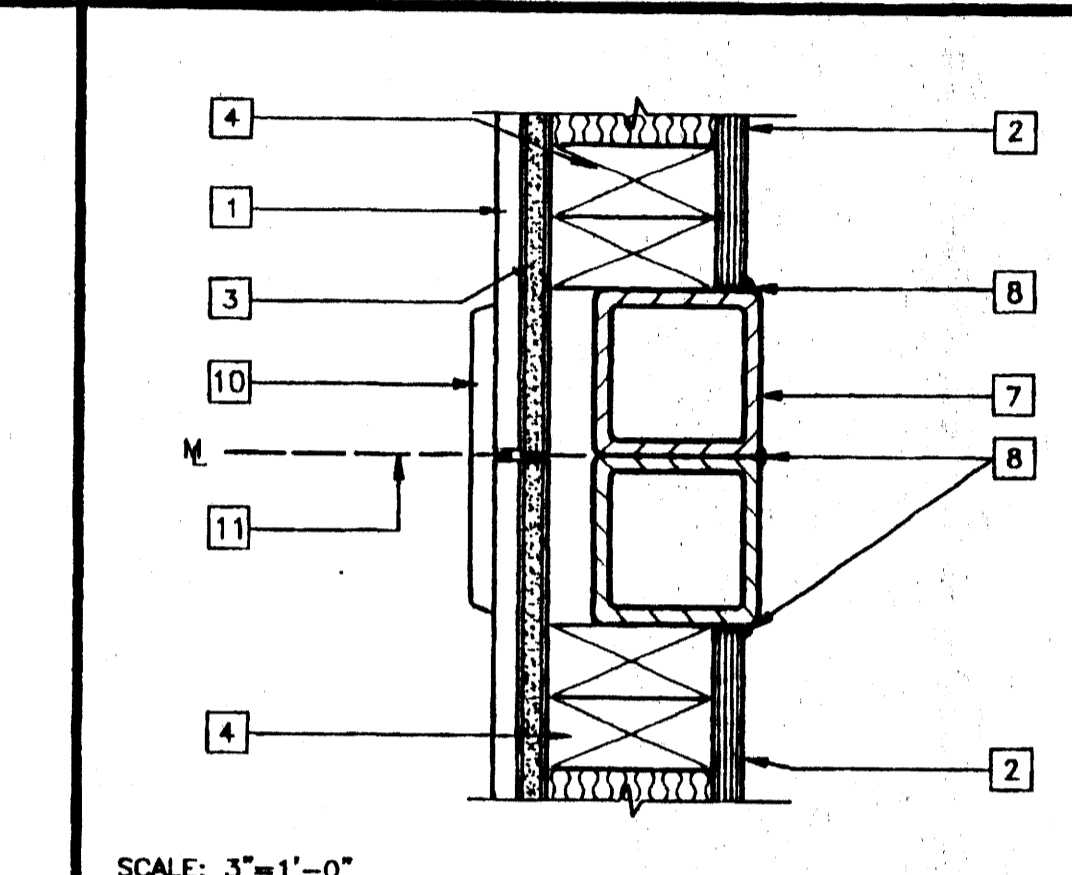

SCALE: 3"=1'-0"


- KEY NOTES**
- 1 TYPICAL INTERIOR FINISH (FIN) - 1/A5.01
 - 2 TYPICAL EXTERIOR FINISH (SEE EXTERIOR ELEVATIONS)
 - 3 1/2" GYPSUM BOARD BACKING WITH 7d COOLER NAILS AT MAX 7" OC TYPICAL AT EACH STUD
 - 4 2"x4" STUD TYPICAL
 - 5 INTERIOR WOOD TRIM.
 - 6 DRIP FLASH 28 GA
 - 7 TUBE STEEL COLUMN (STR)
 - 8 SEALANT TYPICAL (SEE SPECS.)
 - 9 CAULKING
 - 10 CLOSURE
 - 11 MODULE JOINT
 - 12 5/8" TYPE X GYPSUM BOARD
 - 13 FLOOR BEAM (STR)
 - 14 PRESSED STEEL FRAME - 6/A5.01
 - 15 ALUMINUM THRESHOLD - 1/4" WITH 2:1 BEVEL - 8/A5.01
 - 16 FINISH LANDING
 - 17 DOOR BOTTOM - 8/A5.01
 - 18 (2) 2"x4" KING STUD - 13/S4.02
 - 19 2"x4" TRIMMER STUD - 13/S4.02
 - 20 'J' MOLD 26 GA
 - 21 1"x4" WOOD TRIM WITH 8d ELECTRO GALVANIZED AT 12" OC
 - 22 SILL PLATE - 13/S4.02
 - 23 INSULATION (SEE SPECS. FOR SIZE AND TYPE)
 - 24 FINISH FLOORING - 1/A5.01
 - 25 2"x4" FULL HEIGHT JAMB STUDS - 13/S4.02
 - 26 WINDOW GLAZING - 3/A5.01
 - 27 HVAC UNIT BOTTOM SEAT 12 GA#24" LONG WITH (6) 3/8" DIA#2" LAG BOLTS
 - 28 ALUMINUM NAIL ON WINDOW FRAME. INSTALL WITH 8d BOX ELECTRO GALVANIZED NAILS AT 24" OC MAXIMUM WITH MINIMUM 3" BUILDING PAPER BETWEEN FRAME AND WALL
 - 29 #14 x2" SMS INTO PURLIN (TYP 4 PLACES)
 - 30 HEADER - 13/S4.02
 - 31 DOOR - 6/A5.01
 - 32 FINISHED FLOOR LINE
 - 33 HVAC SIDE BRACKET (FURNISHED WITH UNIT) ATTACH TO WALL WITH 3/4"x2" LAG SCREWS
 - 34 HVAC UNIT (HV)
 - 35 4"x4" POST OR ALTERNATE - (2) 2"x4" FULL HEIGHT STUDS WITH 1/2" PLYWOOD SPACER STITCH NAILED WITH 18d AT 12" OC STAGGERED
 - 36 2"x6" LET-IN - S4.01
 - 37 18 GA GALVANIZED IRON HAT
 - 38 CLOSURE SCREEN
 - 39 CORNER MOLDING
 - 40 18 GA x2" WIDE ANGLE WITH 2-#10 SMS EACH LEG
 - 41 18 GA x2" WIDE 5 1/2" DEEP 5' LONG RUNNER
 - 42 3/4" PLYWOOD SHEATHING
 - 43 14 GA x2" ROOF PURLIN AT 48" OC
 - 44 #14 x2" SMS THRU ROOF CURBS INTO PURLIN (TYP 4 PLACES)
 - 45 #8x3/4" SMS AT 5" OC MIN
 - 46 ROOF PURLIN
 - 47 24 GA ROOF CURB SECURE TO ROOF
 - 48 18 GA x2" W/ANGLES SECURE TO A/C UNIT W/2 #10 SMS SECURE TO UNIT W/1 #14 SMS (TYP 2 PLACES)
 - 49 #10 x3/4" SMS (TYP 4 PLACES)

ONE HOUR INTERIOR FIRE WALL

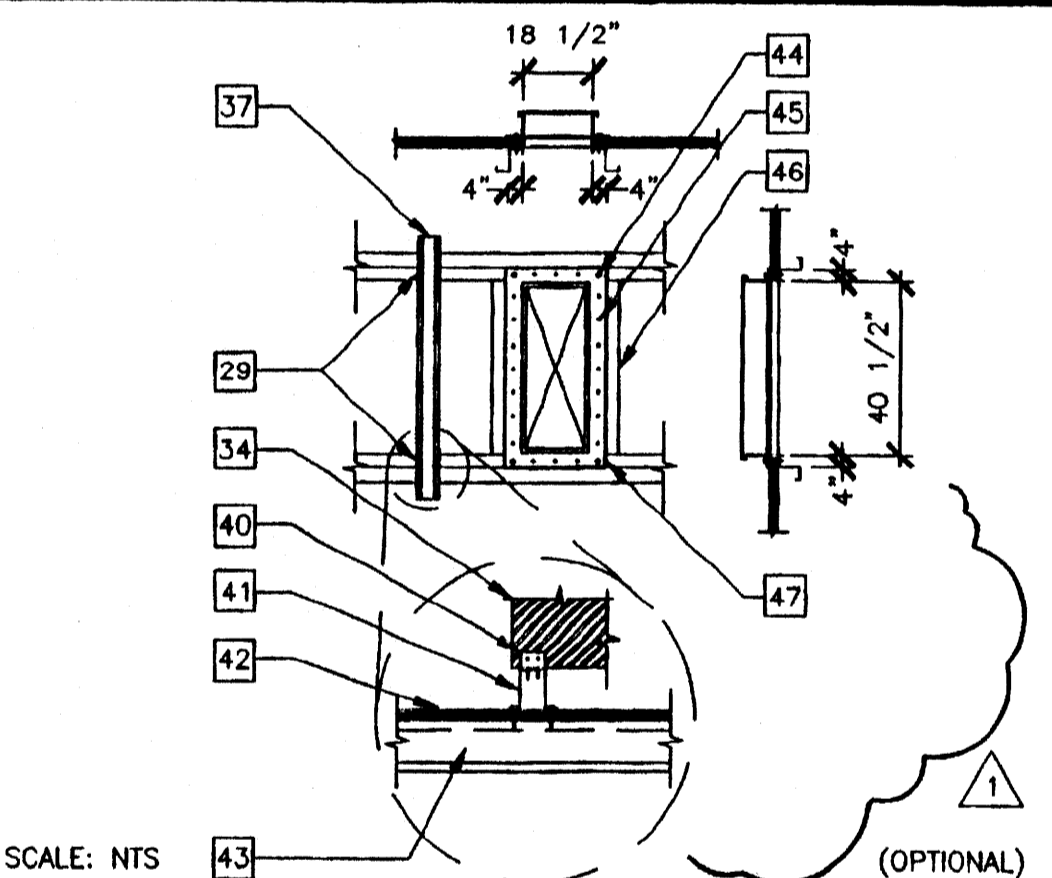


SCALE: NTS (OPTIONAL)

HVAC MOUNT AT JAMBS

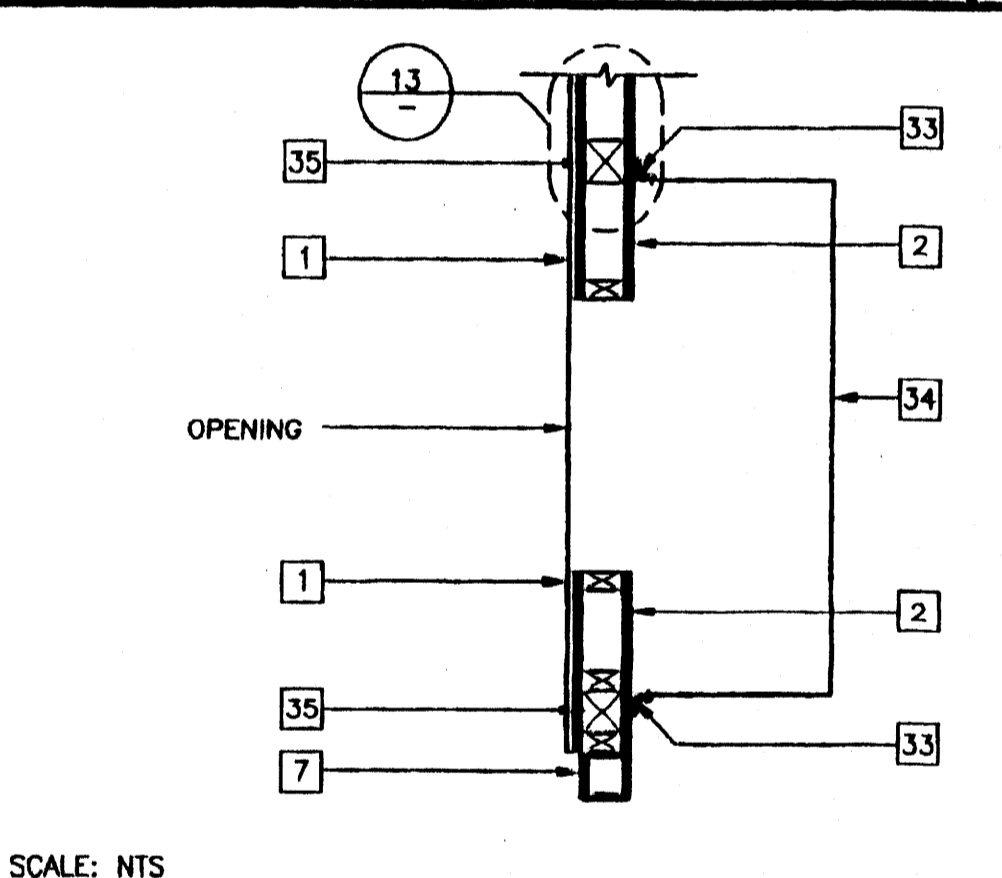


SCALE: NTS

WINDOW HEADER

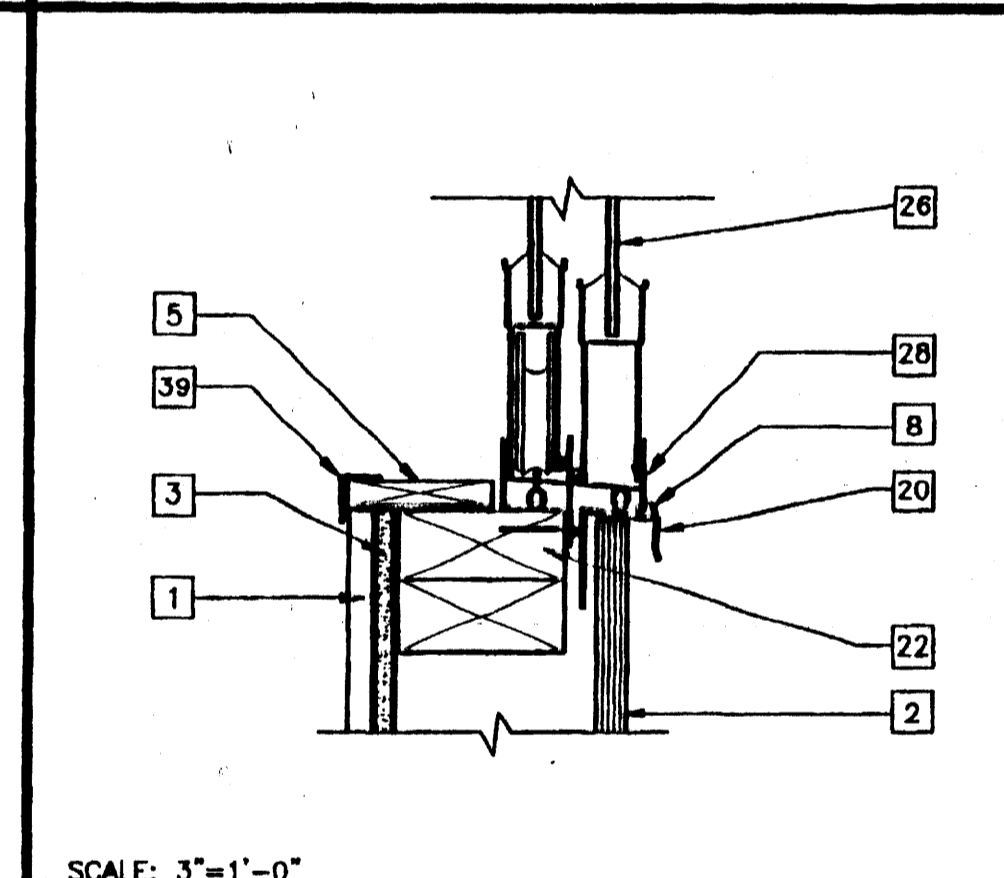


SCALE: 3"=1'-0"

EXTERIOR DOOR JAMB

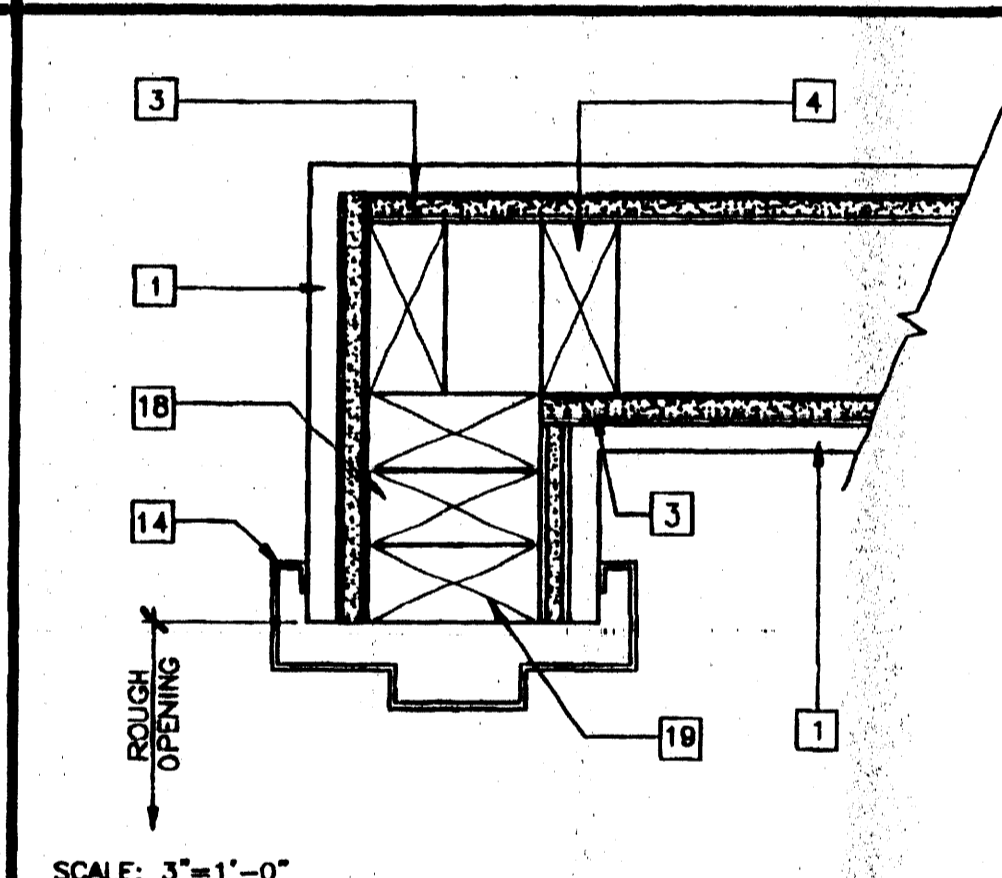


SCALE: 3"=1'-0"

COLUMN AT MODLINE

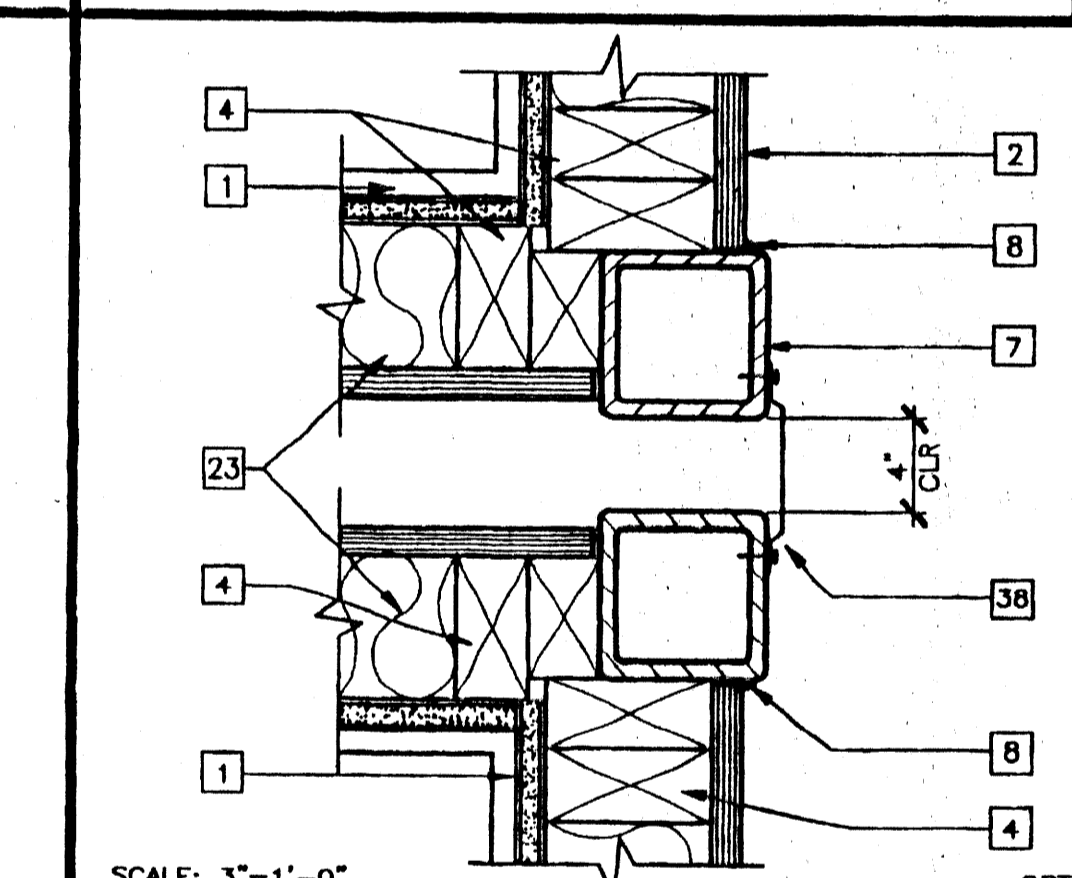


SCALE: 3"=1'-0" (OPTIONAL)

CURB ATTACHMENT ON METAL ROOFING

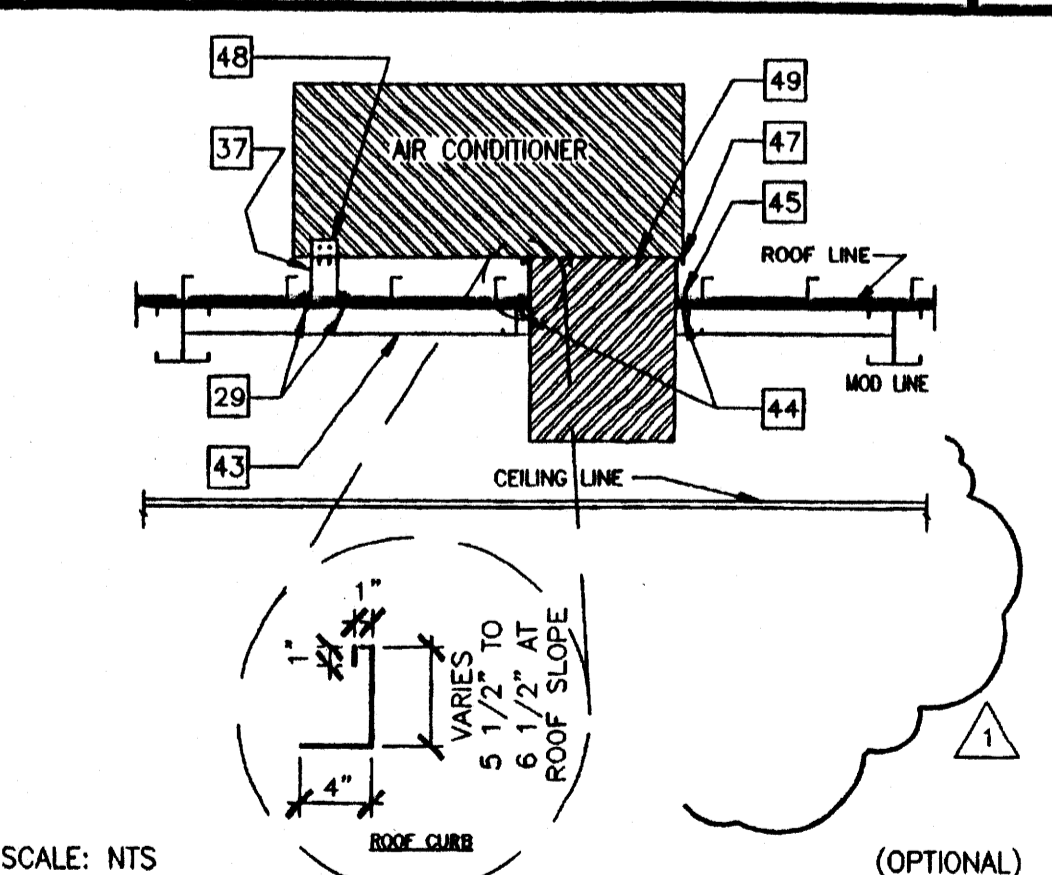


SCALE: NTS (OPTIONAL)

HVAC UNIT (PLAN)

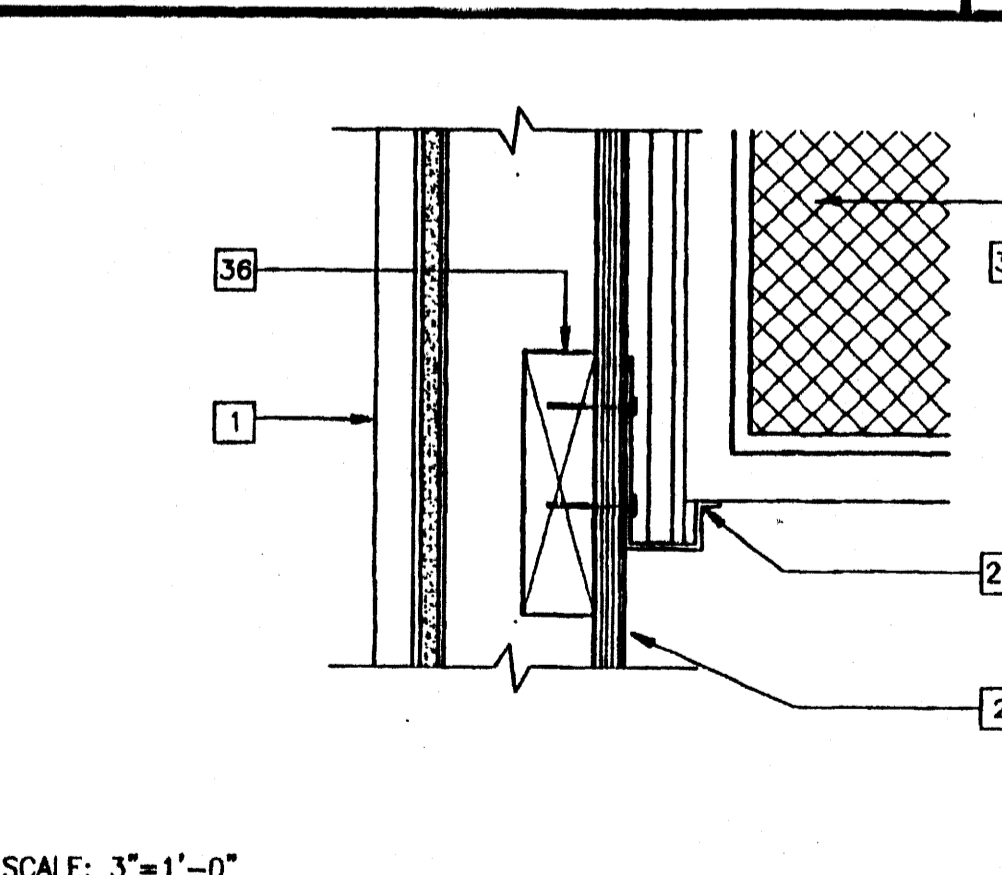


SCALE: 3"=1'-0"

SILL PLATE

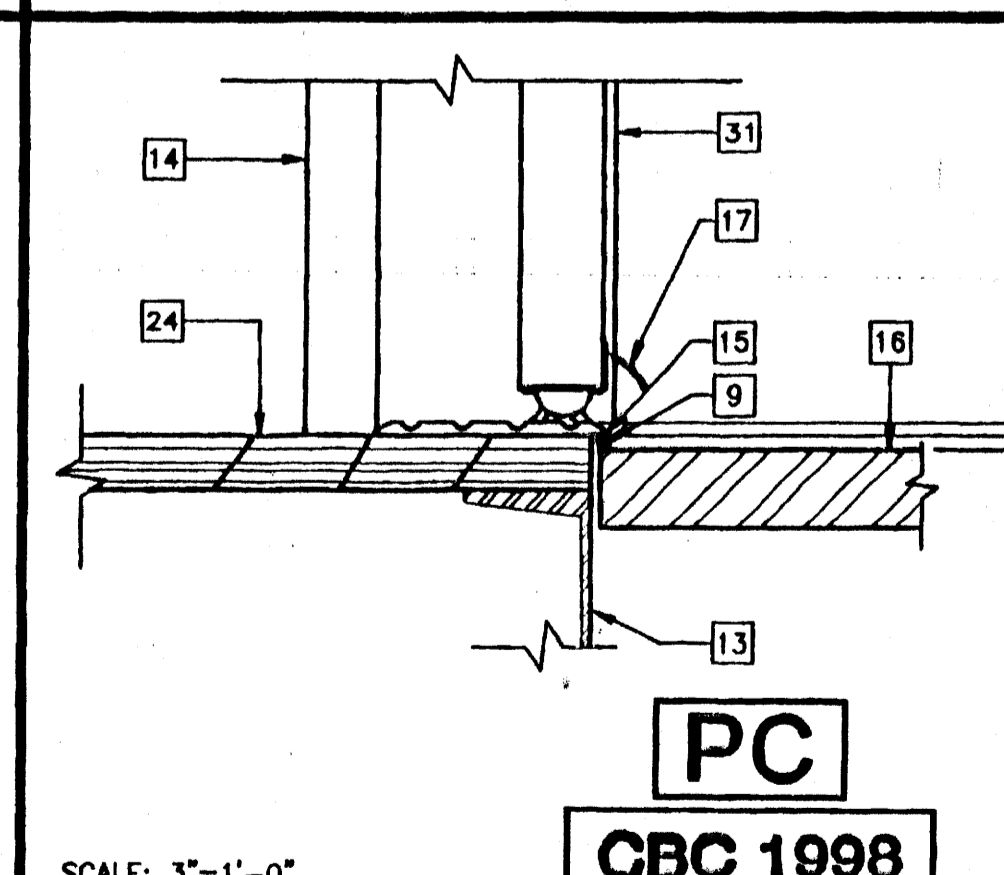


SCALE: 3"=1'-0"

INTERIOR DOOR JAMBS

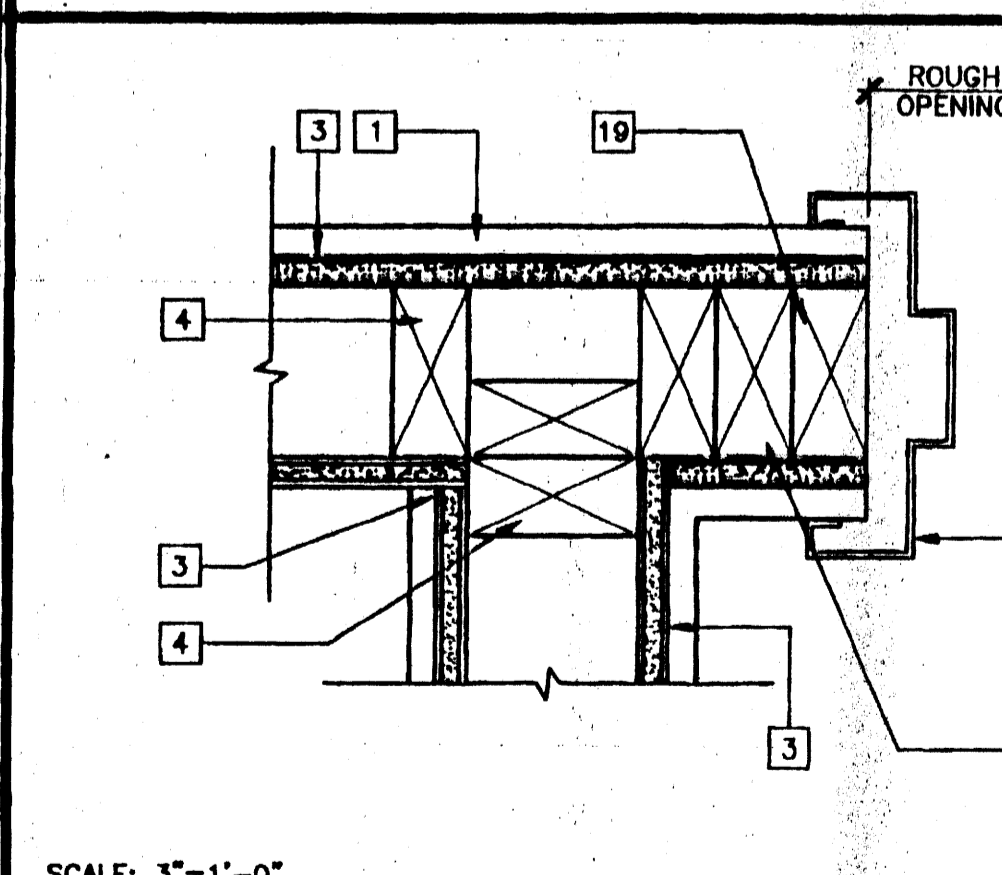


SCALE: 3"=1'-0"

CLOSURE BETWEEN BUILDINGS

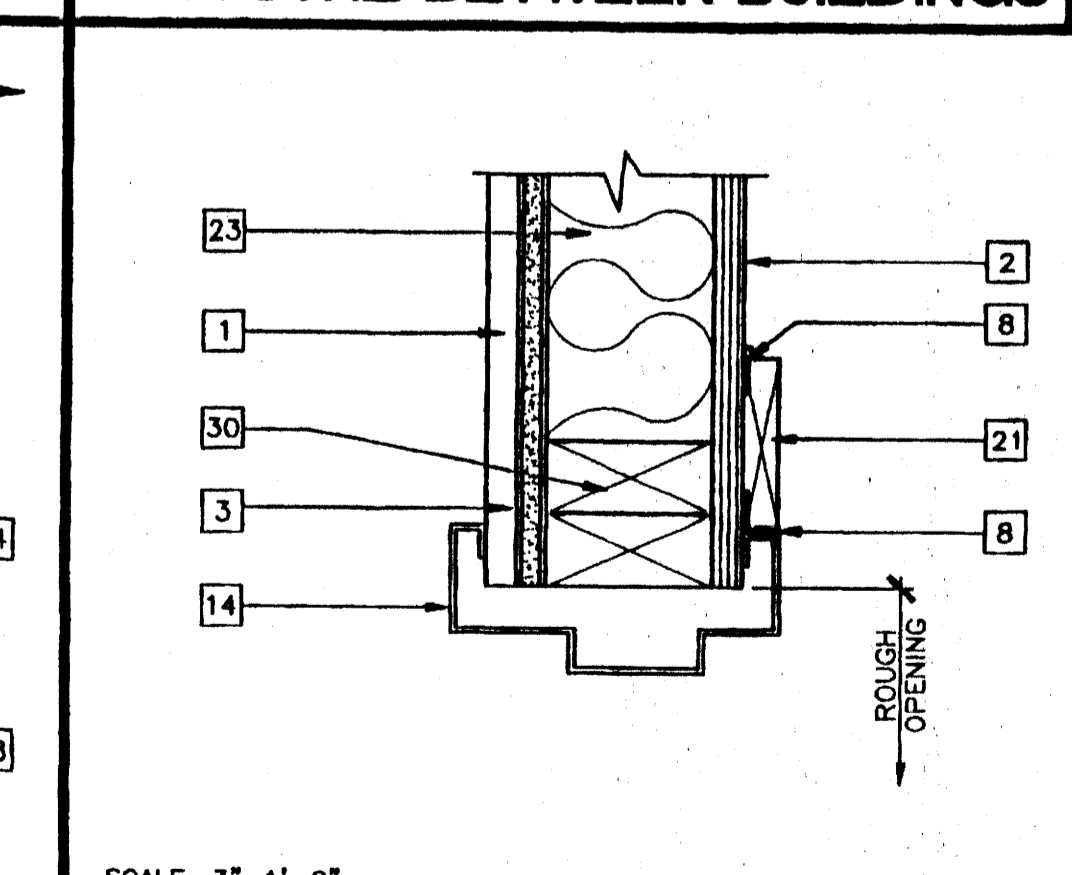


SCALE: 3"=1'-0"

SECTION THRU AIR CONDITIONER

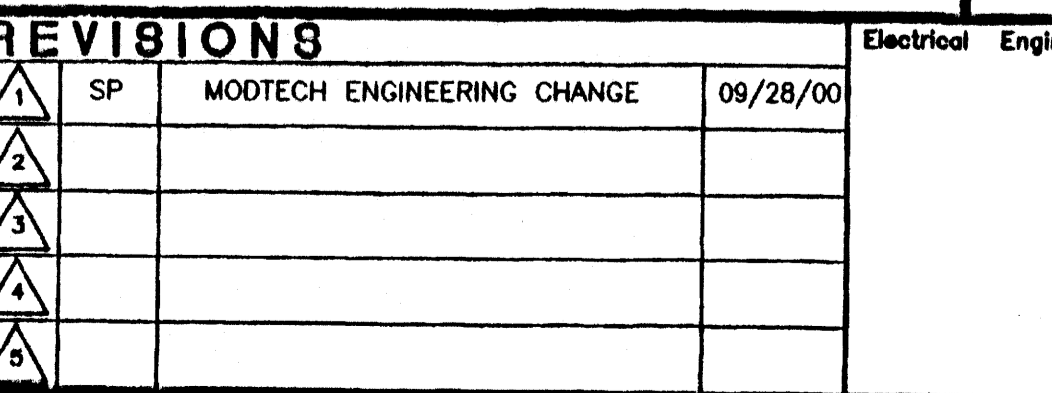


SCALE: NTS (OPTIONAL)

HVAC UNIT AT BOTTOM

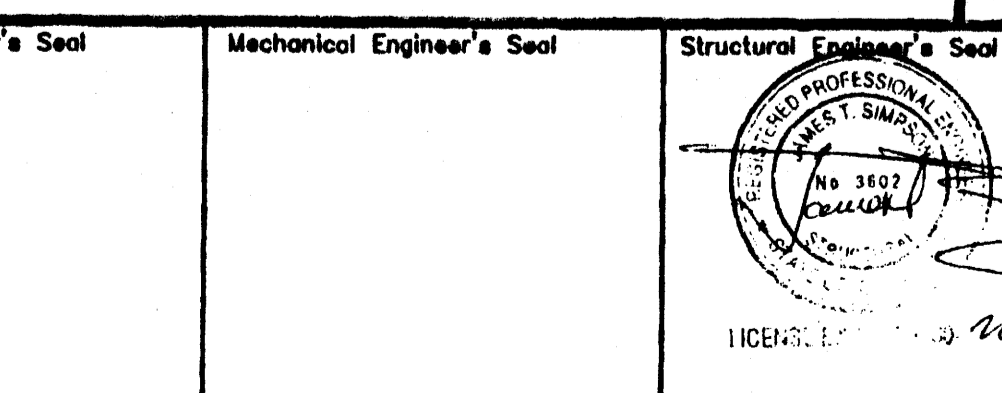


SCALE: 3"=1'-0"

THRESHOLD

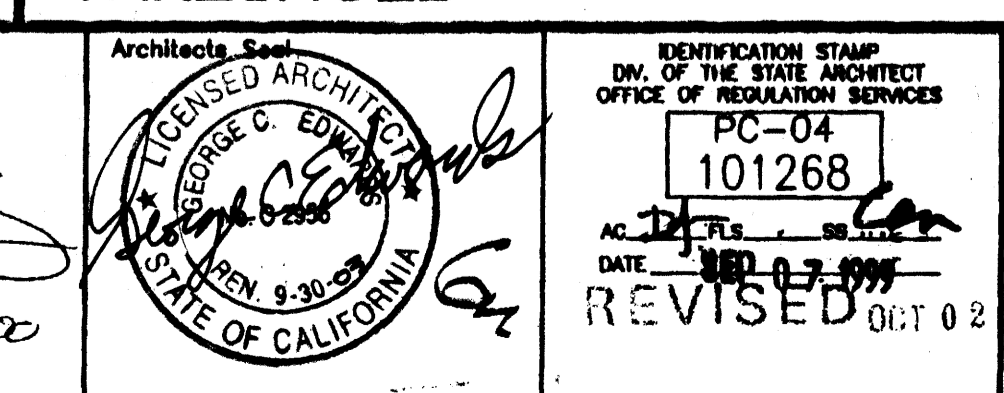


SCALE: 3"=1'-0"

INTERIOR DOOR JAMBS

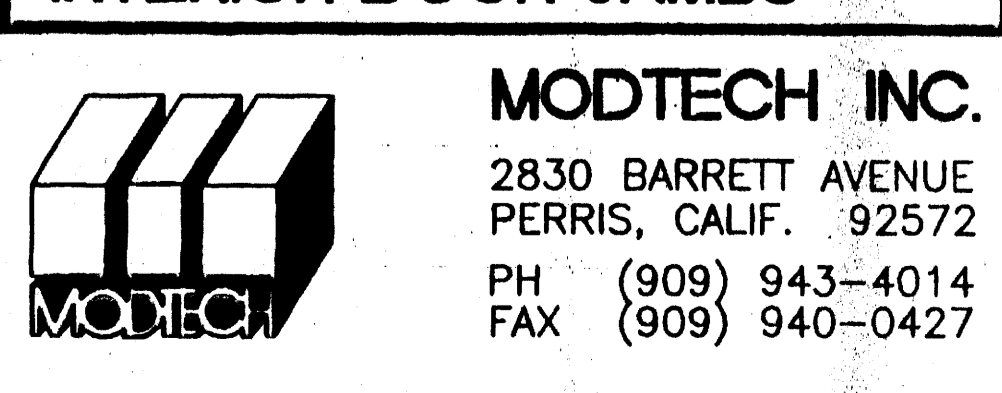

SCALE: 3"=1'-0"

EXTERIOR DOOR HEADER

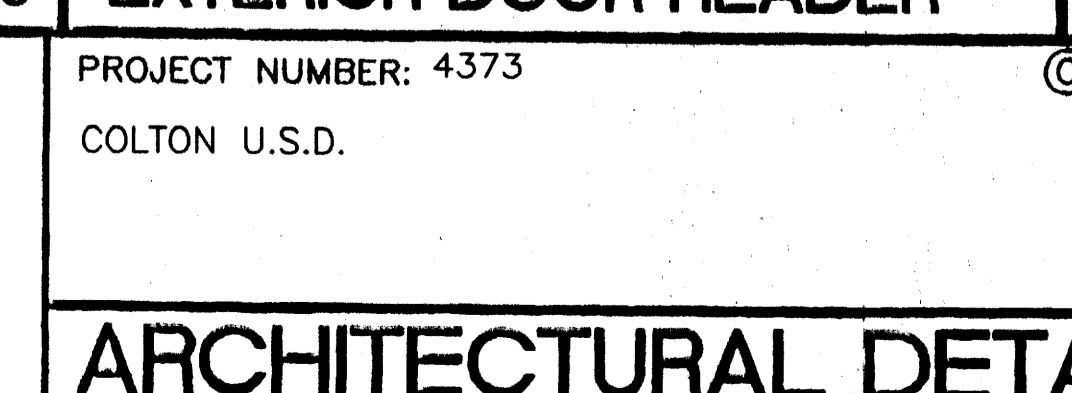

SCALE: 3"=1'-0"

REVISIONS

NO.	DESCRIPTION	DATE
1	SP MODTECH ENGINEERING CHANGE	09/28/00
2		
3		
4		
5		

Electrical Engineer's Seal
Mechanical Engineer's Seal
Structural Engineer's Seal

Architect's Seal
IDENTIFICATION STAMP
DIV. OF THE STATE ARCHITECT
OFFICE OF REGULATION SERVICES
PC-04
101268
DATE: 10/19/02
REVISED OCT 02 2000

MODTECH INC.
2830 BARRETT AVENUE
PERRIS, CALIF. 92572
PH (909) 943-4014
FAX (909) 940-0427


PROJECT NUMBER: 4373
COLTON U.S.D.
© MODTECH, INC. 2002

DRAWN BY: KK
DATE: 11/19/02
CHECKED BY: STKP-67
DATE: 4/02-124
MODTECH Index No.
A6.01

PROJECT NO. 4373
FILE PATH: 2440-A6.01.DWG
PC-04-101268

KEY NOTES

- 1 MAIN RUNNERS AT 4'-0" OC WITH 12 GA HANGER WIRES AT END OF EACH RUNNER
 - 2 CROSS TEE AT 2'-0" OC
- | T-BAR PART NUMBERS | | | |
|--------------------|---------------------|-----------------------------|--------------|
| | ARMSTRONG
FA-041 | CHICAGO
METALLIC
R-47 | USG
IR-47 |
| RUNNER
MAIN | 7301 | 200 | DS 26 |
| 4' CROSS
TEE | 7342 | 1210 | DX 422 |
| 2' CROSS
TEE | 7328 | 1226 | DX 216 |
| WALL
ANGLE | 7800 | 1420-01 | M-7 |
- 4 LIGHT FIXTURE, RECESSED, 2'x4' TYPICAL - 11/A7.11
 - 5 4 WAY SPLAY AT LOCATIONS INDICATED, WIRES TAUT BUT NOT TO DISTORT GRID - 1/A7.11
 - 6 HVAC SUPPLY REGISTER, 2'x2' TYPICAL - 12/A7.11
 - 7 CEILING PANELS: 2'x4' LAY-IN PANELS, ASTM FLAME SPREAD CLASS 1 (0-25), SMOKE DEVELOPMENT DENSITY LESS THAN 450 TYPICAL

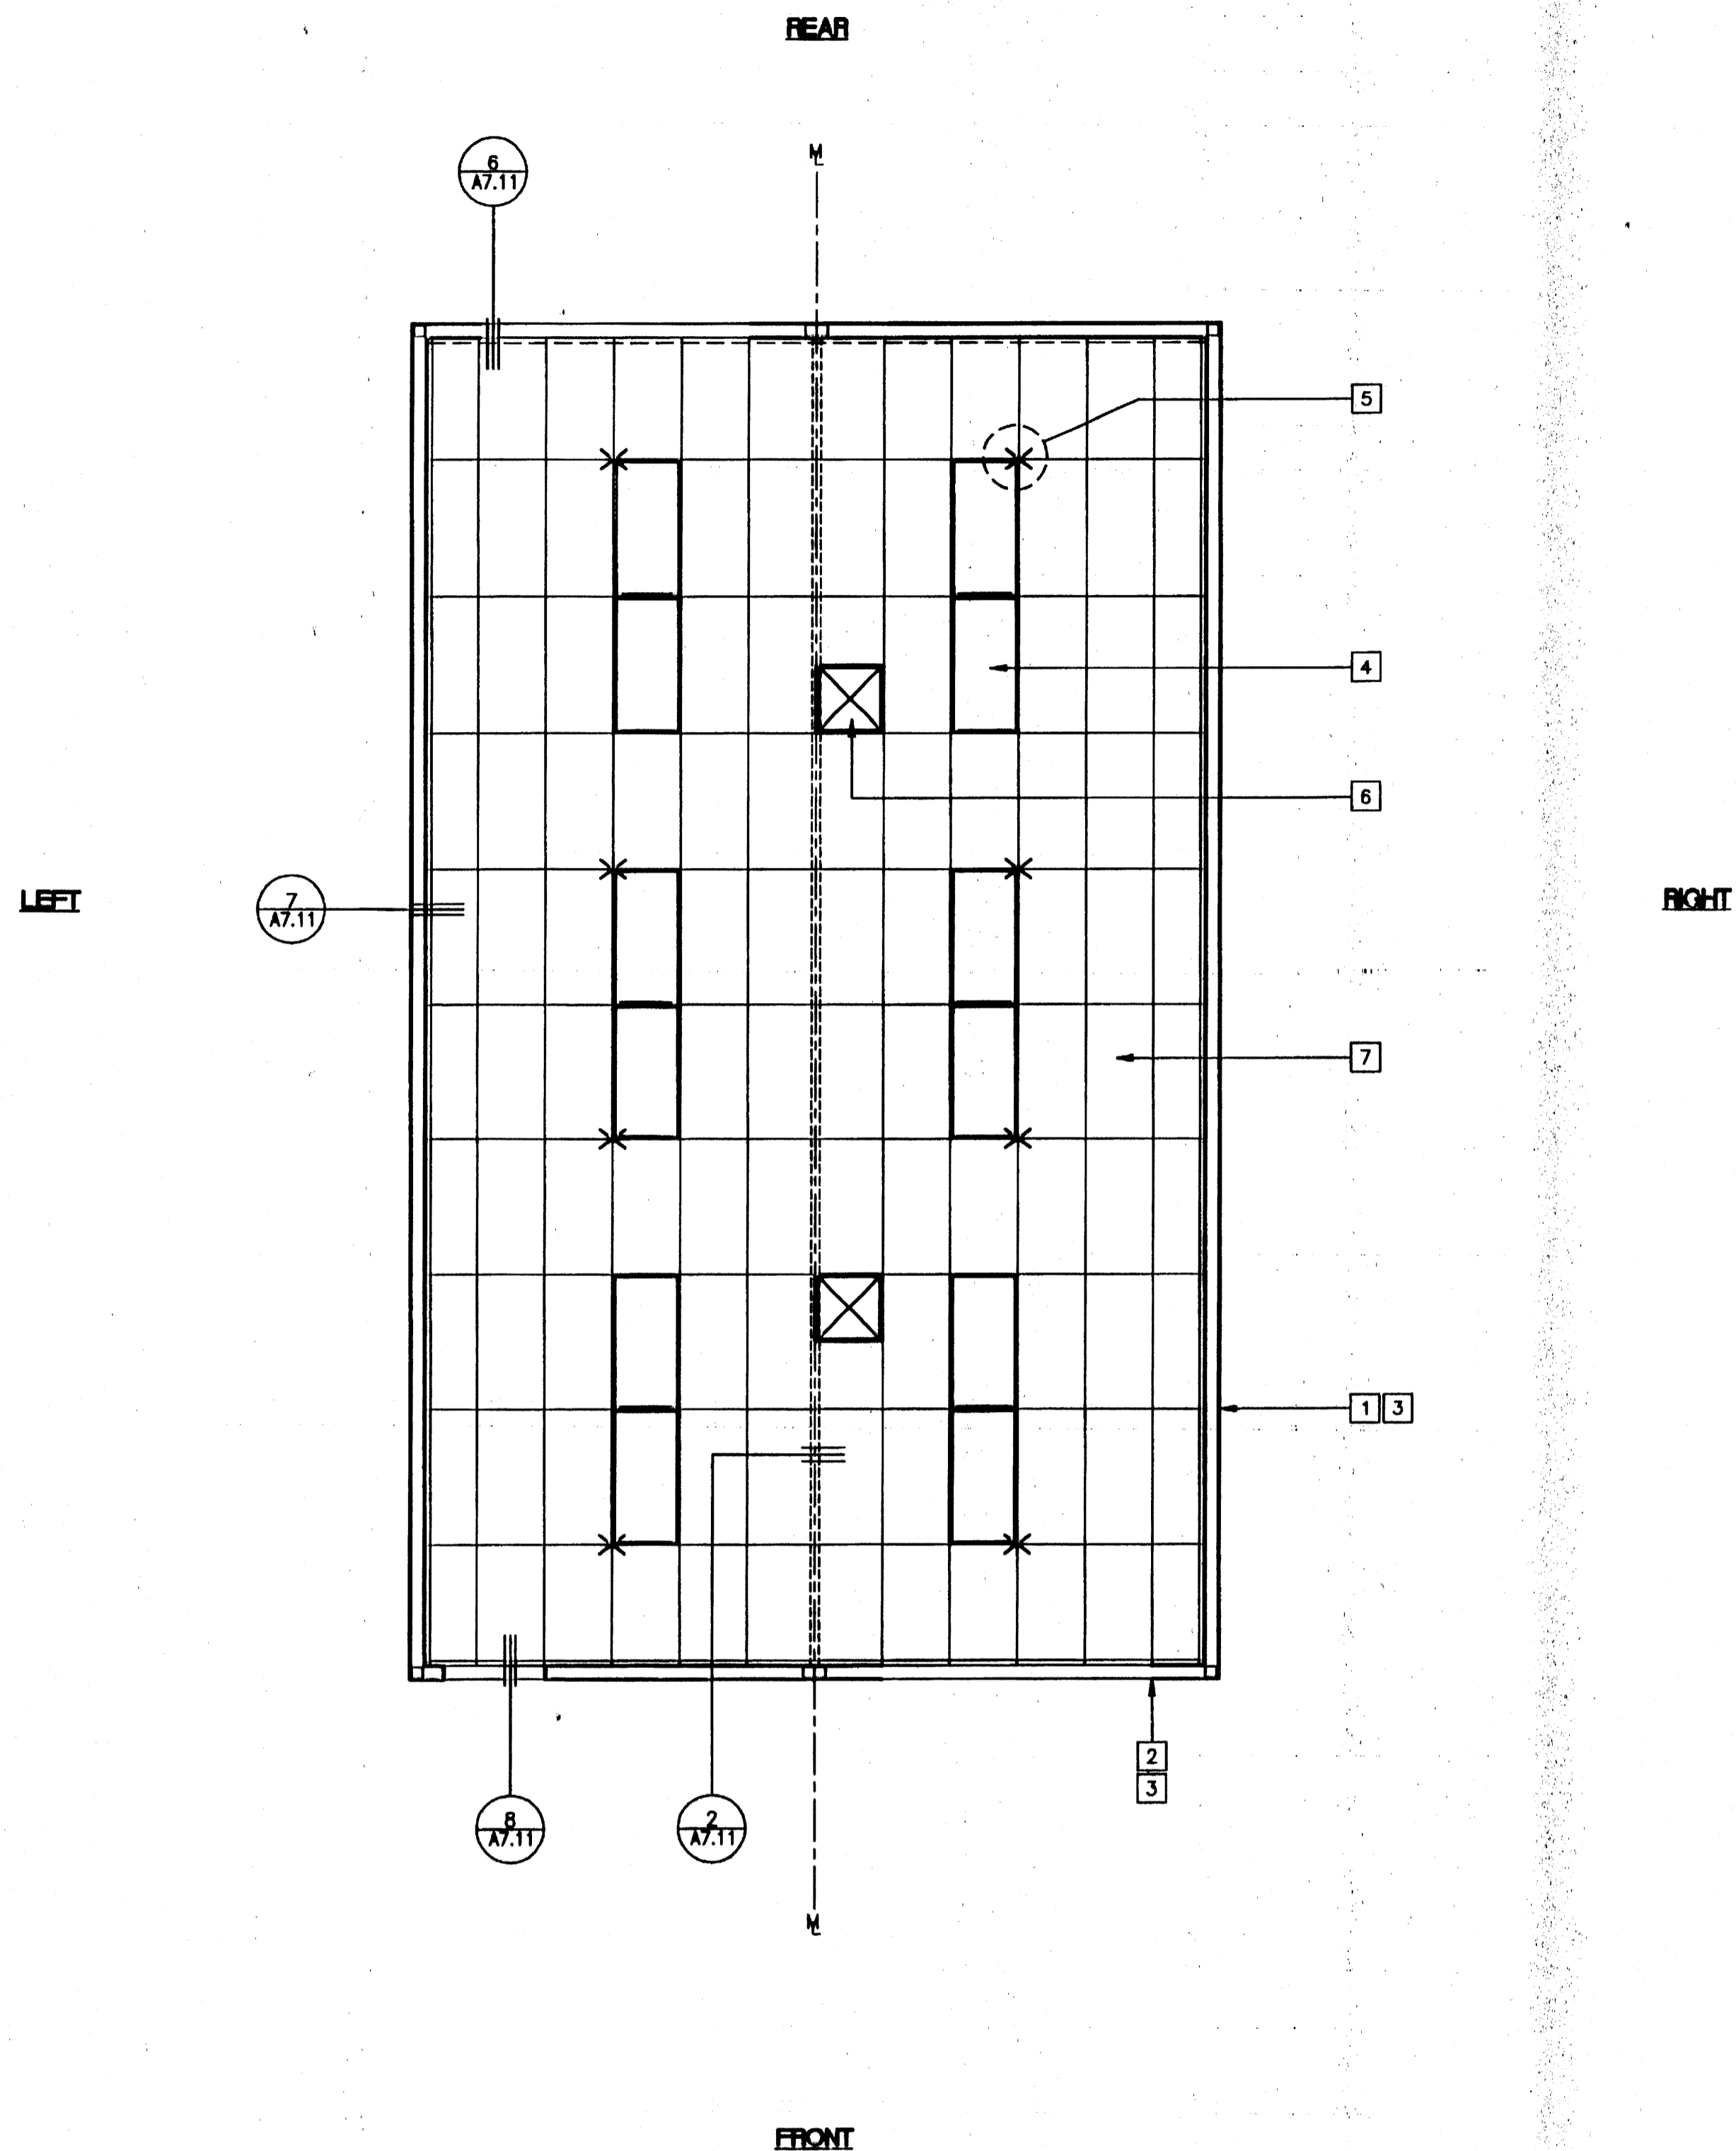

IDENTIFICATION STAMP
 DIV. OF THE STATE ARCHITECT
 OFFICE OF REGULATORY SERVICES
 04 1048 12
 AC - FLS 2 SS CK
 DATE DEC 05 2012

NOTES

- 1. AT THE END OF ROWS OF RUNNERS A 12 GA HANGER WIRE SHALL BE ATTACHED WITHIN 8" OF WALL OR SOFFIT.
- 2. VERTICAL WIRES MORE THAN 1-IN-6 OUT OF PLUMB SHALL HAVE COUNTER BRACING WIRES.
- 3. RUNNERS MAY BE ATTACHED TO WALLS OR MOLD AT (2) ADJACENT WALLS - OTHER WALLS NO ATTACHMENT. CLEARANCE OF 1/2" BETWEEN END OF RUNNERS AND FACE OF WALL.
- 4. DUCTWORK SHALL BE RIGIDLY ATTACHED TO BUILDING AND SHALL NOT BE CLOSER THAN 6" TO HANGER WIRES.

LEGEND

- T & T BAR CEILING
- 2'x 4' ELEC. FIXTURE RECESSED
- SUPPLY AIR DIFFUSER
- SPLAY WIRE
- INDICATES FIXED SIDE 7/A7.11
- INDICATES FREE SIDE 6/A7.11

REFLECTED CEILING PLAN

(24'x40')
 SCALE: 1/4" = 1'-0"

PC
CBC 1998

REVISIONS

1		
2		
3		
4		


Electrical Engineer's Seal

Mechanical Engineer's Seal

Structural Engineer's Seal

Architect's Seal

IDENTIFICATION STAMP
 DIV. OF THE STATE ARCHITECT
 OFFICE OF REGULATORY SERVICES
 PC-04
 101268
 AC - FLS 2 SS CK
 DATE SEP 07 2008

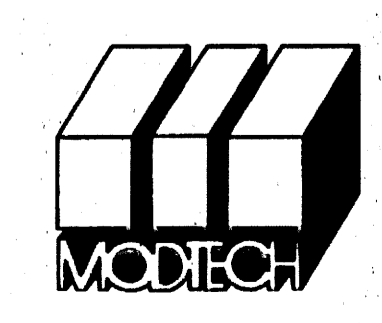

MODTECH INC.
 2830 BARRETT AVENUE
 PERRIS, CALIF. 92572
 PH (909) 943-4014
 FAX (909) 940-0427

PROJECT NUMBER: 4373
 COLTON U.S.D.


© MODTECH, INC. 2002

DRAWN BY: KK
 DATE: 11/19/02
 CHECKED BY: STKP-67
 DATE: 4/12-124
 MODTECH Index No.

REFLECTED CEILING PLAN 24'x40'

A7.01

FILE PATH: 2440-A7.01.DWG PROJECT NO. 4373 PC-04-101268

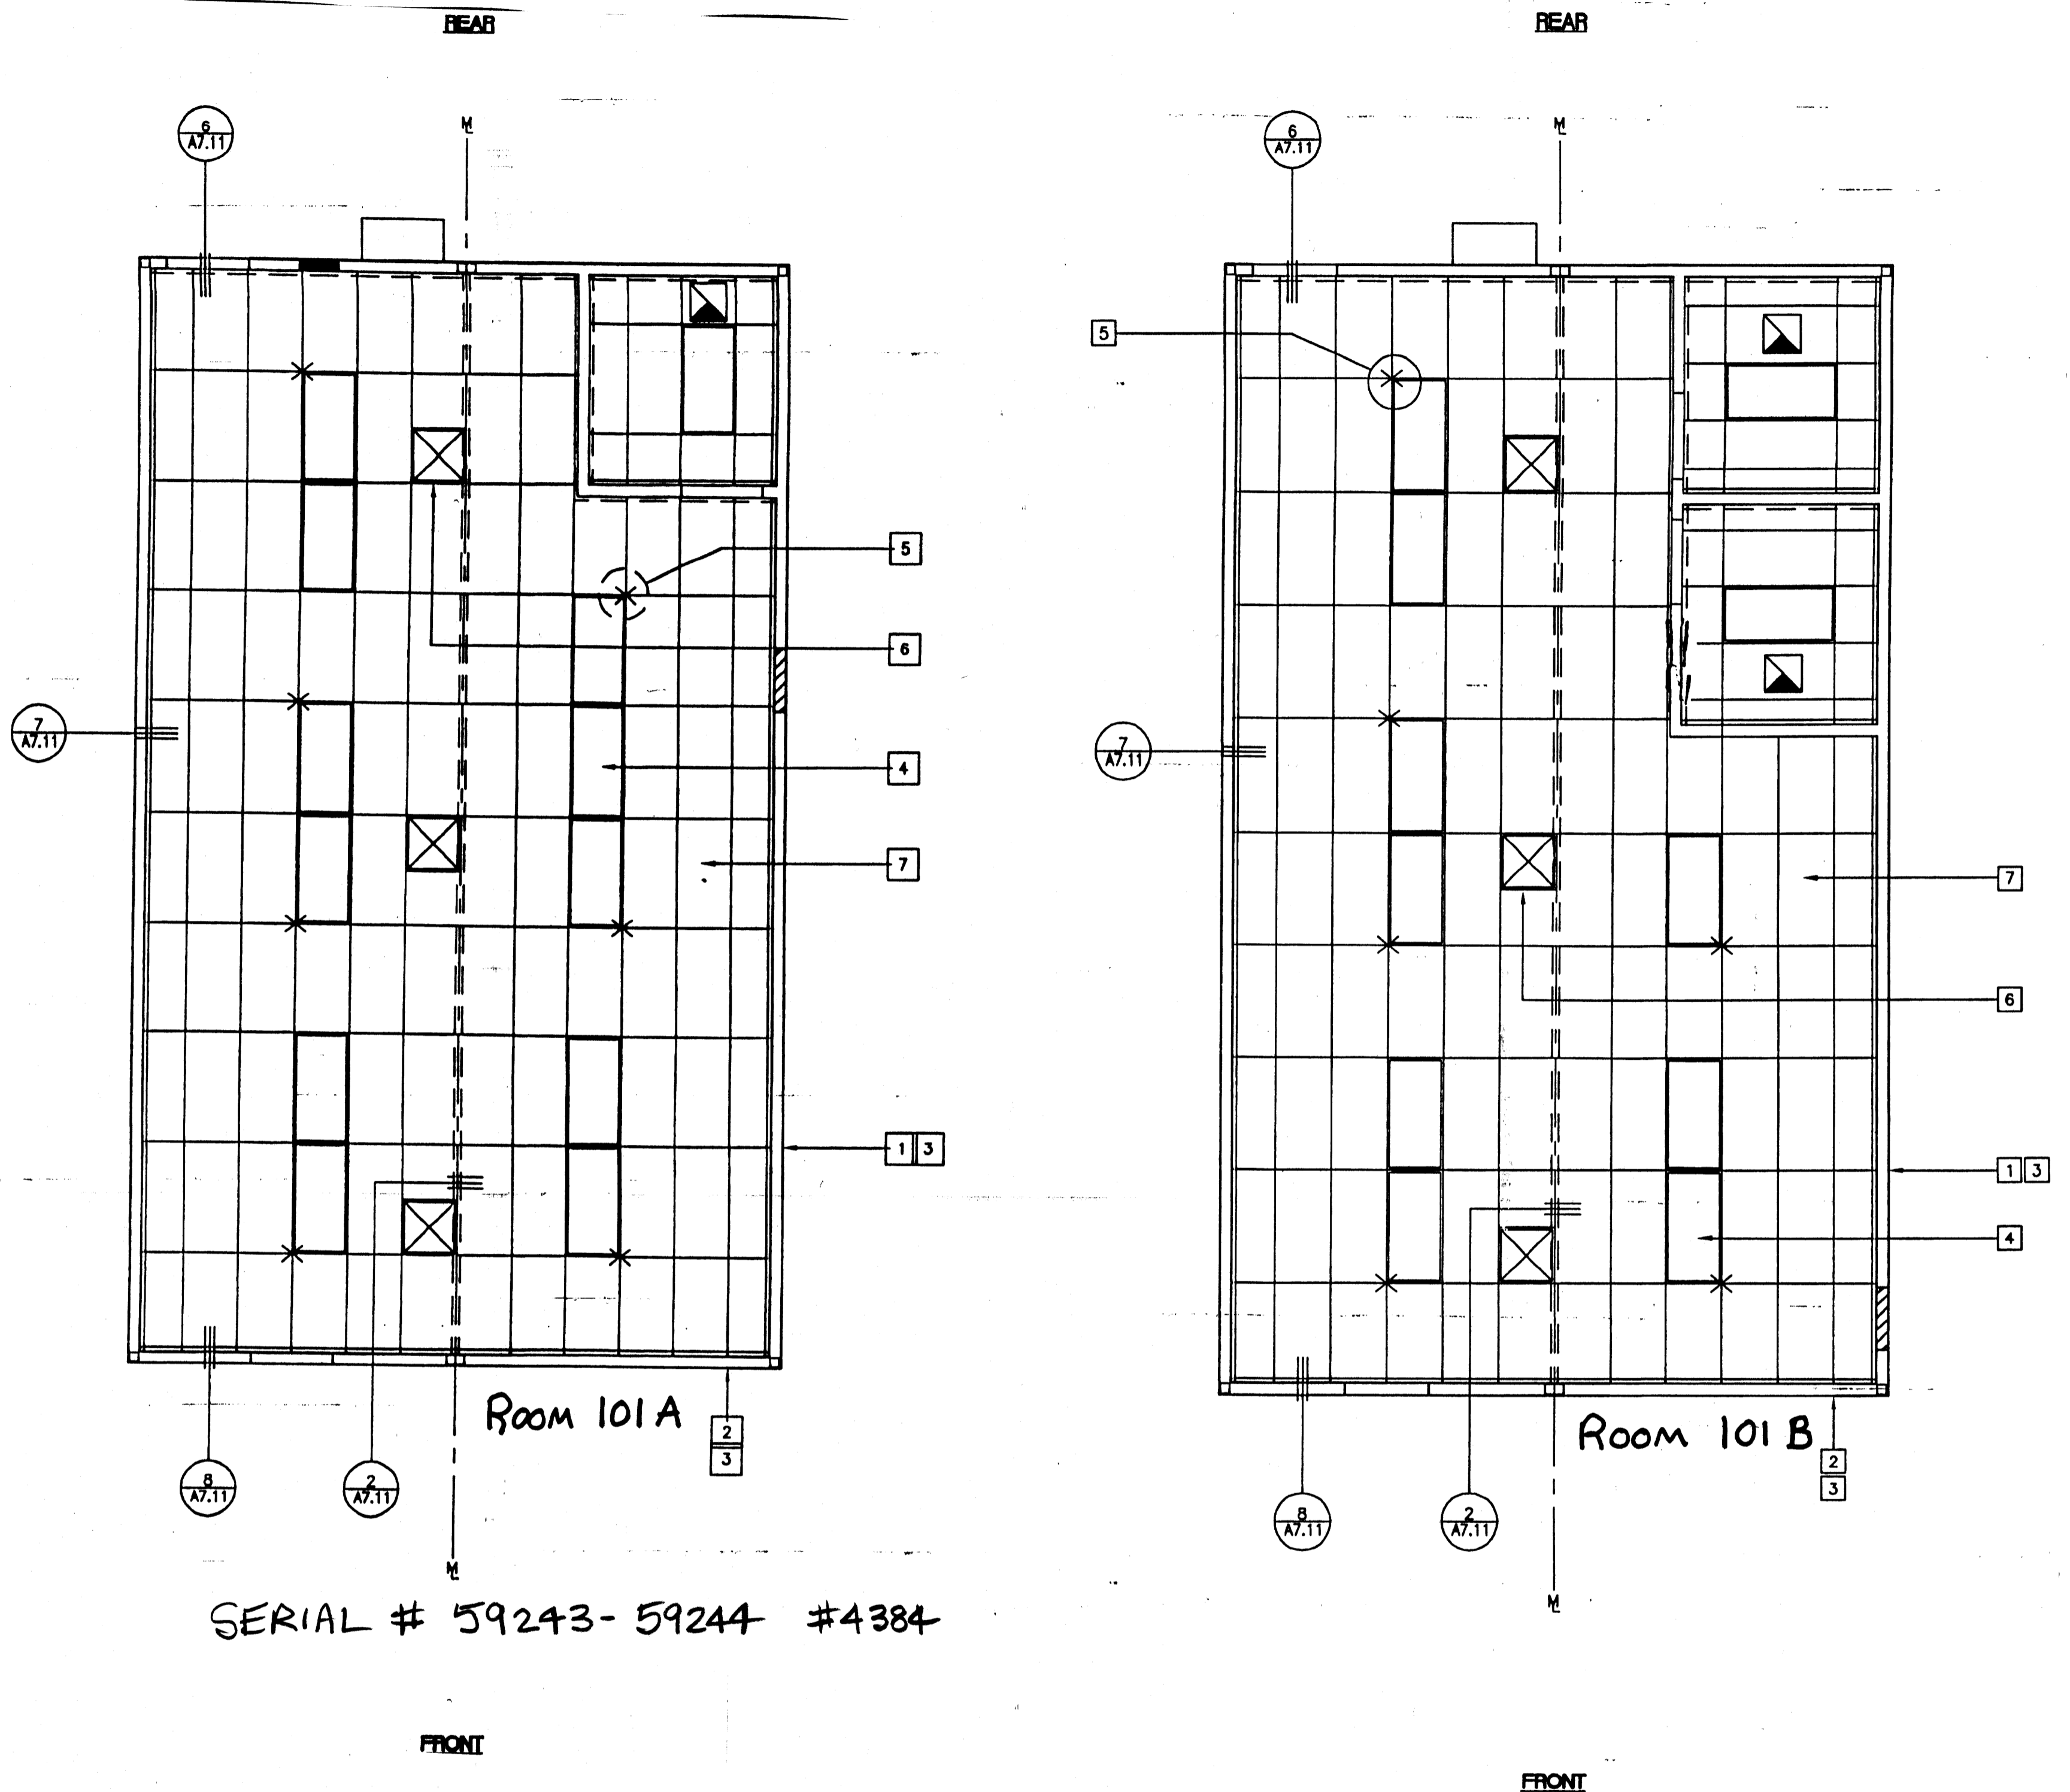

SERIAL # 59243-59244 #4384

REFLECTED CEILING PLAN (24'x40')
SCALE: 1/4" = 1'-0"

KEY NOTES


- 1 MAIN RUNNERS AT 4'-0" OC WITH 12 GA HANGER WIRES AT END OF EACH RUNNER
- 2 CROSS TEE AT 2'-0" OC
- 3

T-BAR PART NUMBERS			
	ARMSTRONG PA-041	CHICAGO METALLIC IR-47	USG IR-47
RUNNER MAIN	7301	200	DS 26
4' CROSS TEE	7342	1210	DX 422
2' CROSS TEE	7328	1226	DX 216
WALL ANGLE	7800	1420-01	M-7
- 4 LIGHT FIXTURE, RECESSED, 2'x4' TYPICAL - 11/A7.11
- 5 4 WAY SPLAY AT LOCATIONS INDICATED, WIRES TAUT BUT NOT TO DISTORT GRID - 1/A7.11
- 6 HVAC SUPPLY REGISTER, 2'x2' TYPICAL - 12/A7.11
- 7 CEILING PANELS: 2'x4' LAY-IN PANELS, ASTM FLAME SPREAD CLASS 1 (0-25). SMOKE DEVELOPMENT DENSITY LESS THAN 450 TYPICAL

NOTES

- 1. AT THE END OF ROWS OF RUNNERS A 12 GA HANGER WIRE SHALL BE ATTACHED WITHIN 8" OF WALL OR SOFFIT.
- 2. VERTICAL WIRES MORE THAN 1-IN-6 OUT OF PLUMB SHALL HAVE COUNTER BRACING WIRES.
- 3. RUNNERS MAY BE ATTACHED TO WALLS OR MOLD AT (2) ADJACENT WALLS - OTHER WALLS NO ATTACHMENT. CLEARANCE OF 1/2" BETWEEN END OF RUNNERS AND FACE OF WALL
- 4. DUCTWORK SHALL BE RIGIDLY ATTACHED TO BUILDING AND SHALL NOT BE CLOSER THAN 6" TO HANGER WIRES.

LEGEND

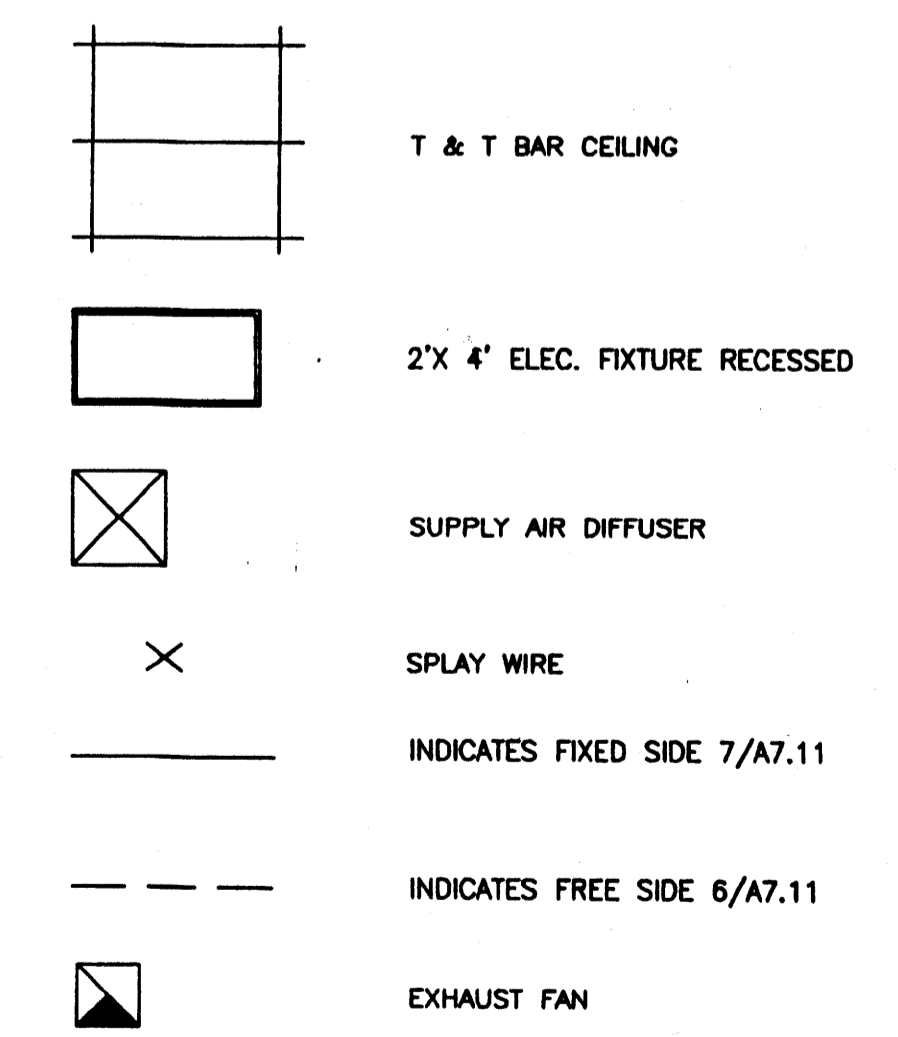


REVISED
 IDENTIFICATION STAMP
 DIV. OF THE STATE ARCHITECT
 OFFICE OF REGULATION SERVICES
 04 104812
 AC FLS SS
 DATE DEC 14 2002

REVISIONS		
DD	CD-1 - ADD ROOM 100, MOVE SINKS, ETC	07-10-01

Electrical Engineer's Seal Mechanical Engineer's Seal Structural Engineer's Seal Architect's Seal

ARCHITECT'S SEAL: LICENSED ARCHITECT, BRUCE C. EDWARDS, No. C 2956, STATE OF CALIFORNIA, EXPIRES 9/30/05

IDENTIFICATION STAMP: DIV. OF THE STATE ARCHITECT, OFFICE OF REGULATION SERVICES, PC-04 101268, AC FLS SS, DATE

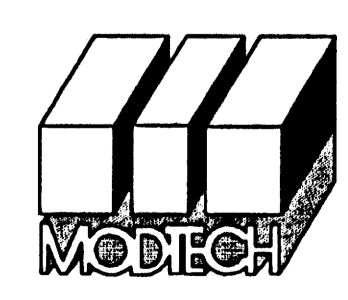

MODTECH INC.
 2830 BARRETT AVENUE
 PERRIS, CALIF. 92572
 PH (909) 943-4014
 FAX (909) 940-0427




PROJECT NUMBER: 4384
 CHINO
 CLASS LEASING

© MODTECH, INC. 1999
 CLASS LEASING INC STOCKPILE # 67
 100-24 x 40 CLASSROOM BUILDINGS
 4012-124 12/05/2002 80 MPH

DRAWN BY: SW
 DATE: 6/26/01
 CHECKED BY:
 DATE:
 MODTECH Index No.

REFLECTED CEILING PLAN 24'x40' A7.01c

FILE PATH: 2440-A7.01.DWG PROJECT NO. 3883 PC-04-101268

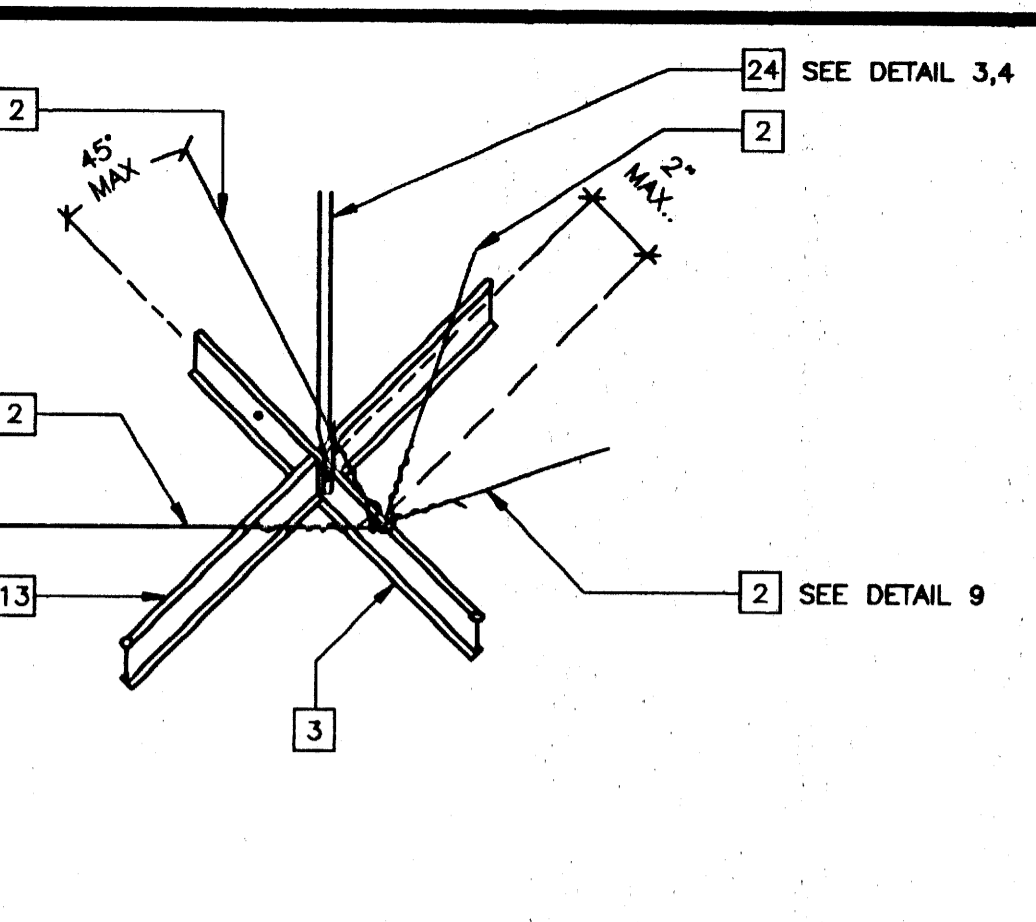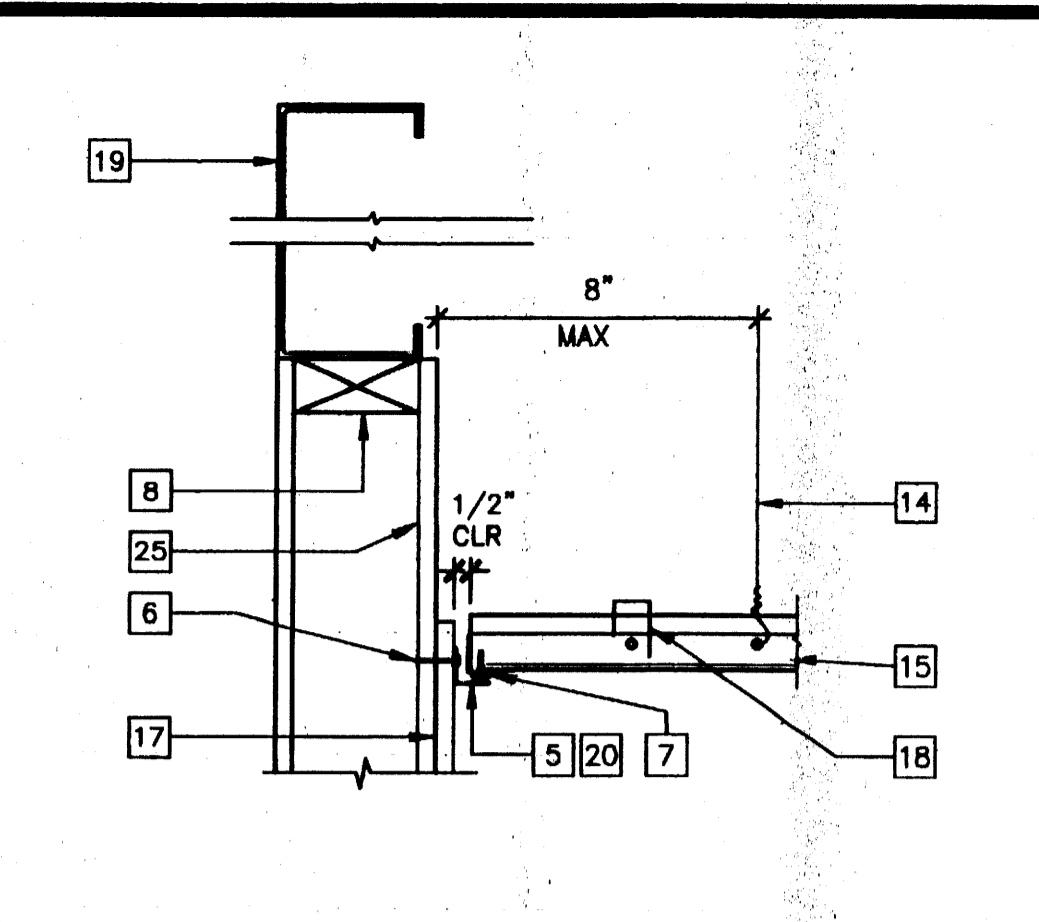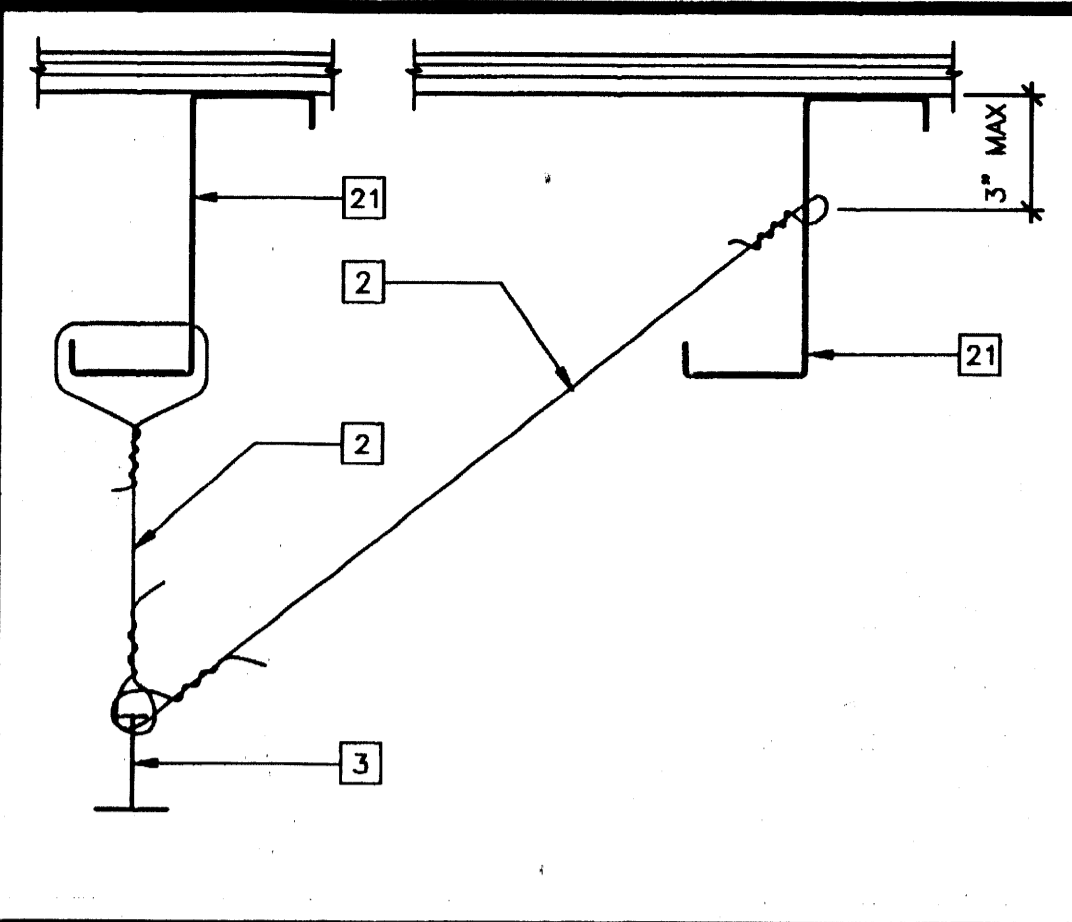

- ### KEY NOTES
- HANGER WIRE AT 4'-0" OC IN PUNCHED OR DRILLED HOLE
 - SPLAY BRACE WIRE TO RUN IN SAME PLANE AS RUNNERS AT MAX 45° FROM CEILING PLANE - SEE NOTE ONE BELOW
 - MAIN RUNNER
 - 1/8" DIA POP RIVET TO EACH T-BAR
 - WALL ANGLE
 - 6d NAIL AT 16" OC AT WALL STUDS (WOOD STUDS) #8 STMS AT 16" OC AT WALL STUDS (STEEL STUDS)
 - ANGLE WITH 1/8" DIA POP RIVET TO EACH T-BAR, NO CONNECTION TO WALL ANGLE
 - TOP PLATE
 - #10 STSMS AT 4' OC
 - HVAC REGISTER, 2'x2' TYPICAL
 - HANGER TO TOP LIP OF ROOF BEAM WHERE NO PURLIN ABOVE MAX SLOPE 1" IN 6", ALTERNATE: CONNECT TO BOTTOM LIP (DASHED) WHERE THERE IS INTERFERENCE WITH DUCTWORK
 - 26 GA CEILING MOUNT x 2" □
 - CROSS TEE
 - HANGER WIRE AT THE END ON EACH RUNNER TO PURLIN MAX DISTANCE FROM WALL 8" OR 1/4 LENGTH OF END TEE RUNNER, WHICHEVER IS LESS, SEE 10/A7.11
 - MAIN RUNNERS OR CROSS TEES
 - #8 STSMS, (2) AT EACH END
 - FINISH WALL
 - HORIZONTAL STRUTS SHALL RUN CONTINUOUS AT ALL PERIMETERS, NOT POP RIVETED TO THE WALL ANGLE ARMSTRONG #7425 OR #7445 WITH SPRING STEEL SNAP TO RUNNER PER IR 47-4
 - ROOF BEAM
 - NO POP RIVETS
 - ROOF PURLIN
 - CRIMP CONDUIT AND ATTACH TO T-BAR GRID WITH (1) #8 TEKSREW
 - CRIMP CONDUIT AND ATTACH TO PURLIN WITH (1) #8 TEKSREW
 - 3/4" EMT CONDUIT
 - EXTEND GYP BOARD TO TOP PLATE FOR FIRE BLOCK
 - RECESSED LIGHT FIXTURE
 - SLACK WIRES, TOTAL OF (2) LOCATED AT OPPOSITE CORNERS OF FIXTURE OR REGISTER
 - (2) 26 GA STRAPS, FASTEN WITH #8 STSMS (1) TO REGISTER AND (1) TO ROOF PURLIN OR ROOF BEAM
 - 24 GA REGISTER CLIP, FASTEN WITH #8 STSMS (1) TO CEILING GRID AND (1) TO REGISTER, (2) CLIPS AT EACH END




17

13 SPLAY BRACING WIRE

9 TYPICAL FREE SIDE

5 SIESMIC SPLAY - 4 WAY

1

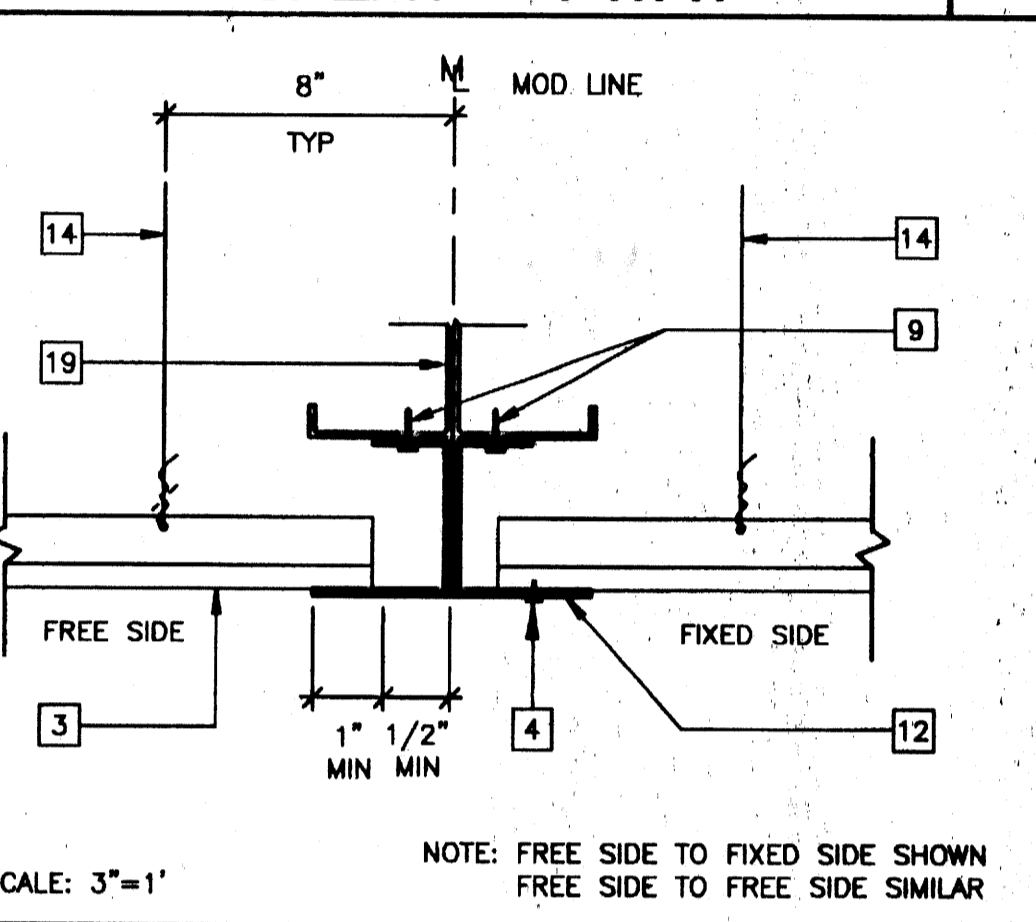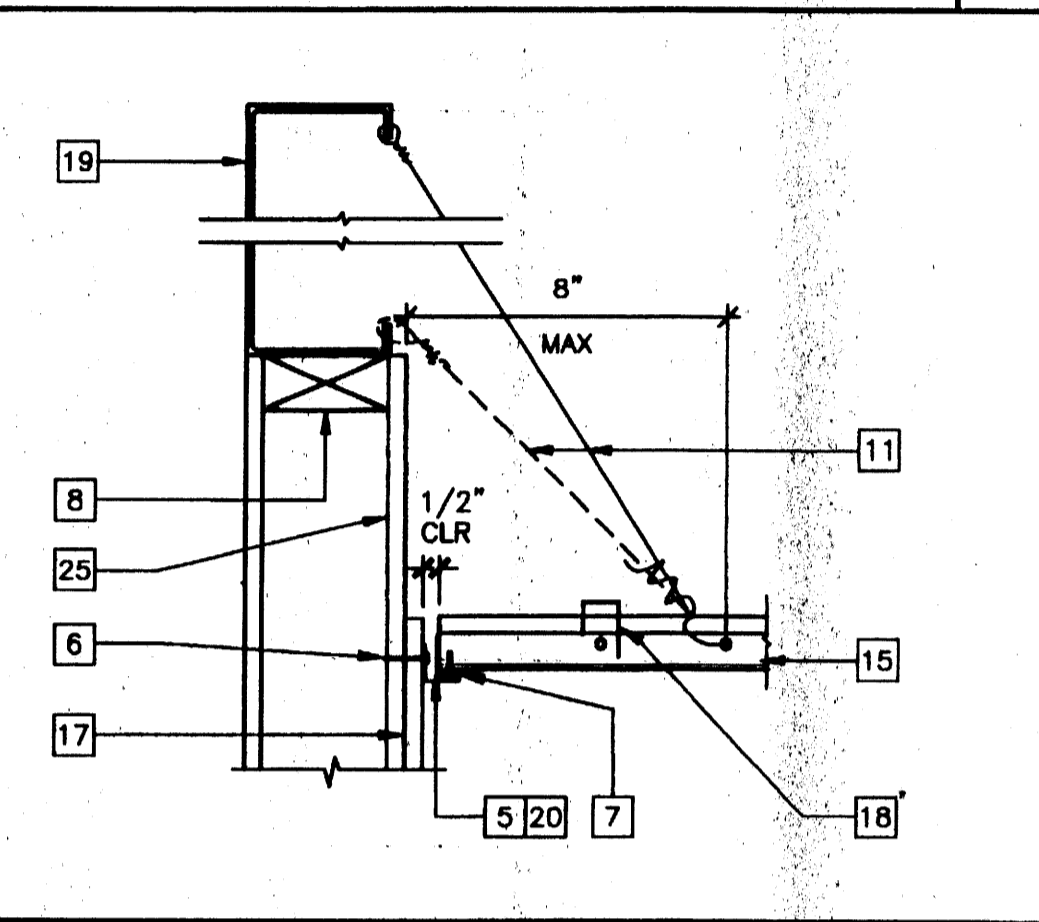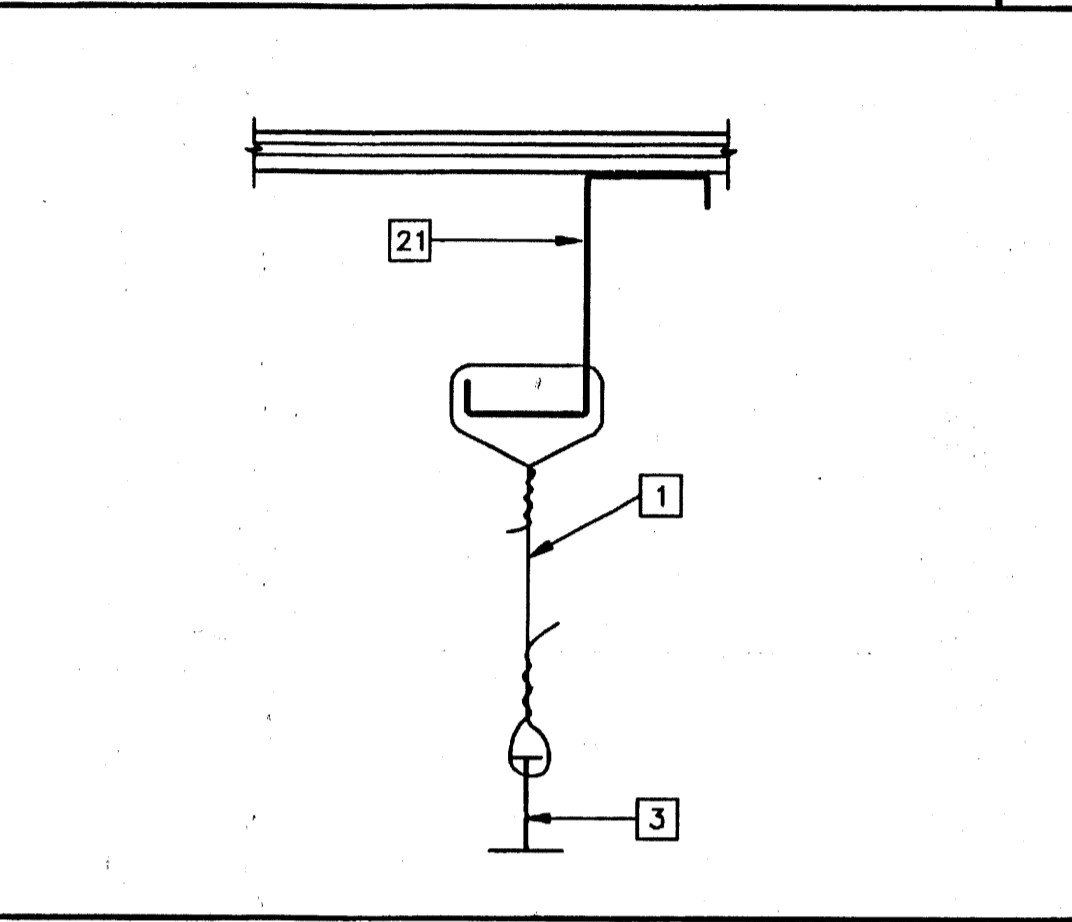




18

14 HANGER WIRE DETAIL

10 ALTERNATE FREE SIDE

6 GRID AT MODLINE

2

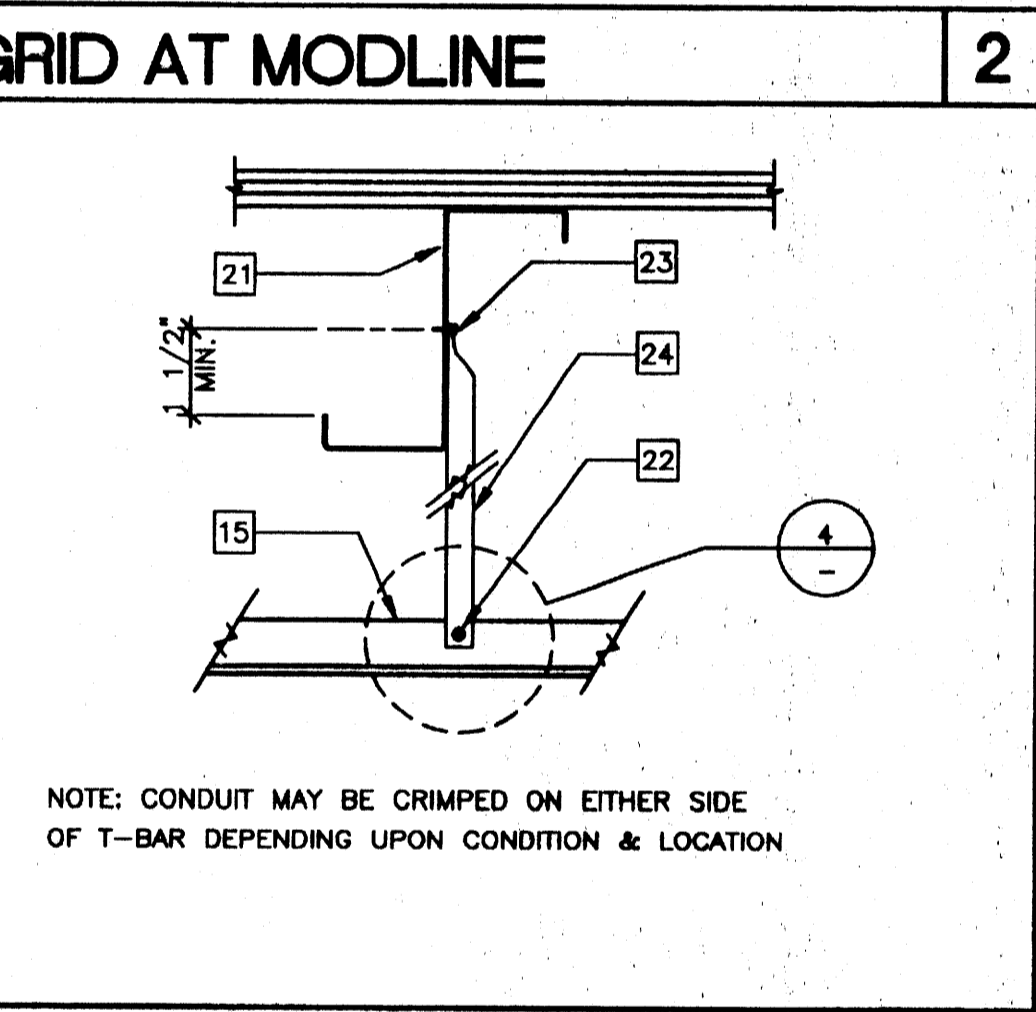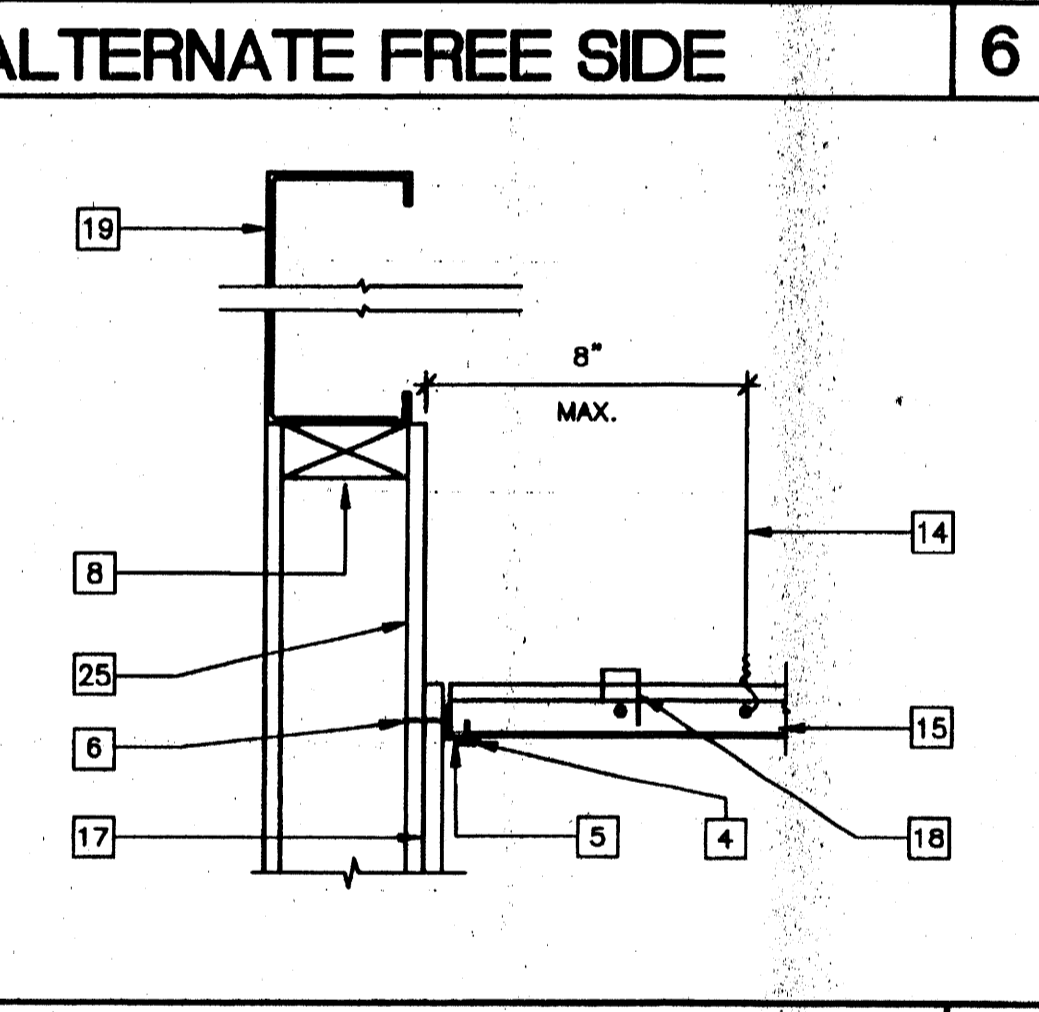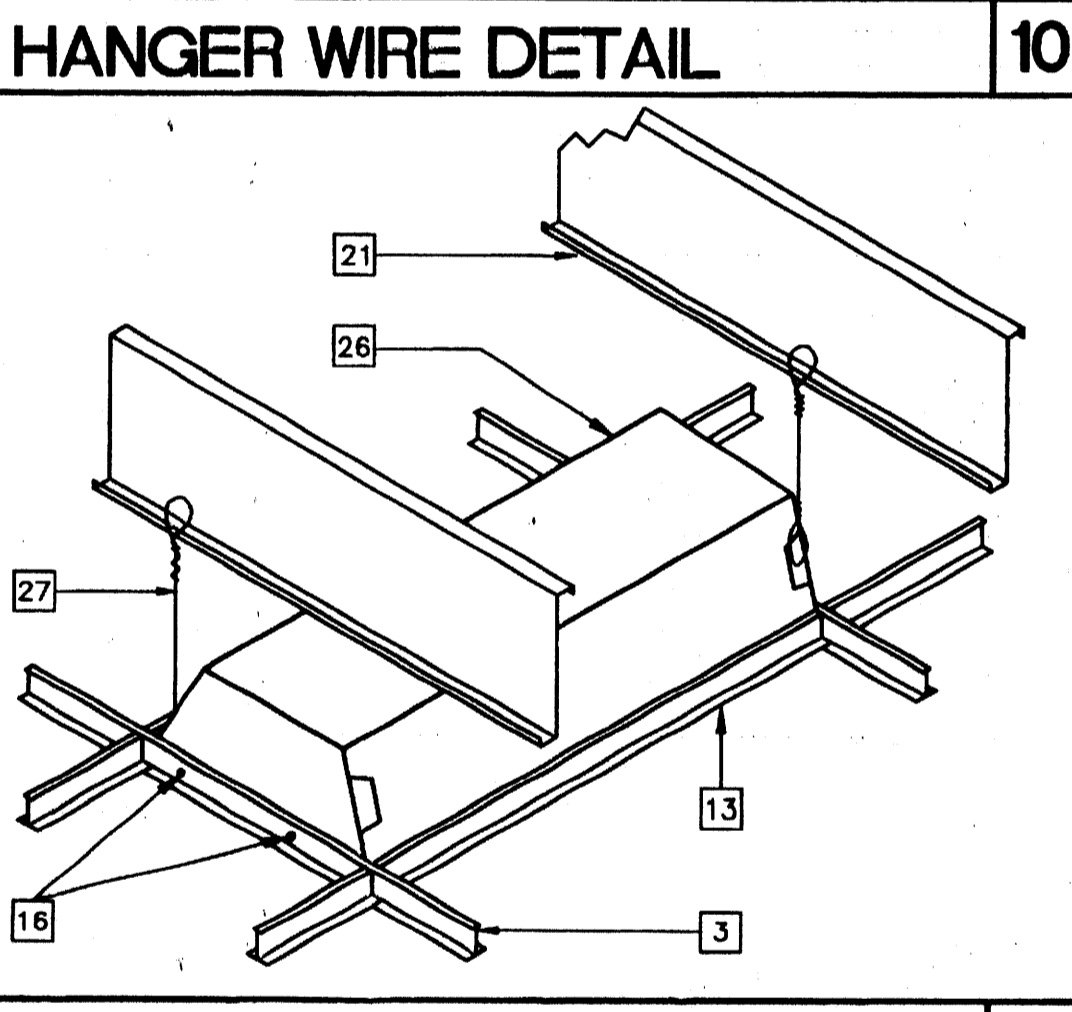




19

15 LIGHT FIXTURE MOUNTING

11 TYPICAL FIXED SIDE

7 COMPRESSION STRUT

3

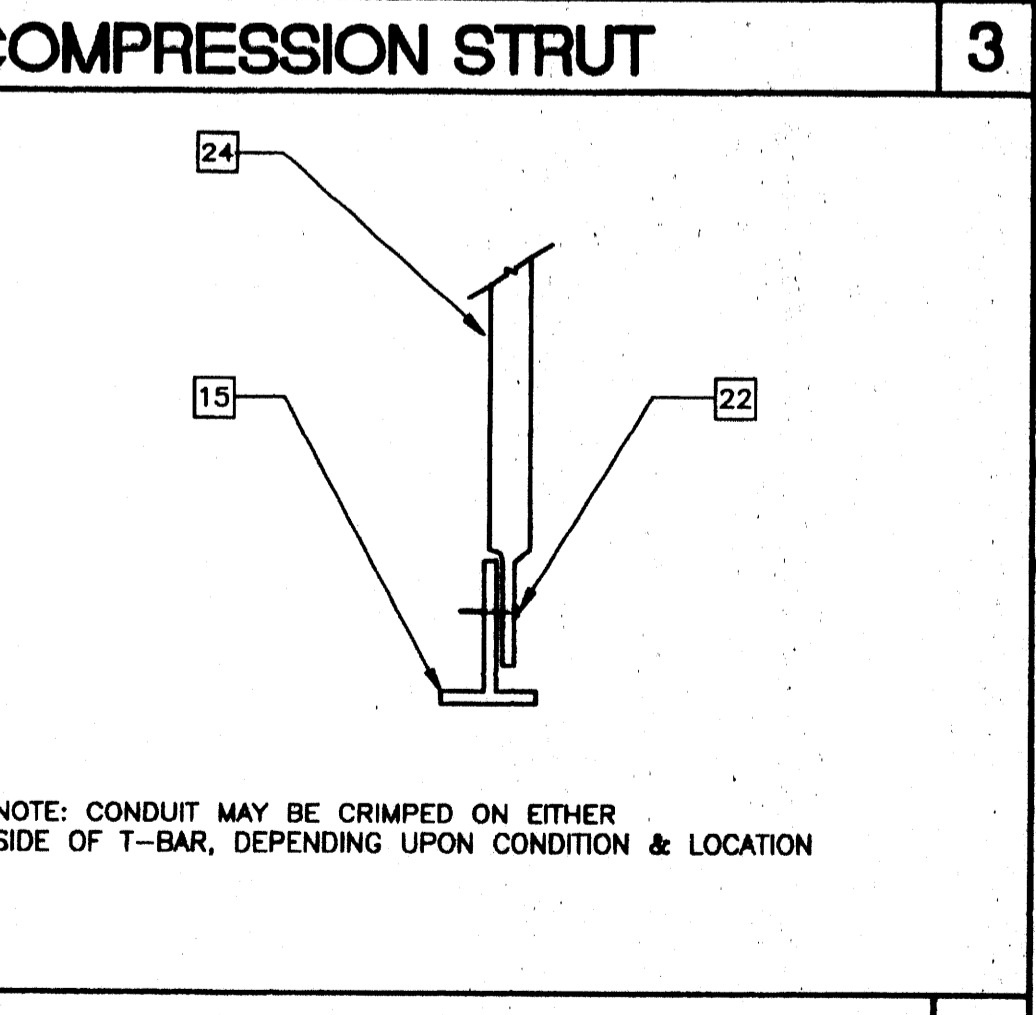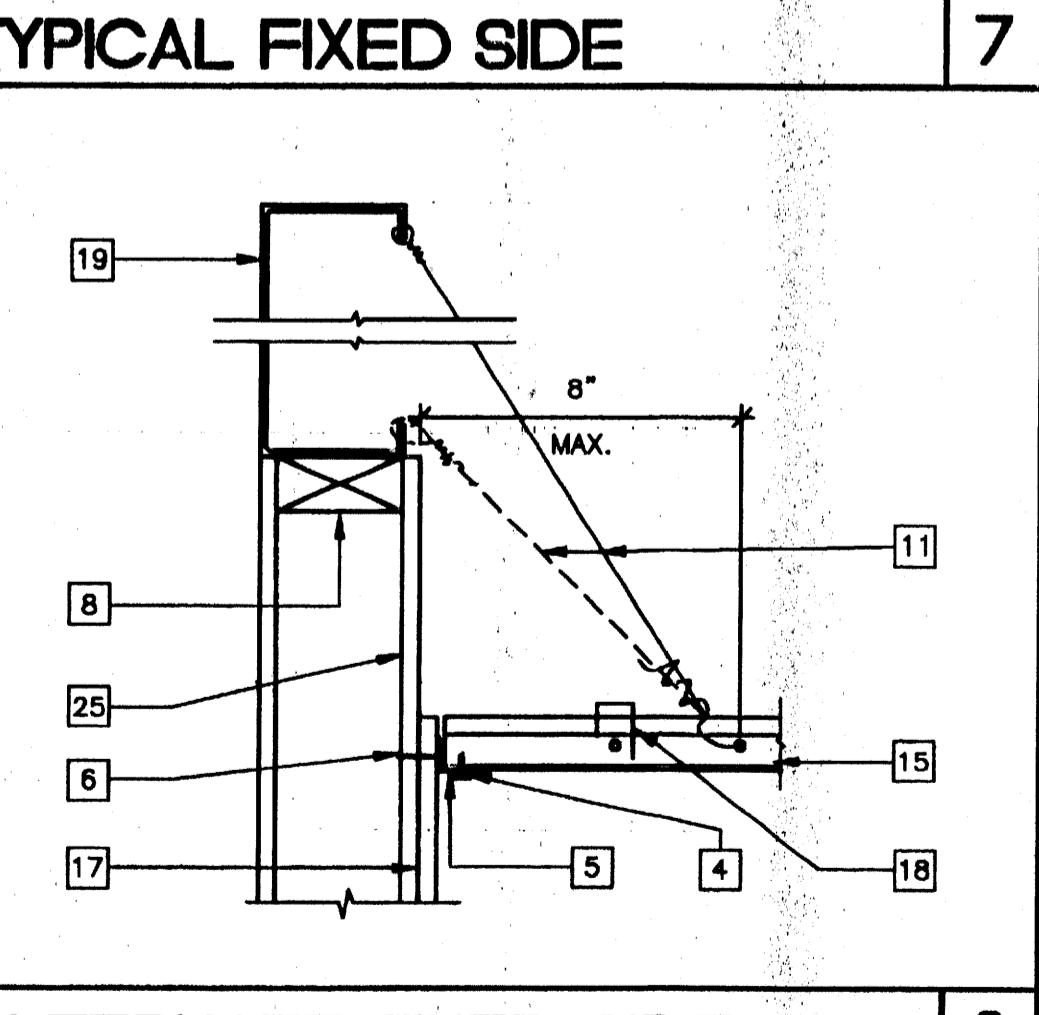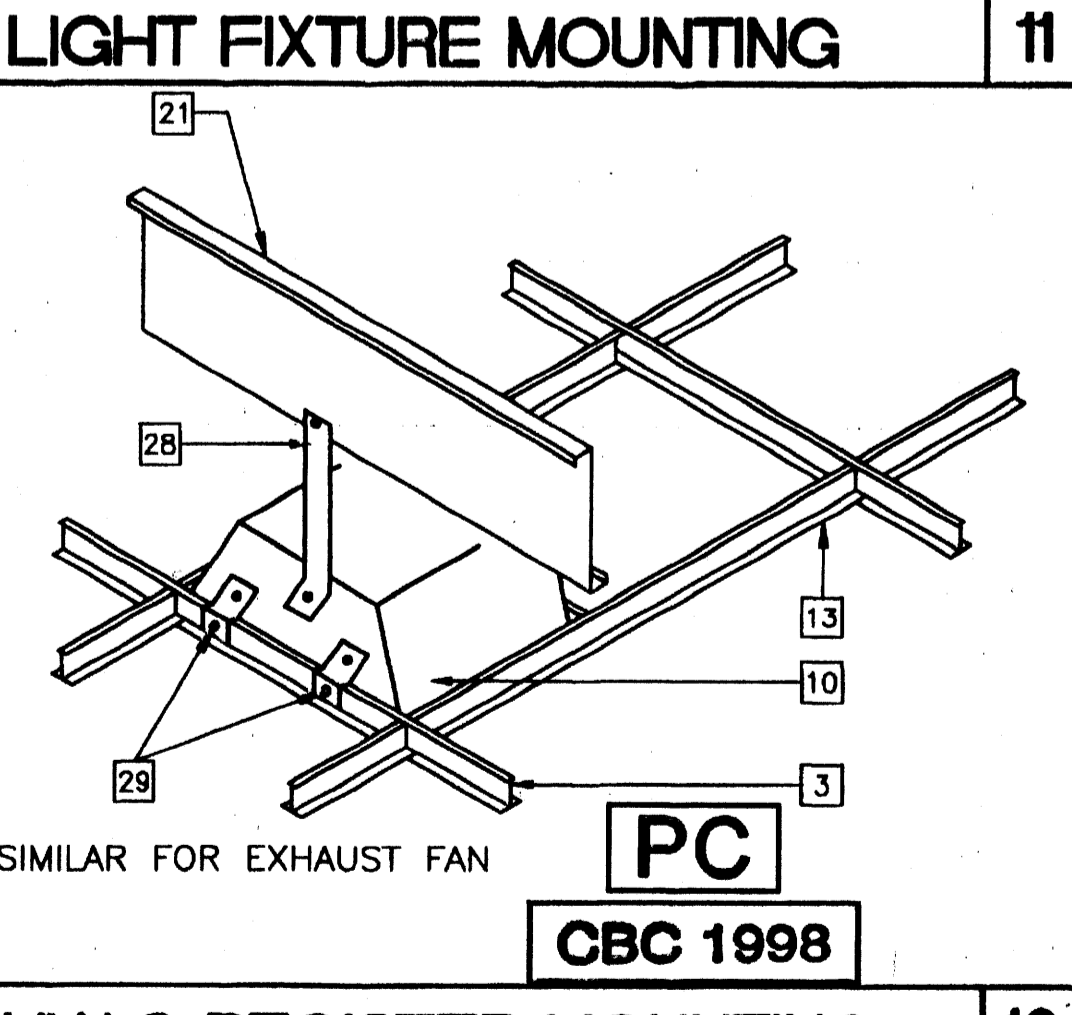

20


16 HVAC REGISTER MOUNTING

12 ALTERNATE FIXED SIDE

8 ALTERNATE COMPRESSION STRUT

4

- ### NOTES
- ALL HANGER, SPLAY BRACE & SLACK WIRES SHALL BE 12 GA WITH MIN 4 TIGHT TURNS WITHIN 1 1/2" MAX OF EACH END

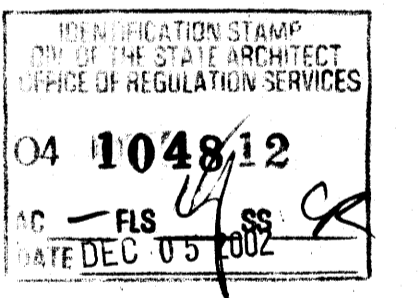

REVISIONS	DESCRIPTION	DATE
1		
2		
3		
4		
5		

Electrical Engineer's Seal
Mechanical Engineer's Seal
Structural Engineer's Seal
Architect's Seal


IDENTIFICATION STAMP
DIV. OF THE STATE ARCHITECT
OFFICE OF REGULATION SERVICES
PC-04
101268
DATE: 07-10-00

MODTECH INC.
2830 BARRETT AVENUE
PERRIS, CALIF. 92572
PH (909) 943-4014
FAX (909) 940-0427


PROJECT NUMBER: 4373
COLTON U.S.D.
© MODTECH, INC. 2002
DRAWN BY: KK
DATE: 11/19/02
CHECKED BY: STKP-67
DATE: 4/12-124
MODTECH Index No.

A7.11


PROJECT NO. 4373
FILE PATH: 2440-A7.11.DWG

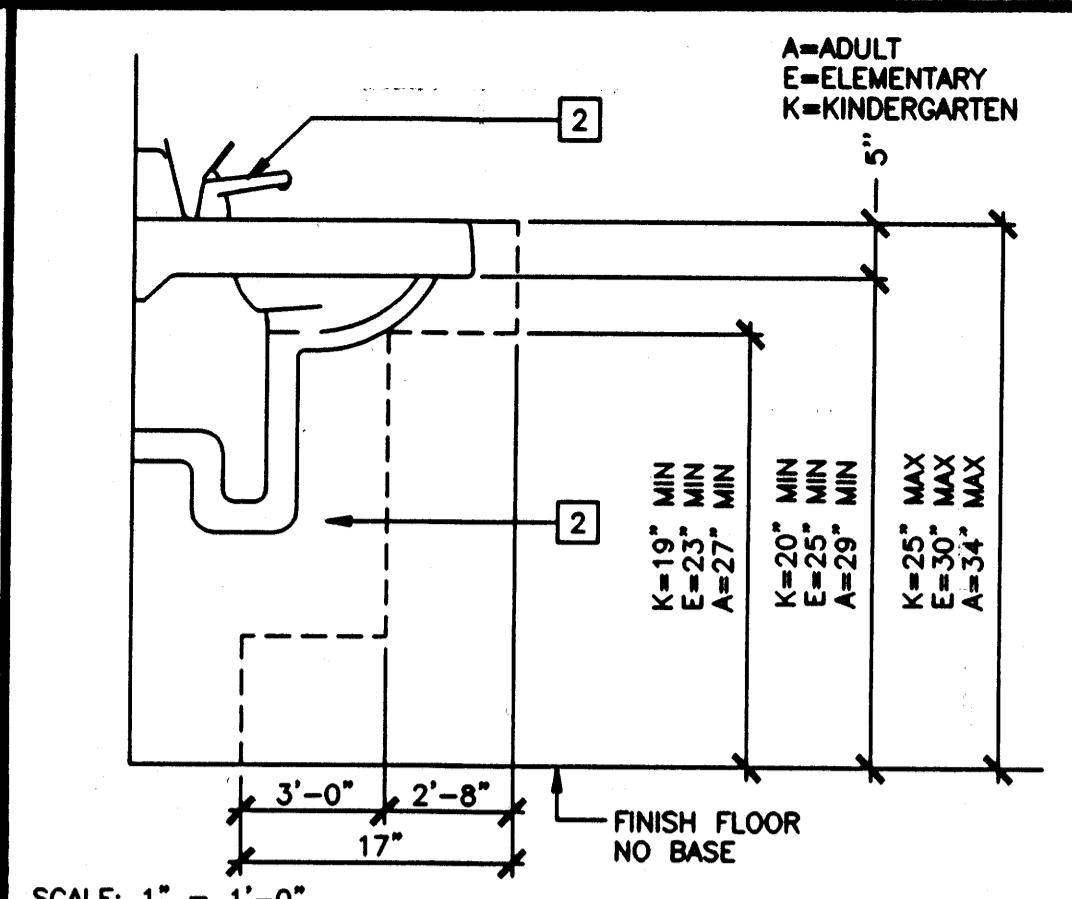

ACCESSIBLE LAV CLEARANCE 12

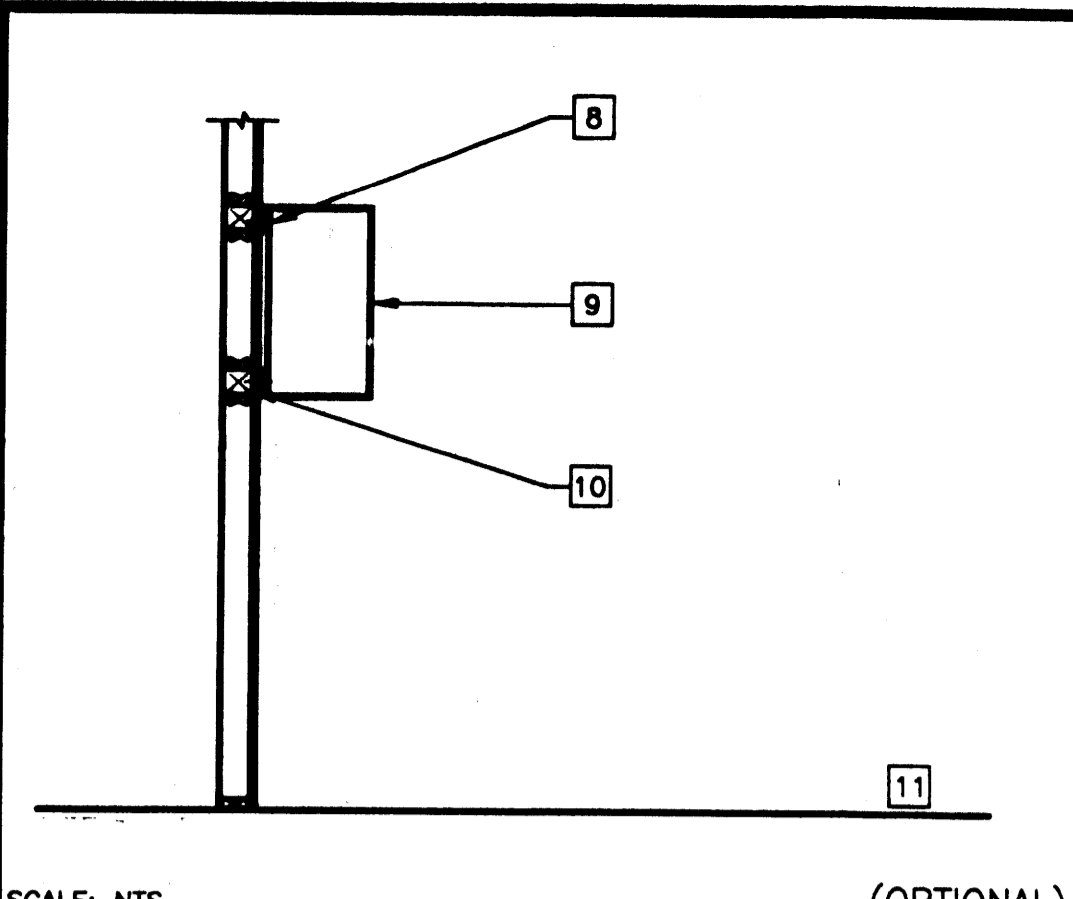


WALL HUNG CABINET ANCHORAGE 8

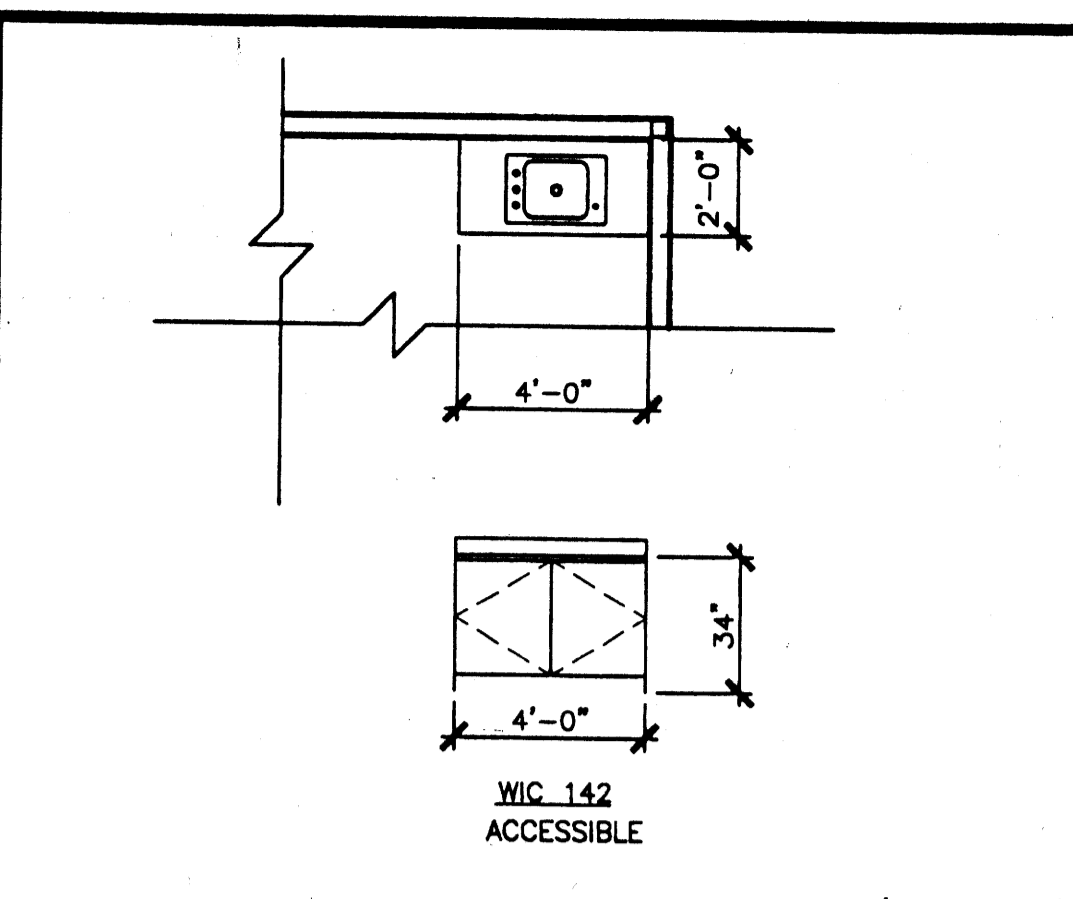


TYPICAL SINK CABINET PLAN AND ELEVATION 4


- KEY NOTES**
- 1 FAUCET MECHANISM SHALL BE OPERABLE WITH ONE HAND AND SHALL NOT REQUIRE TIGHT GRASPING, PINCHING OR TWISTING OF THE WRIST. MAX OPERATING FORCE REQUIRED: 5lb.
 - 2 ACCESSIBLE CLEAR AREA (NO SHARP OR ABRASIVE EDGES)
 - 3 REMOVABLE TOEKICK
 - 4 SILL PLATE
 - 5 GRADE
 - 6 SOV
 - 7 BY OTHERS
 - 8 #12 WOOD SCREWS MIN. 12" OC MIN 2 1/2" INTO 3x4 BLOCKING 2 SCREWS PER CABINET AT EACH BACKING LOCATIONS TYPICAL WALL HUNG CASEWORK
 - 9 ANCHORAGE: 3x4 BLOCKING WITH PAIR OF SIMPSON A35 FRAMING CLIPS EACH END OF EACH BLOCK VERIFY VERTICAL SPACING FINISH GRADE
 - 10 4"x22 GA CONTINUOUS METAL STRAPS WITH #14 STMS AT 24" OC
 - 11 BACK SPLASH
 - 12 BASE CABINET
 - 13 TALL CASEWORK
 - 14 TOP SET BASE
 - 15 SIGNAGE BY DISTRICT PRIOR TO OCCUPANCY.

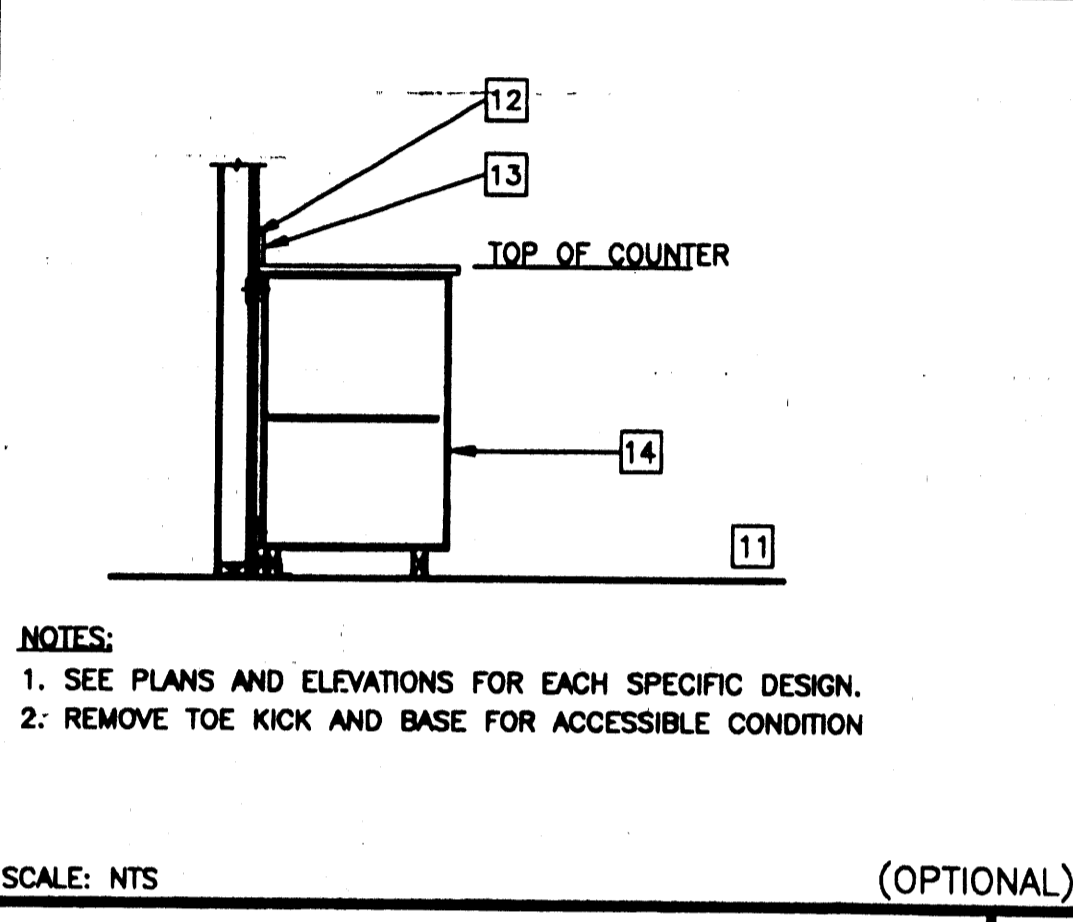


BASE CABINET ANCHORAGE 9

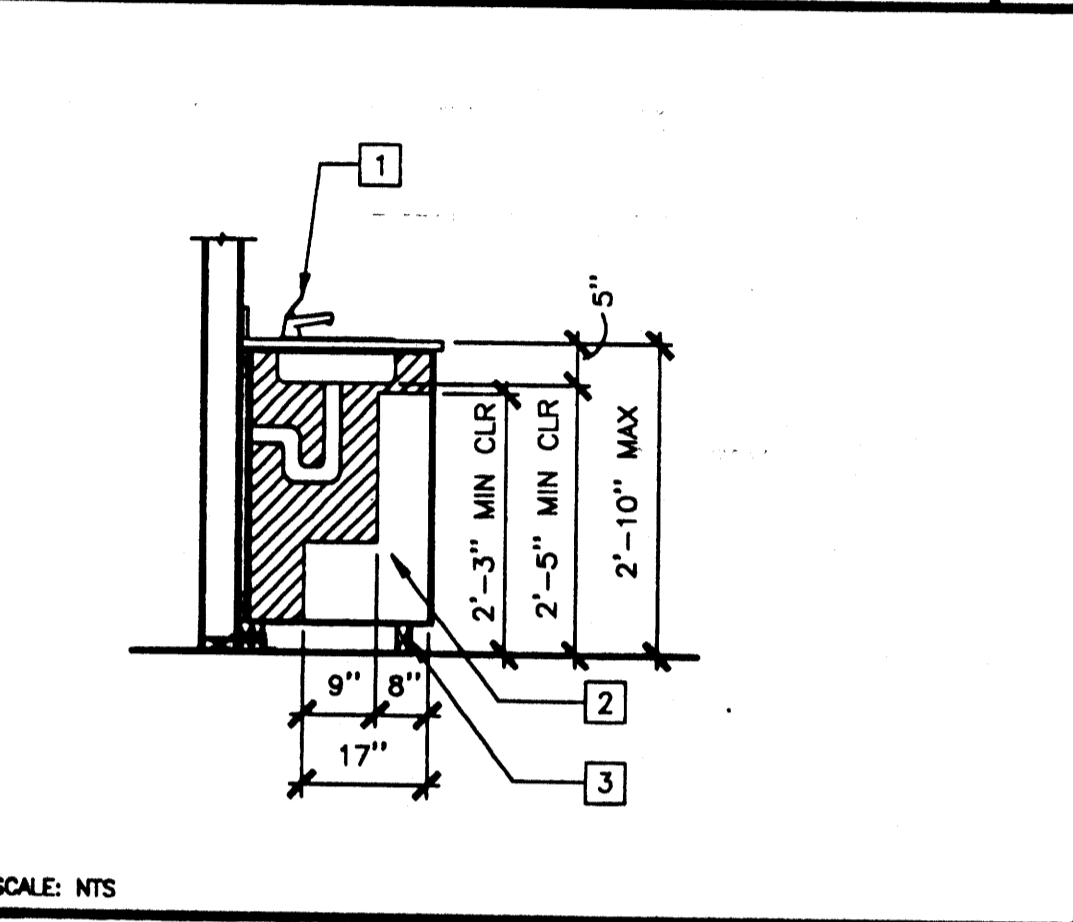


SINK ACCESSIBILITY 5

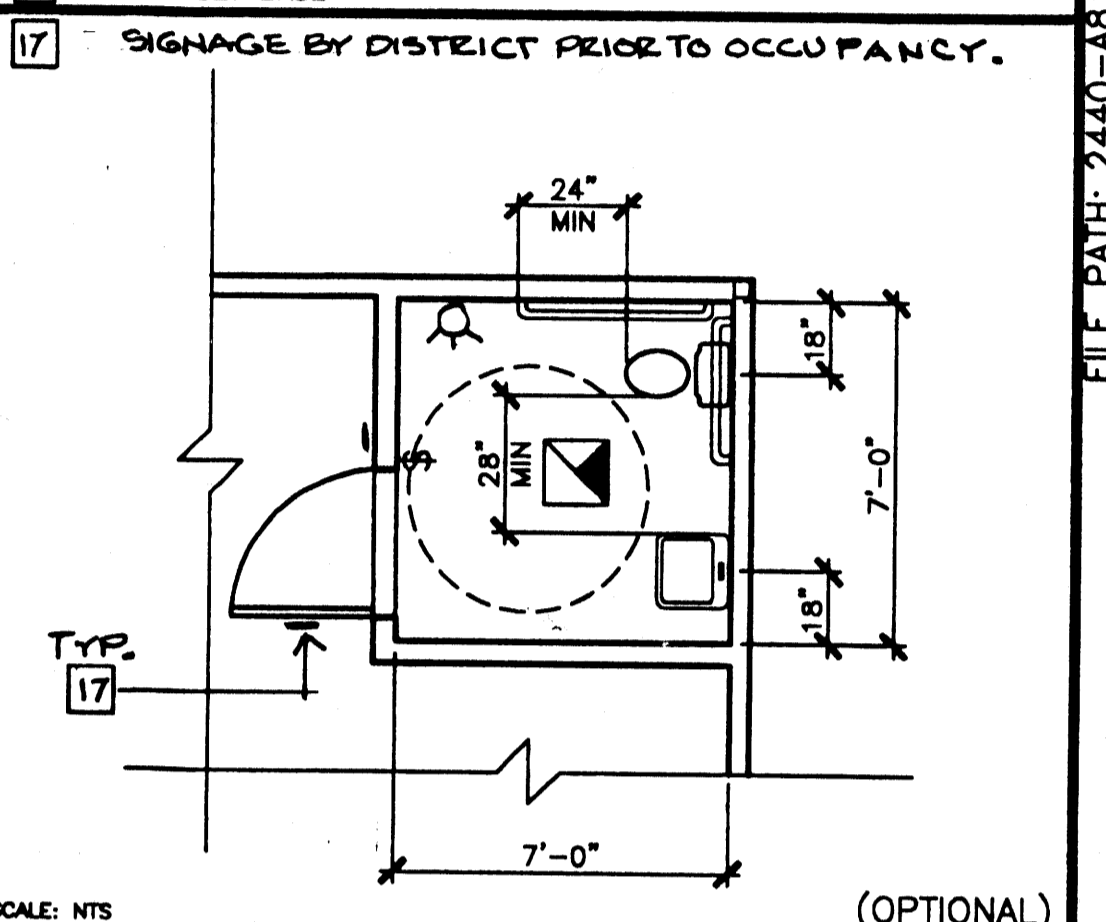


TYPICAL TOILET ROOM PLAN 1

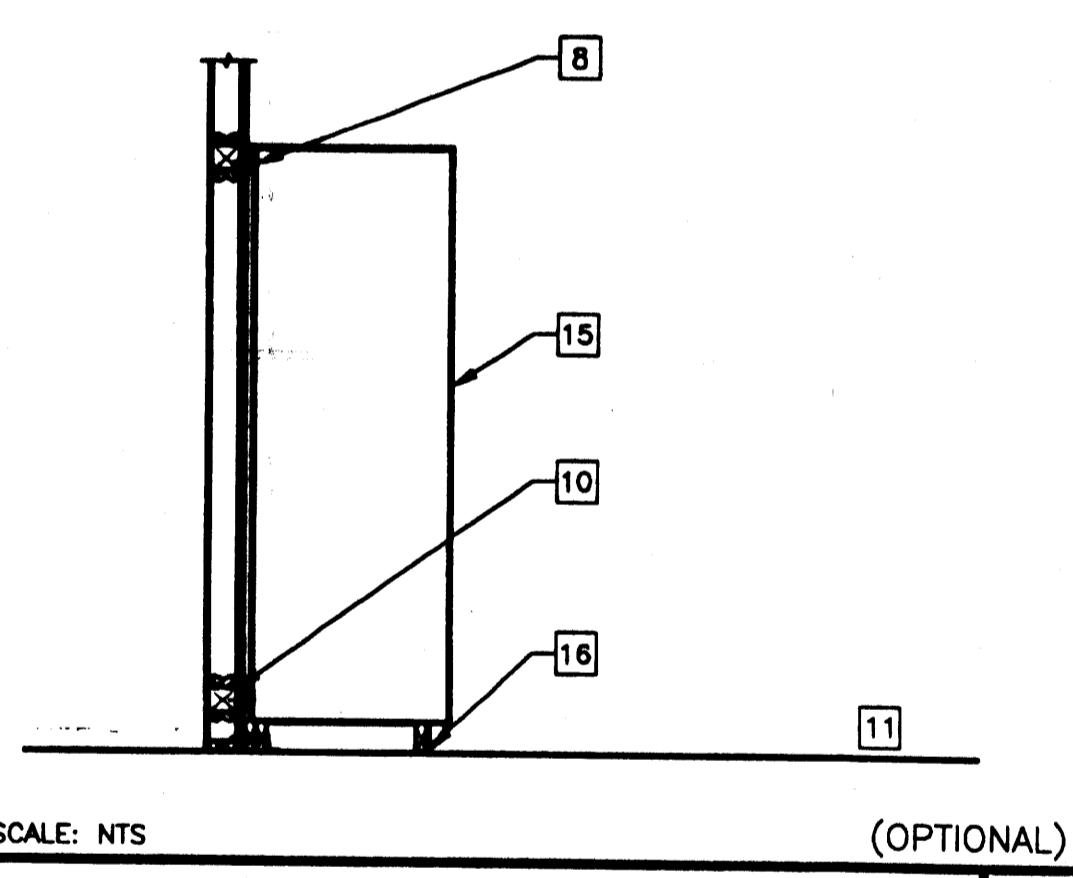

TALL CABINET ANCHORAGE 10

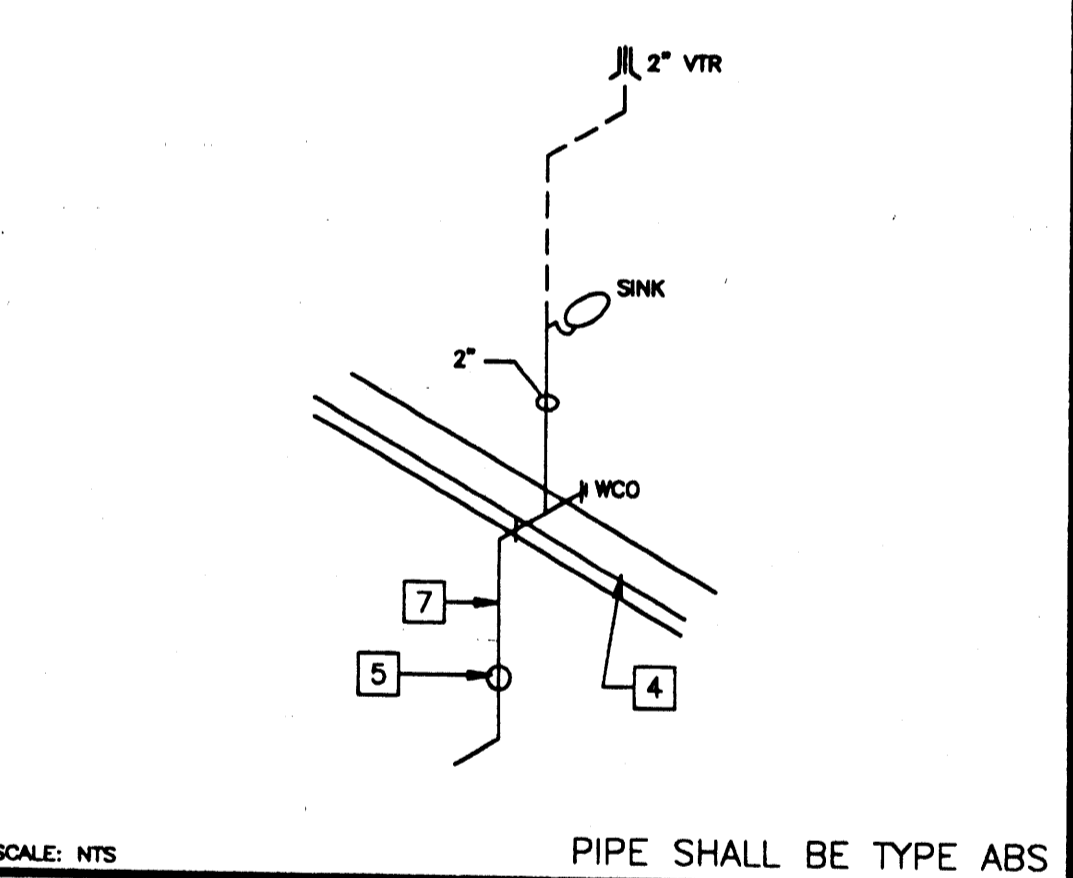

SINK CABINET WASTE 6

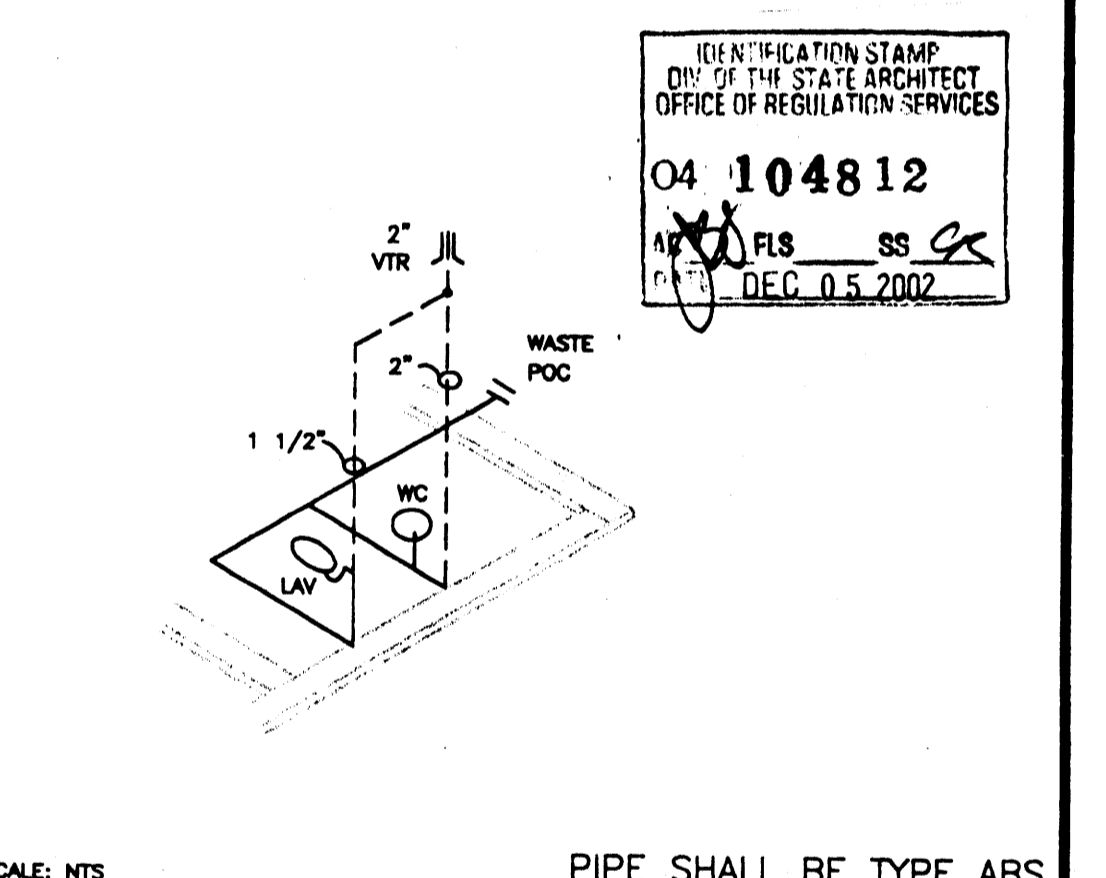


TOILET ROOM WASTE 2

RECESSED OR SEMI RECESSED


	A	E	K
TOILET CENTER FROM WALL	18"	15"	12"
TOILET SEAT HEIGHT	17"-19"	15"	10"-12"
GRAB BAR HEIGHT (SIDE)	33"	27"	20"-22"
TOILET PAPER IN FRONT OF TOILET	12" MAX	6" MAX*	6" MAX*
NAPKIN DISPOSAL IN FRONT OF TOILET	12" MAX	12" MAX	N/A
DISPENSER OR MIRROR HEIGHT	40" MAX	36" MAX	32" MAX
LAVATORY/SINK TOP HEIGHT	34" MAX	29" MAX	24" MAX
LAVATORY/SINK KNEE HEIGHT	27" MAX	24" MAX	19" MAX
SINK DEPTH	7" MAX	5" MAX	5" MAX
URINAL LIP HEIGHT	17" MAX	15" MAX	13" MAX
URINAL FLUSH HANDLE HEIGHT	44" MAX	37" MAX	32" MAX
DRINKING FOUNTAIN BUBBLER HEIGHT	36" MAX	32" MAX	30" MAX
DRINKING FOUNTAIN KNEE CLEARANCE	27" MIN	24" MIN	22" MIN
BUBBLER HEIGHT	2"	3"	6"
RAMP/STAIR HANDRAIL HEIGHT	34"-38"	27"	22"

A = ADULT DIMENSIONS (AGE 12 AND OVER)
 E = ELEMENTARY DIMENSIONS
 K = KINDERGARTEN AND PRE-SCHOOL DIMENSIONS
 * = DEVIATES FROM CODE REQUIREMENTS AND REQUIRES A WRITTEN FINDING OF UNREASONABLE HARDSHIP

NOTE: DIMENSIONS FROM 1998 CBC TABLE 1115B-1

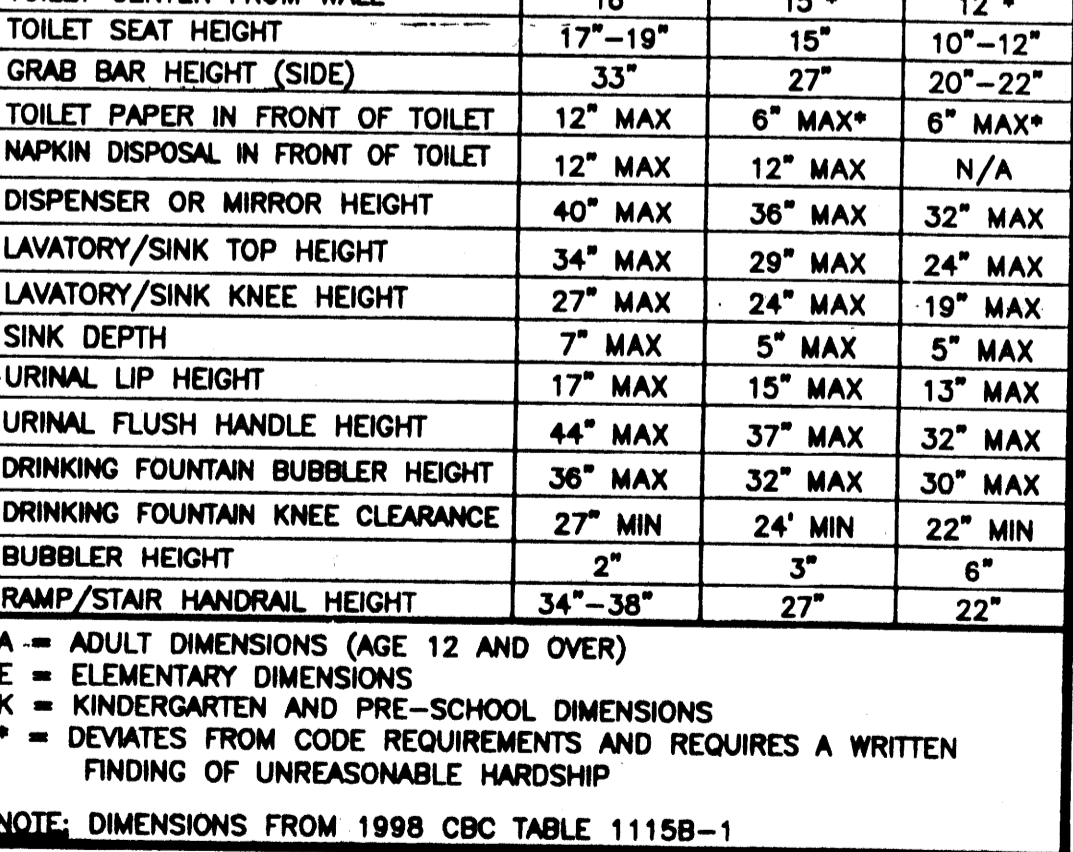

SINK CABINET COLD WATER SUPPLY 7

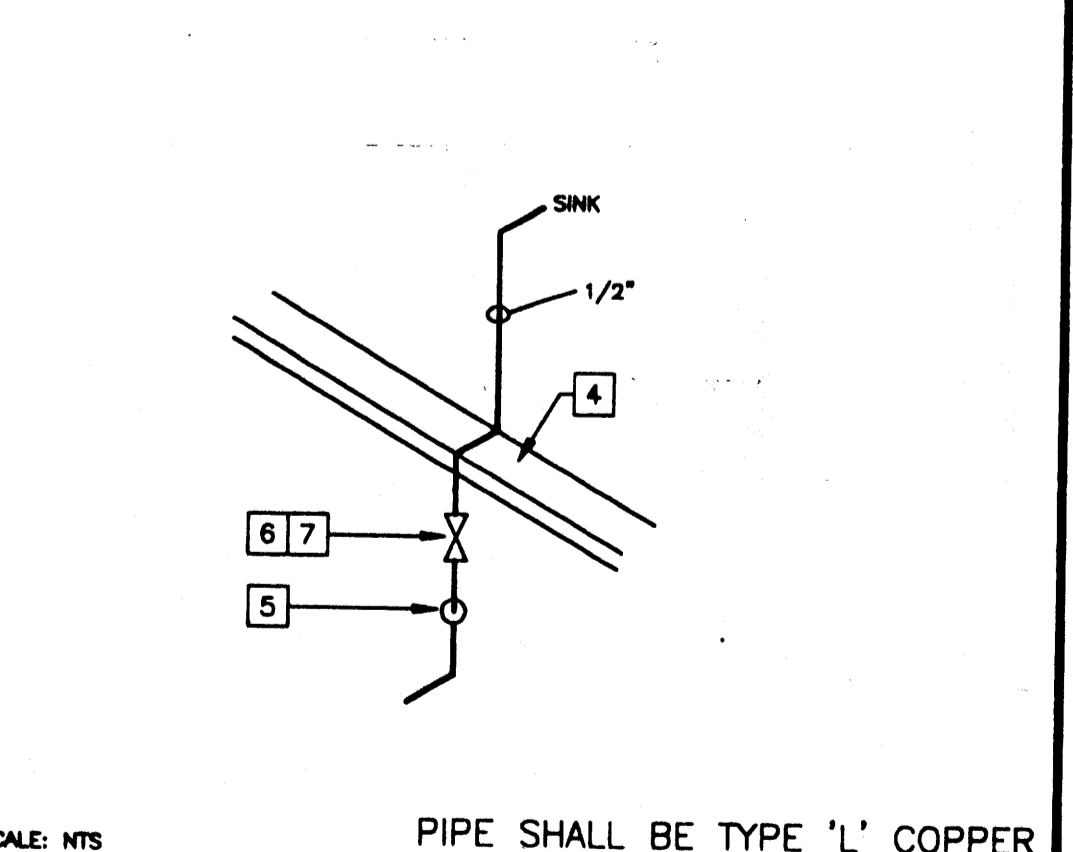

TOILET ROOM COLD WATER SUPPLY 3

ACCESSIBILITY 11

MODTECH INC.
 2830 BARRETT AVENUE
 PERRIS, CALIF. 92572
 PH (909) 943-4014
 FAX (909) 940-0427

MISCELLANEOUS OPTIONS

PROJECT NUMBER: _____
 © MODTECH, INC. 1999

A8.01

DRAWN BY: _____
 DATE: _____
 CHECKED BY: STKP-67
 DATE: 4012-124
 MODTECH Index No. _____

REVISIONS

1					
2					
3					
4					
5					

Electrical Engineer's Seal _____
 Mechanical Engineer's Seal _____
 Structural Engineer's Seal _____
 Architects Seal _____

IDENTIFICATION STAMP
 DIV. OF THE STATE ARCHITECT
 OFFICE OF REGULATION SERVICES
 PC-04
 101268
 DATE: SEP 07 1999

PC
 CBC 1998

FILE PATH: 2440-AB.01.DWG PROJECT NO. PC-04-101268

ELECTRICAL PANEL SCHEDULE


LOAD	WATTS		BREAKER		REAR/INTERIOR		BREAKER		WATTS		LOAD	
	A#	B#	Amps	P	CT	A	B	P	Amps	A#		B#
RECEPTACLE	(4)	720	20	1	1	2	2	50	3360	HVAC (3 1/2T)		
RECEPTACLE/CLOCK	(5)	720	20	1	3	4	-	-	3360	HVAC (3 1/2T)		
					5	6	2	30	2500	HEAT STRIPS (5KW)		
					7	8	-	-	2500	HEAT STRIPS (5KW)		
INT/EXT LIGHTS	(13)	900	20	1	9	10	-	-				
INT. LIGHTS	(12)	840	20	1	11	12	-	-	40	FIRE ALARM (DEDICATED)		
WATTS/PHASE	A = 7480	1620	1560						5860	5900	B = 7460	WATTS/PHASE
TOTAL	15385	WATTS	65	AMPS	120/240	VOLTS			SINGLE #		THREE	WIRE
NCL =	13160	WATTS										

GENERAL GROUNDING NOTES


- EACH BUILDING SHALL BE SEPARATELY GROUNDED WITH A 3/4" RD. X 8' COPPER/ALUM. STEEL GROUND ROD, WHERE ROCK BOTTOM IS ENCOUNTERED, ROD SHALL BE DRIVEN AT AN ANGLE NOT TO EXCEED 45 DEGREE'S FROM THE VERTICAL OR SHALL BE BURIED IN A TRENCH THAT IS AT LEAST 30" DEEP (BY SITE ELECTRICAL)
- TESTING: TEST FOR RESISTANCE TO GROUND, IF RESISTANCE EXCEEDS 25 OHMS, INSTALL ADDITIONAL GROUND RODS SEPARATED AT LEAST 6'-0" UNTIL RESISTANCE IS REDUCED TO 25 OHMS OR LESS. (BY SITE ELECTRICAL)
- APPROVAL OF THIS PLAN DOES NOT CONSTITUTE APPROVAL OF THIS FIRE ALARM FOR ALL SITES. THE FIRE ALARM SYSTEM AND/OR COMPONENTS MAYBE REQUIRED TO BE CHANGED DUE TO SITE LOCATION, EXISTING CONDITIONS OR INCOMPATIBLE COMPONENTS.
- GROUND MG TEST SHALL BE DONE IN THE PRESENCE OF THE PROJECT INSPECTOR. ALL GROUNDING SHALL BE IN ACCORDANCE WITH CEC ARTICLE 250.

ELECTRICAL LEGEND

- 2'x4' 4 TUBE FLUORESCENT LIGHT FIXTURE
- EXTERIOR LIGHT FIXTURE AT +93" AFF
- SWITCH AT +48" AFF
- 3WAY SWITCH AT +48" AFF UON
- DUPLEX WALL RECEPTACLE 15A 125V 3-WIRE AT +18" AFF UON
- HVAC UNIT (HV)
- 4SD J-BOX FOR FIRE ALARM PULL STATION AT +48" AFF, TO 3/4" CO TO PULLSTRING
- 4SD J-BOX FOR FIRE ALARM STROBE AT +80" AFF 3/4" CO TO PULLSTRING
- 4SD J-BOX FOR FIRE ALARM HORN AT +96" AFF 3/4" CO TO PULLSTRING
- WEATHER PROOF GUTTER BOX (6"x6"x4") AT +18" AFF RECEIVE 3/4" CO FROM FA DEVICE, PULLSTRING
- ELECTRICAL PANEL AT +60" AFF TO CENTERLINE 1 1/4" POWER NIPPLE POC, GND JUMPER BY SITE ELECT
- CLOCK AT +90" AFF
- 4SD J BOX FOR HEAT DETECTOR (ATTIC) *
- 4SD J BOX FOR SMOKE DETECTOR (ATTIC) *

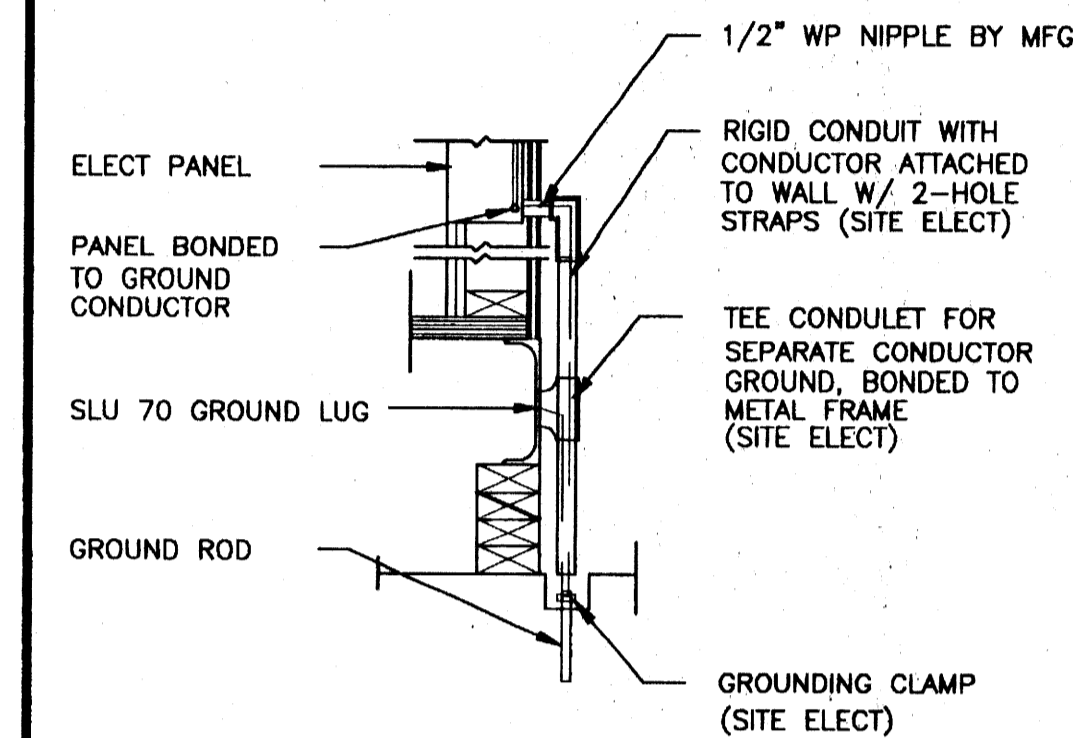


TYP GROUNDING DETAIL 1

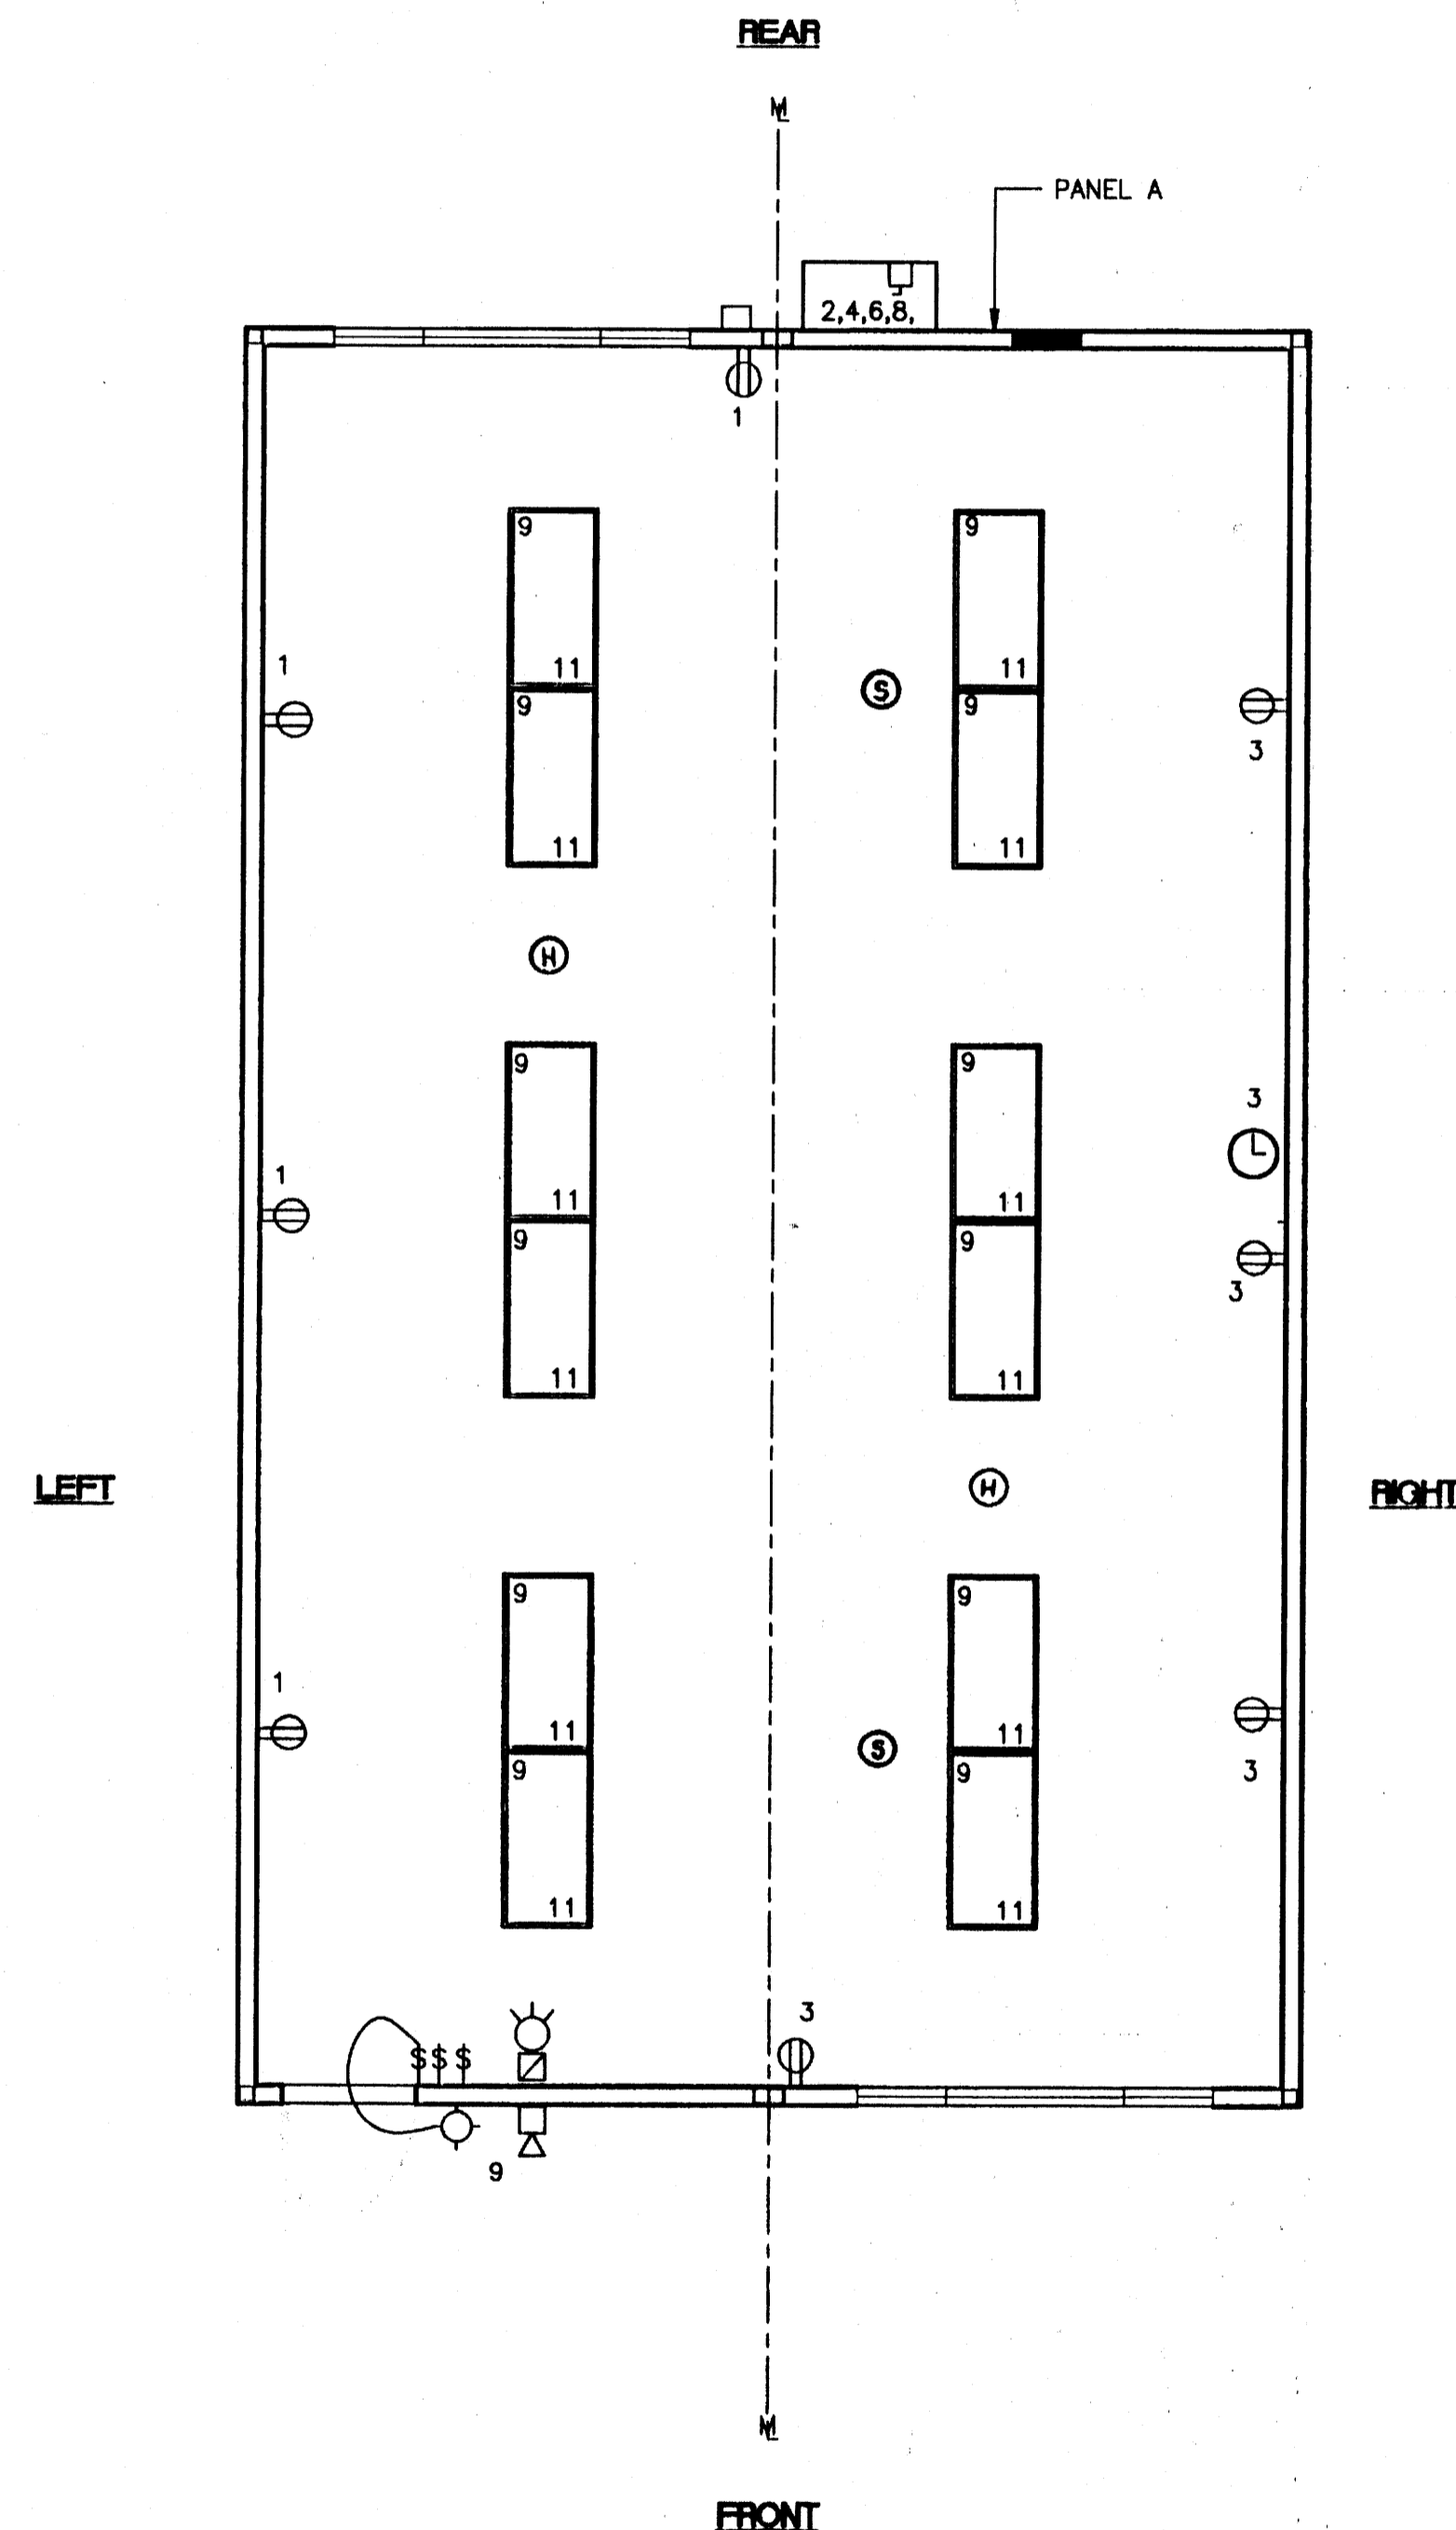

ELECTRICAL PLAN

SCALE: 1/4" = 1'-0"

GROUND JUMPER AT MOD LINE 2

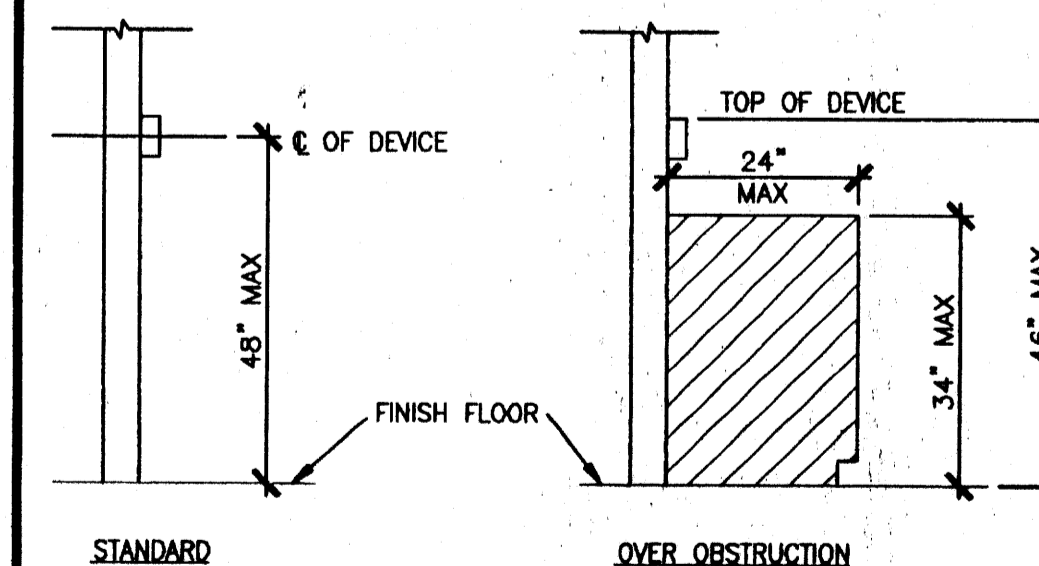


DEVICE MOUNTING 3

PROJECT NUMBER: 4373, 4378, 4435 © MODTECH, INC. 2002
4474, 4505, 4525

NOTES

- SCHOOL EQUIPMENT ANCHORAGE
THE FOLLOWING IS FOR THE ARCHITECTS INFORMATION ONLY:
THE SEISMIC ANCHORAGE OF ELECTRICAL EQUIPMENT SHALL CONFORM TO CCR TITLE 24, SECTION 1632A AND TABLE 16A-0. ANCHORAGE DETAILS FOR ROOF/FLOOR MOUNTED EQUIPMENT WEIGHING LESS THAN 400 LBS & HUNG EQUIPMENT WEIGHING LESS THAN 20 LBS MAY BE OMITTED FROM THE PLANS.
~~ALL ELECTRICAL EQUIPMENT SHALL BE BRACED OR ANCHORED TO RESIST A HORIZONTAL FORCE AGING IN ANY DIRECTION USING THE FOLLOWING DETAILS:~~
~~EQUIPMENT ON CEILING~~
~~EQUIPMENT ON WALL~~
FOR FLEXIBLY MOUNTED EQUIPMENT USE 4 TIMES THE ABOVE VALUES AND FOR SIMULTANEOUS VERTICAL FORCE USE 1/2 TIMES THE HORIZONTAL FORCE.
THE ABOVE VALUES ARE FOR UN-IMPARTING EJECTORS AND GROUNDING DEVICES.
WHERE ANCHORAGE DETAILS ARE NOT SHOWN ON THE DRAWINGS THE FIELD INSTALLATION SHALL BE SUBJECT TO THE APPROVAL OF THE ARCHITECT AND THE FIELD ENGINEER OF THE OFFICE OF THE STATE ARCHITECT.
- SMOKE AND HEAT DETECTORS SHOWN ARE FOR OPTIONAL AUTOMATIC DETECTION. IF ELECTED AS AN OPTION MODTECH WILL PROVIDE 4SD BOXES AND 3/4" CO MOUNTED ON UNDERSIDE OF ROOF PURLINS. DEVICES PROVIDED AND INSTALLED BY OTHERS

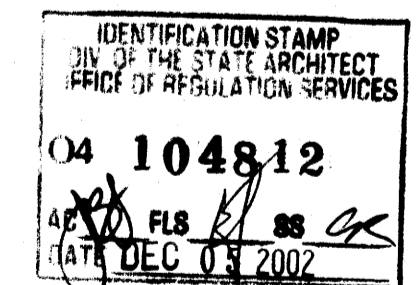

CBC 1993

REVISIONS	Electrical Engineer's Seal	Mechanical Engineer's Seal	Structural Engineer's Seal	Architect's Seal
1				
2				
3				
4				
5				

Professional seals for Electrical, Mechanical, Structural, and Architectural engineers. Includes the Architect's Seal for Gary C. Edwards, No. C 2556, State of California, dated 07/17/00.

IDENTIFICATION STAMP: DIV. OF THE STATE ARCHITECT, OFFICE OF REGULATION SERVICES, PC-04, 101268, DATE SEP 17 2000.

MODTECH INC. 2830 BARRETT AVENUE, PERRIS, CALIF. 92572. PH (909) 943-4014, FAX (909) 940-0427.

ELECTRICAL PLAN

24'x40'

E1.01

FILE PATH: 2440-ET-01.DWG PROJECT NO. 4373 PC-04-101268

ELECTRICAL PANEL SCHEDULE


LOAD	WATTS		BREAKER				WATTS		LOAD		
	A#	B#	Amps	P	U	P	Amps	A#		B#	
RECEPTACLE (4)	720		20	1	1	2	2	50	3360	HVAC (3 1/2T)	
RECEPTACLE/CLOCK (5)	720		20	1	3	4	-	-	3360	HVAC (3 1/2T)	
					5	6	2	30	2500	HEAT STRIPS (5KW)	
					7	8	-	-	2500	HEAT STRIPS (5KW)	
INT/EXT LIGHTS (13)	900		20	1	9	10	-	-			
INT. LIGHTS (12)		840	20	1	11	12	-	-			
WATTS/PHASE	A = 7480	1620	1560					5860	5900	B = 7460	WATTS/PHASE
TOTAL	15385	WATTS	65	AMPS	120/240	VOLTS		SINGLE #		THREE	WIRE
NCL =	13160	WATTS									

GENERAL GROUNDING NOTES

- EACH BUILDING SHALL BE SEPARATELY GROUNDED WITH A 3/4" RD. X 8' COPPERCLAD STEEL GROUND ROD, WHERE ROCK BOTTOM IS ENCOUNTERED, ROD SHALL BE DRIVEN AT AN ANGLE NOT TO EXCEED 45 DEGREE'S FROM THE VERTICAL OR SHALL BE BURIED IN A TRENCH THAT IS AT LEAST 30" DEEP (BY SITE ELECTRICAL)
- TESTING: TEST FOR RESISTANCE TO GROUND, IF RESISTANCE EXCEEDS 25 OHMS, INSTALL ADDITIONAL GROUND RODS SEPARATED AT LEAST 6'-0" UNTIL RESISTANCE IS REDUCED TO 25 OHMS OR LESS. (BY SITE ELECTRICAL)
- APPROVAL OF THIS PLAN DOES NOT CONSTITUTE APPROVAL OF THIS FIRE ALARM FOR ALL SITES. THE FIRE ALARM SYSTEM AND/OR COMPONENTS MAYBE REQUIRED TO BE CHANGED DUE TO SITE LOCATION, EXISTING CONDITIONS OR INCOMPATIBLE COMPONENTS.
- GROUND MG TEST SHALL BE DONE IN THE PRESENCE OF THE PROJECT INSPECTOR. ALL GROUNDING SHALL BE IN ACCORDANCE WITH CEC ARTICLE 250.

ELECTRICAL LEGEND


- 2'x4' 4 TUBE FLUORESCENT LIGHT FIXTURE
- EXTERIOR LIGHT FIXTURE AT +93" AFF
- SWITCH AT +48" AFF
- 3WAY SWITCH AT +48" AFF UON
- DUPLEX WALL RECEPTACLE 15A 125V 3-WIRE AT +18" AFF UON
- HVAC UNIT (HV)
- 4SD J-BOX FOR FIRE ALARM PULL STATION AT +48" AFF, TO 3/4" CO TO OR PULLSTRING
- 4SD J-BOX FOR FIRE ALARM STROBE AT +80" AFF 3/4" CO TO PULLSTRING
- 4SD J-BOX FOR FIRE ALARM HORN AT +96" AFF 3/4" CO TO PULLSTRING
- WEATHER PROOF GUTTER BOX (6"x6"x4") AT +18" AFF RECEIVE 3/4" CO FROM FA DEVICE, PULLSTRING
- ELECTRICAL PANEL AT +60" AFF TO CENTERLINE 1 1/4" POWER NIPPLE POC, GND JUMPER BY SITE ELECT
- CLOCK AT +90" AFF
- 4SD J BOX FOR HEAT DETECTOR (ATTIC) *
- 4SD J BOX FOR SMOKE DETECTOR (ATTIC) *

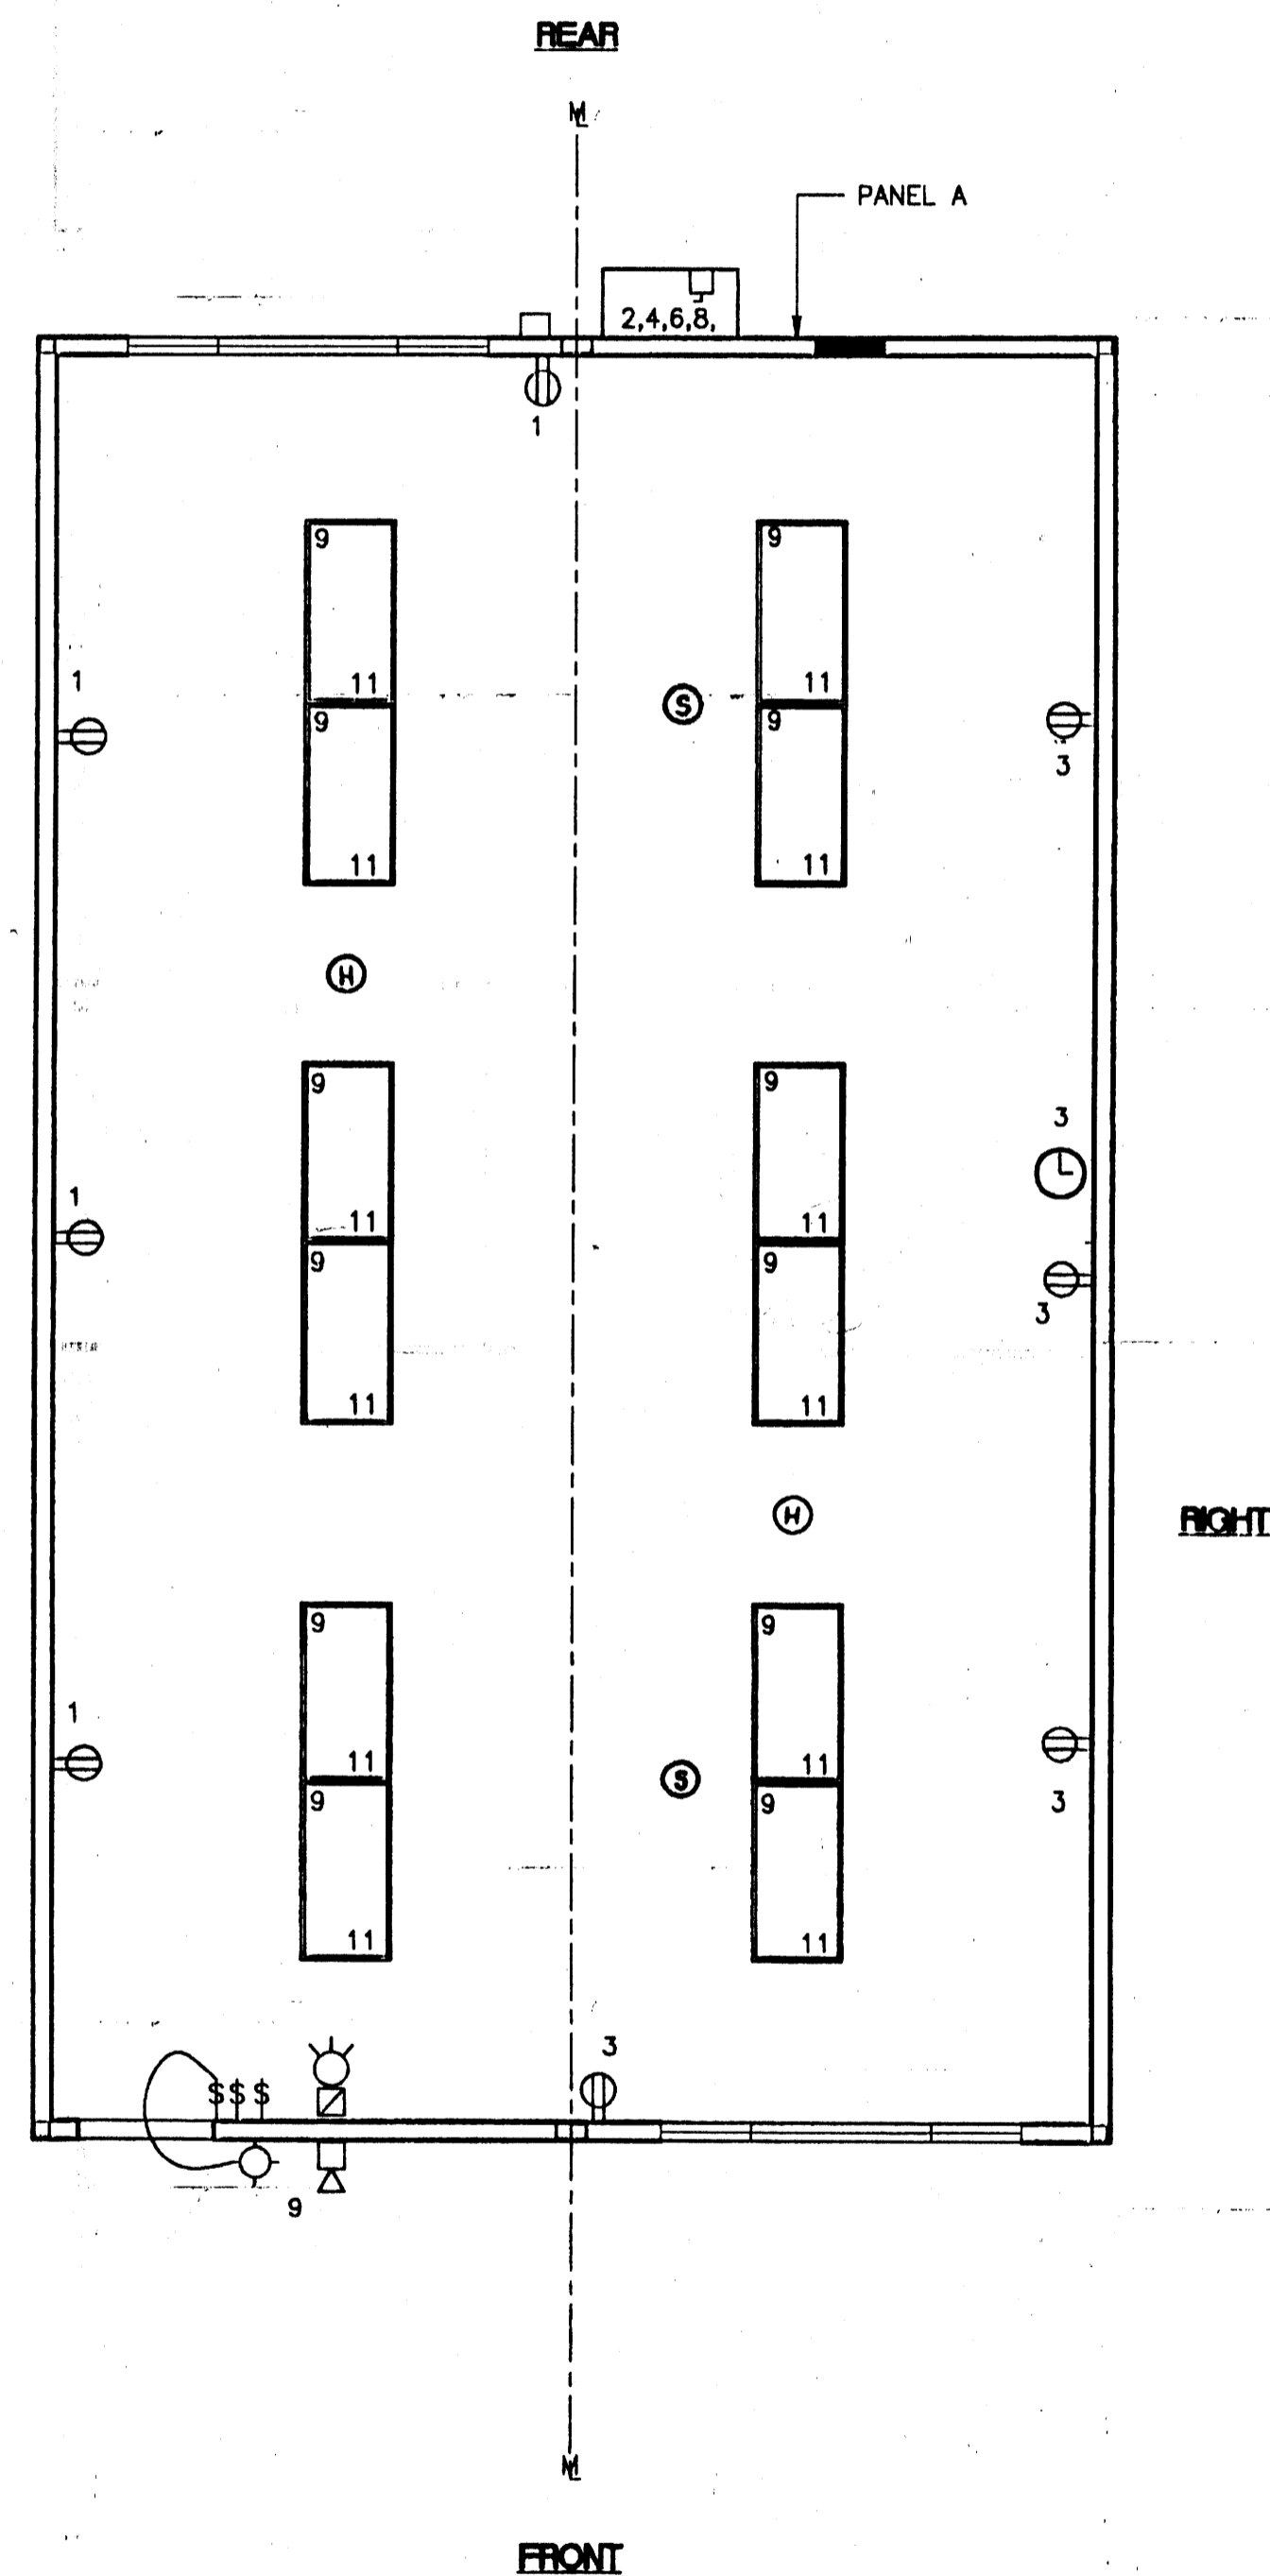


ELECTRICAL PLAN

(24'x40')
SCALE: 1/4" = 1'-0"

TYP GROUNDING DETAIL

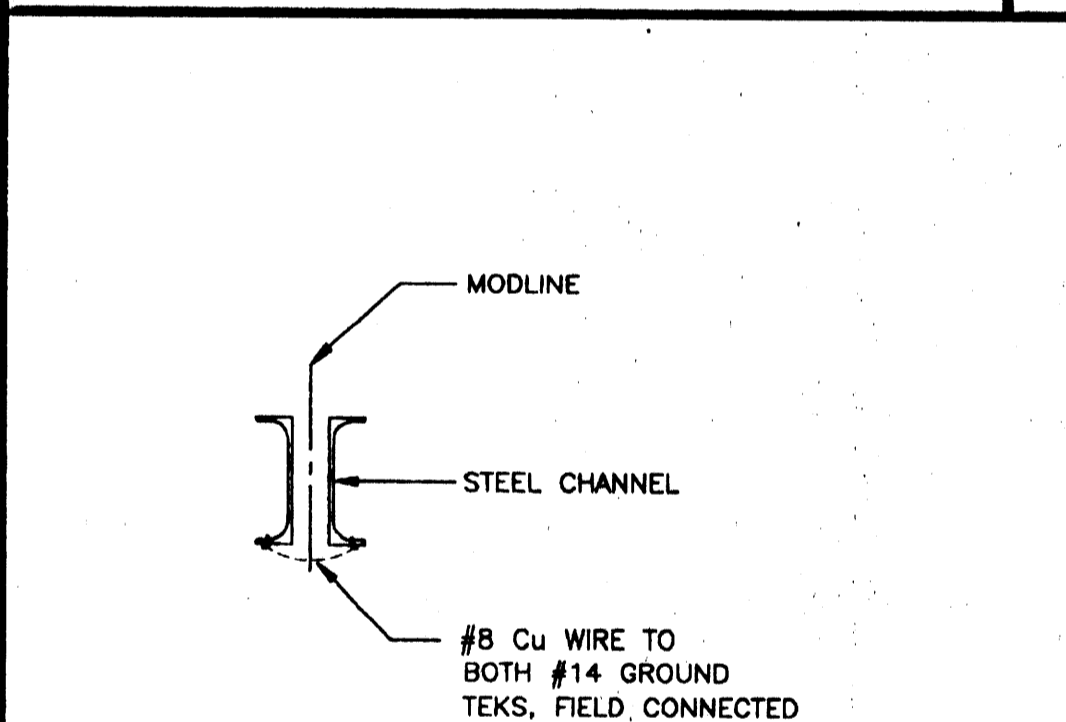

GROUND JUMPER AT MOD LINE

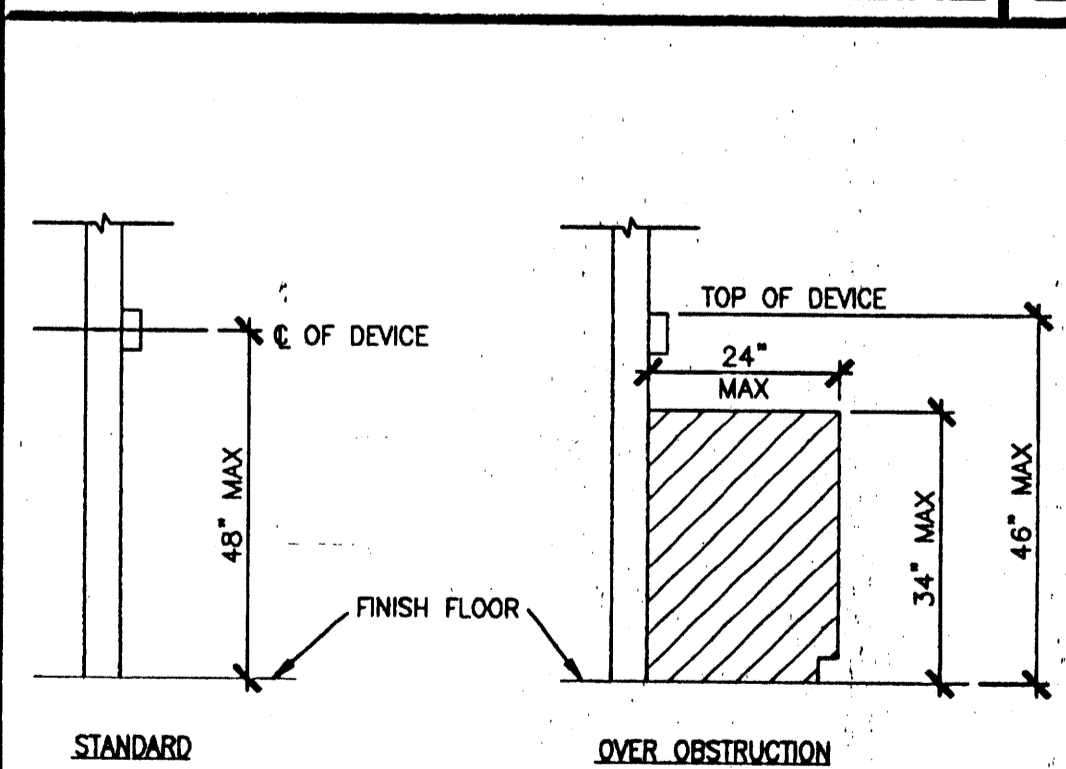


DEVICE MOUNTING

PROJECT NUMBER: 4373, 4378, 4438 © MODTECH, INC. 2002
4474- 10-24 X 40 CLASSROOMS A# 04-104812
SERIAL # 46974-01/02 TO 46978-01/02
SERIAL # 47176-01/02 TO 47176-01/02
4474 STOCK-LATHROP STOCKPILE #67

NOTES

- SCHOOL EQUIPMENT ANCHORAGE
THE FOLLOWING IS FOR THE ARCHITECTS INFORMATION ONLY:
THE SEISMIC ANCHORAGE OF ELECTRICAL EQUIPMENT SHALL CONFORM TO COR TITLE 24, SECTION 1632A AND TABLE 16A-0. ANCHORAGE DETAILS FOR ROOF/FLOOR MOUNTED EQUIPMENT WEIGHING LESS THAN 400 LBS & HUNG EQUIPMENT WEIGHING LESS THAN 20 LBS MAY BE OMITTED FROM THE PLANS.
ALL ELECTRICAL EQUIPMENT SHALL BE BRACED OR ANCHORED TO RESIST A HORIZONTAL FORCE ACTING IN ANY DIRECTION USING THE FOLLOWING CRITERIA:
EQUIPMENT ON GRADE: _____ 50% OF OPERATING WEIGHT
EQUIPMENT ON STRUCTURE: _____ 30% OF OPERATING WEIGHT
FOR FREELY MOUNTED EQUIPMENT USE 4 TIMES THE ABOVE VALUES, AND FOR SIMULTANEOUS VERTICAL FORCE USE 1/3 TIMES THE HORIZONTAL FORCE.
THE ABOVE VALUES ARE FOR AN IMPORTANCE FACTOR, I = 1.0 AND SEISMIC ZONE = 2.
WHERE ANCHORAGE DETAILS ARE NOT SHOWN ON THE DRAWINGS THE FIELD INSTALLATION SHALL BE SUBJECT TO THE APPROVAL OF THE ARCHITECT AND THE FIELD ENGINEER OF THE OFFICE OF THE STATE ARCHITECT.
- SMOKE AND HEAT DETECTORS SHOWN ARE FOR OPTIONAL AUTOMATIC DETECTION, IF ELECTED AS AN OPTION MODTECH WILL PROVIDE 4SD BOXES AND 3/4" CO MOUNTED ON UNDERSIDE OF ROOF PURLINS. DEVICES PROVIDED AND INSTALLED BY OTHERS

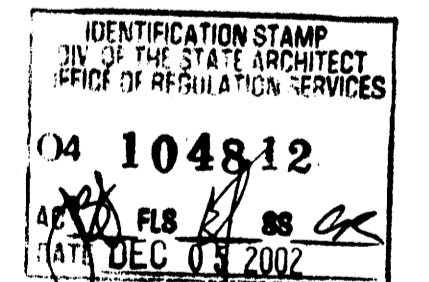

CBC 1993

REVISIONS

1		
2		
3		
4		
5		

Professional seals for Electrical, Mechanical, Structural, and Architects. Includes a large circular seal for the State of California and a rectangular seal for Modtech Inc.

IDENTIFICATION STAMP
DIV. OF THE STATE ARCHITECT
OFFICE OF REGULATION SERVICES
PC-04
101268
DATE: SEP 17 2008

MODTECH INC.
2830 BARRETT AVENUE
PERRIS, CALIF. 92572
PH (909) 943-4014
FAX (909) 940-0427

ELECTRICAL PLAN 24'x40'

DRAWN BY: KK
DATE: 11/19/02
CHECKED BY: STKP-67
DATE: 4/12-12
MODTECH Index No. **E1.01**

FILE PATH: 2440-E1.01.DWG PROJECT NO. 4373 PC-04-101268

ELECTRICAL PANEL SCHEDULE Room 101A

LOAD	WATTS		BREAKER		A		B		BREAKER		WATTS		LOAD	
	A#	B#	Amps	P	A	B	Amps	P	A	B	A#	B#		
RECEPTACLE (4)	720		20	1	1				2	2	80	4080	HVAC (3.5 TON)	
RECEPTACLE/CLOCK (5)	900		20	1	3				4			4080	HVAC (3.5 TON)	
	60			1	5				6	2	30	3120	5KW HEAT STRIPS	
					7				8				3120	5KW HEAT STRIPS
INT/EXT LIGHTS (13)	890		20	1	9				10					
INT. LIGHTS (12)	990		20	1	11				12					
WATTS/PHASE	A = 8810		1610	1890							7200	7200	B = 9090	WATTS/PHASE
TOTAL	17900	WATTS	75	AMPS		120/240	VOLTS		SINGLE #		THREE		WIRE	

ELECTRICAL PANEL SCHEDULE Room 101B





LOAD	WATTS		BREAKER		A		B		BREAKER		WATTS		LOAD	
	A#	B#	Amps	P	A	B	Amps	P	A	B	A#	B#		
RECEPTACLE (4)	720		20	1	1				2	2	50	3960	HVAC (3 1/2T)	
RECEPTACLE/CLOCK (5)	900		20	1	3				4			3960	HVAC (3 1/2T)	
					5				6	2	30	3120	5KW HEAT STRIPS	
					7				8				3120	5KW HEAT STRIPS
INT/EXT LIGHTS (13)	990		20	1	9				10					
INT. LIGHTS (12)	990		20	1	11				12					
WATTS/PHASE	A = 8790		1710	1890							7080	7080	B = 8970	WATTS/PHASE
TOTAL	17760	WATTS	74	AMPS		120/240	VOLTS		SINGLE #		THREE		WIRE	

GENERAL GROUNDING NOTES


- EACH BUILDING SHALL BE SEPARATELY GROUNDING WITH A 3/4" RD. X 8' COPPERCLAD STEEL GROUND ROD. WHERE ROCK BOTTOM IS ENCOUNTERED, ROD SHALL BE DRIVEN AT AN ANGLE NOT TO EXCEED 45 DEGREE'S FROM THE VERTICAL OR SHALL BE BURIED IN A TRENCH THAT IS AT LEAST 30" DEEP (BY SITE ELECTRICAL).
- TESTING: TEST FOR RESISTANCE TO GROUND. IF RESISTANCE EXCEEDS 25 OHMS, INSTALL ADDITIONAL GROUND RODS SEPARATED AT LEAST 6'-0" UNTIL RESISTANCE IS REDUCED TO 25 OHMS OR LESS. (BY SITE ELECTRICAL).
- APPROVAL OF THIS PLAN DOES NOT CONSTITUTE APPROVAL OF THIS FIRE ALARM FOR ALL SITES. THE FIRE ALARM SYSTEM AND/OR COMPONENTS MAYBE REQUIRED TO BE CHANGED DUE TO SITE LOCATION, EXISTING CONDITIONS OR INCOMPATIBLE COMPONENTS.
- GROUND MG TEST SHALL BE DONE IN THE PRESENCE OF THE PROJECT INSPECTOR. ALL GROUNDING SHALL BE IN ACCORDANCE WITH CEC ARTICLE 250.

ELECTRICAL LEGEND


- RECESSED 2' X 4' FLUORESCENT 4-LAMP WITH MAGNETER TRIAD FOUR LAMP HIGH POWER FACTOR BALLAST, PRISMATIC ACRYLIC LENS OF 0.125" MINIMUM THICKNESS IN A DOOR FRAME WITH POSITIVE HINGE AND LATCHES, DIE FORMED HEAVY GAUGE STEEL BODY, BAKED WHITE ENAMEL FINISH, FIXTURE 4 1/2" DEPTH MINIMUM AND FOUR 32 WATT, 48" T-8 LAMPS PRUDENTIAL CAT# PB624-48CTE-PRA.125-SW-120 OR EQUAL BY LITHONIA OR METALUX
- 50 WATT HIGH PRESSURE SODIUM WALL MOUNTED VANDAL RESISTANT FIXTURE WITH PHOTO CONTROL MOUNT AT +96" AFF KENALL # 5010-9051
- SWITCH AT +48" AFF
- 3WAY SWITCH AT +48" AFF UON
- DUPLEX WALL RECEPTACLE 15A 125V 3-WIRE AT +18" AFF UON
- HVAC UNIT (HV)
- 4SD J-BOX FOR FIRE ALARM PULL STATION AT +48" AFF, 3/4" CO TO PULLSTRING
- 4SD J-BOX FOR FIRE ALARM STROBE AT +80" AFF 3/4" CO TO PULLSTRING
- 4SD J-BOX FOR FIRE ALARM HORN AT +96" AFF 3/4" CO TO PULLSTRING
- ELECTRICAL PANEL AT +60" AFF TO CENTERLINE 1 1/4" POWER NIPPLE POC, GND JUMPER BY SITE ELECT
- 4SD J-BOX FOR CLOCK AT +93" AFF 3/4" CO STUB IN ATTIC, PULLSTRING
- 4SD J-BOX FOR HEAT DETECTOR (ATTIC)
- 4SD J-BOX FOR SMOKE DETECTOR - CEILING MOUNTED
- 4s J-BOX FOR HVAC UNIT BYPASS AT +48" AFF
- 4s J-BOX FOR FIRE ALARM HEAT DETECTOR, MOUNTED IN ATTIC
- 12"W X 24" HT. X 6"D WP PULL BOX PROVIDE NAME PLATES AS LISTED ON ELECT. PLANS. +15" AFF
- 4s J-BOX FOR BUZZER AT +93" AFF 3/4" CO STUB IN ATTIC, PULLSTRING
- 4s J-BOX FOR PUBLIC ADDRESS SPEAKER, WALL MOUNTED. 3/4" CO TO +80" AFF
- 4s J-BOX FOR PUBLIC ADDRESS CALL SWITCH AT +48" AFF. 3/4" CO TO PA GUTTER BOX
- 4s J-BOX FOR SECURITY MOTION DETECTOR OUTLET, CEILING MOUNTED. 3/4" CO TO SECURITY GUTTER BOX
- LCS LIGHT CONTROL OCCUPANCY SENSOR CEILING MOUNTED 3/4" CO TO LCS
- LCS LIGHT CONTROL TWO POLE POWER/SWITCH PACK MOUNTED IN ATTIC. 3/4" CO TO LIGHTING CIRCUIT
- 4s J BOX FOR TELEVISION +86" AFF 3/4" CO TO TV GUTTER BOX
- J-BOX FOR FUTURE DATA. +18" AFF 3/4" C/O STUB IN ATTIC. PULLSTRING
- 100 CFM EXHAUST FAN

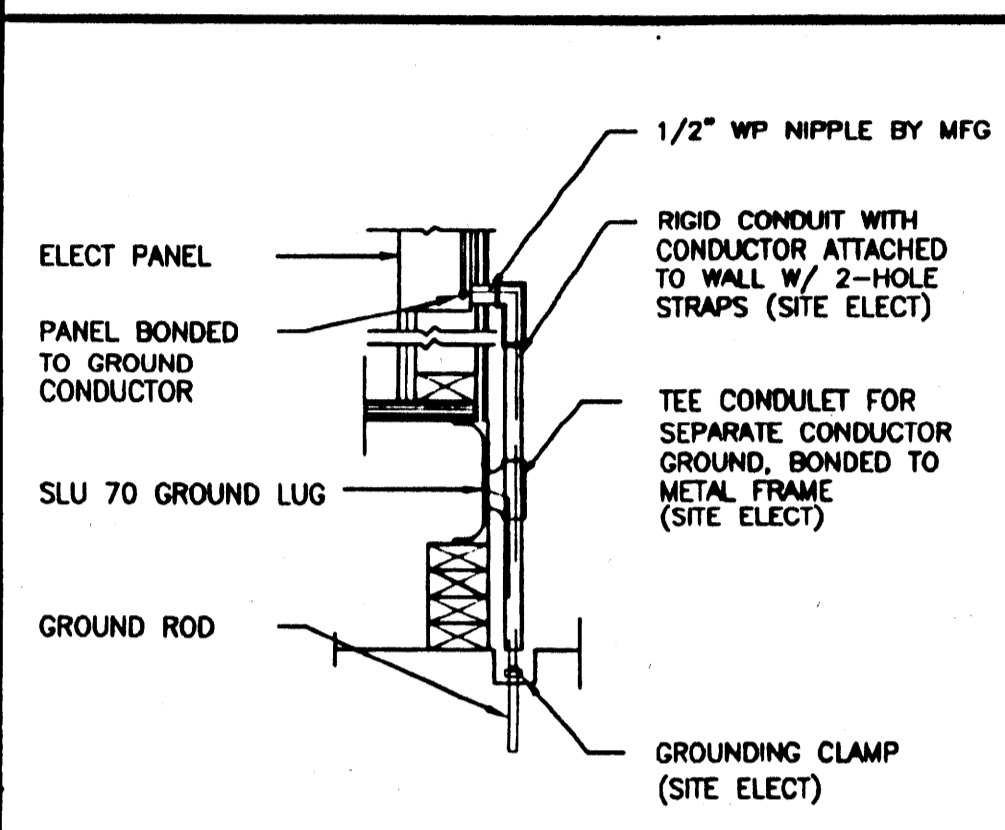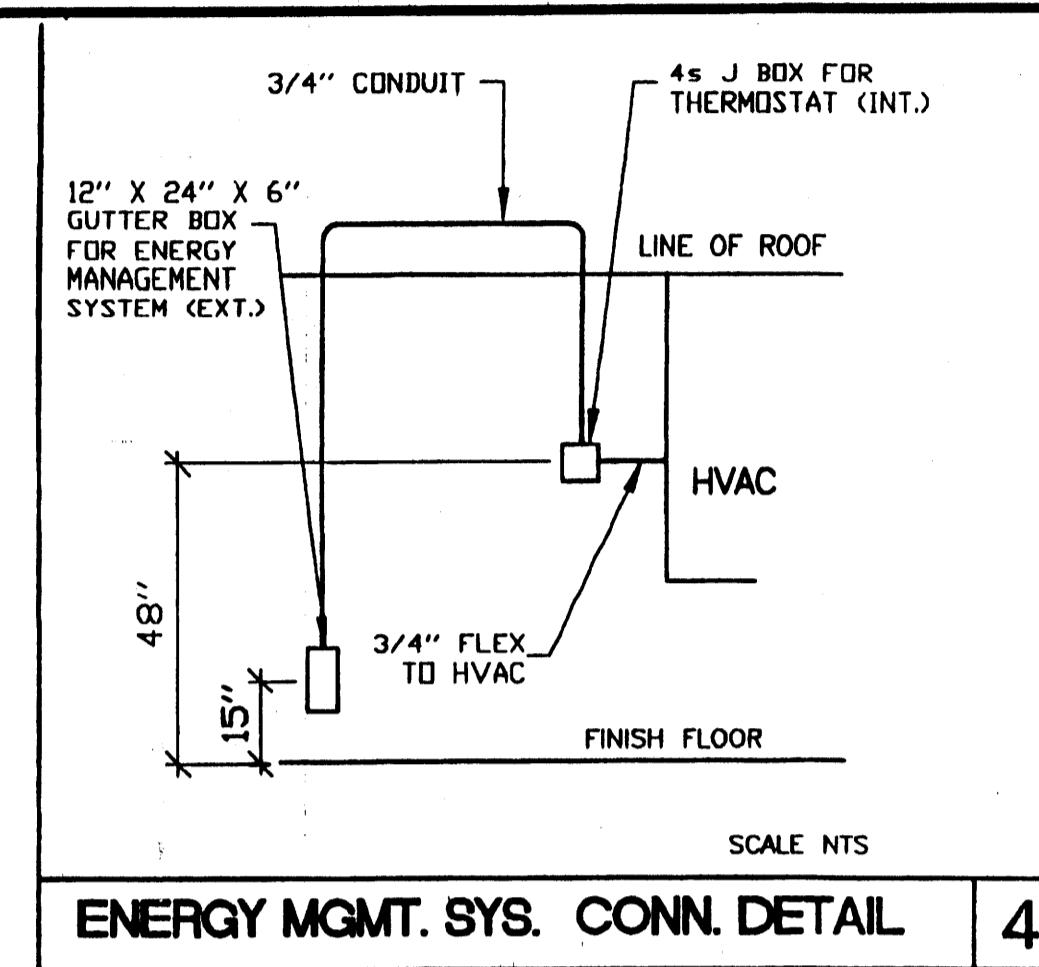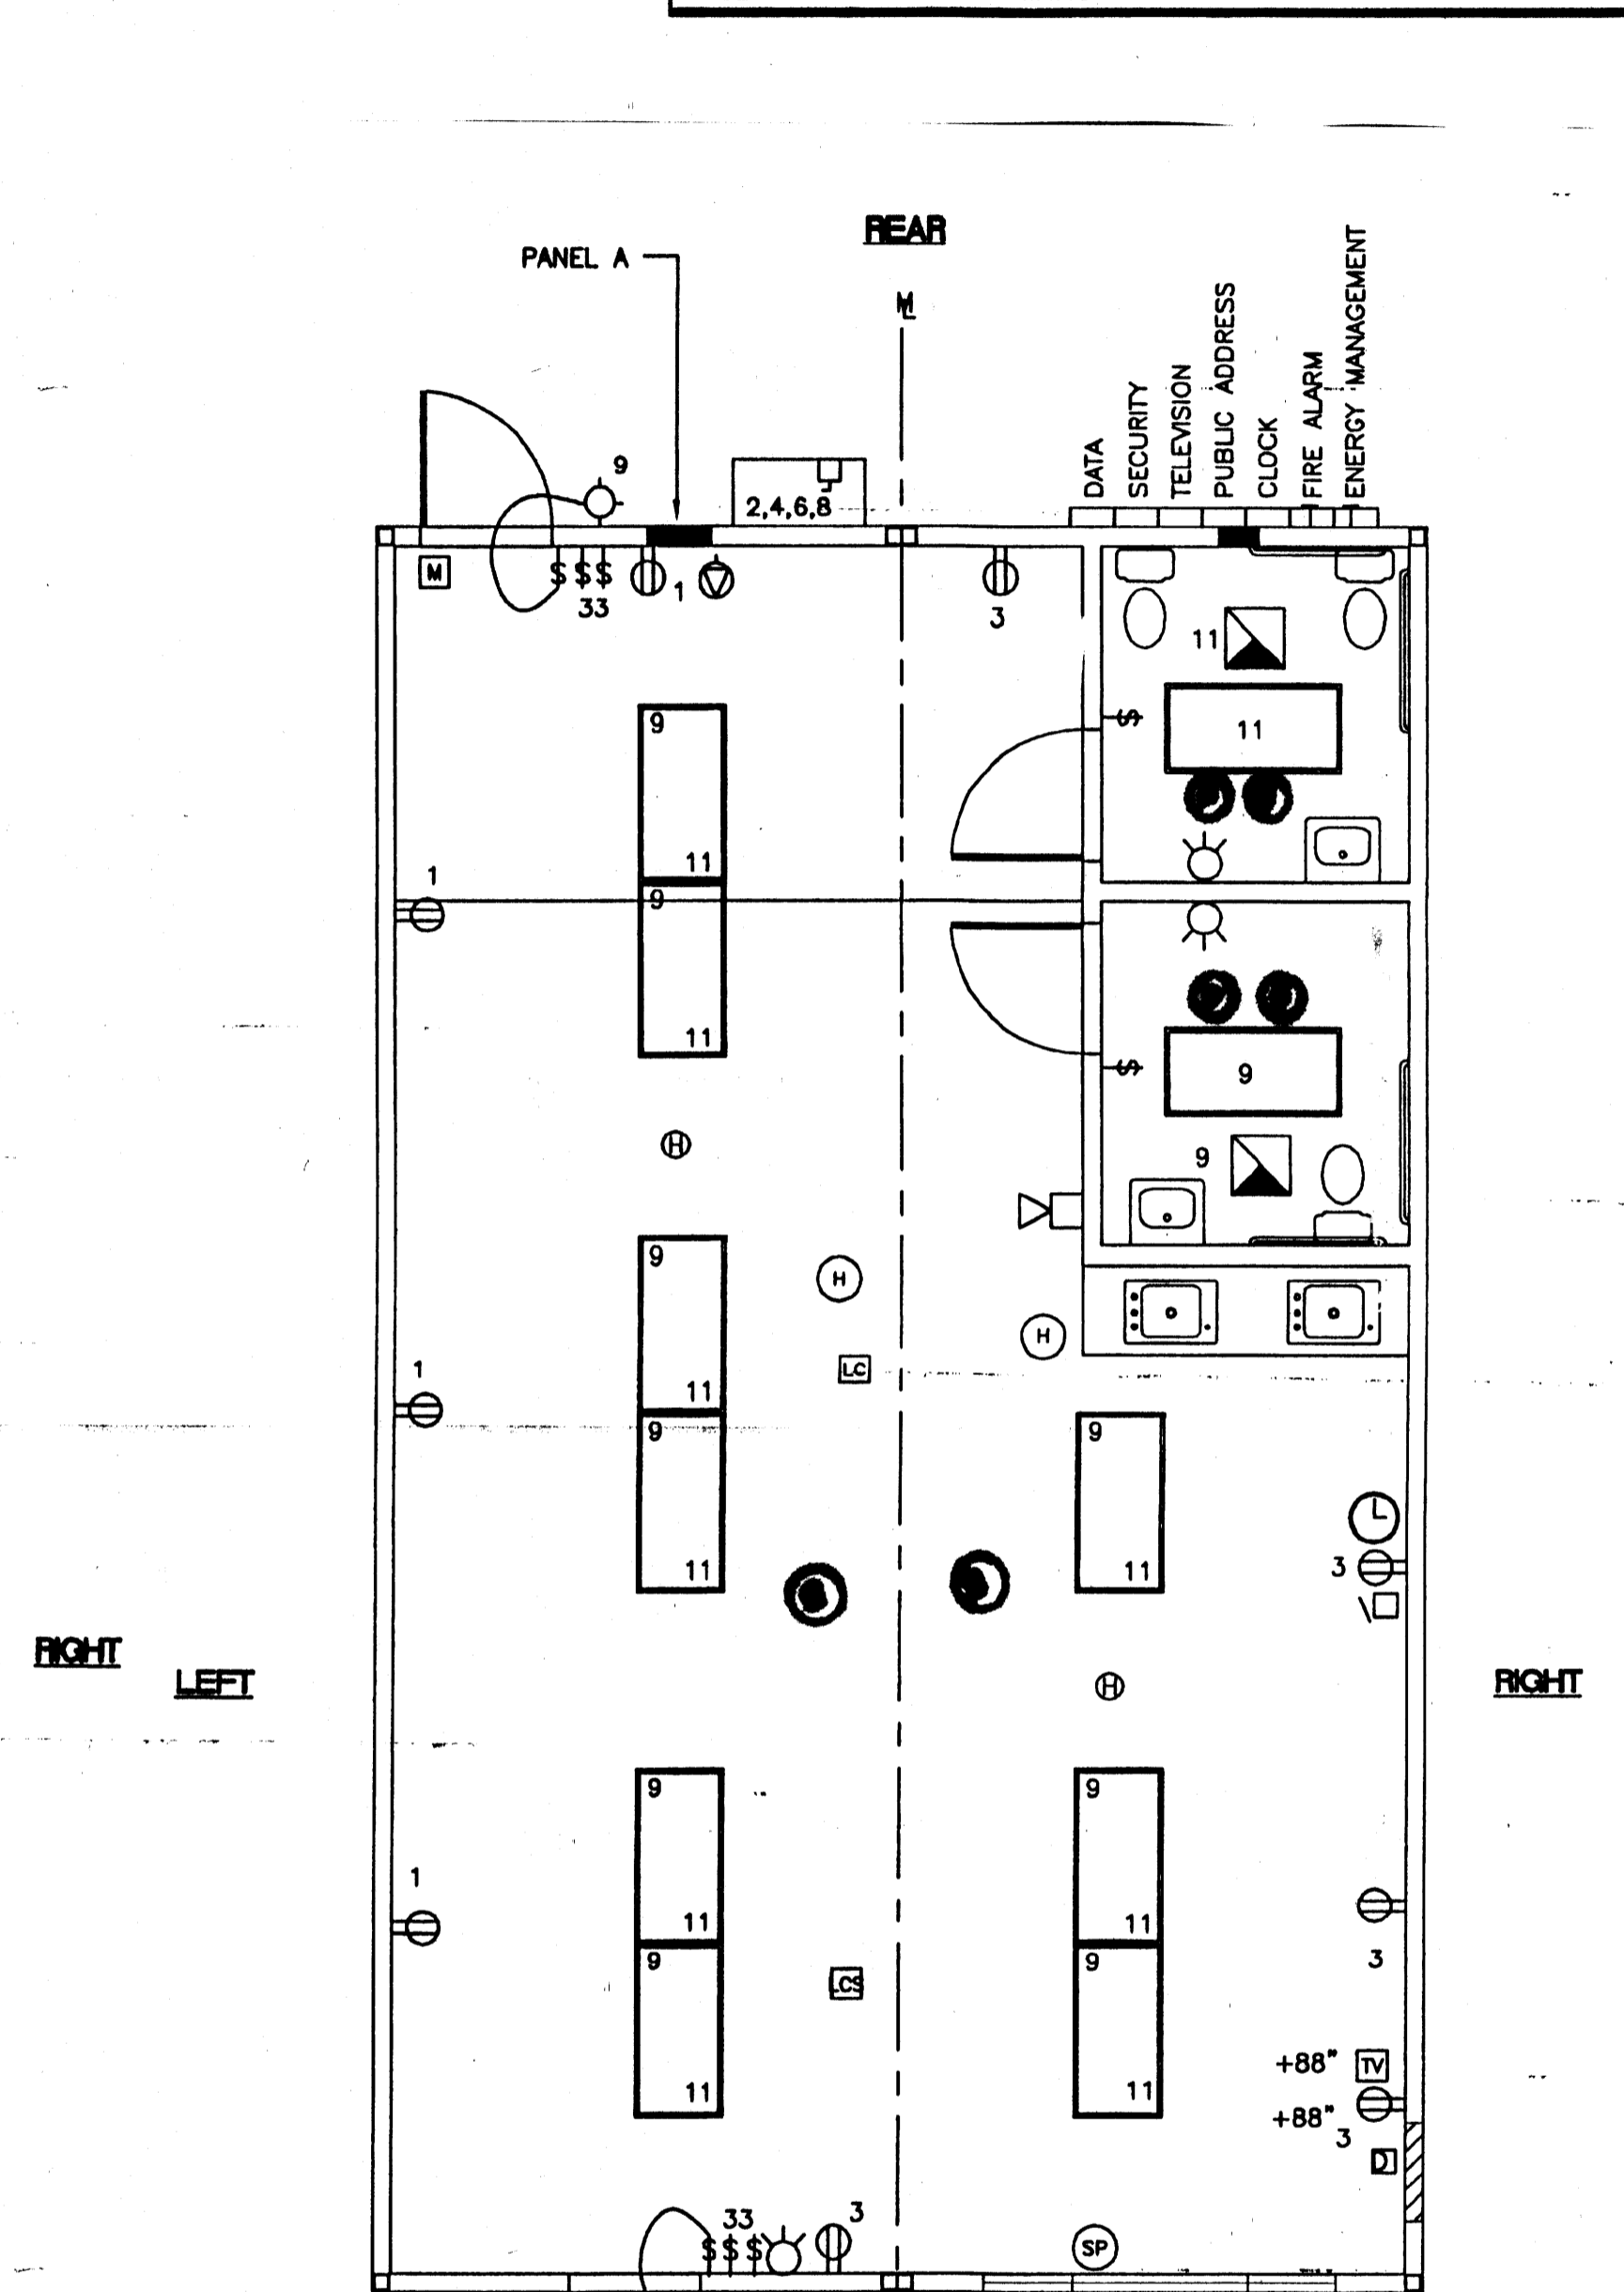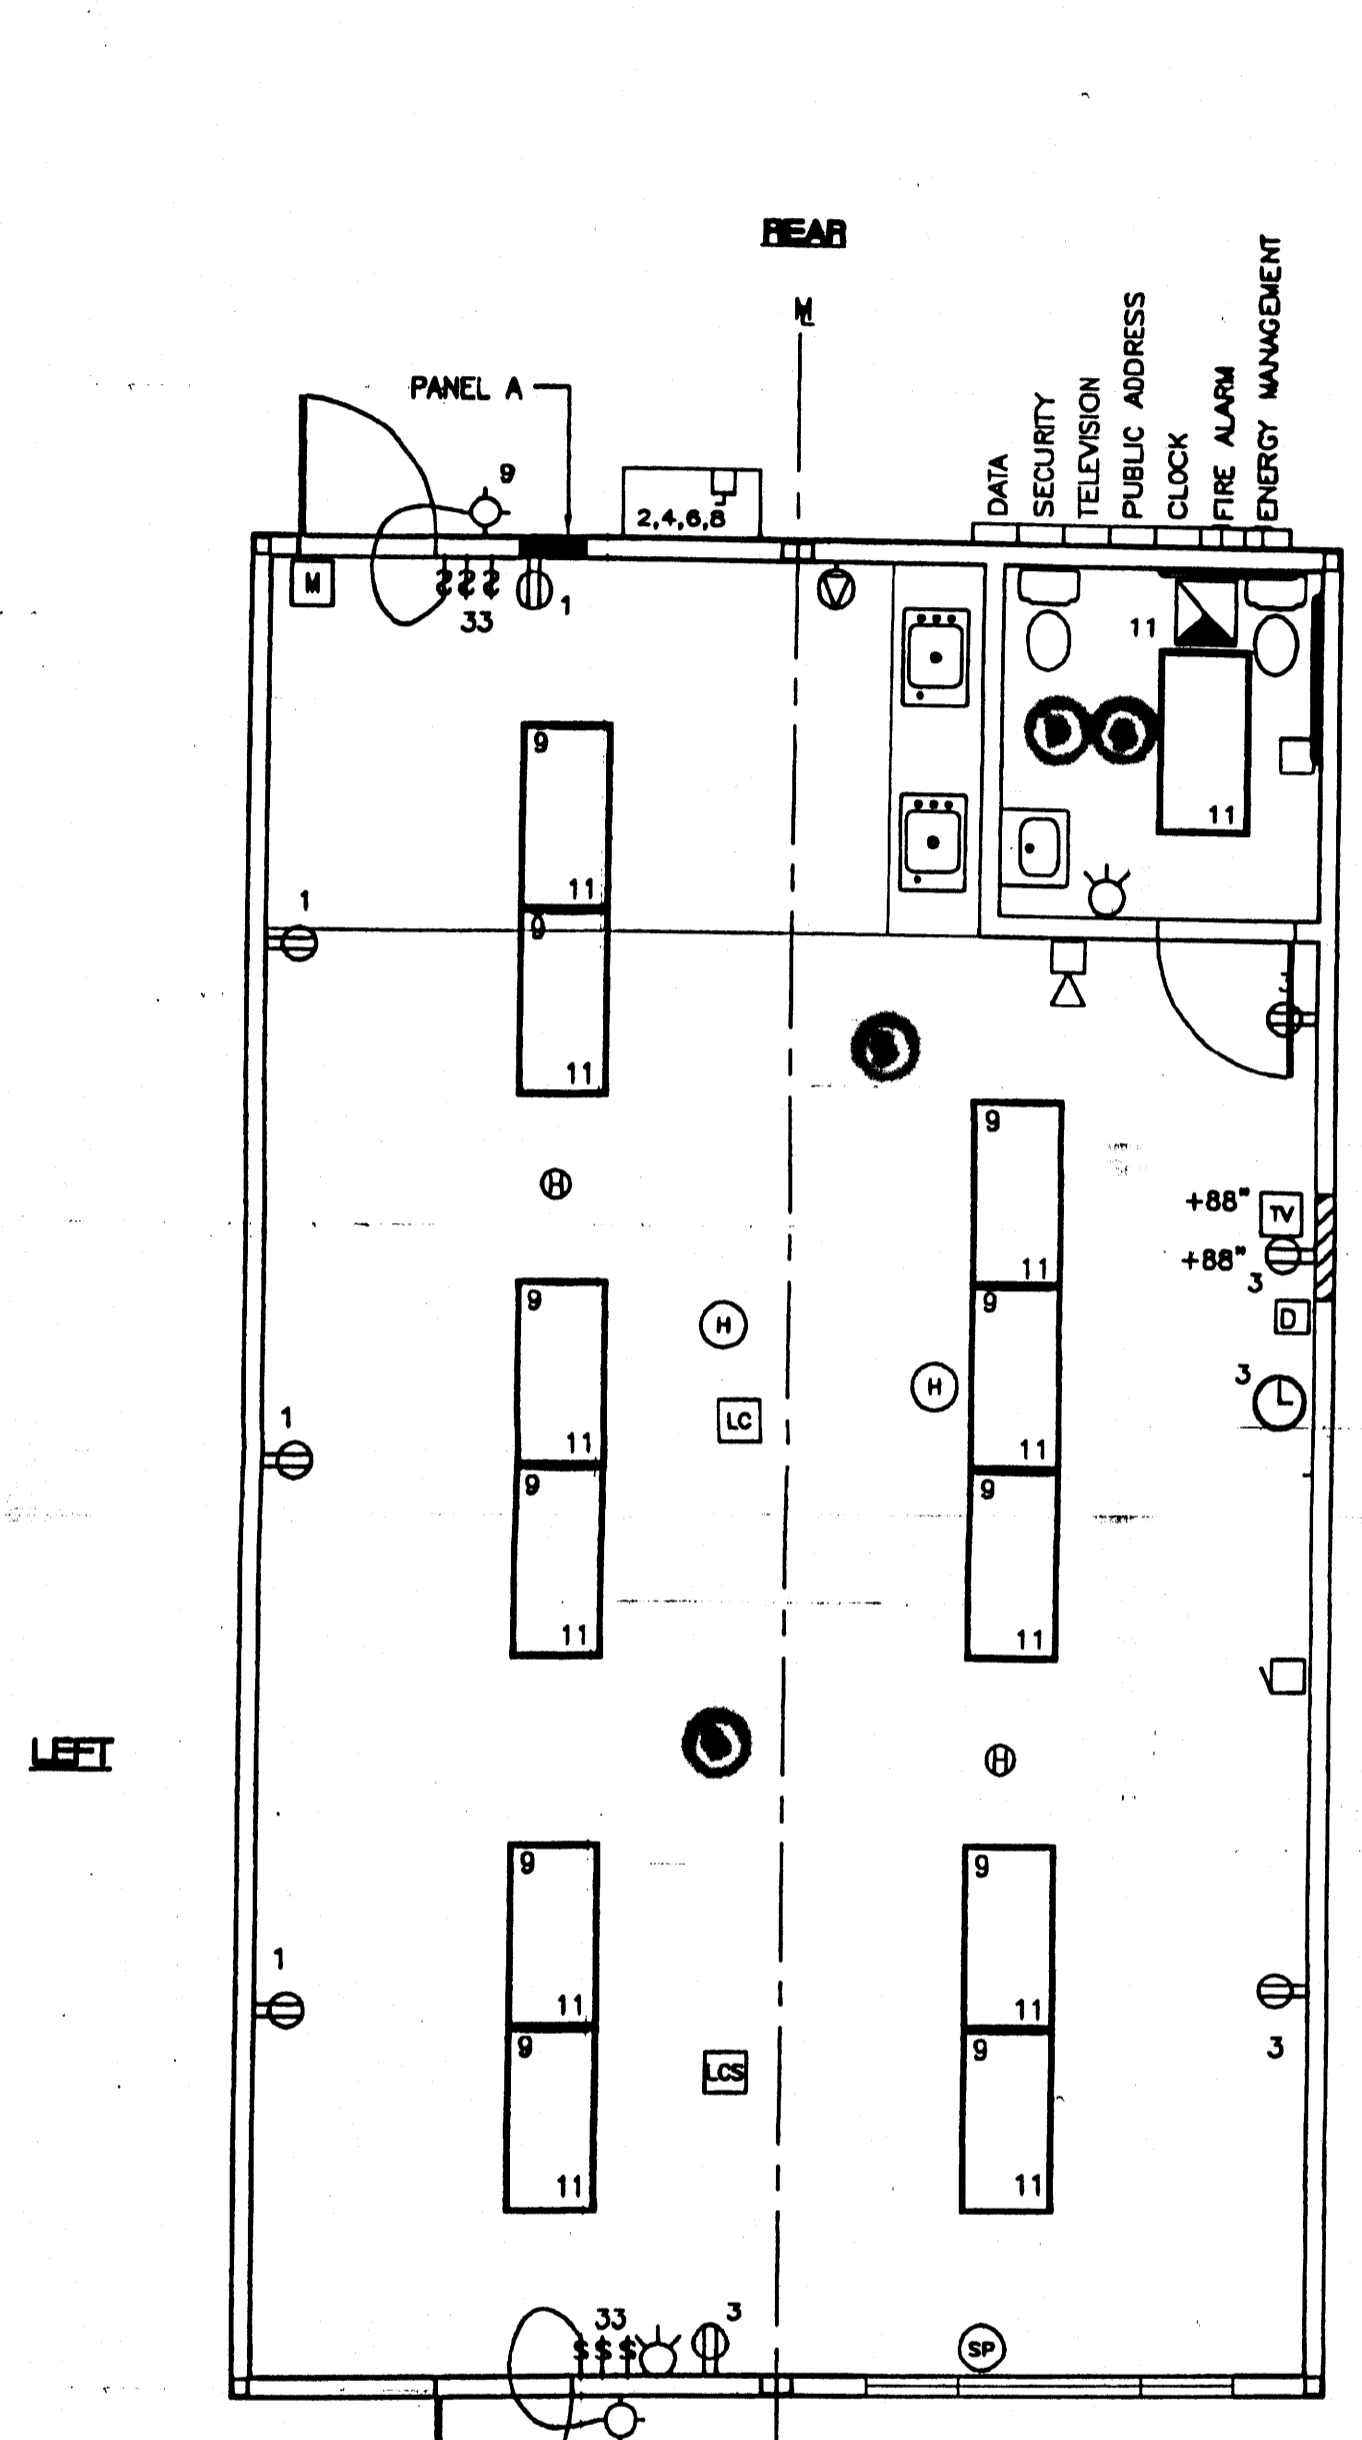

TYP GROUNDING DETAIL 1

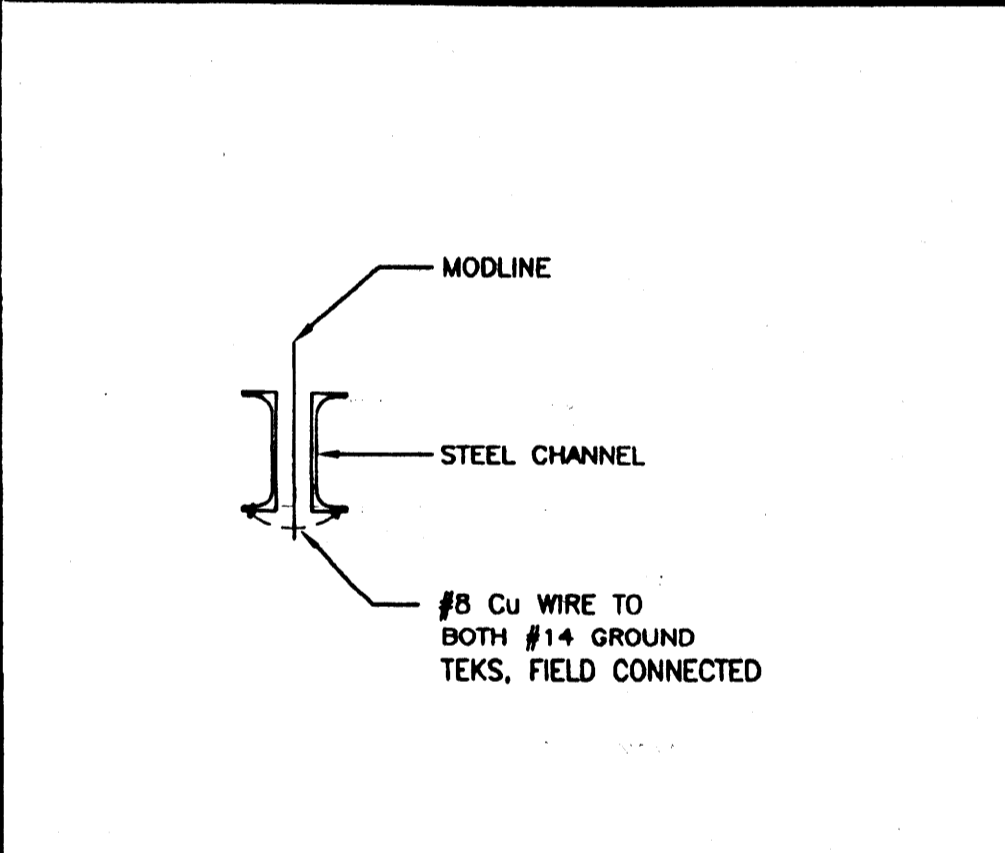

GROUND JUMPER AT MOD LINE 2

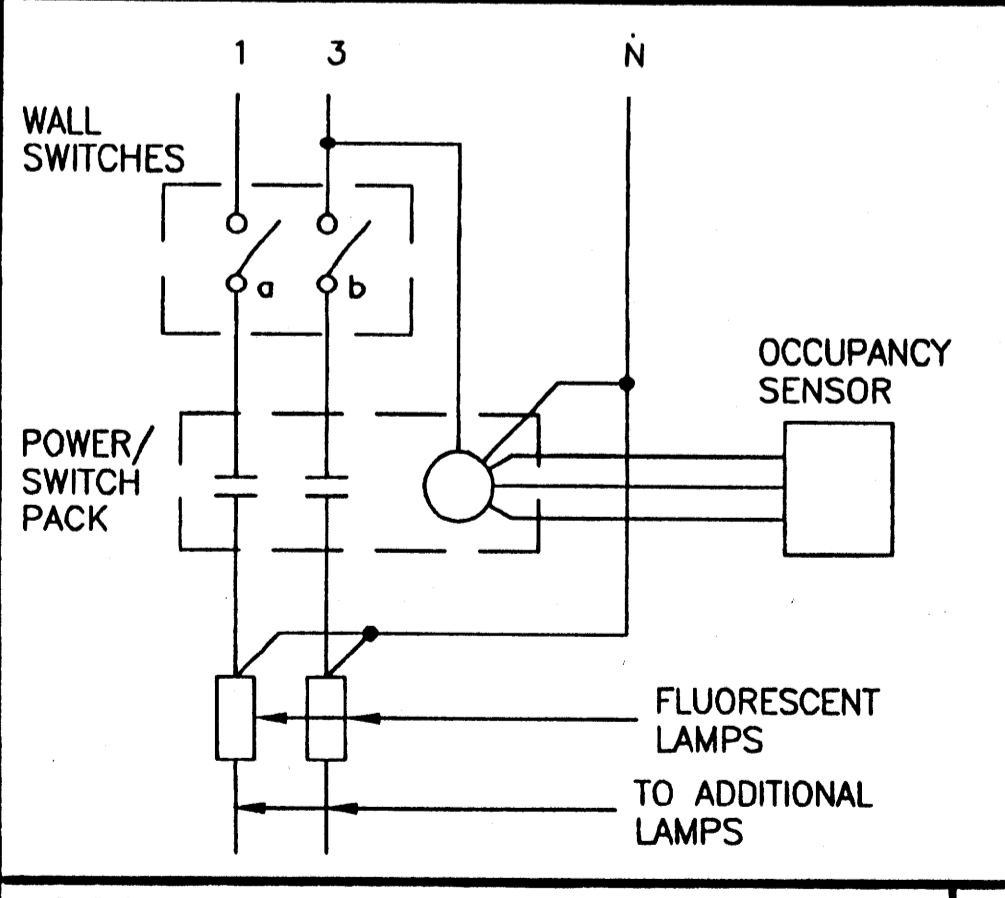

LIGHT CONTROL DIAGRAM 3

NOTES

- SCHOOL EQUIPMENT ANCHORAGE
THE FOLLOWING IS FOR THE ARCHITECTS INFORMATION ONLY:
THE SEISMIC ANCHORAGE OF ELECTRICAL EQUIPMENT SHALL CONFORM TO CCR TITLE 24, SECTION 1632A AND TABLE 16A-0. ANCHORAGE DETAILS FOR ROOF/FLOOR MOUNTED EQUIPMENT WEIGHING LESS THAN 400 LBS & HUNG EQUIPMENT WEIGHING LESS THAN 20 LBS MAY BE OMITTED FROM THE PLANS.
ALL ELECTRICAL EQUIPMENT SHALL BE BRACED OR ANCHORED TO RESIST A HORIZONTAL FORCE ACTING IN ANY DIRECTION USING THE FOLLOWING CRITERIA:
EQUIPMENT ON GRADE: 20% OF OPERATING WEIGHT
EQUIPMENT ON STRUCTURE: 30% OF OPERATING WEIGHT
FOR FLEXIBLY MOUNTED EQUIPMENT USE 4 TIMES THE ABOVE VALUES, AND FOR SIMULTANEOUS VERTICAL FORCE USE 1/3 TIMES THE HORIZONTAL FORCE.
THE ABOVE VALUES ARE FOR AN IMPORTANCE FACTOR, I = 1.0 AND SEISMIC ZONE, Z = 4
WHERE ANCHORAGE DETAILS ARE NOT SHOWN ON THE DRAWINGS THE FIELD INSTALLATION SHALL BE SUBJECT TO THE APPROVAL OF THE ARCHITECT AND THE FIELD ENGINEER OF THE OFFICE OF THE STATE ARCHITECT.
*2 SMOKE AND HEAT DETECTORS SHOWN ARE FOR OPTIONAL AUTOMATIC DETECTION. IF ELECTED AS AN OPTION MODTECH WILL PROVIDE 4SD BOXES AND 3/4" CO MOUNTED ON UNDERSIDE OF ROOF PURLINS. DEVICES PROVIDED AND INSTALLED BY OTHERS.

Room 101A
SERIAL # 59243-59244 # 438A
ELECTRICAL PLAN
SCALE: 1/4" = 1'-0"

Room 101B
ELECTRICAL PLAN
SCALE: 1/4" = 1'-0"

REVISIONS

Electrical Engineer's Seal
Mechanical Engineer's Seal
Structural Engineer's Seal
Architect's Seal
IDENTIFICATION STAMP
DIV. OF THE STATE ARCHITECT
OFFICE OF REGULATION SERVICES
PC-04
101268
DATE: DEC 19 2002

MODTECH INC.
2830 BARRETT AVENUE
PERRIS, CALIF. 92572
PH (909) 943-4014
FAX (909) 940-0427

PROJECT NUMBER: 438A
CHINO
CLASS LEASING
MODTECH, INC. 1999
CLASS LEASING INC STOCKPILE # 67
100- 24 x 40 CLASSROOM BUILDINGS
4012-124 12/05/2002 80 MPH
DRAWN BY: SW
DATE: 6/26/01
CHECKED BY: DATE:
MODTECH Index No.
E1.01C
24'x40'

PROJECT NO. 3883
FILE PATH: 2440-E1.01.DWG
PC-04-101268

CLASS LEASING, INC.

P. O. Box 51150 Riverside, CA 92517-2150
1221 Harley Knox Blvd. Perris, CA 92571-7408
(951) 943-1908 Fax (951) 943-5768

SPECIFICATIONS RELOCATABLE CLASSROOMS

4.01 MATERIAL SPECIFICATIONS:

- Structural framing shall be Hem Fir-Larch graded in accordance with the standard grading rules of the Western Wood Products Association or standard grading rules No. 16 of the West Coast Lumber Inspection Bureau, latest editions. Grades shall be as follows unless noted otherwise on the drawings. (Hem Fir South is not allowed.) Each piece shall be grade marked and no piece may fall below grades indicated. All framing except as noted shall be Hem Fir No. 2.
- Plywood shall be as shown on these drawings with exterior glue in accordance with U.S. Product Standard PS 1-95. All panels shall be marked with an APA grade mark with an identification index as shown on drawings. Use 4'x8' panels-minimum, except at boundaries and at framing changes where minimum panel dimension shall be 24" at roofs and floors and 12" at walls.
- Bolts for timber connections shall conform to ANSI/ASME Standard B18.2.1-1981 & 2005 edition of NDS (the National Design Specification for Wood Construction by the National Forest Products Association). Bolts shall be installed in accordance with the requirement of 200 NDS. Bolt holes shall be 1/32 to 1/16 inch larger than bolt diameter. Bolts shall be full body steel bolts with minimum yield strength of 45,000 PSI. Re-tighten bolts before closing in work.
- Lag screws shall be steel and conform to ANSI/ASME Standard B18.2.1 and 2005 NDS Holes for lag screw shanks shall be bored the same depth and diameter as the shank. The remaining depth of penetration of the screw shall be bored to 70% of the shank diameter. One quarter inch (1/4") diameter lag screws need not have pre-drilled holes if it can be shown that wood members are not damaged during installation. Provide full diameter body lag screws with bending yield strengths per Table 9.3 in NDS
- Provide malleable iron washers or equivalent cut plate washers (not less than a standard cut washer) under nuts and bolt or lag screw heads which bear on wood.
- Wood screws shall conform to ANSI/ASME Standard B18.6.1 and the requirements of the 2005 NDS. Galvanized or other corrosion resistant coating where exposed to weather or used in foundations. Screws shall be steel with cut threads and bending yield strengths per Table 11.3 in NDS.
- Wood members shall be cut or notched only as shown on structural drawings.
- When required nailing tends to split wood members, nail holes shall be pre-bored to 3/4 of the nail diameter.
- Structural nailing shall be with BOX NAILS per all requirements of 2005 NDS. Nailing not specifically indicated shall comply with CCR Title 24, Part 2, Table 2304.9.1. All nails shall be galvanized or other corrosion resistant coating where exposed to weather, in foundations and as noted on plans, per the requirements of CCR Title 24, Part 2, with minimum bending yields per table 11N in NDS. (See nail equivalence below.)
- Nail equivalence:
(provide minimum nail lengths as required for specified penetration, TYPICAL: U.N.O.)
8d equals 113" DIA. - provide 1.36" minimum point penetration
10d equals 131" DIA. - provide 1.57" minimum point penetration
10d equals 148" DIA. - provide 1.78" minimum point penetration
16d equals 162" DIA. - provide 1.94" minimum point penetration
(* 1 1/2" at 2x members)
- Pressure preservative treatment shall be per Section 2303.1.8, CCR Title 24, Part 2. Provide quality mark on all treated foundation members from agency approved by DSA. All foundation members shall be marked as "For ground contact (LP22)" or "For above ground use (LP2)" as appropriate. Treat all cut ends of pressure treated members with an approved preservative. (Willard WB Copper Green 2% or an approved equivalent). Where noted, members below the sub floor that are not a part of the foundation shall be pressure treated per LP2.
- Only material in contact with ground needs to be pressure treated, all other foundation lumber can be DF or HF#2 or equal.
- If machine nailing is utilized for this project, contractor shall comply with all requirements of CCR Title 24, Part 2. Machine nailing is subject to approval by the Structural Engineer or Architect and the Division of the State Architect.
- Fasteners for pressure-preservative treated and fire-retardant treated wood shall comply with Section 2304.9 of CBC.
- Nails and spikes used in wet or exterior locations shall comply with Section 2304.9.1.1 of CBC.
- Shim material shall be plywood CD EXP 1 or equal (not pressure treated).
- Used lumber in good condition is acceptable for use in foundation system.

5.01 SITE INSTALLATION REQUIREMENTS FOR DSA CLASSROOM BUILDINGS:

In the case of equipment located in the State of California, the LESSEE (School District) is responsible for the site being cleared (free of grass, trees, shrubs, etc) and graded to within a 4 1/2" of level grade for each building. If the site exceeds the 4 1/2" level grade requirement additional costs may be charged to lessee.

Under no circumstances should the site be greater than 9" from level grade or have less than a 1000 PSF MINIMUM SOIL BEARING PRESSURE.

Prior to delivery, the lessee shall mark the four corners of the building on the site, including door location. Should special handling be required to either place, install or relocate the classroom on the lessee's site due to site obstruction such as fencing, landscaping, other classrooms, etc., additional costs will be charge to the lessee.

6.01 TEST AND INSTALLATION:

- Provide Electrical Grounding Test per DSA IR E-1.
- No other tests and inspections are required.

1.01 GENERAL REQUIREMENTS:

- The requirements of the general conditions of the agreement and these General Requirements apply to the several trade sections with the same force as though fully repeated in each section.
- Name brands are indicated to establish a standard of quality. Items of equal or better quality may be substituted for the listed brand named products.

1.02 SCOPE OF WORK:

- The work consists of manufacturing off-site in a plant, and installing on-site, modular relocatable building as defined herein, shown and detailed on the drawings. In the case of a Stockpile: the modular relocatable building is manufactured in-plant and stored off-site until such time that it is relocated from the off-site storage location and installed on-site.
- All requirements of CCR (California Code of Regulation) Title 19 and 24 relating to inspections and verified reports shall be complied with and shall include:
 - General responsible charge of Field Administration by the Architect of Record.
 - Inspection during the course of construction by an Inspector approved by DSA (Division of the State Architect) and the District Architect. The Inspector shall be responsible for and approved to inspect the general construction, welding, mechanical and electrical work. Cost of these inspections shall be borne by the School District.
 - On site inspection of the building installation, electrical and utility of the building installation or connection by an inspector approved by the DSA and retained by the School District.
 - Other special tests or inspections as may be required by DSA. Cost of these inspections/tests shall be borne by the School District.

1.03 WORK NOT INCLUDED:

- All on-site or off-site utilities and the connection of them to the building unless indicated on the drawings.
- All leveling, grading or other site preparation (except concrete or wood leveling strips, where Required) unless otherwise indicated on the drawings.
- Fire alarm system, program bell, clock, public address system, intercom system, TV system, computer data or any other low voltage system, unless otherwise indicated on the drawings or the lease agreement.

1.04 ACCESSIBILITY OF SITE:

The School District shall provide access to the site for the installation of the building. Removal of trees, shrubs, fencing, sprinklers, etc. necessary for move-in and removal of the buildings shall be the responsibility of the School District.

2.01 SITE ASSEMBLY:

- Scope of Work:** Contractor (Class Leasing Inc.) shall provide all labor, materials and services to prepare the building elements, transport them from the plant to the site and to complete the assembly at the site.

The condition of the site, such as drainage and soil bearing capacity, shall be the responsibility of the School District and the District Architect.
- Assembly of Elements:**
 - In a location on the site as determined by the District Architect. The contractor shall place the foundation as detailed on the drawings.
 - The elements shall be brought to the site on wheel assembly and transferred to the prepared site. Great care shall be taken to avoid damage to the elements by racking or bumping.
 - Connection of the elements together shall be done according to instructions on the drawings. Flashing, trim and other loose items shall be installed per plans and details of the original building manufacturer's drawings.

3.01 CARPENTRY:

- Scope of Work:** Contractor shall provide all labor, materials and services to install carpentry.
- Workmanship:**
 - FRAMING: securely nailed, bridged and blocked to form rigid structure. Work cut, fitted and assembled level, plumb and true to line. Trim in as long lengths as possible with all standing trim in one piece. Trim sealed at all edges.
 - NAILING: in accordance with the title 24 CCR-Table 2304.9.1. Nails shall be corrosion resistant box nails.
 - Machine applied nailing shall have prior demonstration and approval by DSA Field Inspector and the Architect. The approval is subject to continuous satisfactory performance. Plywood shall have a minimum thickness of 3/8". If nail heads penetrate the outer ply more than would be normal for a hand hammer or if minimum allowable edge distances are not maintained, the performance will be deemed unsatisfactory.
 - TRIM: sealed at all edges. Sealant painted to match trim or siding.

APPLICABLE BUILDING CODES

ALL NEW WORK SHALL COMPLY AND CONFORM TO THE REQUIREMENTS OF THE 2010 CBC

2010 CALIFORNIA CODE OF REGULATIONS (CCR)

- 2010 CALIFORNIA BUILDING STANDARDS ADMINISTRATIVE CODE (PART 1, TITLE 24, CCR)
- 2010 CALIFORNIA BUILDING CODE (CBC) (PART 2, TITLE 24, CCR) (2009 INTERNATIONAL BUILDING CODE VOLUMES 1-3 WITH 2010 CALIFORNIA AMENDMENTS)
- 2010 CALIFORNIA ELECTRICAL CODE (CEC) (PART 3, TITLE 24, CCR) (2008 NATIONAL ELECTRICAL CODE WITH 2010 CALIFORNIA AMENDMENTS)
- 2010 CALIFORNIA MECHANICAL CODE (CMC) (PART 4, TITLE 24, CCR) (2009 UNIFORM MECHANICAL CODE WITH 2010 CALIFORNIA AMENDMENTS)
- 2010 CALIFORNIA PLUMBING CODE (CPC) (PART 5, TITLE 24, CCR) (2009 UNIFORM PLUMBING CODE WITH 2010 CALIFORNIA AMENDMENTS)
- 2010 CALIFORNIA ENERGY CODE (PART 6, TITLE 24, CCR)
- 2010 CALIFORNIA REFERENCED STANDARDS CODE (PART 12, TITLE 24, CCR)
- 2010 CALIFORNIA FIRE CODE (PART 9, TITLE 24, CCR) (2009 INTERNATIONAL FIRE CODE WITH 2010 CALIFORNIA AMENDMENTS)

TITLE 19 CCR PUBLIC SAFETY, STATE FIRE MARSHALL REGULATIONS

DESIGN DATA:

FLOOR LIVE LOAD = 50 PSF, 50 + 20 PSF PARTITIONS, 100 PSF ROOF LIVE LOAD = 20 PSF REDUCIBLE FOR TRIBUTARY AREA
WIND SPEED = 85 MPH (V) (3 SECOND GUST), Kz = 1.0
SNOW LOAD: PROJECT IS NOT LOCATED IN A SNOW REGION.
BUILDING CODES = IBC AND CBC 2007

SEISMIC DESIGN DATA:	MOMENT FRAME PC'S	SEISMIC DESIGN DATA:	SHEAR WALL PC'S
Basic Seismic Force-Resisting System = STEEL MOMENT FRAME	= EQUIVALENT LATERAL FORCE ANALYSIS PROCEDURE USED	Basic Seismic Force-Resisting System = WOOD PANEL SHEAR WALLS	= EQUIVALENT LATERAL FORCE ANALYSIS PROCEDURE USED
Seismic Design Category = E (per CBC Section 1613A.5.3)	Design Base Shear: 24x40 BUILDING = 9404 # (Roof, Floor, Walls & Partitions)	Seismic Design Category = E (per CBC Section 1613A.5.3)	Design Base Shear: 24x40 BUILDING = 9404 # (Roof, Floor, Walls & Partitions)
	36x40 BUILDING = 14110 # (Roof, Floor, Walls & Partitions)		36x40 BUILDING = 14110 # (Roof, Floor, Walls & Partitions)
	48x40 BUILDING = 19810 # (Roof, Floor, Walls & Partitions)		48x40 BUILDING = 19810 # (Roof, Floor, Walls & Partitions)


FLOOD DESIGN DATA: Project is not located in a flood zone

LIMITATIONS WOOD FOUNDATION PC ONLY:

WOOD FOUNDATION ONLY PC IS DESIGNED TO SUPPORT THE SUPERSTRUCTURE FOR THE RELOCATABLE BUILDINGS AS LISTED ON THIS DRAWING.

THE DESIGN CALCULATIONS ARE BASED ON THE FOLLOWING:

- DSA APPROVED STOCKPILE BUILDINGS
- ROOF OVERHANGS OF 5'-0" MAXIMUM
- SINGLE SLOPE OR DUAL SLOPE BUILDINGS
WALL HEIGHT: 9'-0" MAXIMUM ON DUAL SLOPE BUILDING.
WALL HEIGHT: 10'-4" MAXIMUM ON SINGLE SLOPE BUILDING.
(HEIGHT DETERMINED FROM FINISH FLOOR IN BUILDING TO BOTTOM OF STEEL ROOF STRUCTURE BEAMS OR ROOF HEADERS)
WALL HEIGHT: 9'-10" MAXIMUM ON SHEAR WALL-DUAL SLOPE BUILDING
- WALL DEAD LOAD OF 10 PSF (NO STUCCO)
- FLOOR DEAD LOAD OF 8 PSF

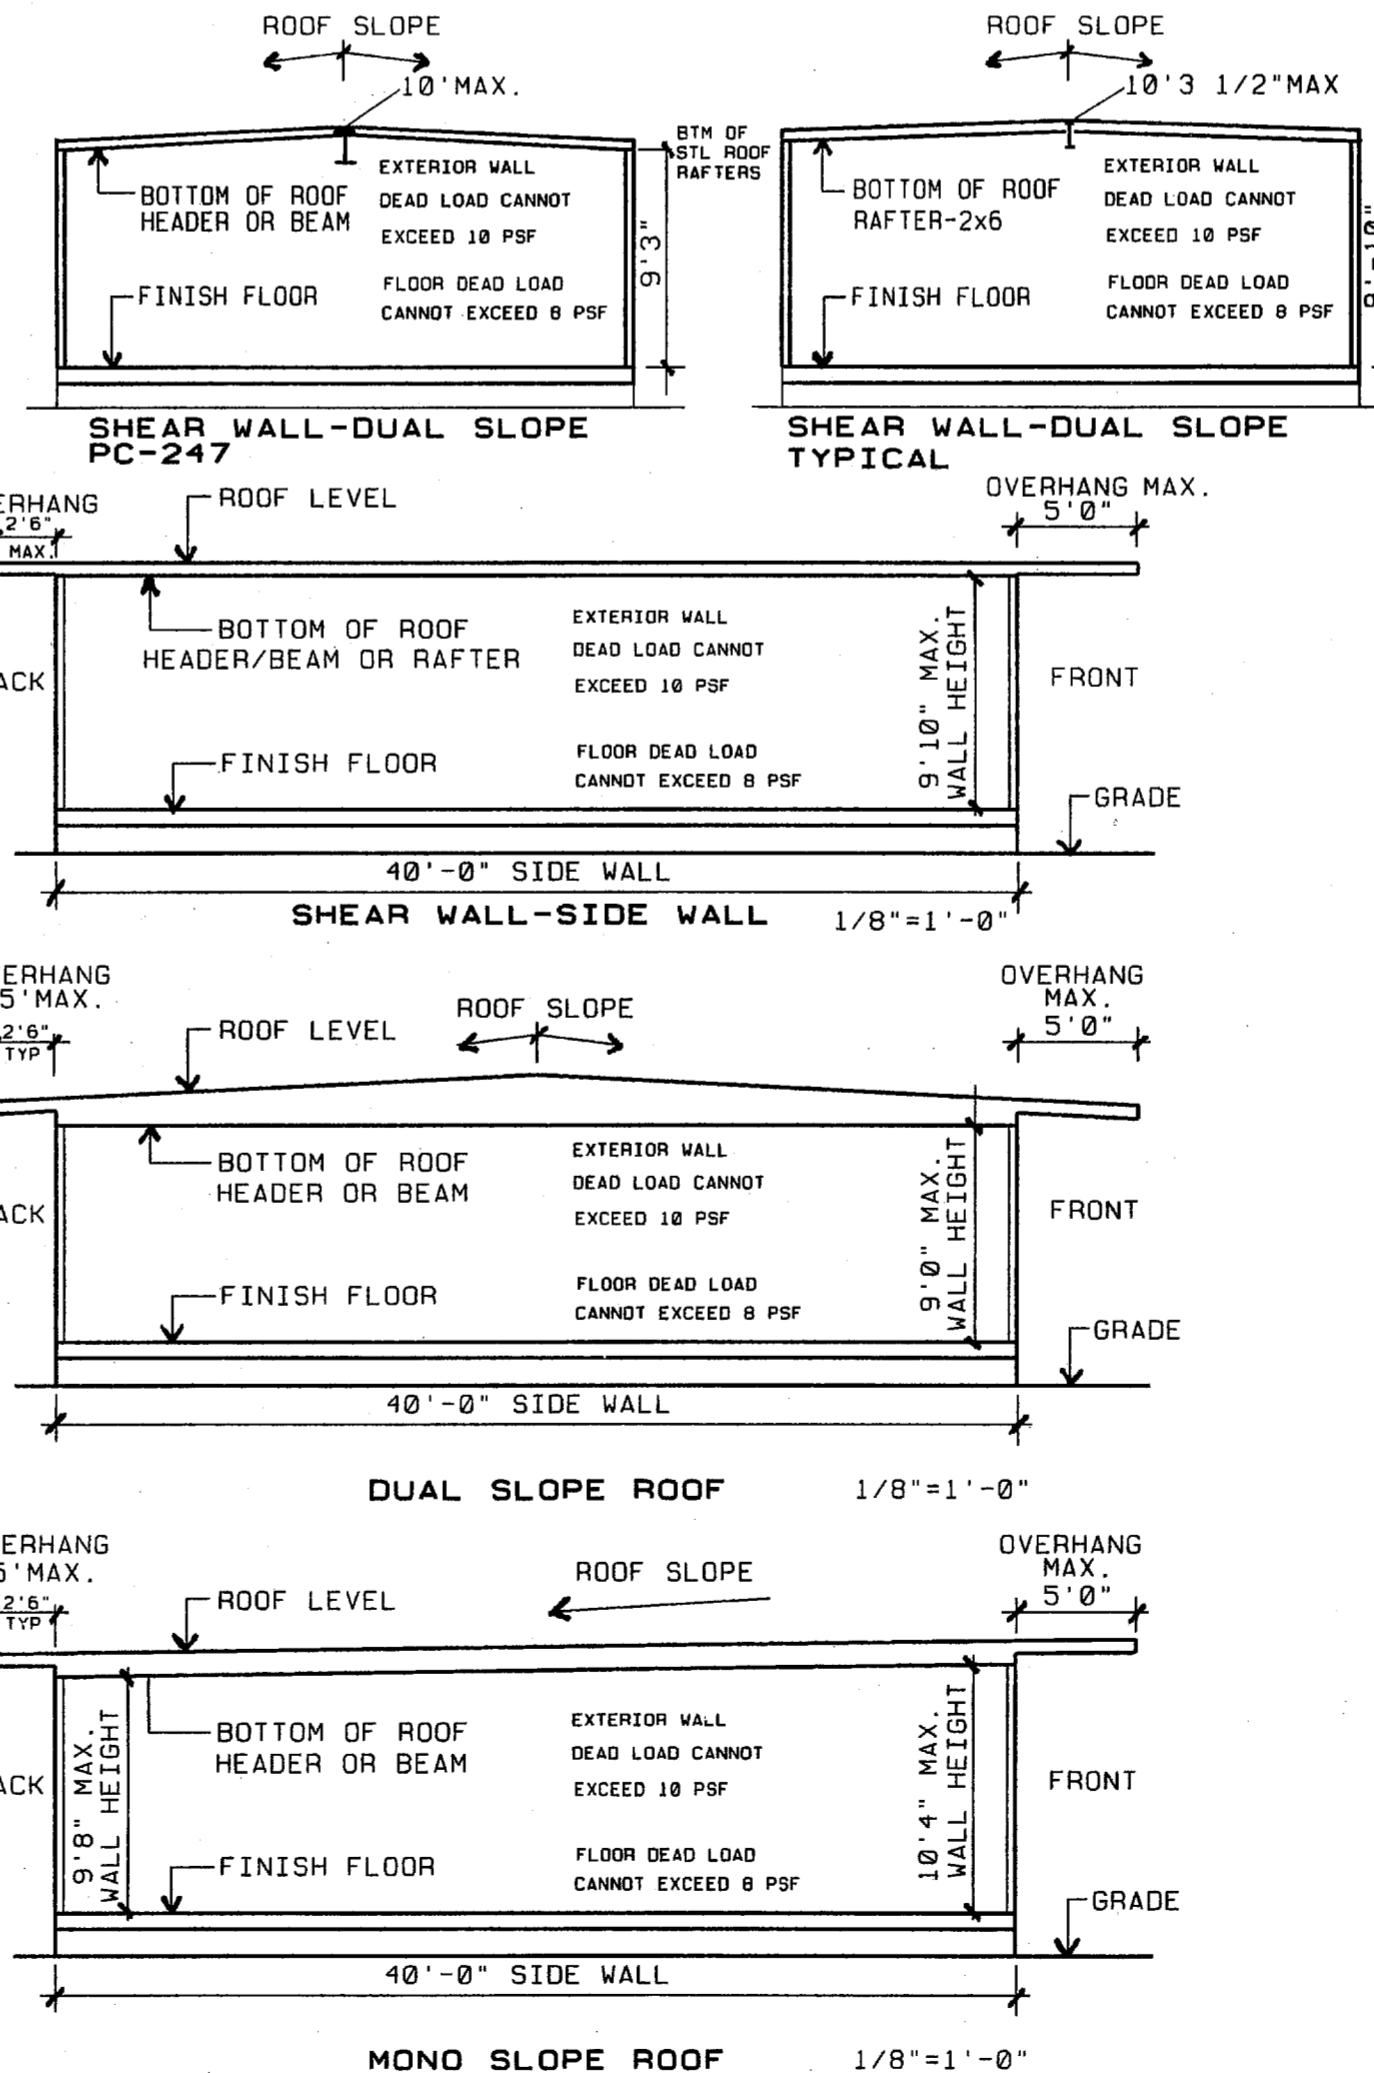

TYPICAL ELEVATIONS ARE SHOWN TO CLARIFY FOUNDATION PC ONLY LIMITATIONS
DOCUMENTATION SHALL BE PROVIDED BY ENGINEER OF GENERAL RESPONSIBLE CHARGE
TO BE REVIEWED AND APPROVED BY THE DSA STRUCTURAL PLAN REVIEWER.

SCOPE OF WORK: DSA FOUNDATION PLANS FOR EXISTING STOCKPILE BUILDINGS FOR CLASS LEASING, INC.

SHEET INDEX: STOCKPILE BUILDING FOUNDATION PC# 04-111441 - 2010 CODE UPDATE
F1.0 COVER SHEET, BUILDING DATA, STOCKPILE APPROVAL INDEX

NO.	DESCRIPTION
F1.1	24 x 40 - 50 PSF WOOD FOUNDATION PLAN & DETAILS, ADJACENT BUILDING PAD
F2.0	24 x 40 - 50 PSF FOUNDATION PLAN & DETAILS, ADJACENT BUILDING PAD
F2.1	24 x 40 - 50 PSF FOUNDATION PLAN & DETAILS, ADJACENT BUILDING PAD
F2.2	24 x 40 - 50 PSF FOUNDATION PLAN & DETAILS, ADJACENT BUILDING PAD
F2.3	24 x 40 - 100 PSF FOUNDATION PLAN & DETAILS, ADJACENT BUILDING PAD
F4.0	48 x 40 - 50 PSF FOUNDATION PLAN & DETAILS, ADJACENT BUILDING PAD
F4.1	48 x 40 - 50 PSF FOUNDATION PLAN & DETAILS, ADJACENT BUILDING PAD
F4.2	48 x 40 - 100 PSF FOUNDATION PLAN & DETAILS, ADJACENT BUILDING PAD

ADJACENT BUILDINGS: ONLY THOSE BUILDINGS MANUFACTURED BY THE SAME COMPANY MAY BE PLACED ADJACENT TO EACH OTHER.

CLASS LEASING- APPROVED STOCKPILE A NUMBERS FOR THIS FOUNDATION PC

STKP #	DSA #	PC-BASE	DATE	SIZE	FLOOR LOAD	BLDG MFG.
STKP 1029	50643	SHR	10/21/88	24x40	50+20#	MODTECH
STKP 02	52512	48137-SHR	11/08/89	24x40	50#	MODTECH
STKP 01	52513	46750-SHR	11/08/89	24x40	50#	MODTECH
STKP 03	52514	SHR	11/08/89	24x40	50#	MODTECH
STKP 05	52515	45400-SHR	12/07/89	24x40	50#	AURORA
STKP 04	52516	SIM PC 28 SHR	12/07/89	24x40	50#	MODTECH
STKP 22	55113	PC 80	10/05/90	24x40	50#	MODTECH
STKP 24	55580	PC 95	08/14/94	24x40	50#	MODTECH
STKP 13	61957	PC 247	06/29/94	24x40	50#	MODTECH
STKP 77	57970	PC 247	11/10/97	24x40	50#	MODTECH

STKP #	DSA #	PC-BASE	DATE	SIZE	FLOOR LOAD	BLDG MFG.
STKP 11	52482	MRF	06/13/91	24x40	50+20#	MODTECH
STKP 20	55031	PC 79	09/19/90	24x40	50#	MODTECH
STKP 21	55032	PC 79	09/19/90	24x40	50#	MODTECH
STKP 23	55347	PC 79	11/26/90	24x40	50#	MODTECH
STKP 30	57184	PC 79	11/08/91	24x40	50+20#	MODTECH
STKP 14	57679	PC 98	03/19/92	24x40	50#	MODTECH
STKP 18	63288	PC 243	05/04/95	24x40	50#	MODTECH
STKP 19	63321	PC 242	05/11/95	24x40	50#	MODTECH
STKP 27	65493	PC 266	07/31/98	24x40	50#	MODTECH
STKP 31	66318	PC 266	11/12/98	24x40	50+20#	MODTECH
STKP 33	67333	PC 266	03/11/97	24x40	50#	MODTECH
STKP 35	04-100117	PC 266	01/15/98	24x40	50+20#	MODTECH
STKP 39	04-100595	PC 275	08/10/98	24x40	50+20#	MODTECH
STKP 37	04-100596	PC 266	08/10/98	24x40	50+20#	MODTECH
STKP 40	04-100690	PC 282	09/03/98	24x40	50+20#	MODTECH
STKP 42	04-100929	PC 266	01/07/99	24x40	50+20#	MODTECH
STKP 43	04-101555	PC 275	09/09/99	24x40	50#	MODTECH
STKP 44	04-101602	PC 266	09/30/99	24x40	50+20#	MODTECH
STKP 48	04-101768	PC 101268	12/16/99	24x40	50#	MODTECH
STKP 51	04-102015	PC 101268	03/16/00	24x40	50# 50+20#	MODTECH
STKP 53	04-102365	PC 101268	07/06/00	24x40	50+20#	MODTECH
STKP 56	04-102824	PC 101268	12/21/00	24x40	50#	MODTECH
STKP 62	04-104169	PC 101268	04/18/02	24x40	50+20#	MODTECH
STKP 67	04-104812	PC 101268	12/05/02	24x40	50+20#	MODTECH
STKP 70	04-105299	PC 104801	05/22/03	24x40	50+20#	MODTECH
STKP 76	04-105455	PC 104796	07/17/03	24x40	50#	MODTECH
STKP 78	04-109208	PC 106884	12/13/07	24x40	50#	CURRENT/SMI


STKP #	DSA #	PC-BASE	DATE	SIZE	FLOOR LOAD	BLDG MFG.
STKP 15	52476	MRF	12/18/91	36x40	50#	MODTECH
STKP 32	66370	PC 266	11/12/96	36x40	50+20#	MODTECH
STKP 34	67332	PC 266	03/11/97	36x40	50+20#	MODTECH
STKP 45	04-101618	PC 101268	10/07/99	36x40	50+20#	MODTECH
STKP 57	04-103001	PC 101268	08/11/00	36x40	50#	MODTECH
STKP 65	04-104441	PC 101268	07/11/00	36x40	50+20#	MODTECH
STKP 71	04-106419	PC 104801	07/29/04	36x40	50+20#	MODTECH
STKP 73	04-108585	PC 101268	03/01/07	36x40	100#	MODTECH
STKP 74	04-108895	PC 107557	08/07/07	36x40	50+20#	SILVERCREEK
STKP 81	04-110319	PC 109598	04/09/09	36x40	50+20#	SMI
STKP 89	04-111101	PC 79	09/03/10	36x40	50+20#	MODTECH

STKP #	DSA #	PC-BASE	DATE	SIZE	FLOOR LOAD	BLDG MFG.
STKP SW	52484	PC 79	11/08/91	48x40	100#	MODTECH
STKP SW	57194	PC 79	11/08/91	48x40	70#	MODTECH
STKP 17	63289	PC 266	05/04/95	48x40	50+20#	MODTECH
STKP 41	04-100797	PC 266	05/04/95	48x40	50+20#	MODTECH
STKP 46	04-101617	PC 101268	10/07/99	48x40	50+20#	MODTECH
STKP 63	04-104170	PC 101268	04/18/02	48x40	50+20#	MODTECH

PRE-CHECK (PC) DOCUMENT
CODE: 2010 CBC
A SEPARATE PROJECT APPLICATION FOR CONSTRUCTION IS REQUIRED

IDENTIFICATION STAMP
DIV. OF THE STATE ARCHITECT
OFFICE OF REGULATION SERVICES
PC 04-112161
DATE: FEB 01 2012

RELOCATION STOCKPILE CLASSROOM FOUNDATION PLAN & DETAILS

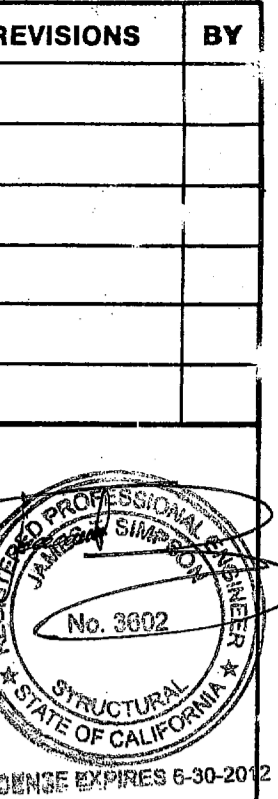

APR 25 2012


SCANNED

CLASS LEASING, INC.
P. O. Box 51150 Riverside, CA 92517-2150
1221 Harley Knox Blvd. Perris, CA 92571-7408
VOICE (951) 943-1908 FAX (951) 943-5768


CLASS LEASING, INC.
STOCKPILE CLASSROOM
RELOCATION
FOUNDATION PLAN & DETAILS
PC 04-111441

24x40-50
DATE 08-15-2011
SCALE
DRAWN LAM-CLLS
JOB
SHEET F1.0

3"x24" END WALL VENTS AS REQUIRED FOR ADJACENT BUILDING APPLICATIONS MIN 18" FROM BUILDING CORNERS MIN 18" FROM MODLINES MIN 12" BLOCKING BETWEEN VENTS

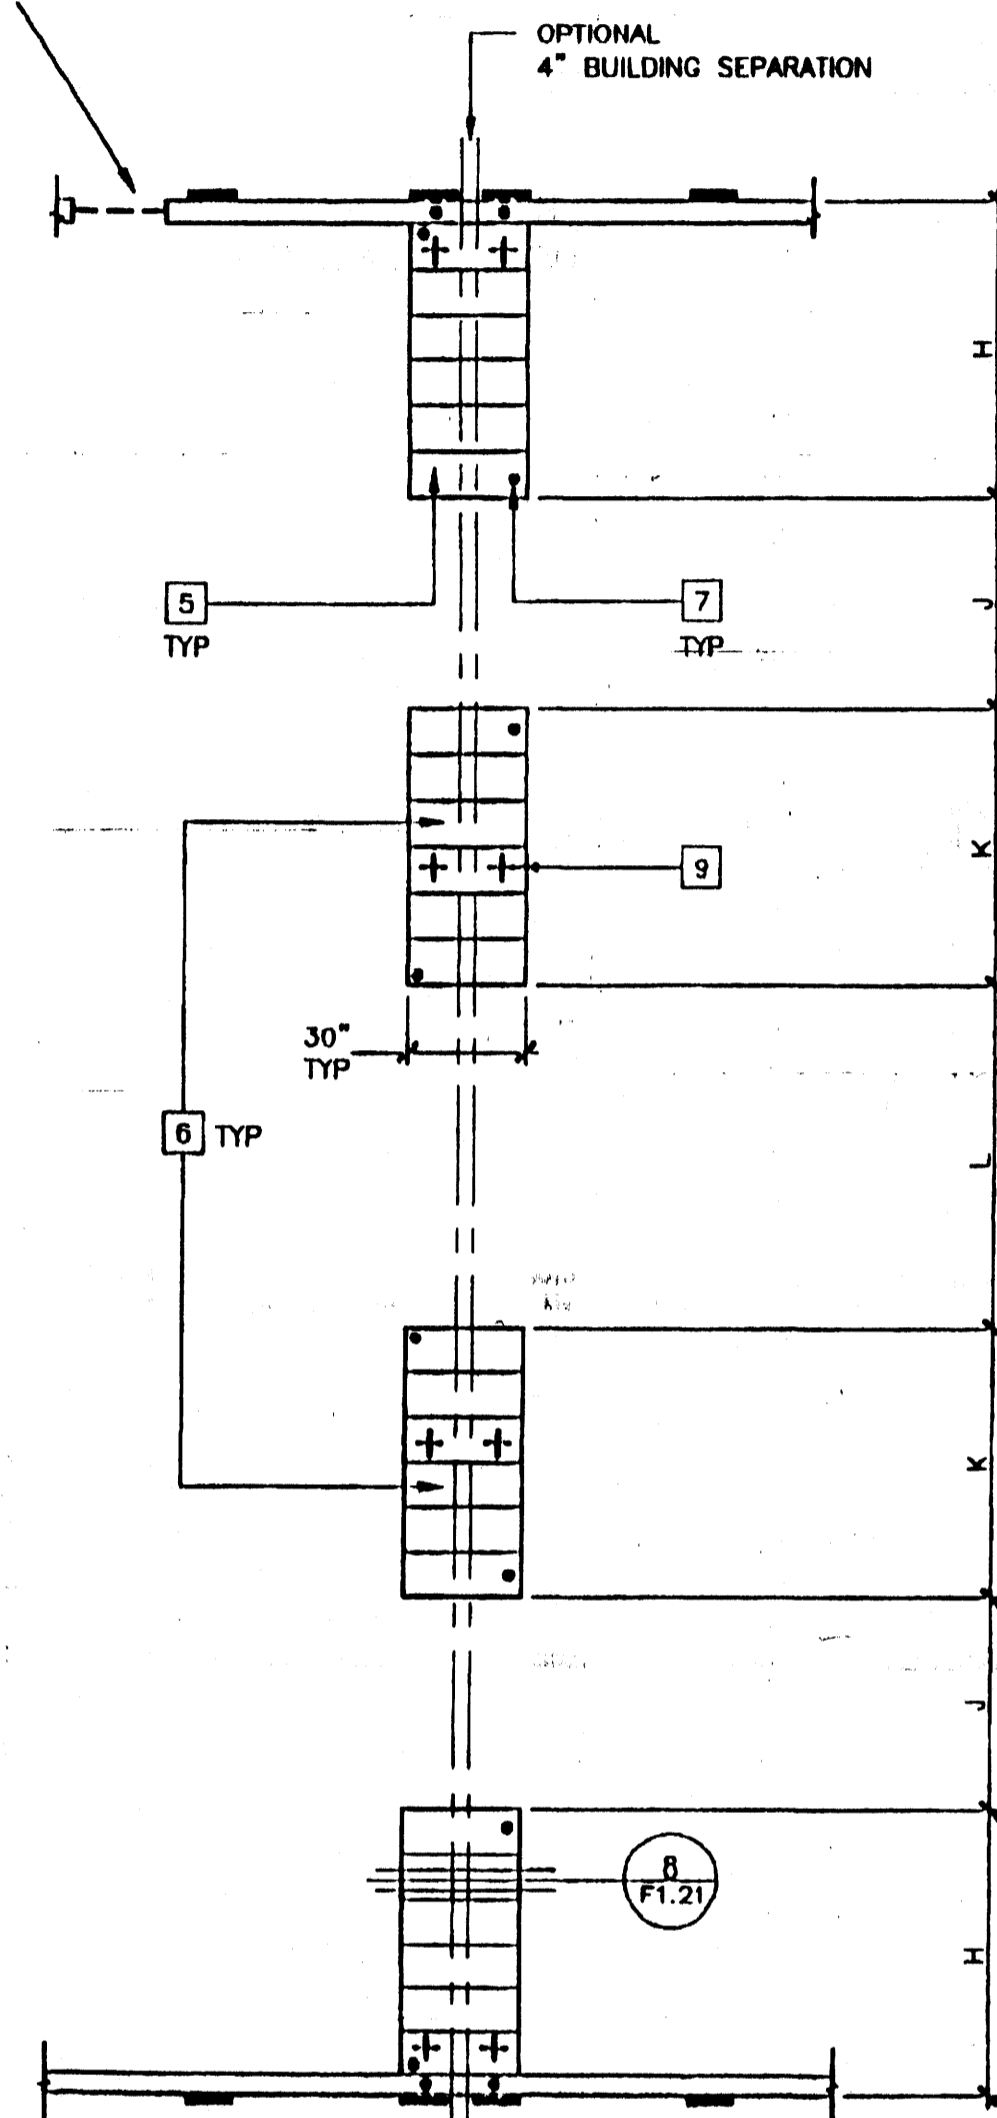

FOOTINGS AT ADJACENT BUILDING (OPTIONAL 4" SEPARATION)

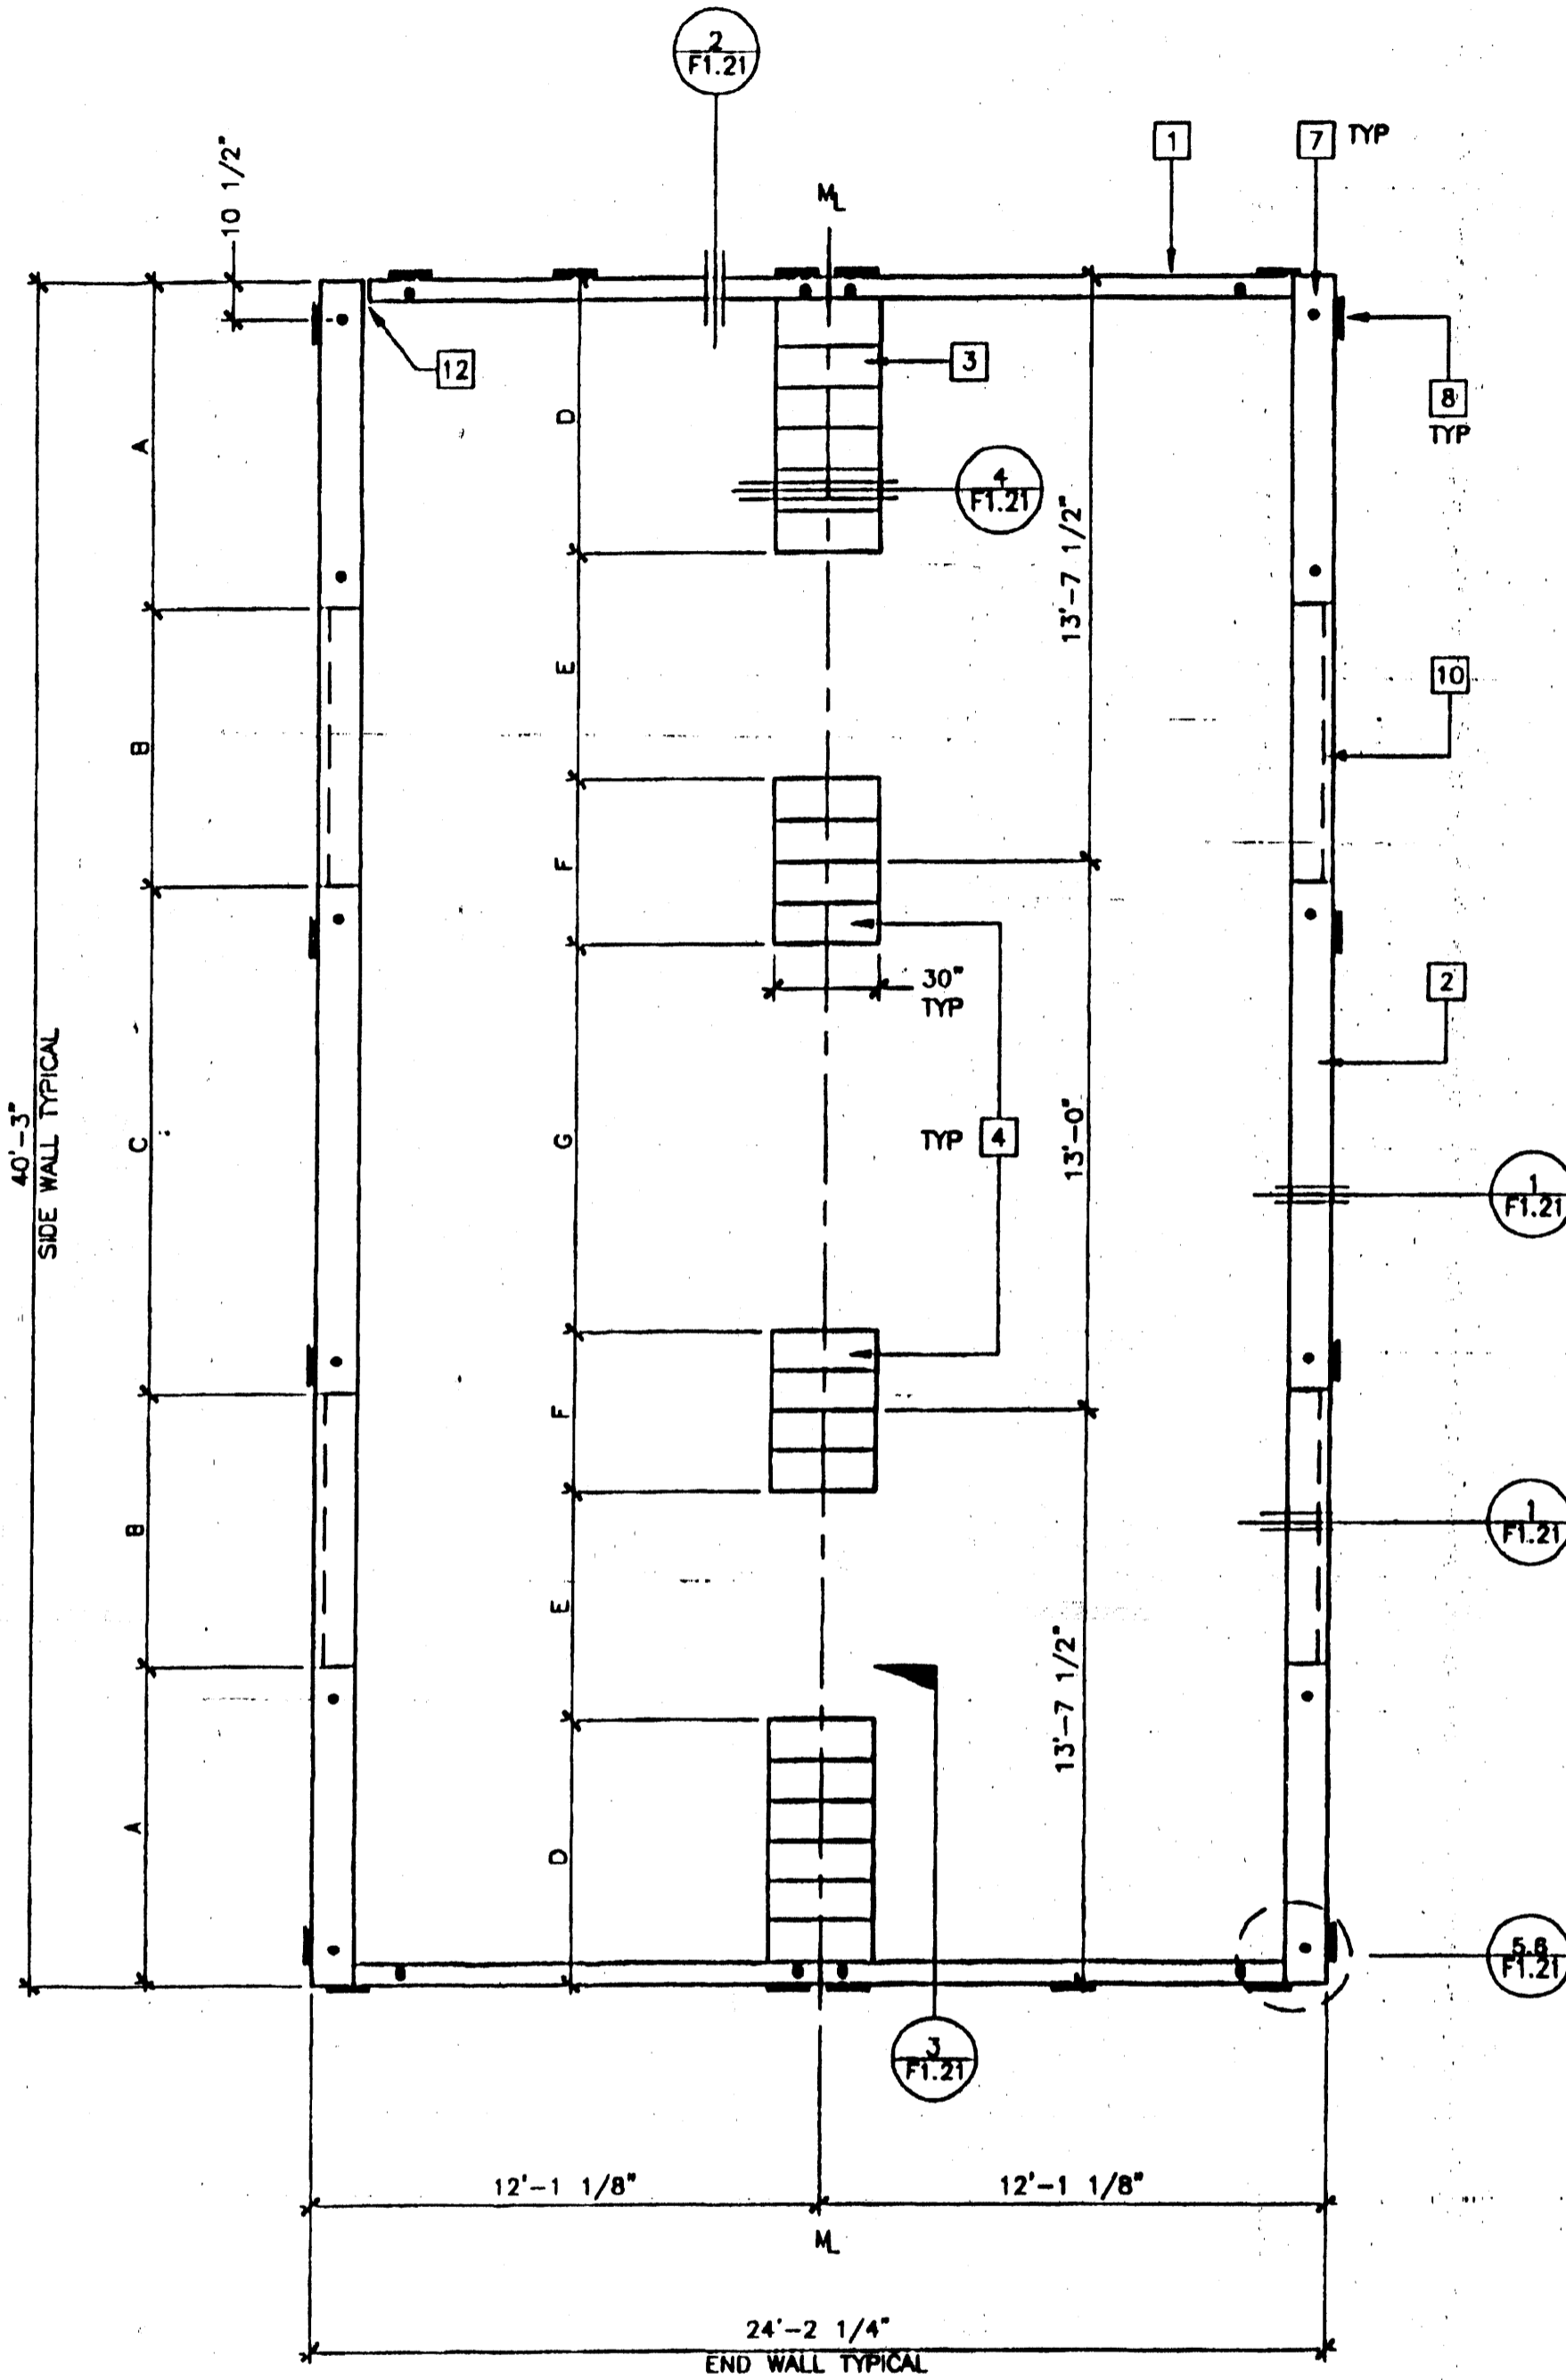

FOUNDATION PLAN

24'x40' WOOD SILL
SCALE: 1/4" = 1'-0"

FOUNDATION PLATE SCHEDULE

		50 PSF	50 + 20 PSF	100 PSF
END WALL	SILL	2"x6"	2"x6"	2"x12"
	BLOCKING	2"x4"	2"x4"	2"x6"
	TOP PLATE	2"x4"	2"x4"	2"x6"
SIDE WALL	SILL	2"x12"	2"x12"	2"x12"
	BLOCKING	2"x6"	2"x6"	2"x6"
	TOP PLATE	2"x4"	2"x6"	2"x4"
MODLINE PAD AT ENDWALL	SILL	(6)2" x 12" x 30"	(7)2" x 12" x 30"	(5)2" x 12" x 30"
	BLOCKING	2"x10"	2"x10"	2"x10"
	TOP PLATE	2"x8"	2"x8"	2"x8"
MODLINE PAD AT INTERIOR	SILL	(4)2" x 12" x 30"	(5)2" x 12" x 30"	(12)2" x 10" x 30"
	BLOCKING	2" x 8"	2" x 10"	2" x 10"
	TOP PLATE	2" x 8"	2" x 8"	2" x 8"
4" SEPARATION PAD AT END WALL	SILL	(6)2" x 12" x 30"	(6)2" x 12" x 30"	(6)2" x 10" x 30"
	BLOCKING	2" x 12"	2" x 12"	2" x 12"
	TOP PLATE	2" x 12"	2" x 12"	2" x 12"
4" SEPARATION PAD AT INTERIOR	SILL	(2)2" x 12" x 30"	(6)2" x 12" x 30"	(4)2" x 10" x 30"
	BLOCKING	2" x 12"	2" x 12"	2" x 12"
	TOP PLATE	2" x 12"	2" x 12"	2" x 12"

DIMENSION SCHEDULE

	50 PSF	50 + 20 PSF	100 PSF	125 PSF
A	7'-7 1/2"	9'-1 1/2"	9'-1 1/2"	
B	4'-6"	4'-0"	4'-0"	
C	1'-0"	14'-0"	14'-0"	
D	6'-1"	7'-1/4"	5'-7 1/2"	
E	5'-1"	4'-4"	3'-8"	
F	3'-9"	4'-8 1/4"	9'-3"	
G	9'-7"	8'-2"	3'-8"	
H	6'-1"	6'-1"	5'-6 1/2"	
J	4'-9"	3'-10"	2'-6"	
K	5'-7 1/2"	7'-6"	10'-9 1/2"	
L	7'-4"	5'-5"	2'-7 1/2"	



VENT CALCULATIONS

VENTING REQUIRED = 24'x40' = 960 / 150 = 6.4 SF

VENT
 S1 = 3"x78" = 1.63 SF
 S2 = 3"x48" = 1.00 SF
 E1 = 3"x24" = 0.50 SF

50 PSF FLOOR LOAD
 S1x4 = 6.52 SF > 6.40 SF OK

50+20 PSF FLOOR LOAD
 S2x4 = 4.00 SF
 E1x5 = 2.50 SF
 6.50 SF > 6.4 OK

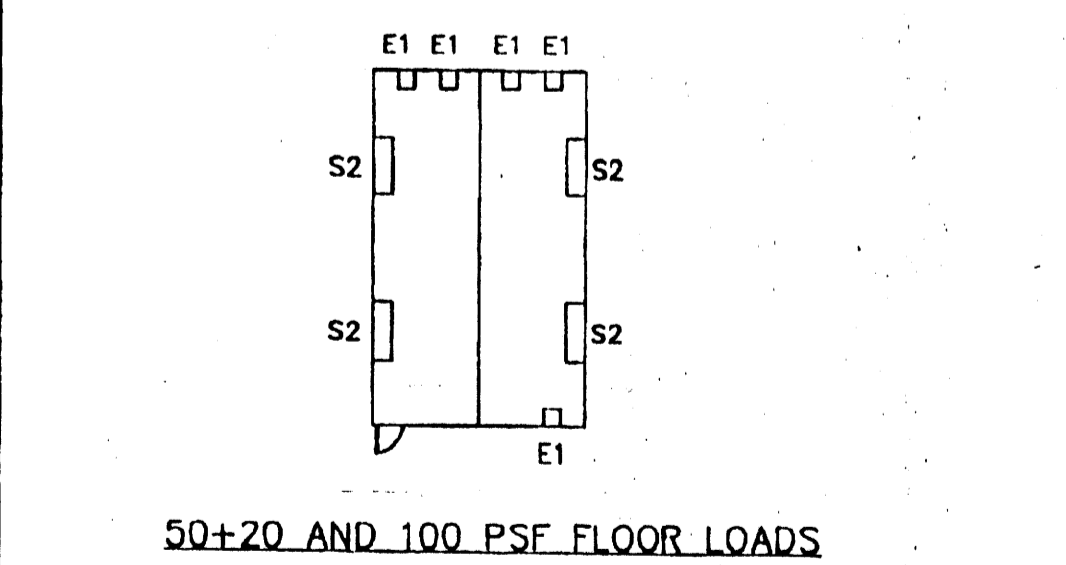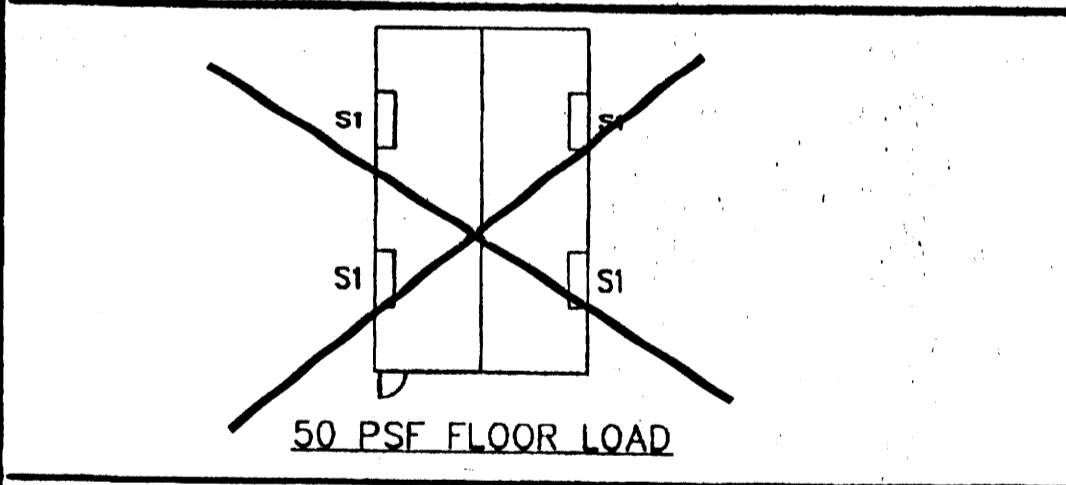

VENT LEGEND

S1 = SIDE WALL VENT, 3"x6"-6"
 S2 = SIDE WALL VENT, 3"x4"-0"
 E1 = END WALL VENT, 3"x2"-0"


KEY NOTES

- FOUNDATION AT END WALL - SEE FOUNDATION PLATE SCHEDULE
- FOUNDATION AT SIDE WALL - SEE FOUNDATION PLATE SCHEDULE
- FOUNDATION MODLINE PAD AT END WALL - SEE FOUNDATION PLATE SCHEDULE.
- FOUNDATION MODLINE PAD AT INTERIOR - SEE FOUNDATION PLATE SCHEDULE.
- FOUNDATION PAD AT 4" SEPARATION AT END WALL
- FOUNDATION PAD AT 4" SEPARATION AT INTERIOR WALL
- SILL RESTRAINT - SEE NOTE 1
- TIE PLATE - 5/8", F1.21
- AT 70 MPH DESIGN WIND LOAD: MIN (4) AT EACH END WALL, (3) AT EACH SIDE WALL
- AT 80 MPH DESIGN WIND LOAD: MIN (5) AT EACH END WALL, (3) AT EACH SIDE WALL
- 5/8" DIAx4" LAGS
- FOUNDATION VENT
- FOR VENTS THAT OCCUR UNDER LANDINGS PROVIDE EQUAL AREA SCREENED VENT IN LANDING SKIRT
- 2" CUTOFF OF SILL PLATE FOR DRAINAGE, FIELD TO LOCATE AT LOWEST CORNER OF FOUNDATION

NOTES

- SILL RESTRAINT:
ON ASPHALT CONCRETE PAVING OR ON SOIL OR ON PRE-DRILLED CONCRETE SLAB ON GRADE USE 1" OD GALVANIZED PIPE AT 10'-0" OC MAX 12" PENETRATION BELOW SURFACE VERTICALLY DRILLED SILL HOLE TO BE 1 1/4" MAX. PIPE MAY BE DRIVEN MAX OF 45° ANGLE. TO VERTICAL 18-1/2" LONG PIPE REQUIRED FOR PENETRATION AT 45° ANGLE.
ALTERNATE:
ON CONCRETE PAVING HILTI DS 82-P10 THRU SILL PLATE, 8" OC AT END WALLS AND 16" OC AT SIDE WALLS.
- TO PREVENT WATER FROM PONDING BENEATH THE STRUCTURE VERIFY DRAINAGE WITH DISTRICT ARCHITECT SITE PLANS
- A WOOD SILL (FOOTING) PLATE SHALL BE PRESSURE TREATED HEM FIR OR DOUG FIR AND MAY BEAR DIRECTLY ON SOIL OR PAVED SURFACE. GRASS OR TURF SHALL BE CLEARED TO BARE SOIL UNDER THE ENTIRE AREA OF THE BUILDING (BY DISTRICT). THE WOOD SILL (FOOTING) PLATE MAY SUPPORT WOOD CRIPPLE STUDS, POSTS OR CONTINUOUS BLOCKING AND SHEATHING (SKIRT) WHICH NEED NOT BE TREATED. FOUNDATION LUMBER TO BE PRECUT AT FACTORY, LUMBER AND PRESSURE TREATING TO BE VERIFIED BY THE IN-PLANT INSPECTOR.
- FOUNDATION DESIGNED FOR 1000 PSF SOIL BEARING PRESSURE PER ORS IR 23-6.
- THIS FOUNDATION PLAN HAS 1/4" ADDED AT EACH MODLINE AND 1/8" AT EACH SIDE WALL AND DOES NOT MATCH THE FLOOR PLAN, THIS IS REQUIRED FOR GROWTH THAT IS EXPERIENCED WHEN SETTING MULTIPLE MODULE BUILDINGS.

BUILDINGS OVER 2160 SQ. FT. MUST BE INSTALLED ON A PERMANENT CONCRETE FOUNDATION.

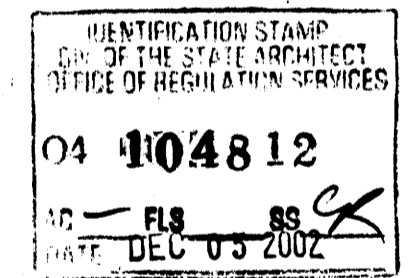

REVISIONS

NO.	DESCRIPTION	DATE
1	ADDED NOTE #6	9/7/00
2	REVISED VENT LEGEND	12/20/00
3	REVISED NOTE #1	01/03/00

REVISOR: [Signature]

REVISOR: [Signature]

REVISED JAN 4 2001 **PC**

REVISED [Signature] **CBC 1998**

IDENTIFICATION STAMP
 DIV. OF THE STATE ARCHITECT
 OFFICE OF REGULATION SERVICES
 PC-04
 101268
 AC. FILE NO. 04
 DATE SEP 07 1999

MODTECH INC.
 2830 BARRETT AVENUE
 PERRIS, CALIF. 92572
 PH (909) 943-4014
 FAX (909) 940-0427

PROJECT NUMBER: 4373, 4378, 4384, 4438 © MODTECH, INC. 2002
 4474


10- 24 x 40 CLASSROOMS A# 04-104812
 SERIAL # 46974-01/02 TO 46978-01/02
 SERIAL # 47176-01/02 TO 47176-01/02

FOUNDATION PLAN 24'x40'/WOOD/50, 50+20, 100 PSF


DRAWN BY: KK
 DATE: 11/19/02
 CHECKED BY: STKP-67
 DATE: 4012-129

F1.01


FILE PATH: 2440-F1.01.DWG PROJECT NO. 4373

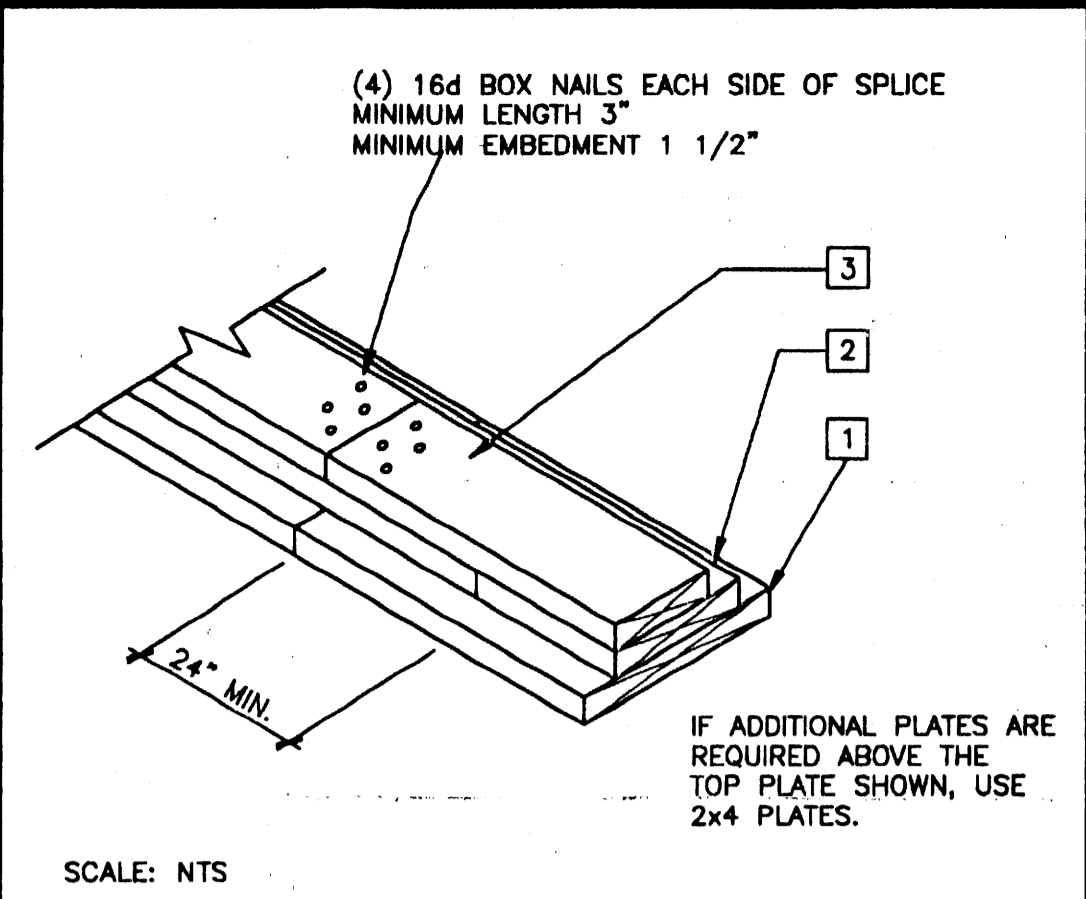


FOUNDATION SPLICE 9

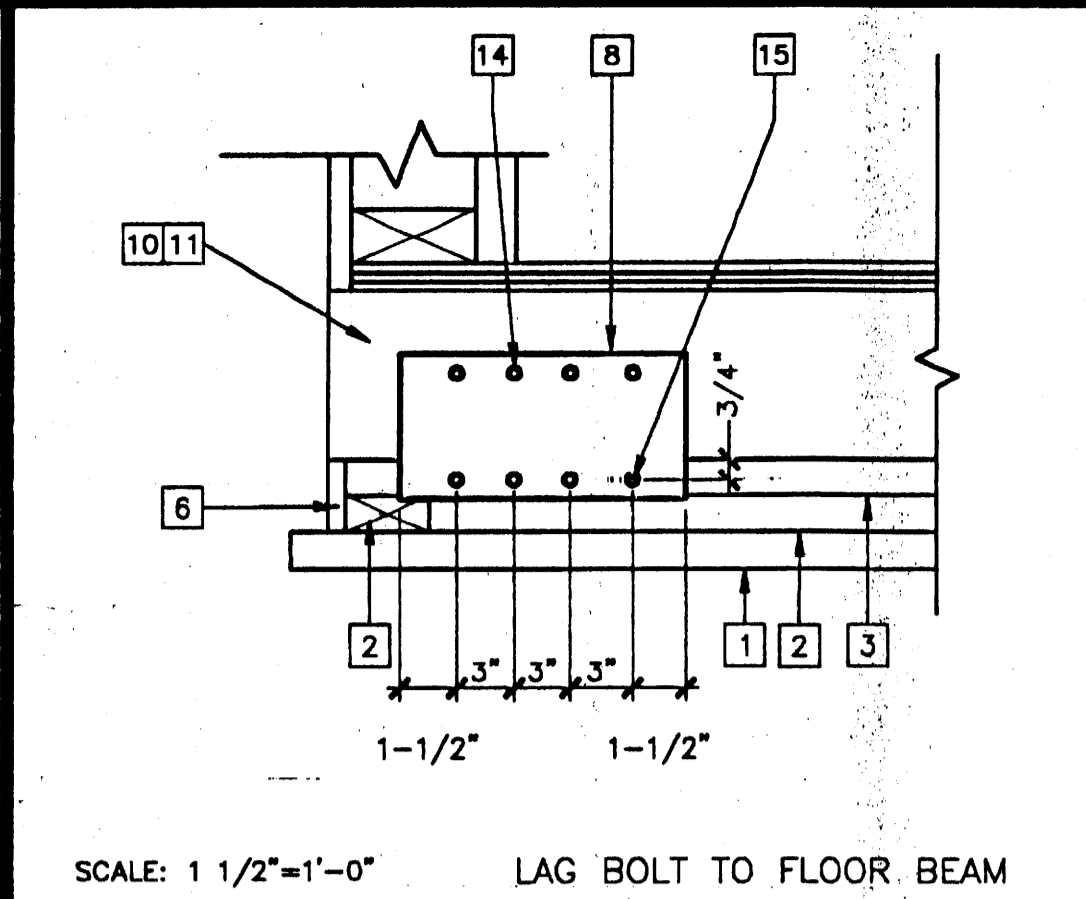


TIE PLATE 5

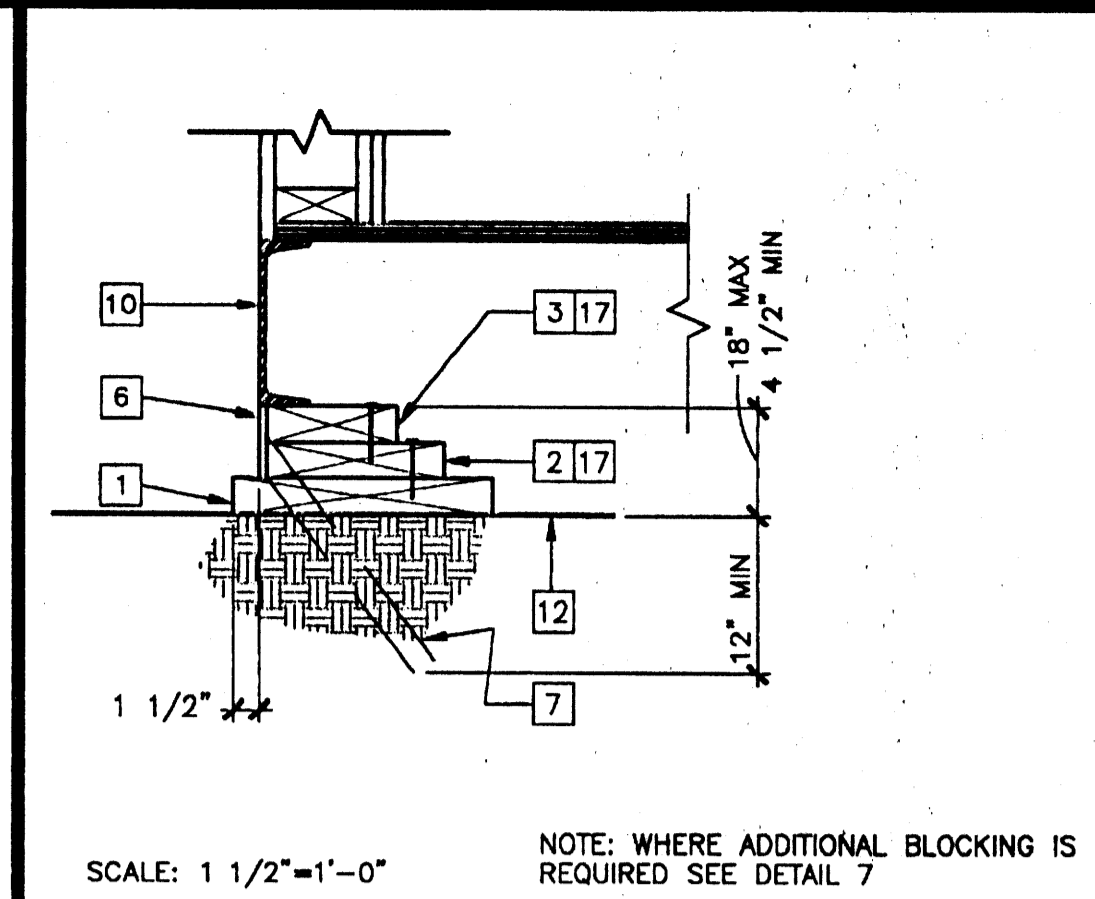


FOUNDATION AT SIDE WALL 1

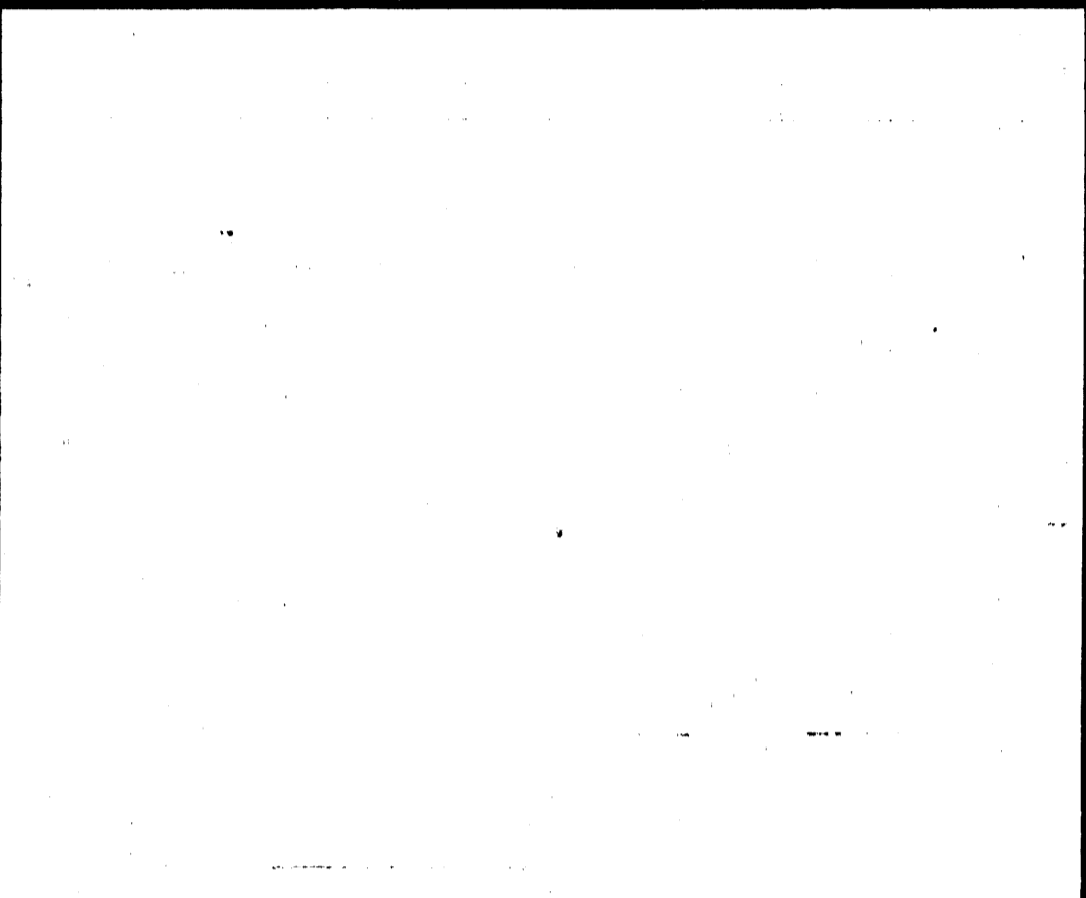


TIE PLATE (ALTERNATE) 6

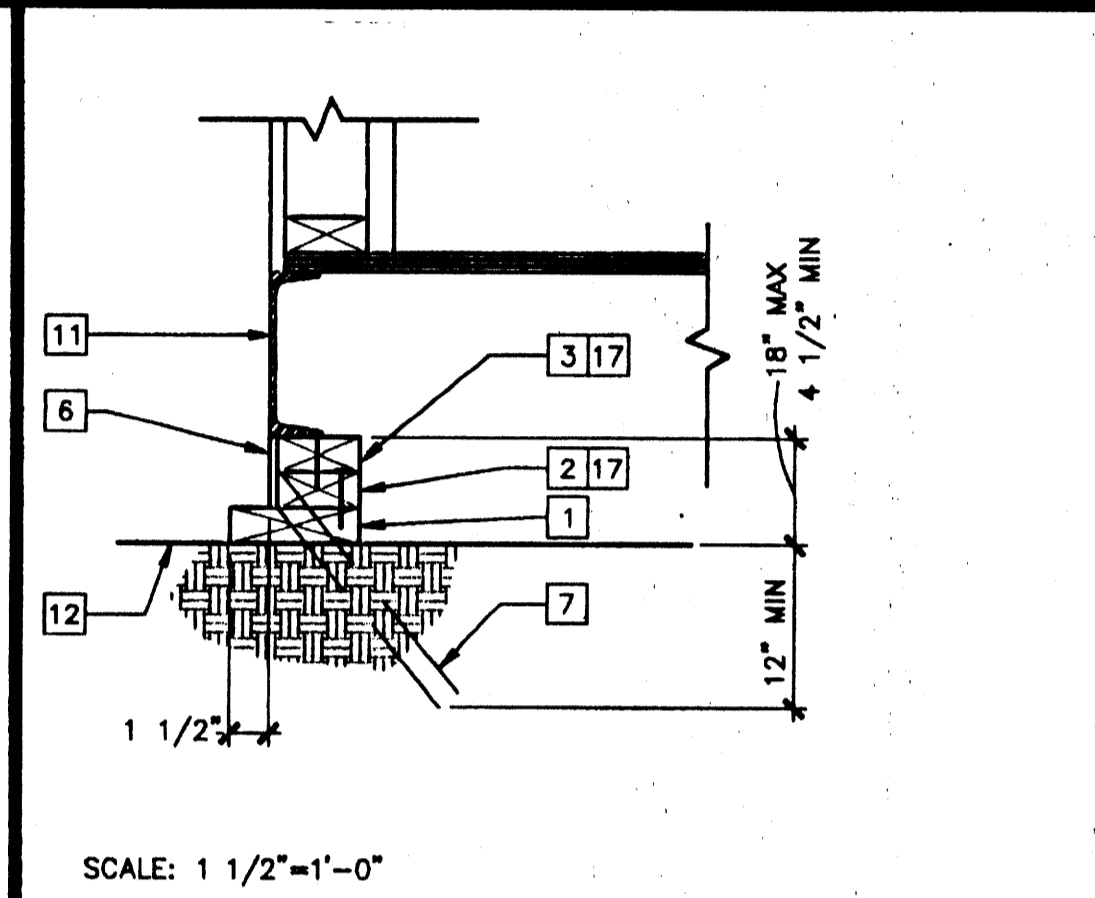


FOUNDATION AT END WALL 2

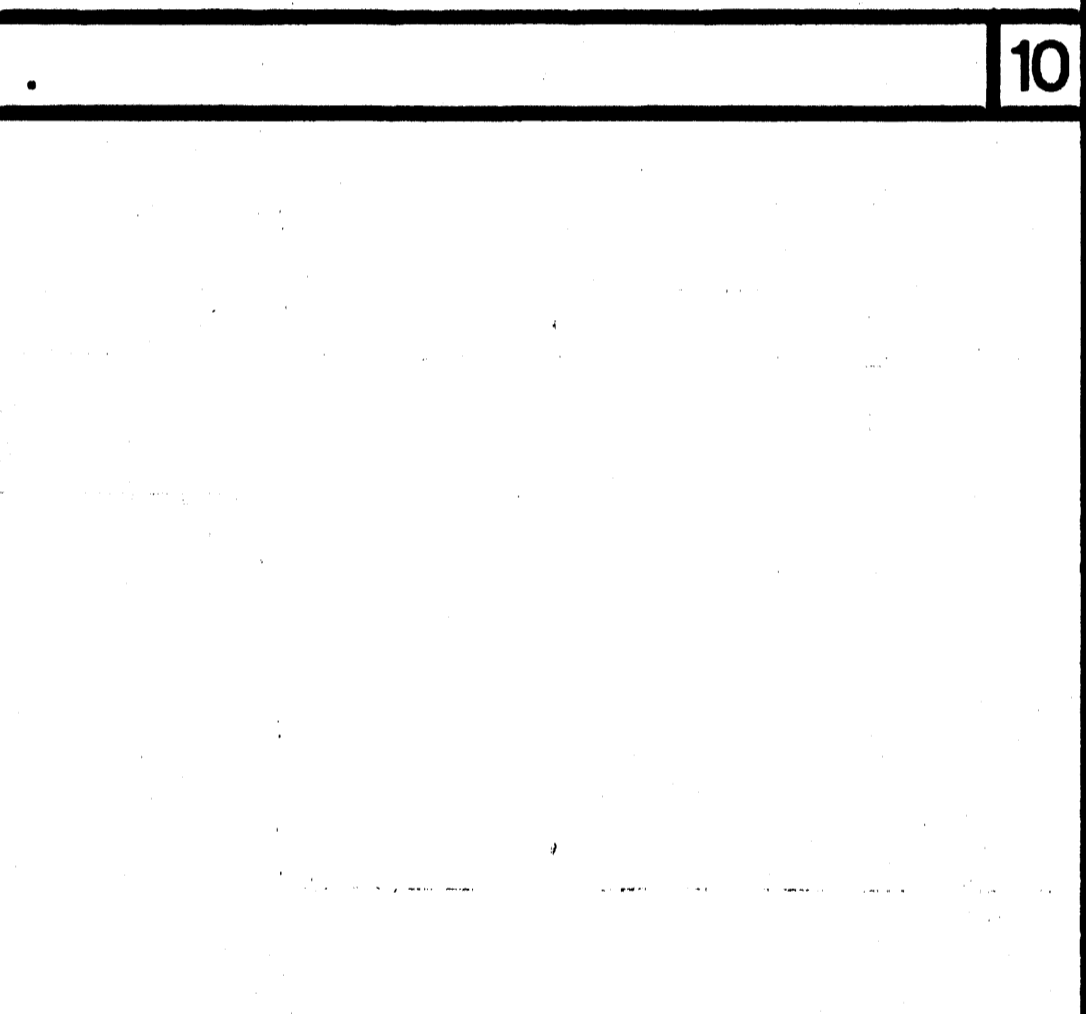


ADDITIONAL BLOCKING 7

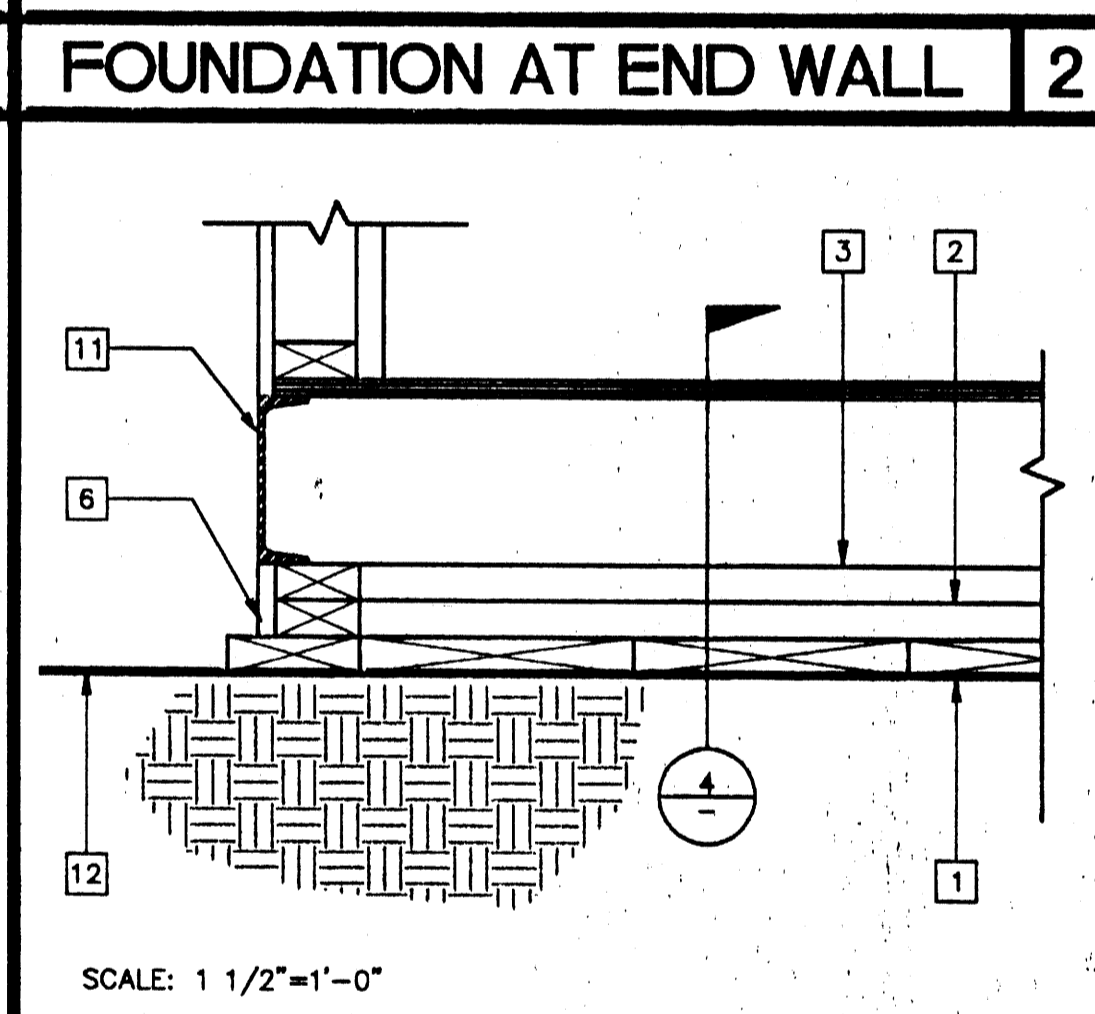

FOUNDATION AT MODLINE 3

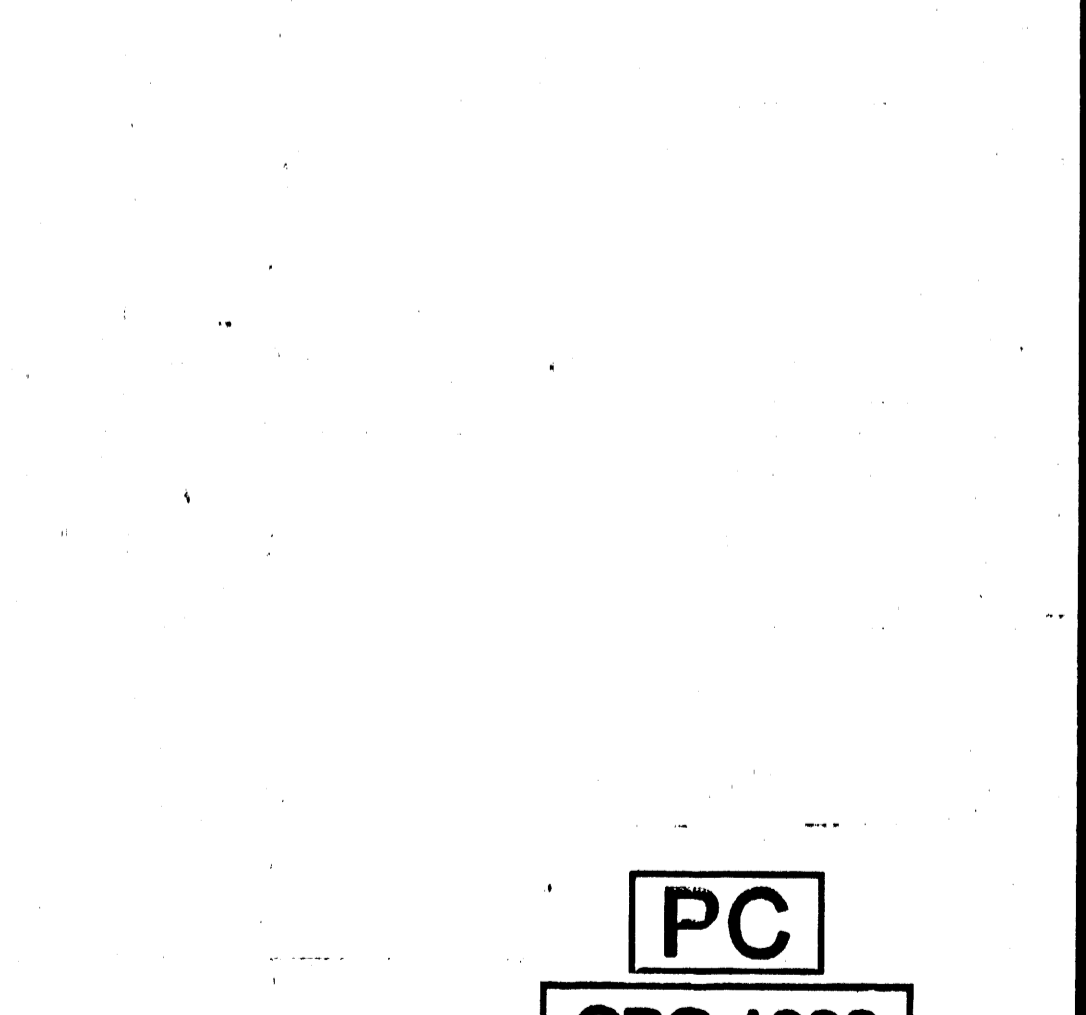

FOUNDATION AT ADJACENT BUILDING 8

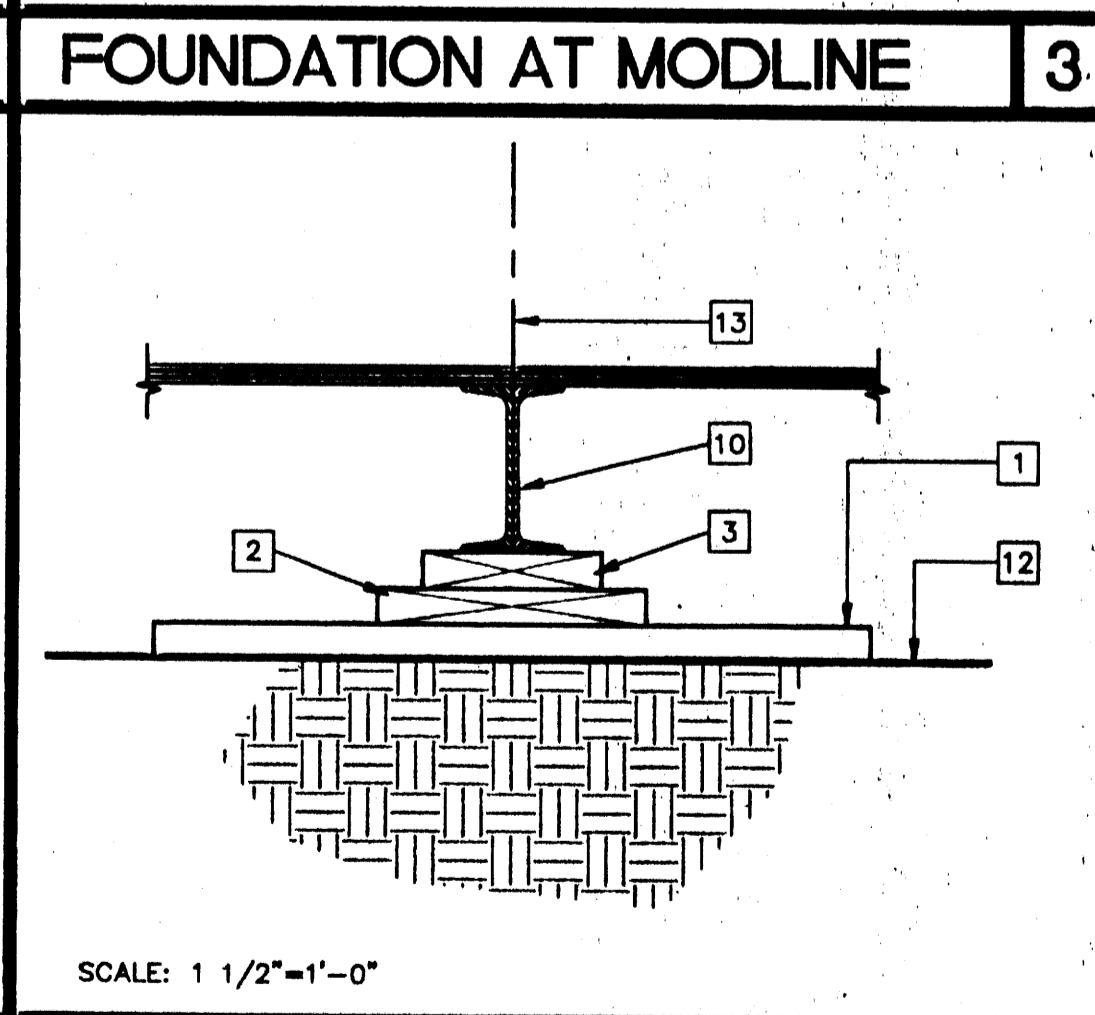

FOUNDATION AT MODLINE 4

- KEY NOTES**
- SILL PLATE - SEE FOUNDATION PLATE SCHEDULE.
 - BLOCKING PLATE - SEE FOUNDATION PLATE SCHEDULE, ATTACH TO SILL OR BLOCKING WITH 16d NAILS AT 12" OC
 - TOP PLATE - SEE FOUNDATION PLATE SCHEDULE, ATTACH TO BLOCKING WITH 16d NAILS AT 12" OC
 - ADDITIONAL 2"x4" BLOCKING AS NECESSARY FOR LEVELING
 - LOCATION OF SHIM PLATES WHERE REQUIRED FOR LEVELING USE 1/4", 1/2" OR 3/4" PLYWOOD AT SAME WIDTH AS TOP PLATE
 - SKIRTING-3/8" PLYWOOD, ATTACH WITH 10d NAILS, EDGE NAILING 4" OC AT END WALLS AND 6" OC AT SIDE WALLS, FIELD NAILING 12" OC
 - SILL RESTRAINT - SEE NOTE 1
 - TIE PLATE 6"x12"x10 GA
 - TIE PLATE 4"x12"x10 GA
 - FLOOR BEAM
 - FLOOR HEADER
 - FINISH GRADE
 - MODLINE
 - 1/4" DIA STS TYPICAL 4 PLACES
 - 1/4" DIAx3" LONG LAG SCREW TYPICAL 4 PLACES
 - 5/8" DIAx4" LAGS (FOR LOCATION SEE PLAN)
 - REMOVE AT VENT LOCATIONS

IDENTIFICATION STAMP
DIVISION OF THE STATE ARCHITECT
OFFICE OF REGULATION SERVICES
04 104812
FIS SS
DEC 05 2002

PC
CBC 1998

REVISIONS

1		
2		
3		
4		
5		

Electrical Engineer's Seal
Mechanical Engineer's Seal
Structural Engineer's Seal
Architect's Seal

IDENTIFICATION STAMP
DIV. OF THE STATE ARCHITECT
OFFICE OF REGULATION SERVICES
PC-04
101268
DATE: SEP 07 1999


MODTECH INC.
2830 BARRETT AVENUE
PERRIS, CALIF. 92572
PH (909) 943-4014
FAX (909) 940-0427

PROJECT NUMBER: 4373, 4378, 4384, 4438 © MODTECH, INC. 2002
4474
10-24 X 40 CLASSROOMS A# 04-104812
SERIAL # 46974-01/02 TO 46978-01/02
SERIAL # 47176-01/02 TO 47176-01/02
4474 STOCK-LATHROP STOCKPILE #67

DRAWN BY: KK
DATE: 11/19/02
CHECKED BY: STKP-67
DATE: 4/02-124
MODTECH Index No.

FOUNDATION DETAILS WOOD/50, 50+20, 100 PSF **F1.21**

FILE PATH: 2440-F1.21.DWG PROJECT NO. 4373 PC-04-101268

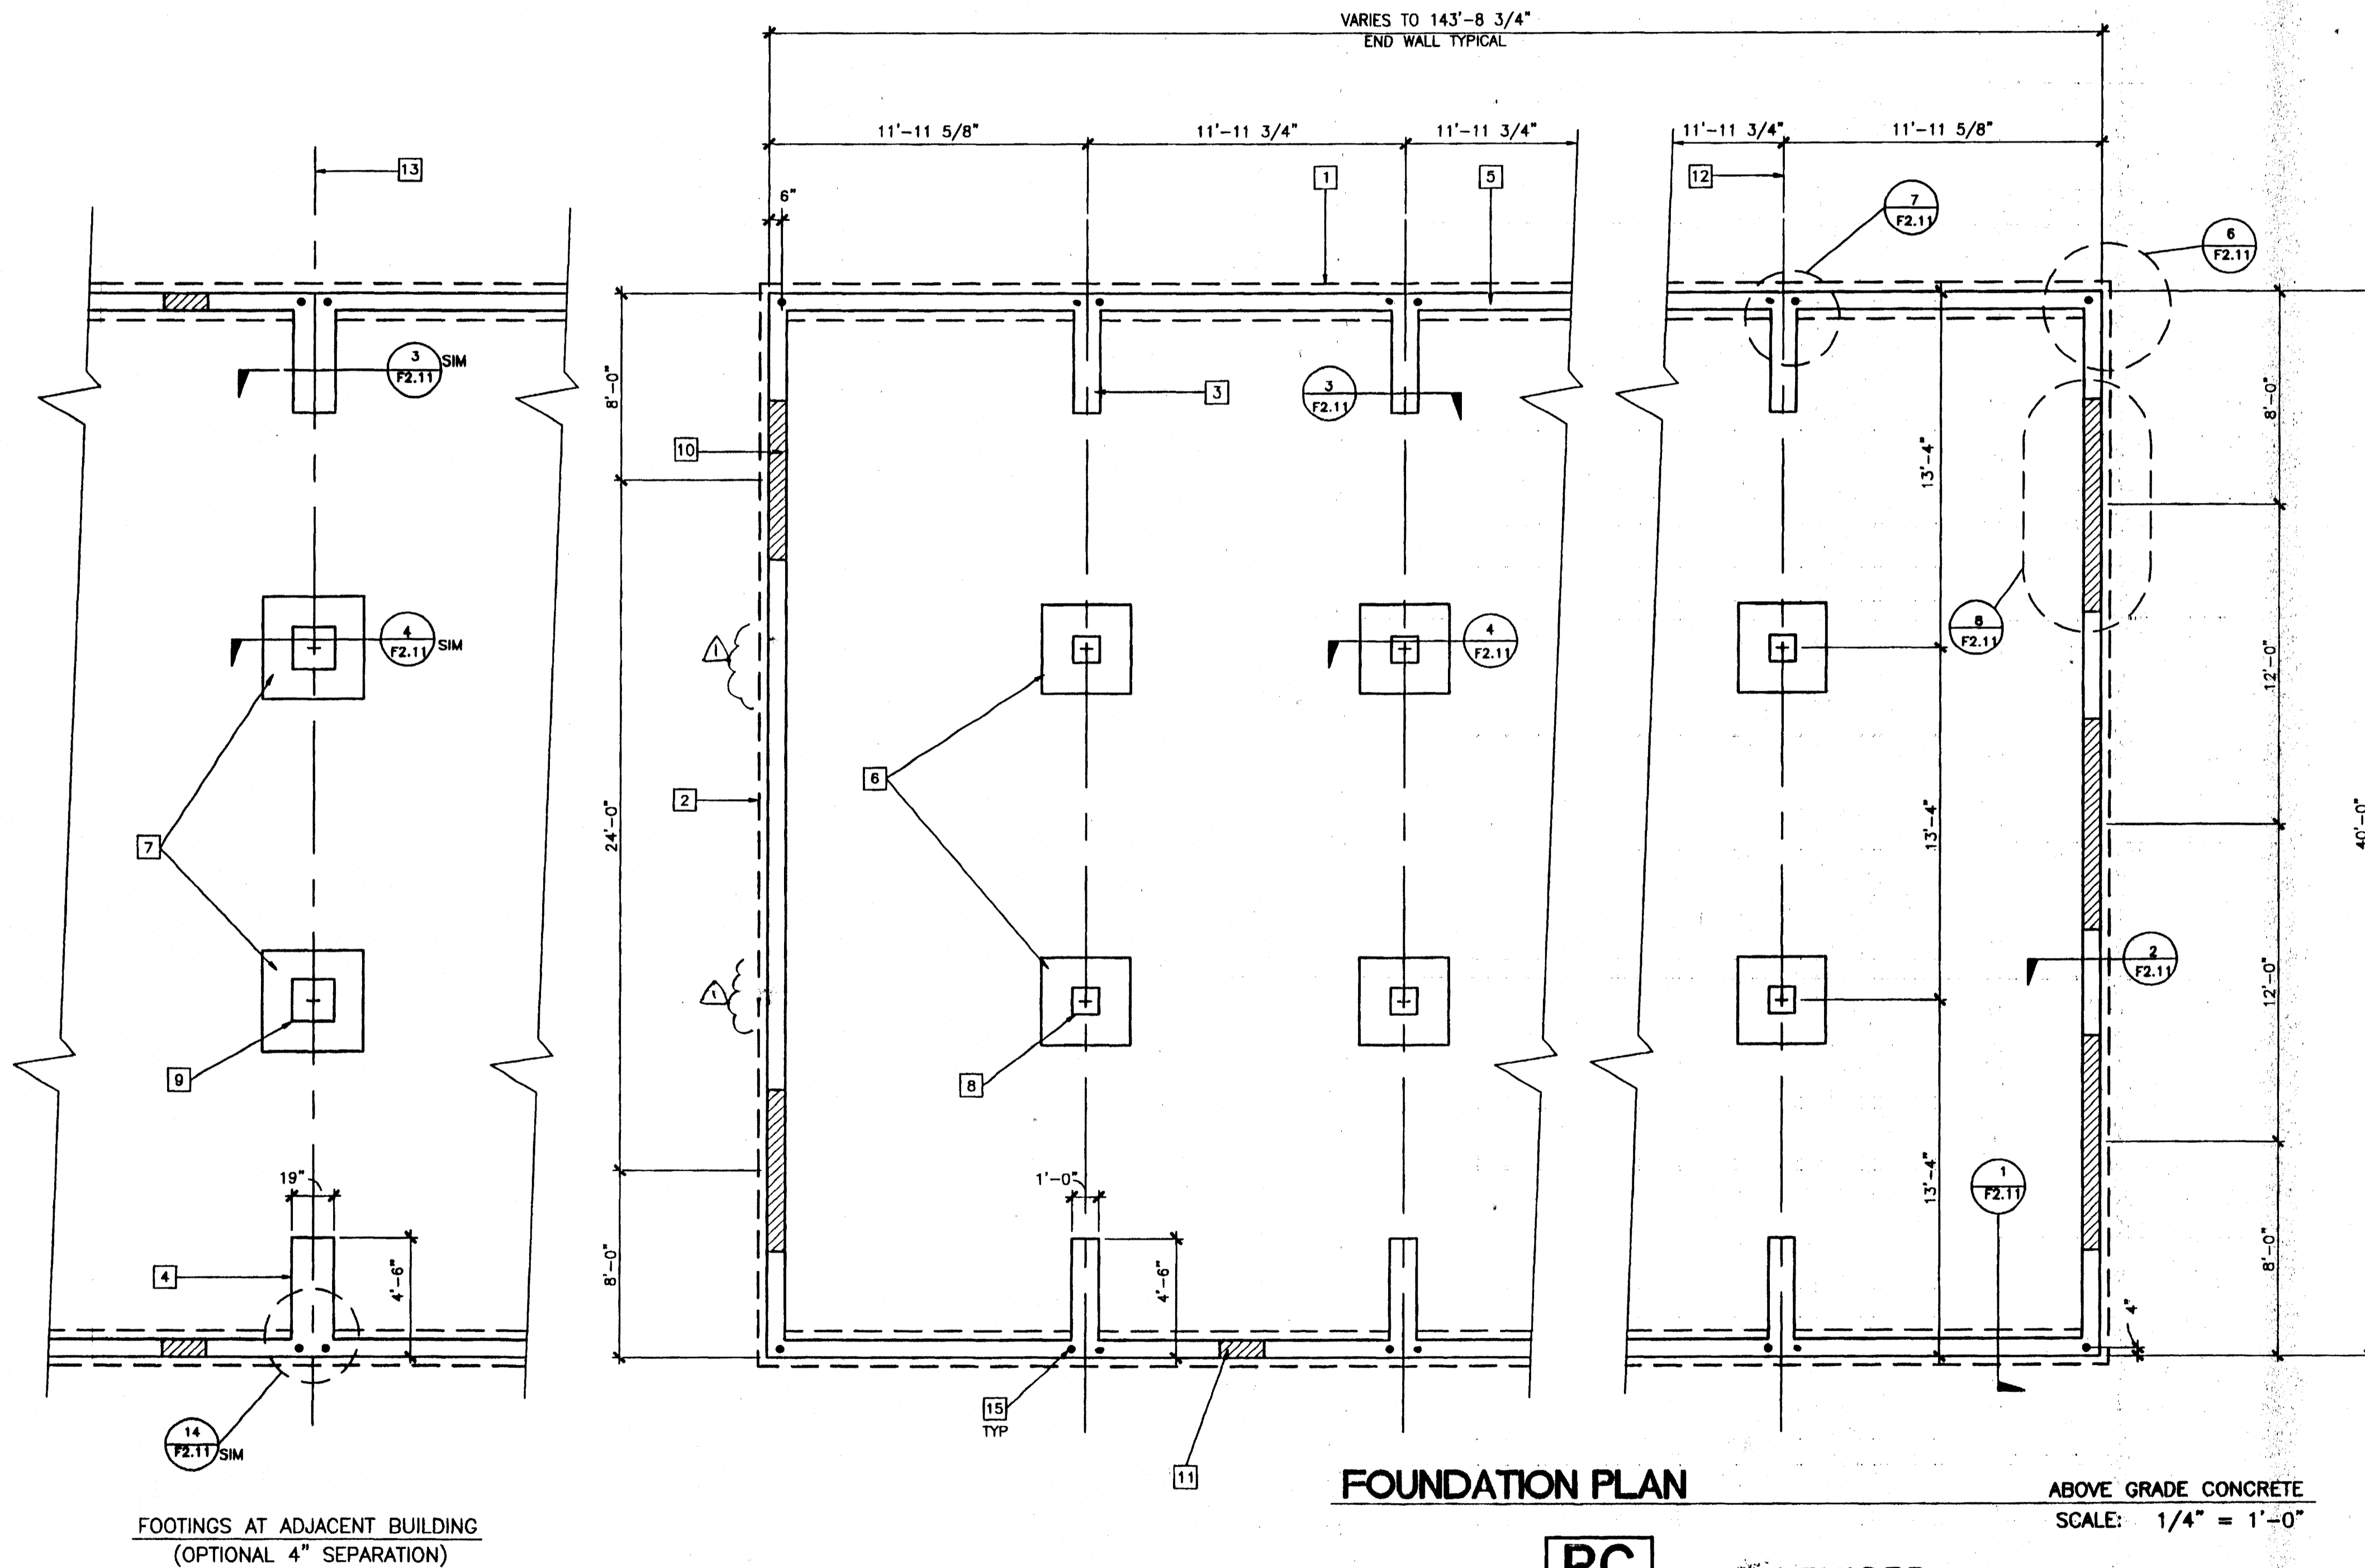

FOUNDATION PLAN

ABOVE GRADE CONCRETE
SCALE: 1/4" = 1'-0"


DESIGN FLOOR LIVE LOAD	50 PSF	50+20 PSF	100 PSF	125 PSF
SIDEWALL	12"	12"	SEE SHEET F2.02	SEE SHEET F2.02
ENDWALL	17"/18"	19"		
PAD	3'-4"/3'-5"	4'-0"/3'-10"		
PAD AT 4" SEPARATION	3'-9"/3'-8"	4'-3"/4'-1"		

BUILDING	(SF) AREA	(SF) VENTING REQUIRED	SIDE WALL VENTING	SIDE WALL VENT AREA	END WALL VENTING	END WALL VENT AREA	TOTAL VENT SUPPLIED
24'x40'	960	6.4	(4) A	7.00	-	-	7.00
36'x40'	1440	9.6	(6) A	10.5	-	-	10.50
48'x40'	1920	12.8	(6) B	14.00	-	-	14.00
60'x40'	2400	16	(6) B	14.00	(2) C	2.33	16.33
72'x40'	2880	19.2	(6) B	14.00	(4) C (1) D	5.25	19.25
84'x40'	3360	22.4	(6) B	14.00	(7) C (1) D	8.75	22.75
96'x40'	3840	25.6	(6) B	14.00	(10) C	11.66	25.66
108'x40'	4320	28.8	(6) B	14.00	(13) C	15.16	29.16
120'x40'	4800	32	(6) B	14.00	(15) C (1) D	18.07	32.07
132'x40'	5280	35.2	(6) B	14.00	(18) C (1) D	21.57	35.57
144'x40'	5760	38.4	(6) B	14.00	(21) C	24.49	38.49

LEGEND	VENT A 6'x3.5" = 1.75 SF
	VENT B 8'x3.5" = 2.33 SF
	VENT C 4'x3.5" = 1.166 SF
	VENT D 2'x3.5" = 0.583 SF

- KEY NOTES**
- END WALL FOOTING - SEE FOOTING SCHEDULE
 - SIDE WALL FOOTING - SEE FOOTING SCHEDULE
 - INTERIOR RETURN FOOTING - SEE FOOTING SCHEDULE
 - MODLINE RETURN AT 4" SEPARATION - OPTIONAL
 - STEM WALL - 8" TYPICAL UON
 - MODLINE PAD
 - MODLINE PAD AT 4" SEPARATION - OPTIONAL
 - 12" DIA OR SQUARE PEDESTAL (TYPICAL AT MODLINE)
 - 19" DIA OR SQUARE PEDESTAL (TYPICAL AT MODLINE)
 - TYPICAL VENT
 - ADDITIONAL END WALL VENTS AS REQUIRED (48" MAXIMUM LENGTH) OR INCREASE VENT HEIGHT AS REQUIRED AT SIDEWALLS
 - MODLINE
 - 4" BUILDING SEPARATION AT ADJACENT BUILDINGS - OPTIONAL
 - NOT USED
 - ANCHOR BOLT LOCATION - (1) AT EACH CORNER OF BUILDING AND (2) AT EACH MODLINE LOCATION

- NOTES**
- SOIL TYPE AND FOUNDATION**
A. BEARING: SOIL BEARING VALUE OF 1000 PSF USED FOR DESIGN.
B. FOOTINGS: ALL FOOTINGS SHALL EXTEND 12 INCHES MINIMUM INTO NATIVE SOIL OR APPROVED ENGINEERED FILL.
 - CONCRETE**
ALL CONCRETE SHALL HAVE THE FOLLOWING MINIMUM STRENGTH AT 28 DAYS: FOOTINGS: $f'_c = 3000$ PSI (DESIGN BASED ON $f'_c = 2000$ PSI). CONCRETE SHALL CONFORM TO TITLE 24 SECTION 1905A.2.3 METHOD A OR B. METHOD A NON-DESIGNED MIX PER TABLE 19A-A-8 METHOD B PER SECTION 1905A.3.1. CONCRETE SUPPLIER SHALL PROVIDE CONCRETE MIX DESIGN AND A BREAK HISTORY OF 30 CONSECUTIVE BREAKS IDENTIFIED TO THAT MIX DESIGN. ALL CEMENT SHALL BE TYPE I OR TYPE II PER ASTM C-150, UNLESS NOTED OTHERWISE ON THE APPROVED PLANS, SPECIFICATIONS OR GEOTECHNICAL REPORT FOR DSA METHOD A. THE FOLLOWING PROPORTIONS ARE REQUIRED: MINIMUM 7:1 SACKS PER YARD. WATER CONTENT SHALL NOT EXCEED 6 GALLONS PER SACK. AGGREGATE SHALL BE 3/4" TO 1" MAXIMUM SIZE BUT NOT MORE THAN 3/4" OF MINIMUM CLEAR BAR SPACING. ANCHOR BOLTS, DOWELS, REINFORCING STEEL AND EMBEDDED ITEMS ARE TO BE SECURELY TIED IN PLACE BEFORE CONCRETE IS Poured.
 - REINFORCING STEEL GRADE 40.**
ALL REINFORCING STEEL SHALL BE BILLET STEEL PER ASTM A-615 WELDED REINFORCING STEEL SHALL CONFORM TO ASTM A-708, OR SHALL BE ASTM A-615 PREHEATED AND WELDED PER AWS D1.4-79.
 - FOR FOOTINGS USING TRENCH FOR FORMING WIDTH SHALL BE INCREASED 2" EA. SIDE
 - THE ABOVE FOUNDATION PLAN HAS 1/4" ADDED AT EACH MOD LINE AND 1/8" AT EACH SIDE WALL AND DOES NOT MATCH THE FLOOR PLAN. THIS IS REQUIRED FOR GROWTH THAT IS EXPERIENCED WHEN SETTING MULTIPLE MODULE BUILDINGS.
 - MAX VENT LENGTH AT SIDE WALLS IS 8'-0"
MAX VENT LENGTH AT END WALLS IS 4'-0"
MIN DISTANCE FROM VENT TO EDGE OF MODULE IS 2'-0"
MIN DISTANCE BETWEEN VENTS IS 2'-0"

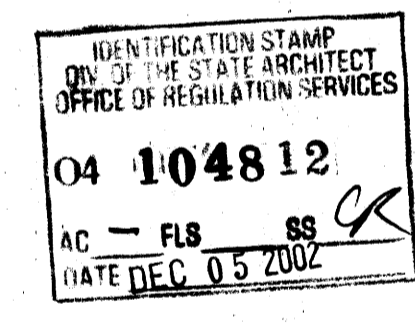

REVISIONS

10/16/02	MODTECH FIX	
10/16/02	ADD DELETE VENT NOTE	FYM

Electrical Engineer's Seal
Mechanical Engineer's Seal
Structural Engineer's Seal
Architect's Seal

PC
CBC 1998

REVISIONS:
OCT 25 2001
OCT 19 2000

IDENTIFICATION STAMP
DIV. OF THE STATE ARCHITECT
OFFICE OF REGULATION SERVICES
PC-04
101268
AC - FLS - SB - 10
DATE SEP 07 1997

MODTECH INC.
2830 BARRETT AVENUE
PERRIS, CALIF. 92572
PH (909) 943-4014
FAX (909) 940-0427

REVISOR: AUG 31 2000

PROJECT NUMBER: 4373
COLTON U.S.D.


© MODTECH, INC. 2002

DRAWN BY: KK
DATE: 11/19/02
CHECKED BY: STKP-67
DATE: 4012-124

MODTECH Index No.

FOUNDATION PLAN AGC - 50, 50+20 PSF **F2.01**

FILE PATH: 2440-F2.01.DWG PROJECT NO. 4373 PC-04-101268

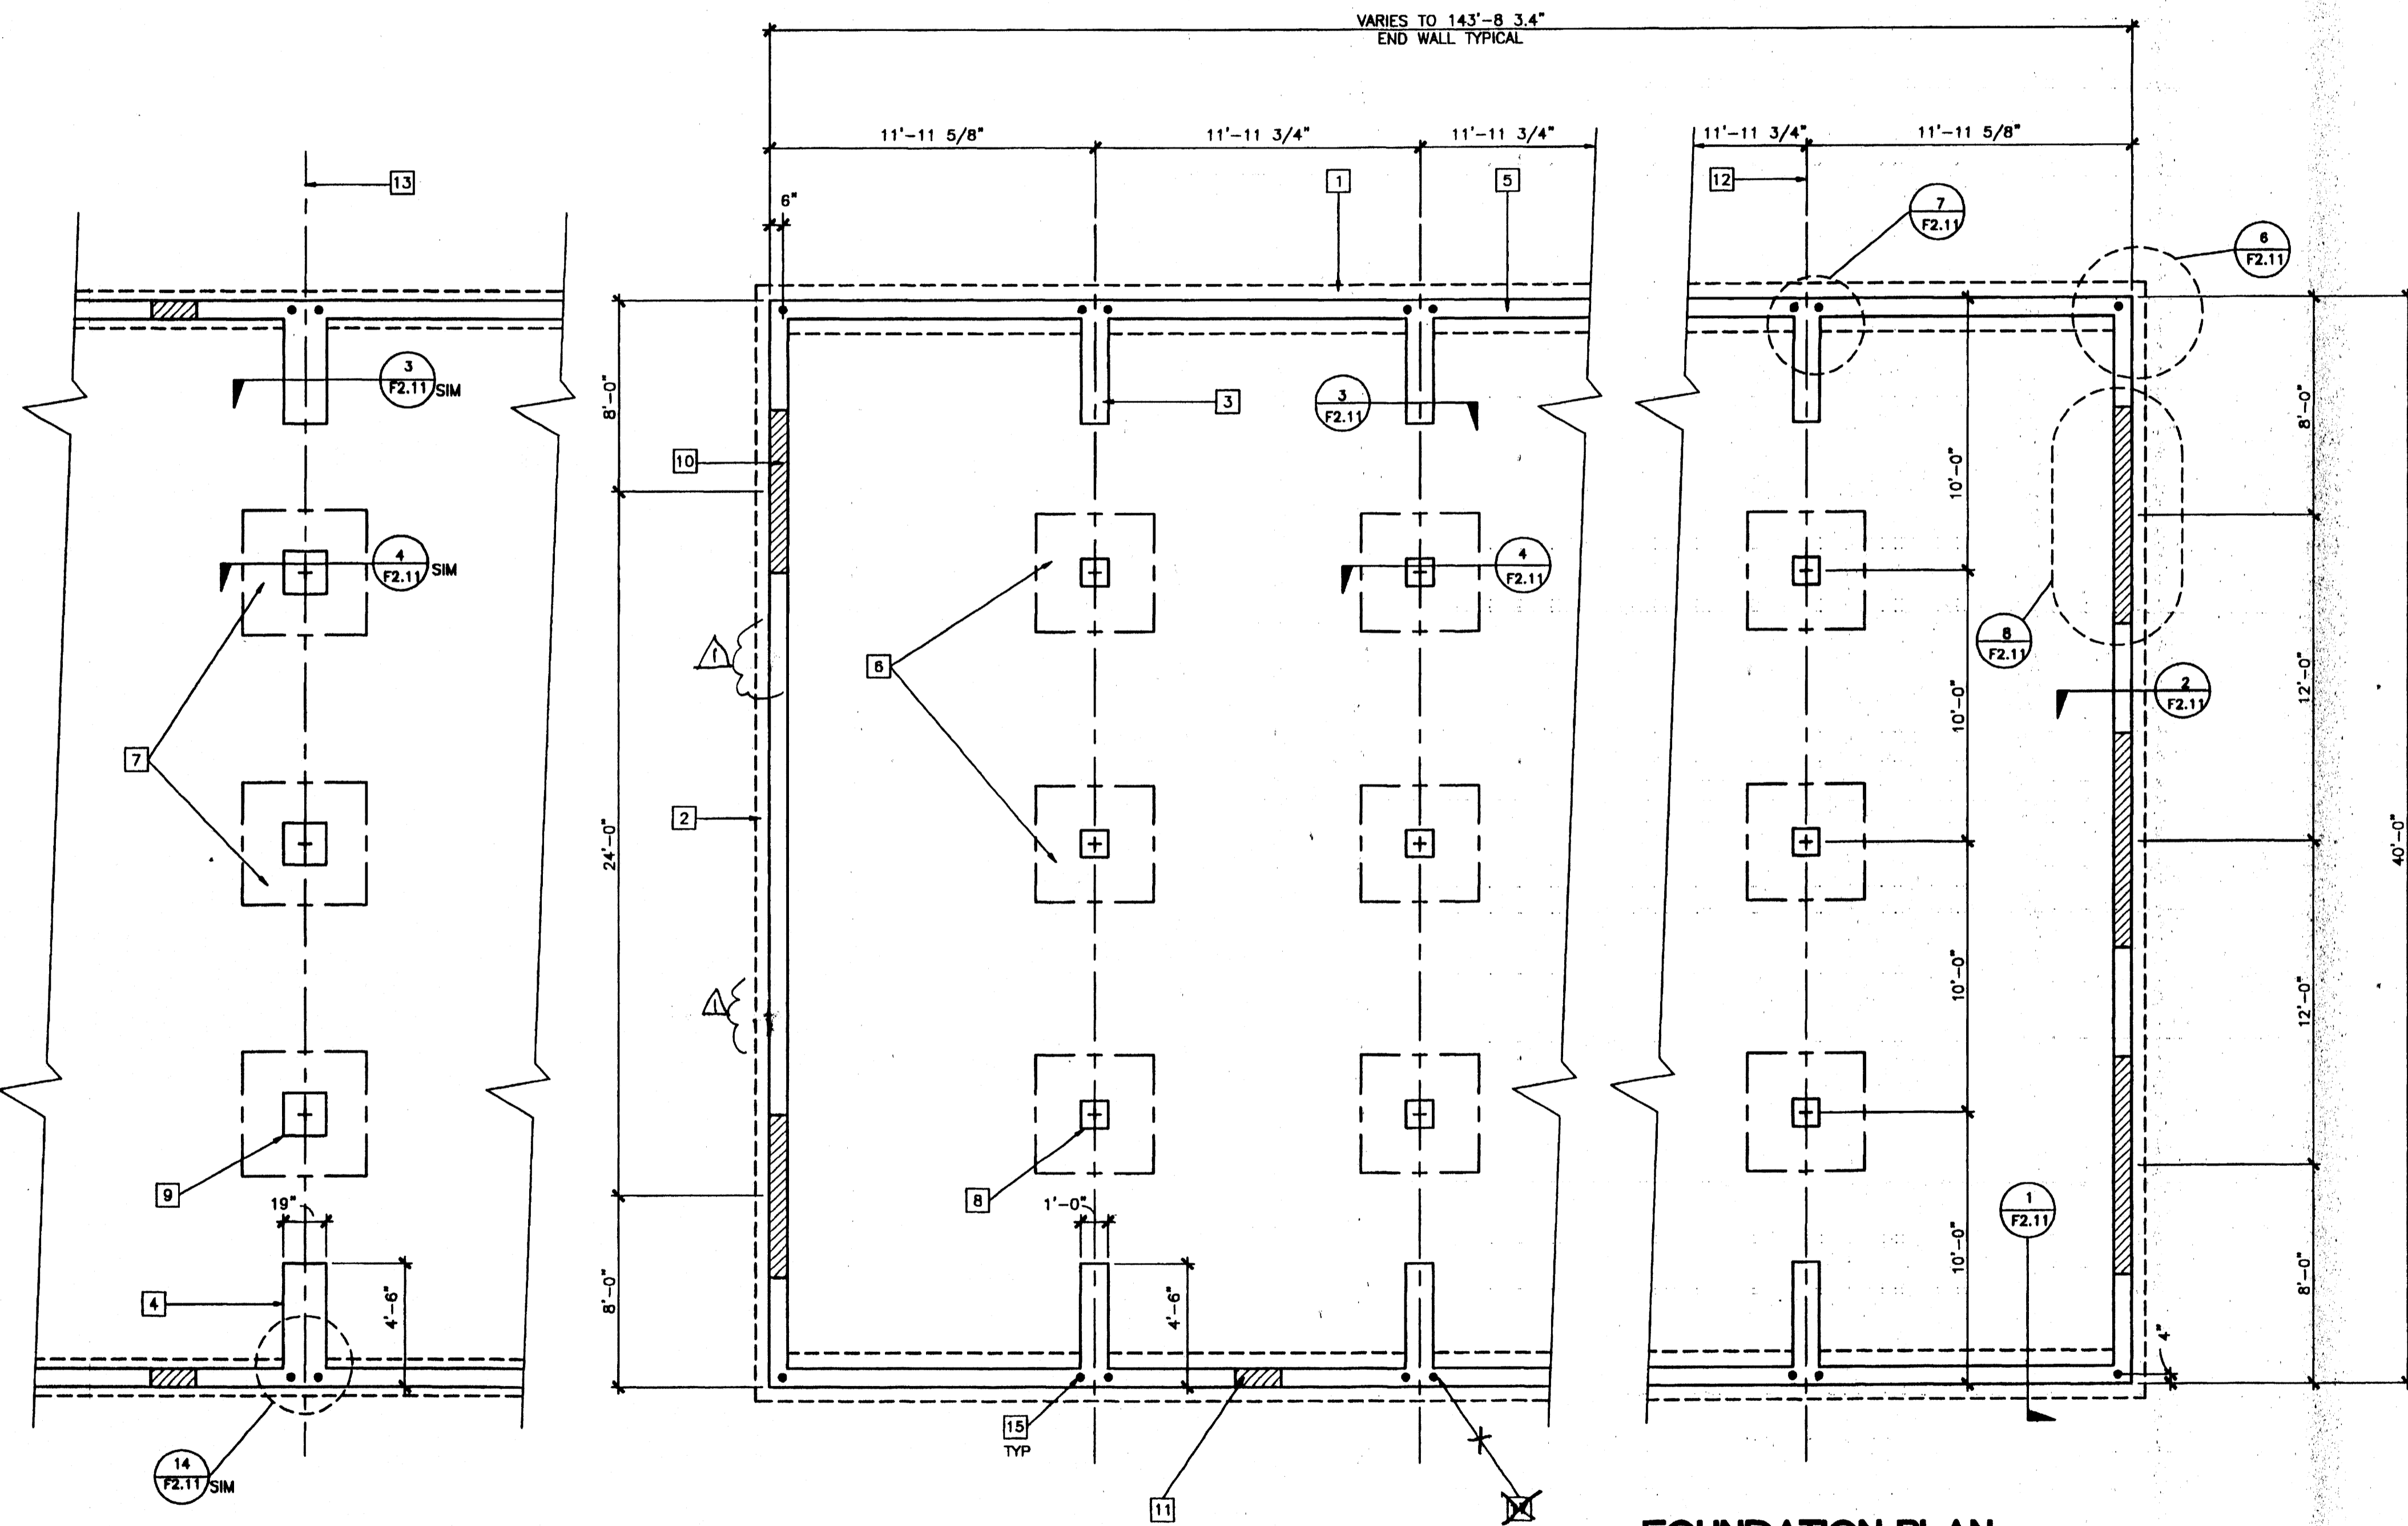

FOOTINGS AT ADJACENT BUILDING
(OPTIONAL 4" SEPARATION)

FOUNDATION PLAN

ABOVE GRADE CONCRETE
SCALE: 1/4" = 1'-0"

FOOTING SCHEDULE

DESIGN FLOOR LIVE LOAD	50 PSF	50+20 PSF	100 PSF	125 PSF
SIDEWALL	SEE SHEET F2.01	SEE SHEET F2.01	12"/14"	14"/15"
ENDWALL			20"/21"	21"/23"
PAD			4'-0"/4'-4"	4'-4"/4'-9"
PAD AT 4" SEPARATION			4'-3"/4'-7"	4'-7"/4'-11"

* = VALUE FOR CONCRETE FLOOR

VENTING SCHEDULE

BUILDING	(SF) VENTING AREA	(SF) VENTING REQUIRED	SIDE WALL VENTING	SIDE WALL VENT AREA	END WALL VENTING	END WALL VENT AREA	TOTAL VENT SUPPLIED
24'x40'	960	6.4	(4) A	7.0	-	-	7.0
36'x40'	1440	9.6	(6) A	10.5	-	-	10.5
48'x40'	1920	12.8	(6) B	14	-	-	14
60'x40'	2400	16	(6) B	14	(2) C	2.33	16.33
72'x40'	2880	19.2	(6) B	14	(4) C (1) D	2.25	19.25
84'x40'	3360	22.4	(6) B	14	(7) C (1) D	8.75	22.75
96'x40'	3840	25.6	(6) B	14	(10) C	11.66	25.66
108'x40'	4320	28.8	(6) B	14	(13) C	15.16	29.16
120'x40'	4800	32	(6) B	14	(15) C (1) D	18.07	32.07
132'x40'	5280	35.2	(6) B	14	(18) C (1) D	21.57	33.57
144'x40'	5760	38.4	(6) B	14	(21) C	24.49	38.49

LEGEND

VENT A	6'x3.5" = 1.75 SF
VENT B	8'x3.5" = 2.33 SF
VENT C	4'x3.5" = 1.166 SF
VENT D	2'x3.5" = 0.583 SF

KEY NOTES

- 1 21" END WALL FOOTING
- 2 SIDE WALL FOOTING - SEE FOOTING SCHEDULE
- 3 INTERIOR RETURN FOOTING - SEE FOOTING SCHEDULE
- 4 MODLINE RETURN AT 4" SEPARATION - OPTIONAL
- 5 STEM WALL - 8" TYPICAL UON
- 6 MODLINE PAD
- 7 MODLINE PAD AT 4" SEPARATION - OPTIONAL
- 8 12" DIA OR SQUARE PEDESTAL (TYPICAL AT MODLINE)
- 9 19" DIA OR SQUARE PEDESTAL (TYPICAL AT MODLINE)
- 10 TYPICAL VENT
- 11 ADDITIONAL END WALL VENTS AS REQUIRED (48" MAXIMUM LENGTH) OR INCREASE VENT HEIGHT AS REQUIRED AT SIDEWALLS
- 12 MODLINE
- 13 4" BUILDING SEPARATION - ADJACENT BUILDINGS - OPTIONAL
- 14 NOT USED
- 15 ANCHOR BOLT LOCATION - (1) AT EACH CORNER OF BUILDING. (2) AT EACH MODLINE LOCATION.
- 16 NOT USED
- 17 SECOND ANCHOR BOLT AT MODLINE FOR 125 PSF FLOOR ONLY


NOTES

NOTES: DELETE ALL UNDER FLOOR VENTS WHEN SINGLE STORY BUILDING OR BOTTOM FLOOR OF TWO STORY BUILDING UTILIZES THE CONCRETE FLOOR OPTION.

1. SOIL TYPE AND FOUNDATION
 - A. BEARING: SOIL BEARING VALUE OF 1000 PSF USED FOR DESIGN.
 - B. FOOTINGS: ALL FOOTINGS SHALL EXTEND 12 INCHES MINIMUM INTO NATIVE SOIL OR APPROVED ENGINEERED FILL.
2. CONCRETE

ALL CONCRETE SHALL HAVE THE FOLLOWING MINIMUM STRENGTH AT 28 DAYS: FOOTINGS: $f'_c = 3000$ PSI (DESIGN BASED ON $f'_c = 2000$ PSI, CONCRETE SHALL CONFORM TO TITLE 24 SECTION 19054.2.3 METHOD A OR B. METHOD A NON-DESIGNED MIX PER TABLE 19A-A-8 METHOD B PER SECTION 19054.3.1. CONCRETE SUPPLIER SHALL PROVIDE CONCRETE MIX DESIGN AND A BREAK HISTORY OF 30 CONSECUTIVE BREAKS IDENTIFIED TO THAT MIX DESIGN. ALL CEMENT SHALL BE TYPE I OR TYPE II PER ASTM C-150, UNLESS NOTED OTHERWISE ON THE APPROVED PLANS. SPECIFICATIONS OR GEOTECHNICAL REPORT FOR DSA METHOD A. THE FOLLOWING PROPORTIONS ARE REQUIRED: MINIMUM 7.1 SACKS PER YARD, WATER CONTENT SHALL NOT EXCEED 6 GALLONS PER SACK. AGGREGATE SHALL BE 3/4" TO 1" MAXIMUM SIZE BUT NOT MORE THAN 3/4" OF MINIMUM CLEAR BAR SPACING. ANCHOR BOLTS, DOWELS, REINFORCING STEEL AND EMBEDDED ITEMS ARE TO BE SECURELY TIED IN PLACE BEFORE CONCRETE IS POURED.
3. REINFORCING STEEL GRADE 40.

ALL REINFORCING STEEL SHALL BE BILLET STEEL PER ASTM A-615 WELDED REINFORCING STEEL SHALL CONFORM TO ASTM A-706, OR SHALL BE ASTM A-615 PREHEATED AND WELDED PER AWS D1.4-79.
4. FOR FOOTINGS USING TRENCH FOR FORMING WIDTH SHALL BE INCREASED 2" EA. SIDE
5. THE ABOVE FOUNDATION PLAN HAS 1/4" ADDED AT EACH MOD LINE AND 1/8" AT EACH SIDE WALL AND DOES NOT MATCH THE FLOOR PLAN. THIS IS REQUIRED FOR GROWTH THAT IS EXPERIENCED WHEN SETTING MULTIPLE MODULE BUILDINGS.
6. MAX VENT LENGTH AT SIDE WALLS IS 8'-0"
MAX VENT LENGTH AT END WALLS IS 4'-0"
MIN DISTANCE FROM VENT TO EDGE OF MODULE IS 2'-0"
MIN DISTANCE BETWEEN VENTS IS 2'-0"

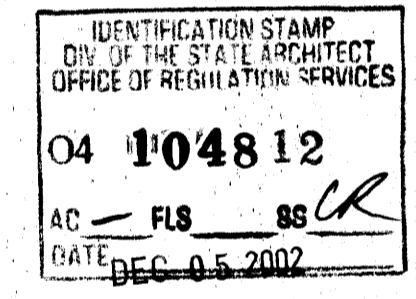

PC
CBC 1998

REVISED OCT 25 2001
REVISED OCT 19 2000

REVISIONS

10/18/02	MODTECH FIX	
10/25/01	ADD DELETE VENT NOTE	


Electrical Engineer's Seal

Mechanical Engineer's Seal

Structural Engineer's Seal

Architect's Seal

IDENTIFICATION STAMP
DIV. OF THE STATE ARCHITECT
OFFICE OF REGULATORY SERVICES
PC-04
101268
DATE 08/07/2000

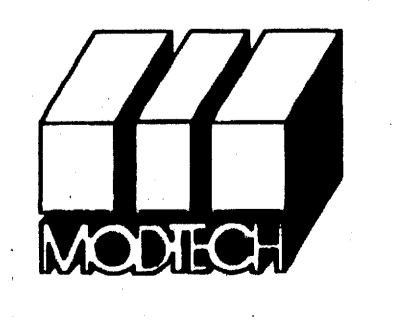

MODTECH INC.
2830 BARRETT AVENUE
PERRIS, CALIF. 92572
PH (909) 943-4014
FAX (909) 940-0427

PROJECT NUMBER: 4373
COLTON U.S.D.


© MODTECH, INC. 2002

DRAWN BY: KK
DATE: 11/19/02
CHECKED BY: STKP-67
DATE: 4/12-124


FOUNDATION DETAILS AGC - 100, 125 PSF

F2.02


PROJECT NO. 4373
FILE PATH: 2440-F2.02.DWG

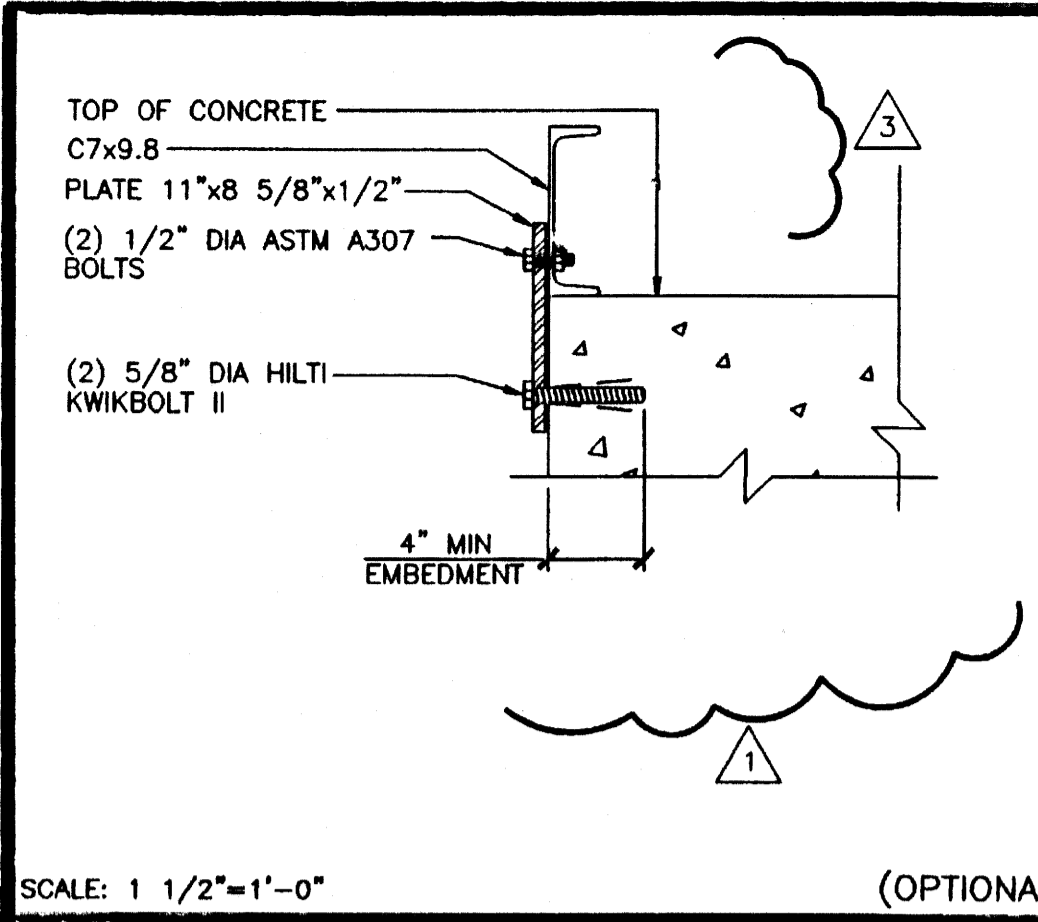


SCALE: 1 1/2"=1'-0" (OPTIONAL)

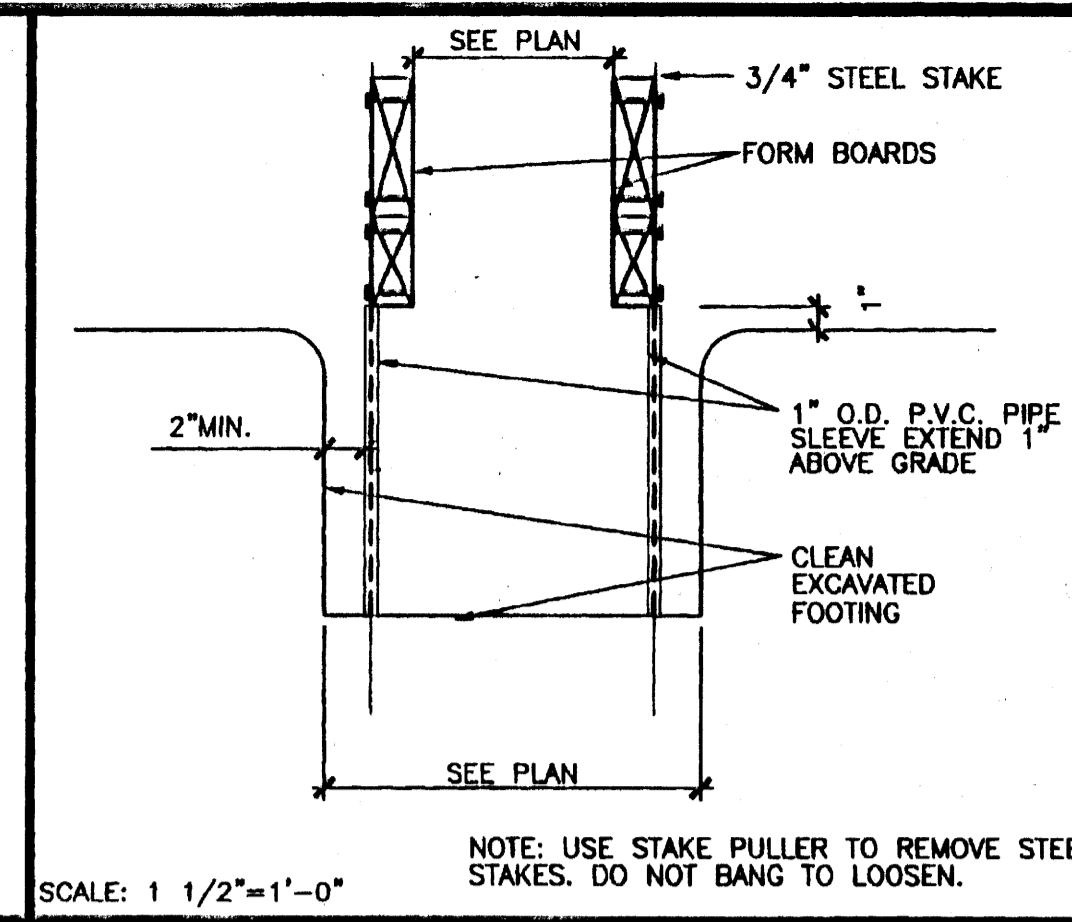


SCALE: 1 1/2"=1'-0" NOTE: USE STAKE PULLER TO REMOVE STEEL STAKES. DO NOT BANG TO LOOSEN.

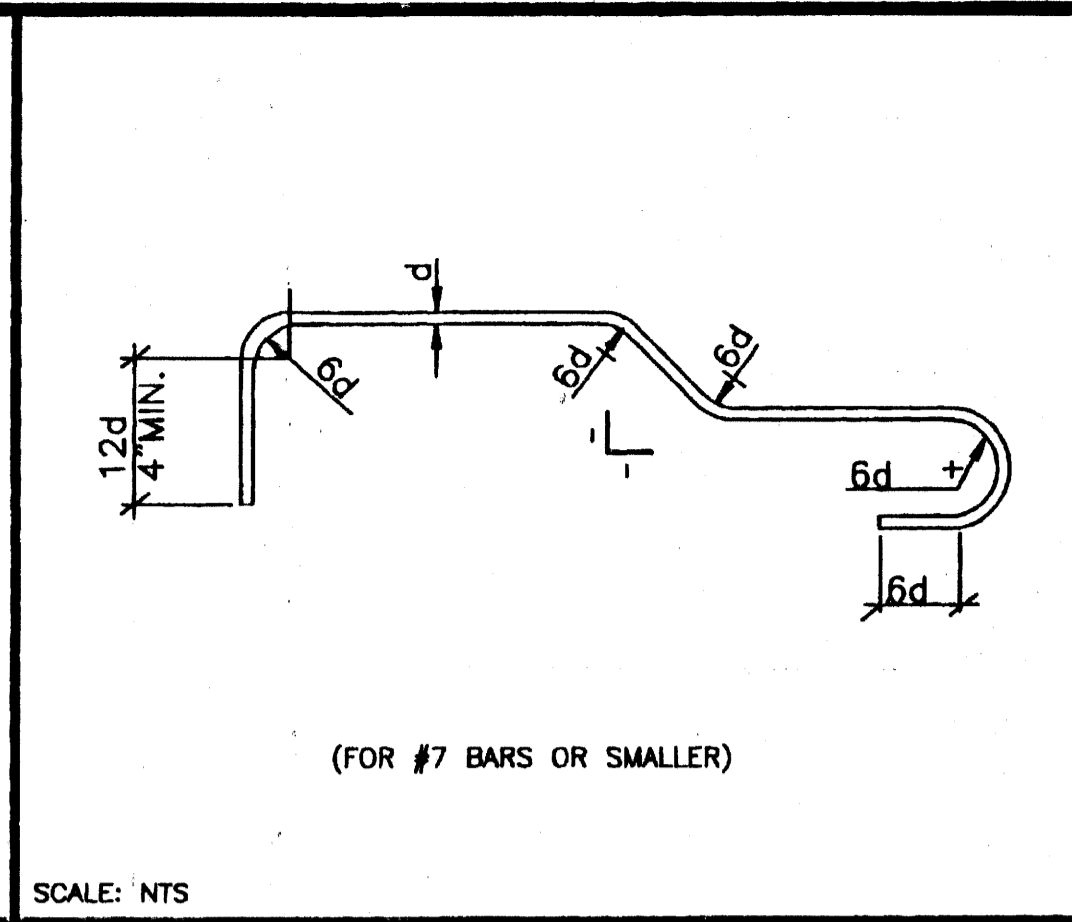

SCALE: NTS (FOR #7 BARS OR SMALLER)

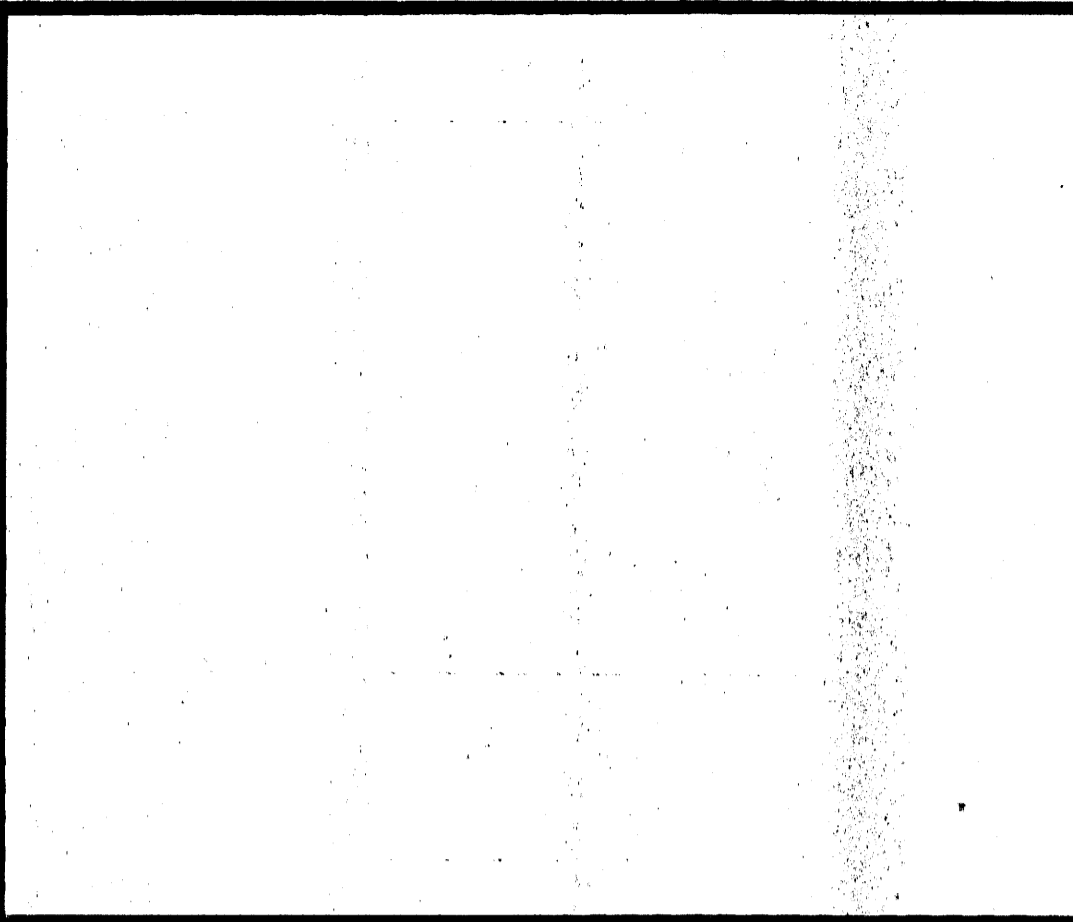


SCALE: 1 1/2"=1'-0"

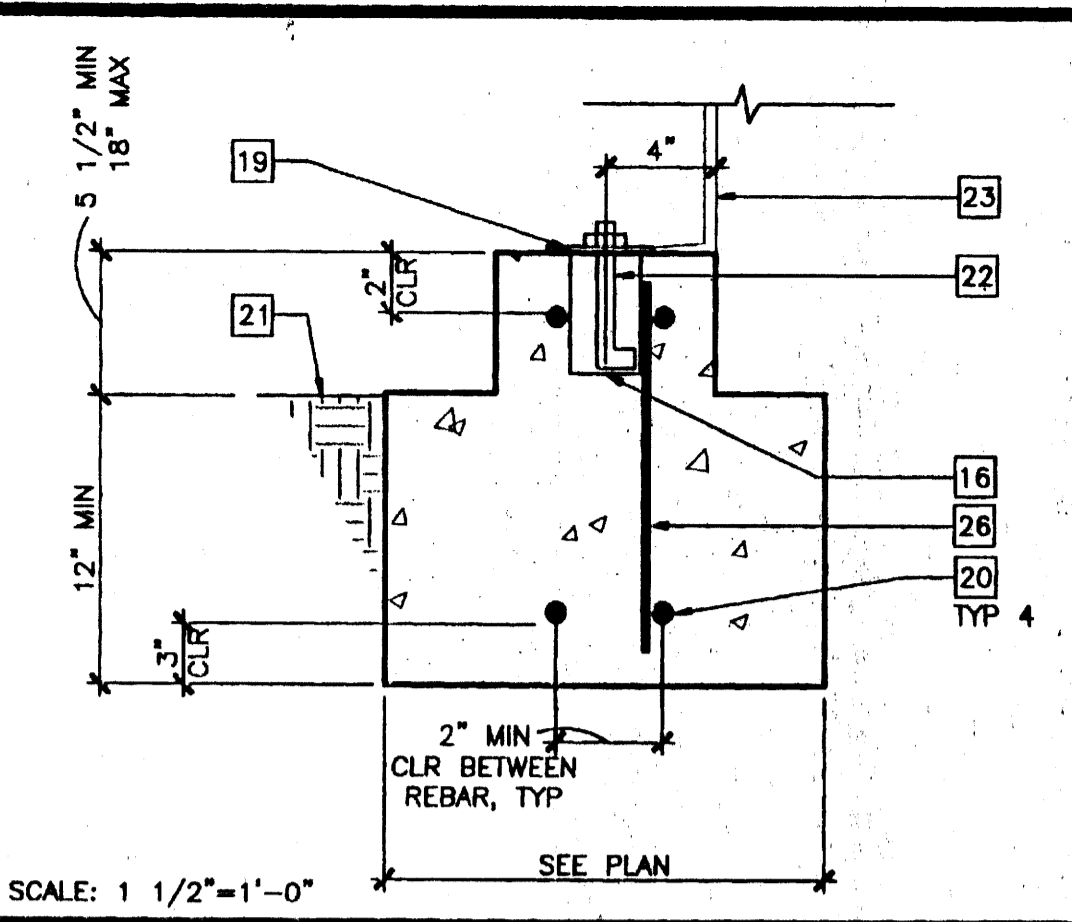


SCALE: 1 1/2"=1'-0"


- ### KEY NOTES
- END WALL FOOTING - SEE FOOTING SCHEDULE
 - SIDE WALL FOOTING - SEE FOOTING SCHEDULE
 - MODLINE RETURN
 - SLEEVE DIAMETER 2" LARGER THAN PIPE DIAMETER
 - STEM WALL
 - FOOTING: FOR PIPES IN THIS AREA LOWER FOOTING SO PIPES PASS THROUGH STEM WALL
 - PIPE THROUGH STEM WALL
 - MODLINE
 - CONCRETE PEDESTAL - 12" MINIMUM AT INTERIOR PAD, 19" MINIMUM AT 4" SEPARATION (OPTIONAL)
 - STARTER WALL AFTER SET. CLEAN TO REMOVE LAITANCE AND SCUM
 - CUT BACK SPALL
 - CONTINUOUS CLEAN-OUT. STAKES NOT PERMITTED WITHIN FOOTING AREA
 - MINIMUM FORMWORK (UNLESS FULLY FORMED)
 - 2x PLANKING
 - CONCRETE INTERIOR PAD FOOTING - SEE FOUNDATION PLAN FOR SIZES
 - 3" DIAx6" DEEP CANOUT IN FOUNDATION (BY CONCRETE SUBCONTRACTOR)
 - OPTION 1: 12 GA GALVANIZED EXPANDED DIAMOND MESH. IMBED 1 1/2" INTO WET CONCRETE AT 2 SIDES AND BOTTOM
OPTION 2: 3/16"x1 1/2"x1 1/2" GALVANIZED ANGLE FRAME WITH 12 GA GALVANIZED EXPANDED DIAMOND MESH WELDED TO END OF INTERIOR ANGLE LEG. ANCHOR WITH 3 FASTENERS AT BOTTOM INTO CONCRETE AND 3 FASTENERS AT TOP INTO FLOOR CHANNEL.
 - ANCHOR PLATE
 - #5 STEEL @ 2 AT TOP AND 8" OC
 - #5 STEEL REINFORCING BARS CONTINUOUS
 - FINISH GRADE LINE
 - 3/4" ANCHOR BOLT A307 WITH 5" EMBEDMENT OR 3/4" DIA THREADED ROD A36 WITH 5" EMBEDMENT
 - FLOOR HEADER
 - FLOOR BEAM
 - NEAT CUT TRENCH
 - #3 VERTICAL AT 24" OC FOR BUILDINGS 60'x40' AND GREATER ONLY
 - (4) #5xL VERTS
 - 4" BUILDING SEPARATION - ADJACENT BUILDINGS - OPTIONAL
 - BUILDING LINE
 - (4) #5'S EACH WAY AT BOTTOM

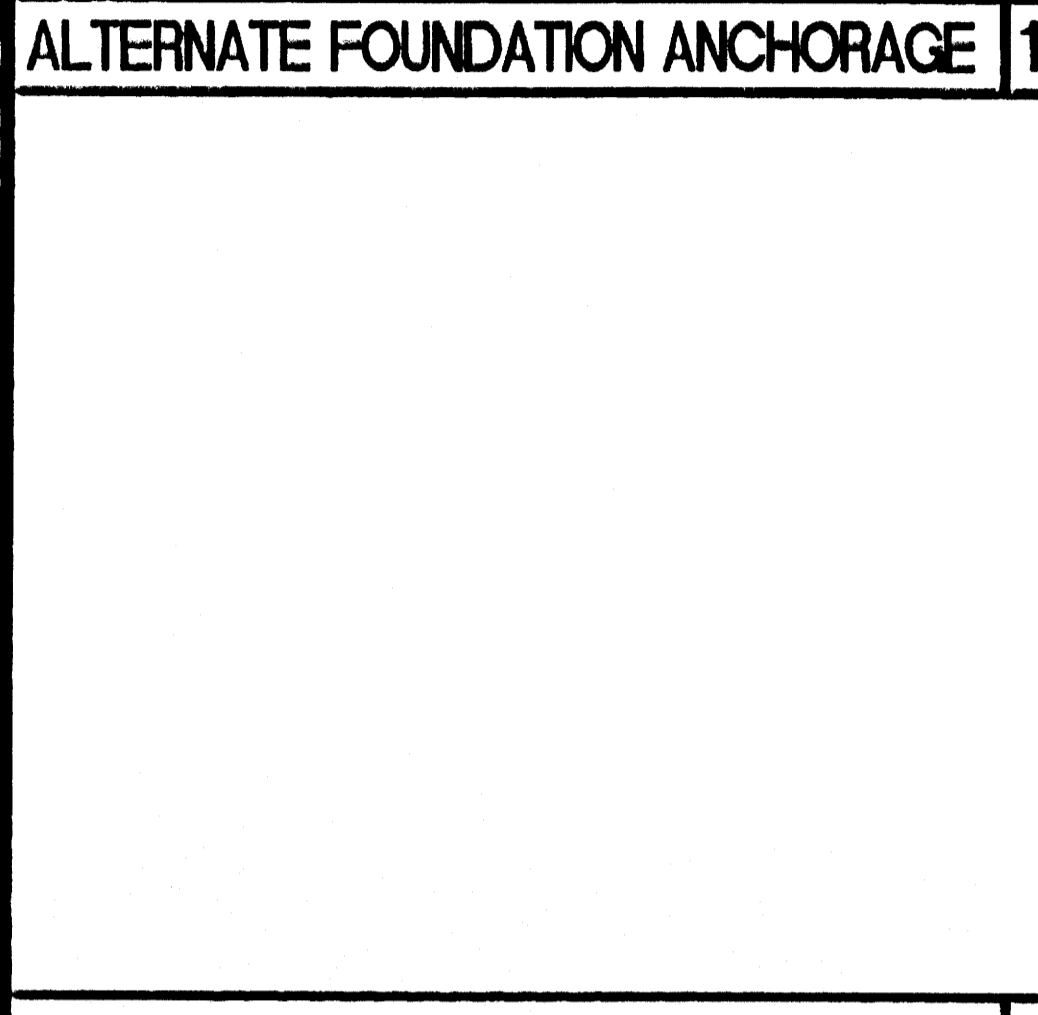


SCALE: NTS

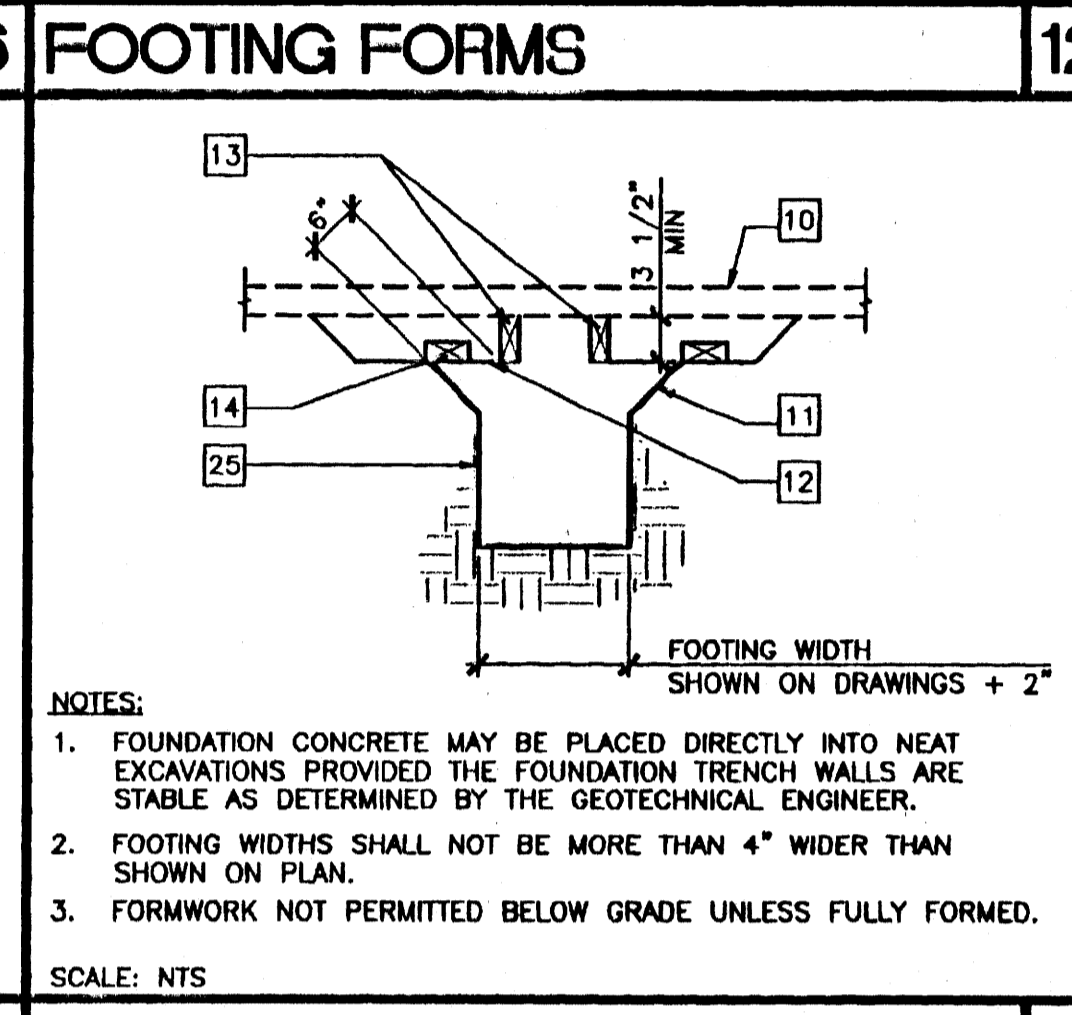


SCALE: NTS

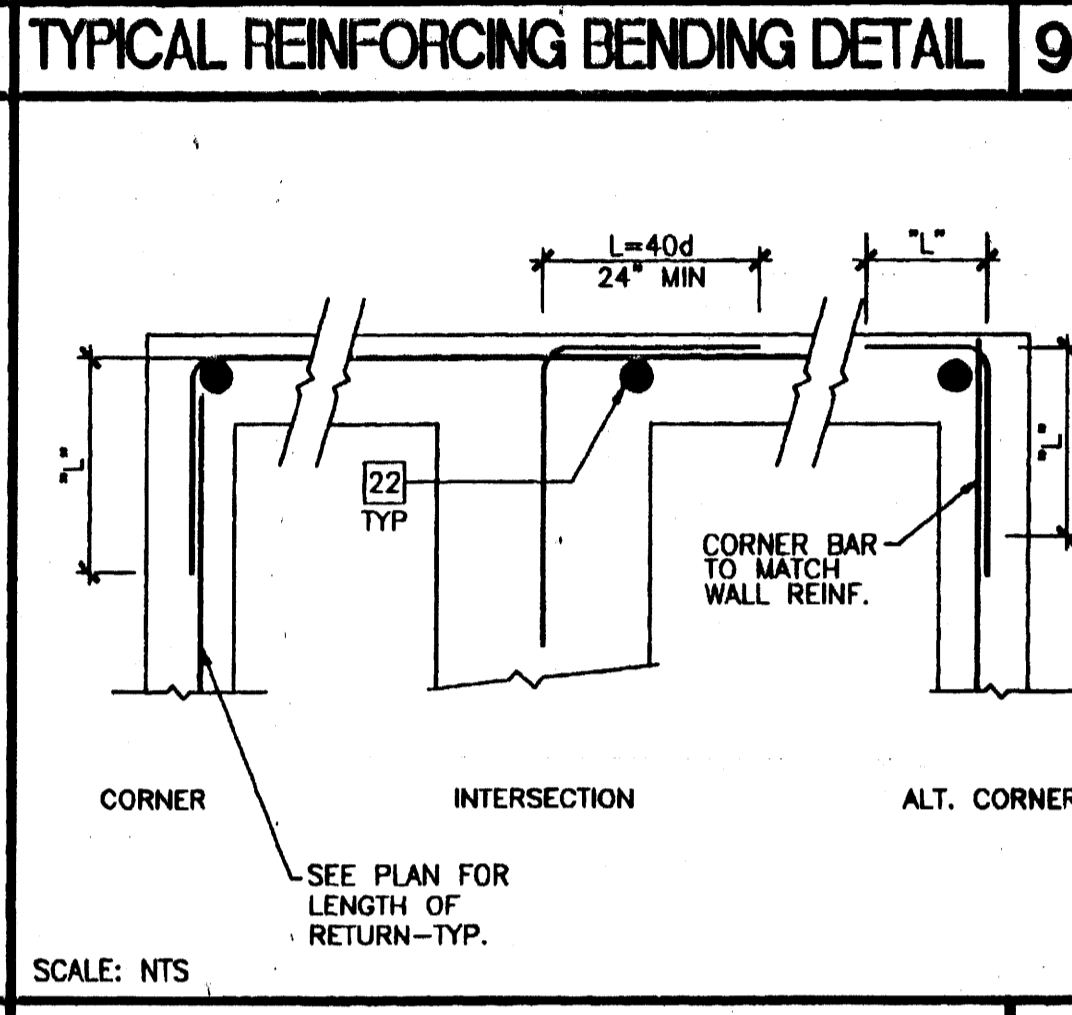


SCALE: 1 1/2"=1'-0"

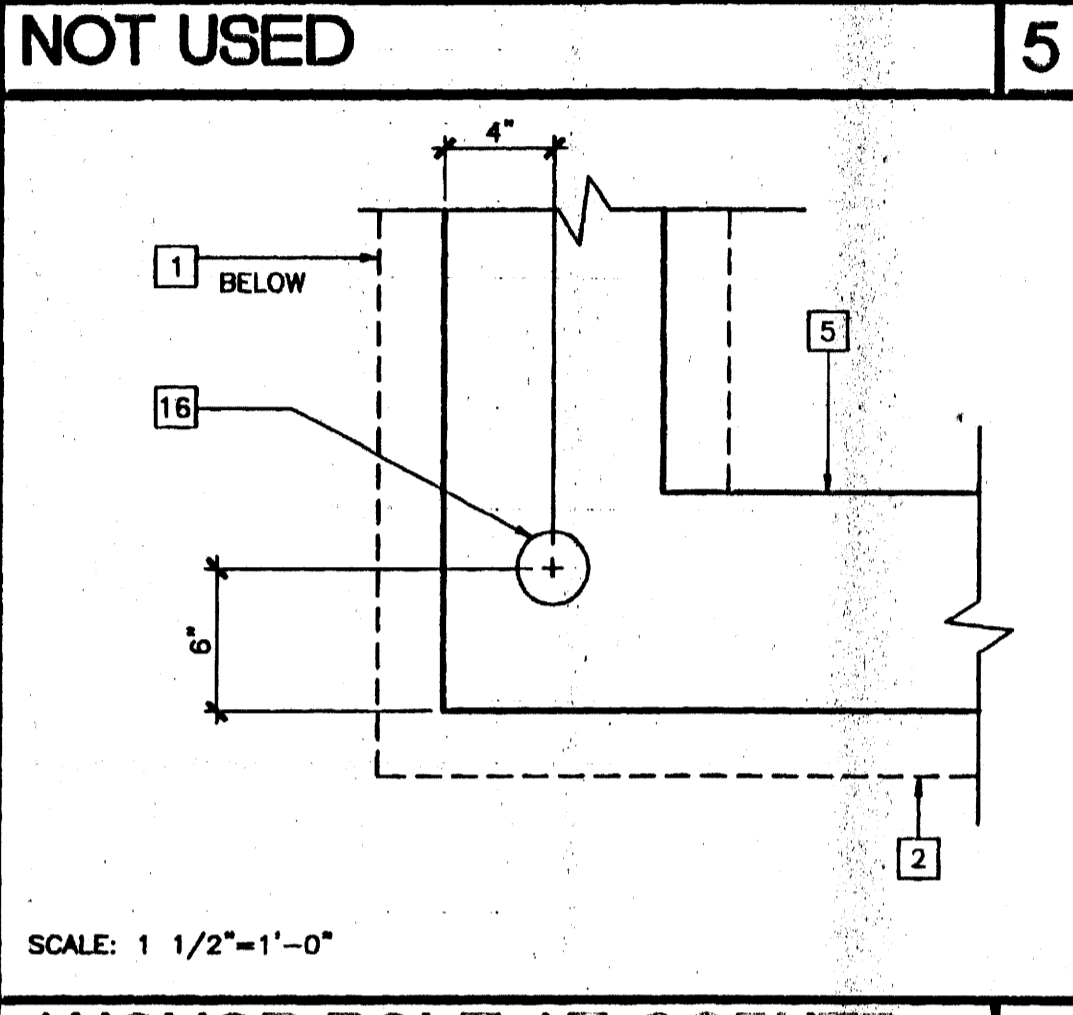


SCALE: 1 1/2"=1'-0"

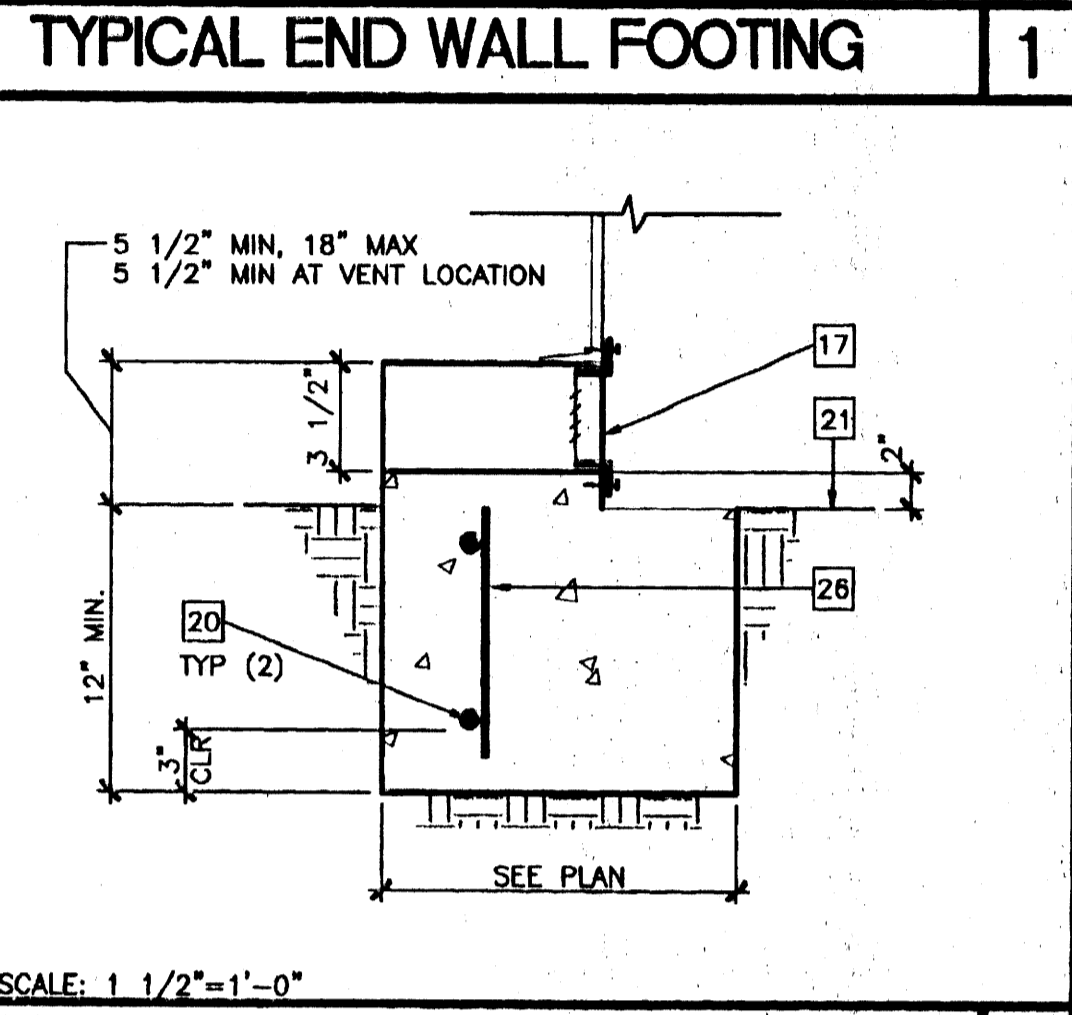


SCALE: 1 1/2"=1'-0"

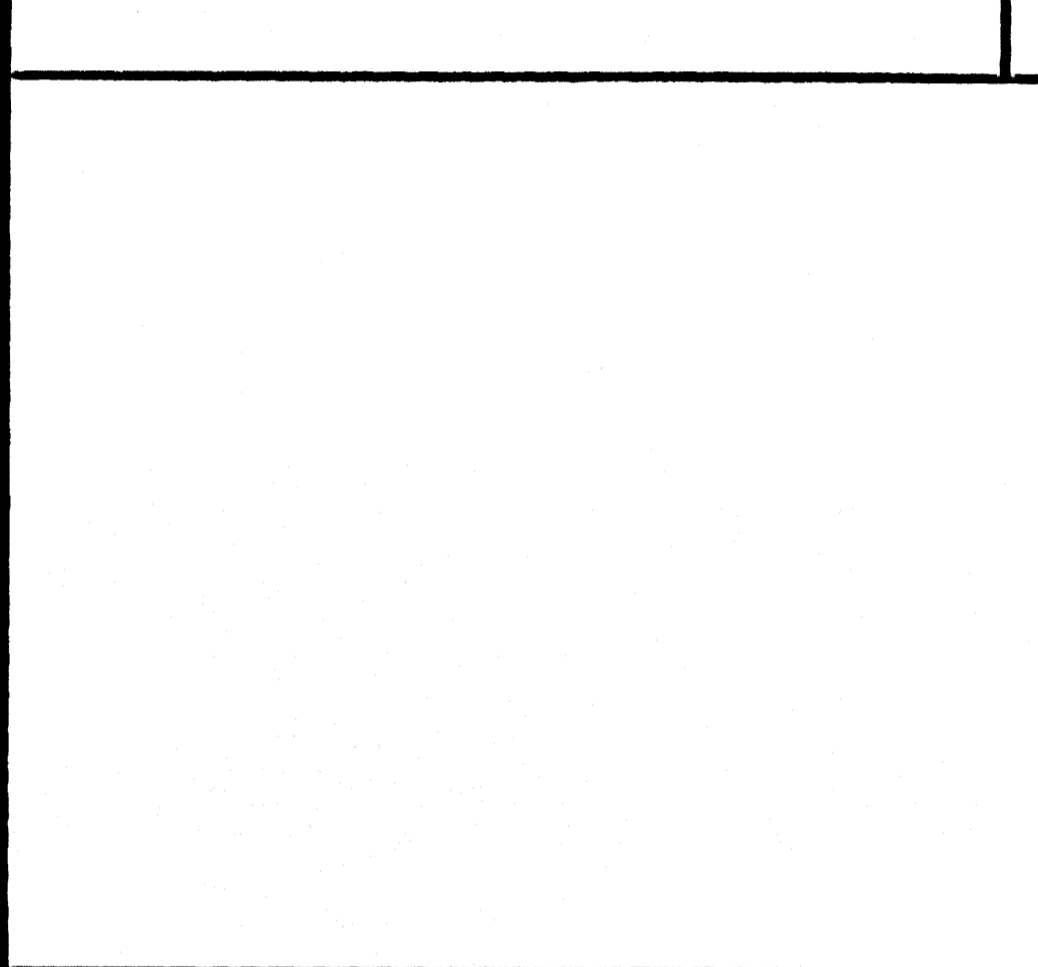


SCALE: NTS (OPTIONAL)

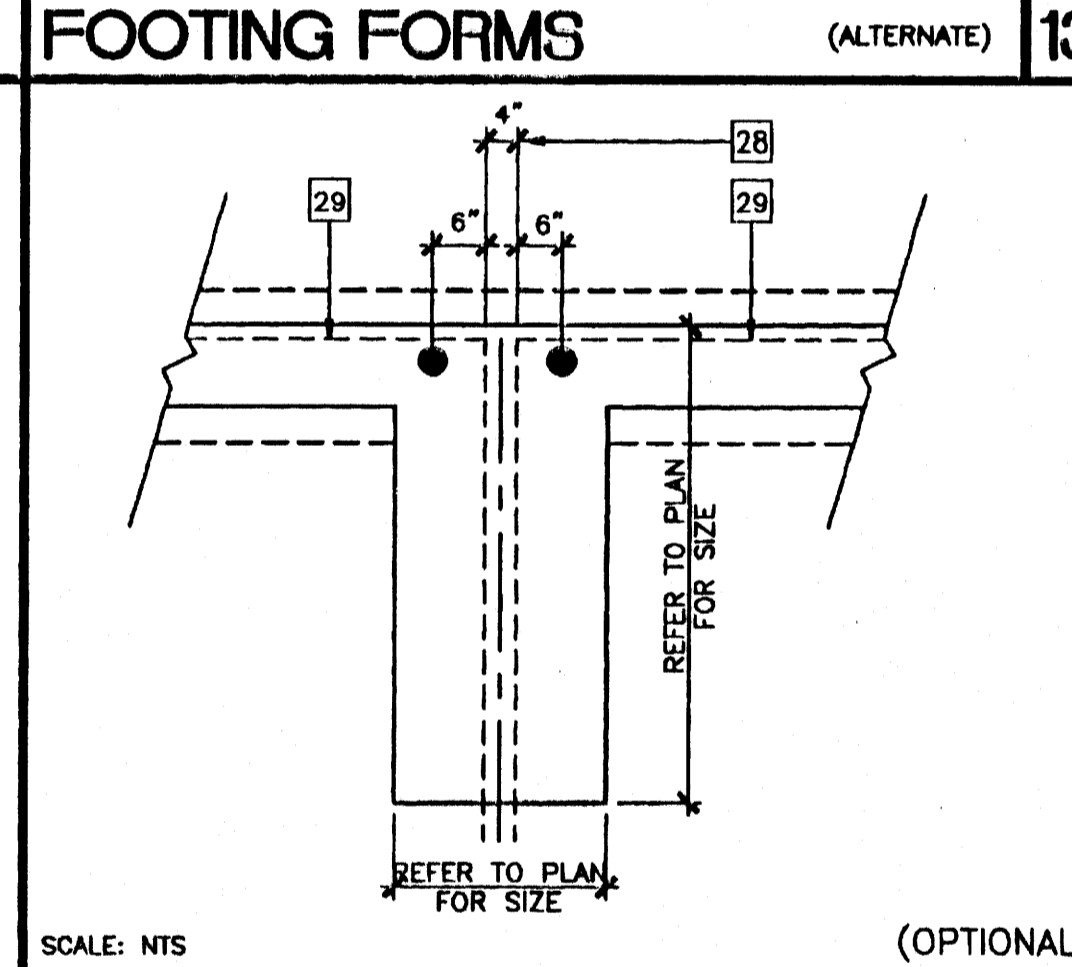


SCALE: NTS

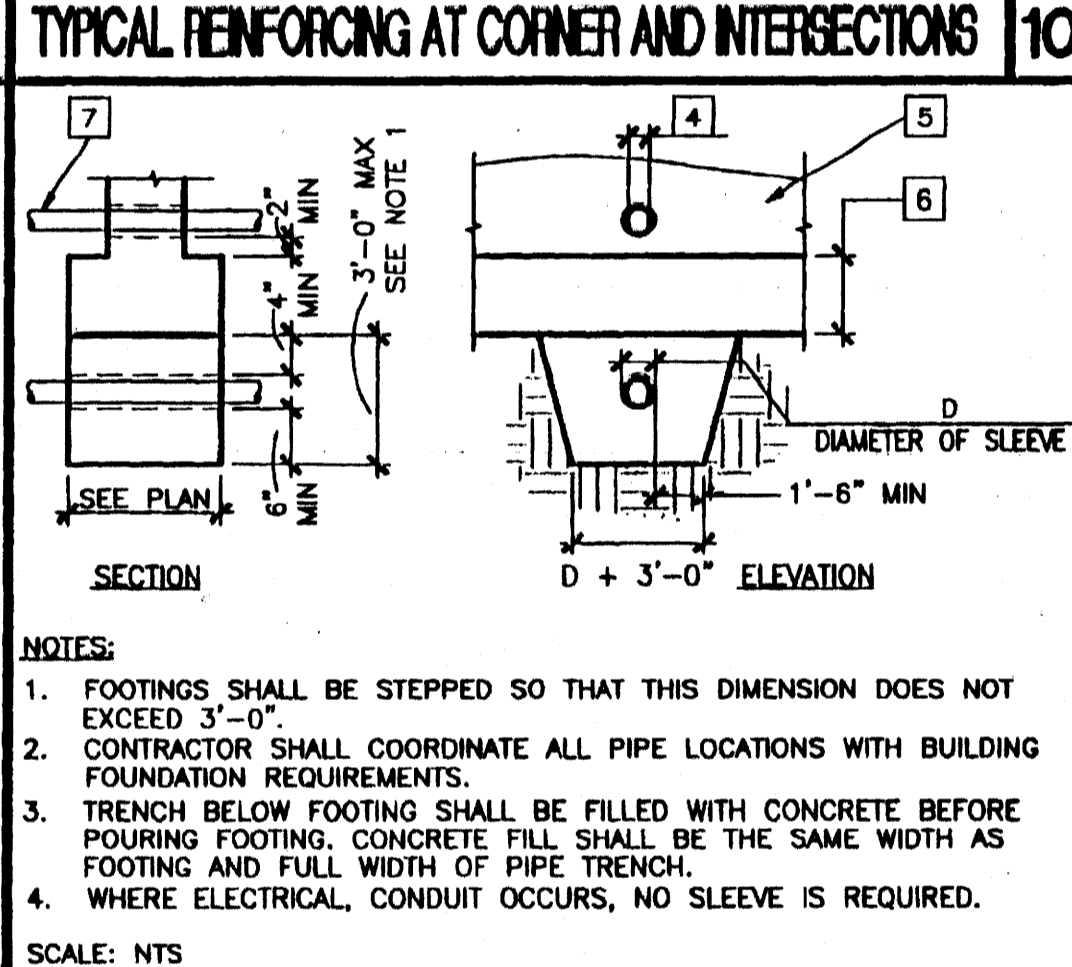


SCALE: 1 1/2"=1'-0"

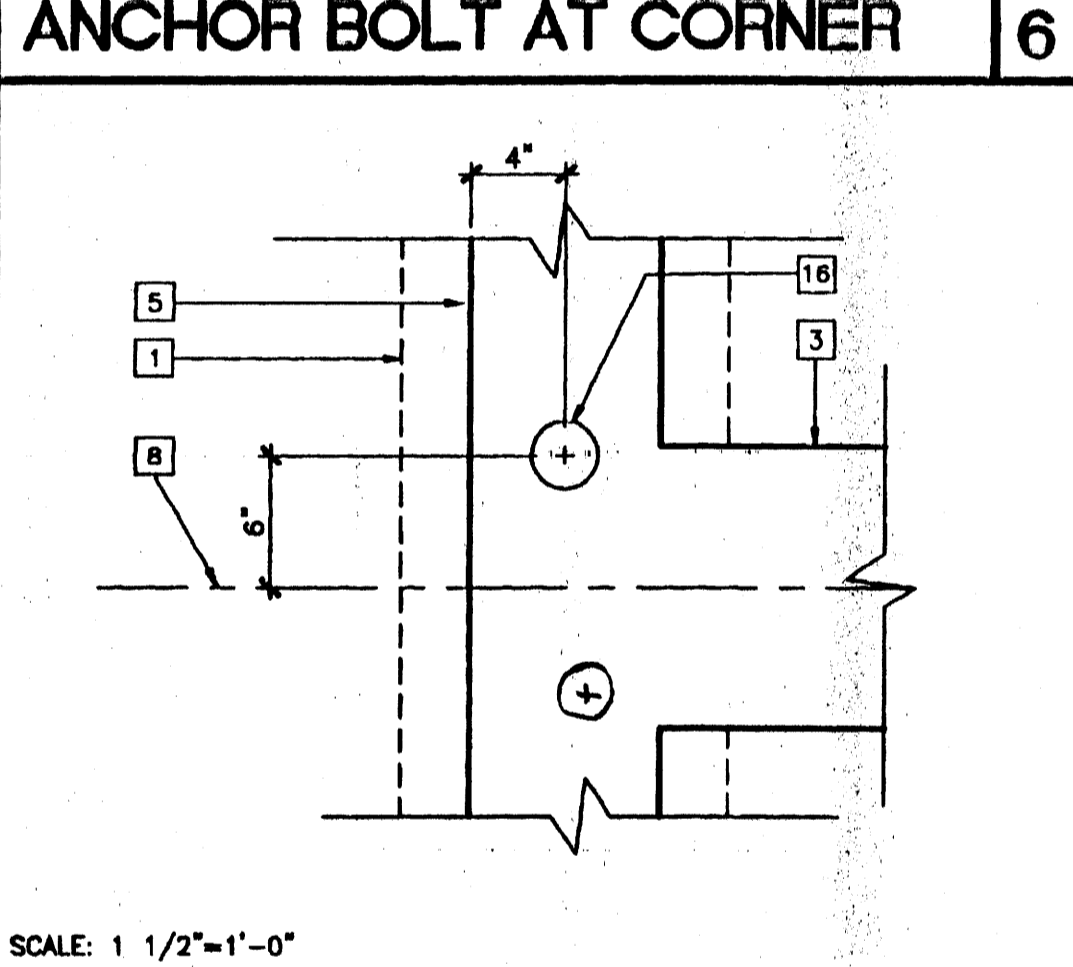


SCALE: 1 1/2"=1'-0"

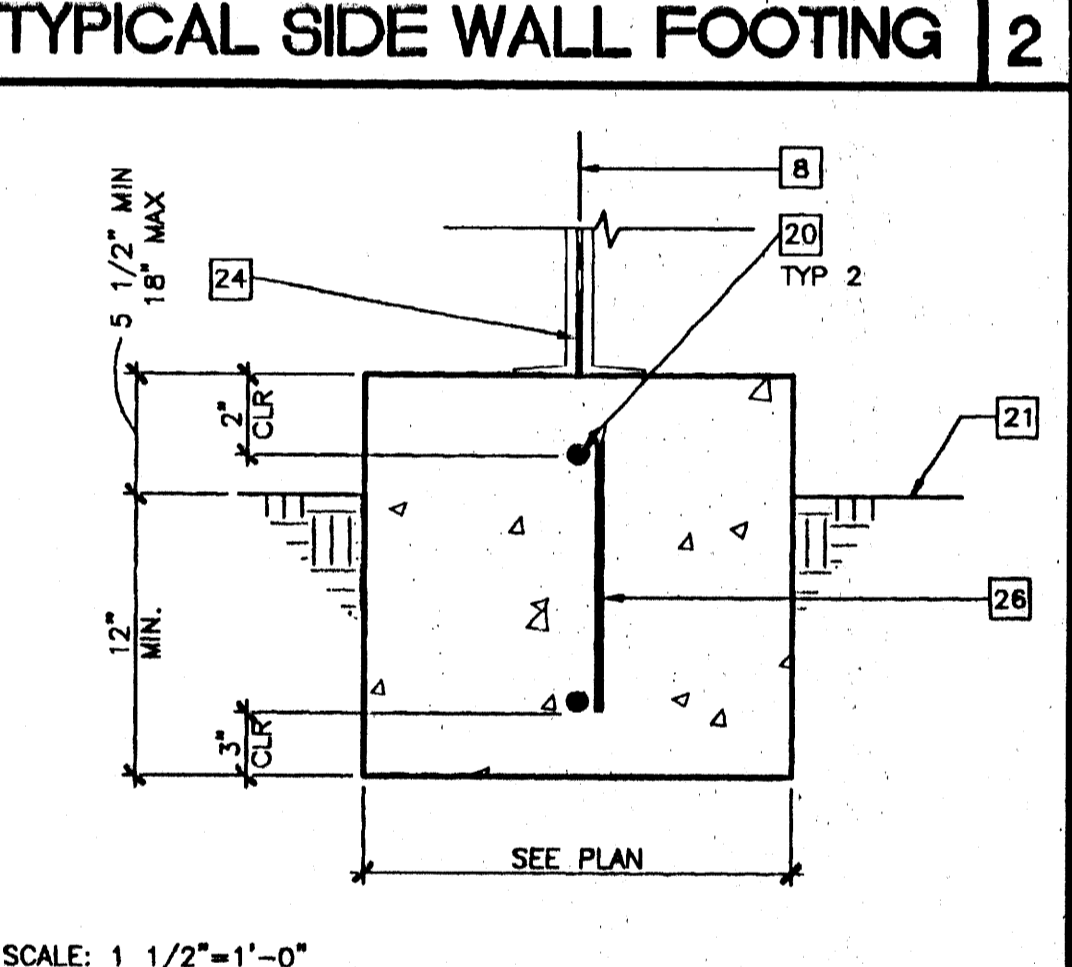


SCALE: 1 1/2"=1'-0"

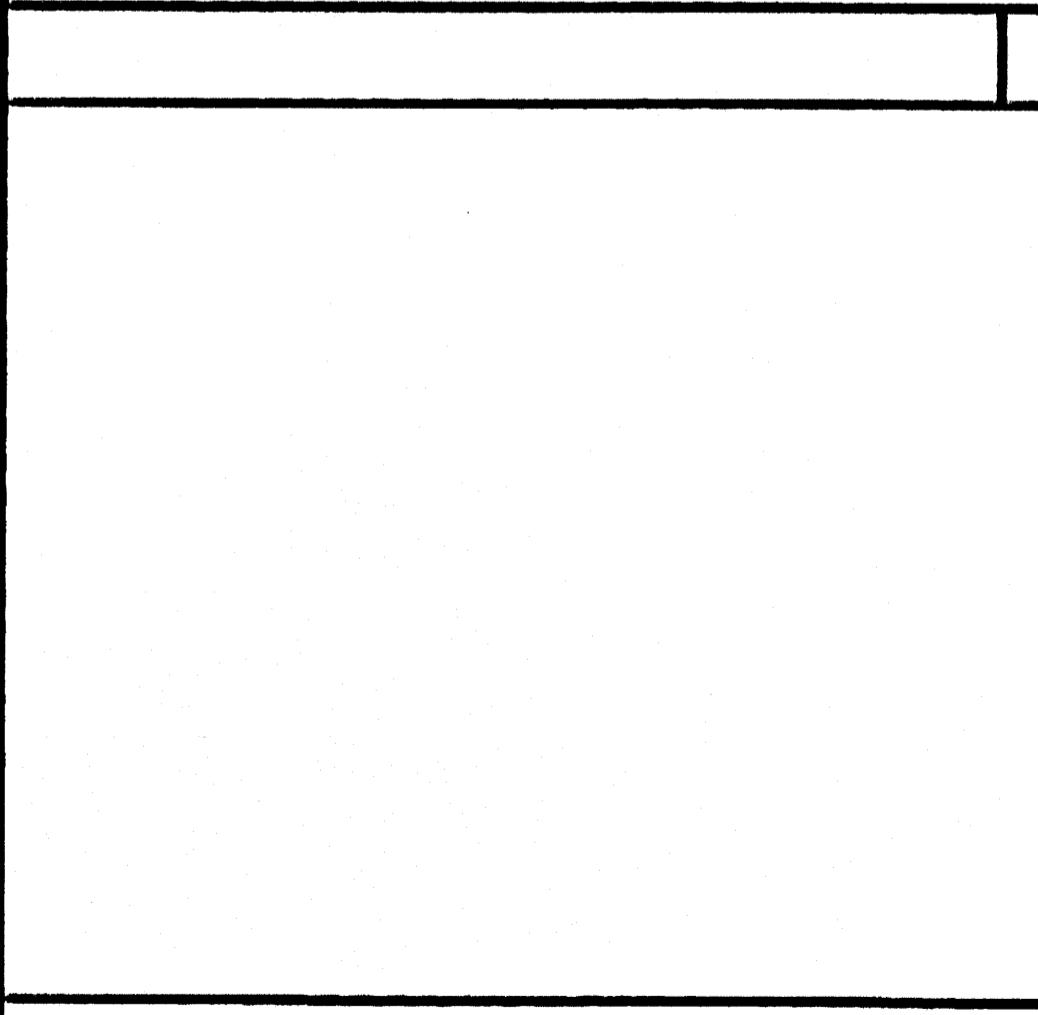


SCALE: 1 1/2"=1'-0" (OPTIONAL)

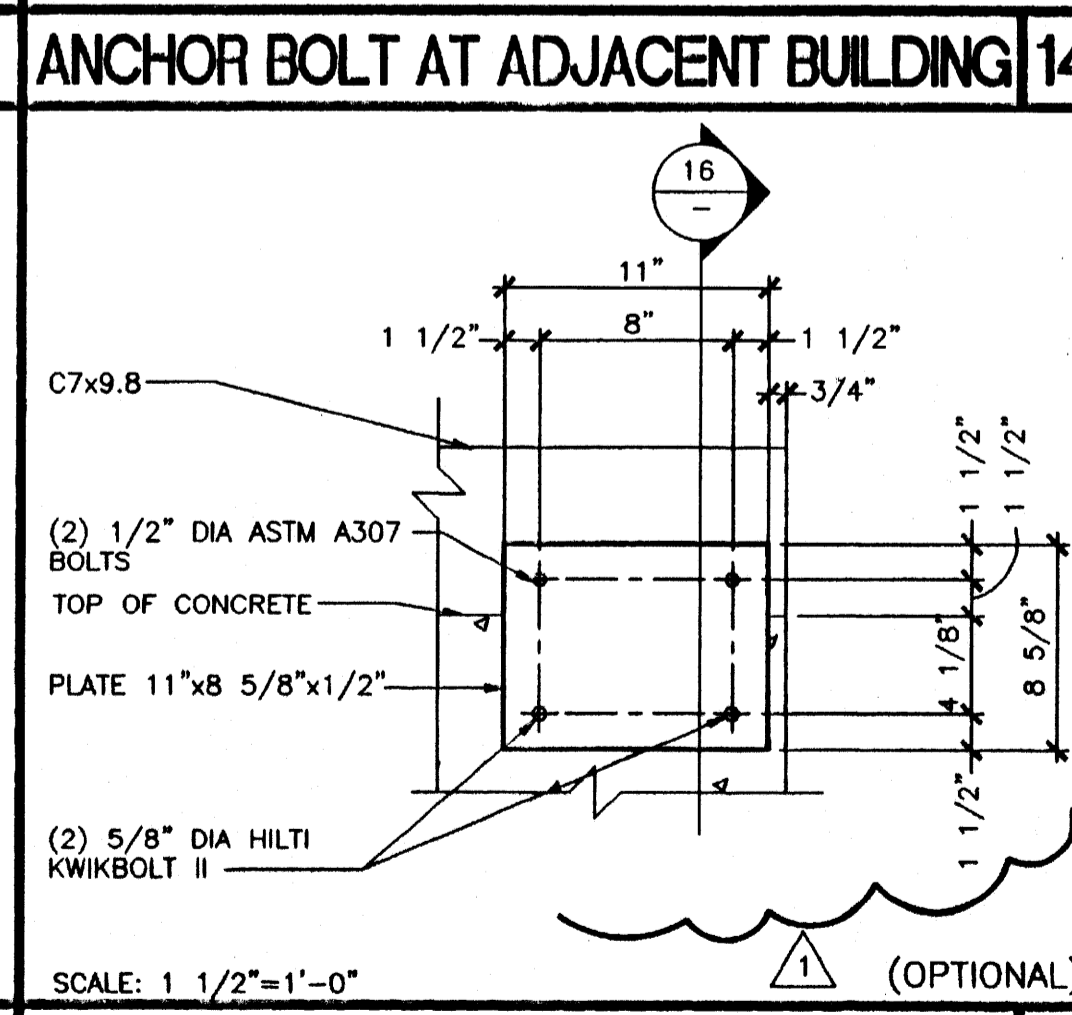


SCALE: 1/2"=1'-0" (OPTIONAL)

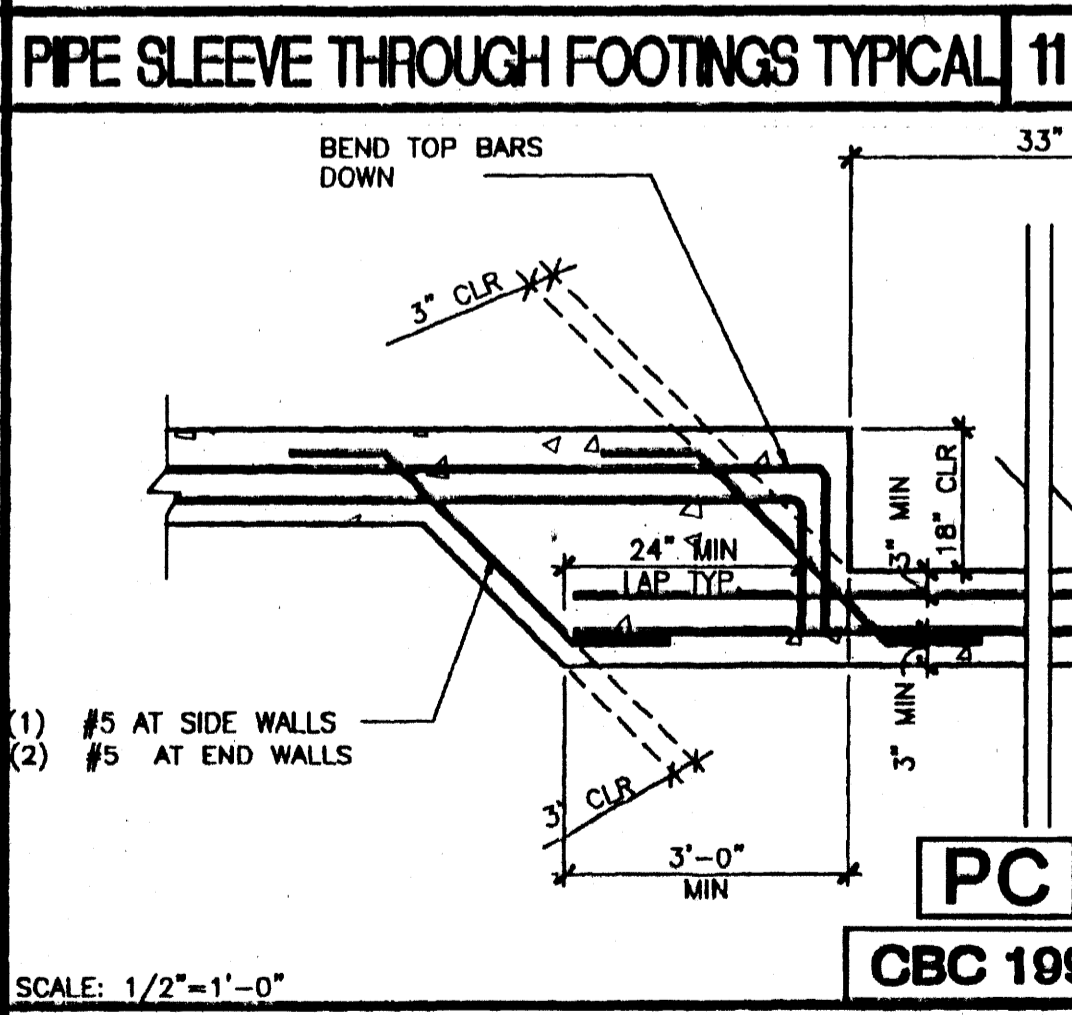


SCALE: 1 1/2"=1'-0"

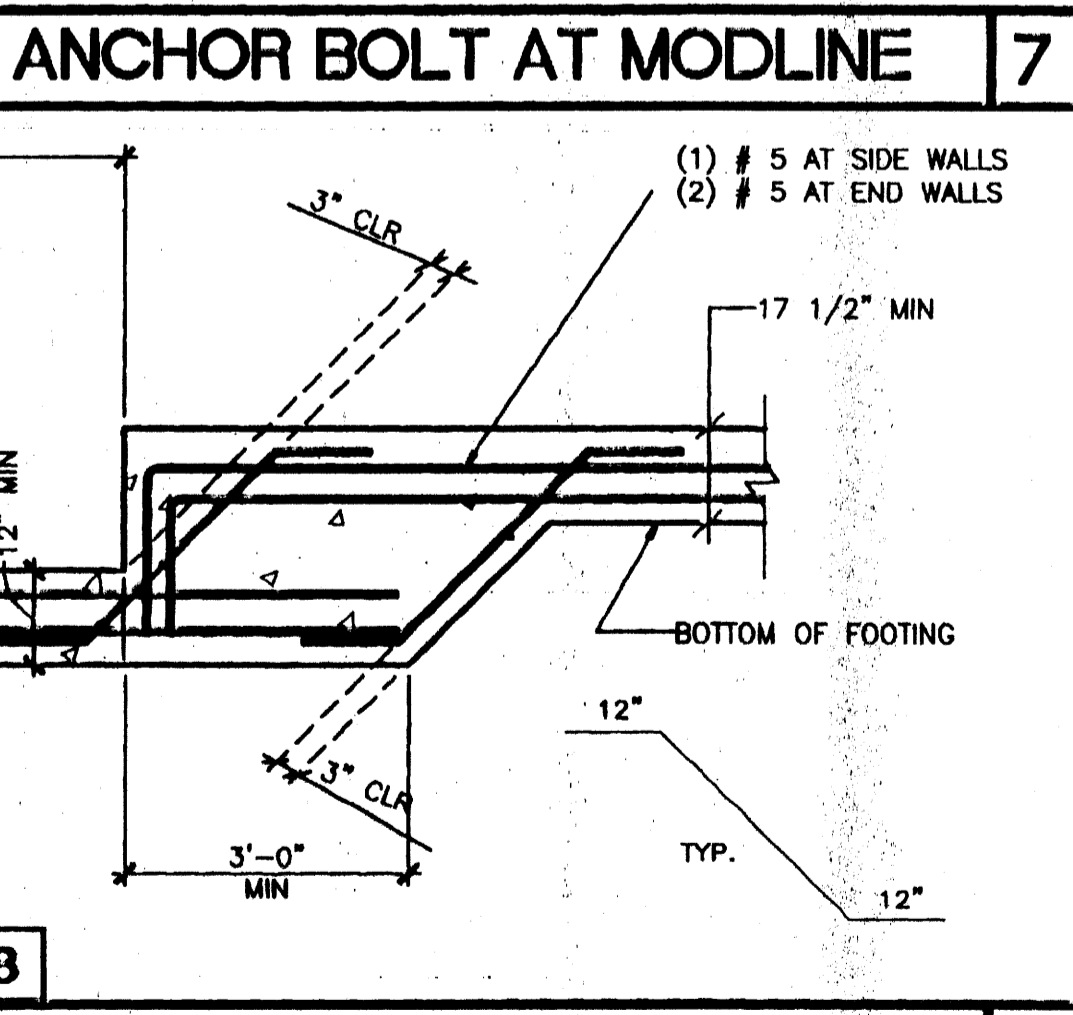

SCALE: 1 1/2"=1'-0"

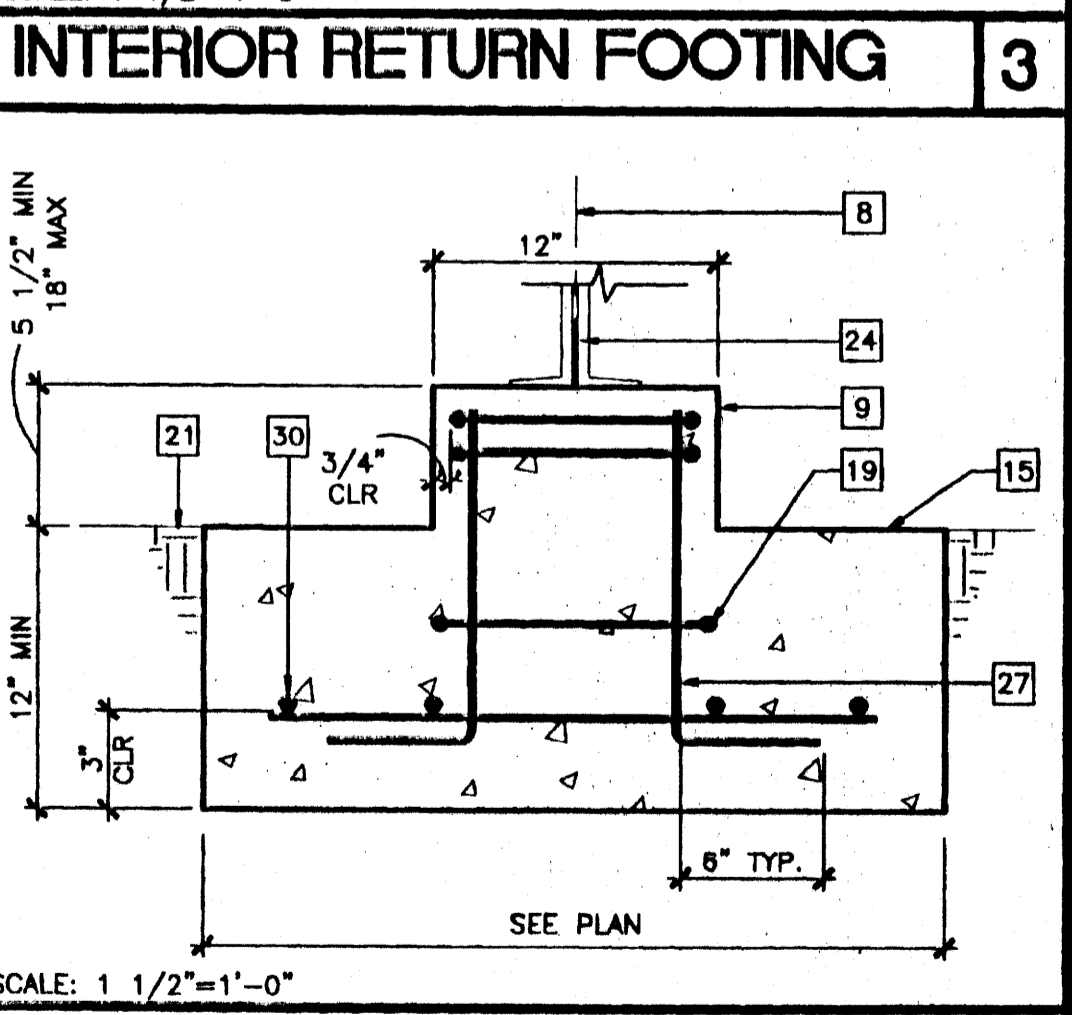

SCALE: 1 1/2"=1'-0"

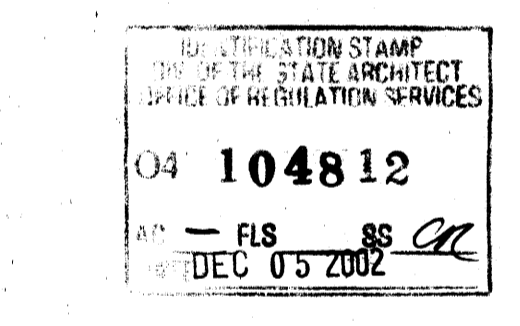

NO.	REVISION	DATE
1	SP MODTECH ENGINEERING CHANGE	9/21/00
2	SP MODTECH ENGINEERING CHANGE	09/28/00
3	10/18/02 MODTECH FIX	
4	FH CHANGED KEY NOTE 22	1/3/01

Electrical Engineer's Seal
Mechanical Engineer's Seal
Structural Engineer's Seal
Architect's Seal

IDENTIFICATION STAMP
DIV. OF THE STATE ARCHITECT
OFFICE OF REGULATION SERVICES
PC-04
101268
DATE: SEP 17 2002
REVISED OCT 1 6 2002

MODTECH INC.
2830 BARRETT AVENUE
PERRIS, CALIF. 92572
PH (909) 943-4014
FAX (909) 940-0427

PROJECT NUMBER: 4373
COLTON U.S.D.
© MODTECH, INC. 2002

DRAWN BY: KK
DATE: 11/19/02
CHECKED BY: STKP-67
DATE: 4/12-124
MODTECH Index No.
F2.11

FILE PATH: 2440-F2.11.DWG PROJECT NO. 4373

FILE PATH: 2440-F3.01.DWG PROJECT NO. 4373

FOOTING SCHEDULE

DESIGN FLOOR LIVE LOAD	50 PSF	50+20 PSF	100 PSF	125 PSF
SIDEWALL	12"	12"	SEE SHEET F3.02	SEE SHEET F3.02
ENDWALL	17"/11"	19"		
PAD	3'-4"/3'-5"	4'-0"/3'-10"		
PAD AT 4" SEPARATION	5'-9"/3'-9"	4'-3"/4'-1"		

* = VALUE FOR CONCRETE FLOOR

VENTING SCHEDULE

BUILDING	(SF)	VENTING AREA REQUIRED	SIDE WALL VENTING	SIDE WALL VENT AREA	END WALL VENTING	END WALL VENT AREA	TOTAL VENT SUPPLIED
24'x40'	960	6.4	(5) A	7.8	-	-	7.8
36'x40'	1440	9.6	(4) B	9.6	-	-	9.6
48'x40'	1920	12.8	(6) B	14.4	-	-	14.4
60'x40'	2400	16	(4) C (2) B	12.92 4.8	-	-	17.7
72'x40'	2880	19.2	(6) C	19.38	-	-	19.4
84'x40'	3360	22.4	(6) C	19.38	(2) A (1) D	3.65	23.03
96'x40'	3840	25.6	(6) C	19.38	(4) A (1) D	6.6	25.9
108'x40'	4320	28.8	(6) C	19.38	(6) A (1) D	9.5	28.9
120'x40'	4800	32	(6) C	19.38	(9) A	31.1	32.52
132'x40'	5280	35.2	(6) C	19.38	(11) A	16.1	35.5
144'x40'	5760	38.4	(6) C	19.38	(13) A (1) D	24.49	39.09

LEGEND	VENT SIZE	AREA (SF)	GRATE SIZE
	A 3'-9"x5"	1.56	4'x8"
B 5'-9"x5"	2.40	6'x8"	
C 7'-9"x5"	3.23	8'x8"	
D 1'-9"x5"	0.73	2'x8"	
ACCESS (OPTIONAL)	E 2'-9"x18"	4.13	3'x2'



KEY NOTES

- 1 END WALL FOOTING - SEE FOOTING SCHEDULE
- 2 SIDE WALL FOOTING - SEE FOOTING SCHEDULE
- 3 INTERIOR RETURN FOOTING - SEE FOOTING SCHEDULE
- 4 MODLINE RETURN AT 4" SEPARATION - OPTIONAL
- 5 STEM WALL - 8" TYPICAL UON
- 6 MODLINE PAD
- 7 MODLINE PAD AT 4" SEPARATION - OPTIONAL
- 8 12" DIA OR SQUARE PEDESTAL (TYPICAL AT MODLINE)
- 9 19" DIA OR SQUARE PEDESTAL (TYPICAL AT MODLINE)
- 10 TYPICAL VENT
- 11 ADDITIONAL END WALL VENTS AS REQUIRED (48" MAXIMUM LENGTH) OR INCREASE VENT HEIGHT AS REQUIRED AT SIDEWALLS
- 12 MODLINE
- 13 4" BUILDING SEPARATION AT ADJACENT BUILDING - OPTIONAL
- 14 NOT USED
- 15 ANCHOR BOLT LOCATION - (1) AT EACH CORNER OF BUILDING AND (2) AT EACH MODLINE LOCATION

NOTES

1. SOIL TYPE AND FOUNDATION
 - A. BEARING: SOIL BEARING VALUE OF 1000 PSF USED FOR DESIGN.
 - B. FOOTINGS: ALL FOOTINGS SHALL EXTEND 12 INCHES MINIMUM INTO NATIVE SOIL OR APPROVED ENGINEERED FILL.
2. CONCRETE
 - ALL CONCRETE SHALL HAVE THE FOLLOWING MINIMUM STRENGTH AT 28 DAYS: FOOTINGS: $f'_c = 3000$ PSI (DESIGN BASED ON $f'_c = 2000$ PSI). CONCRETE SHALL CONFORM TO TITLE 24 SECTION 1905A.2.3 METHOD A OR B. METHOD A NON-DESIGNED MIX PER TABLE 19A-A-8. METHOD B PER SECTION 1905A.3.1. CONCRETE SUPPLIER SHALL PROVIDE 8 PER SECTION 1905A.3.1. CONCRETE SUPPLIER SHALL PROVIDE CONCRETE MIX DESIGN AND A BREAK HISTORY OF 30 CONSECUTIVE BREAKS IDENTIFIED TO THAT MIX DESIGN. ALL CEMENT SHALL BE TYPE I OR TYPE II PER ASTM C-150. UNLESS NOTED OTHERWISE ON THE APPROVED PLANS, SPECIFICATIONS OR GEOTECHNICAL REPORT FOR DSA METHOD A, THE FOLLOWING PROPORTIONS ARE REQUIRED: MINIMUM 7.1 SACKS PER YARD. WATER CONTENT SHALL NOT EXCEED 6 GALLONS PER SACK. AGGREGATE SHALL BE 3/4" TO 1" MAXIMUM SIZE BUT NOT MORE THAN 3/4" OF MINIMUM CLEAR BAR SPACING. ANCHOR BOLTS, DOWELS, REINFORCING STEEL AND EMBEDDED ITEMS ARE TO BE SECURELY TIED IN PLACE BEFORE CONCRETE IS POURED.
3. REINFORCING STEEL GRADE 40.
 - ALL REINFORCING STEEL SHALL BE BILLET STEEL PER ASTM A-615 WELDED REINFORCING STEEL SHALL CONFORM TO ASTM A-706, OR SHALL BE ASTM A-615 PREHEATED AND WELDED PER AWS D1.4-79.
4. FOR FOOTINGS USING TRENCH FOR FORMING WIDTH SHALL BE INCREASED 2" EA. SIDE
5. THE ABOVE FOUNDATION PLAN HAS 1/4" ADDED AT EACH MOD LINE AND 1/8" AT EACH SIDE WALL AND DOES NOT MATCH THE FLOOR PLAN. THIS IS REQUIRED FOR GROWTH THAT IS EXPERIENCED WHEN SETTING MULTIPLE MODULE BUILDINGS.
6. MAX VENT LENGTH AT SIDE WALLS IS 8'-0"
MAX VENT LENGTH AT END WALLS IS 4'-0"
MIN DISTANCE FROM VENT TO EDGE OF MODULE IS 2'-0"
MIN DISTANCE BETWEEN VENTS IS 2'-0"

NOTE: DELETE ALL UNDER FLOOR VENTS WHEN SINGLE STORY BUILDING OR BOTTOM FLOOR OF TWO STORY BUILDING UTILIZES THE CONCRETE FLOOR OPTION.

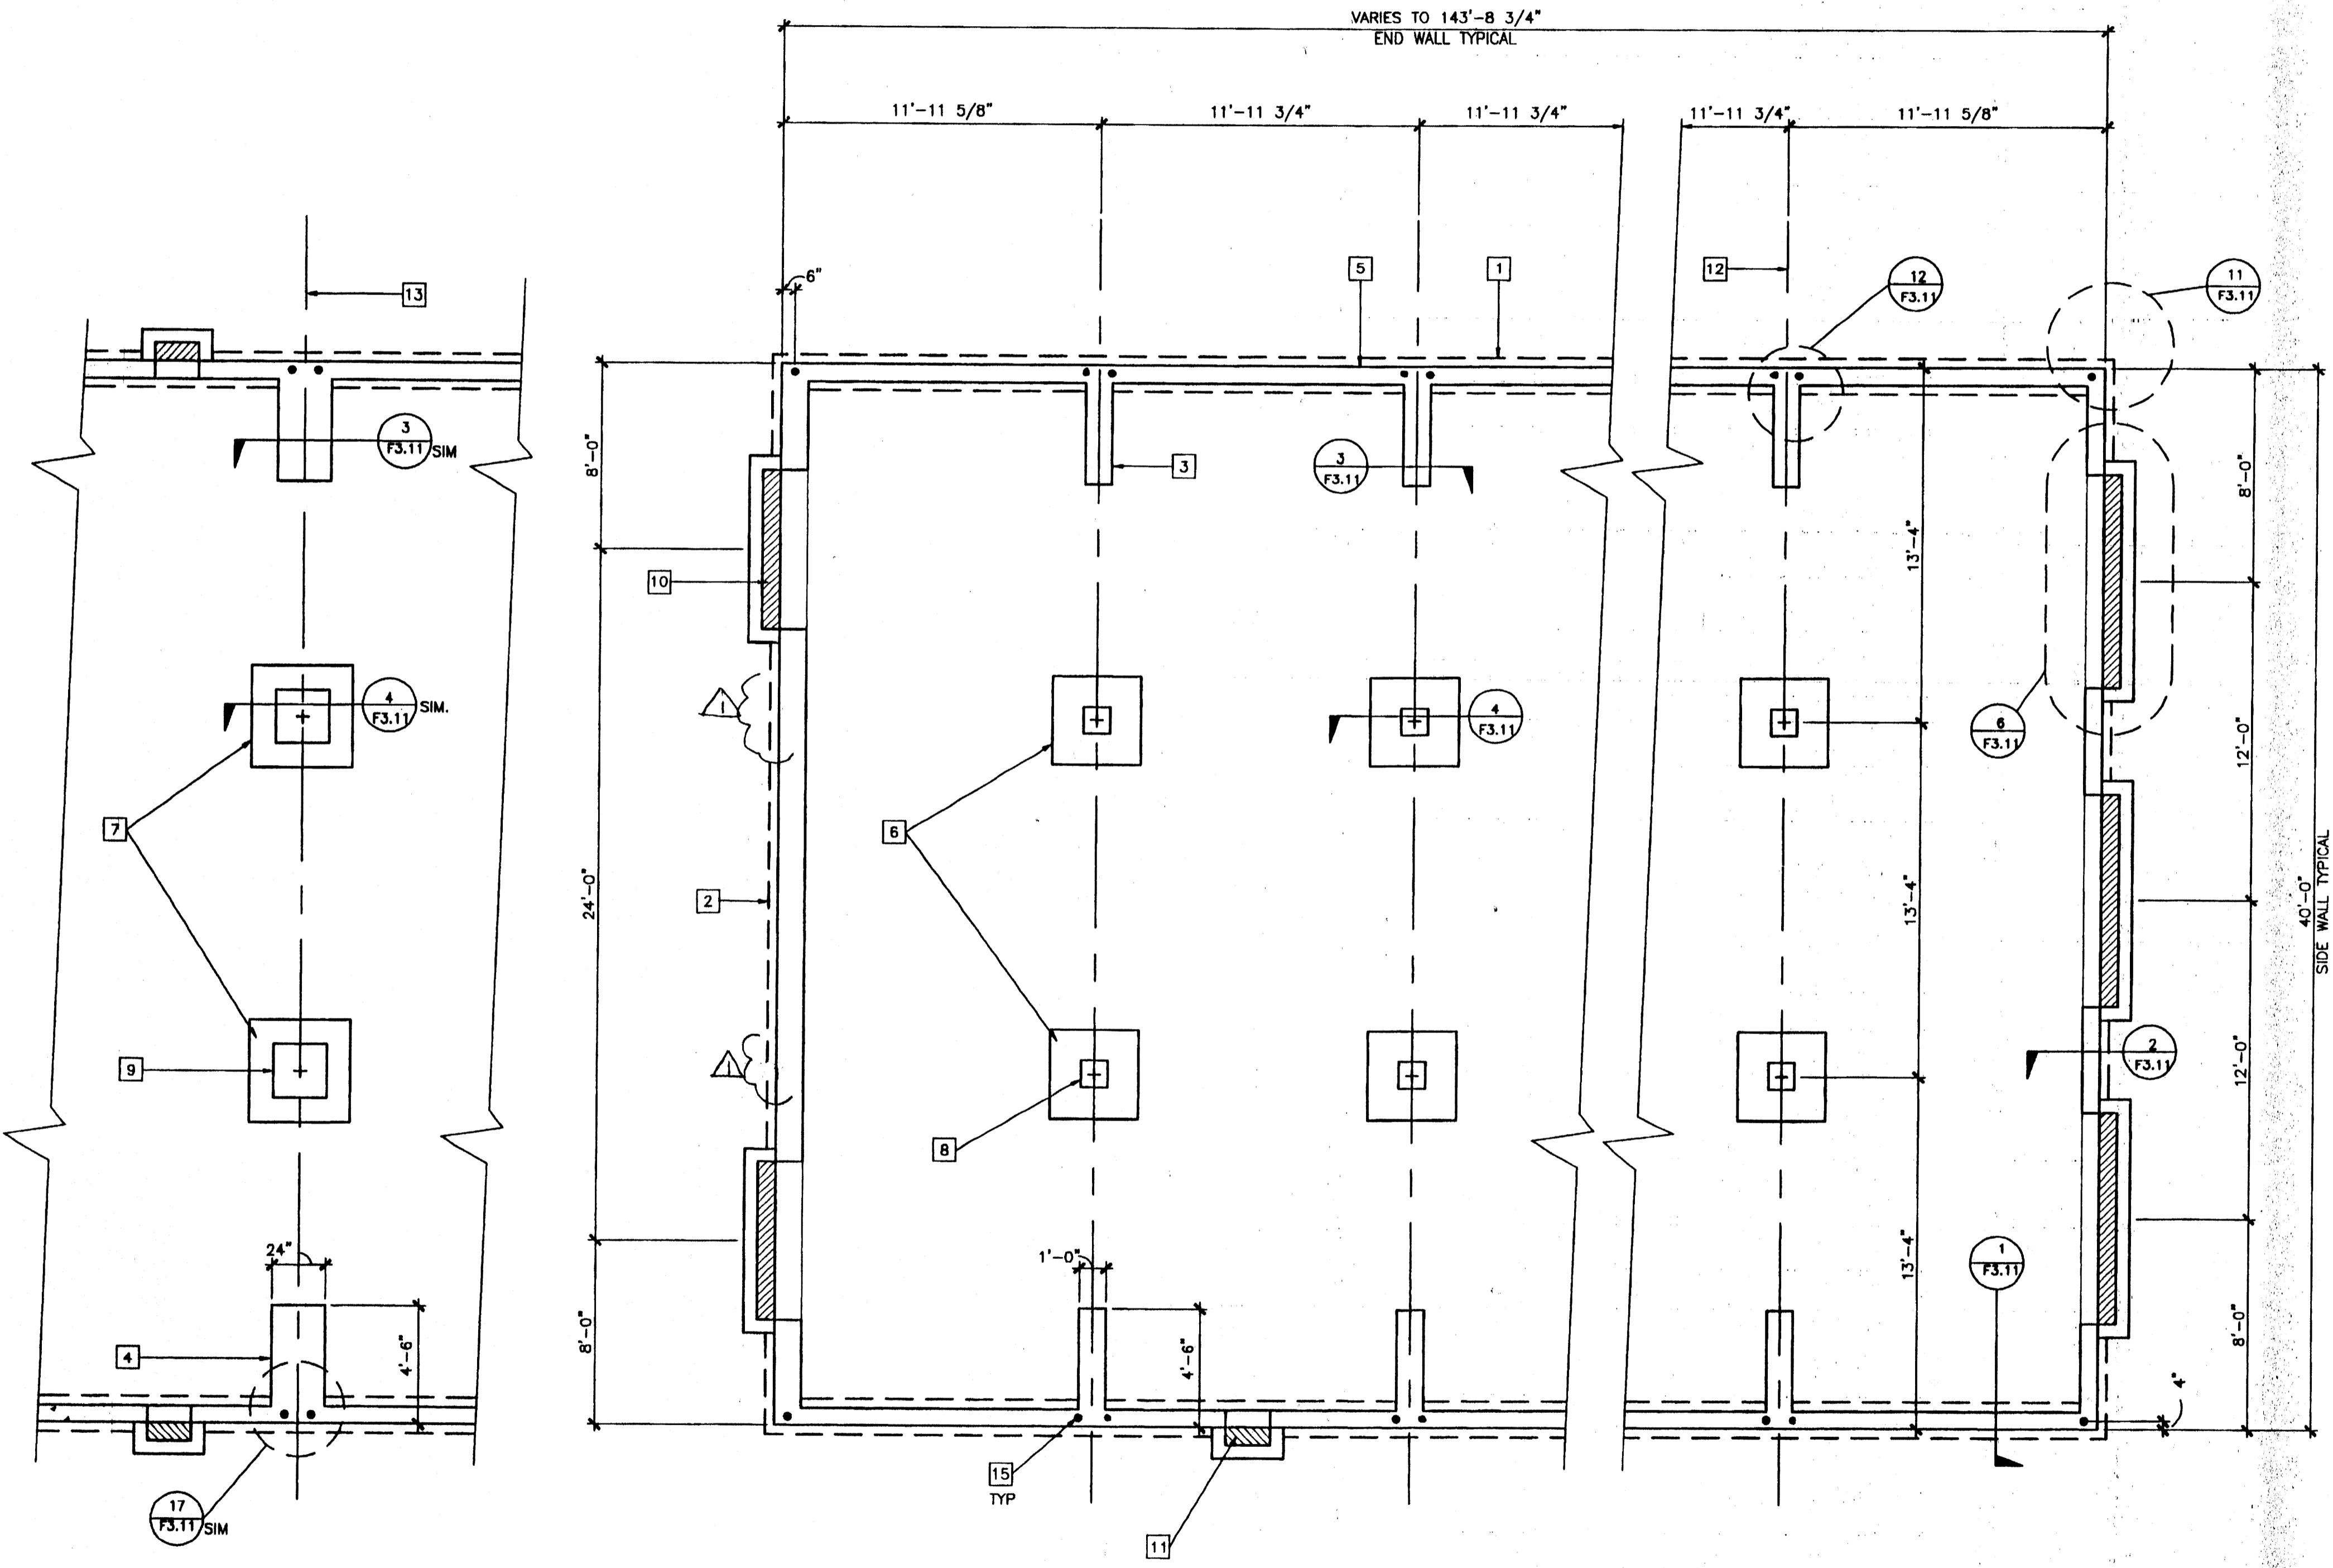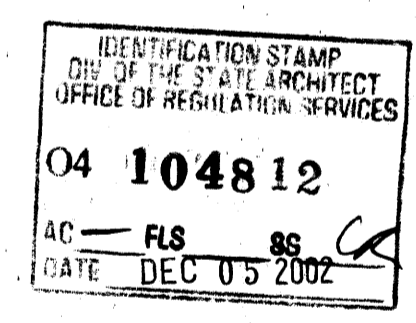

FOOTINGS AT ADJACENT BUILDING (OPTIONAL 4" SEPARATION)

REVISED OCT 2 5 2001
REVISED OCT 1 9 2001
PC
CBC 1998

FOUNDATION PLAN

BELOW GRADE CONCRETE
SCALE: 1/4" = 1'-0"

REVISIONS

1	10/18/00	MODTECH	FIX
2	FVH	ADD DELETE VENT	NOTE 10/25/01
3			
4			
5			

Electrical Engineer's Seal	Mechanical Engineer's Seal	Structural Engineer's Seal	Architect's Seal

MODTECH INC.
2830 BARRETT AVENUE
PERRIS, CALIF. 92572
PH (909) 943-4014
FAX (909) 940-0427

PROJECT NUMBER: 4373
COLTON U.S.D.
© MODTECH, INC. 2002
DRAWN BY: KK
DATE: 11/19/02
CHECKED BY: STKP-67
DATE: 4-012-124
MODTECH Index No.
FOUNDATION PLAN BGC - 50, 50+20 PSF **F3.01**

FOOTING SCHEDULE

DESIGN FLOOR LIVE LOAD	50 PSF	50+20 PSF	100 PSF	125 PSF
SIDEWALL	SEE SHEET F3.01	SEE SHEET F3.01	12"/14"	14"/15"
ENDWALL			20"/21"	21"/23"
PAD			4'-0"/4'-4"	4'-4"/4'-9"
PAD AT 4" SEPARATION			4'-3"/4'-7"	4'-7"/4'-11"


* = VALUE FOR CONCRETE FLOOR

VENTING SCHEDULE

BUILDING	(SF) AREA	(SF) VENTING REQUIRED	SIDE WALL VENTING	SIDE WALL VENT AREA	END WALL VENTING	END WALL VENT AREA	TOTAL VENT SUPPLIED
24'x40'	960	6.4	(5) A	7.8	-	-	7.8
36'x40'	1440	9.6	(4) B	9.6	-	-	9.6
48'x40'	1920	12.8	(6) B	14.4	-	-	14.4
60'x40'	2400	16	(4) C (2) B	12.92 4.8	-	-	17.7
72'x40'	2880	19.2	(6) C	19.38	-	-	19.4
84'x40'	3360	22.4	(6) C	19.38	(2) A (1) D	3.65	23.03
96'x40'	3840	25.6	(6) C	19.38	(4) A (1) D	6.6	25.9
108'x40'	4320	28.8	(6) C	19.38	(6) A (1) D	9.5	28.9
120'x40'	4800	32	(6) C	19.38	(9) A	31.1	32.52
132'x40'	5280	35.2	(6) C	19.38	(11) A	16.1	35.5
144'x40'	5760	38.4	(6) C	19.38	(13) A (1) D	24.49	39.09

LEGEND	VENT	SIZE	AREA (SF)	GRATE SIZE
	A	3'-9"x5"	1.56	4'x8"
B	5'-9"x5"	2.40	6'x8"	
C	7'-9"x5"	3.23	8'x8"	
D	1'-9"x5"	0.73	2'x8"	
ACCESS (OPTIONAL)	E	2'-9"x18"	4.13	3'x2'

NOTE: DELETE ALL UNDER FLOOR VENTS WHEN SINGLE STORY BUILDING OR BOTTOM FLOOR OF TWO STORY BUILDING UTILIZES THE CONCRETE FLOOR OPTION.

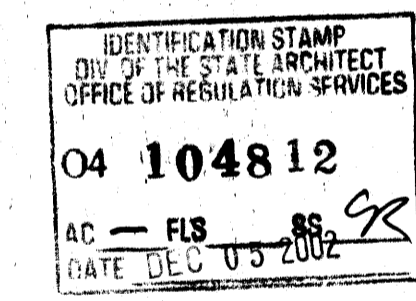


KEY NOTES

- END WALL FOOTING - SEE FOOTING SCHEDULE
- SIDE WALL FOOTING - SEE FOOTING SCHEDULE
- INTERIOR RETURN FOOTING - SEE FOOTING SCHEDULE
- MODLINE RETURN AT 4" SEPARATION - OPTIONAL
- STEM WALL - 8" TYPICAL UON
- MODLINE PAD
- MODLINE PAD AT 4" SEPARATION - OPTIONAL
- 12" DIA OR SQUARE PEDESTAL (TYPICAL AT MODLINE)
- 24" DIA OR SQUARE PEDESTAL (TYPICAL AT MODLINE)
- TYPICAL VENT
- ADDITIONAL END WALL VENTS AS REQUIRED (48" MAXIMUM LENGTH) OR INCREASE VENT HEIGHT AS REQUIRED AT SIDEWALLS
- MODLINE
- 4" BUILDING SEPARATION AT ADJACENT BUILDING - OPTIONAL
- NOT USED
- ANCHOR BOLT LOCATION - (1) AT EACH CORNER OF BUILDING, (1) AT EACH MODLINE LOCATION.
- NOT USED
- SECOND ANCHOR BOLT AT MODLINE FOR 125 PSF FLOOR ONLY

NOTES

- SOIL TYPE AND FOUNDATION**
A. BEARING: SOIL BEARING VALUE OF 1000 PSF USED FOR DESIGN.
B. FOOTINGS: ALL FOOTINGS SHALL EXTEND 12 INCHES MINIMUM INTO NATIVE SOIL OR APPROVED ENGINEERED FILL.
- CONCRETE**
ALL CONCRETE SHALL HAVE THE FOLLOWING MINIMUM STRENGTH AT 28 DAYS: FOOTINGS: $f'_c = 3000$ PSI (DESIGN BASED ON $f'_c = 2000$ PSI). CONCRETE SHALL CONFORM TO TITLE 24 SECTION 1905A.2.3 METHOD A OR B. METHOD A NON-DESIGNED MIX PER TABLE 19A-A-8. METHOD B PER SECTION 1905A.3.1. CONCRETE SUPPLIER SHALL PROVIDE CONCRETE MIX DESIGN AND A BREAK HISTORY OF 50 CONSECUTIVE BREAKS IDENTIFIED TO THAT MIX DESIGN. ALL CEMENT SHALL BE TYPE I OR TYPE II PER ASTM C-150. UNLESS NOTED OTHERWISE ON THE APPROVED PLANS, SPECIFICATIONS OR GEOTECHNICAL REPORT FOR DSA METHOD A, THE FOLLOWING PROPORTIONS ARE REQUIRED: MINIMUM 7.1 SACKS PER YARD. WATER CONTENT SHALL NOT EXCEED 6 GALLONS PER SACK. AGGREGATE SHALL BE 3/4" TO 1" MAXIMUM SIZE BUT NOT MORE THAN 3/4" OF MINIMUM CLEAR BAR SPACING. ANCHOR BOLTS, DOWELS, REINFORCING STEEL AND EMBEDDED ITEMS ARE TO BE SECURELY TIED IN PLACE BEFORE CONCRETE IS POURED.
- REINFORCING STEEL GRADE 40**
ALL REINFORCING STEEL SHALL BE BILLET STEEL PER ASTM A-615 WELDED REINFORCING STEEL SHALL CONFORM TO ASTM A-706, OR SHALL BE ASTM A-615 PREHEATED AND WELDED PER AWS D1.4-79.
- FOR FOOTINGS USING TRENCH FOR FORMING WIDTH SHALL BE INCREASED 2" EA. SIDE
- THE ABOVE FOUNDATION PLAN HAS 1/4" ADDED AT EACH MOD LINE AND 1/8" AT EACH SIDE WALL AND DOES NOT MATCH THE FLOOR PLAN. THIS IS REQUIRED FOR GROWTH THAT IS EXPERIENCED WHEN SETTING MULTIPLE MODULE BUILDINGS.
- MAX VENT LENGTH AT SIDE WALLS IS 8'-0"
MAX VENT LENGTH AT END WALLS IS 4'-0"
MIN DISTANCE FROM VENT TO EDGE OF MODULE IS 2'-0"
MIN DISTANCE BETWEEN VENTS IS 2'-0"

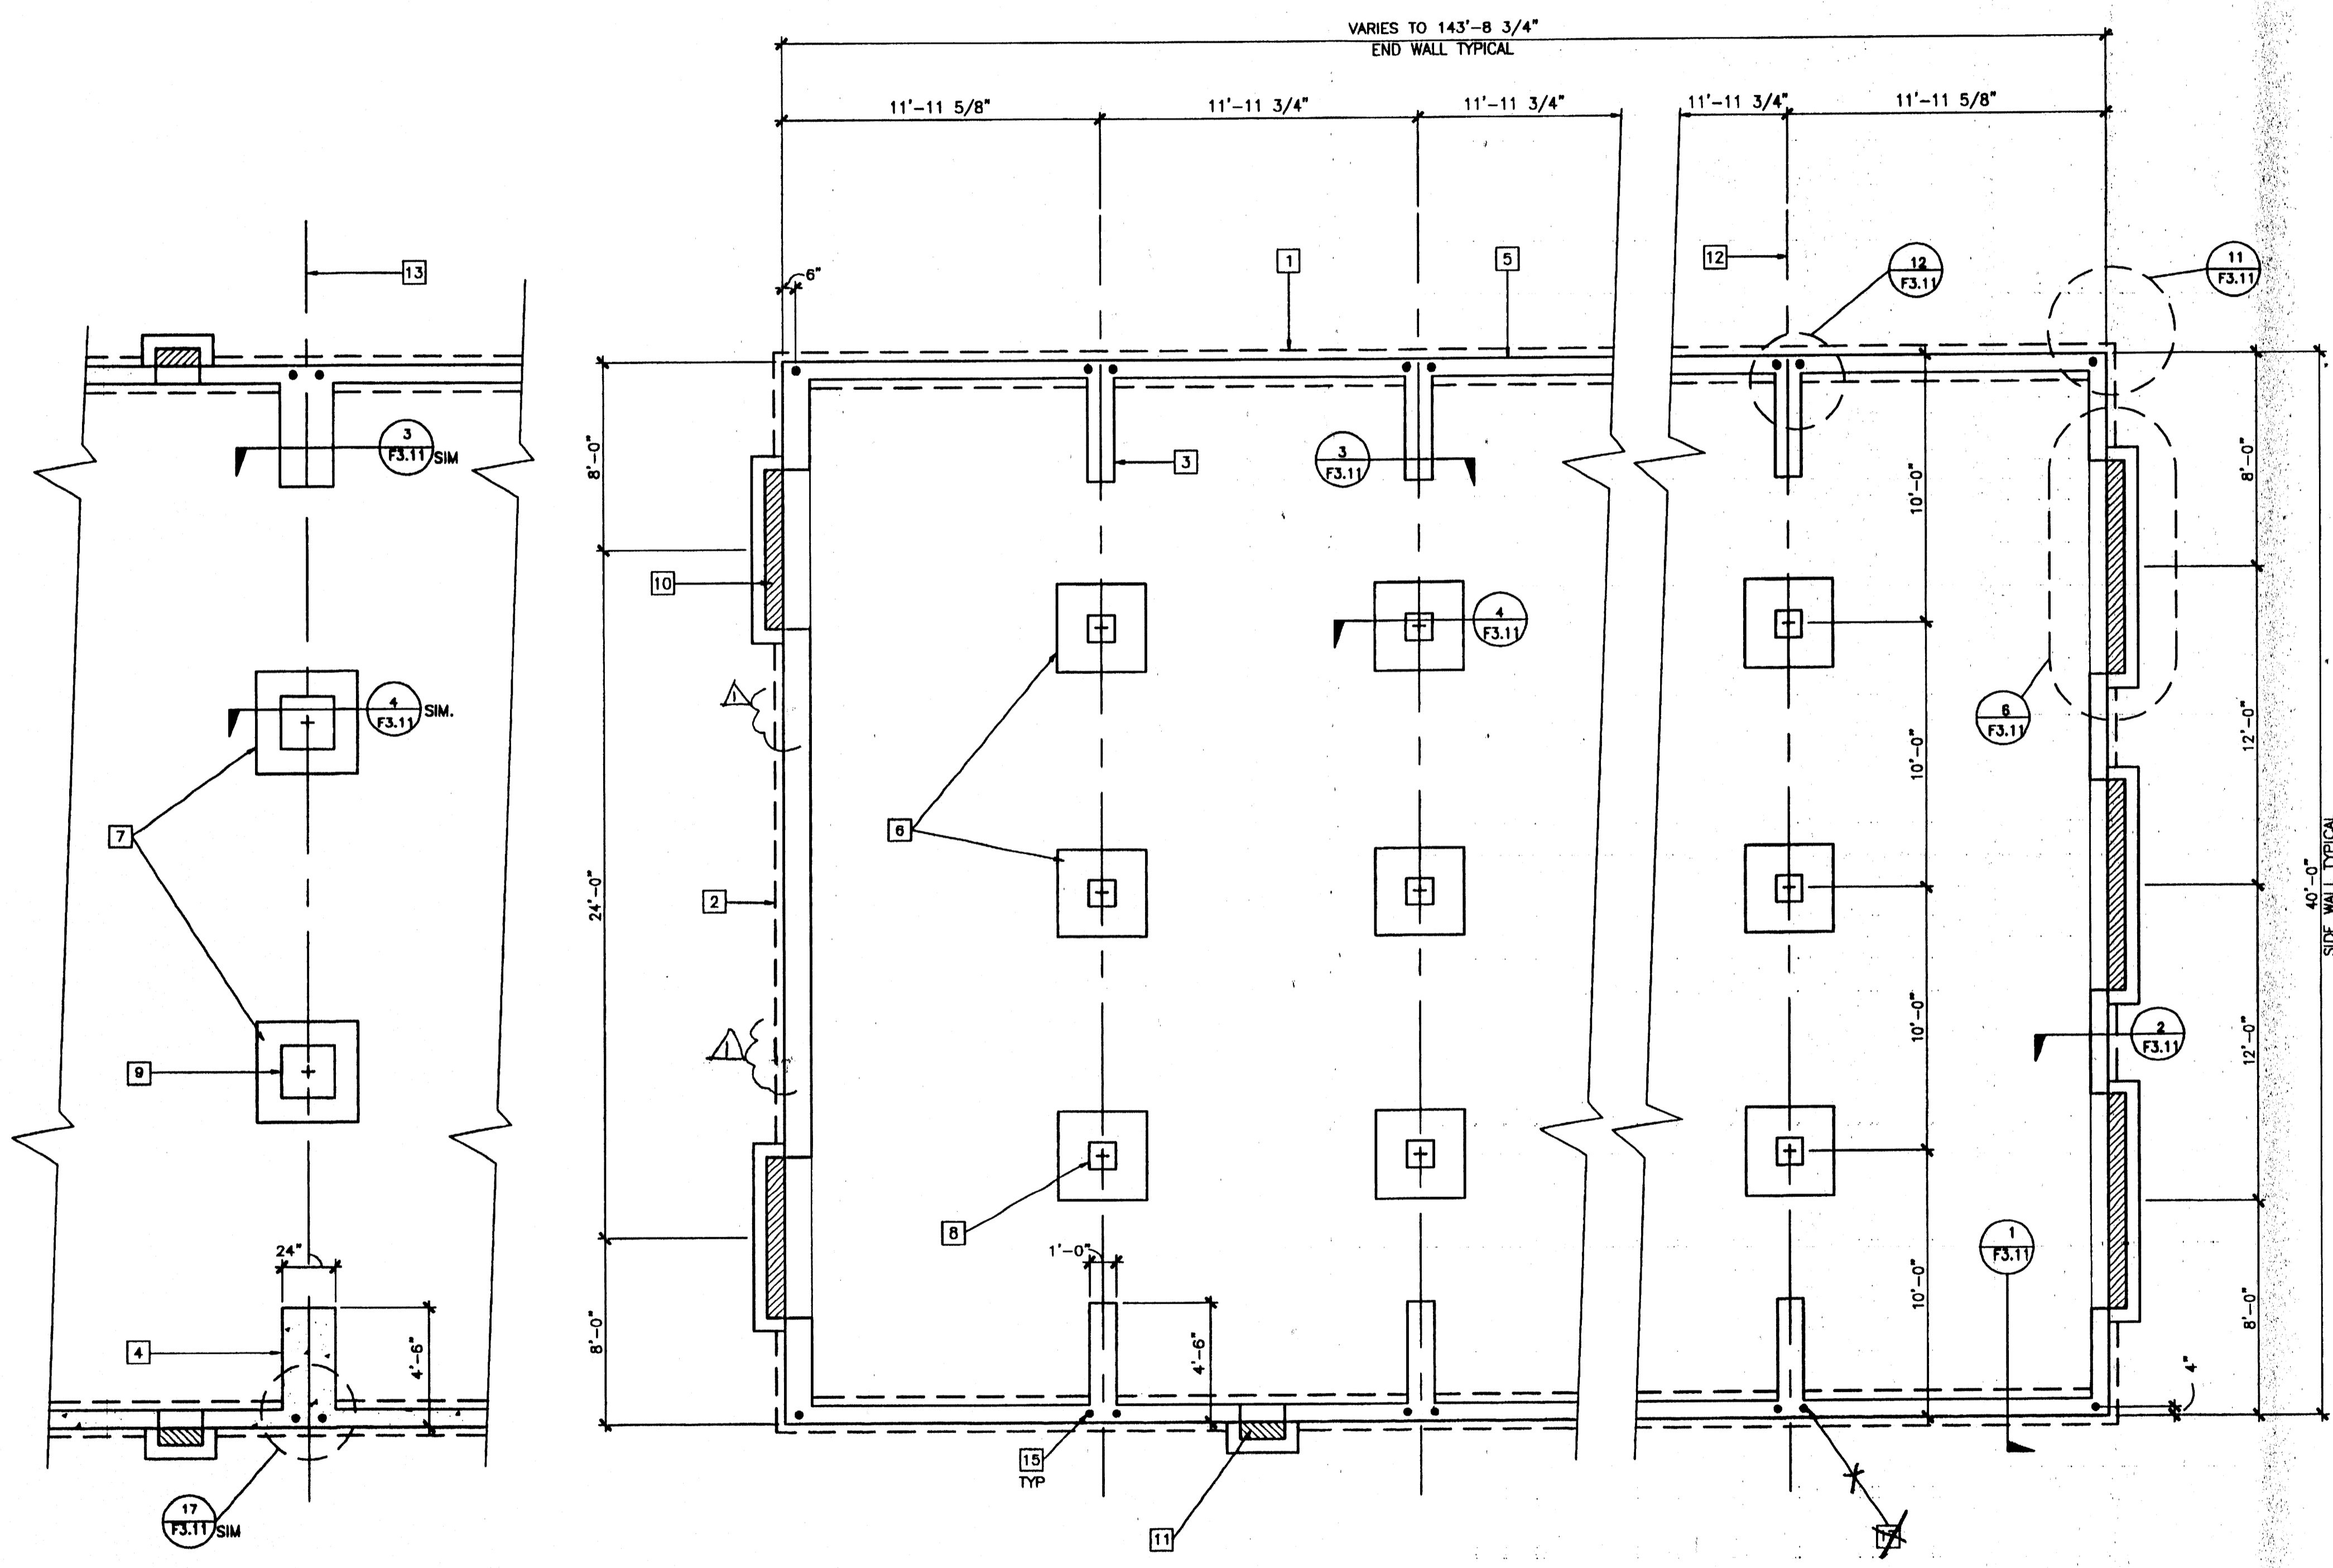

FOUNDATION PLAN

BELOW GRADE CONCRETE
SCALE: 1/4" = 1'-0"

REVISIONS

1	10/19/00	MODTECH FIX	
2	FVH	ADD DELETE VENT NOTE	10/25/01
3			
4			

Electrical Engineer's Seal
Mechanical Engineer's Seal
Structural Engineer's Seal
Architect's Seal


REVISIONS
OCT 19 2000
PC
CBC 1998
IDENTIFICATION STAMP
DIV. OF THE STATE ARCHITECT
OFFICE OF REGULATION SERVICES
PC-04
101268
AC - FLS
DATE SEP 07 1999
REVISED AUG 31 2000

MODTECH INC.
2830 BARRETT AVENUE
PERRIS, CALIF. 92572
PH (909) 943-4014
FAX (909) 940-0427

PROJECT NUMBER: 4373
COLTON U.S.D.
MODTECH, INC. 2002
DRAWN BY: KK
DATE: 11/19/02
CHECKED BY: STKP-67
DATE: 04/12-12/4
MODTECH Index No.
F3.02
FOUNDATION PLAN BGC - 100, 125 PSF


FILE PATH: 2440-F3.02.DWG

PROJECT NO. 4373

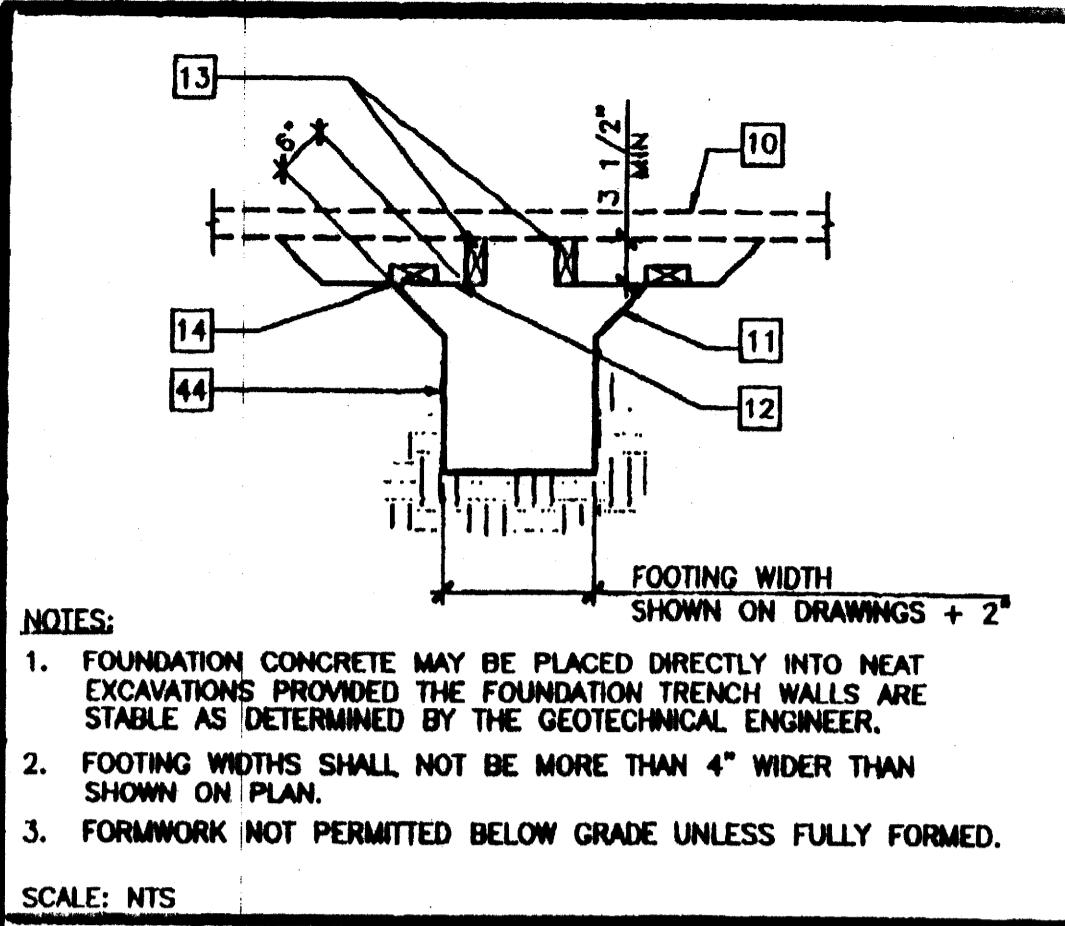


NOTES:
 1. FOUNDATION CONCRETE MAY BE PLACED DIRECTLY INTO NEAT EXCAVATIONS PROVIDED THE FOUNDATION TRENCH WALLS ARE STABLE AS DETERMINED BY THE GEOTECHNICAL ENGINEER.
 2. FOOTING WIDTHS SHALL NOT BE MORE THAN 4" WIDER THAN SHOWN ON PLAN.
 3. FORMWORK NOT PERMITTED BELOW GRADE UNLESS FULLY FORMED.


SCALE: NTS

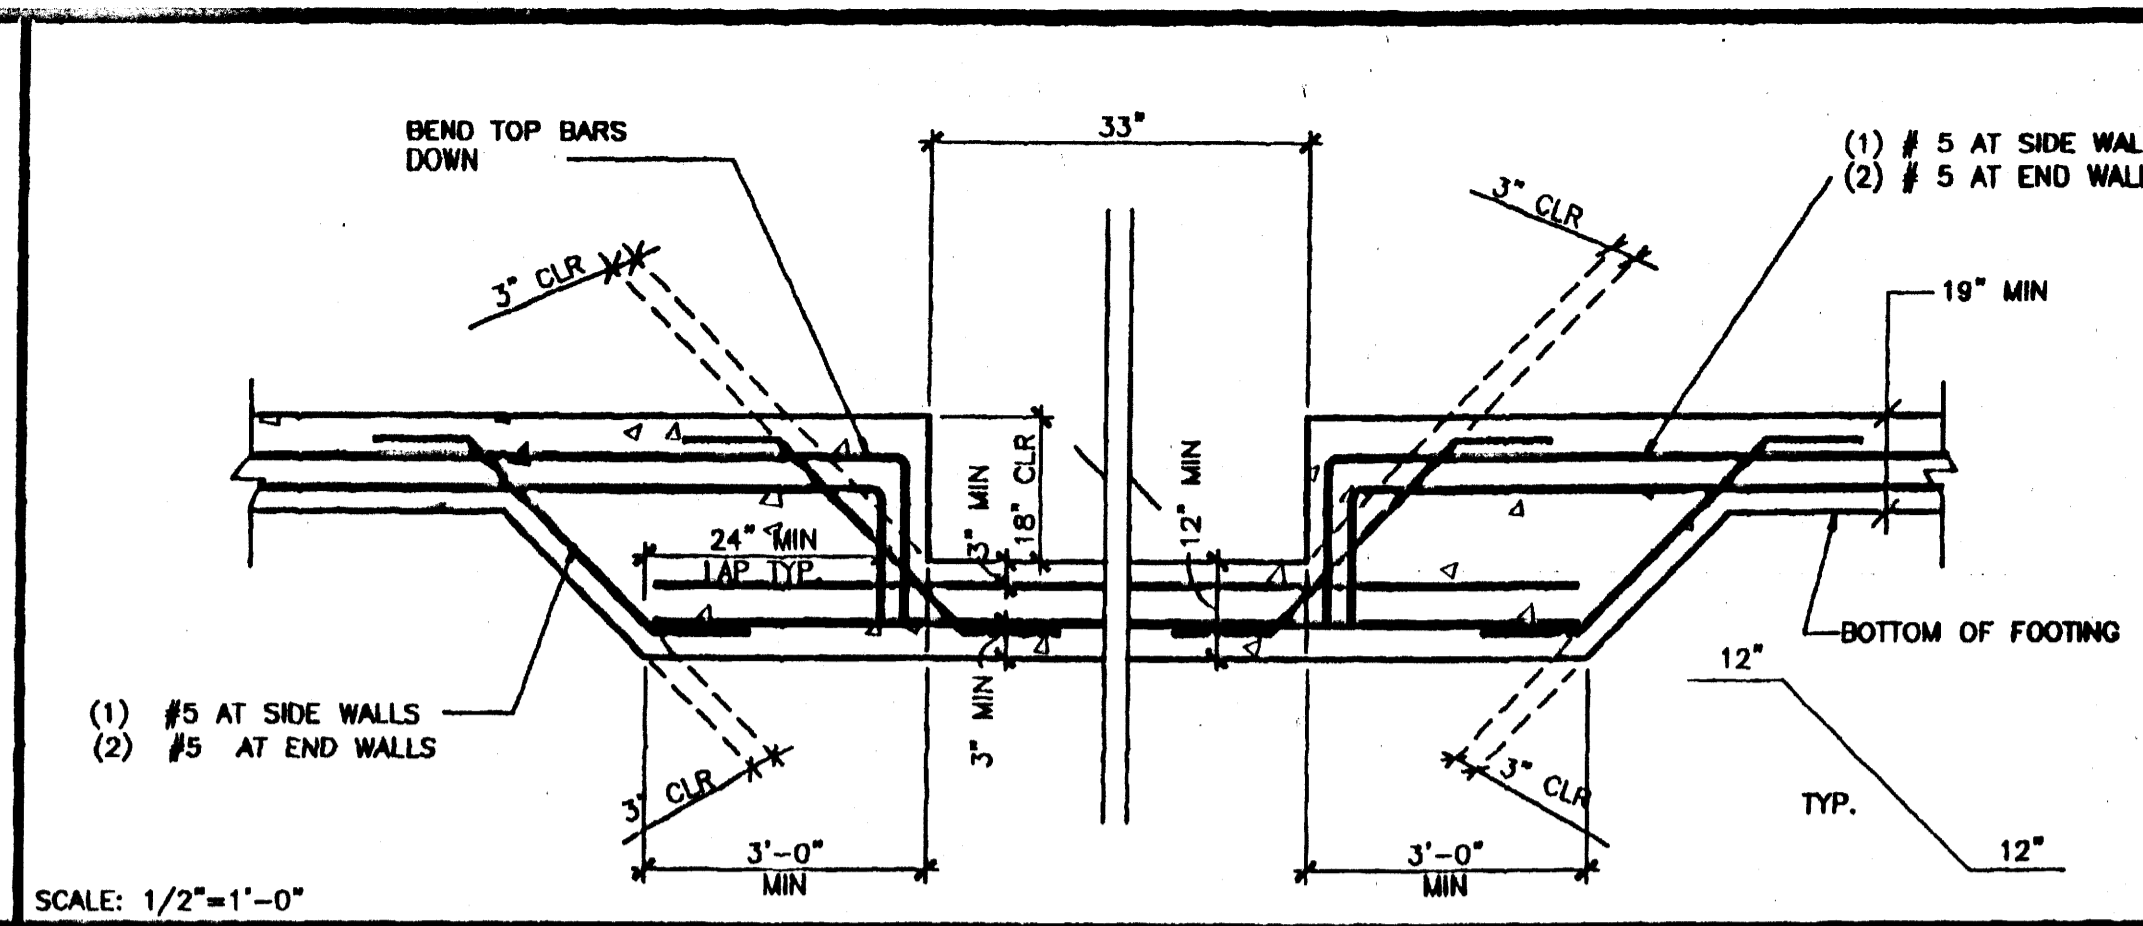

SCALE: 1/2"=1'-0"

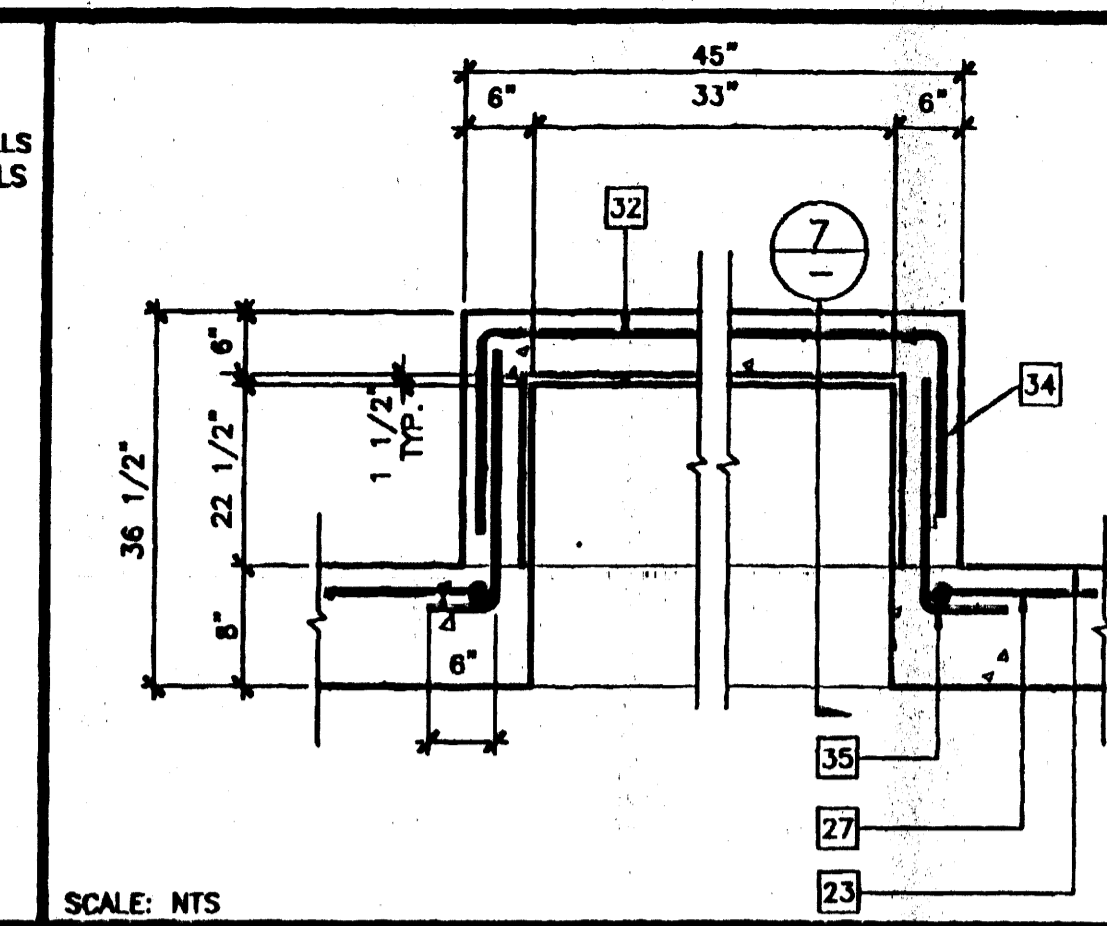

SCALE: NTS

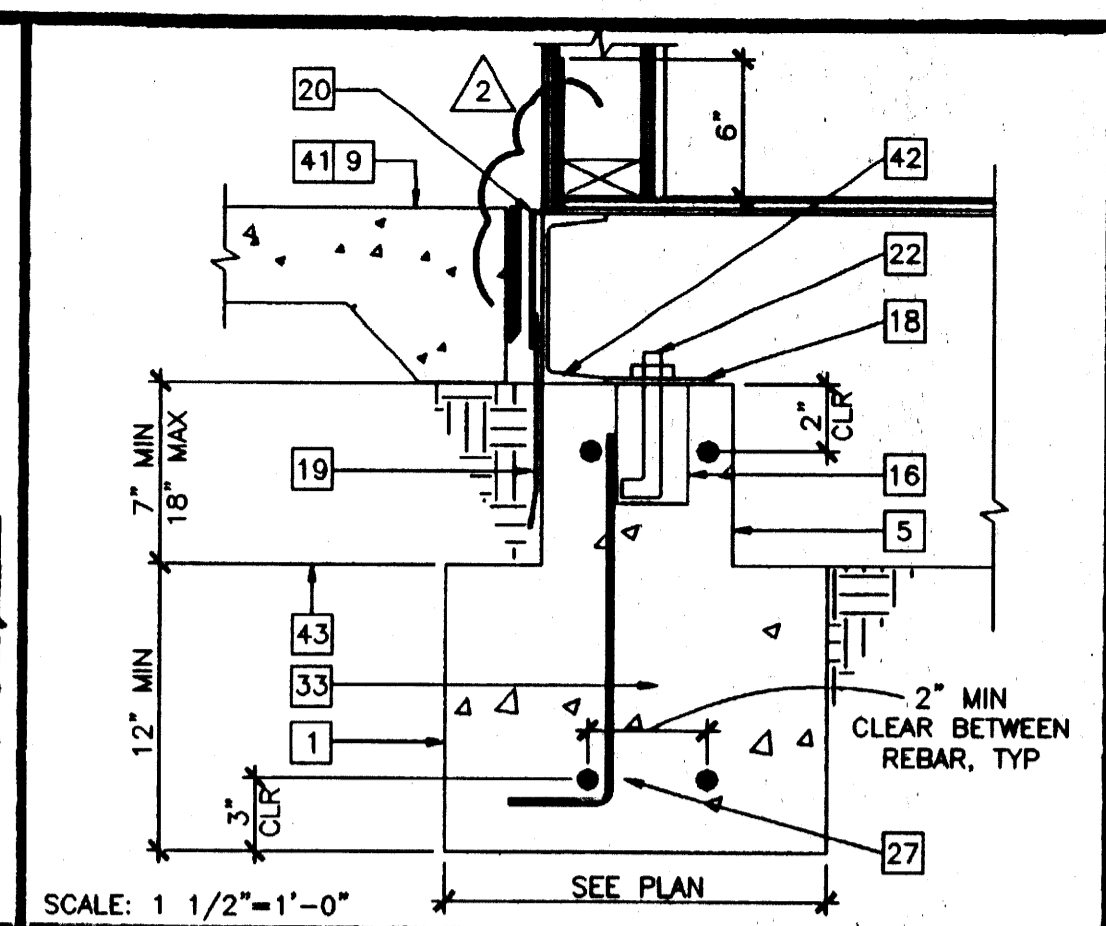

SCALE: 1 1/2"=1'-0"


- KEY NOTES**
- END WALL FOOTING - SEE FOOTING SCHEDULE
 - SIDE WALL FOOTING - SEE FOOTING SCHEDULE
 - MODLINE RETURN FOOTING - SEE FOOTING SCHEDULE
 - SLEEVE DIAMETER 2" LARGER THAN PIPE DIAMETER
 - STEM WALL
 - FOOTING, FOR PIPES IN THIS AREA LOWER FOOTING SO PIPES PASS THROUGH STEM WALL
 - PIPE THROUGH STEM WALL
 - MODLINE
 - CONCRETE FLATWORK (BY DISTRICT)
 - STARTER WALL AFTER SET. CLEAN TO REMOVE LAITANCE AND SCUM
 - CUT BACK SPALL
 - CONTINUOUS CLEAN-OUT. STAKES NOT PERMITTED WITHIN FOOTING AREA
 - MINIMUM FORMWORK (UNLESS FULLY FORMED)
 - 2x PLANKING
 - CONCRETE INTERIOR PAD FOOTING - SEE FOUNDATION PLAN FOR SIZES
 - 3" DIA x 5" DEEP CANOUT IN FOUNDATION (BY CONCRETE SUBCONTRACTOR)
 - OPTION 1: 12 GA GALVANIZED EXPANDED DIAMOND MESH. EMBED 1 1/2" INTO WET CONCRETE AT 2 SIDES AND BOTTOM
 OPTION 2: 3/16"x1 1/2"x1 1/2" GALVANIZED ANGLE FRAME WITH 12 GA GALVANIZED EXPANDED DIAMOND MESH WELDED TO END OF INTERIOR ANGLE LEG. ANCHOR WITH 3 FASTENERS AT BOTTOM INTO CONCRETE AND 3 FASTENERS AT TOP INTO FLOOR CHANNEL.
 - ANCHOR PLATE. - 3/51
 - COUNTER FLASHING (BY OTHERS)
 - GALVANIZED FLASHING, BY MODTECH
 - NOT USED
 - 3/4" ANCHOR BOLT A307 WITH 5" EMBEDMENT OR 3/4" DIA THREADED ROD A36 WITH 5" EMBEDMENT
 - LINE OF BUILDING
 - DOOR
 - DOOR FRAME
 - ALUMINUM THRESHOLD
 - #5 TOP AND BOTTOM CONTINUOUS
 - (4) #5'S EACH WAY AT BOTTOM
 - 4 - #5 X L VERTS
 - #4 SQUARE TIES AT 8" OC
 - #4 SQUARE TIES; 2 AT TOP OF FOOTING
 - #4 CONTINUOUS
 - #3 VERTICAL AT 24" OC
 - LAP 4"
 - STANDARD 90° HOOK TYPICAL
 - DRYWELL 3" DEEP WITH 3/8" PEA GRAVEL (ONLY AT ACCESS)
 - 3/8" DIA x3" ANCHOR BOLT WELDED TO ANCHOR FRAME
 - 1 1/4"x1 1/4" ANGLE FRAME
 - HORIZONTAL GRATE: GRATE OPENING TO BE MAXIMUM 1" EXCEPT 1/2" IN PATH OF TRAVEL (UPGRADE CHANGE ORDER REQUIRED), SEE ARCHITECTURAL SITE PLAN
 - CONCRETE AREAWAY WALL
 - FINISH GRADE
 - STEEL FLOOR FRAME
 - FINISH PAD ELEVATION - REFER TO GENERAL NOTES
 - NEAT CUT TRENCH
 - 4" BUILDING SEPARATION AT ADJACENT BUILDING - OPTIONAL
 - BUILDING LINE

FOOTING FORMS - PERMANENT


16 ACCESS VENT ELEVATION

9 ACCESS VENT


5 TYPICAL ENDWALL FOOTING

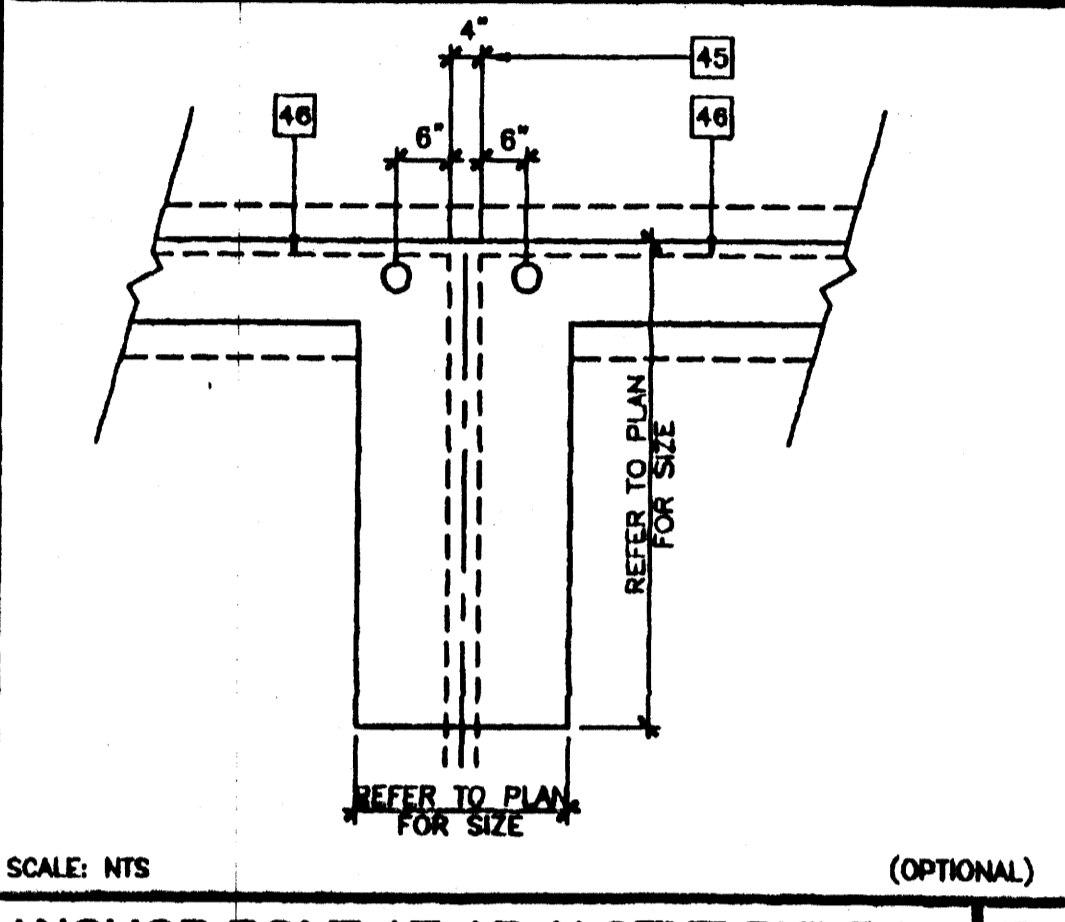


SCALE: NTS (OPTIONAL)

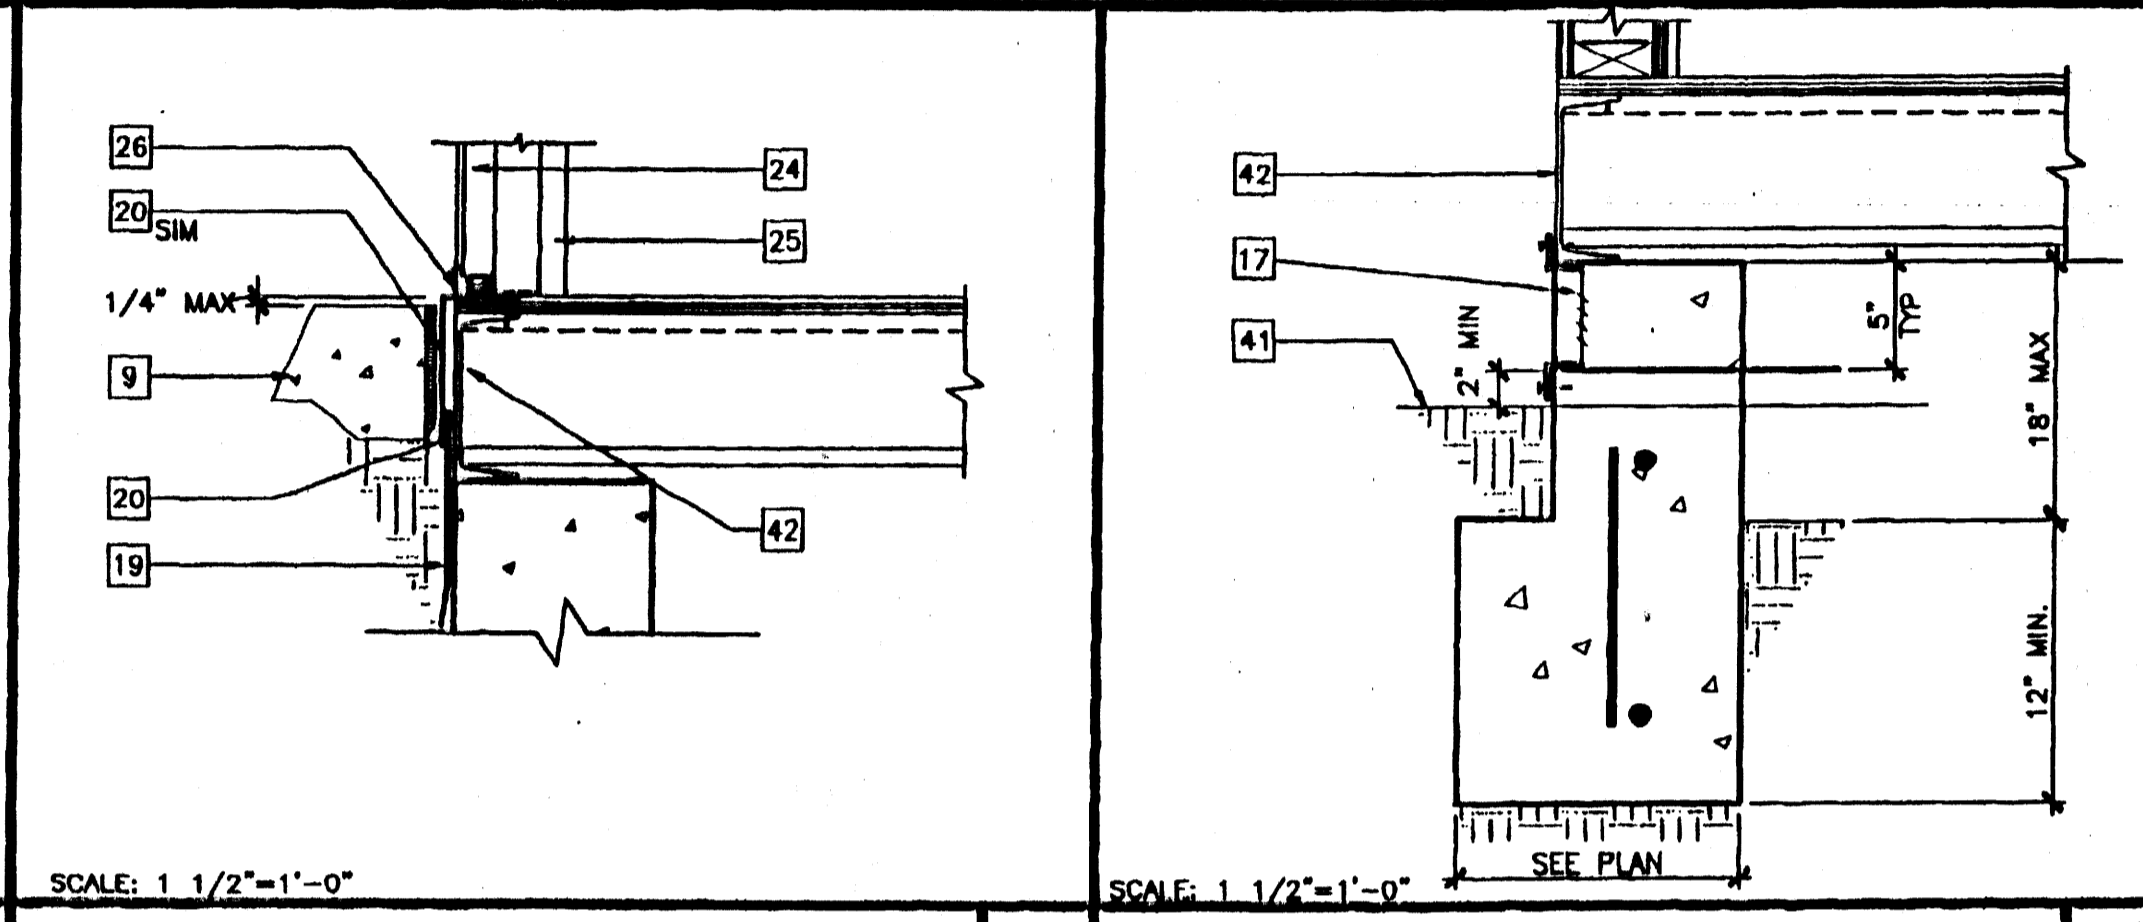

SCALE: 1 1/2"=1'-0"

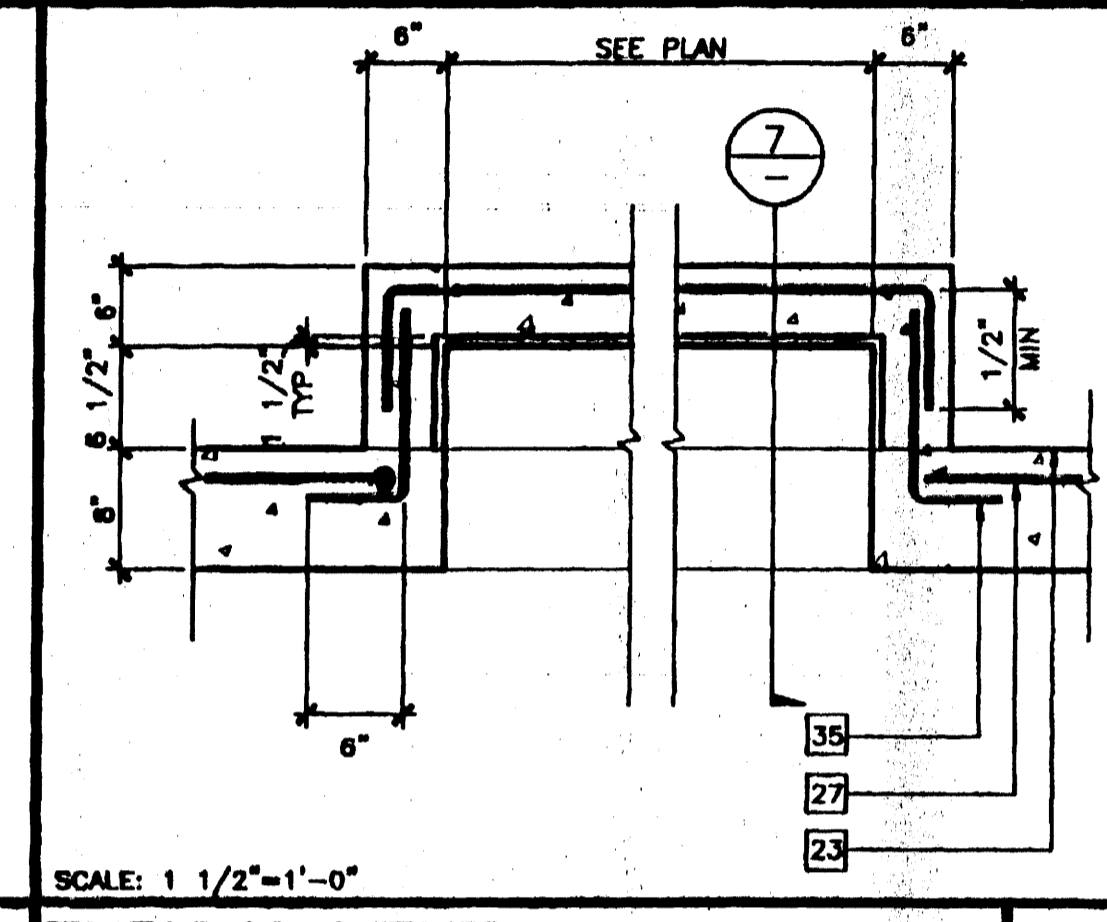

SCALE: 1 1/2"=1'-0"

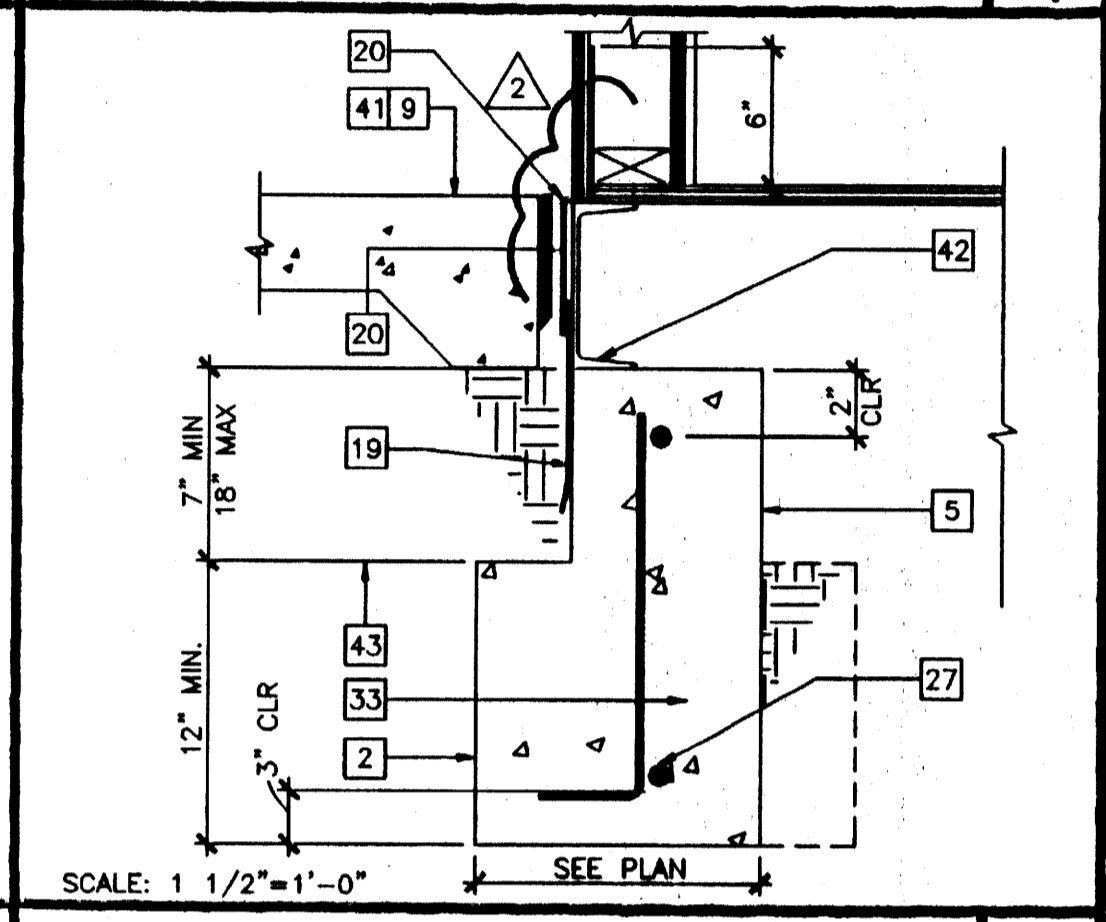


SCALE: 1 1/2"=1'-0"

ANCHOR BOLT AT ADJACENT BUILDING


17 CURB AND WALKWAY AND DOOR

10 ALTERNATE VENT AT ABOVE GRADE CONDITION


6 TYPICAL SIDEWALL FOOTING

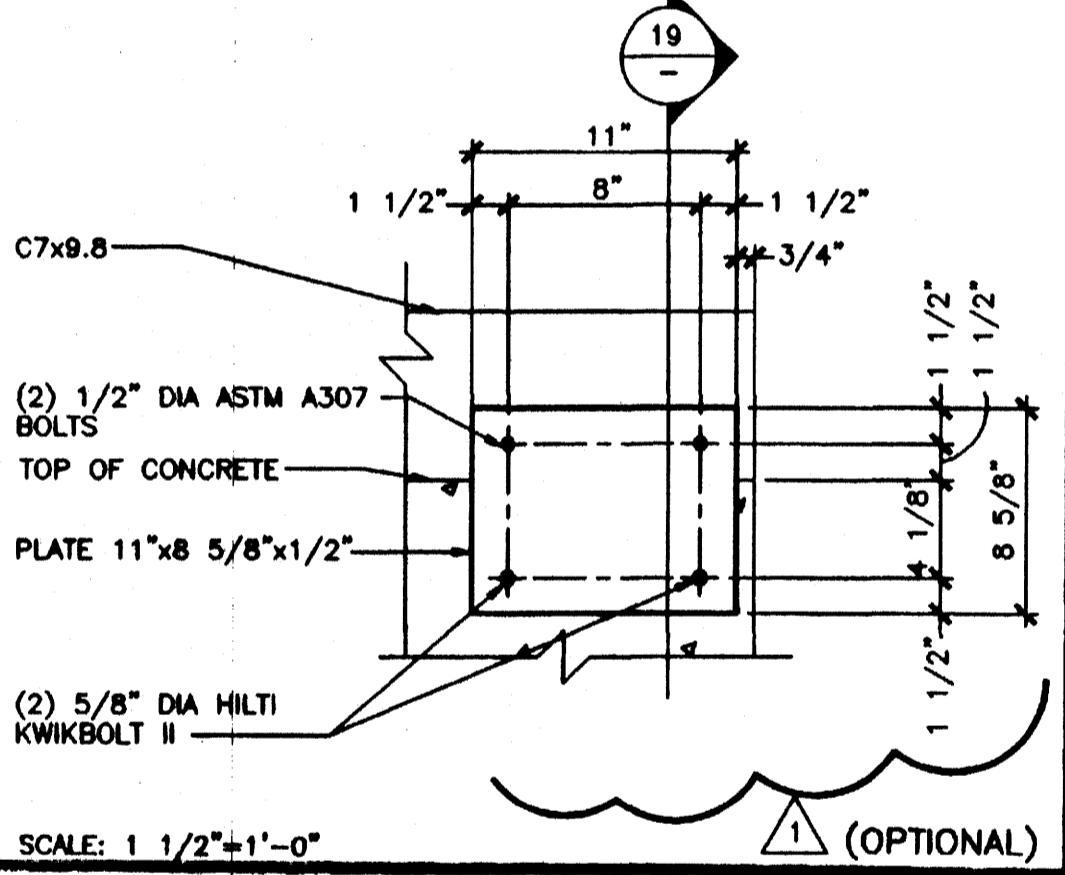


SCALE: 1 1/2"=1'-0" (OPTIONAL)

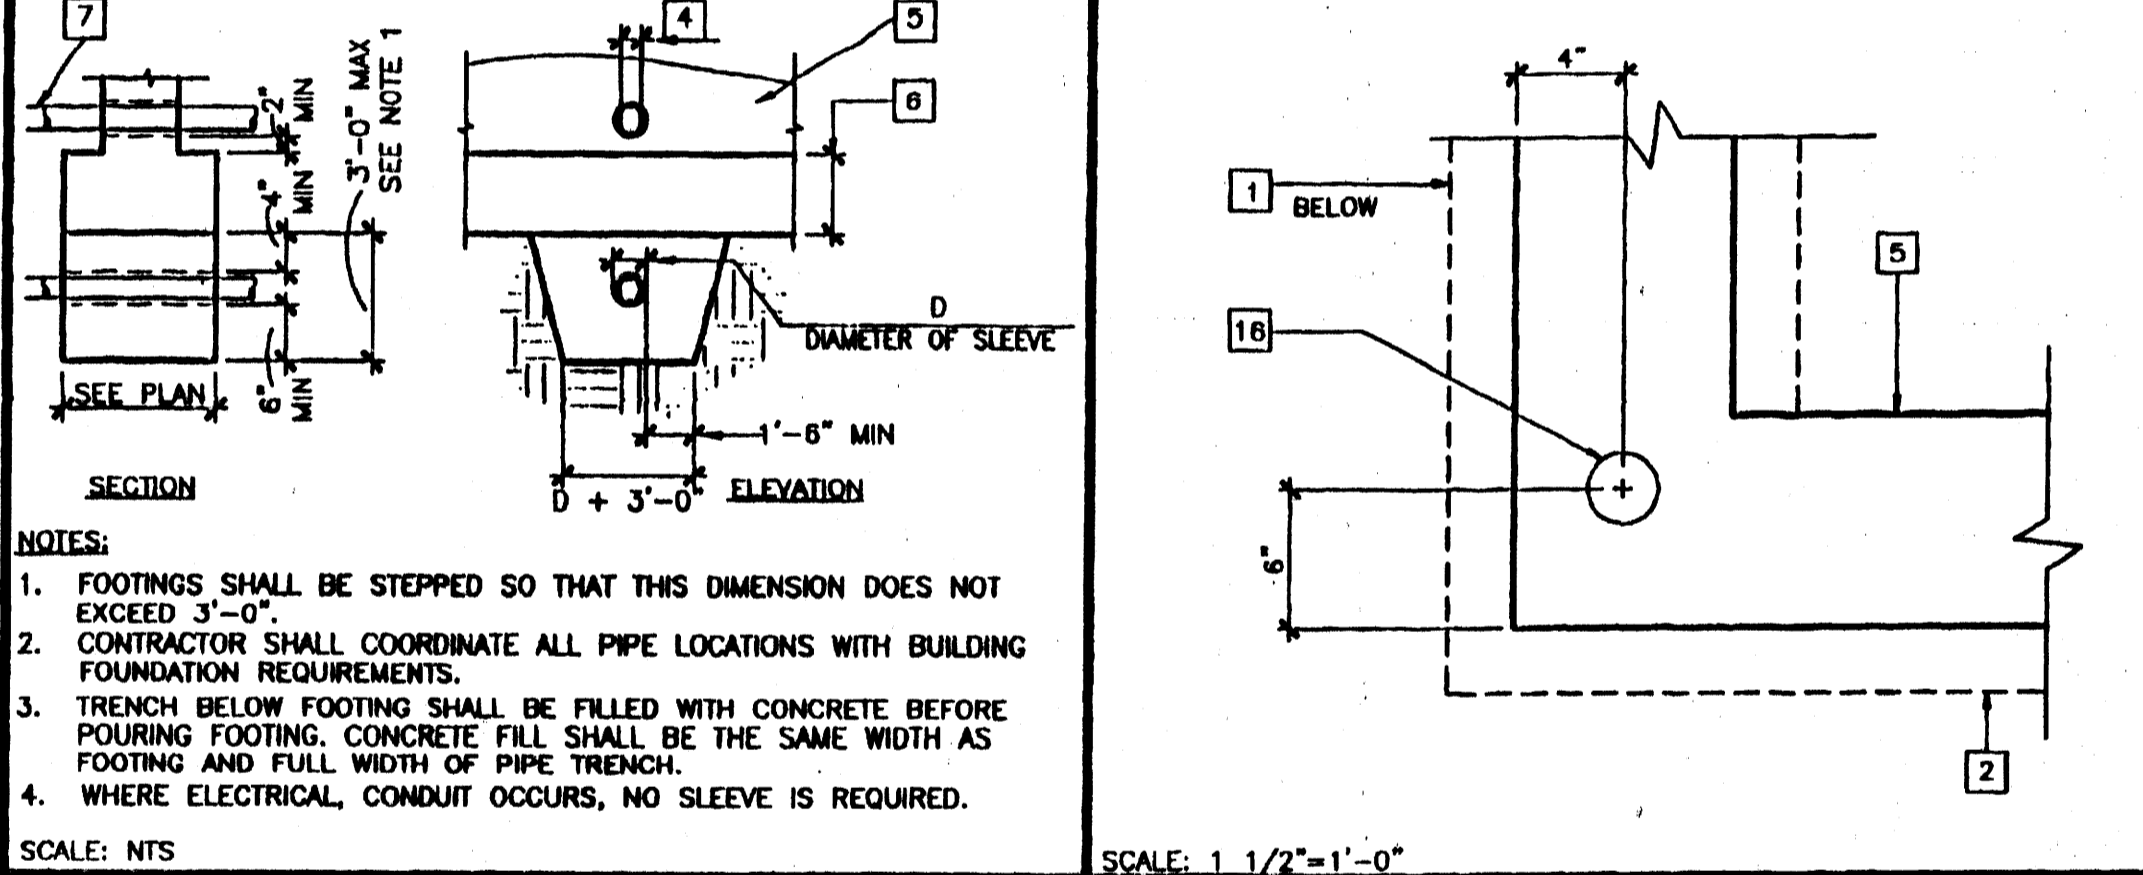

SCALE: NTS

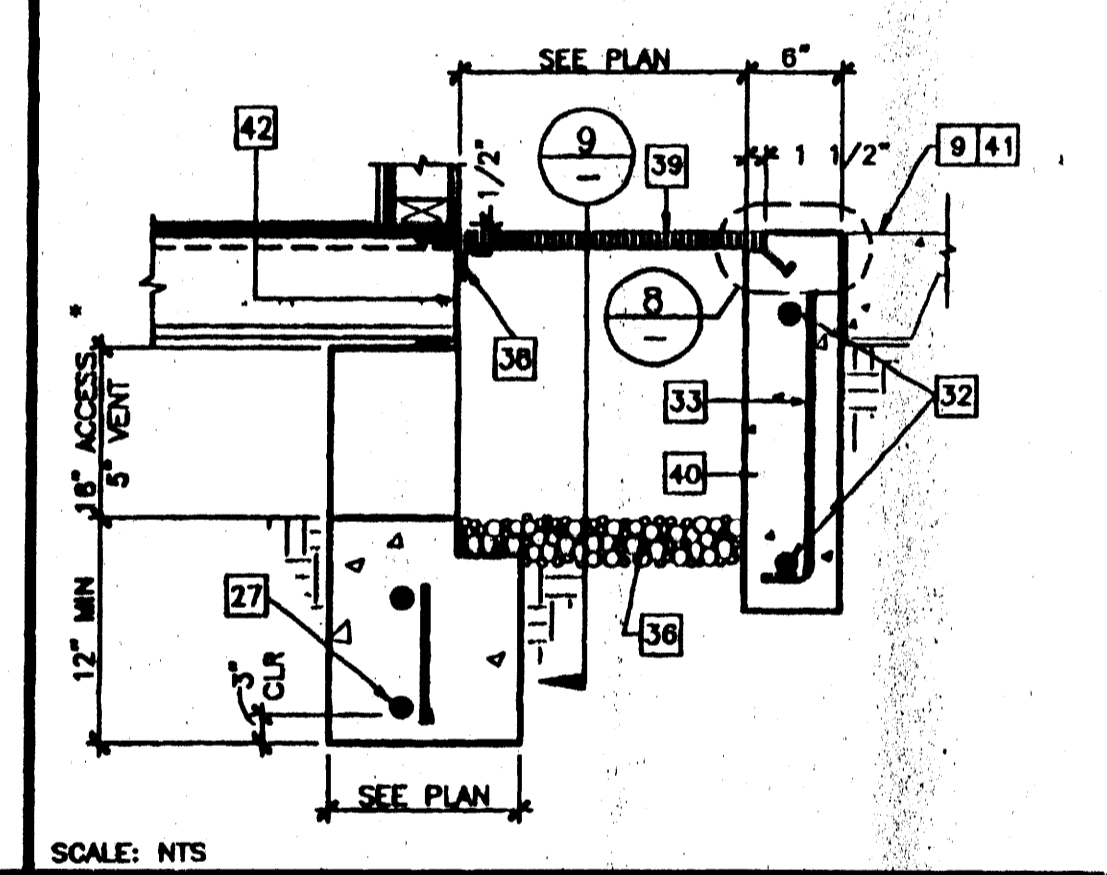

SCALE: 1 1/2"=1'-0"

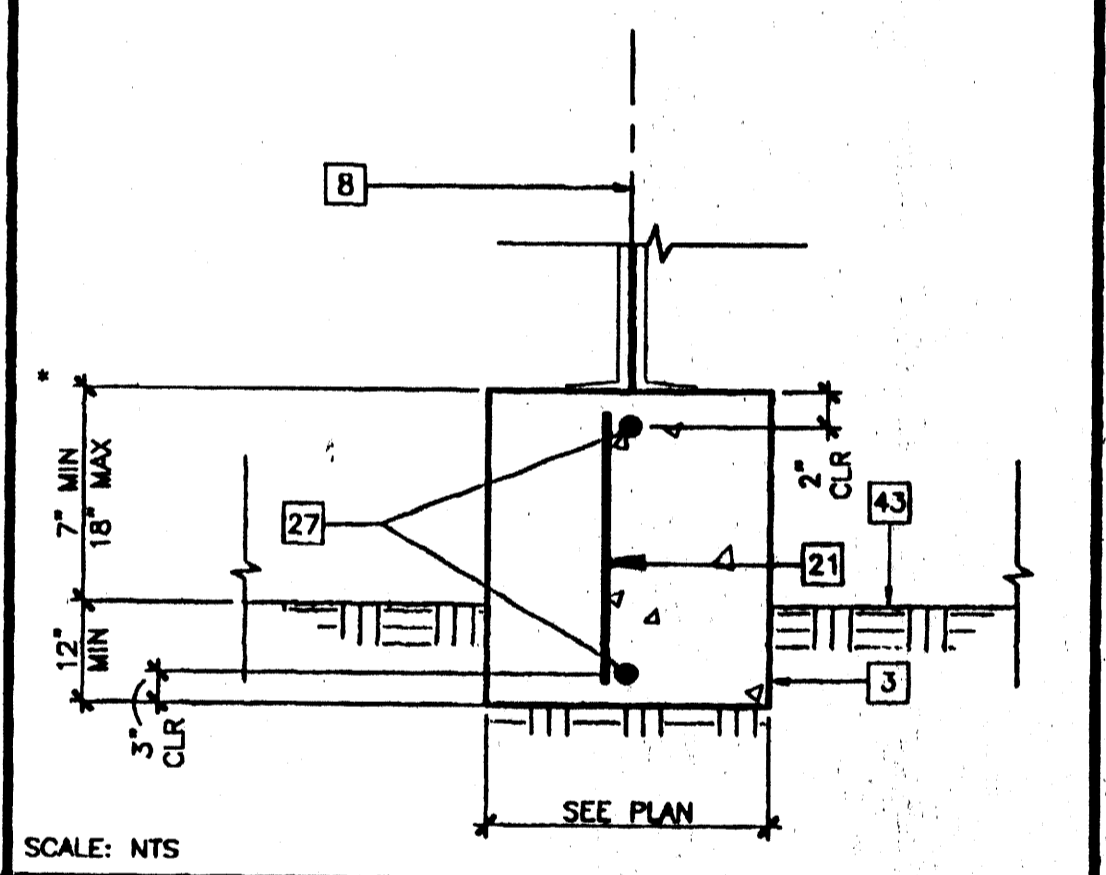


SCALE: NTS

ALTERNATE FOUNDATION ANCHORAGE


18 PIPES PERPENDICULAR TO FOOTINGS

11 ANCHOR BOLT AT CORNER


7 ACCESS / VENT SECTION

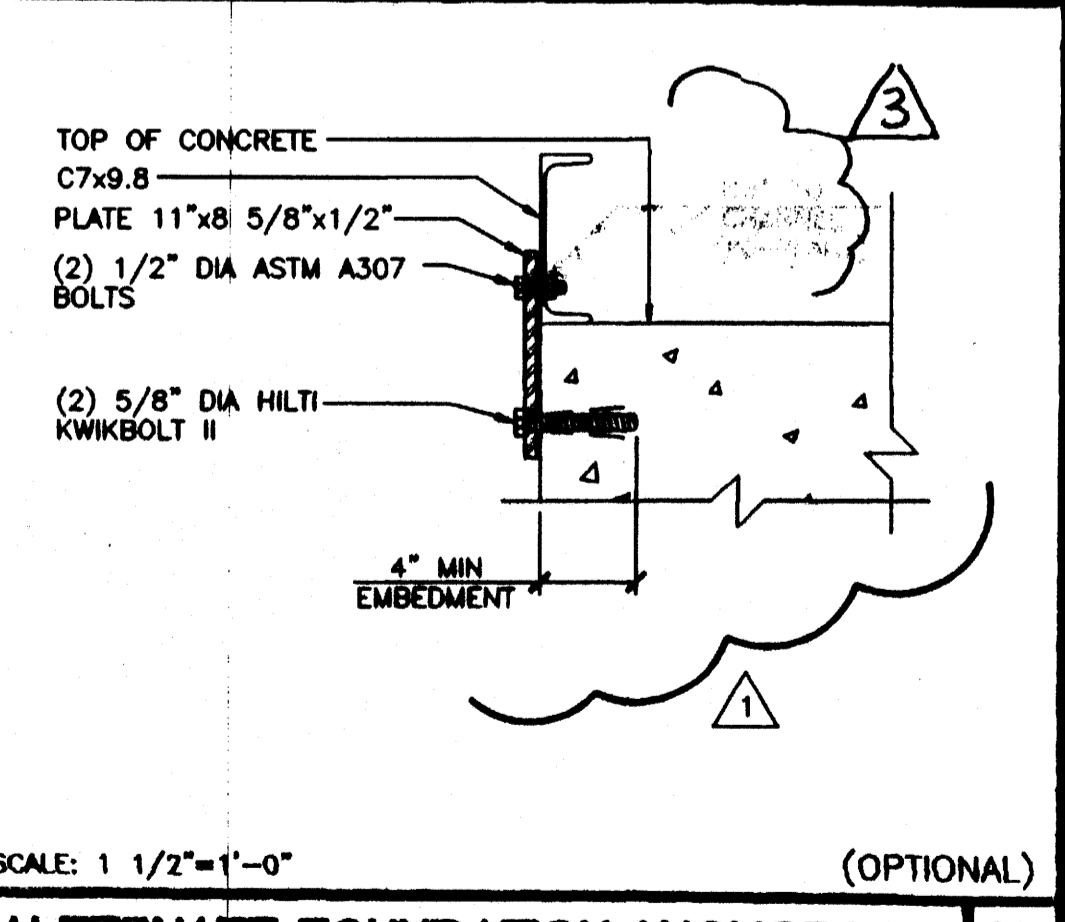


SCALE: 1 1/2"=1'-0" (OPTIONAL)

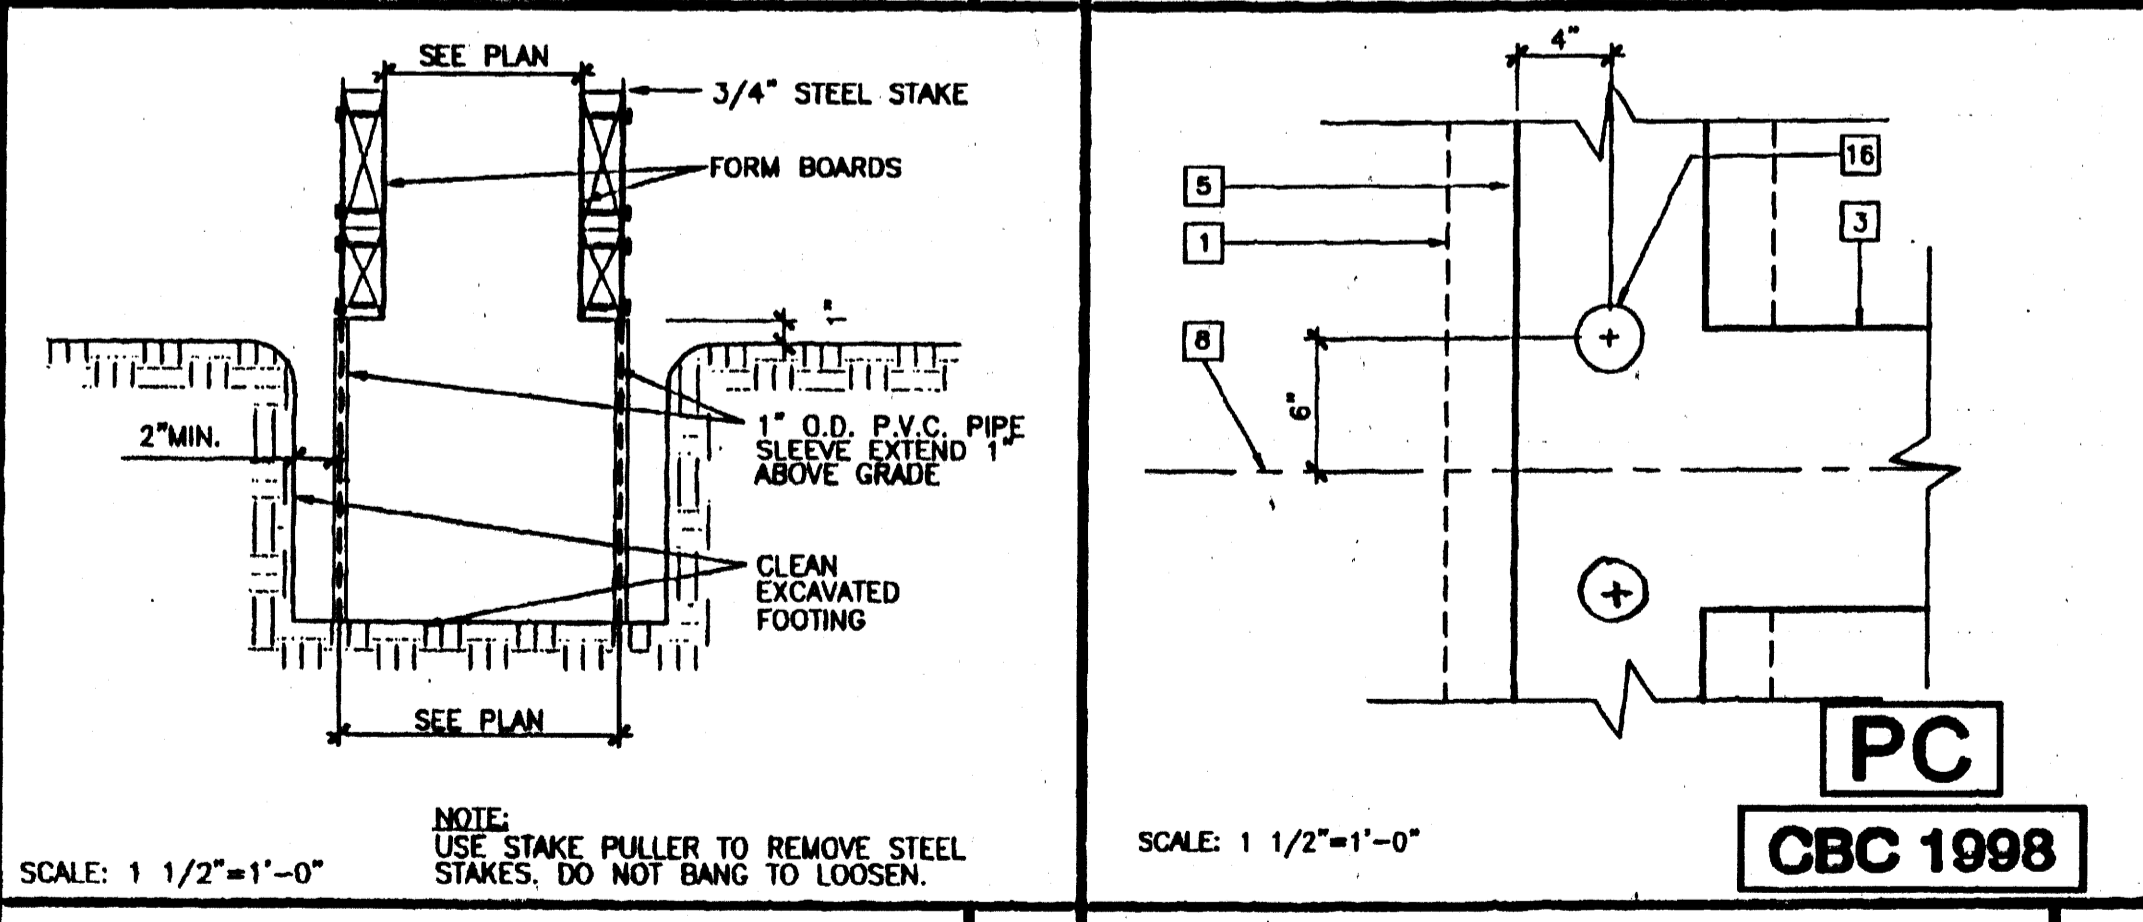

SCALE: 1 1/2"=1'-0"

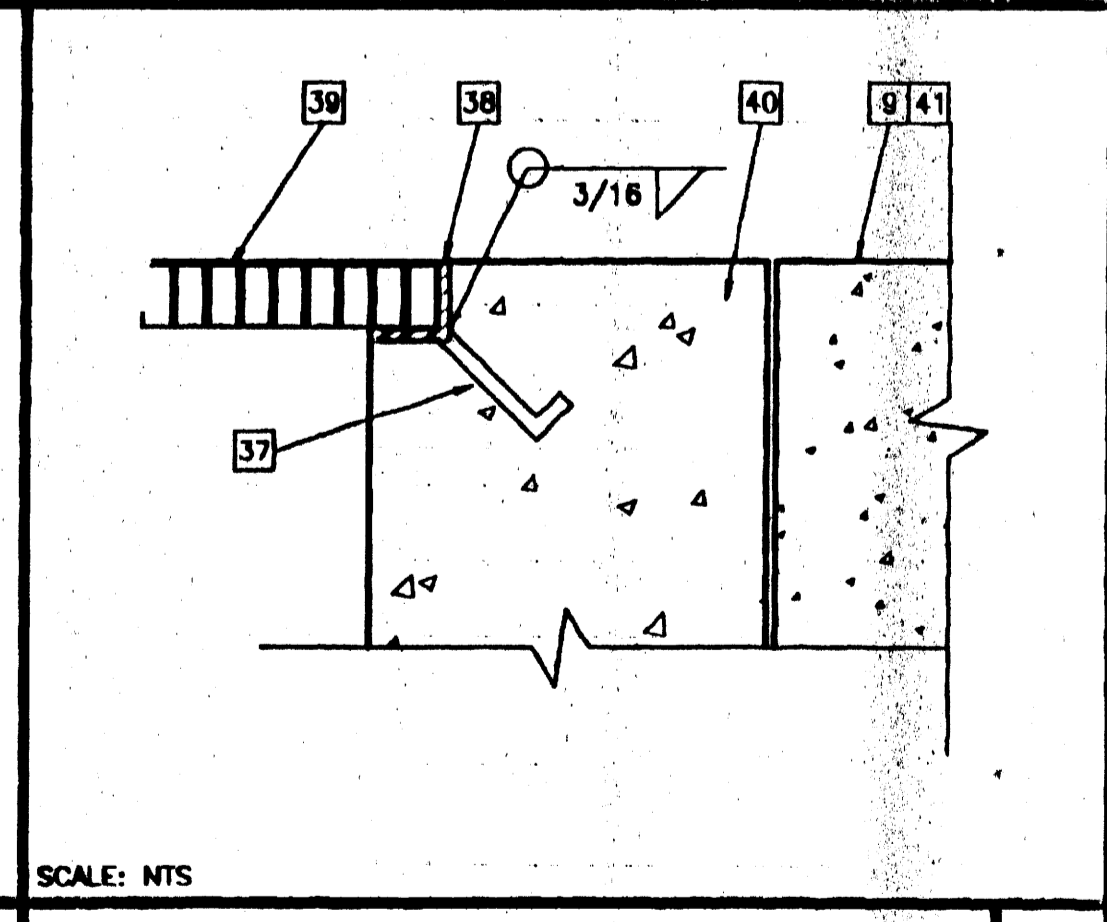

SCALE: NTS

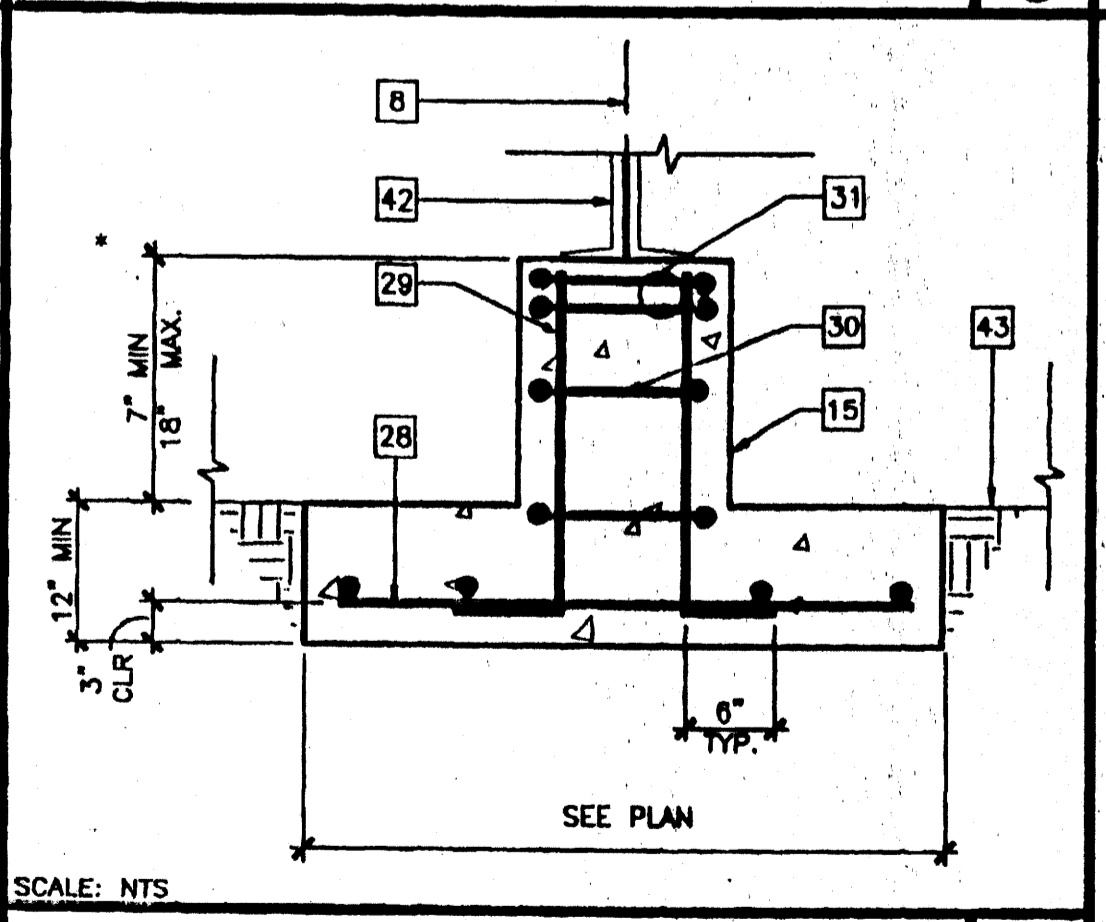

SCALE: NTS

ALTERNATE FOUNDATION ANCHORAGE

19 FOOTING FORMS - TEMPORARY

12 GRATING SUPPORT

8 INTERIOR PAD FOOTING

NOTES

* 1. 11" MINIMUM 30" MAXIMUM FOR ALL BUILDINGS - 2160 SQUARE FEET OR OVER

IDENTIFICATION STAMP
 DIV. OF THE STATE ARCHITECT
 OFFICE OF REGULATION SERVICES
 04 104812
 AC - FLS SS
 DATE DEC 05 2002

REVISED MAY 3 2001
 REVISED JAN 4 2001
 REVISED OCT 19 2000

REVISIONS	DESCRIPTION	DATE
SP	MODTECH ENGINEERING CHANGE	9/21/00
SP	MODTECH ENGINEERING CHANGE	09/28/00
SP	MODTECH FIX	10/10/00
FVH	CHANGE 3/4 TO 3/8 BOLT	5/30/01

Electrical Engineer's Seal
 Mechanical Engineer's Seal
 Structural Engineer's Seal
 Architect's Seal

IDENTIFICATION STAMP
 DIV. OF THE STATE ARCHITECT
 OFFICE OF REGULATION SERVICES
 PC-04
 101268
 AC - FLS SS
 DATE SEP 17 2000
 REVISED OCT 02 2000

MODTECH INC.
 2830 BARRETT AVENUE
 PERRIS, CALIF. 92572
 PH (909) 943-4014
 FAX (909) 940-0427

PROJECT NUMBER: 4373
 COLTON U.S.D.
 © MODTECH, INC. 2002

DRAWN BY: KK
 DATE: 11/19/02
 CHECKED BY: STKP-67
 DATE: 4/02-124
 MODTECH Project No.
F3.11

FOUNDATION DETAILS BELOW GRADE CONCRETE

FILE PATH: 2440-F3.11.DWG PROJECT NO. 4373

KEY NOTES


- 1 AC1: WALL MOUNT 3.5 TON HEAT PUMP WITH 5KW HEATER OLA AND CALIFORNIA STATE ENERGY APPROVED 208/230V, 1 PHASE, 59 AMP WEIGHT 515 LBS
- 2 THERMOSTAT AT 48" AFF (SEE SPECS)
- 3 FLEX DUCT
- 4 15"x15" 4 WAY SUPPLY AIR GRILLE
- 5 10"x30"x24" PLENUM (SEE SPECS)

NOTES

1. INSULATION APPLIED TO EXTERIOR SURFACE OF DUCTS LOCATED IN BLDGS SHALL HAVE A FLAME SPREAD OF NOT MORE THAN 25 AND A SMOKE-DENSITY NOT EXCEEDING 50 WHEN TESTED AS A COMPOSITE INSTALLATION. INCLUDING INSULATION, FACING MATERIALS, TAPES AND ADHESIVES AS NORMALLY APPLIED
2. SCHOOL EQUIPMENT ANCHORAGE
 THE FOLLOWING IS FOR THE MECHANICAL ENGINEER'S INFORMATION ONLY:
 THE SEISMIC ANCHORAGE OF MECHANICAL EQUIPMENT SHALL CONFORM CCR TITLE 24, SECTION 1632A AND TABLE 16A-0. ANCHORAGE DETAILS FOR ROOF/FLOOR MOUNTED EQUIPMENT WEIGHING LESS THAN 400 LBS AND HUNG EQUIPMENT WEIGHING LESS THAN 20 LBS. MAY BE OMITTED FROM THE PLANS.
 ALL MECHANICAL EQUIPMENT SHALL BE BRACED OR ANCHORED TO RESIST A HORIZONTAL FORCE ACTING IN ANY DIRECTION USING THE FOLLOWING CRITERIA:

EQUIPMENT ON GRADE	20% OF OPERATING WEIGHT
EQUIPMENT ON STRUCTURE	30% OF OPERATING WEIGHT

 FOR FLEXIBLY MOUNTED EQUIPMENT USE 4 TIMES THE ABOVE VALUES AND FOR SIMULTANEOUS VERTICAL FORCE USE 1/3 TIMES THE HORIZONTAL FORCE.
 THE ABOVE VALUES ARE FOR AN IMPORTANCE FACTOR, I = 1.0 AND SEISMIC ZONE, Z = 4
 WHERE ANCHORAGE DETAILS ARE NOT SHOWN ON THE DRAWINGS THE FIELD INSTALLATION SHALL BE SUBJECT TO THE APPROVAL OF THE MECHANICAL ENGINEER AND THE FIELD ENGINEER OF THE OFFICE OF THE STATE ARCHITECT.

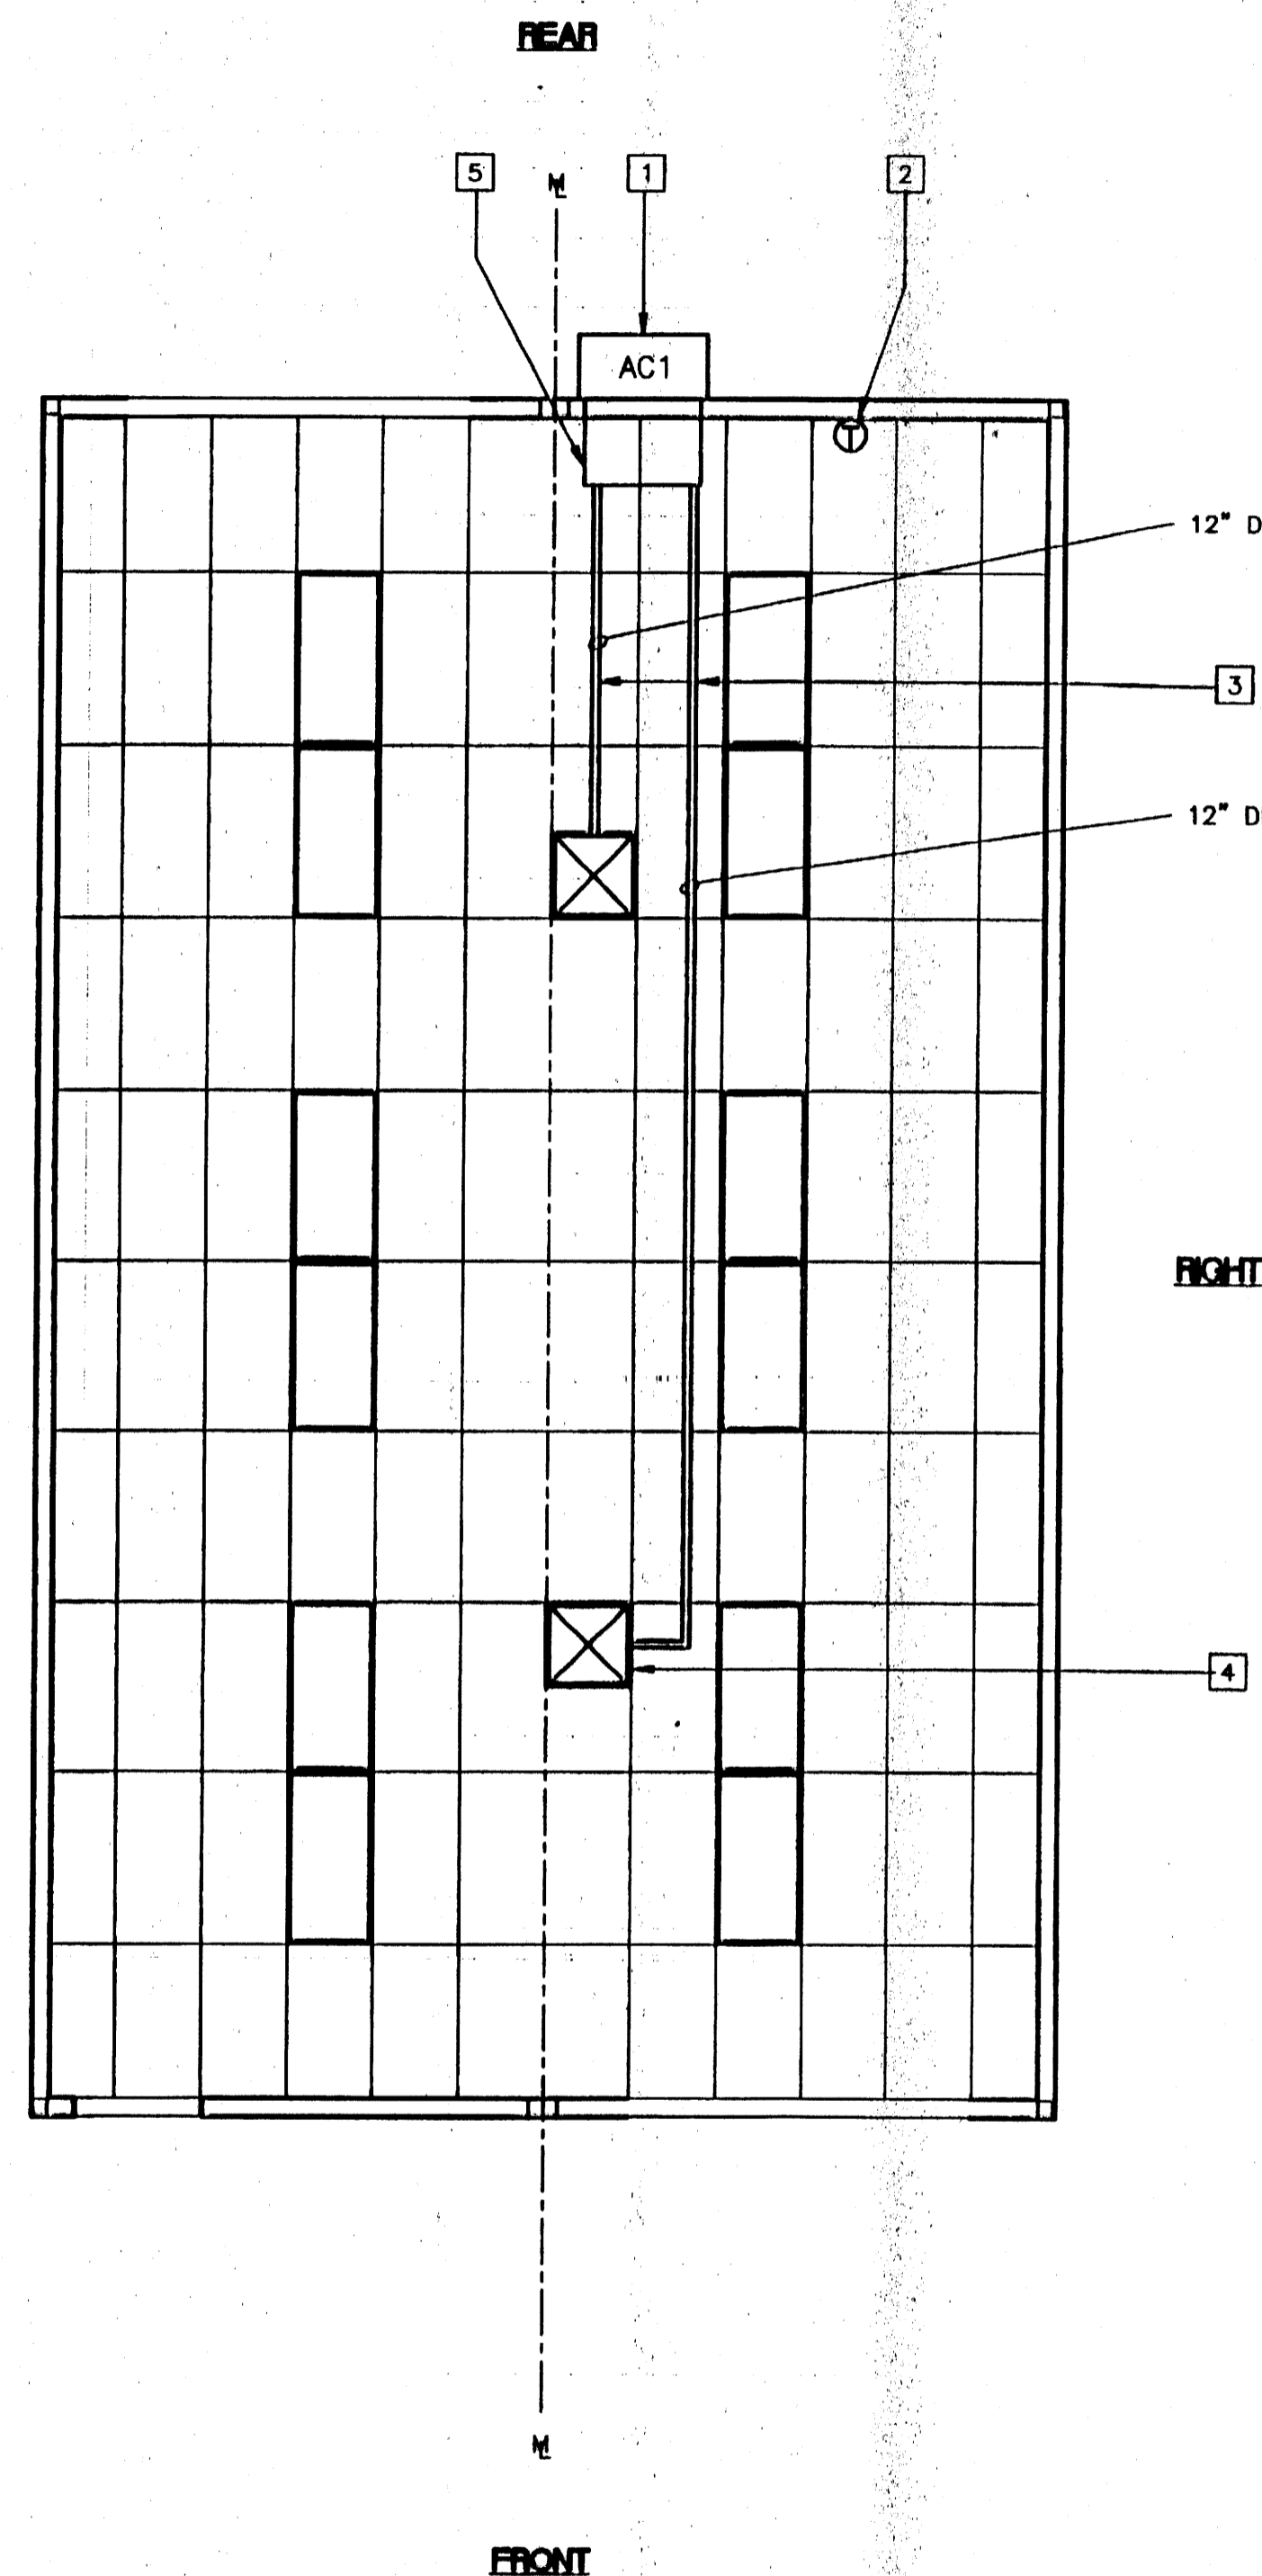



MECHANICAL (HVAC) PLAN

(24'x40')

SCALE: 1/4" = 1'-0"

PC

CBC 1998

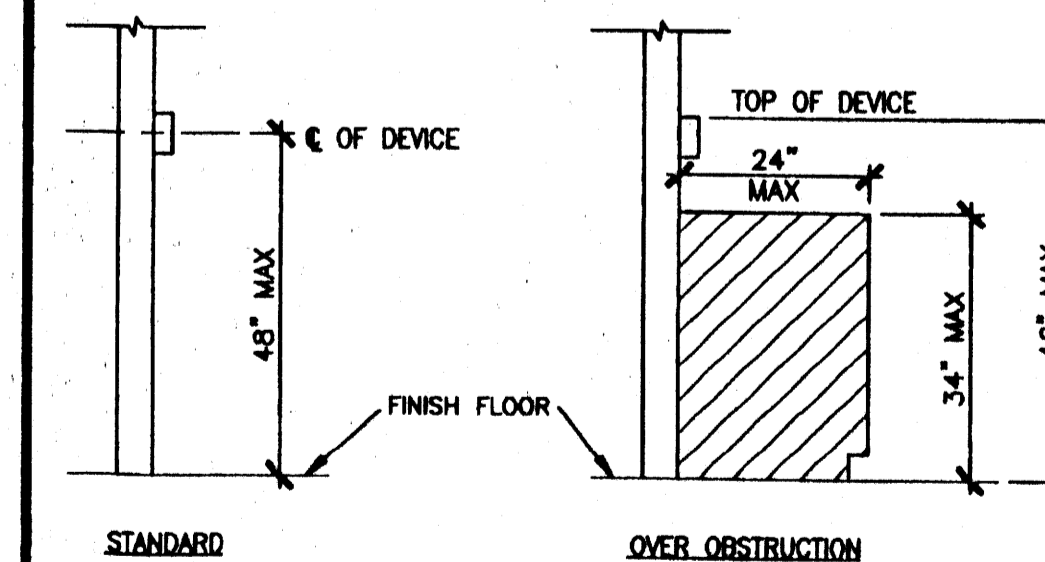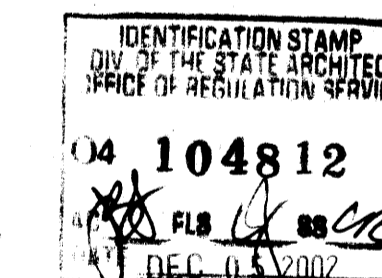

DEVICE MOUNTING


1

REVISIONS			
SP	MODTECH ENGINEERING CHANGE	DATE	
1			
2			
3			
4			
5			


Electrical Engineer's Seal

Mechanical Engineer's Seal

Structural Engineer's Seal

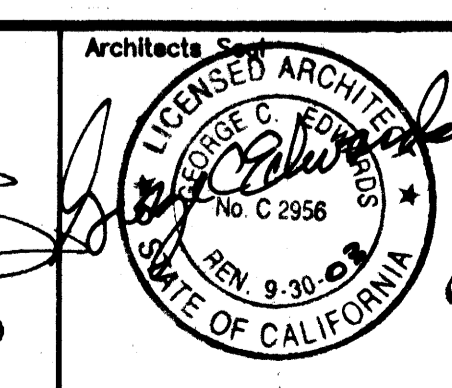

IDENTIFICATION STAMP
 DIV. OF THE STATE ARCHITECT
 OFFICE OF REGULATION SERVICES
 PC-04
 101268
 AC: [Signature]
 DATE: 08/07/00
 REVISED

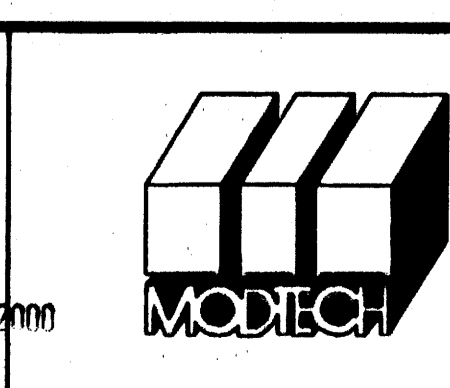

MODTECH INC.
 2830 BARRETT AVENUE
 PERRIS, CALIF. 92572
 PH (909) 943-4014
 FAX (909) 940-0427

PROJECT NUMBER: 4373
 COLTON U.S.D.
 © MODTECH, INC. 2002

DRAWN BY: KK
 DATE: 11/19/02
 CHECKED BY: STKP-67
 DATE: 01/12/04
 MODTECH Index No.
M1.01


MECHANICAL (HVAC) PLAN

24'x40' **M1.01**


FILE PATH: 2440-M1.01.DWG PROJECT NO. 4373 PC-04-101268

KEY NOTES

- 1 AC1: WALL MNT. BARO 3.5 TON HEAT PUMP WITH 5KW HEATER OLA AND CALIFORNIA STATE ENERGY APPROVED 208/230V, 1 PHASE, 28 AMP WEIGHT 510 LBS
- 2 ENERGY MANAGEMENT SYS. CONTROLS PER CHINO U.S.D. PARKER-CORNER THERMOSTAT M301E SEE 4/6101
- 3 FLEX DUCT
- 4 15"x15" 4 WAY SUPPLY AIR GRILLE
- 5 10"x30"x24" PLENUM (SEE SPECS)

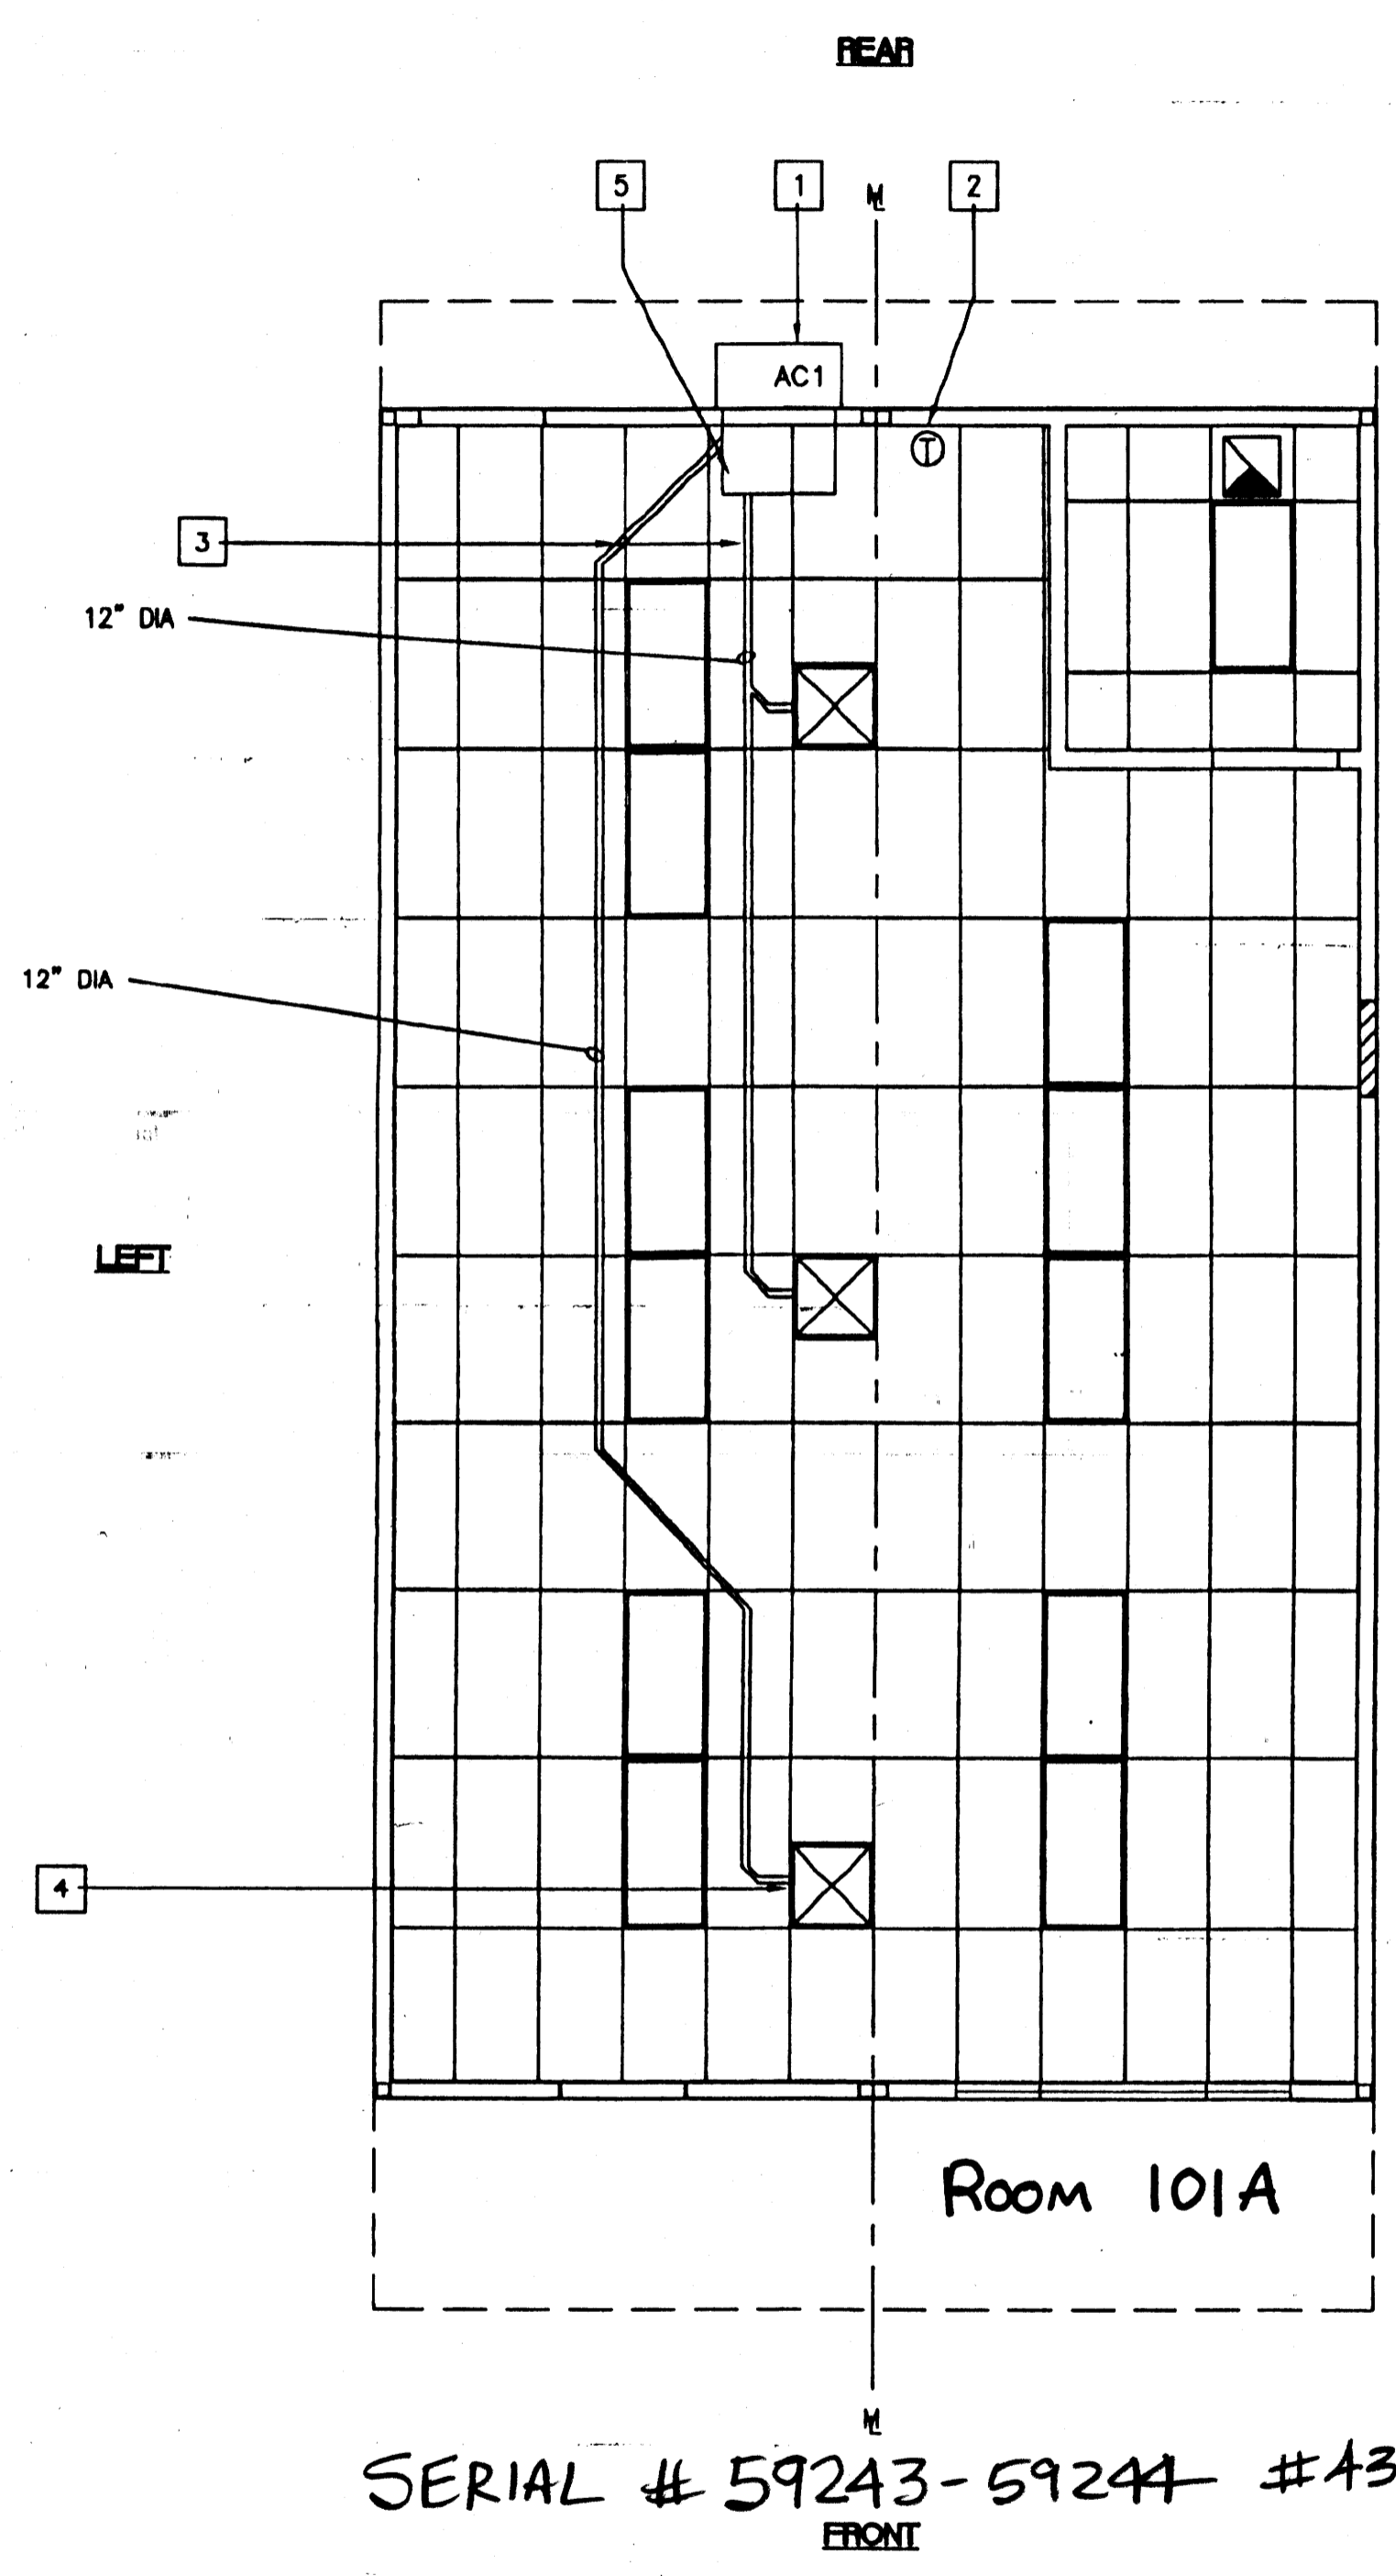


SERIAL # 59243-59244 #4384

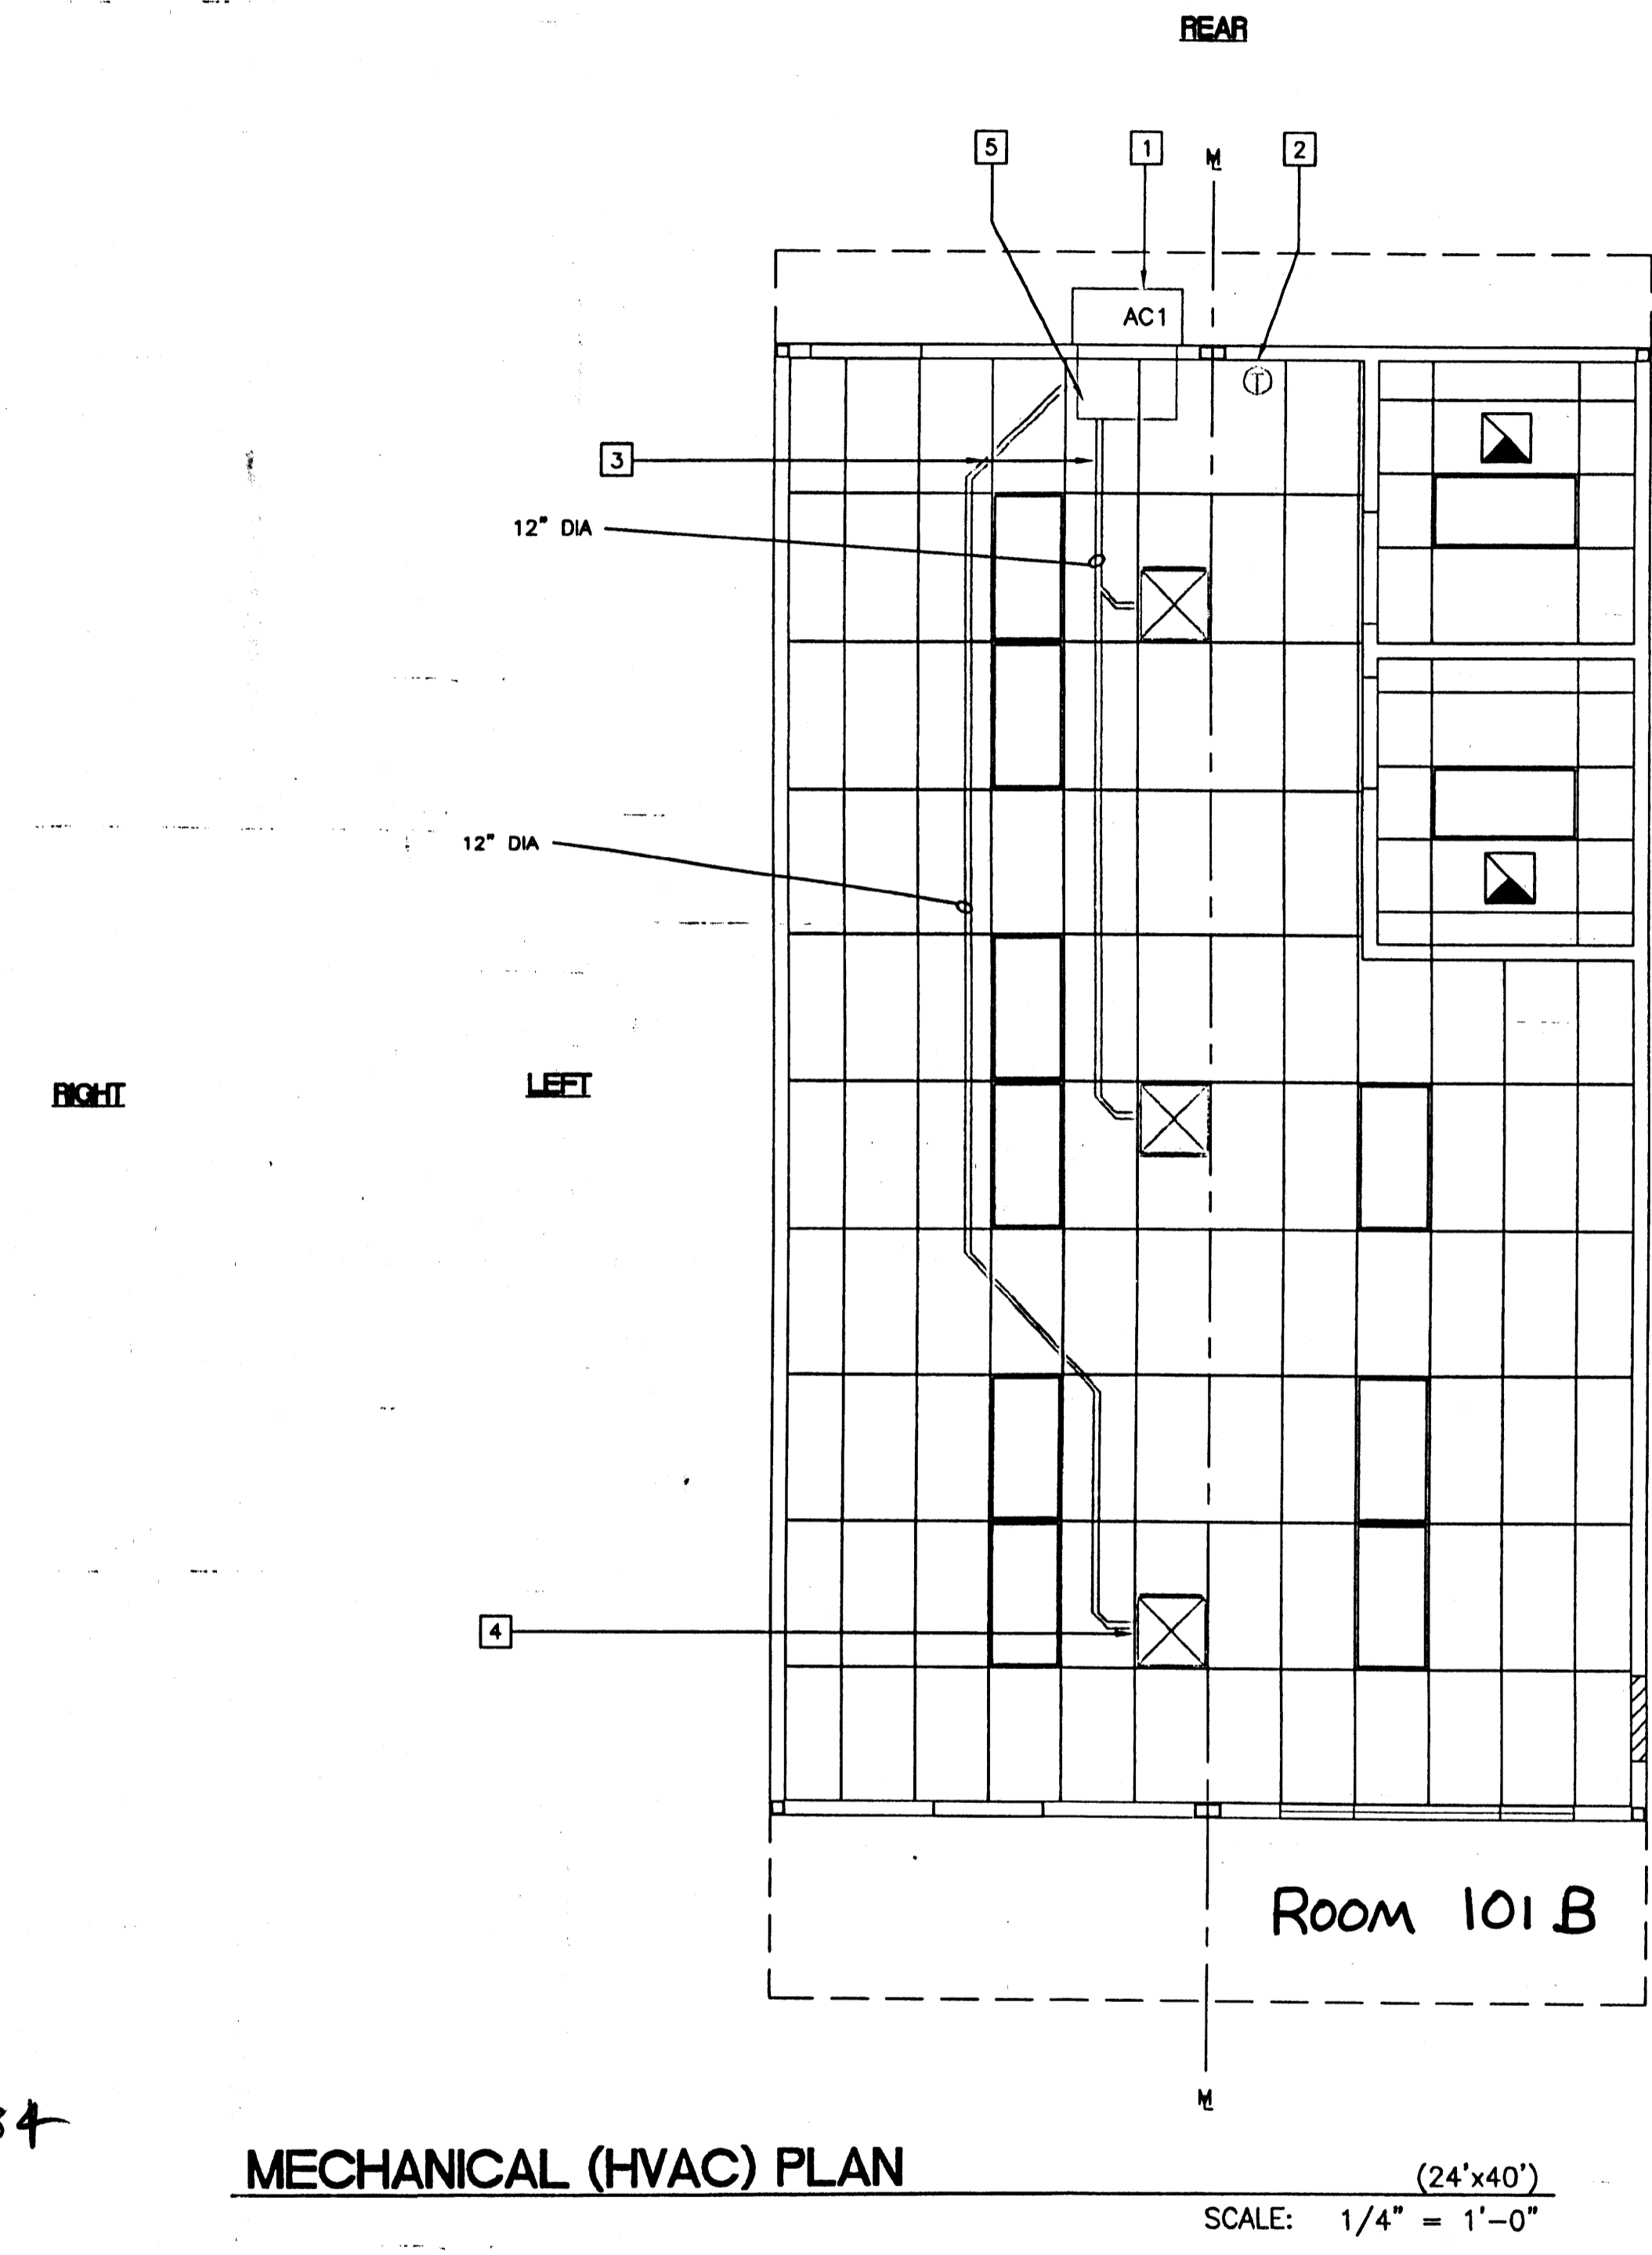

MECHANICAL (HVAC) PLAN (24'x40')
SCALE: 1/4" = 1'-0"

REVISED
IDENTIFICATION STAMP
DIV. OF THE STATE ARCHITECT
OFFICE OF REGULATION SERVICES
04 104812
AC1 FLS SS
DATE DEC 19 2002

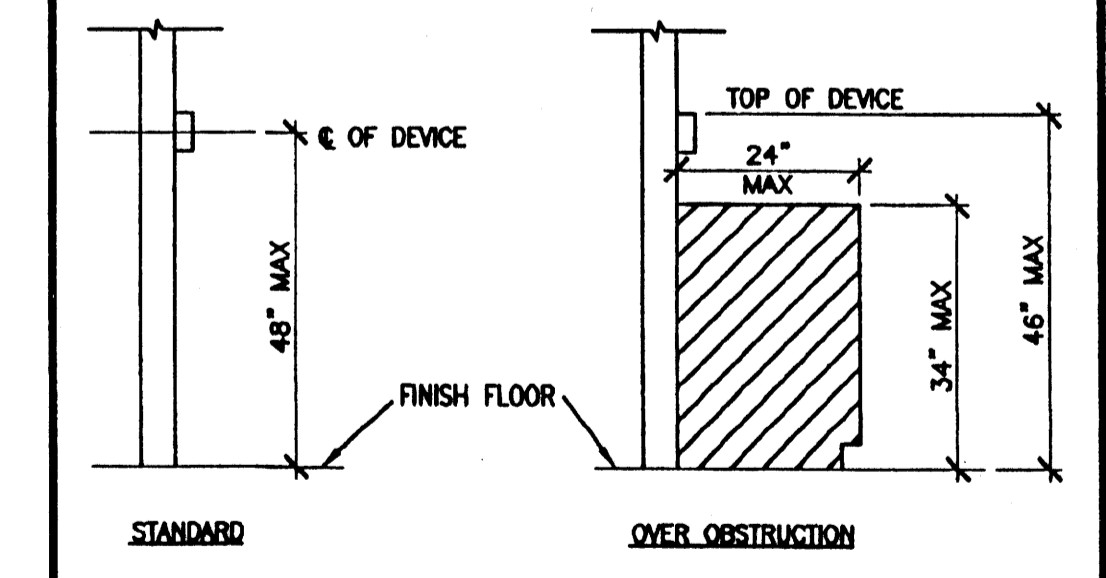

DEVICE MOUNTING 1

REVISIONS	Electrical Engineer's Seal	Mechanical Engineer's Seal	Structural Engineer's Seal	Architect's Seal
1				
2				
3				
4				
5				

BASED ON PC04-101268

IDENTIFICATION STAMP
DIV. OF THE STATE ARCHITECT
OFFICE OF REGULATION SERVICES
PC-04
101268
AC FLS SS
DATE

MODTECH INC.
2830 BARRETT AVENUE
PERRIS, CALIF. 92572
PH (909) 943-4014
FAX (909) 940-0427


PROJECT NUMBER: **4384**
CHINO
CLASS LEASING
© MODTECH, INC. 1999
CLASS LEASING INC STOCKPILE # 67
100-24 x 40 CLASSROOM BUILDINGS
4012-124 12/05/2002 80 MPH

DRAWN BY: SW
DATE: 6/26/01
CHECKED BY:
DATE:
MODTECH Index No.
M1.01 C


MECHANICAL (HVAC) PLAN 24'x40'

PROJECT NO. 3683
FILE PATH: 2440-M1.01.DWG
PC-04-101268

REVISIONS	BY

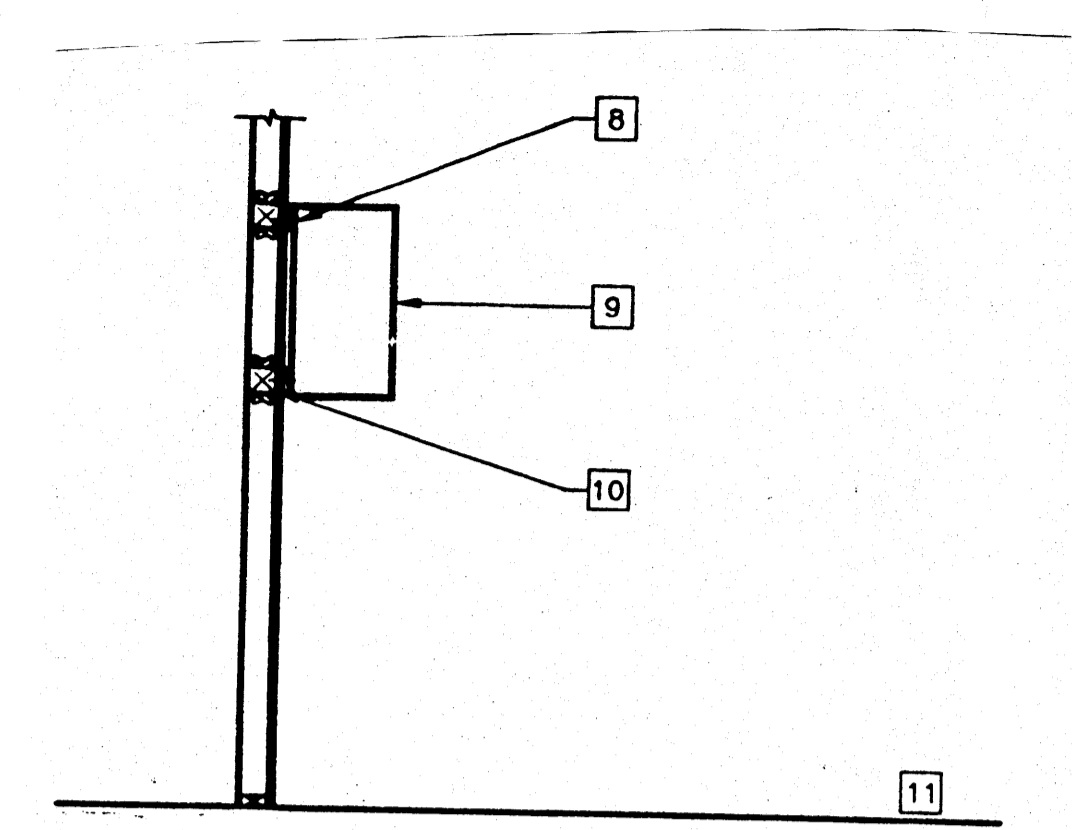


SCALE: NTS (OPTIONAL)
WALL HUNG CABINET ANCHORAGE

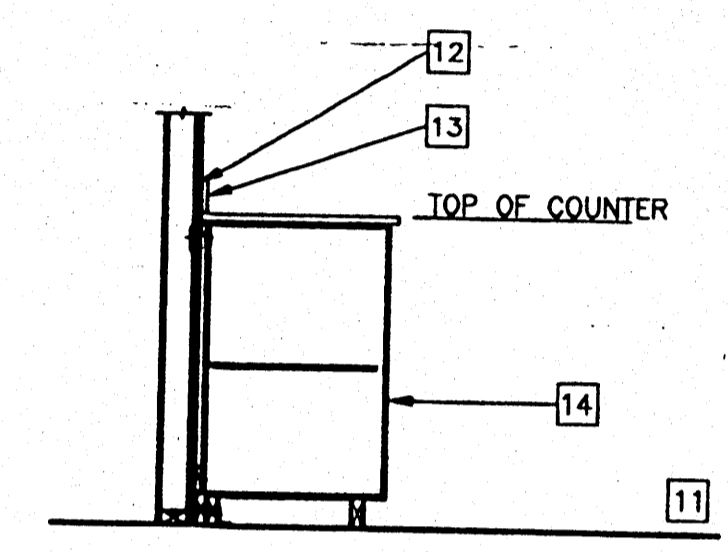

NOTES:
 1. SEE PLANS AND ELEVATIONS FOR EACH SPECIFIC DESIGN.
 2. REMOVE TOE KICK AND BASE FOR ACCESSIBLE CONDITION

SCALE: NTS (OPTIONAL)
BASE CABINET ANCHORAGE

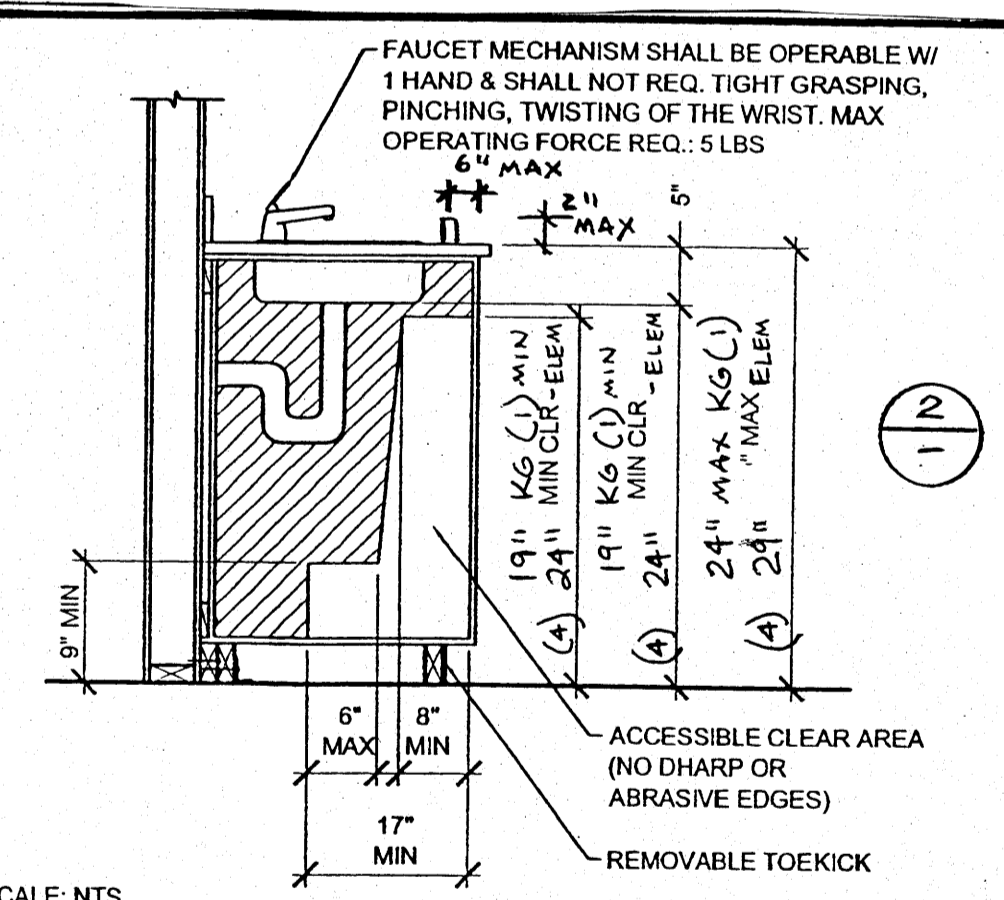

SCALE: NTS
SINK ACCESSIBILITY



DIMENSION	SUGGESTED		
	A (INCHES)	E (INCHES)	K (INCHES)
TOILET CENTERING FROM WALL	18"	15"	12"
TOILET SEAT HEIGHT/DIM TO TOP OF SEAT	7"-19"	15"	10"-12"
GRAB BAR HEIGHT (SIDE)	33"	27"	20"-22"
TOILET PAPER IN FRONT OF TOILET (RECESSED OR SEMI-RECESSED)	12" MAX	6" MAX*	6" MAX*
NAPKIN DISPOSAL IN FRONT OF TOILET	12" MAX	12" MAX	N/A
DISPENSER OR MIRROR HEIGHT	40" MAX	36" MAX	32" MAX
LAVATORY/SINK TOP HEIGHT	34" MAX	29" MAX	24" MAX
LAVATORY/SINK KNEE CLEARANCE	27" MIN	24" MIN	19" MIN
URINAL LIP HEIGHT	17" MAX	15" MAX	13" MAX
URINAL FLUSH HANDLE HEIGHT	44" MAX	37" MAX	32" MAX
DRINKING FOUNTAIN BUBBLER HEIGHT	38" MAX	32" MAX	30" MAX
DRINKING FOUNTAIN KNEE CLEARANCE	27" MIN	24" MIN	22" MIN
RAMP/STAIR HANDRAIL HEIGHT	34"-38"	27"	22"
BUBBLER HEIGHT	2"	3"	6"
SINK DEPTH (FOR CLEARANCE)	7" MAX	5" MAX	5" MAX

A = ADULT DIMENSIONS (AGE 12 AND OVER)
 E = ELEMENTARY DIMENSIONS
 K = KINDERGARTEN AND PRE-SCHOOL DIMENSIONS
 * = DEVIATES FROM CODE REQUIREMENTS AND REQUIRES A WRITTEN FINDING OF UNREASONABLE HARDSHIP
 NOTE: DIMENSIONS FROM 2001 CBC TABLE 1115B-1


ACCESSIBILITY

KEY NOTES

- 1 FAUCET MECHANISM SHALL BE OPERABLE WITH ONE HAND AND SHALL NOT REQUIRE TIGHT GRASPING, PINCHING OR TWISTING OF THE WRIST. MAX OPERATING FORCE REQUIRED: 5lbs.
- 2 ACCESSIBLE CLEAR AREA (NO SHARP OR ABRASIVE EDGES)
- 3 REMOVABLE TOEKICK
- 4 SILL PLATE
- 5 GRADE
- 6 SOV
- 7 BY OTHERS
- 8 #12 WOOD SCREWS MIN. 12" OC MIN 2 1/2" INTO 3x4 BLOCKING
- 9 WALL HUNG CASEWORK
- 10 ANCHORAGE: 3x4 BLOCKING WITH PAIR OF SIMPSON A35 FRAMING CLIPS EACH END OF EACH BLOCK VERIFY VERTICAL SPACING
- 11 FINISH GRADE
- 12 4"x22 GA CONTINUOUS METAL STRAPS WITH #14 STMS AT 24" OC
- 13 BACK SPLASH
- 14 BASE CABINET
- 15 TALL CASEWORK
- 16 TOP SET BASE

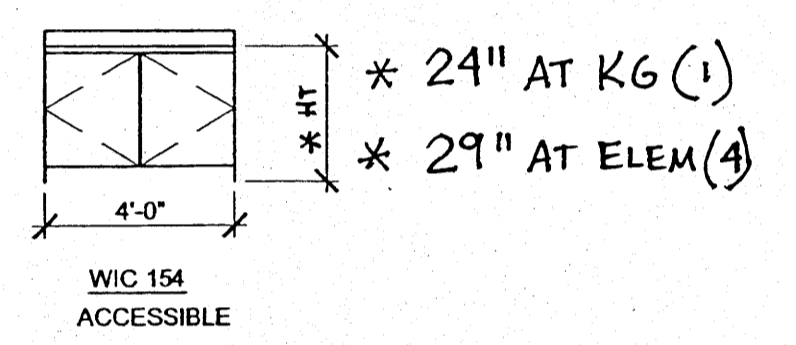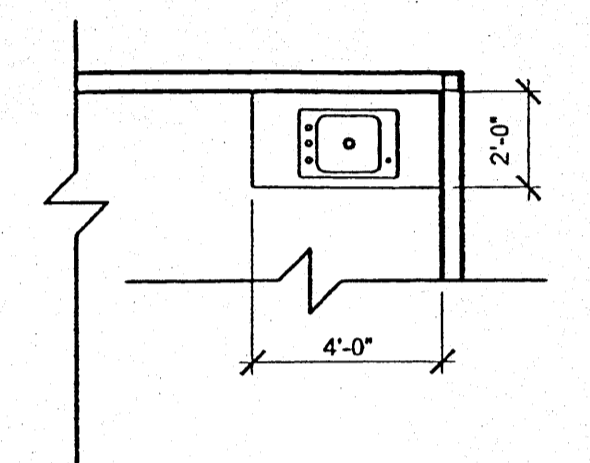


TYPICAL SINK CABINET

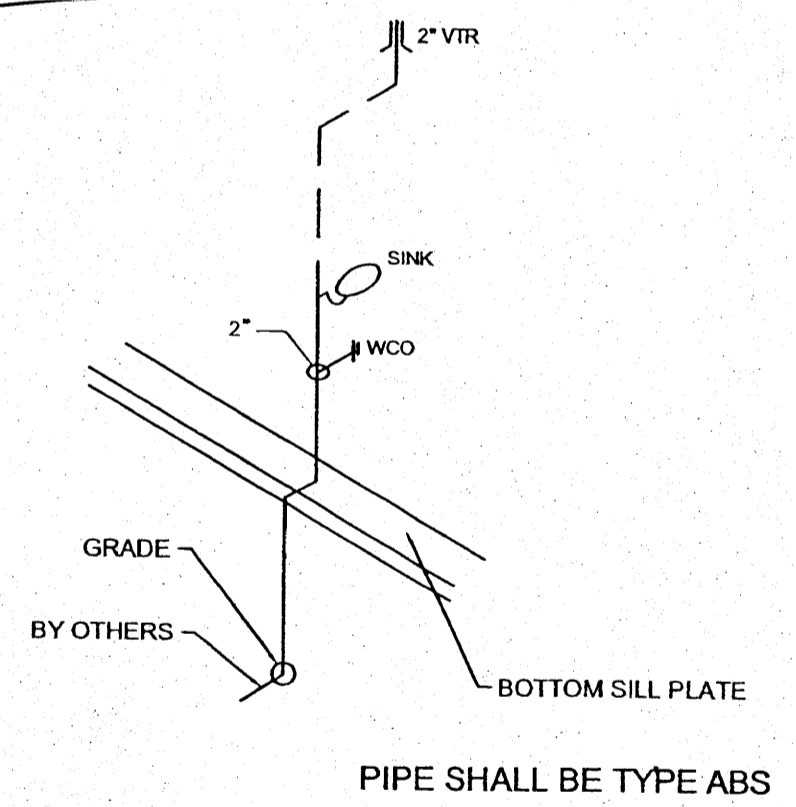


SCALE: NTS PIPE SHALL BE TYPE ABS

SINK CABINET WASTE

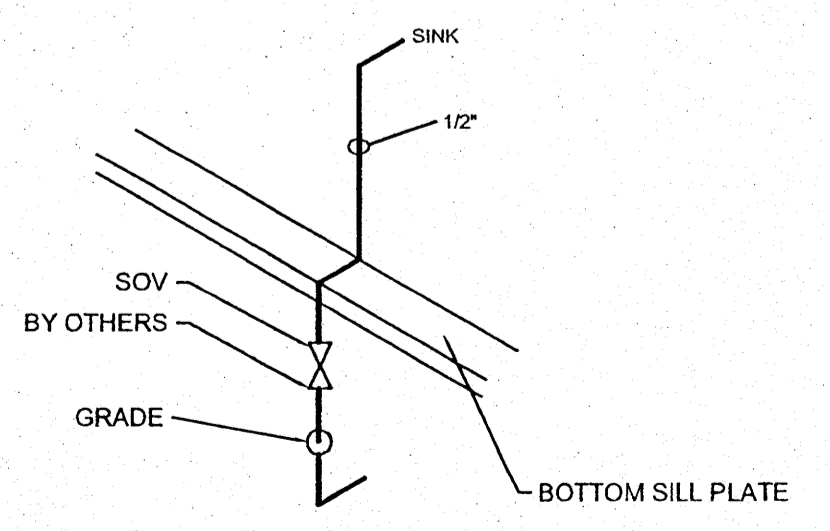


SCALE: NTS PIPE SHALL BE TYPE 1/2" COPPER

SINK CABINET COLD WATER SUPPLY

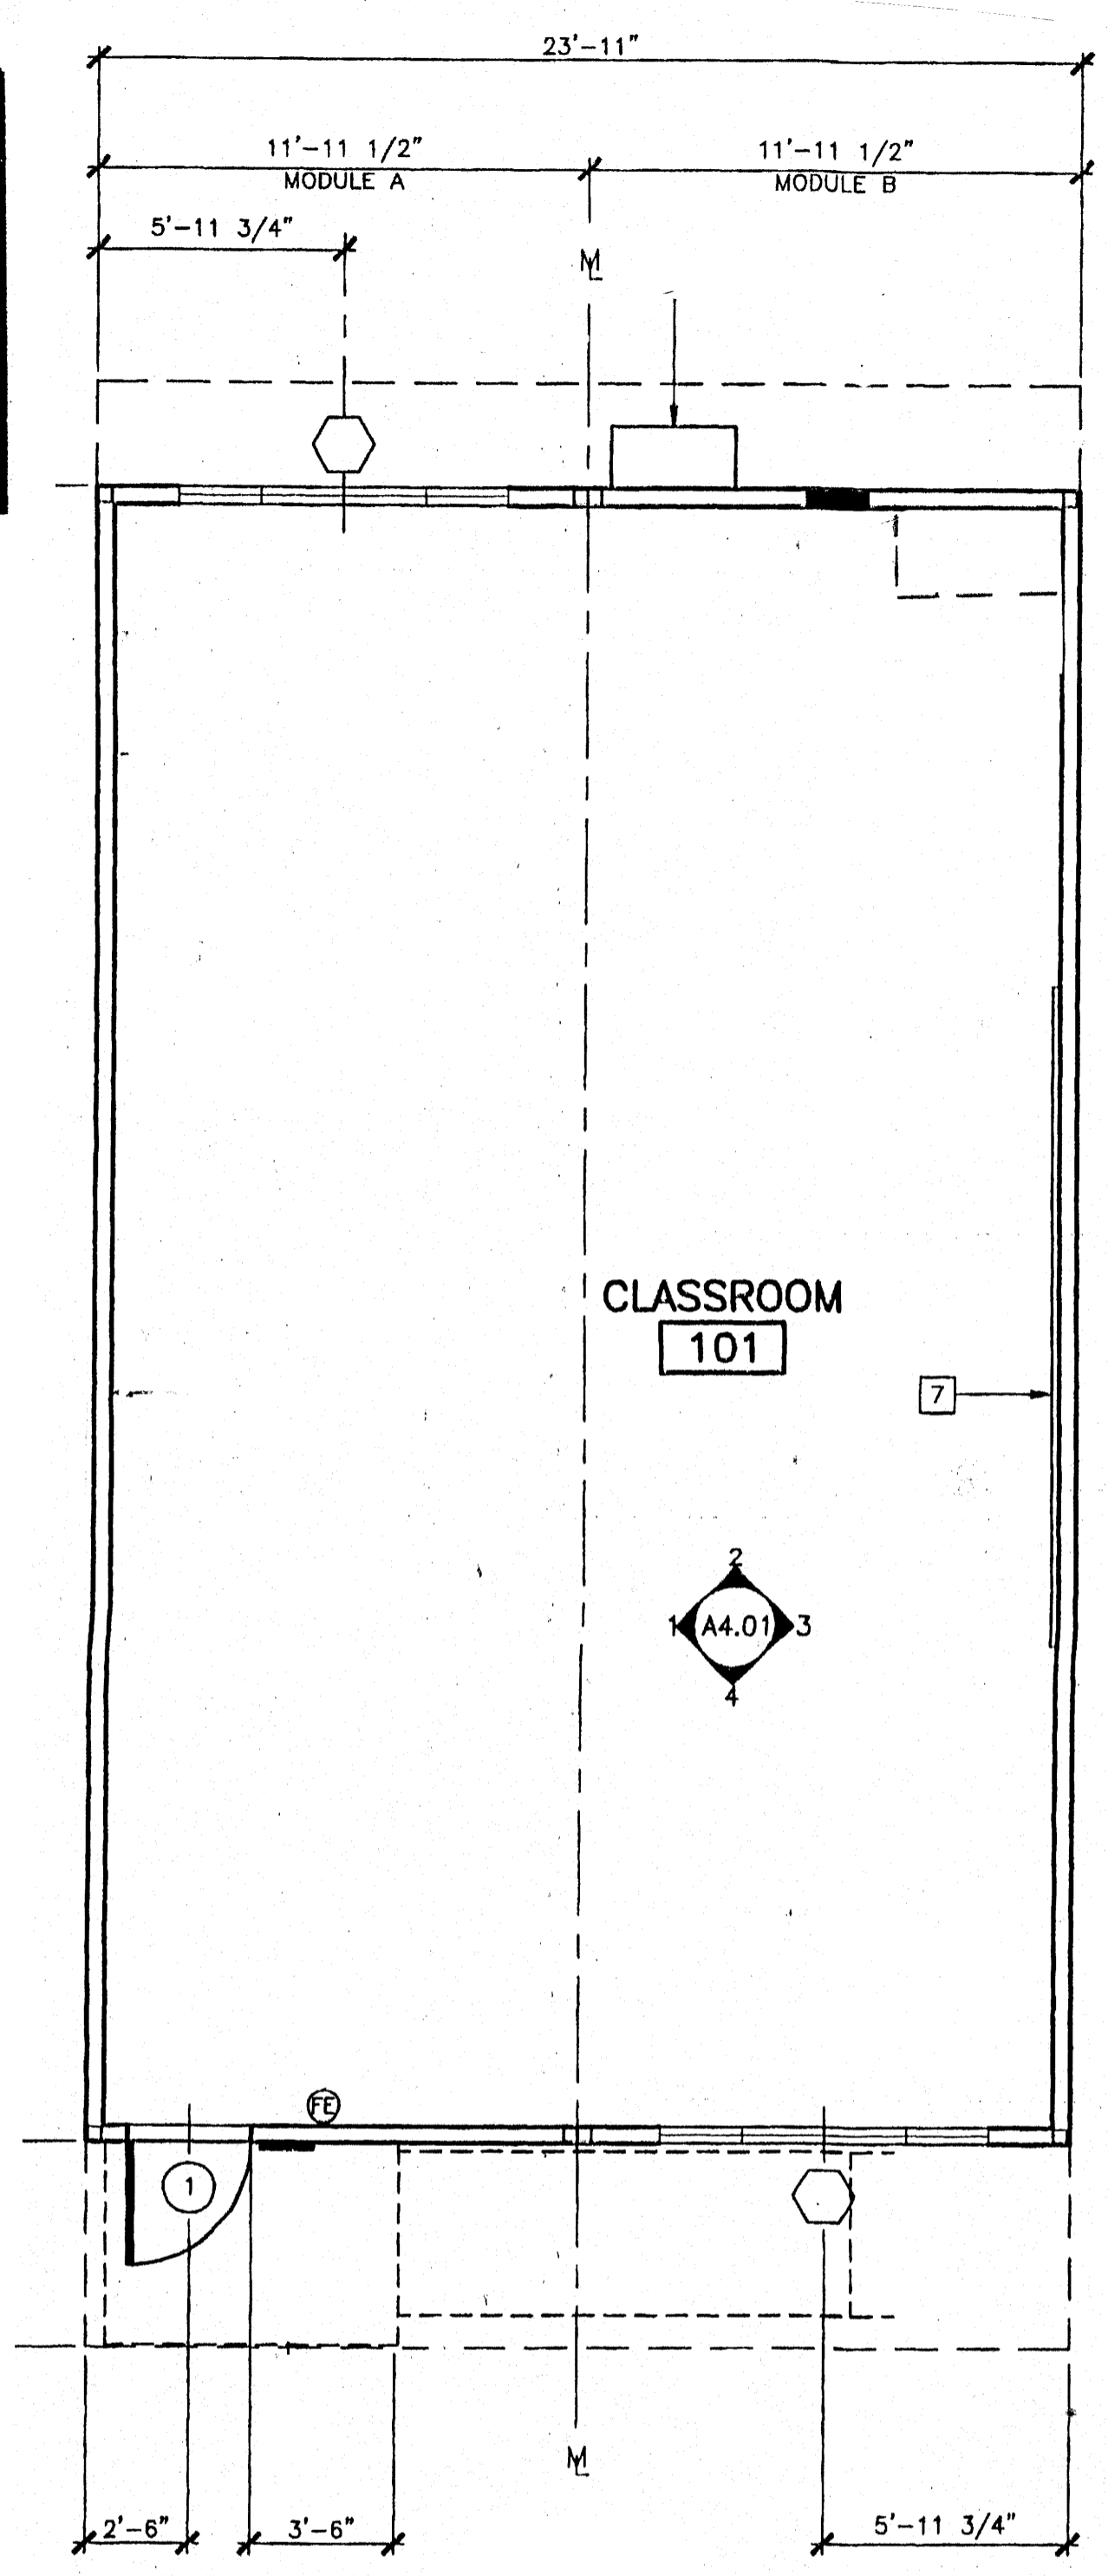

CLASS LEASING INC
 PO BOX 51150
 RIVERSIDE CA 92517-2150


DATE
SCALE
DRAWN
JOB
SHEET
OF SHEETS

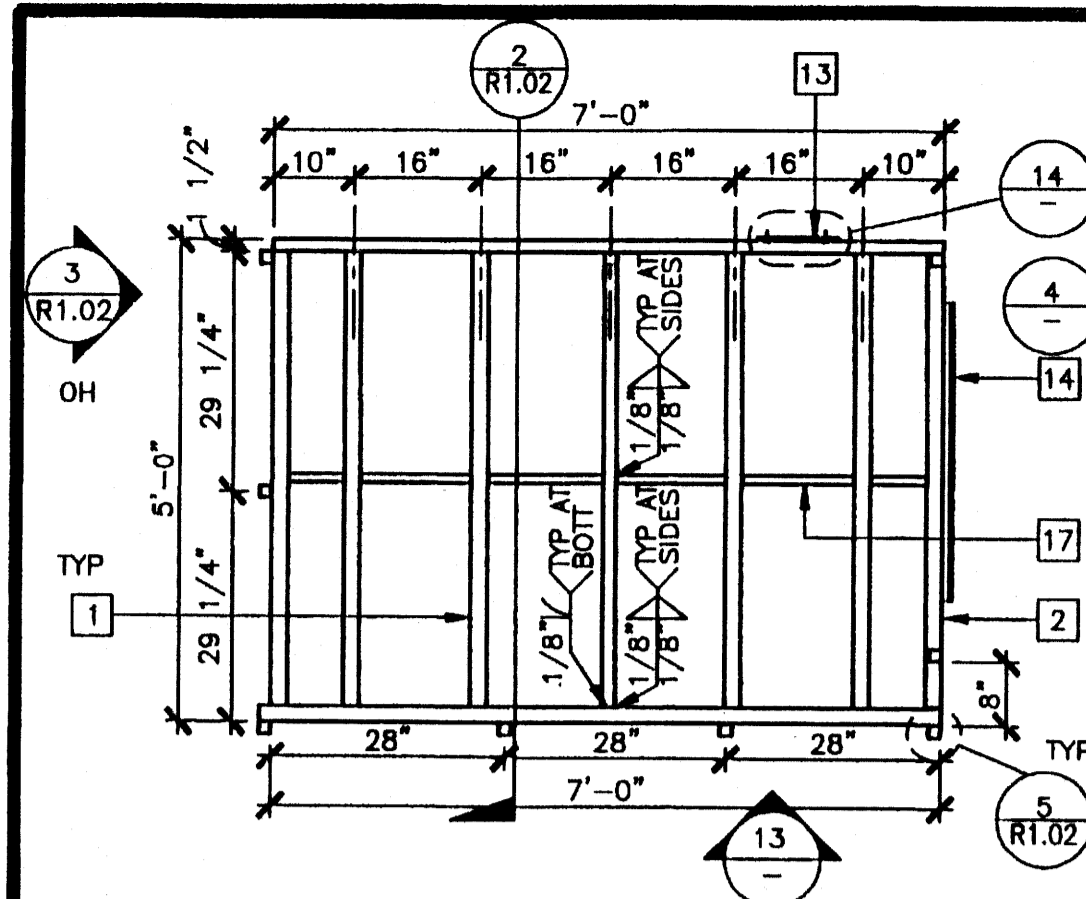

LANDING FRAME

12


SCALE: NTS

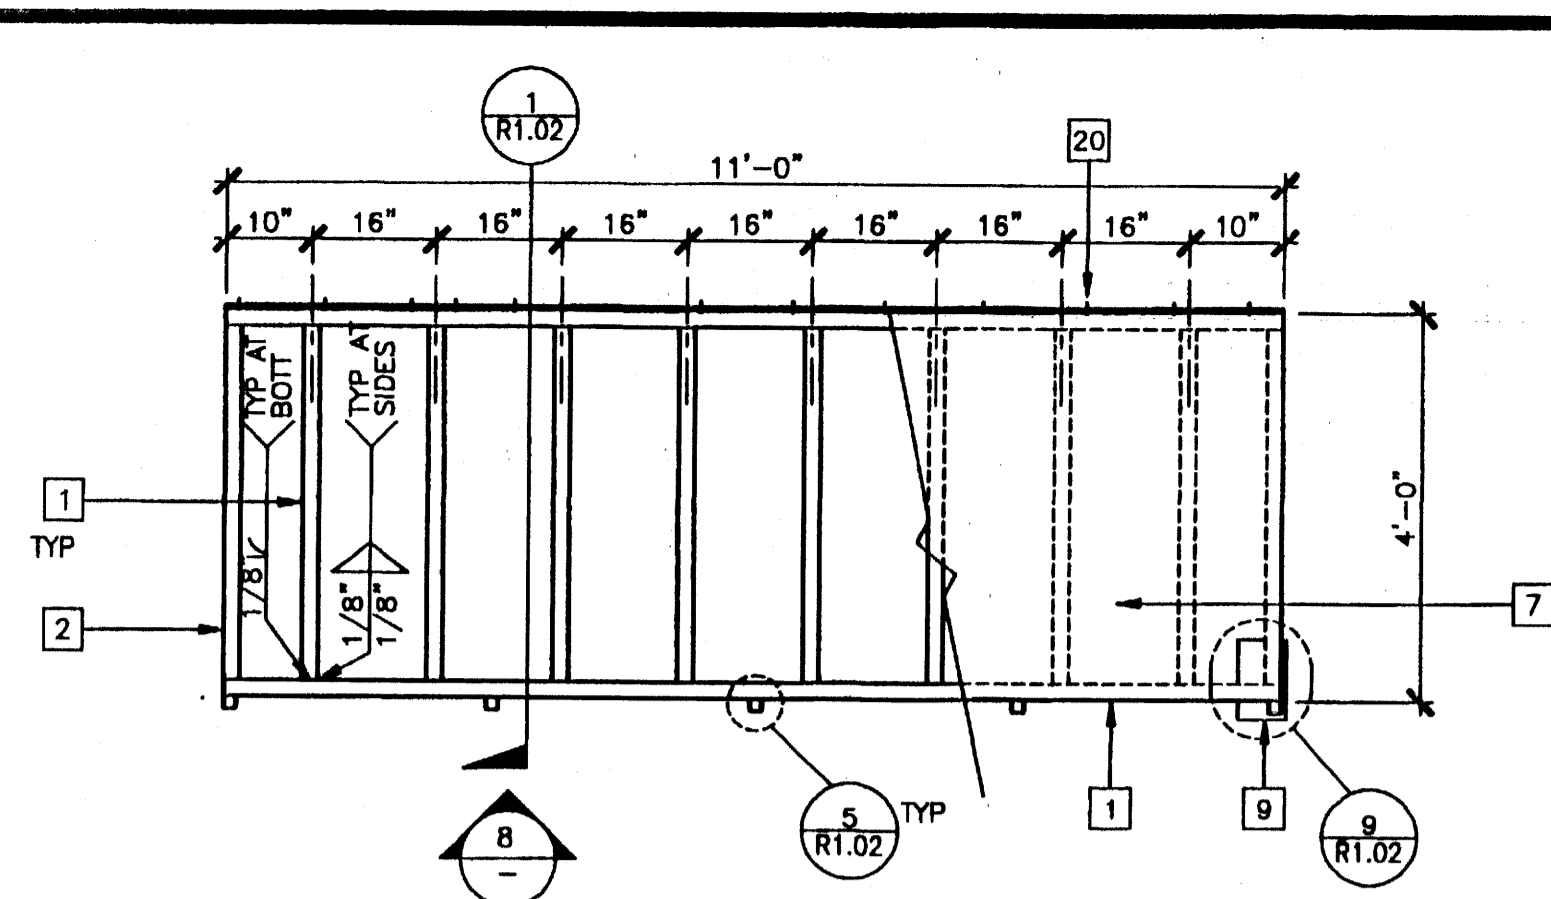

RAMP FRAME


7

SCALE: 3/8"=1'-0"

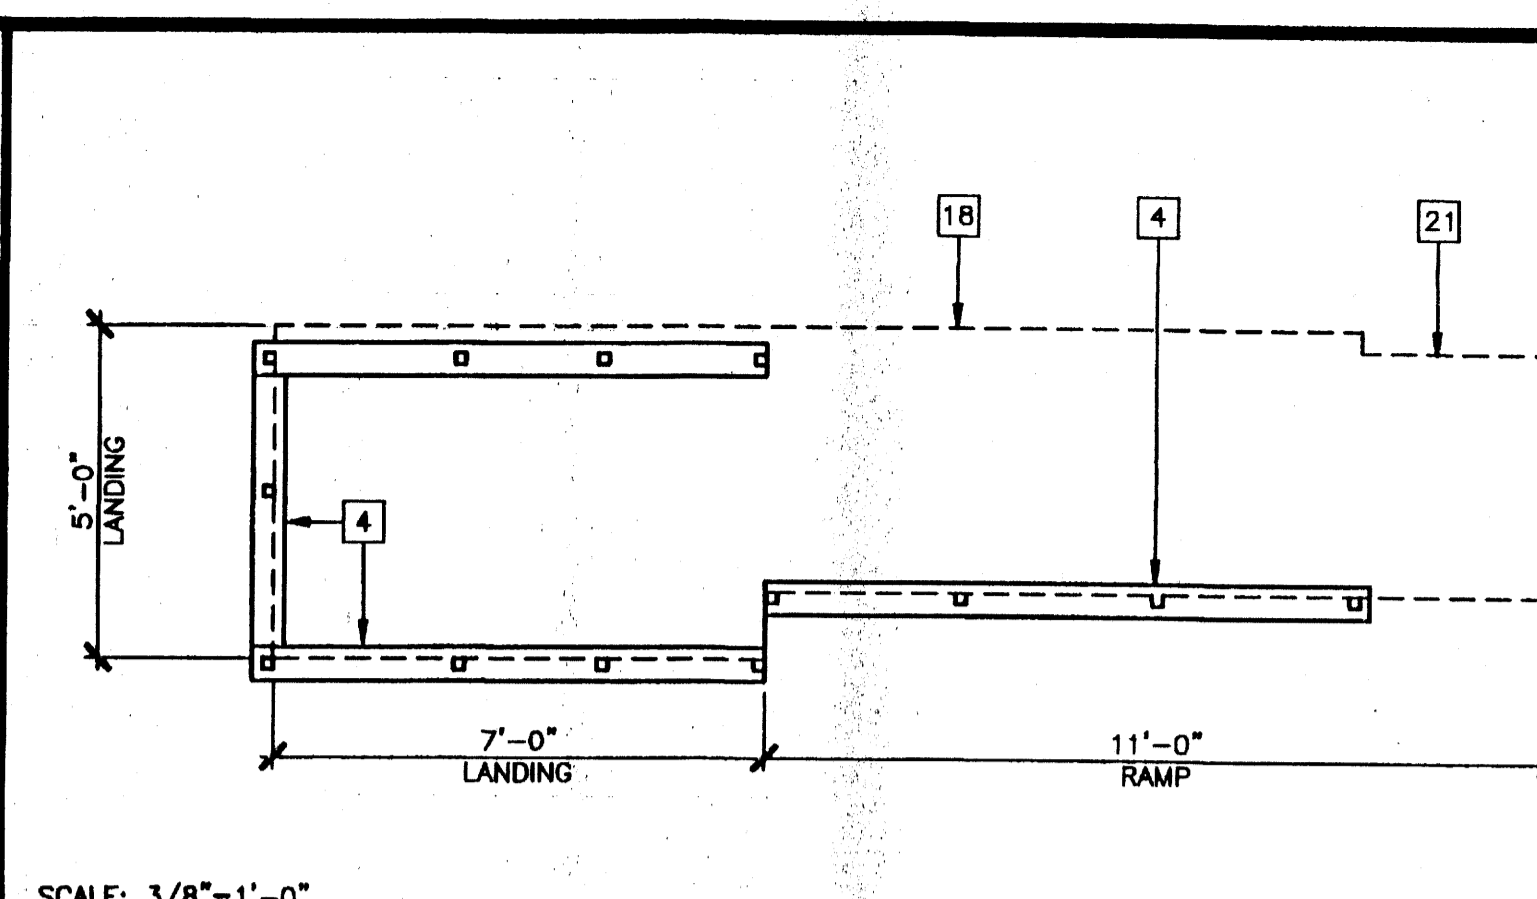

SILL PLAN FOR RAMP AND LANDING


1

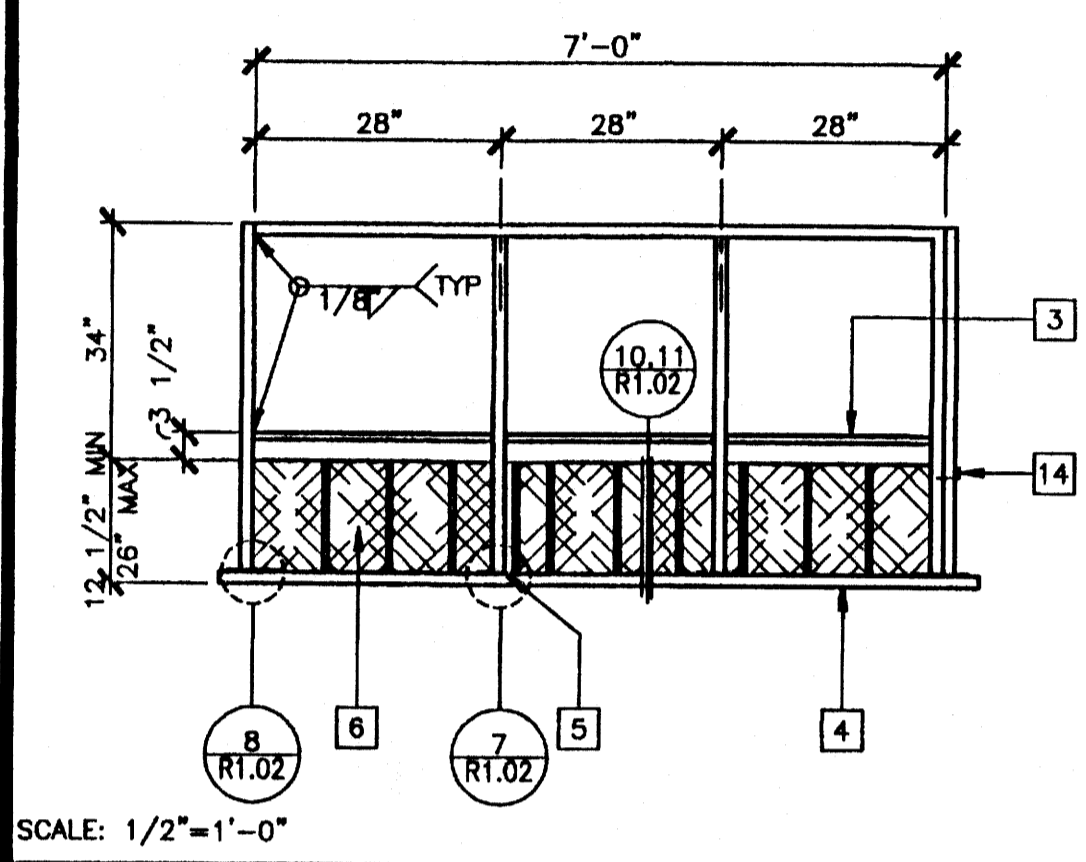

LANDING ELEVATION

13


SCALE: 1/2"=1'-0"

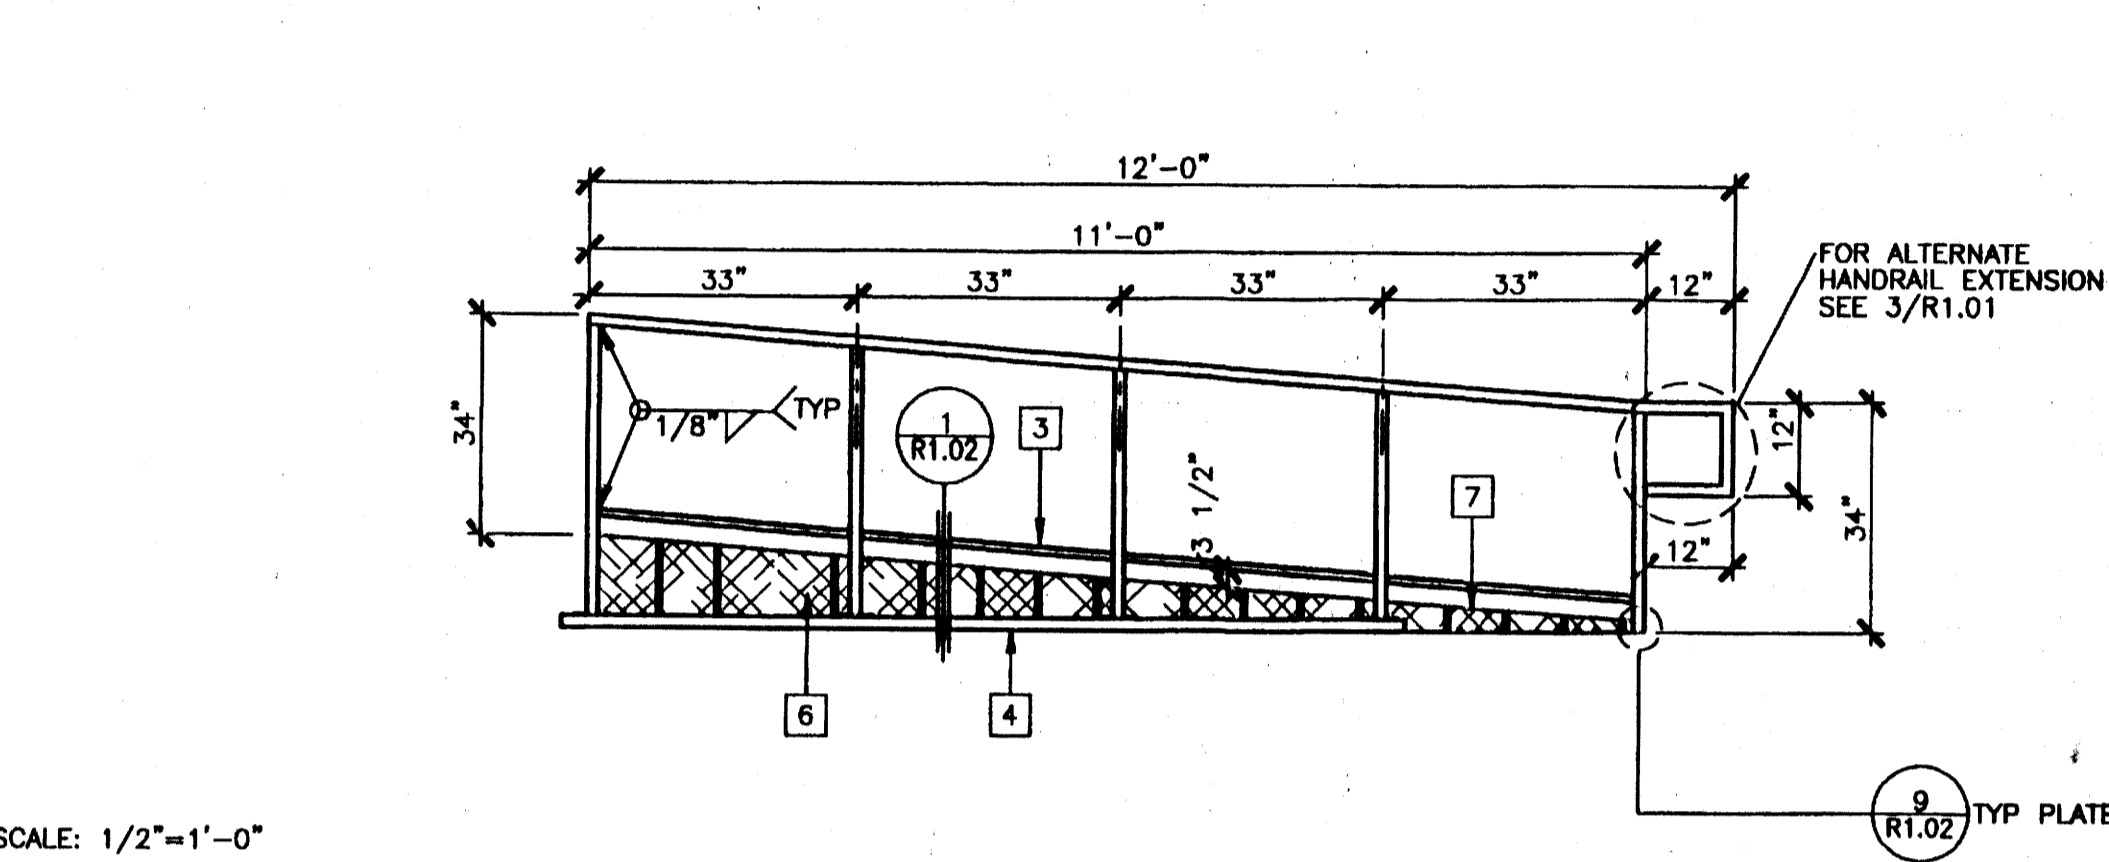

RAMP ELEVATION

8


SCALE: 1/2"=1'-0"

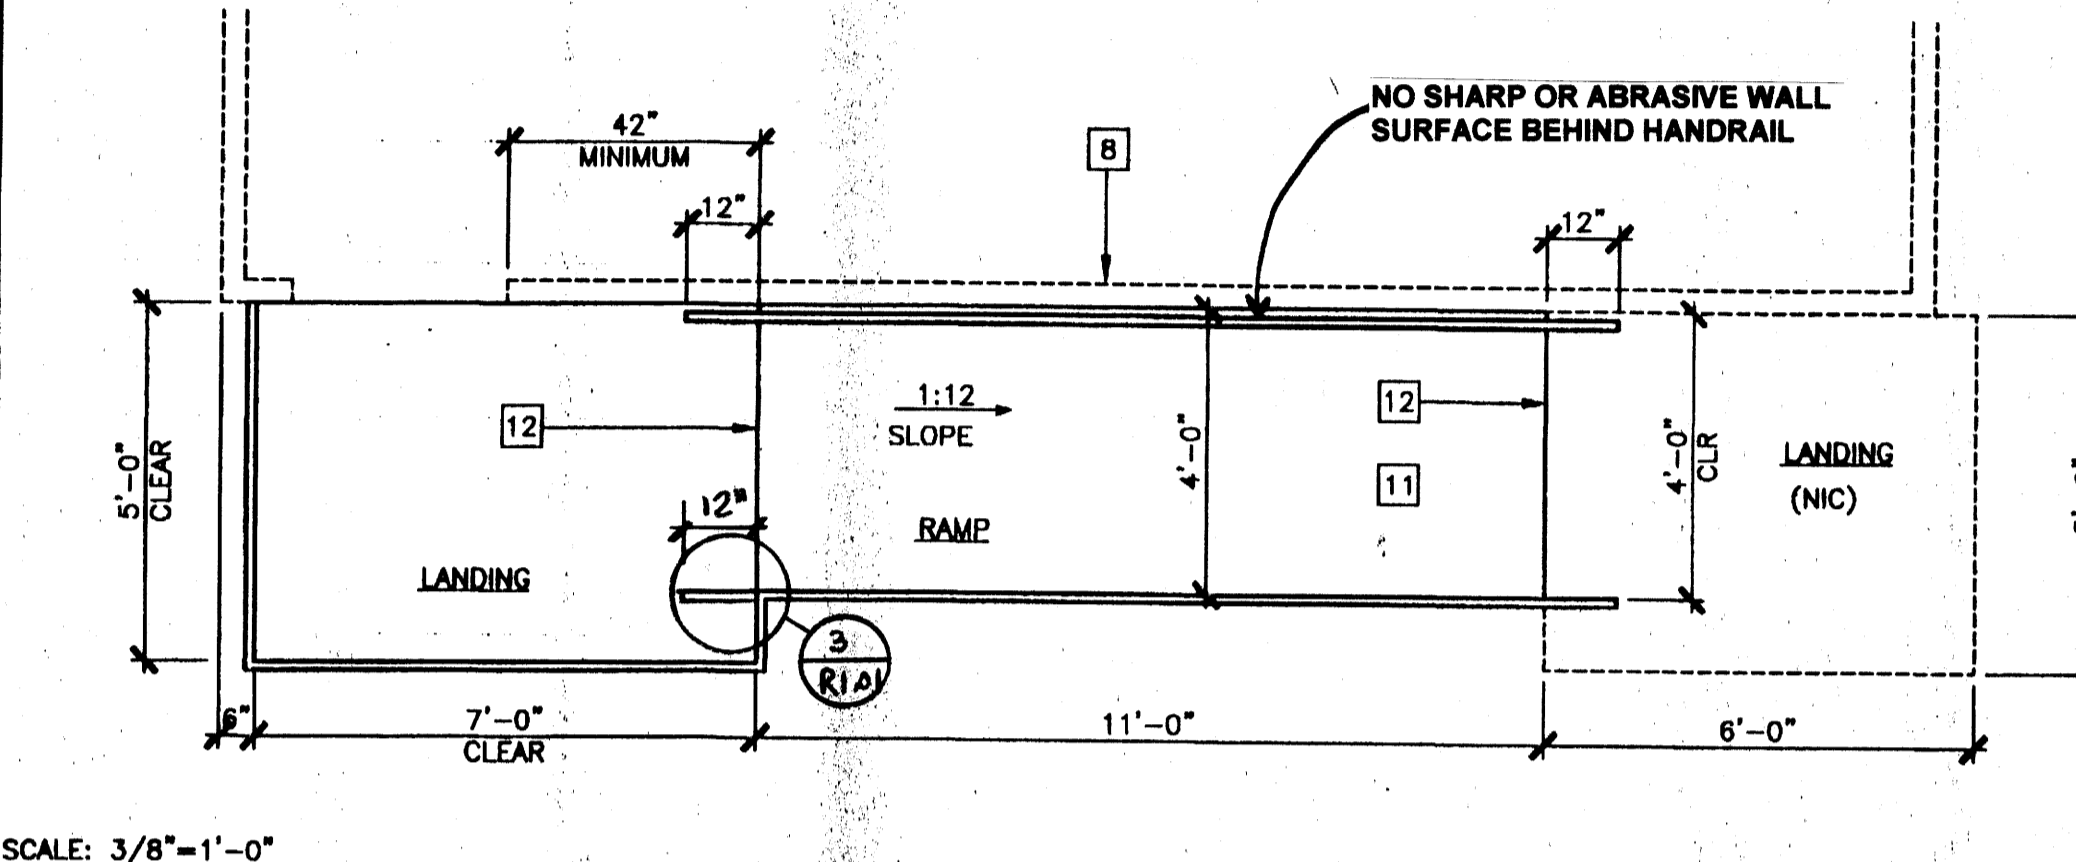

RAMP AND LANDING AT BUILDING

2


SCALE: 3/8"=1'-0"

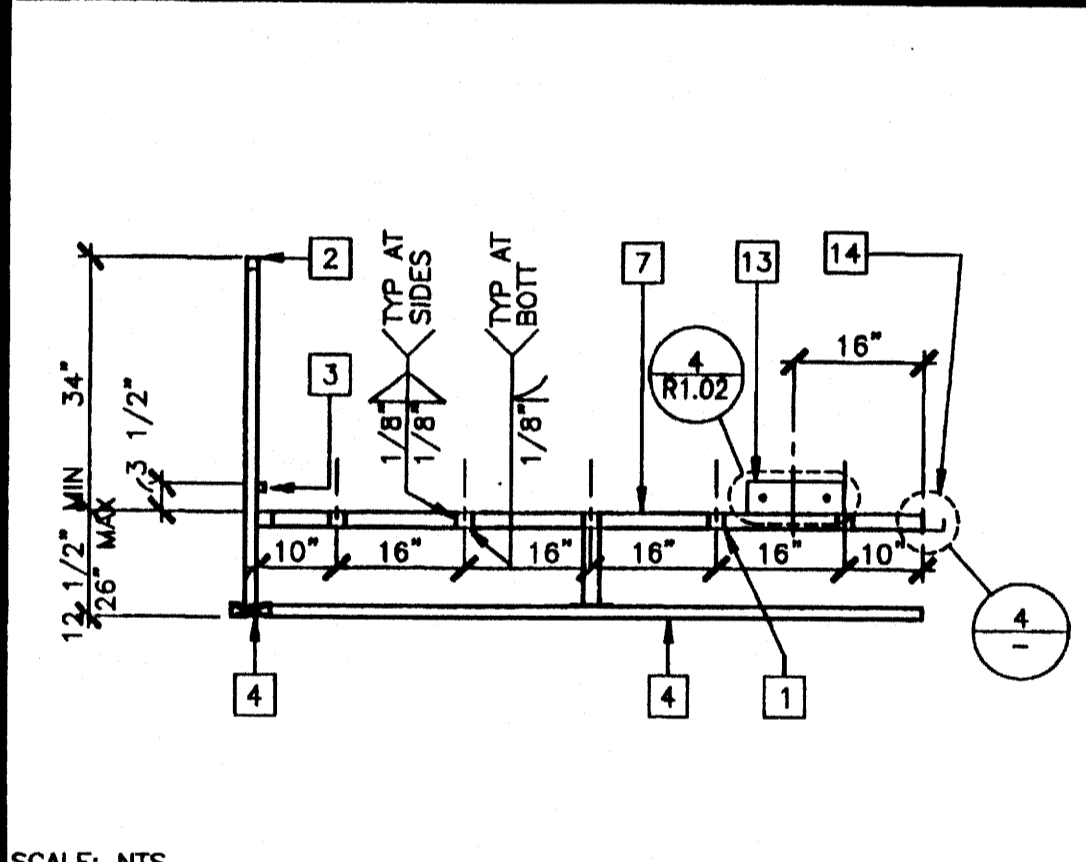

SECTION AT LANDING

14


SCALE: NTS

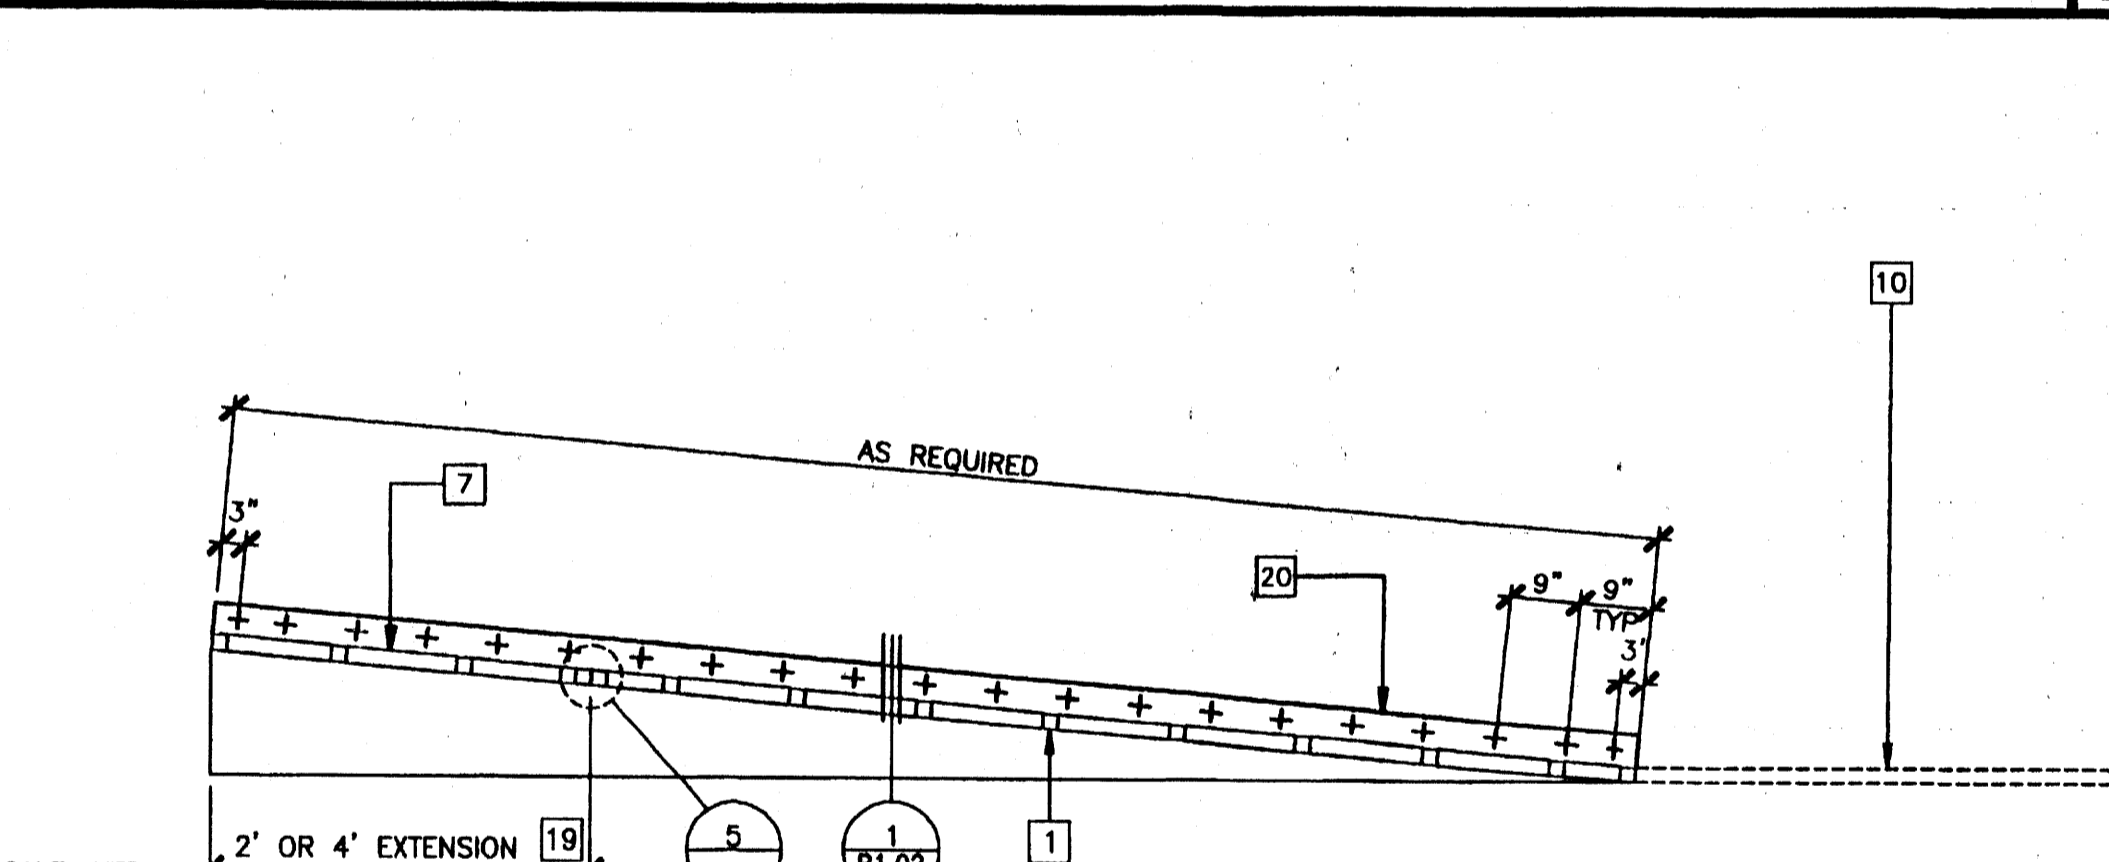

LONGITUDINAL SECTION AT RAMP

9


SCALE: NTS

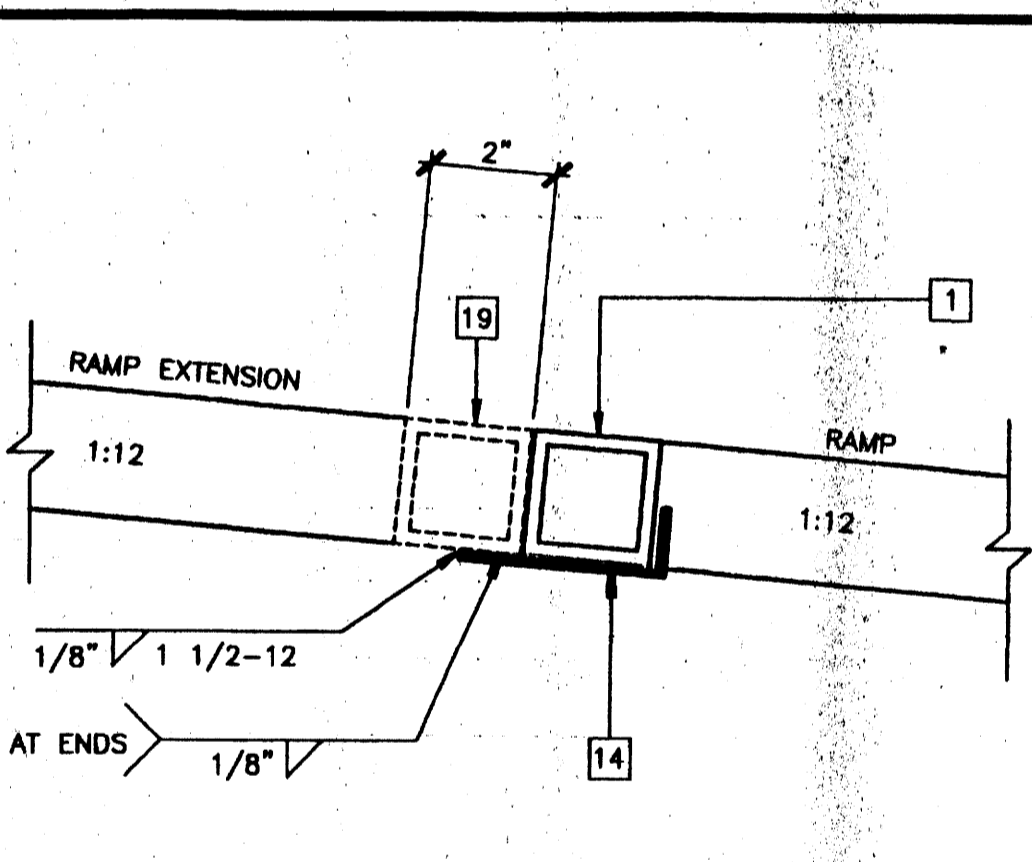

RAMP EXTENSION TO RAMP


5

SCALE: NTS

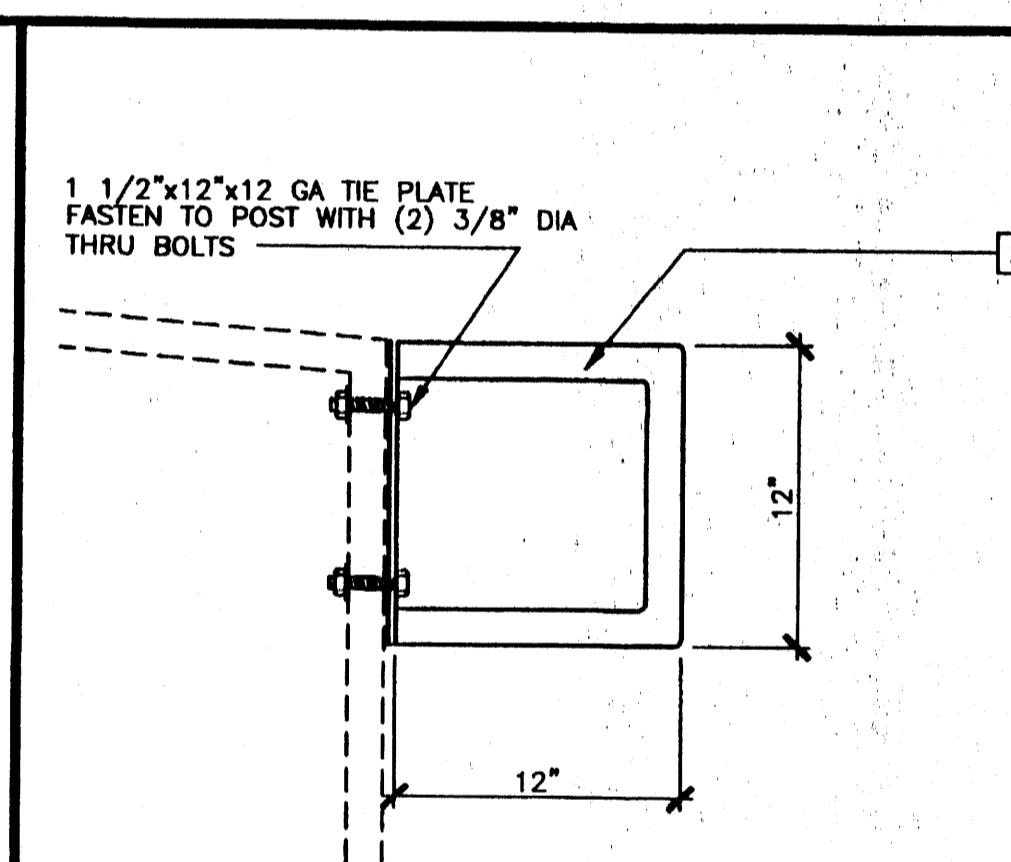

ALTERNATE GUARD RAIL EXTENSION


3

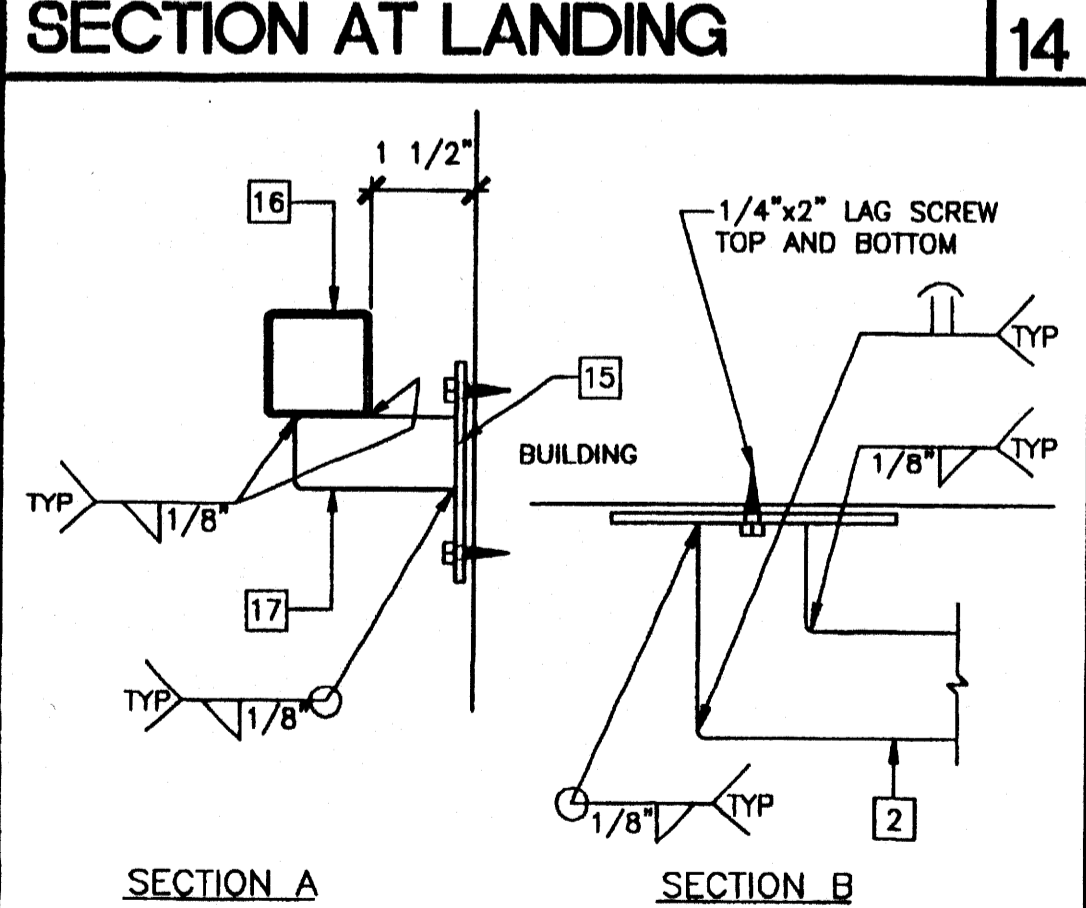

HANDRAIL CONNECTION

15


SCALE: NTS

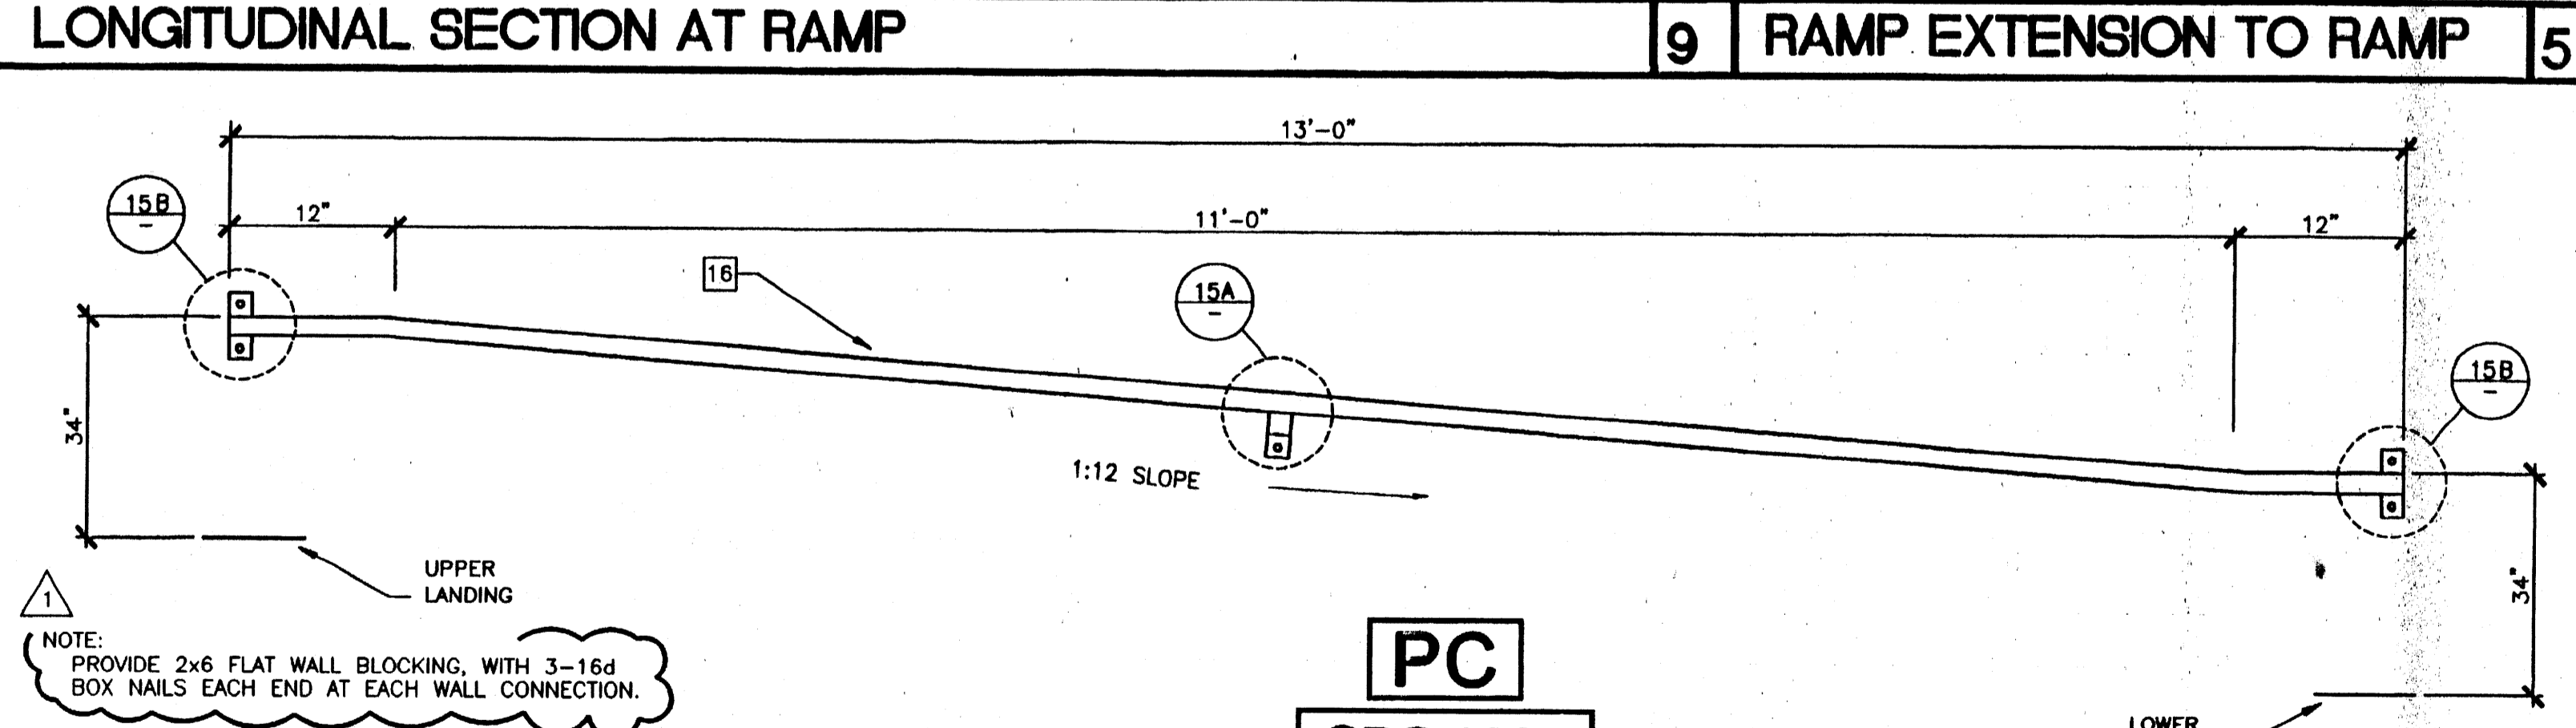

HANDRAIL ATTACHED TO BUILDING (OPTIONAL)

6

SCALE: NTS

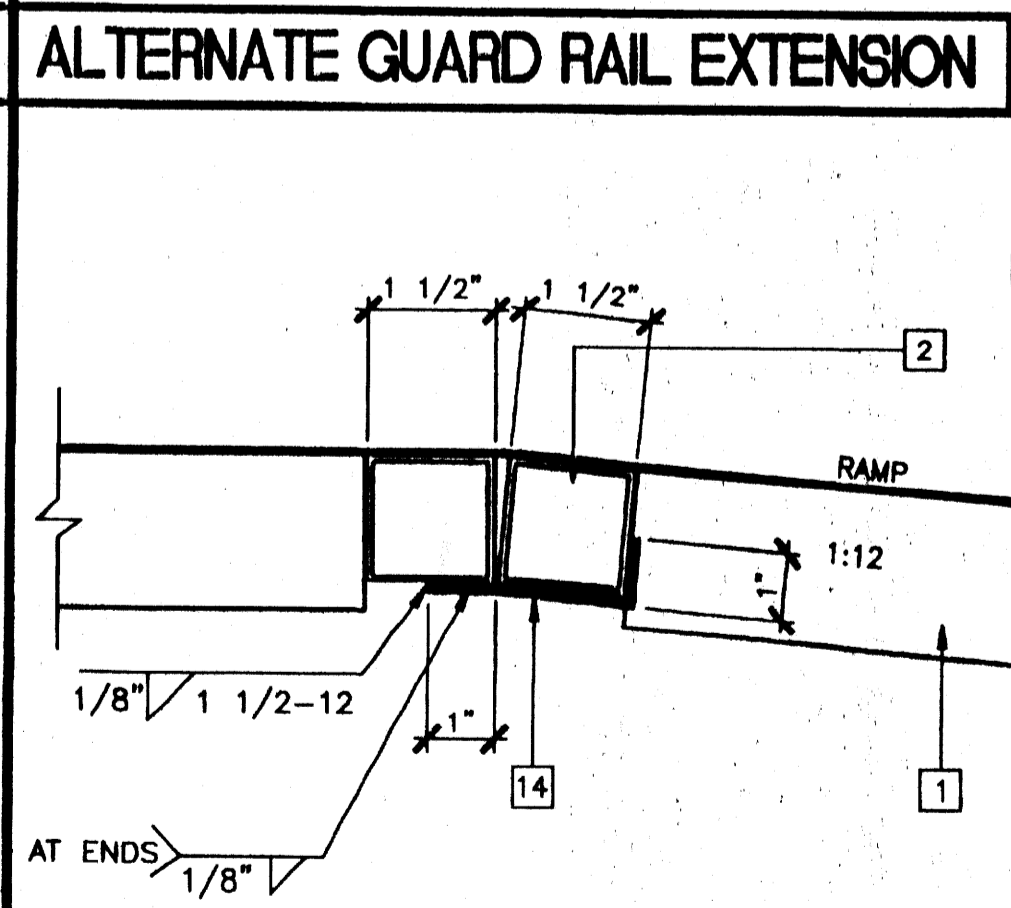

RAMP AT LANDING

4

SCALE: NTS

KEY NOTES

- 1 TS 2"x2"x1/4 GA
- 2 TS 1 1/2"x1 1/2"x1/4 GA (Fy = 39KSI). ROUNDED OR BEVELED AT CORNERS.
- 3 TS 1"x1"x1/8 GA WHEELCHAIR GUIDE
- 4 2"x6" PRESSURE TREATED SILL PLATE
- 5 2"x4"x12 GA BASE PLATE WITH (2) 1/4"x1" LAGS
- 6 SKIRTING: PLYWOOD TO MATCH BUILDING SIDING. BLOCK ALL EDGES. ATTACH WITH 8d AT 6" OC EDGES AND 12" OC FIELD. AT EDGE CONNECTION TO TUBE STEEL USE #14x2" TEK SCREWS AT 6" OC
- 7 12 GA METAL DECK: NON-SLIP SURFACE. DESIGN COEFFICIENT OF FRICTION GREATER THAN 6%. MAINTAINABLE FOR 1 YEAR
- 8 EXISTING BUILDING
- 9 6"x10"x12 GA BASE PLATE AT RAMP TOE
- 10 LOWER LANDING BY DISTRICT
- 11 RAMP BY MODTECH
- 12 FLUSH TRANSITION
- 13 6"x12"x10 GA PLATE WITH (2) 1/4"x3" LAGS TO STRUCTURAL FRAME OF BUILDING
- 14 3"x1"x3'-0"x10 GA BENT PLATE
- 15 2"x4"x 1/8" PLATE
- 16 TS 1 1/2"x1 1/2"x1/4 GA HANDRAIL - CONTINUOUS AND UNINTERRUPTED ROUNDED OR BEVELED AT CORNERS.
- 17 TS 1"x1"x1/8 GA
- 18 LINE OF RAMP/LANDING ABOVE
- 19 RAMP EXTENSION FRAME
- 20 6"x10 GA CONTINUOUS PLATE WITH 1/4"x2" TEK SCREWS AT 9" OC INTO WOOD OR FOUNDATION BLOCKS OR #14x2" TEK SCREWS INTO STEEL AT 9" OC
- 21 NOTCH BOTTOM PLATE (MUD SILL) AS REQUIRED TO CLEAR RAMP TOE. MAX NOTCH 1 1/2"x4'-0" LONG.
- 22 NOTCH BOTTOM PLATE (MUD SILL) AS REQUIRED TO CLEAR RAMP TOE. MAX NOTCH 1 1/2"x4'-0" LONG.

NOTES

1. RAMP: RAMP SHALL NOT SLOPE MORE THAN 1" IN 12"
2. HANDRAILS: HANDRAILS AT BOTH SIDES OF RAMP AT 34" HEIGHT.
3. SURFACE: LANDING & RAMP TO HAVE NON-SLIP SURFACE AMCOR GRIP II AS MANUFACTURED BY AMERICAN CHEMICAL COMPANY (OR EQUAL)
4. GROUNDING: PROVIDE GROUNDING OF RAMP TO BUILDING FRAME WITH #8 COPPER TO BOTH GROUND LUGS.
5. ARCHITECT SITE/RAMP/LANDING PLANNING: DUE TO VARYING SITE CONDITIONS THE MAXIMUM HEIGHT OF FINISH FLOOR FROM GRADE IS 26". THEREFORE IT IS POSSIBLE THAT THE ACCESS RAMP ATTACHED TO THE BUILDING COULD BE 26'-0" AT A SLOPE OF 1:12. ARCHITECT MUST TAKE INTO ACCOUNT THAT THE RAMP SUPPLIED BY MODTECH INC. IS 11'-0" AT A SLOPE OF 1:12. THEREFORE THE ARCHITECT WILL HAVE TO DESIGN AND PROVIDE DETAILS OF RAMP EXTENSIONS AND BOTTOM LANDING DEPENDING ON PARTICULAR SITE CONDITIONS. IN NO WAY IS MODTECH INC RESPONSIBLE FOR ANY RAMP EXTENSION EXCEEDING THE ORIGINAL PLAN AS SHOWN ON THIS SHEET
6. ALL 1 1/4" AND 1 1/2" TUBE STEEL TO BE OF ASTM A500 GRADE A STEEL (Fy = 39 KSI)

REVISIONS		
NO.	DESCRIPTION	DATE
1	MODTECH ENGINEERING CHANGE	09/28/00
2		
3		
4		
5		

Electrical Engineer's Seal

Mechanical Engineer's Seal

Structural Engineer's Seal

Architect's Seal

IDENTIFICATION STAMP
DIV. OF THE STATE ARCHITECT
OFFICE OF REGULATION SERVICES
PC-04
101268
REVISED OCT 0


MODTECH INC.
2830 BARRETT AVENUE
PERRIS, CALIF. 92572
PH (909) 943-4014
FAX (909) 940-0427

PROJECT NUMBER: 4373, 4378, 4438, 4438 © MODTECH, INC. 2002
4474, 4505, 4525


DRAWN BY: KK
DATE: 11/19/02
CHECKED BY: STKP-67
DATE: 4/12/12
MODTECH Index No.
R1.01

RAMP/LANDING


FILE PATH: Z440-RT.01.DWG PROJECT NO. 4373 PC-04-101268

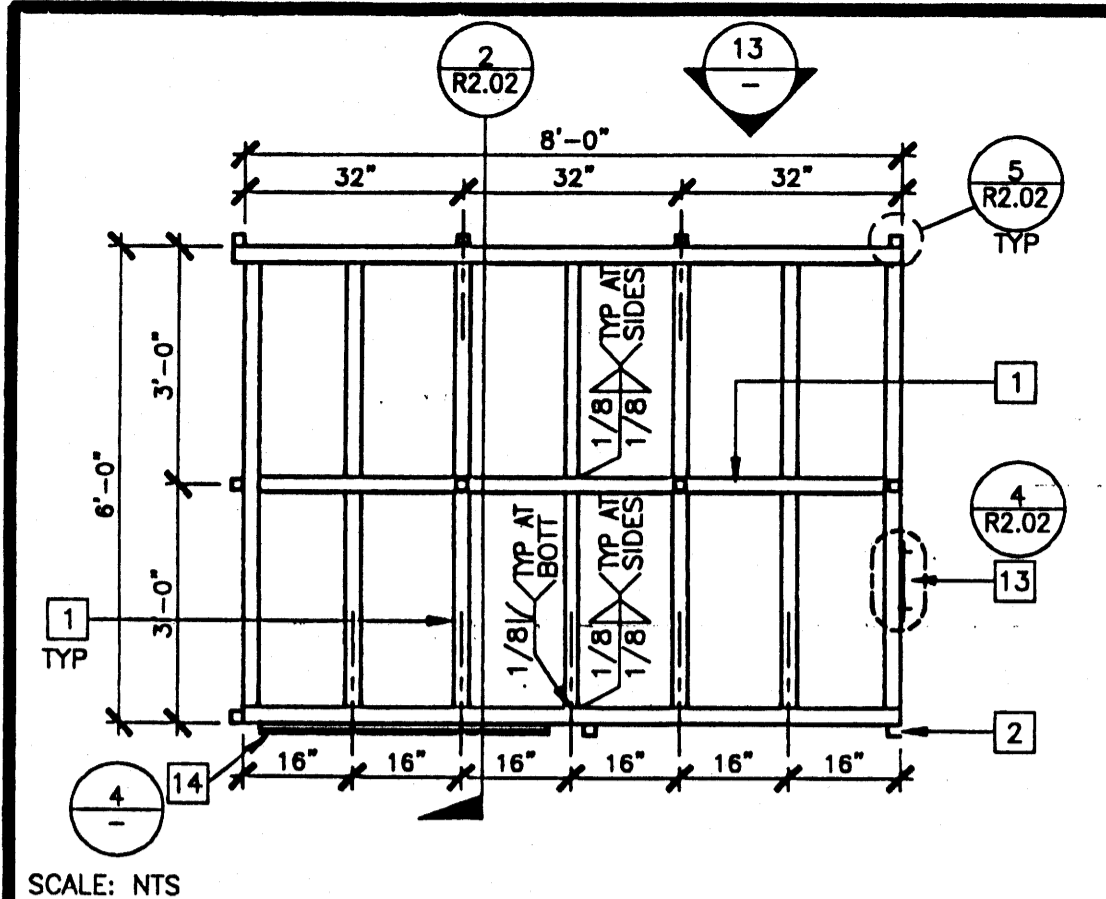


SCALE: NTS
LANDING FRAME 12

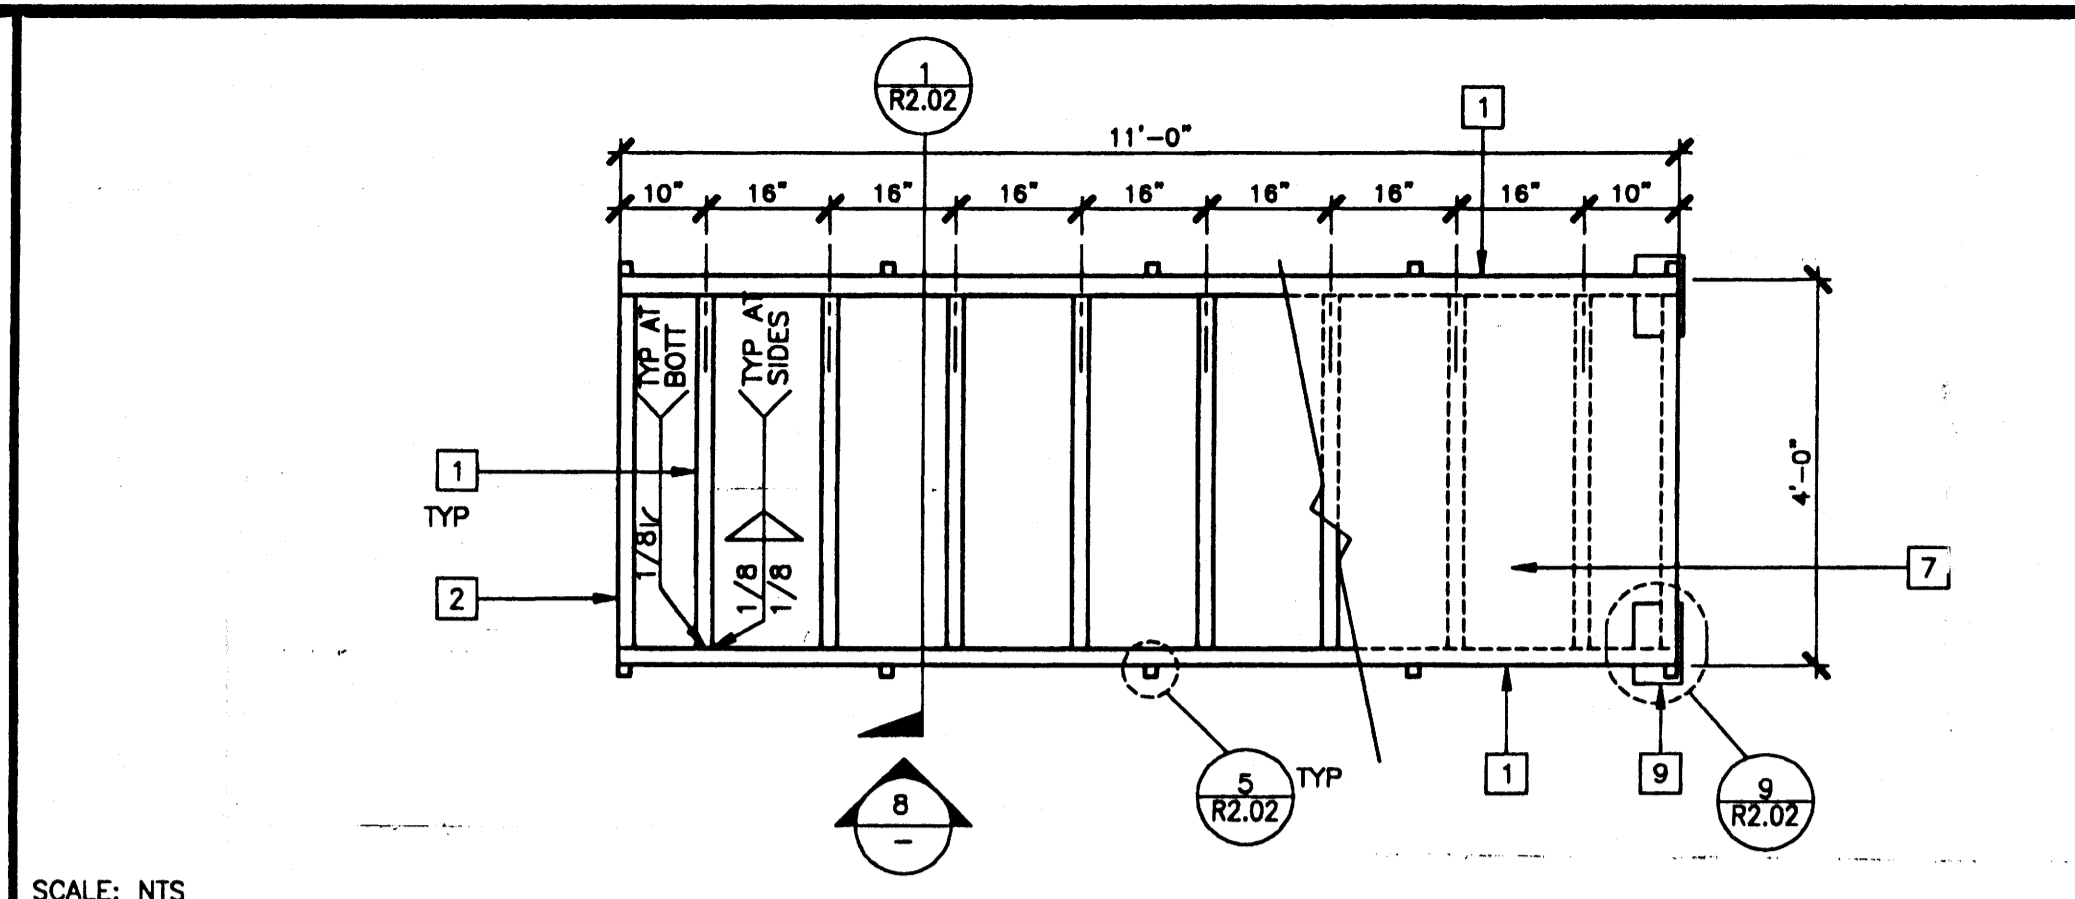


SCALE: NTS
RAMP FRAME 7

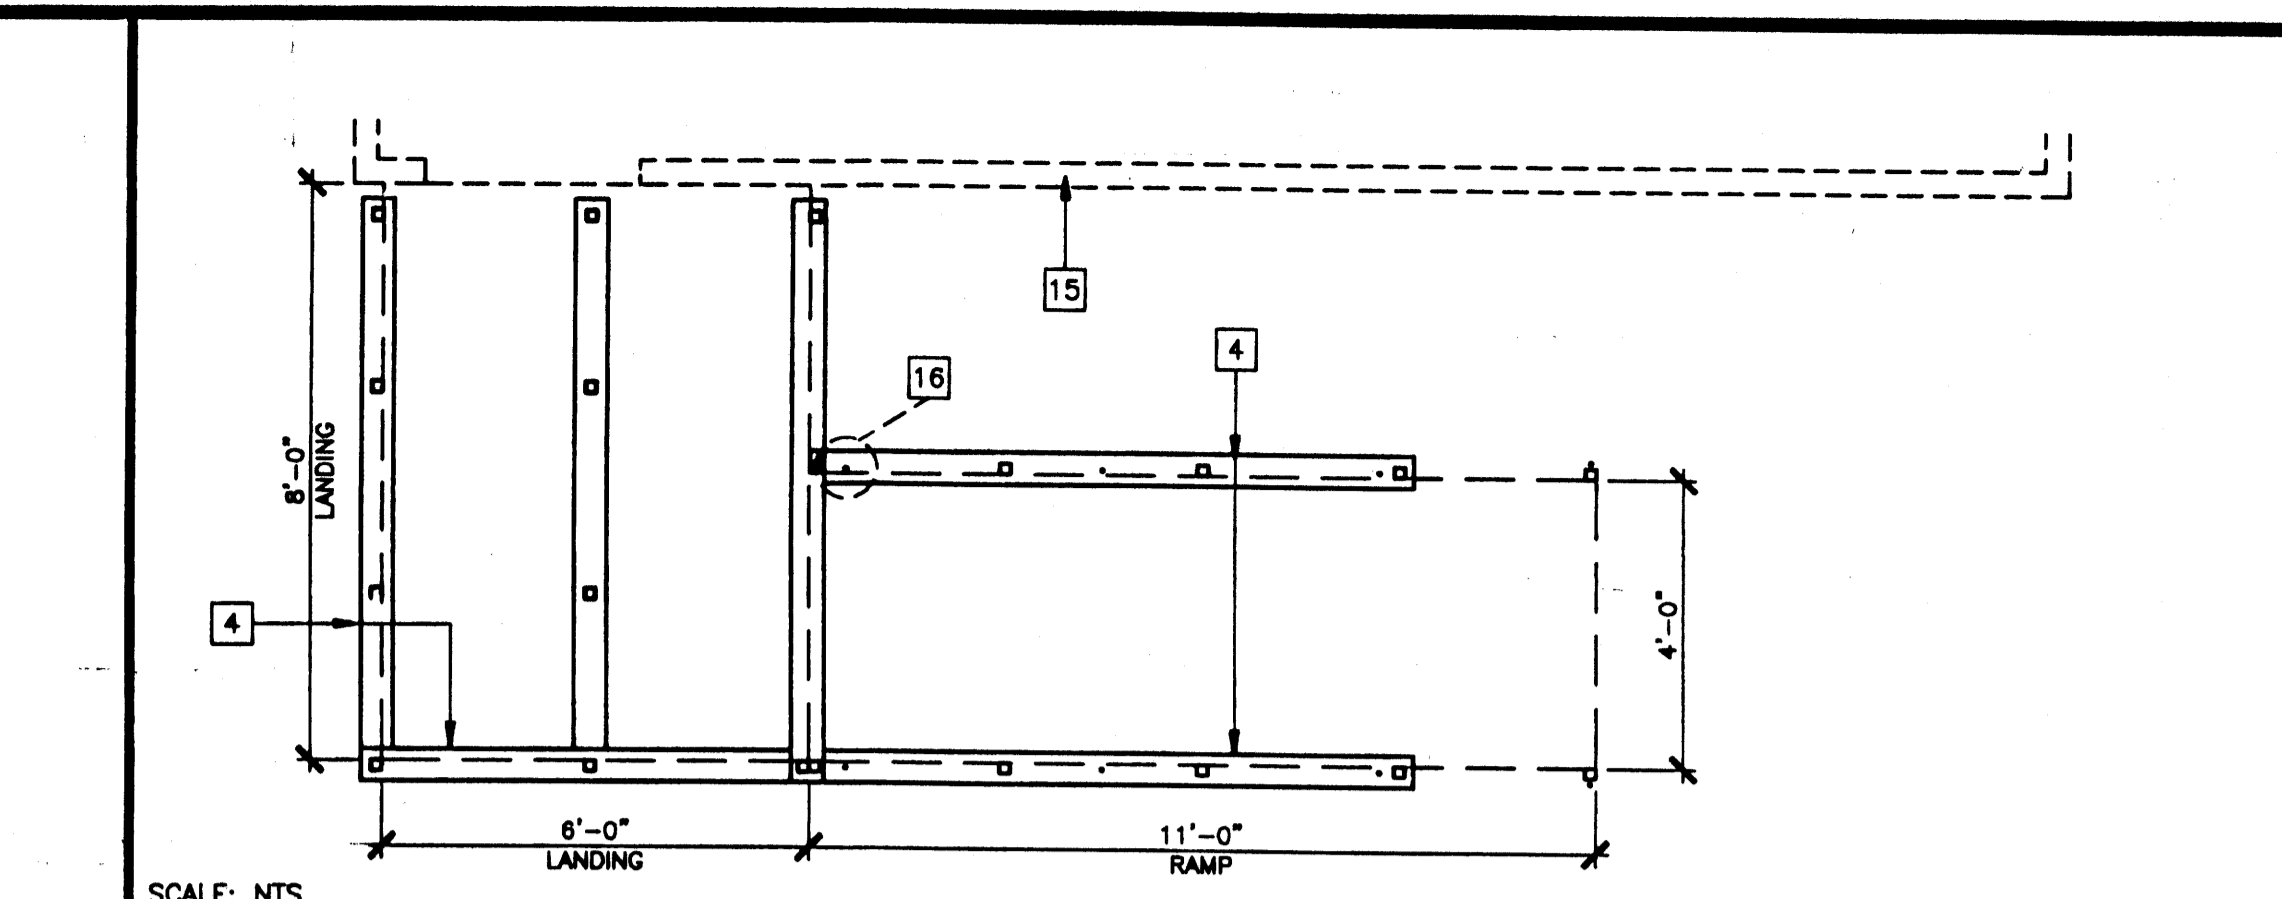


SCALE: NTS
SILL PLAN FOR RAMP AND LANDING 1

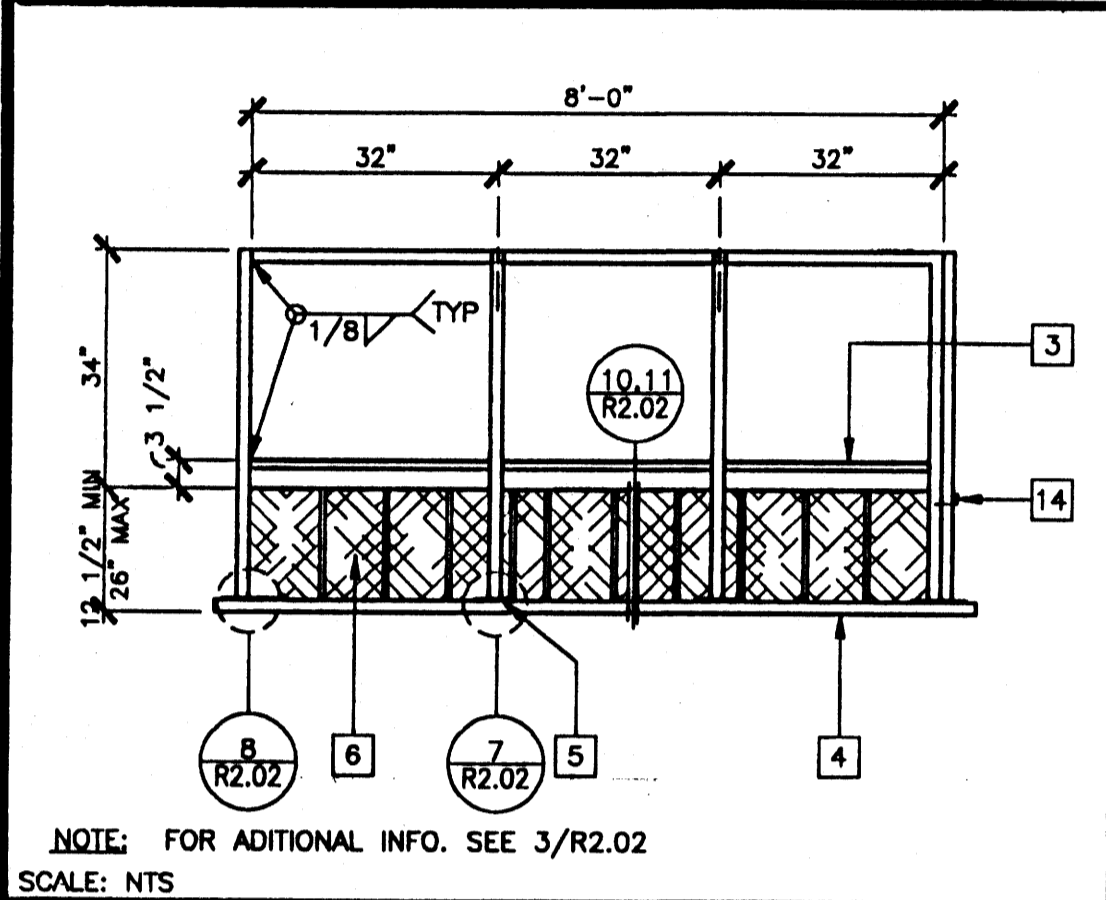


NOTE: FOR ADDITIONAL INFO. SEE 3/R2.02
SCALE: NTS
LANDING ELEVATION 13

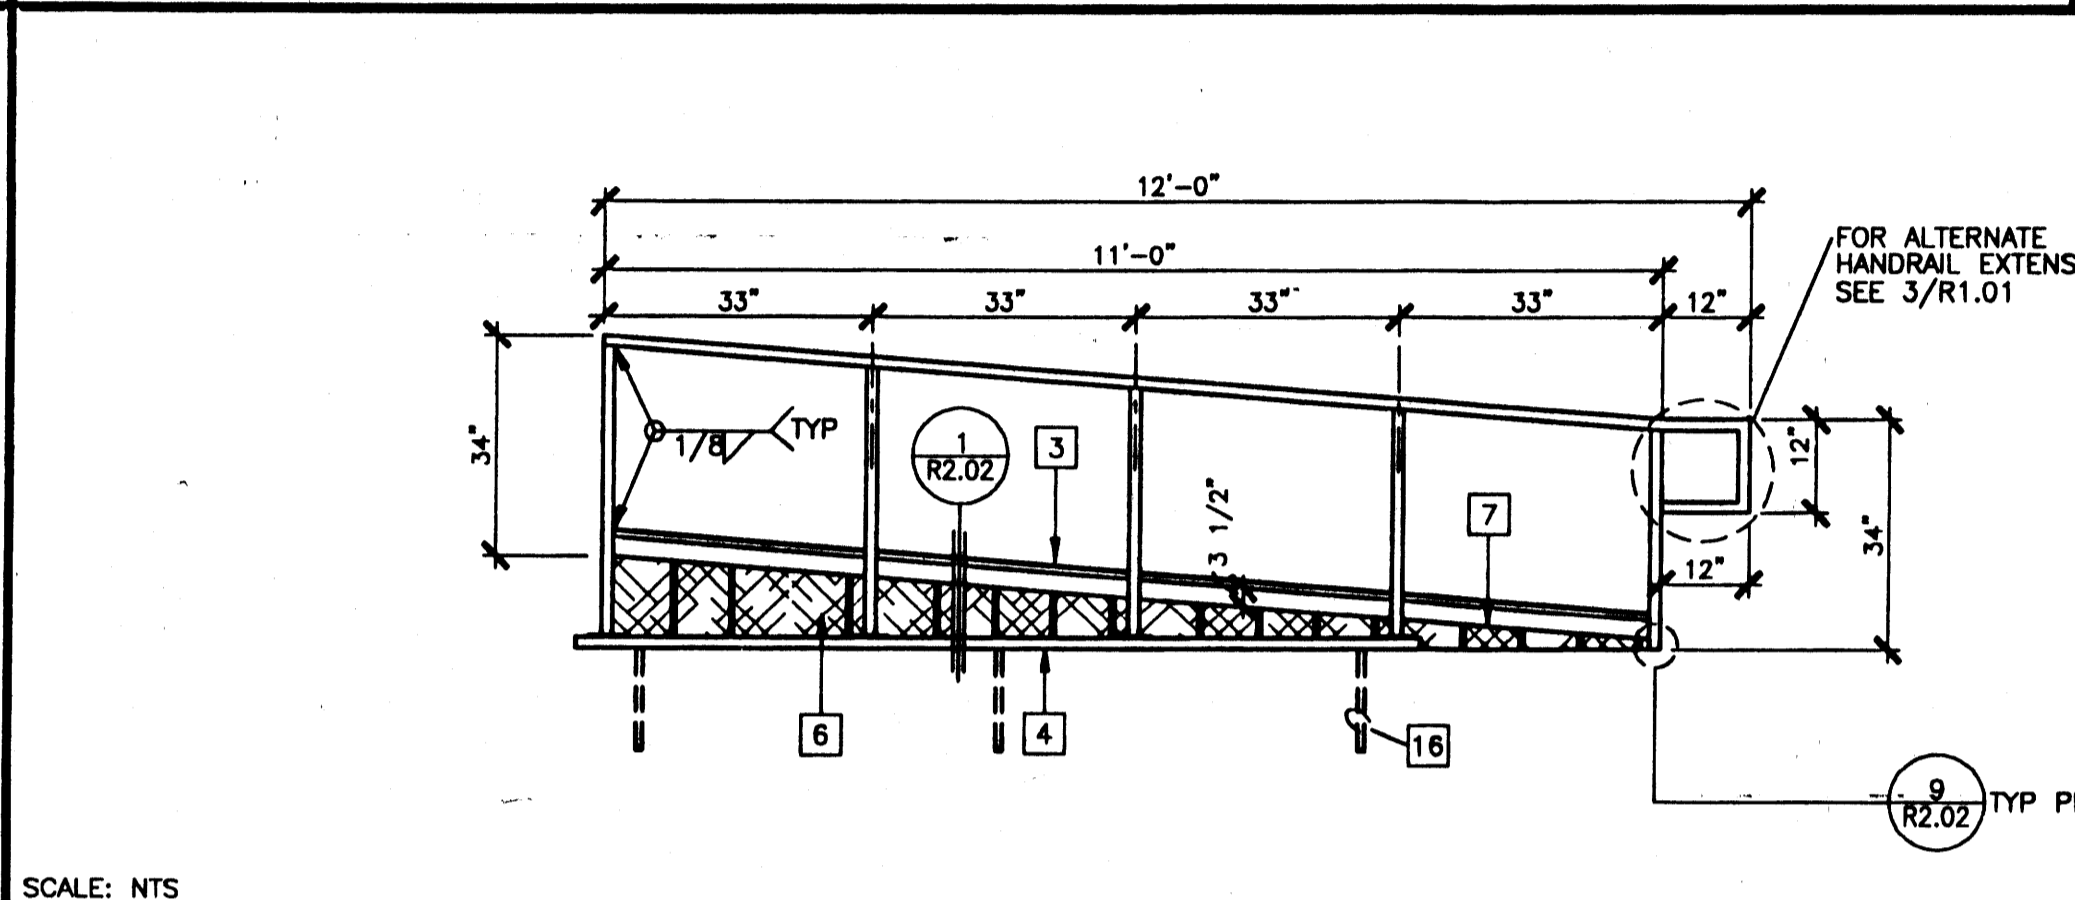


SCALE: NTS
RAMP ELEVATION 8

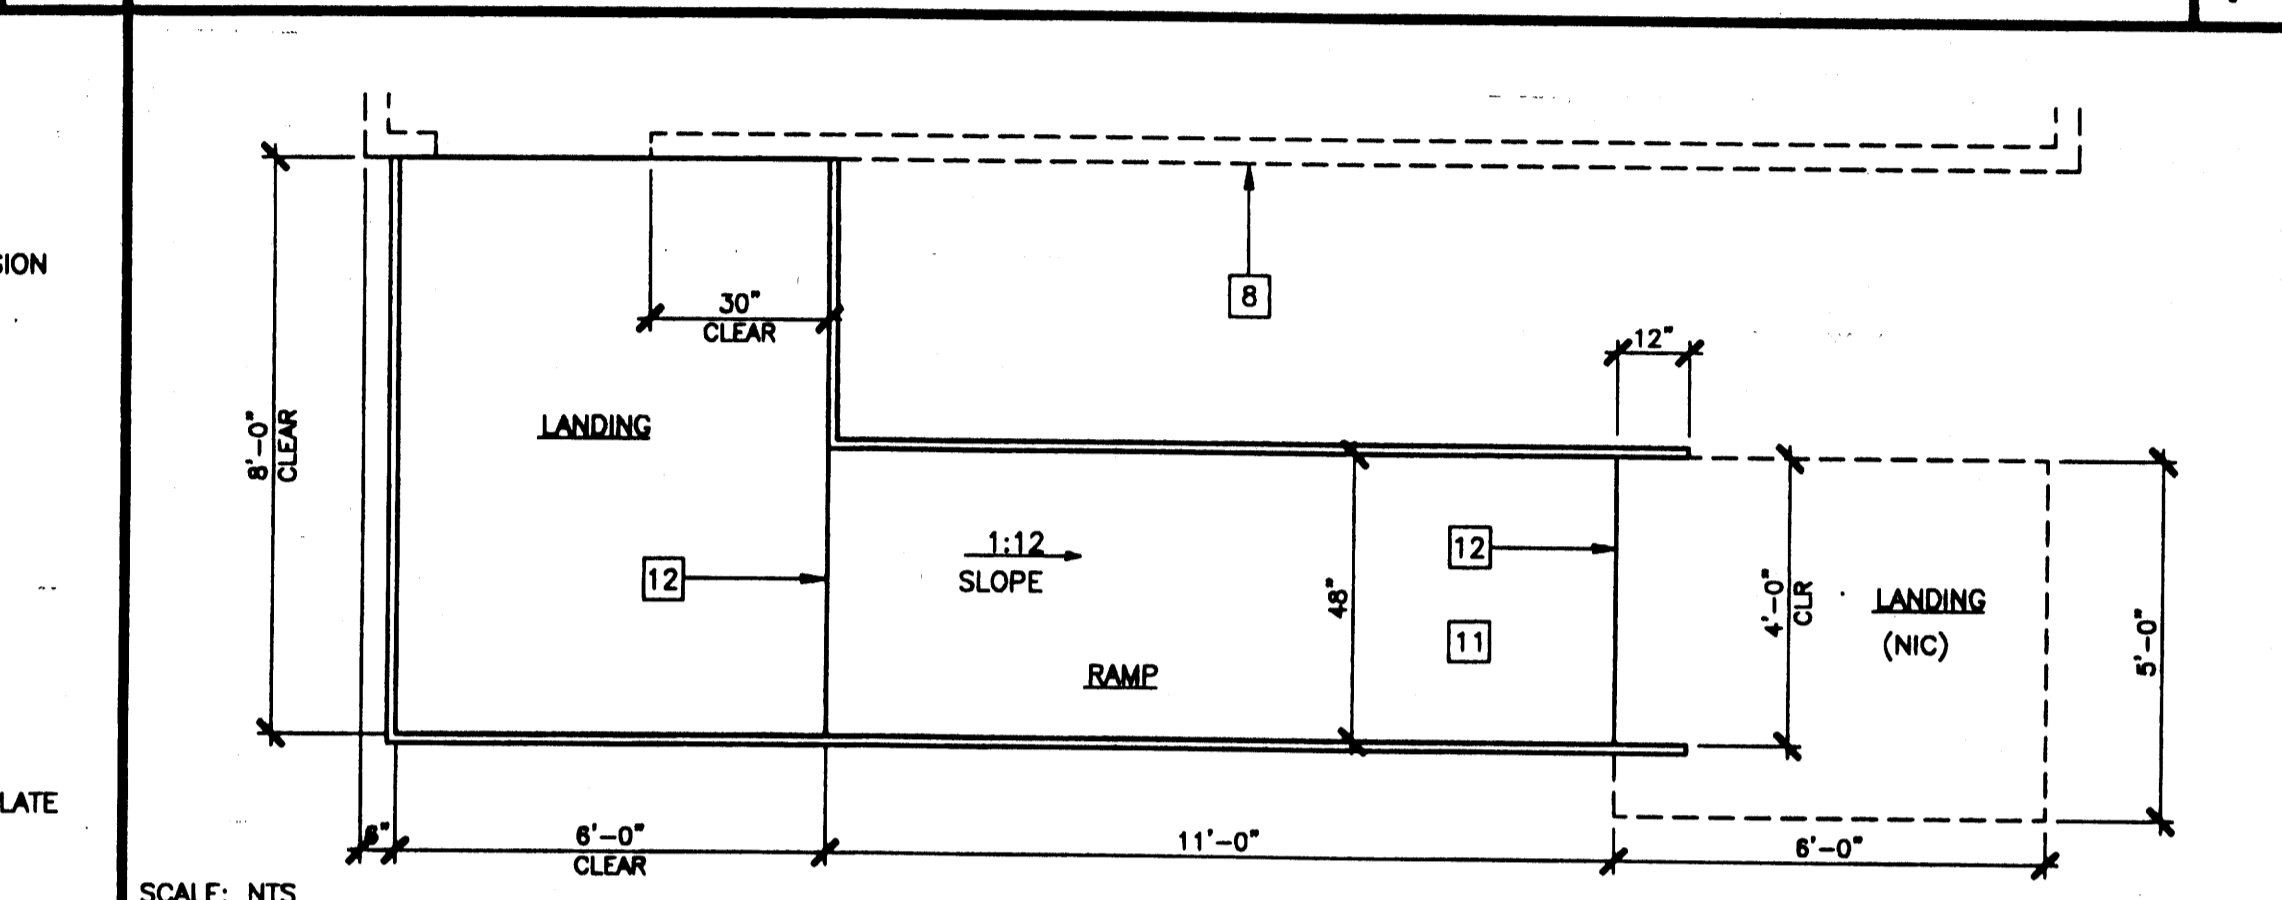


SCALE: NTS
RAMP AND LANDING AT BUILDING 2

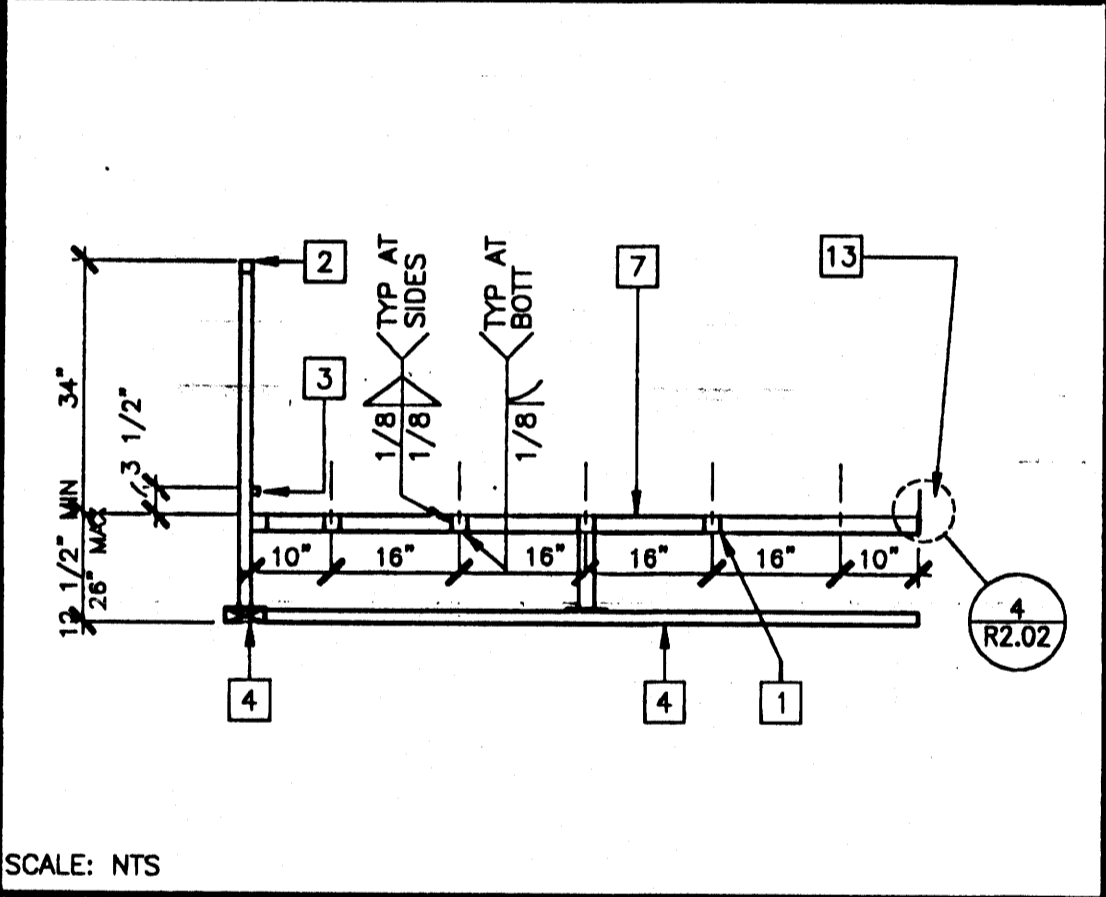


SCALE: NTS
LONG. SECTION AT LANDING 14

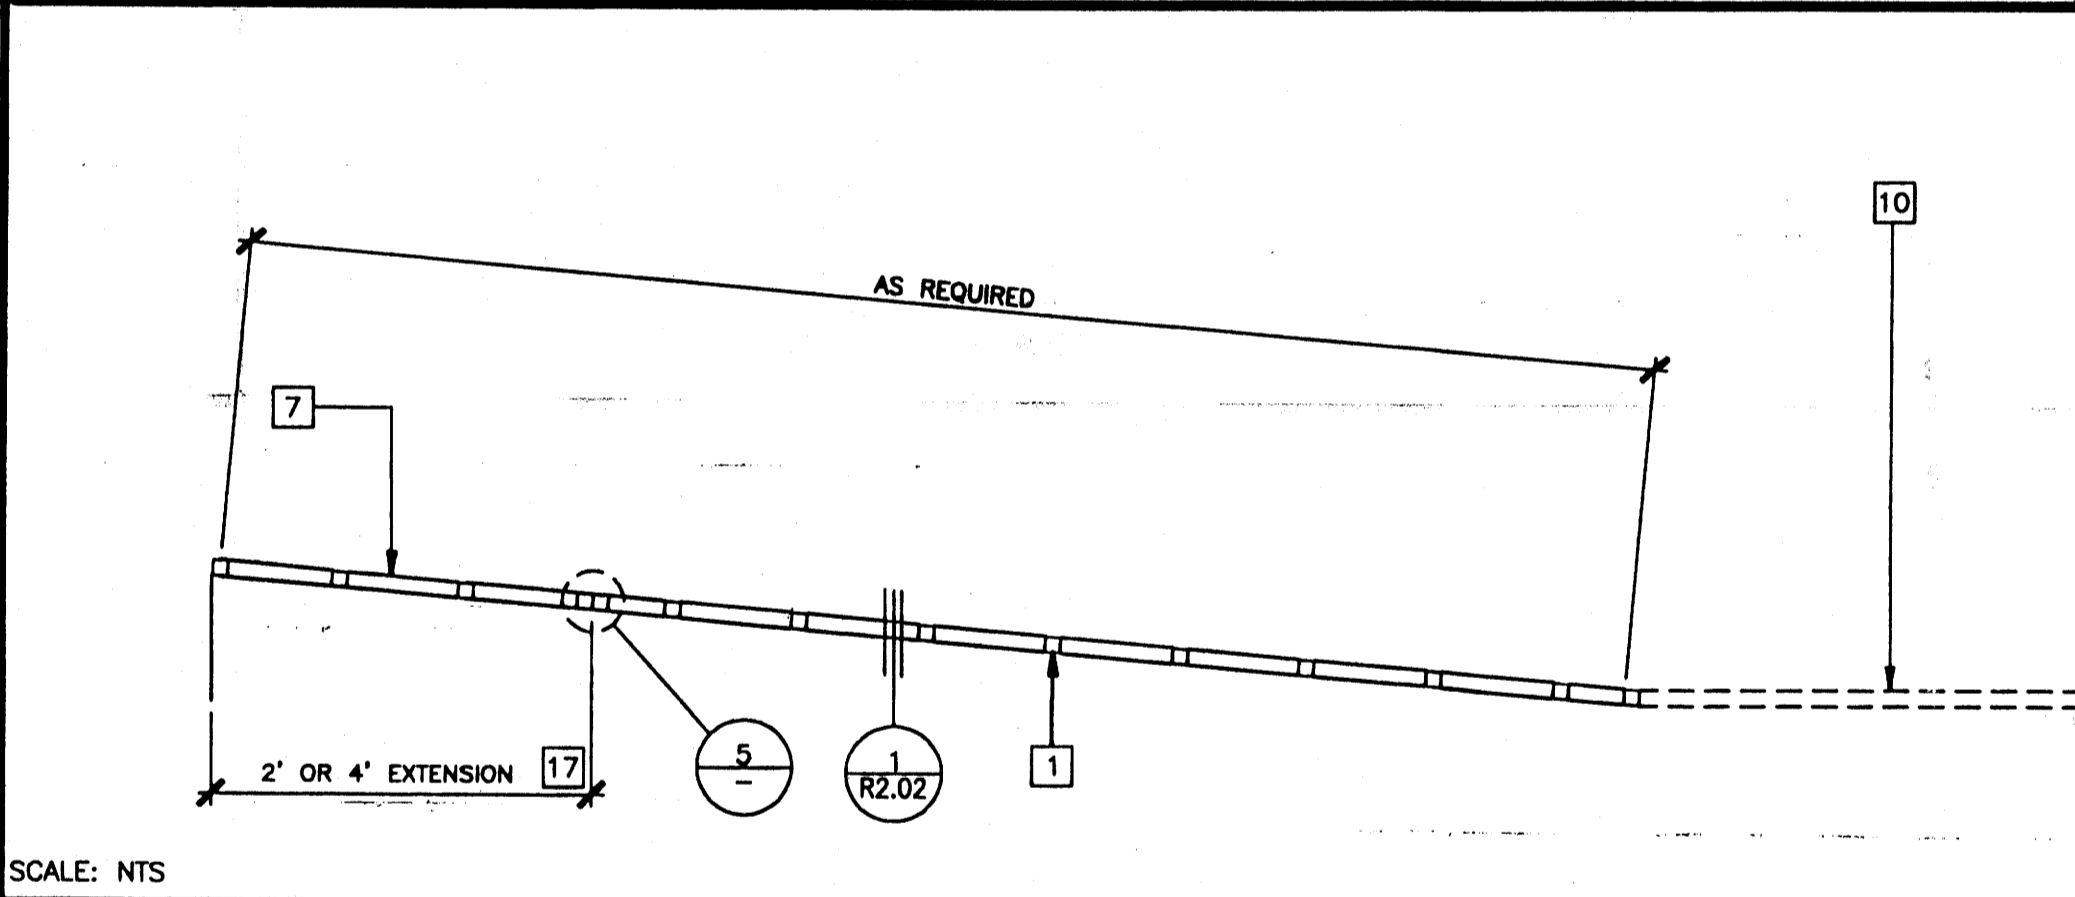

SCALE: NTS
LONGITUDINAL SECTION AT RAMP 9

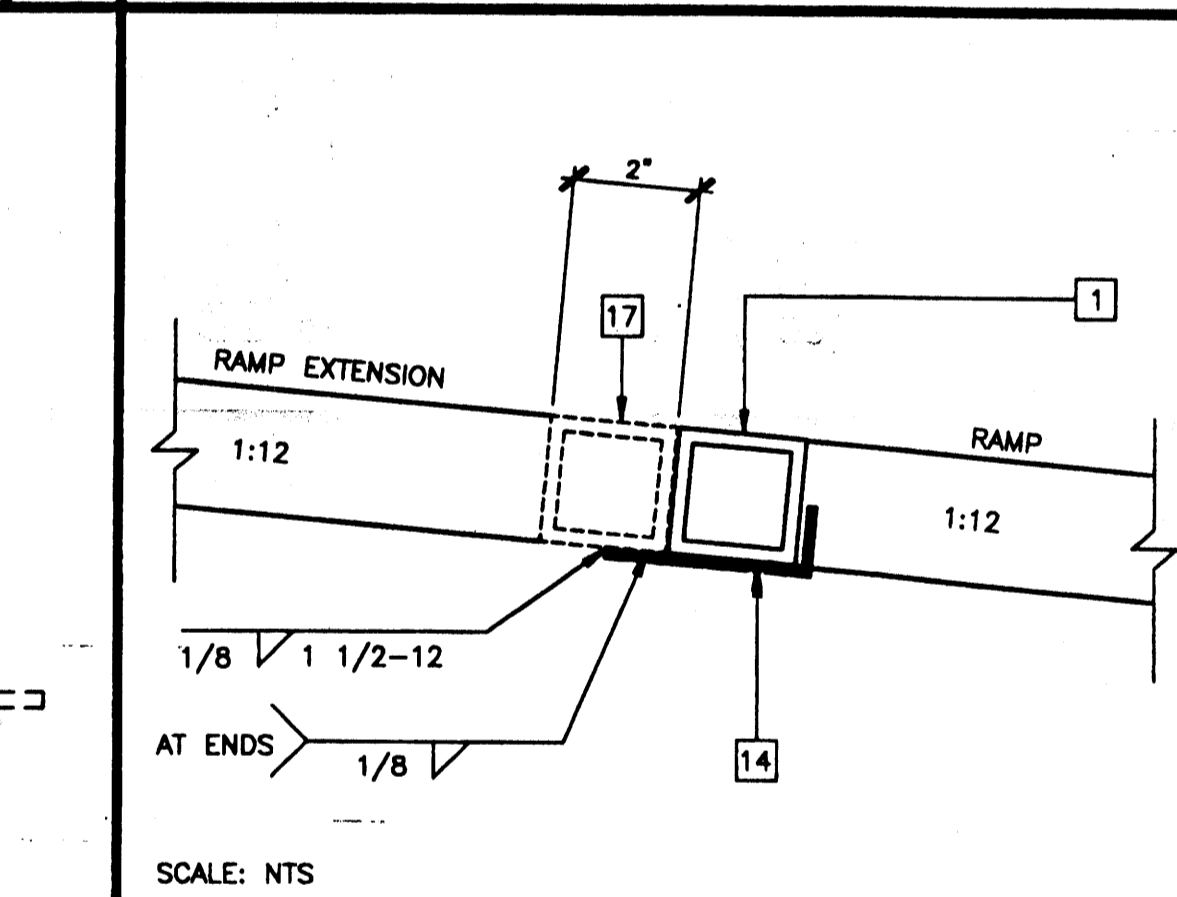

SCALE: NTS
RAMP EXTENSION TO RAMP 5

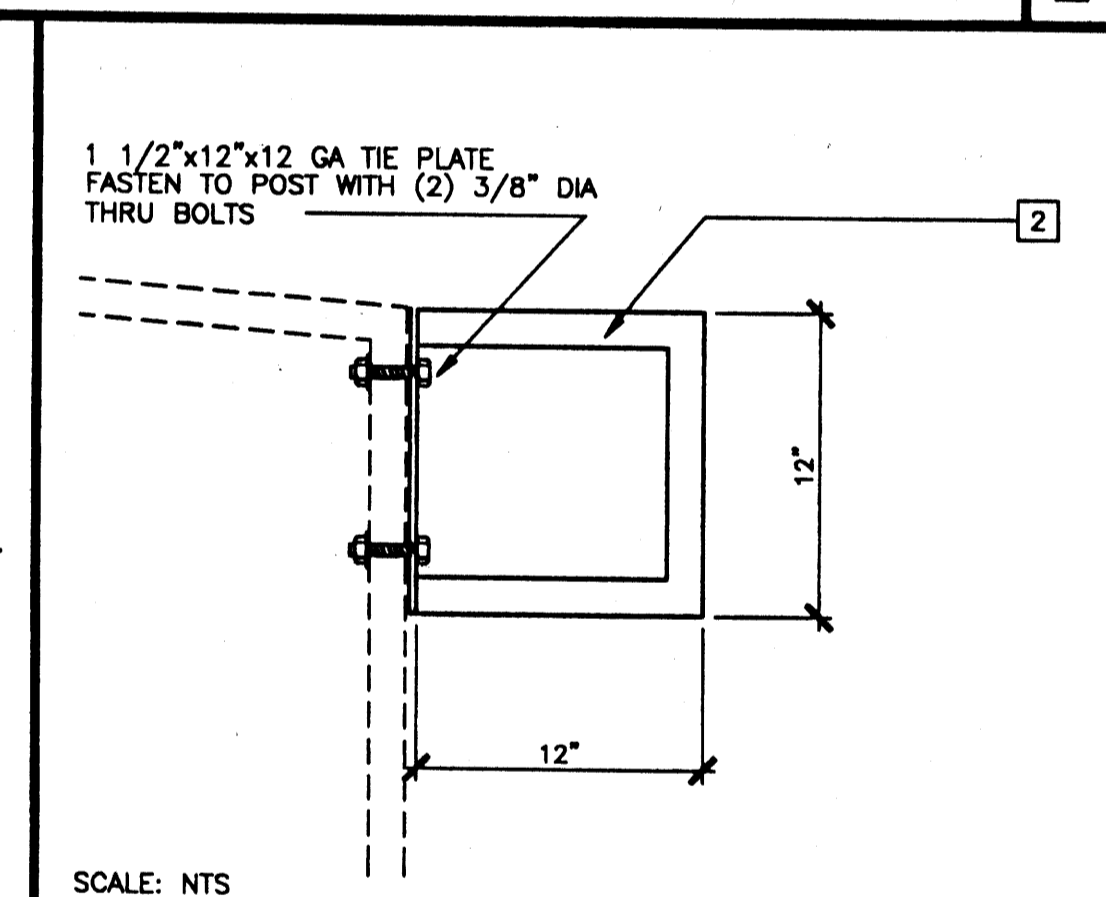

SCALE: NTS
GUARD RAIL EXTENSION 3

- KEY NOTES**
- 1 TS 2"x2"x14 GA
 - 2 TS 1 1/2"x1 1/2"x14 GA (Fy = 39KSI)
 - 3 TS 1"x1"x16 GA WHEELCHAIR GUIDE
 - 4 2"x6" PRESSURE TREATED SILL PLATE
 - 5 2"x4"x12 GA BASE PLATE WITH (2) 1/4"x1" LAGS
 - 6 SKIRTING: PLYWOOD TO MATCH BUILDING SIDING. BLOCK ALL EDGES. ATTACH WITH 8d AT 6" OC EDGES AND 12" OC FIELD. AT EDGE CONNECTION TO T.S. USE #14x2" TEK SCREWS AT 6" OC
 - 7 12GA METAL DECK: NON-SLIP SURFACE. DESIGN COEFFICIENT OF FRICTION GREATER THAN 6%. MAINTAINABLE FOR 1 YEAR
 - 8 EXISTING BUILDING
 - 9 6"x10"x12 GA BASE PLATE AT RAMP TOE
 - 10 LOWER LANDING BY DISTRICT
 - 11 RAMP BY MODTECH
 - 12 FLUSH TRANSITION
 - 13 6"x12"x10 GA PLATE WITH (2) 1/4"x3" LAGS TO STRUCTURAL FRAME OF BUILDING
 - 14 3"x1"x3'-0"x10 GA BENT PLATE
 - 15 LINE OF RAMP/LANDING ABOVE
 - 16 SILL RESTRAINT PIPE 1" DIA - MINIMUM 12" EMBEDMENT
 - 17 RAMP EXTENSION FRAME

REVISED

IDENTIFICATION STAMP
DIV. OF THE STATE ARCHITECT
OFFICE OF REGULATION SERVICES

04 104812
DATE DEC 19 2002

REVISIONS

1			
2			
3			
4			
5			


Electrical Engineer's Seal
Mechanical Engineer's Seal
Structural Engineer's Seal
Architect's Seal

PC
CBC 1998

IDENTIFICATION STAMP
DIV. OF THE STATE ARCHITECT
OFFICE OF REGULATION SERVICES

PC-04
101268
DATE 1 SEP 07 1999

MODTECH INC.
2830 BARRETT AVENUE
PERRIS, CALIF. 92572
PH (909) 943-4014
FAX (909) 940-0427

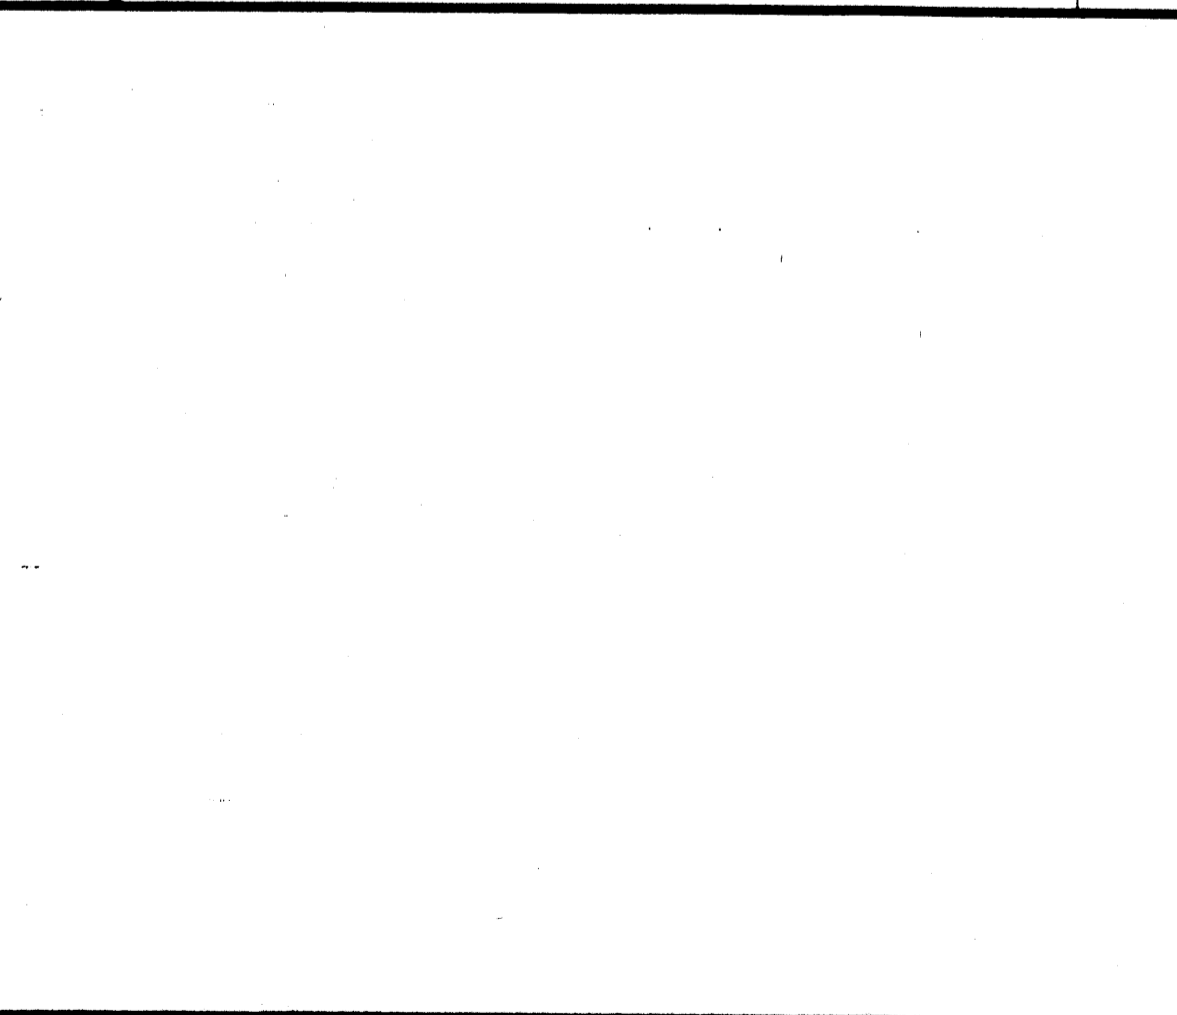

SCALE: NTS
RAMP AT LANDING 4

- NOTES**
1. RAMP: RAMPS SHALL NOT SLOPE MORE THAN 1" IN 12"
 2. HANDRAILS: HANDRAILS AT BOTH SIDES OF RAMP AT 34" HEIGHT.
 3. SURFACE: LANDING & RAMP TO HAVE NON-SLIP SURFACE AMCOR GRIP II AS MANUFACTURED BY AMERICAN CHEMICAL COMPANY (OR EQUAL)
 4. GROUNDING: PROVIDE GROUNDING OF RAMP TO BUILDING FRAME WITH #8 COPPER TO BOTH GROUND LUGS.
 5. ARCHITECT SITE/RAMP/LANDING PLANNING: DUE TO VARYING SITE CONDITIONS THE MAXIMUM HEIGHT OF FINISH FLOOR FROM GRADE IS 26". THEREFORE IT IS POSSIBLE THAT THE ACCESS RAMP ATTACHED TO THE BUILDING COULD BE 26'-0" AT A SLOPE OF 1:12. ARCHITECT MUST TAKE INTO ACCOUNT THAT THE RAMP SUPPLIED BY MODTECH INC. IS 11'-0" AT A SLOPE OF 1:12. THEREFORE THE ARCHITECT WILL HAVE TO DESIGN AND PROVIDE DETAILS OF RAMP EXTENSIONS AND BOTTOM LANDING DEPENDING ON PARTICULAR SITE CONDITIONS. IN NO WAY IS MODTECH INC RESPONSIBLE FOR ANY RAMP EXTENSION EXCEEDING THE ORIGINAL PLAN AS SHOWN ON THIS SHEET
 6. ALL 1 1/4" AND 1 1/2" TUBE STEEL TO BE OF ASTM A500 GRADE A STEEL (Fy = 39 KSI)

PROJECT NUMBER: 4444
© MODTECH, INC. 1999
CLASS LEASING INC STOCKPILE # 67
100-24 x 40 CLASSROOM BUILDINGS
4012-124 12/05/2002 80 MPH


DRAWN BY:
DATE:
CHECKED BY:
DATE:

MODTECH Index No.


RAMP/LANDING

R2.01


FILE PATH: 2440-R2.01.DWG PROJECT NO. PC-04-101268

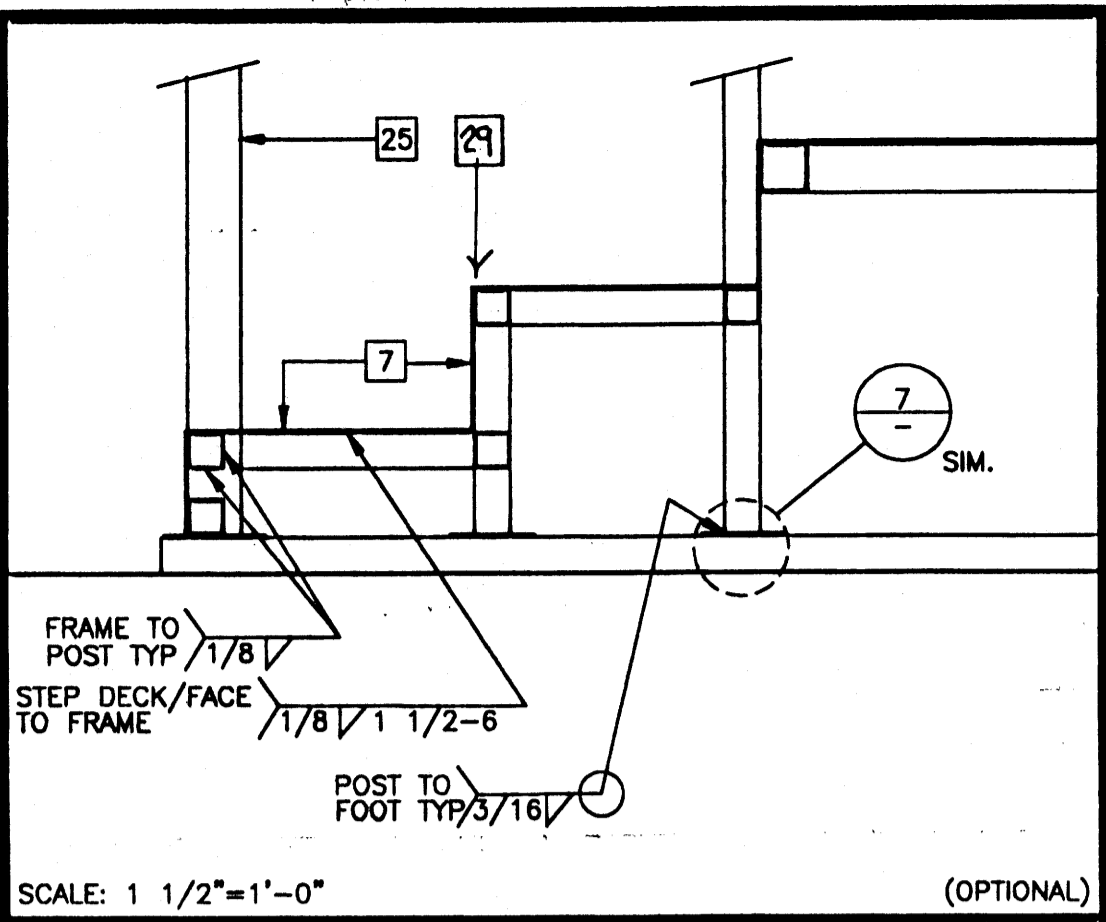


STAIR SECTION 16

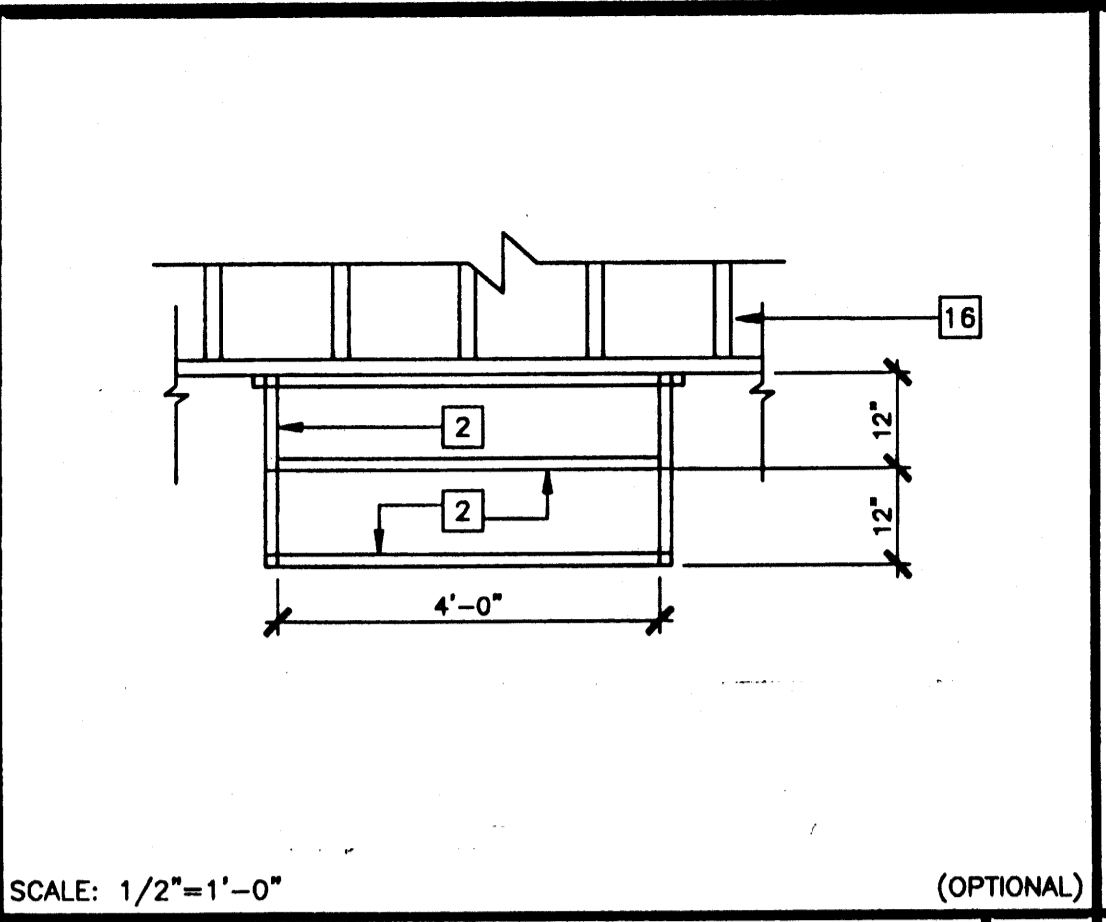


STAIR FRAMING PLAN 12

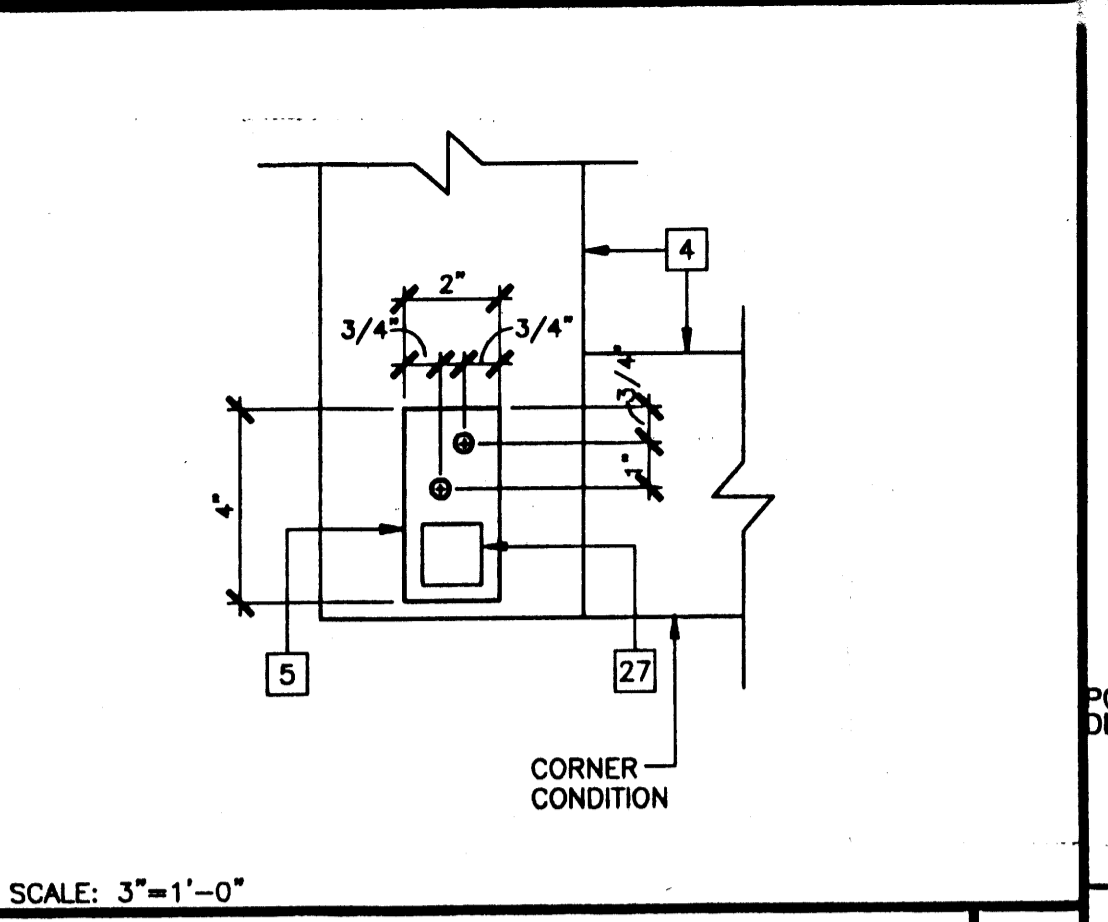


ADJUSTABLE LEG BASE PLATE 8

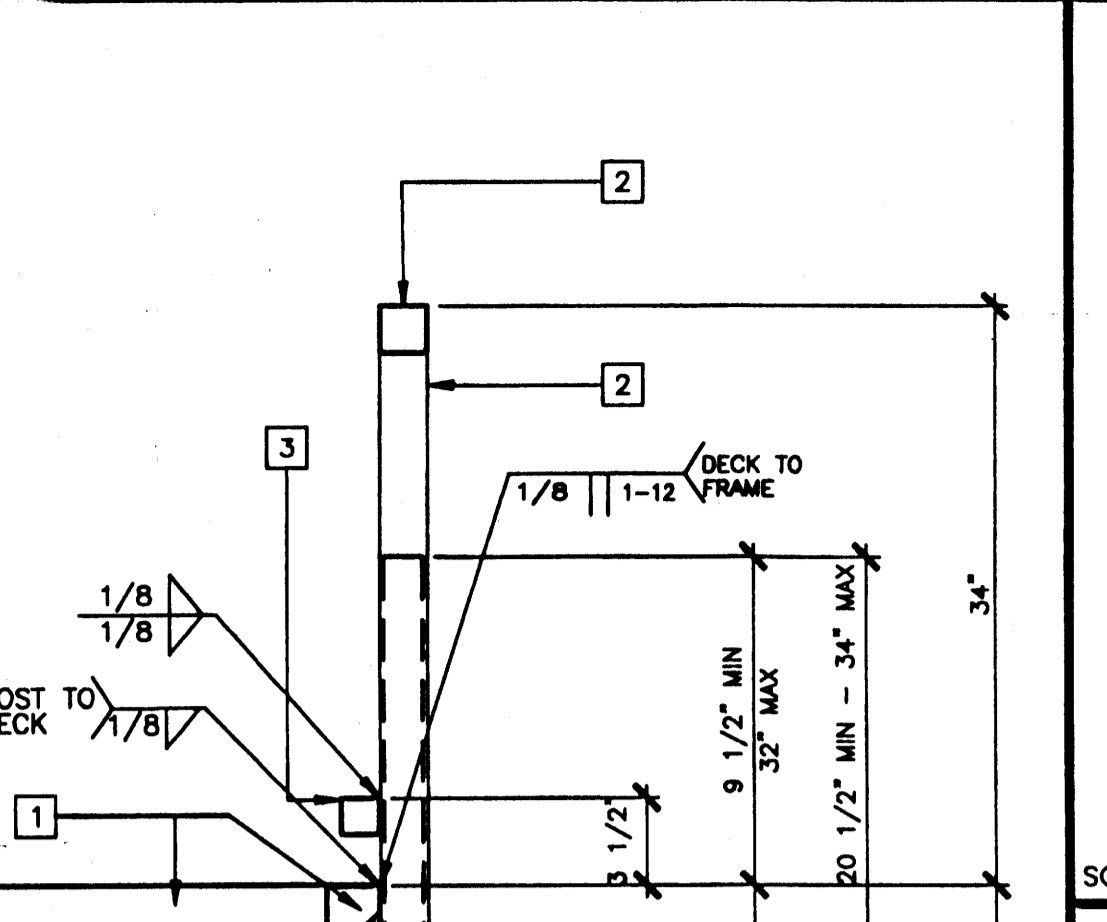


ADJUSTABLE LEG 5

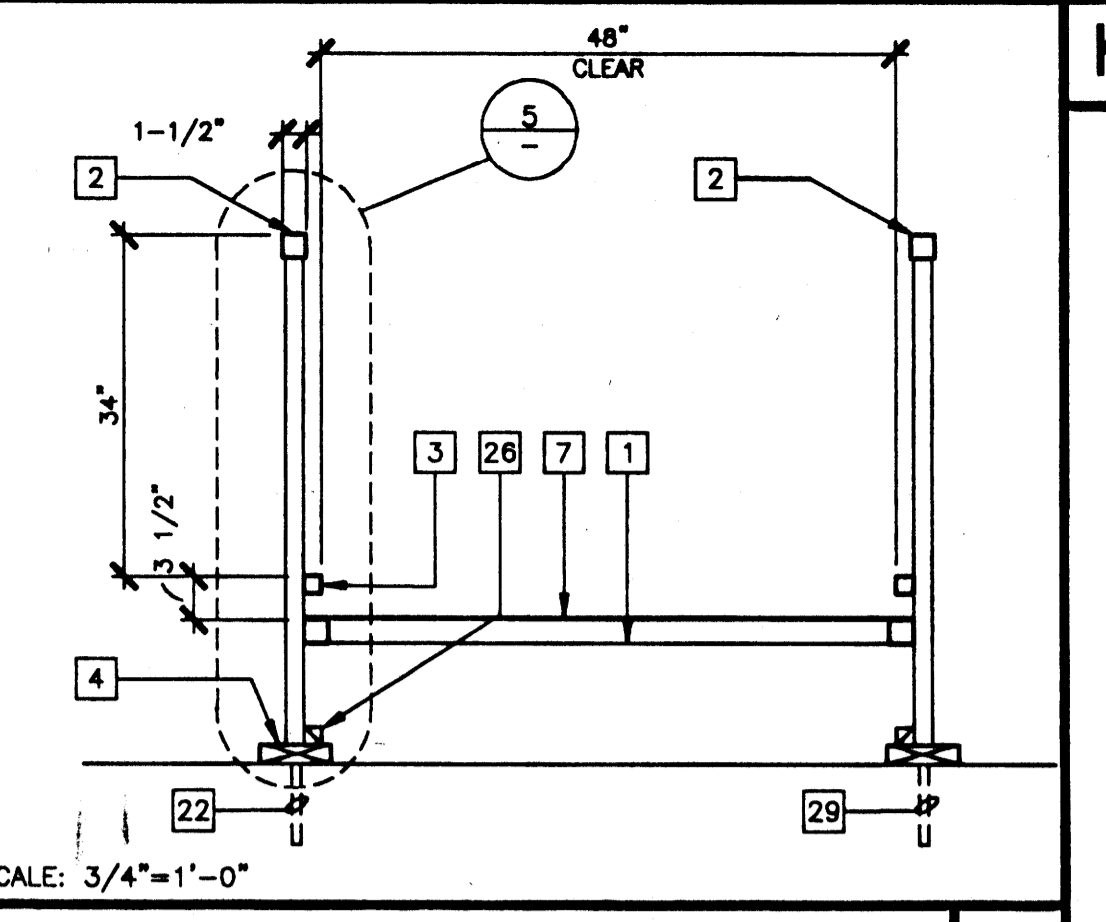


SECTION AT RAMP 1

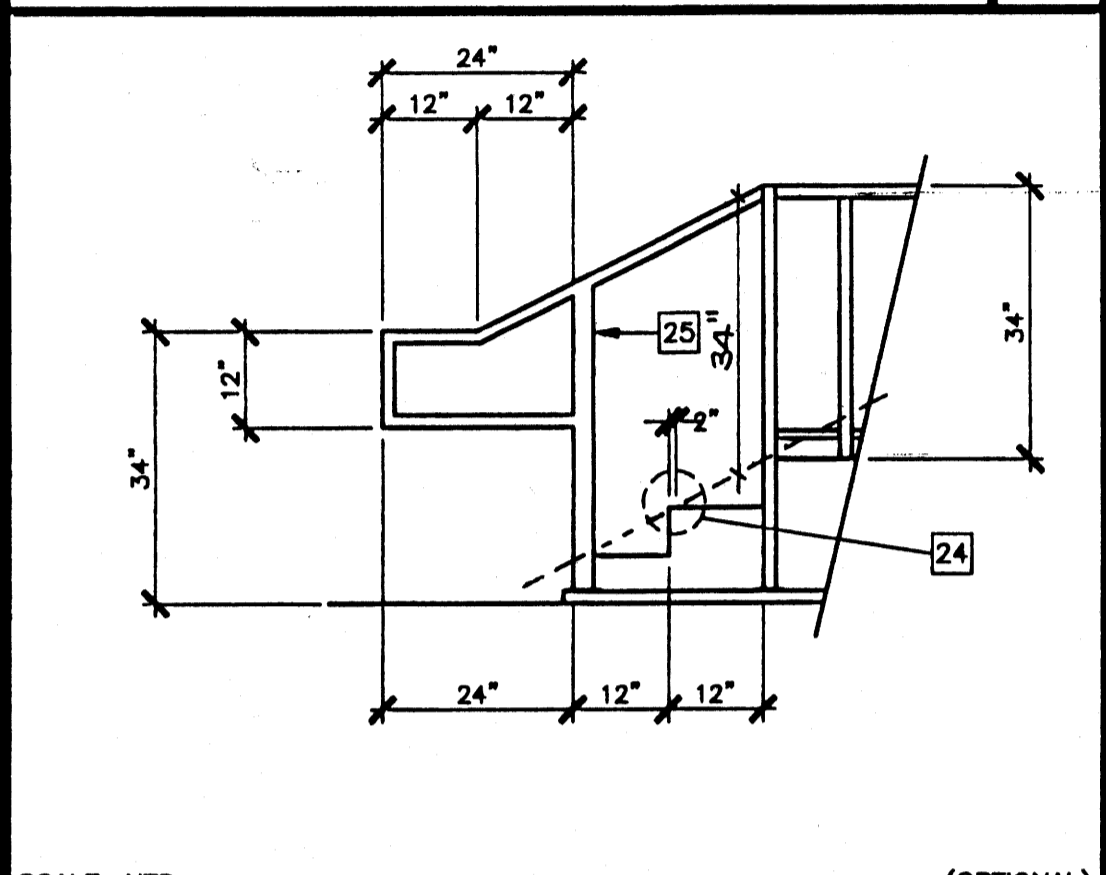


STAIR ELEVATION 17

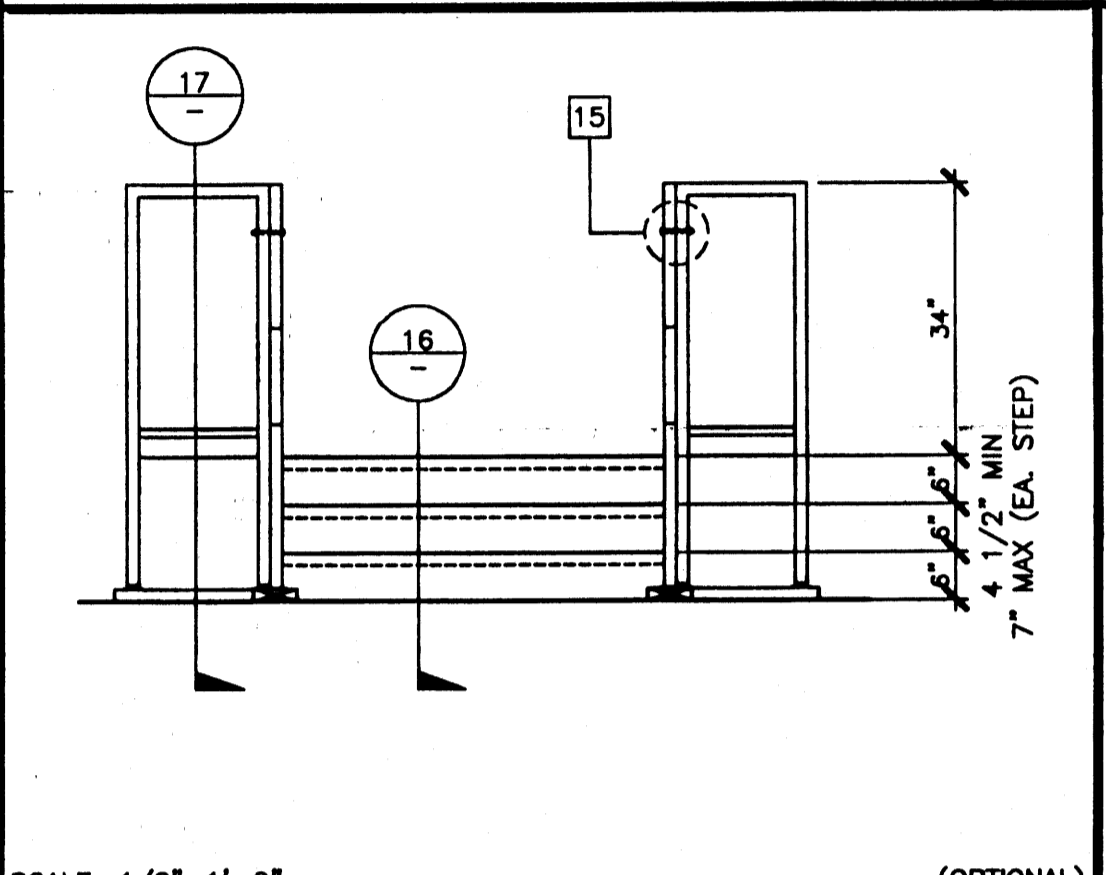


STAIR ELEVATION 13

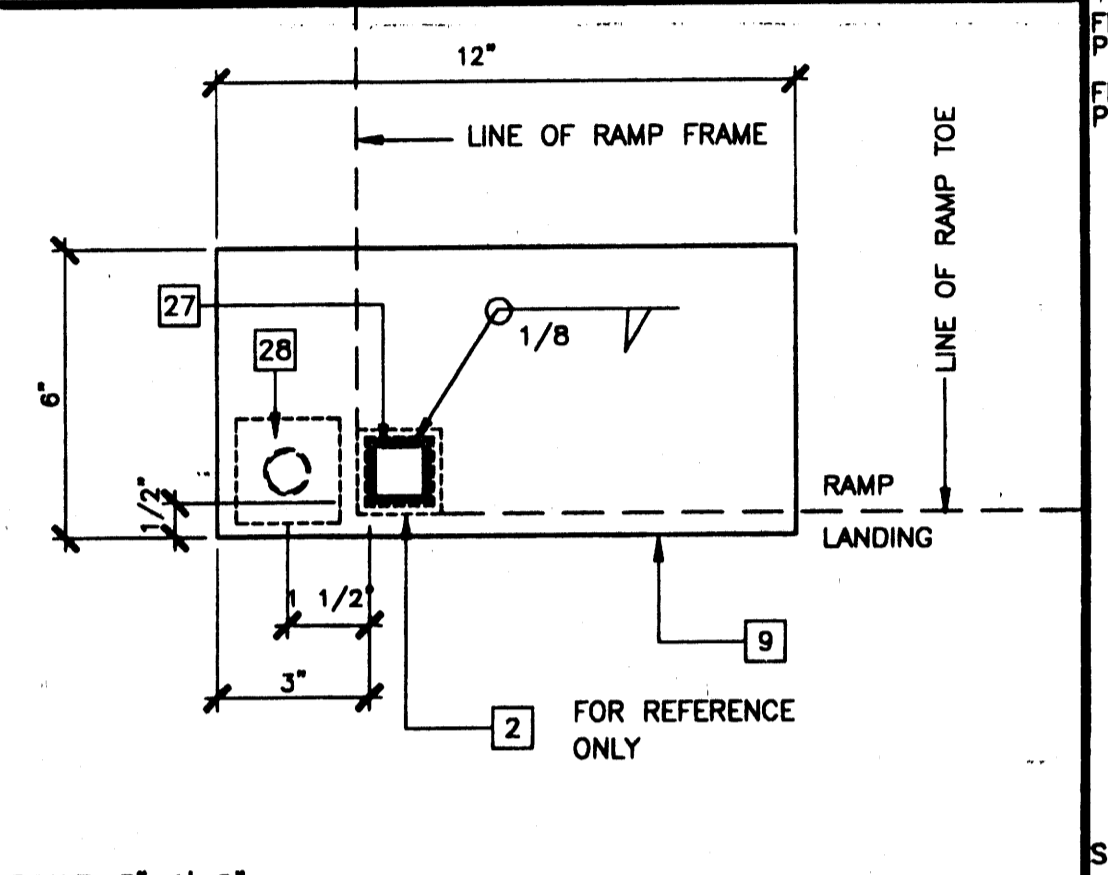


BASE PLATE AT RAMP TOE 9

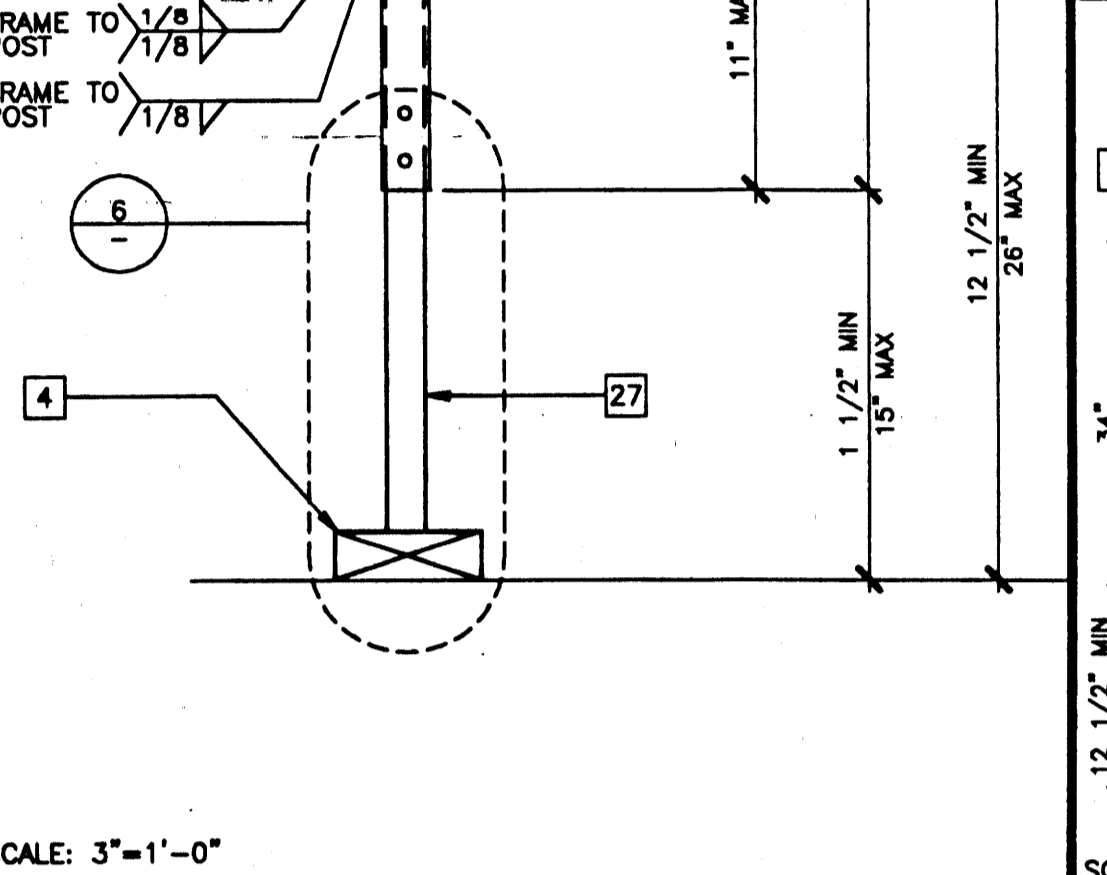


ADJUSTABLE LEG 5

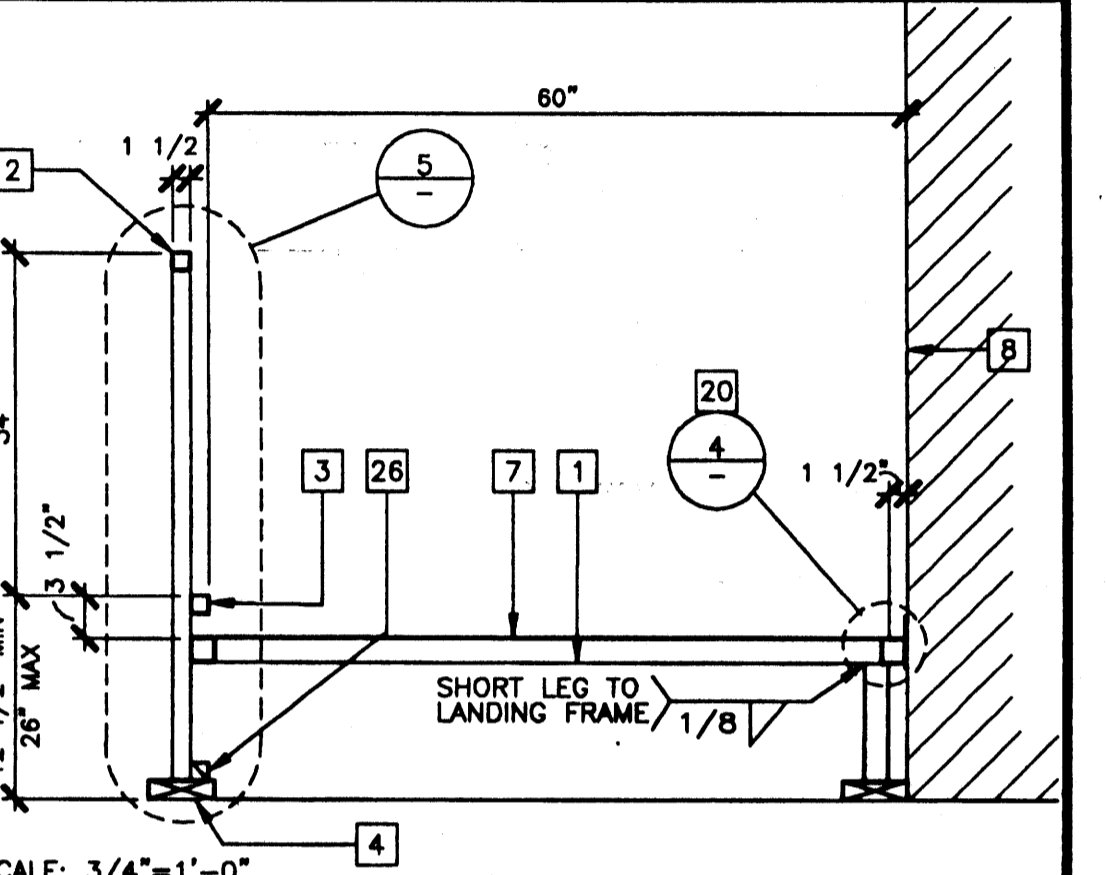


SECTION AT LANDING 2

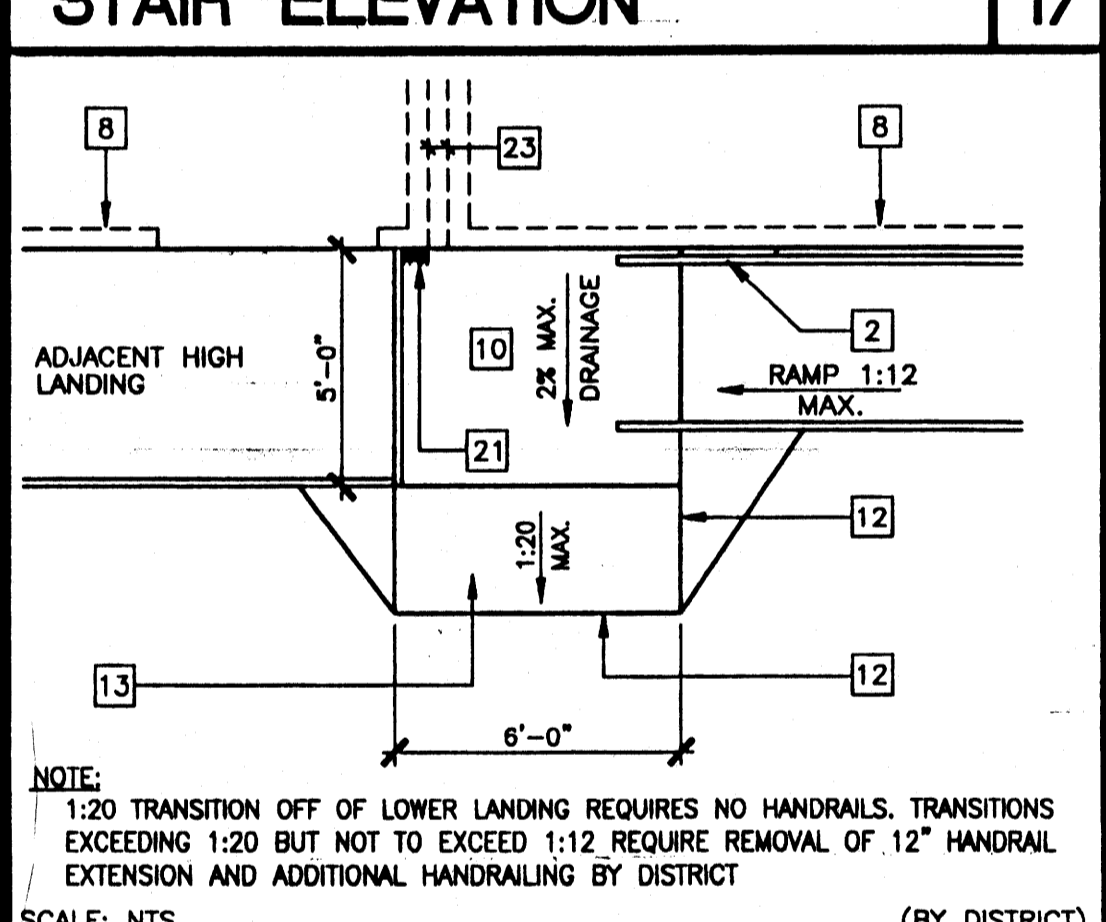


RAMP TRANSITION 18

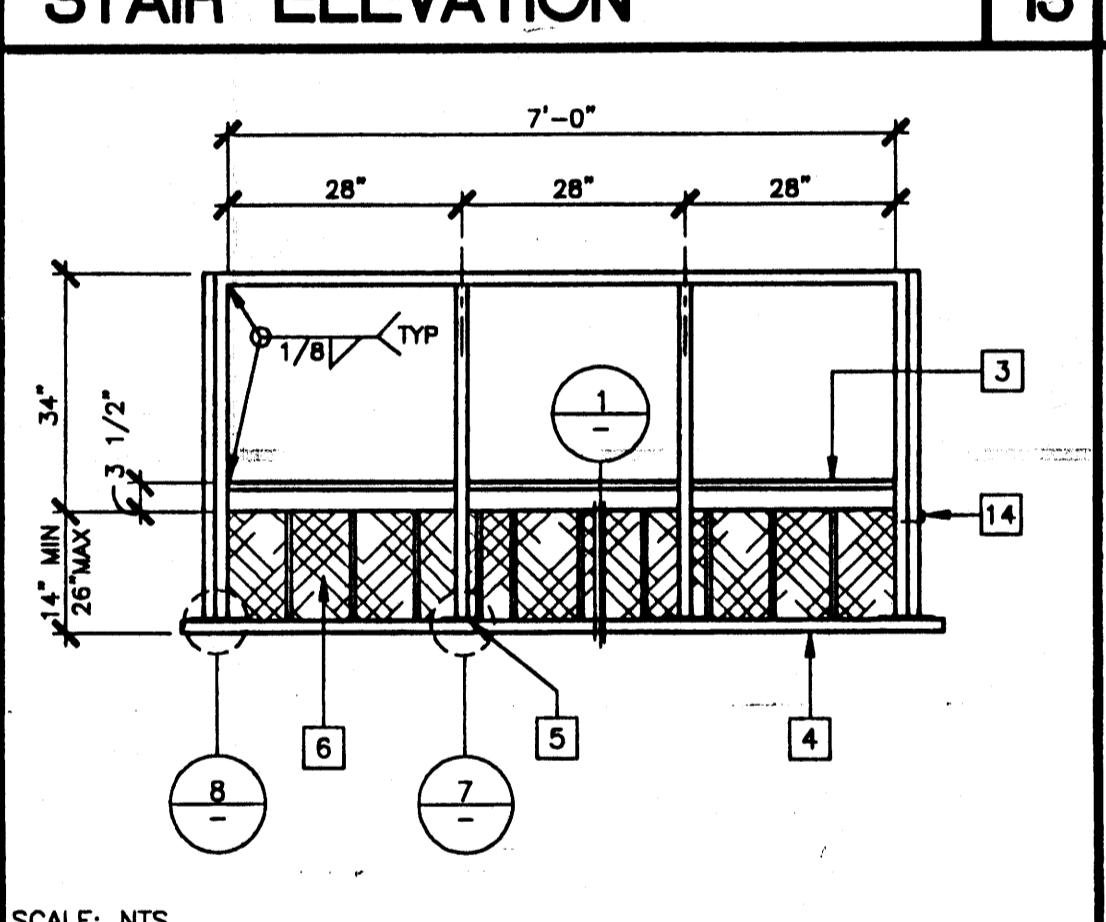


LANDING ELEVATION 14

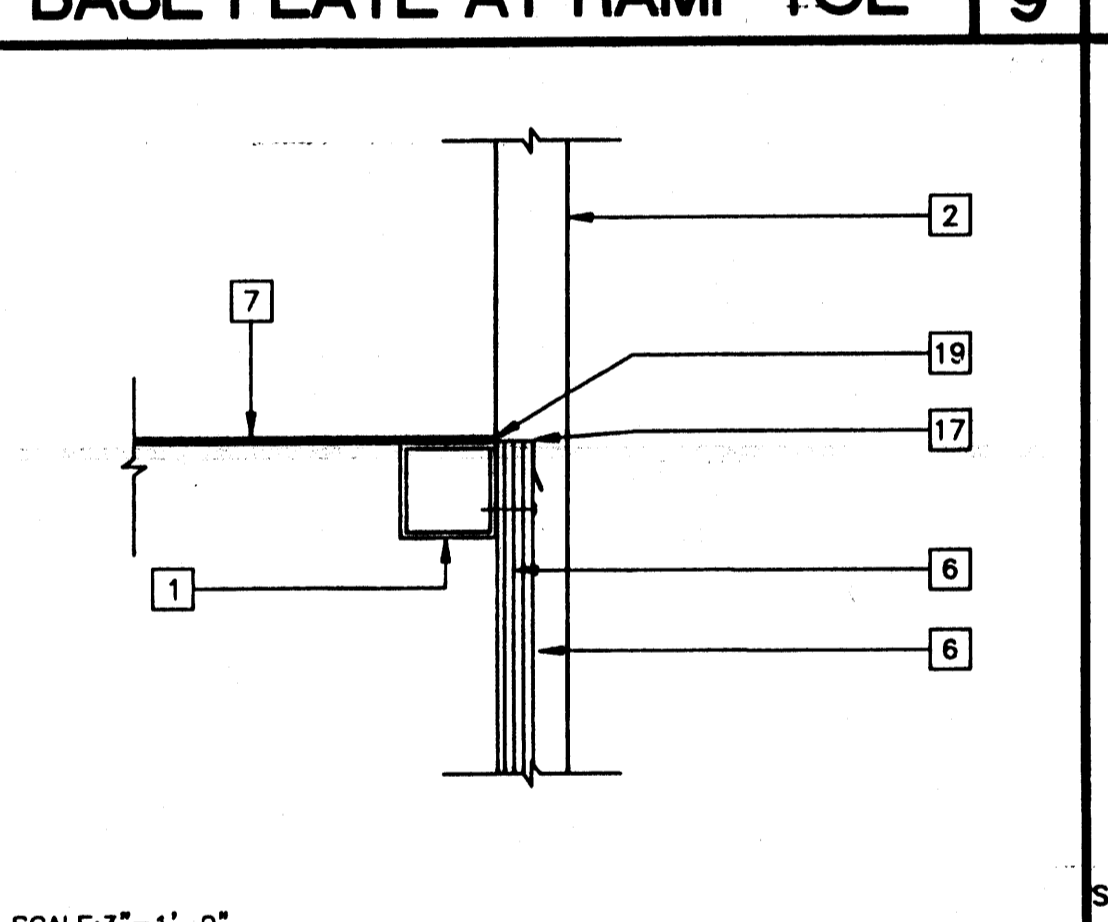


SKIRT FLASHING 10

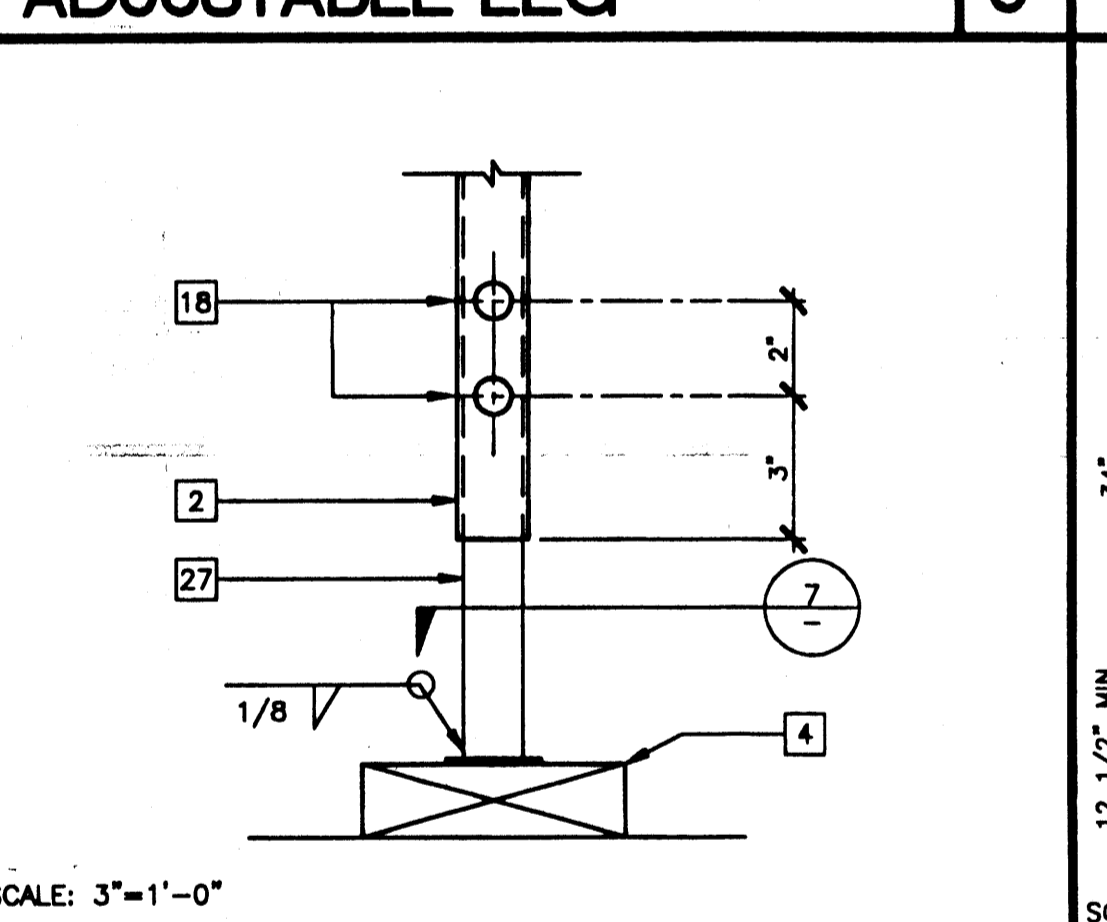


ADJUSTABLE LEG 6

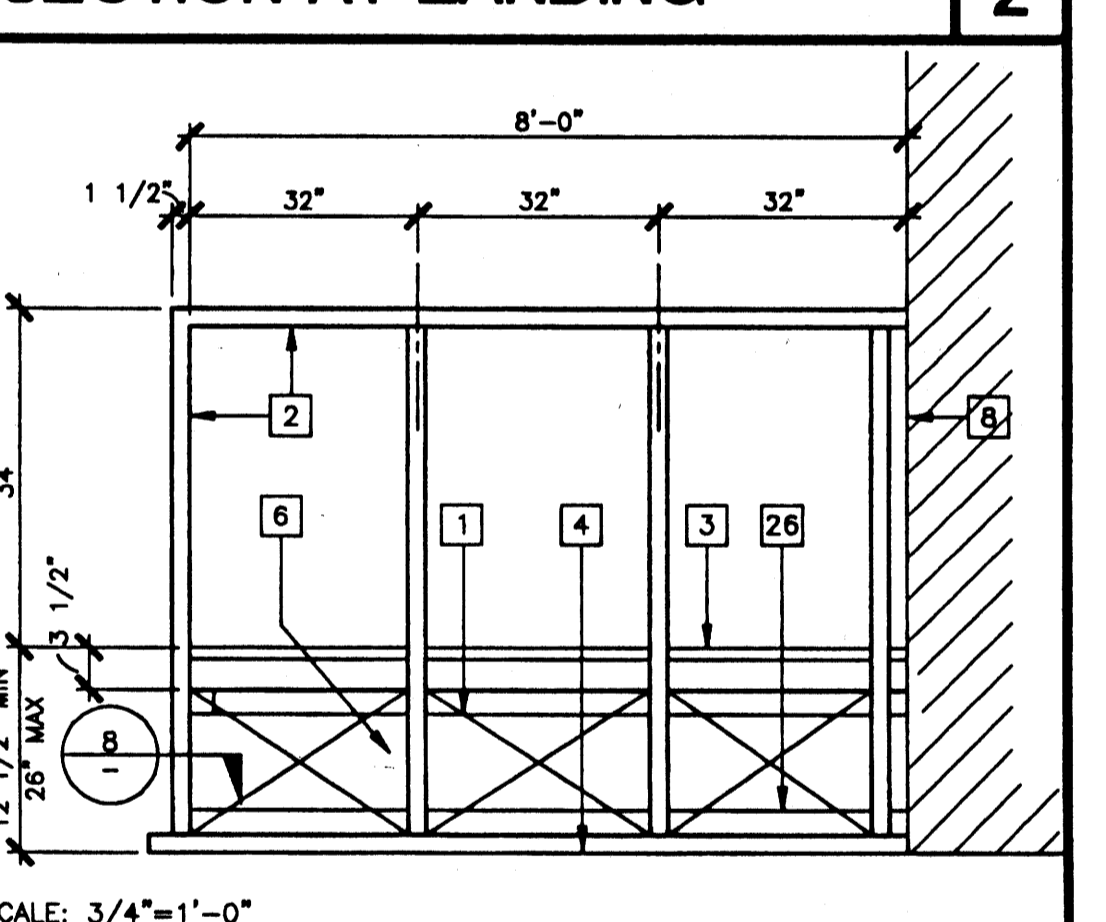


END ELEVATION 3

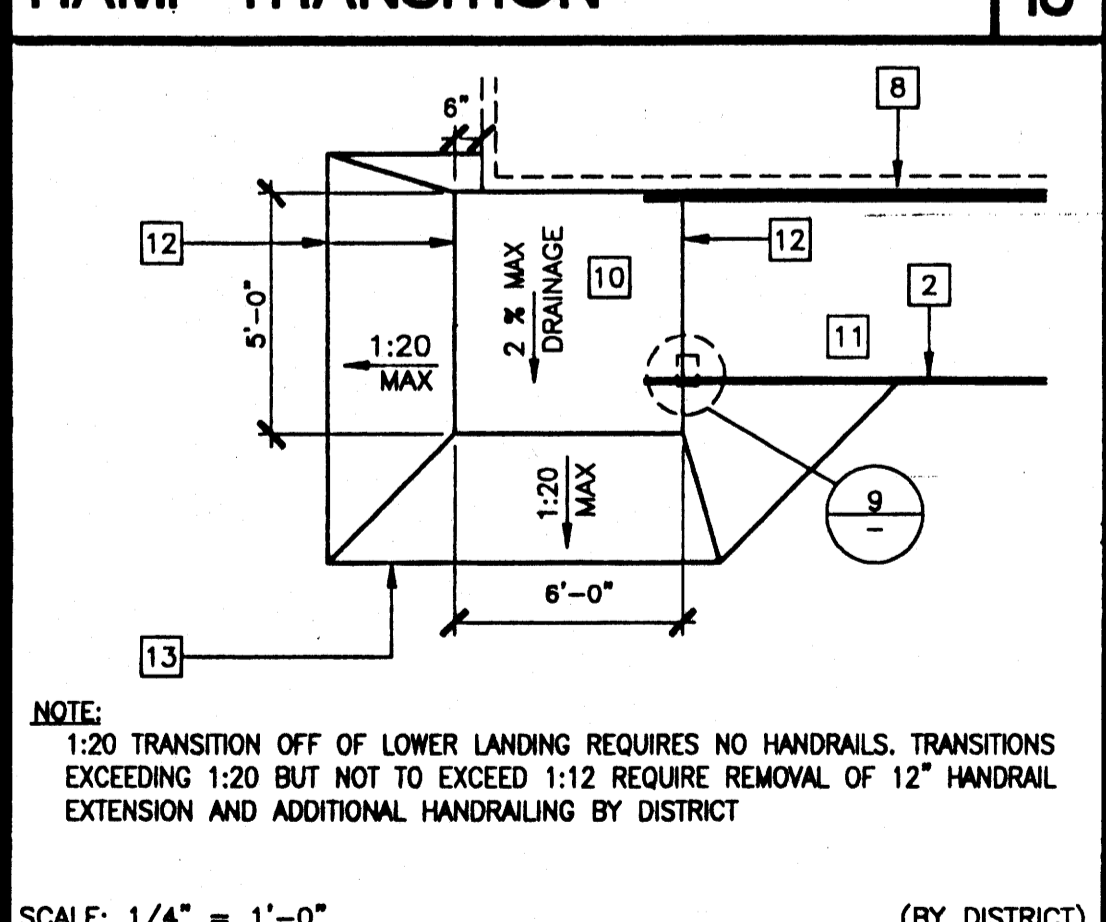


RAMP TRANSITION 19

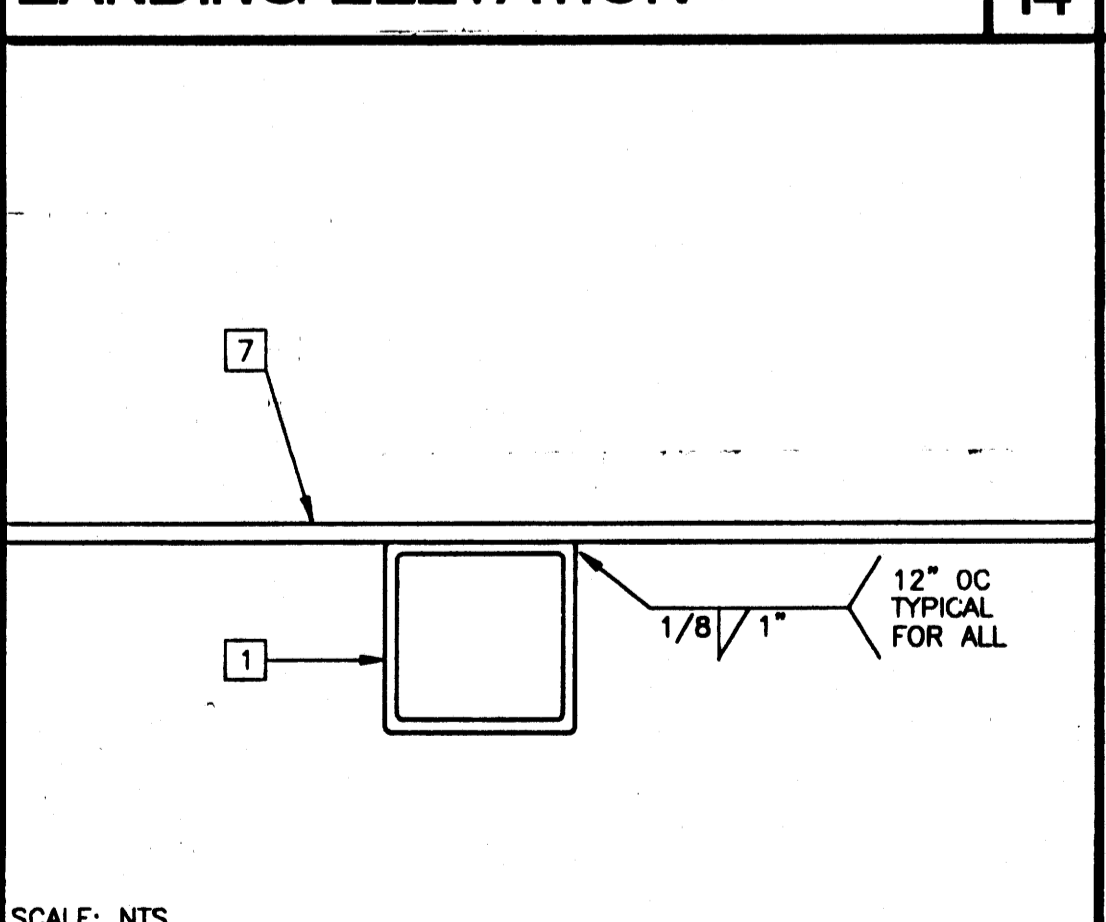


SECTION AT INTERIOR FRAME 15

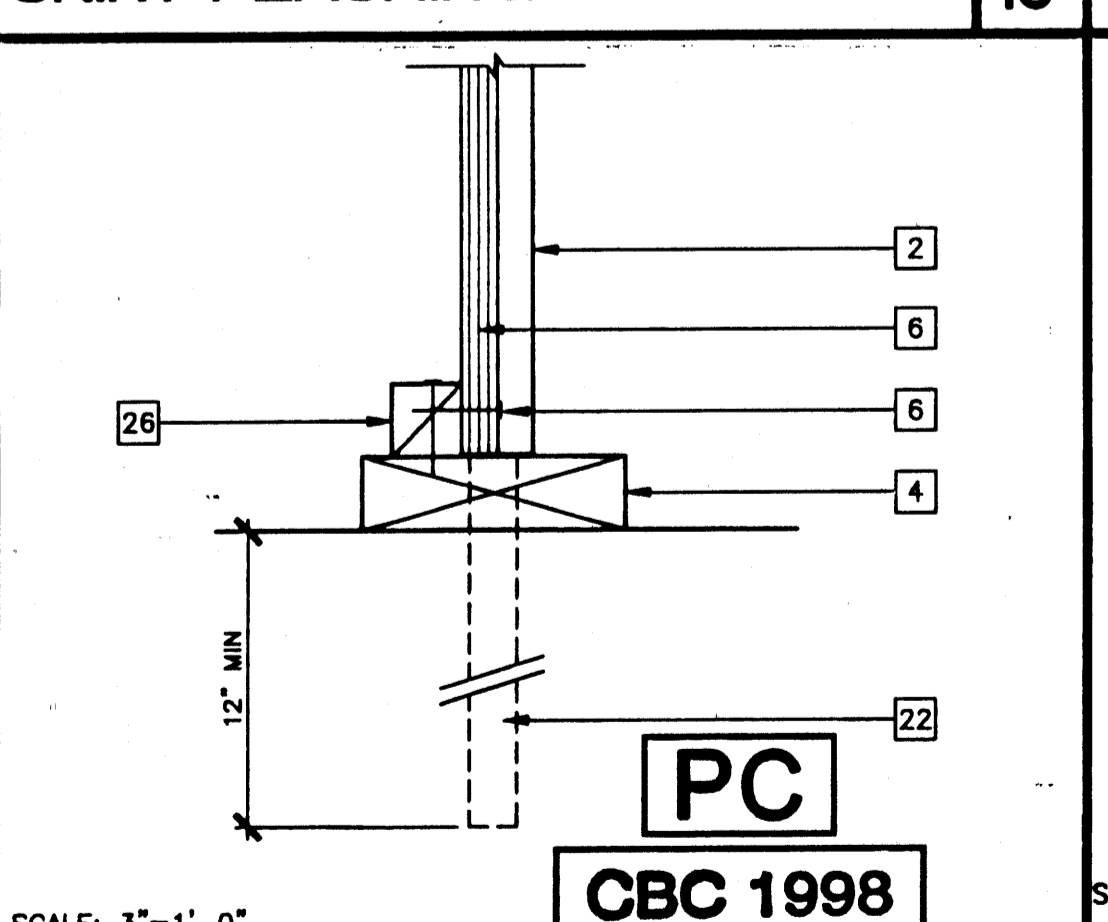

SKIRT AT SILL PLATE 11

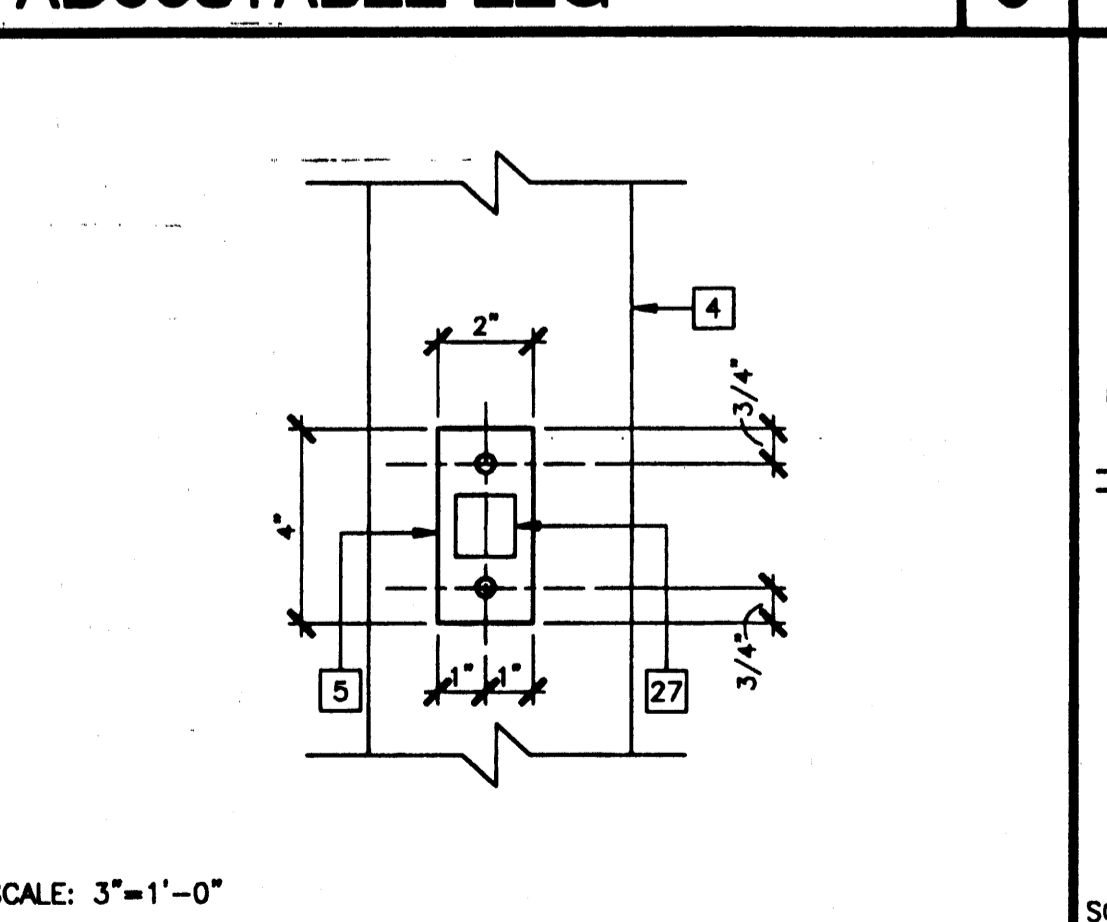

ADJUSTABLE LEG BASE PLATE 7

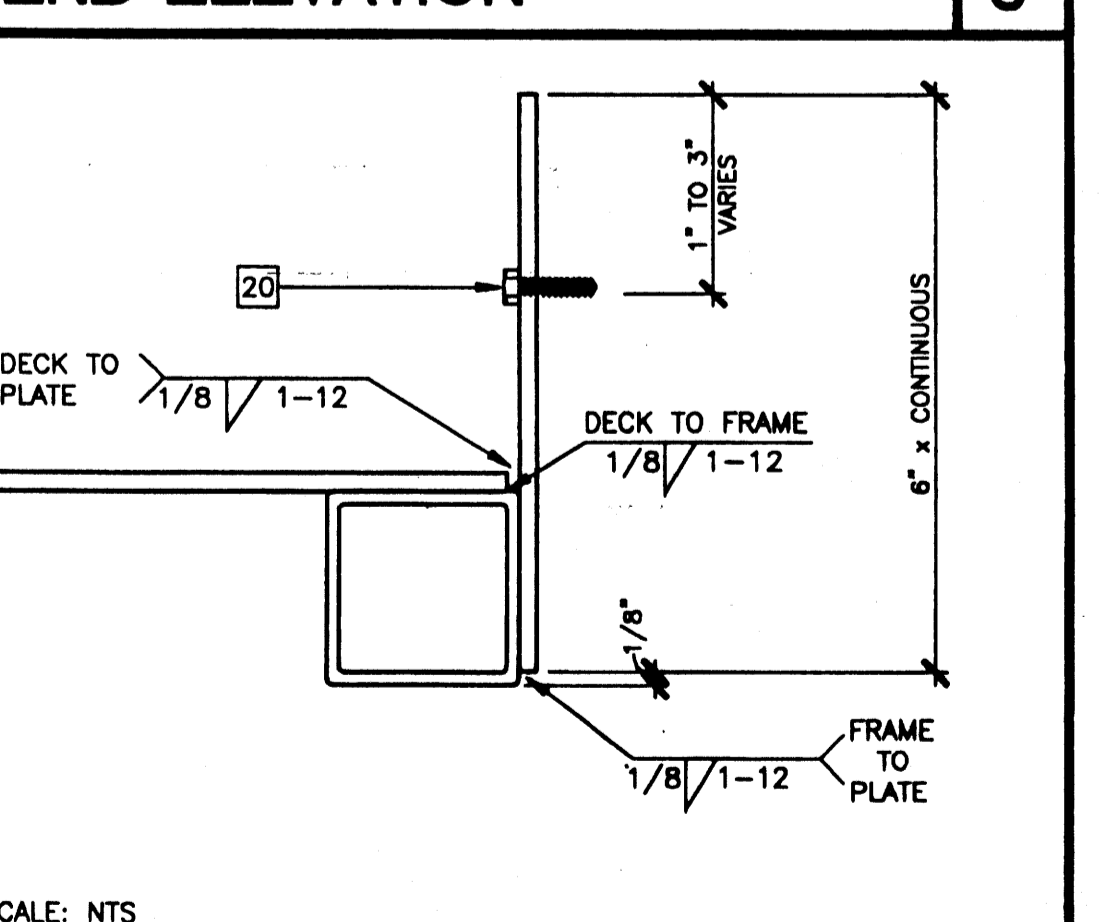

SECTION AT PLATE 4

- KEY NOTES**
- TS 2"x2"x14 GA
 - TS 1 1/2"x1 1/2"x14 GA (Fy = 39 KSI)
 - TS 1"x1"x16 GA WHEELCHAIR GUIDE
 - 2"x6" PRESSURE TREATED SILL PLATE
 - 2"x4"x12 GA BASE PLATE WITH 2-1/4"x1" LAGS
 - SKIRTING: PLYWOOD TO MATCH BUILDING SIDING. BLOCK ALL EDGES. ATTACH WITH 8d AT 6" OC EDGES AND 12" OC FIELD. AT EDGE CONNECTION TO T.S. USE #14x2" TEK SCREWS AT 6" OC
 - 12GA METAL DECK: NON-SLIP SURFACE. DESIGN COEFFICIENT OF FRICTION GREATER THAN 6%. MAINTAINABLE FOR 1 YR.
 - EXISTING BUILDING.
 - 6"x10"x12 GA BASE PLATE AT RAMP TOE.
 - LOWER LANDING BY DISTRICT
 - RAMP BY MODTECH
 - FLUSH TRANSITION
 - PAVE BY DISTRICT.
 - 3"x1"x3'-0"x10 GA BENT PLATE
 - FASTEN POSTS WITH 3/8" THRU BOLT, TYPICAL
 - RAMP LANDING, TYPICAL
 - 26 GA FLASHING
 - 3/8"x2" LONG MB WITH NUT & WASHERS
 - CAULKING
 - 6" x 10GA CONTINUOUS PLATE W / #14 x 2" TEK SCREWS AT 9" OC INTO WOOD OR FOUNDATION BLOCKS OR #14 x 2" TEK SCREWS INTO METAL AT 9" OC
 - PROVIDE DIVERSION FOR WATER FROM DOWNSPOUT FOR THIS CONDITION. BY DISTRICT
 - SILL RESTRAINT PIPE 1" - 12" MINIMUM EMBEDMENT
 - 3" MINIMUM BUILDING SEPERATION
 - 2" SLIP RESISTANT WARNING STRIPES MAX 1" FROM EVERY STAIR NOSING. USE CONTRASTING COLOR.
 - TS 2 1/2"x1 1/2"x8 GA ASTM A500 GRADE A
 - 2"x2" NAILER WITH 16d AT 12" OC
 - TS 1 1/4"x1 1/4"x14 GA (Fy = 39 KSI)
 - SILL RESTRAINT PIPE 1" - 12" MINIMUM EMBEDMENT WITH 2"x2"x1/4" CAP PLATE WELDED TO PIPE
 - PROVIDE ROUNDED OR BEVELED EDGES ON STAIR NOSING.

REVISIONS

1		
2		
3		
4		

Electrical Engineer's Seal
Mechanical Engineer's Seal
Structural Engineer's Seal
Architects Seal

IDENTIFICATION STAMP
DIV. OF THE STATE ARCHITECT
OFFICE OF REGULATION SERVICES
PC-04
101268
DATE SEP 07 2002


MODTECH INC.
2830 BARRETT AVENUE
PERRIS, CALIF. 92572
PH (909) 943-4014
FAX (909) 940-0427

PROJECT NUMBER: 447
© MODTECH, INC. 1999
CLASS LEASING INC STOCKPILE # 67
100-24 x 40 CLASSROOM BUILDINGS
4012-124 12/05/2002 80 MPH


DRAWN BY:
DATE:
CHECKED BY:
DATE:
MODTECH Index No.

R2.02


FILE PATH: 2440-R2.02.DWG
PROJECT NO. PC-04-101268

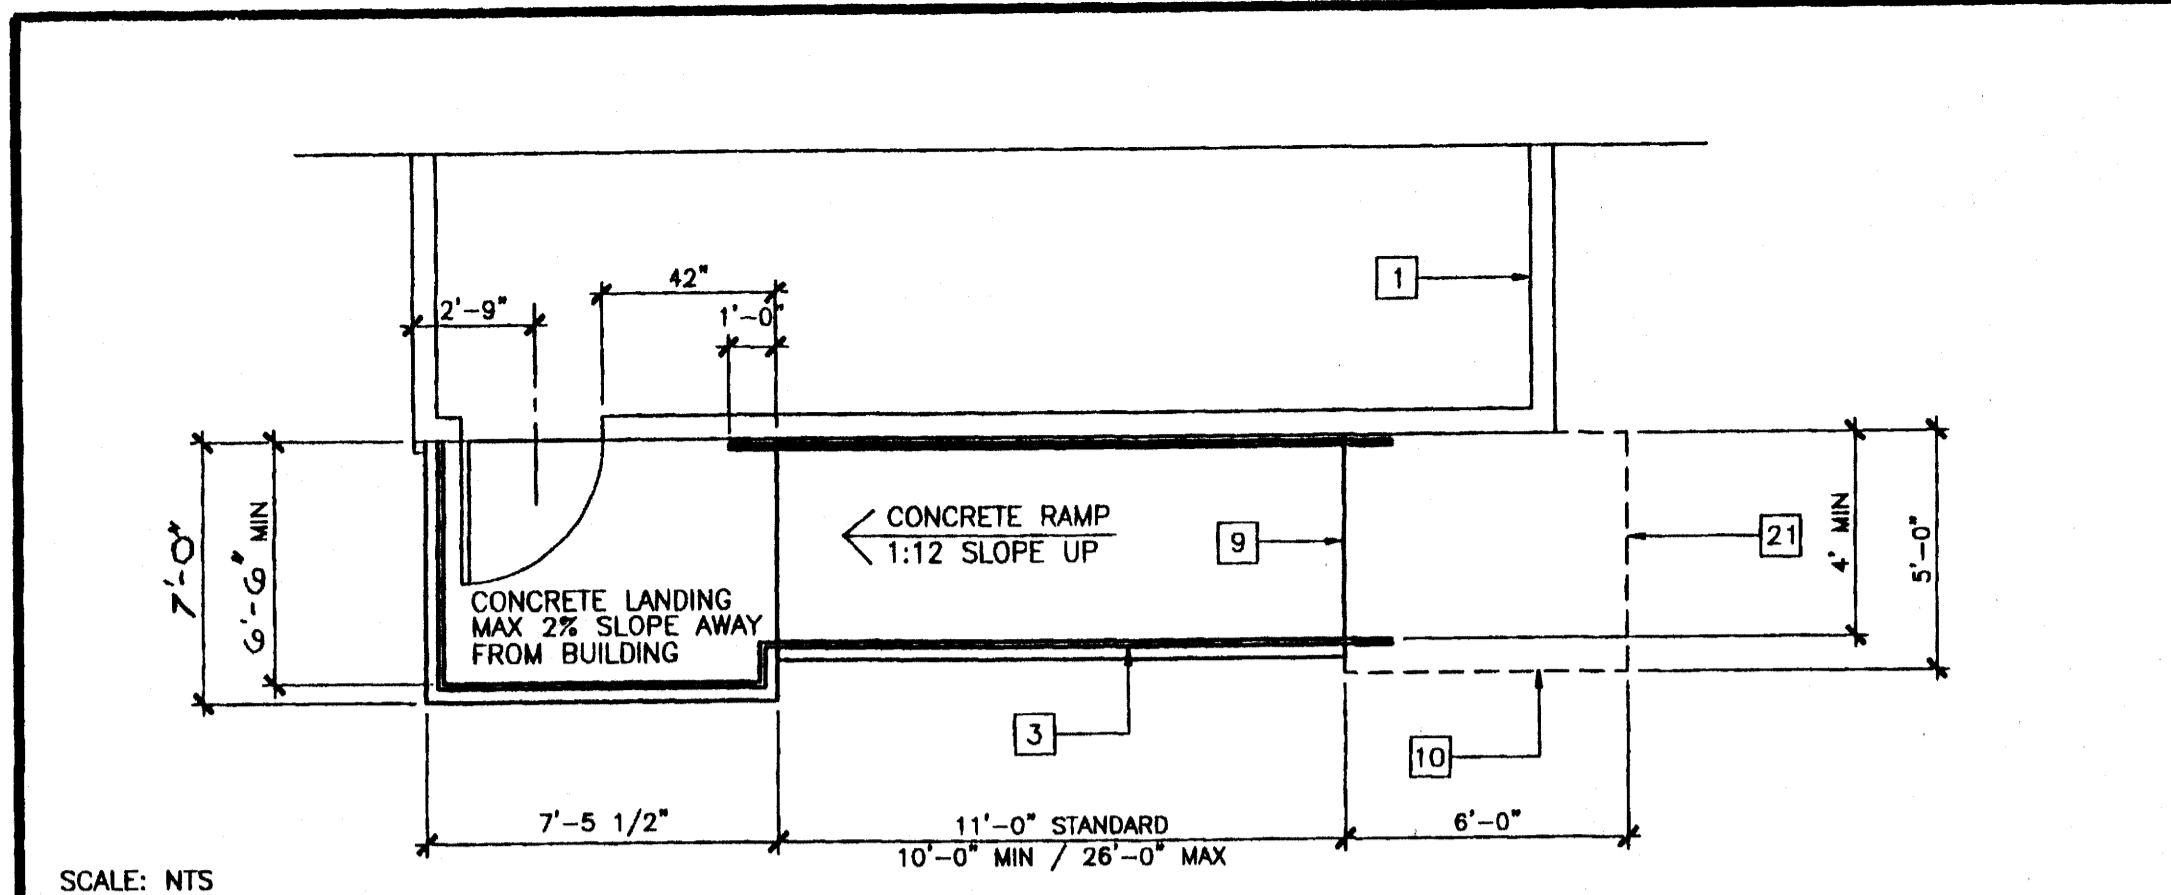


RAMP PLAN AT BUILDING

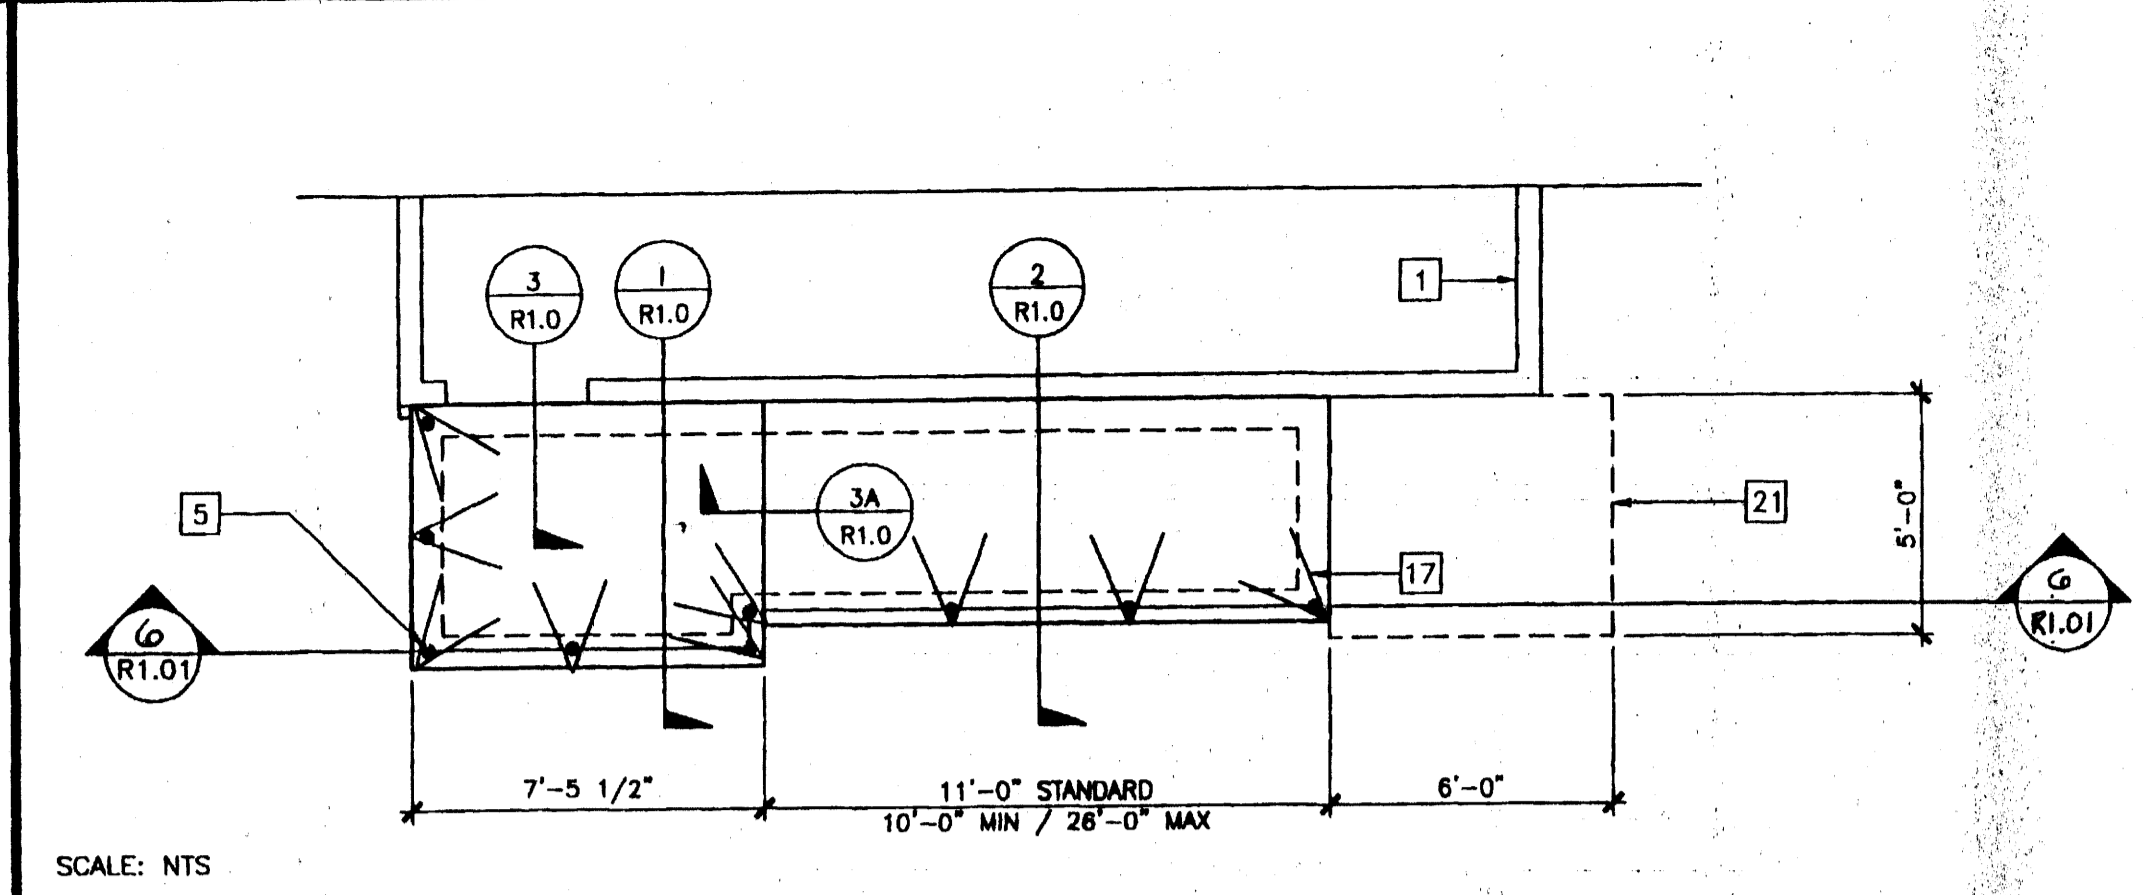


FOUNDATION PLAN

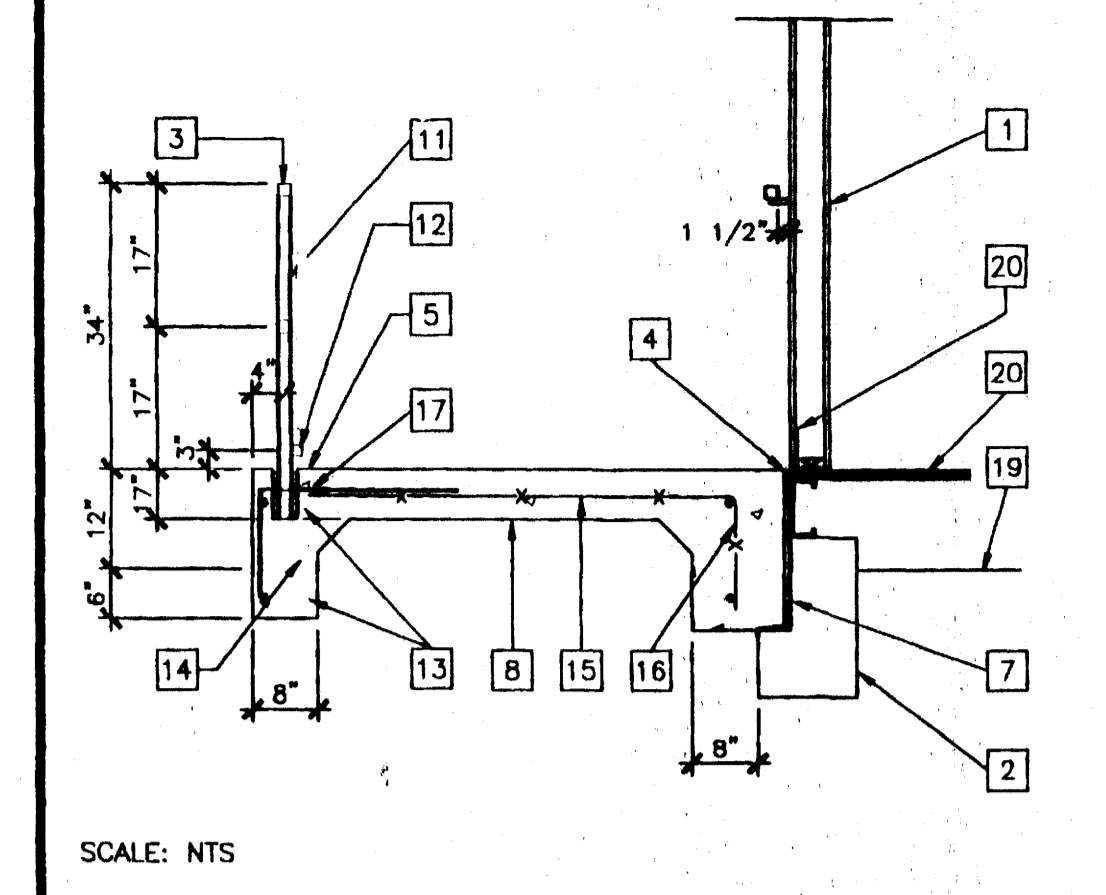


SECTION AT LANDING

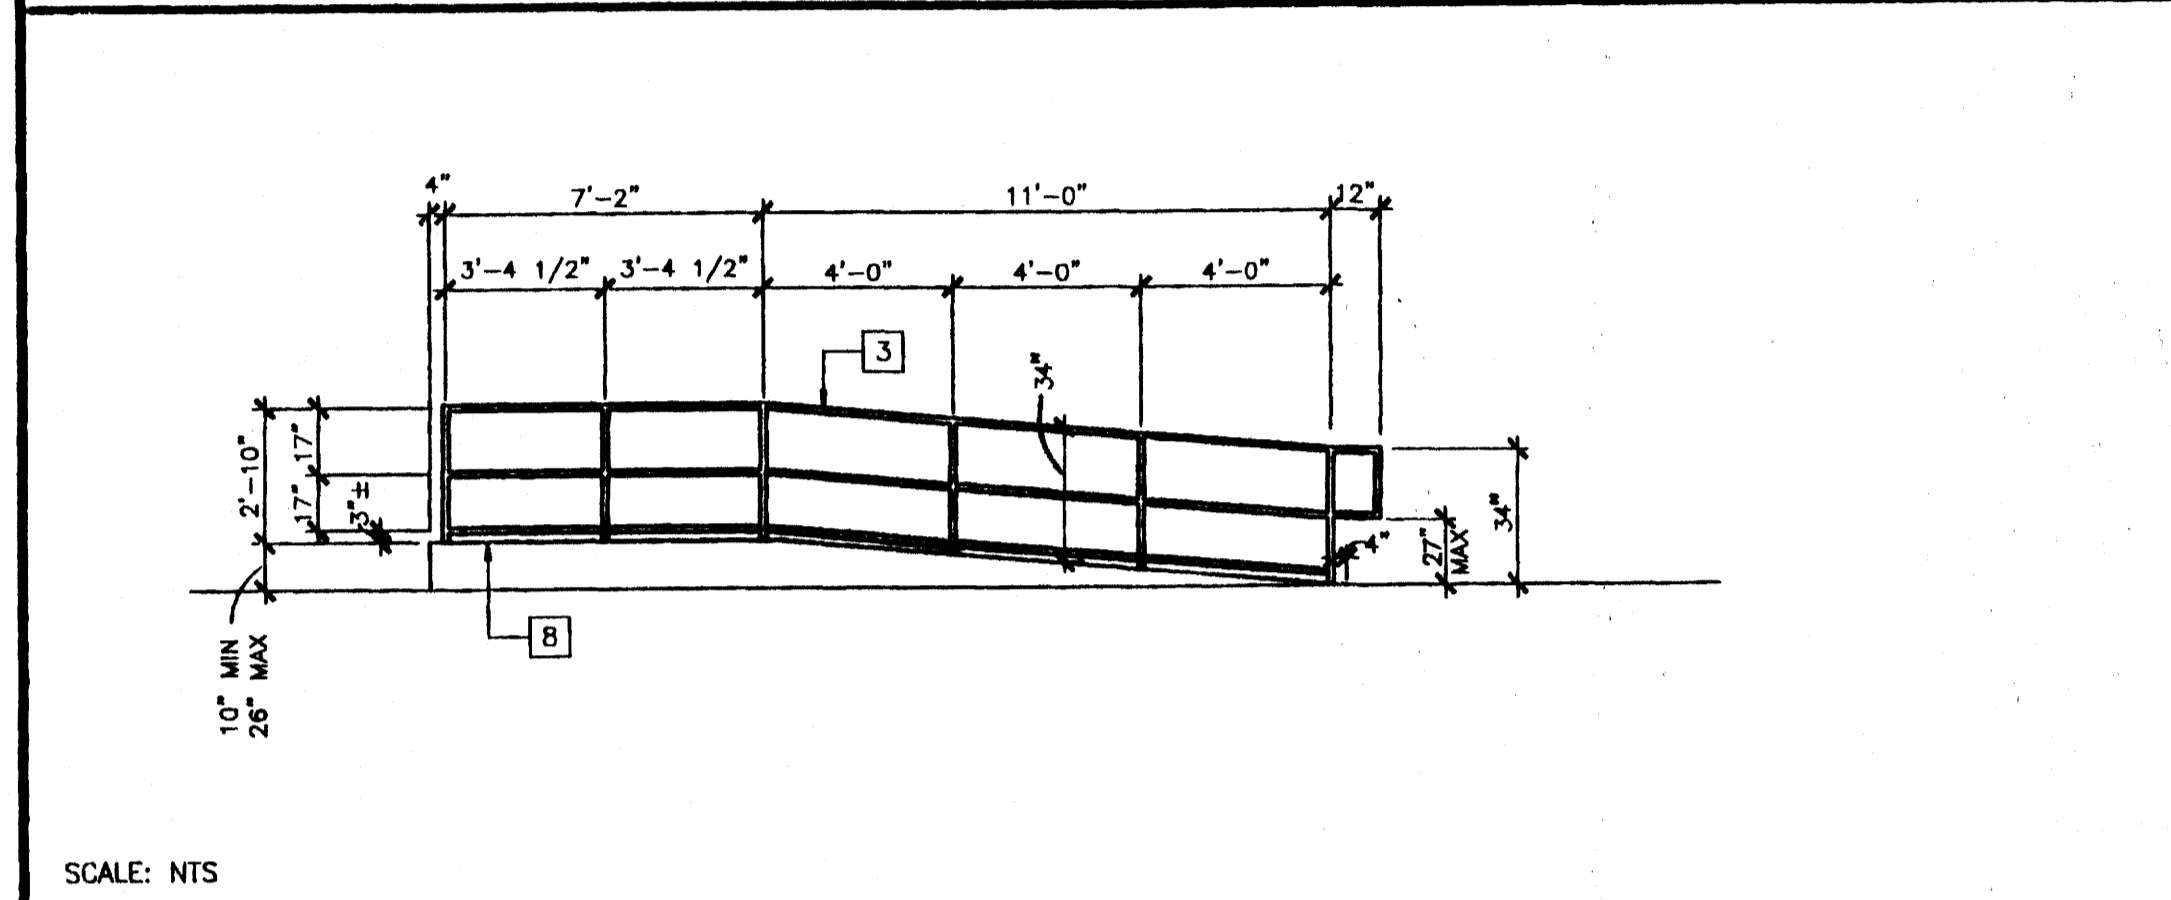


RAMP / LANDING ELEVATION

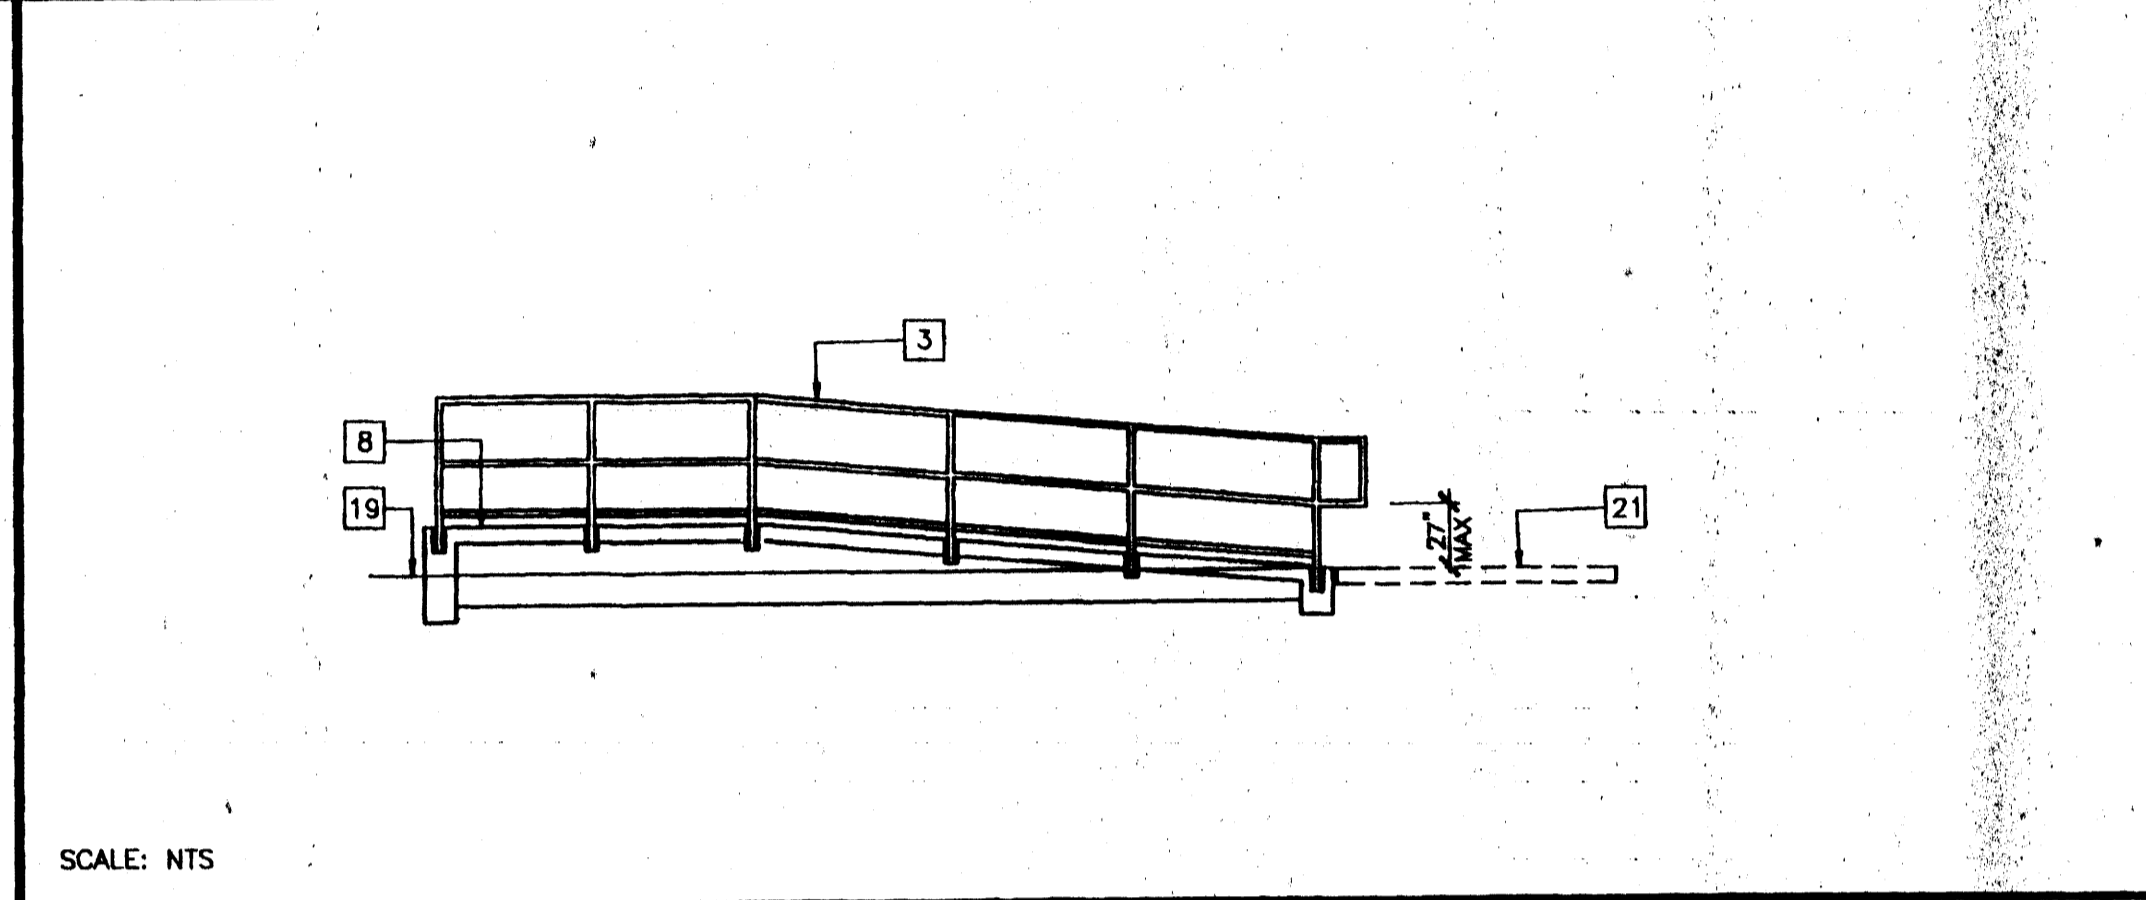


RAMP / LANDING SECTION

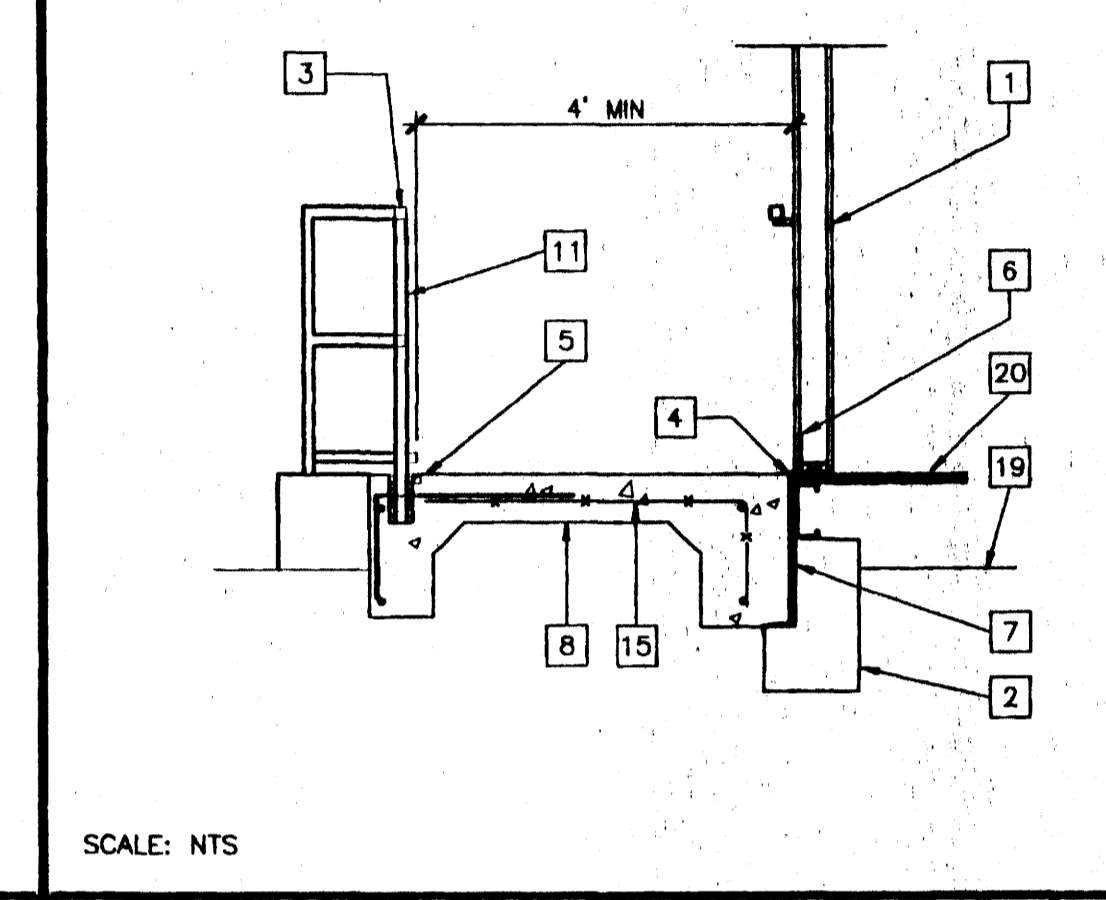


SECTION AT RAMP

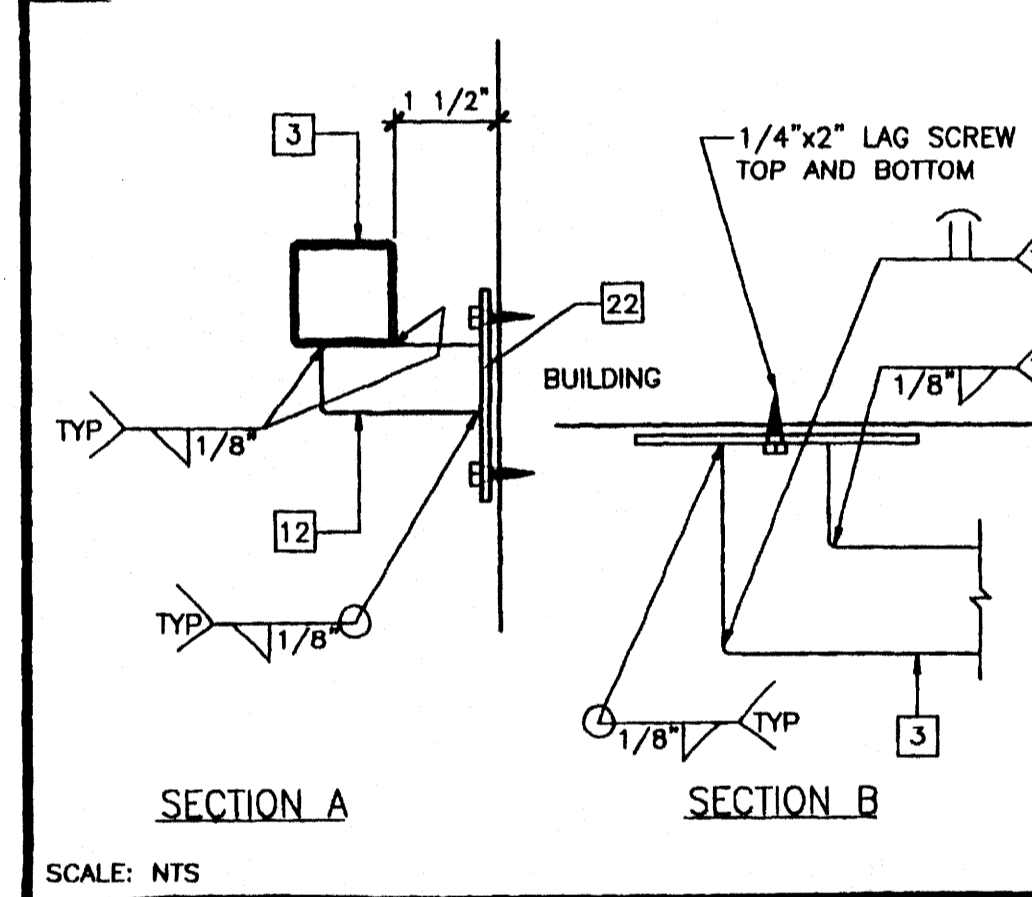

HANDRAIL CONNECTION

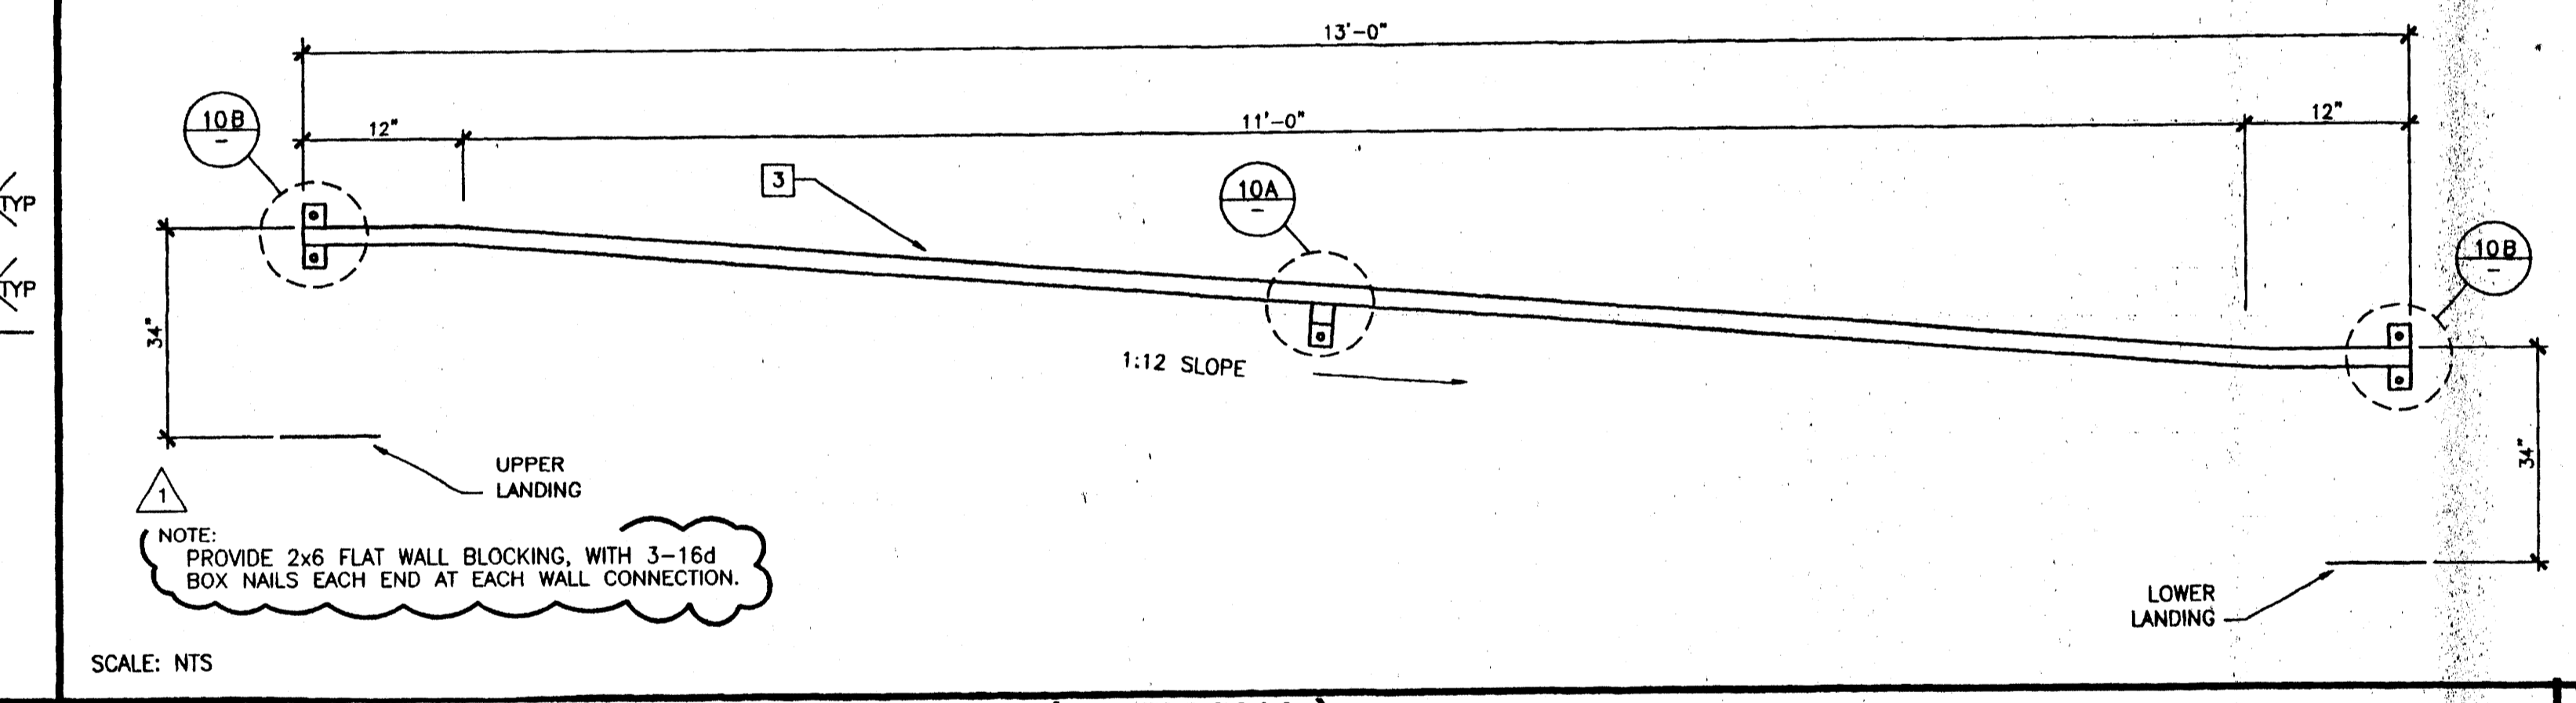


HANDRAIL ATTACHED TO BUILDING (OPTIONAL)

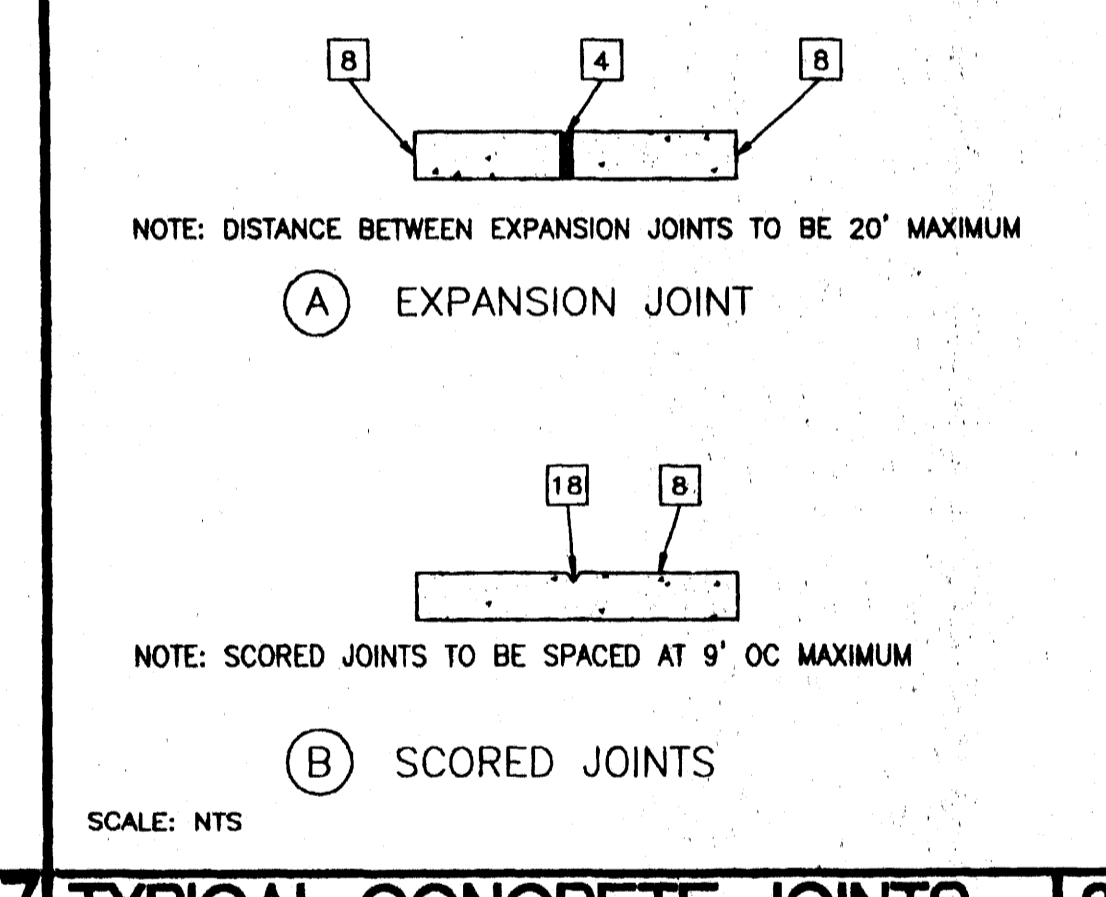

TYPICAL CONCRETE JOINTS

REVISIONS	Electrical Engineer's Seal	Mechanical Engineer's Seal	Structural Engineer's Seal	Architect's Seal
SP	MODTECH ENGINEERING CHANGE			

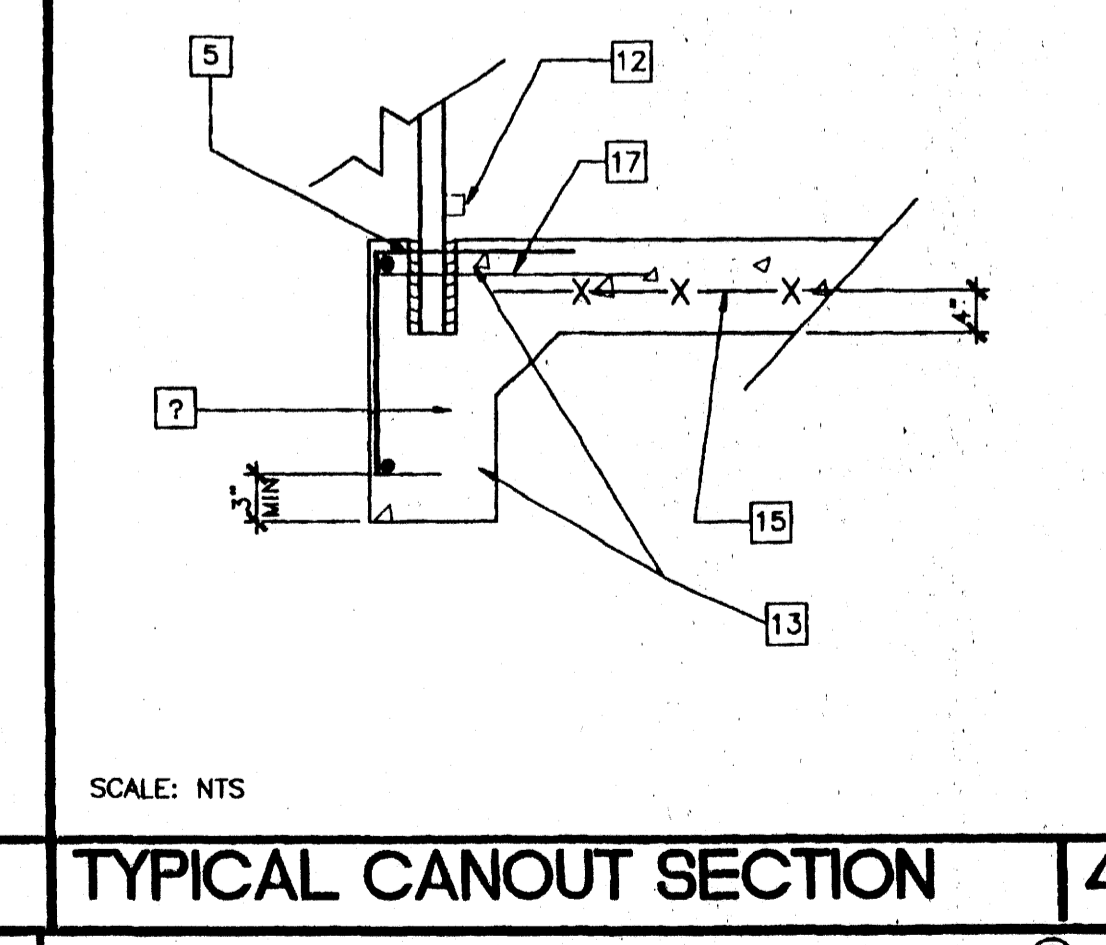

TYPICAL CANOUT SECTION

- ### KEY NOTES
- CLASSROOM BUILDING
 - FOOTING. SEE BUILDING FOUNDATION PLAN
 - TS 1 1/2"x1 1/2"x14 GA HANDRAIL - CONTINUOUS AND UNINTERRUPTED
 - SEALANT OVER 1/2" COMPRESSIVE FILLER
 - 3" DIAx6" DEEP SCHEDULE 40 PVC CANOUT. REMOVE PVC. CLEAN OUT HOLE. PLACE RAIL LEG AND FILL WITH NON-SHRINKING GROUT.
 - FLASHING BY MODTECH
 - 26 GA GALVANIZED FLASHING BY RAMP BUILDER
 - 6" CONCRETE SLAB OVER COMPACTED FILL WITH 6x6 10x10 WWM AT MID DEPTH OF SLAB.
 - SMOOTH TRANSITION
 - SMOOTH TRANSITION. LANDING TO PATH OF TRAVEL SURFACE
 - 1 1/2"x1 1/2"x0.188 (3/16") TUBE STEEL POSTS. ASTM A500 GRADE A FY = 39 KSI
 - 1"x1"x16GA TUBE STEEL WHEEL GAURD
 - (1) - #4 CONT
 - #4 @ 12" O.C.
 - 6x6-10x10 WWM
 - BEND MESH DOWN
 - #3x24"x24" HAIRPIN AT EACH TUBE VERTICAL
 - SCORED CONCRETE JOINT
 - FINISH GRADE LEVEL
 - FINISH FLOOR LEVEL
 - 5'x6' LANDING BY DISTRICT. 2% SLOPE MAX AWAY FROM BUILDING
 - 2"x4"x1/8" PLATE


- ### NOTES
- DUE TO VARYING SITE CONDITIONS THE MAXIMUM HEIGHT OF THE FINISH FLOOR FROM GRADE IS 26". THEREFORE, IT IS POSSIBLE THAT THE ACCESS RAMP COULD BE 26" AT A SLOPE OF 1:12. ARCHITECT MUST TAKE INTO ACCOUNT THAT THE RAMP SUPPLIED BY MODTECH INC. IS 12" AT A SLOPE OF 1:12. THEREFORE THE ARCHITECT MUST DESIGN AND DETAIL FOR LENGTHS BEYOND THE 12" STANDARD AND MUST NOTIFY CLIENT AND MODTECH THAT A NON-STANDARD RAMP WILL BE REQUIRED.
 - RAMPS: RAMPS SHALL NOT SLOPE MORE THAN 1" IN 12"
 - HANDRAILS: HANDRAILS AT BOTH SIDES OF RAMP AT 34" HEIGHT.
 - LANDING AND RAMP TO HAVE NON SLIP SURFACE.

REVISIONS	Electrical Engineer's Seal	Mechanical Engineer's Seal	Structural Engineer's Seal	Architect's Seal
SP	MODTECH ENGINEERING CHANGE			

PROJECT NUMBER: 4373
 COLTON U.S.D.
 © MODTECH, INC. 2002


DRAWN BY: KK 4012-124
 DATE: 11/19/02
 CHECKED BY: STK P-67
 DATE: 12/5/02
 MODTECH Index No.
R4.01

FILE PATH: 240-R1.0.DWG PROJECT NO. 4373 PC-04-101268

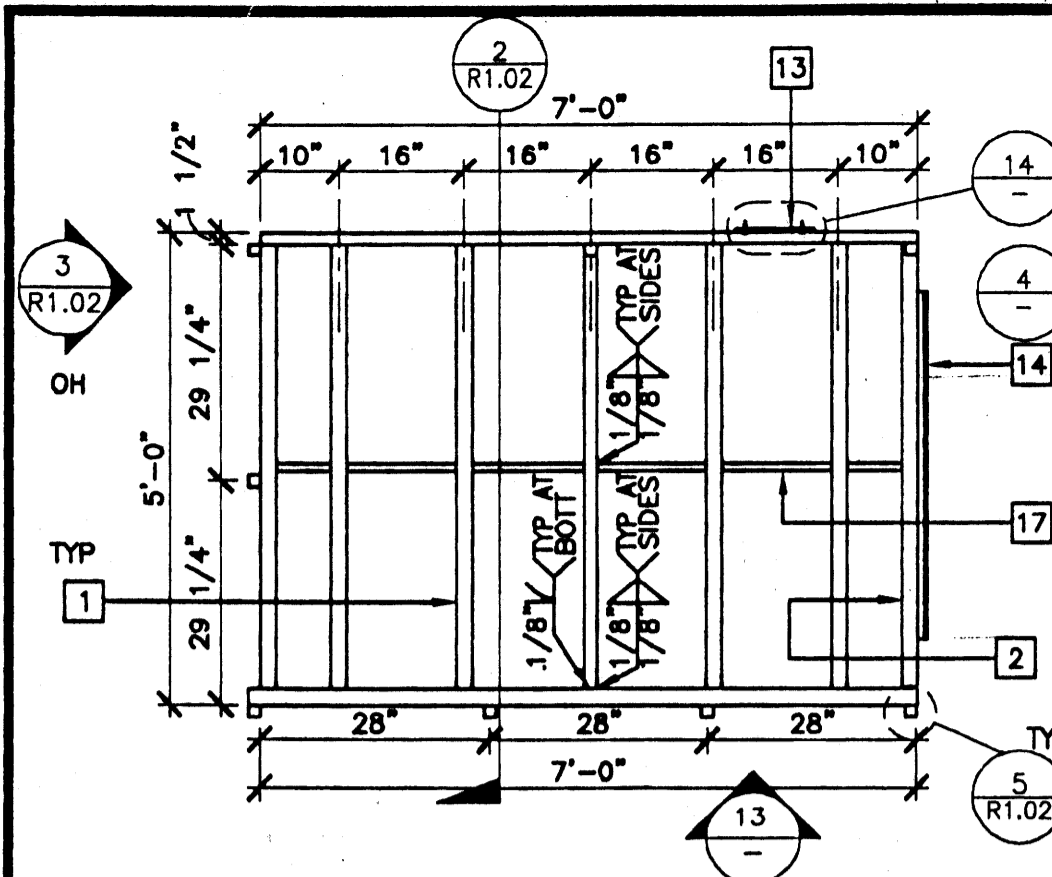


LANDING FRAME

12

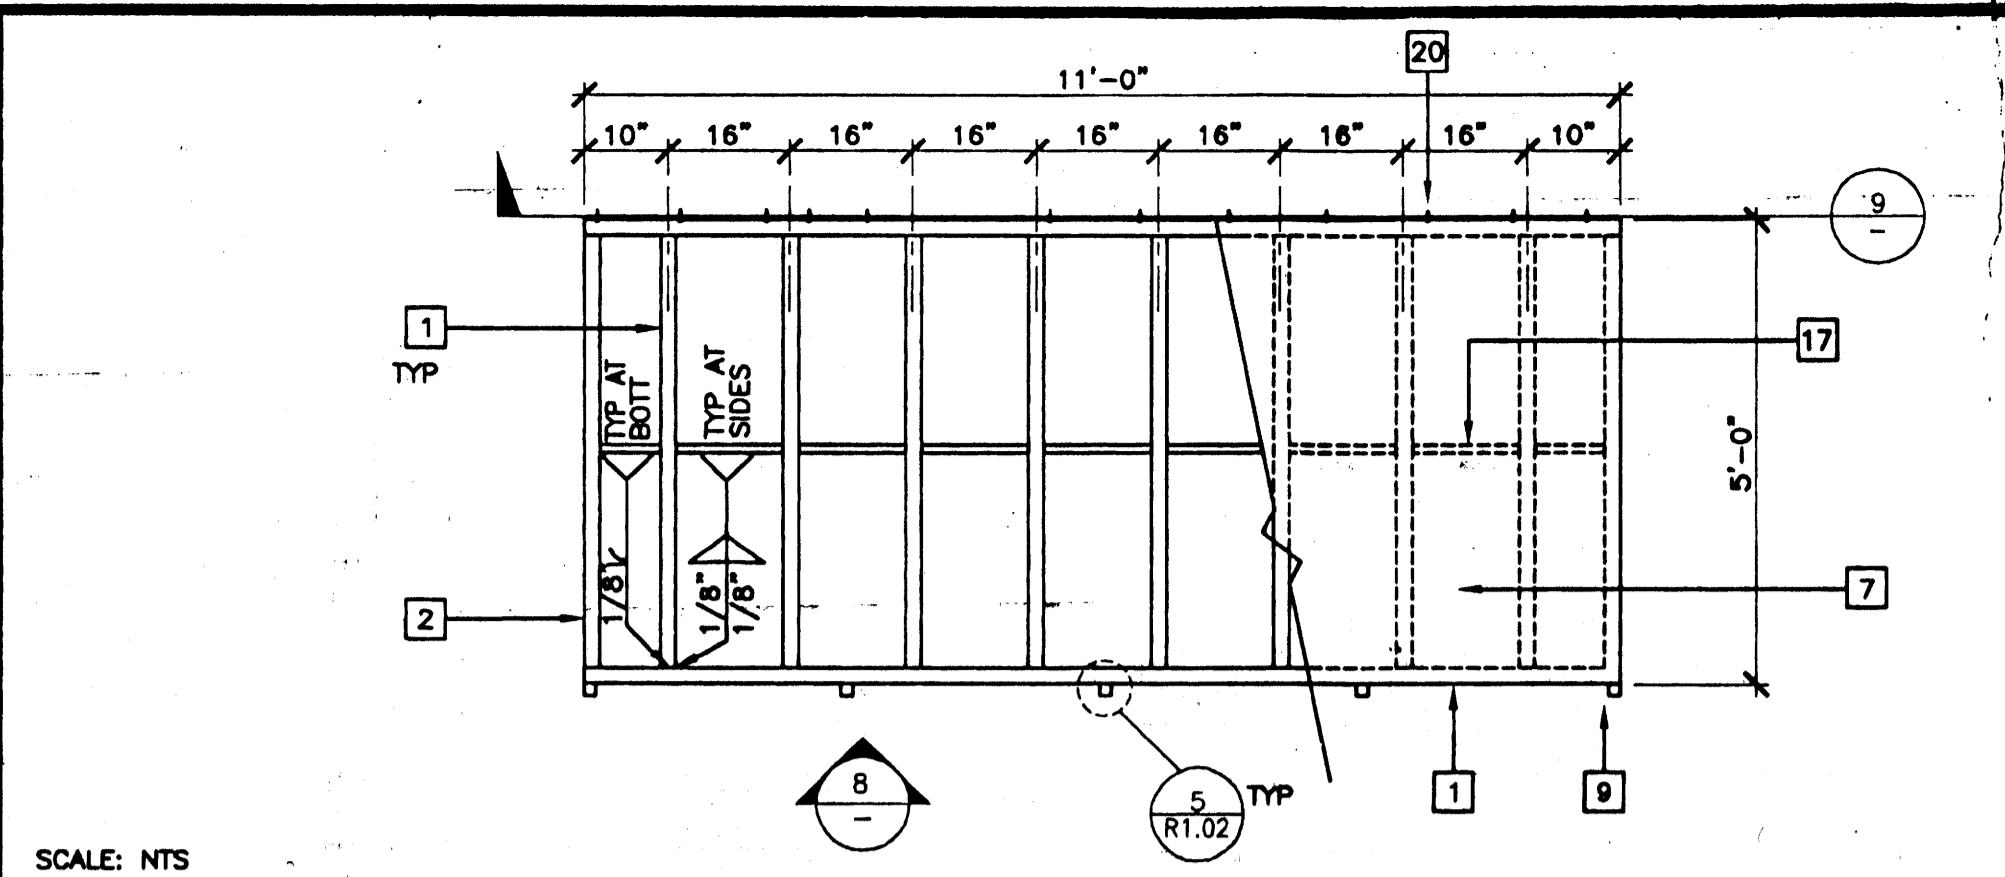


RAMP FRAME

7

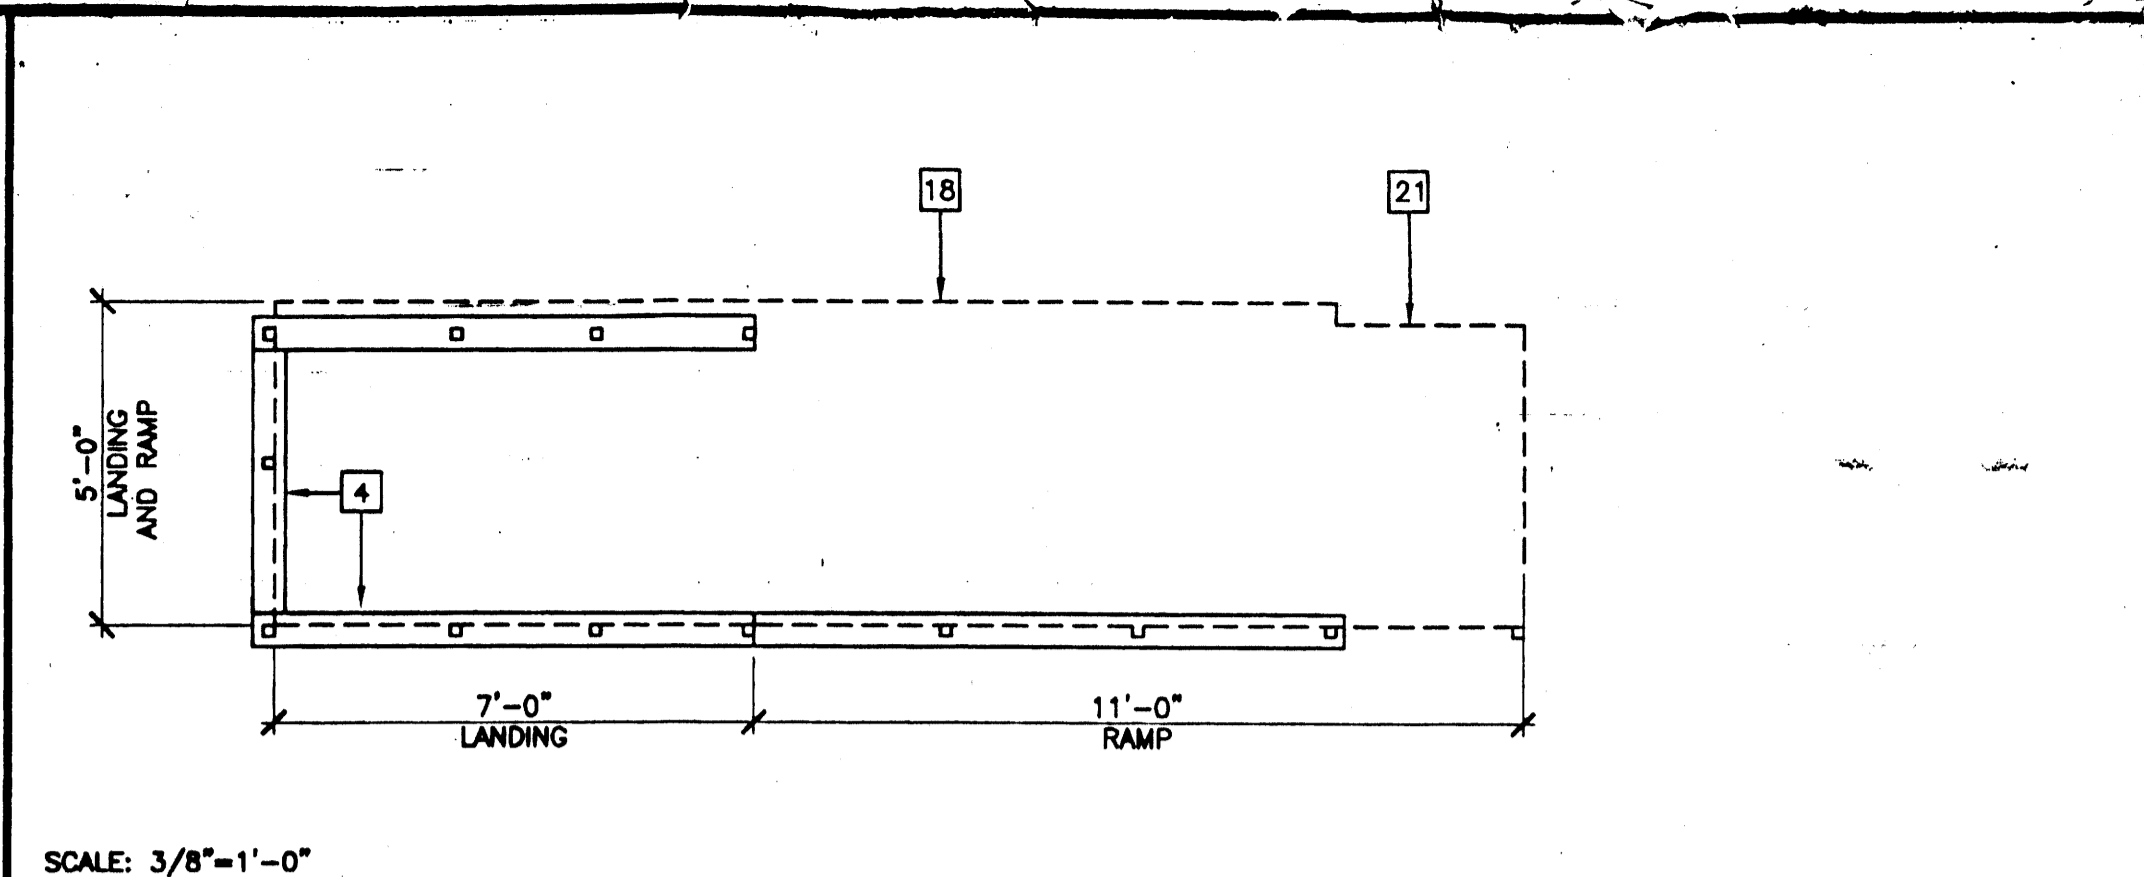


SILL PLAN FOR RAMP AND LANDING

1

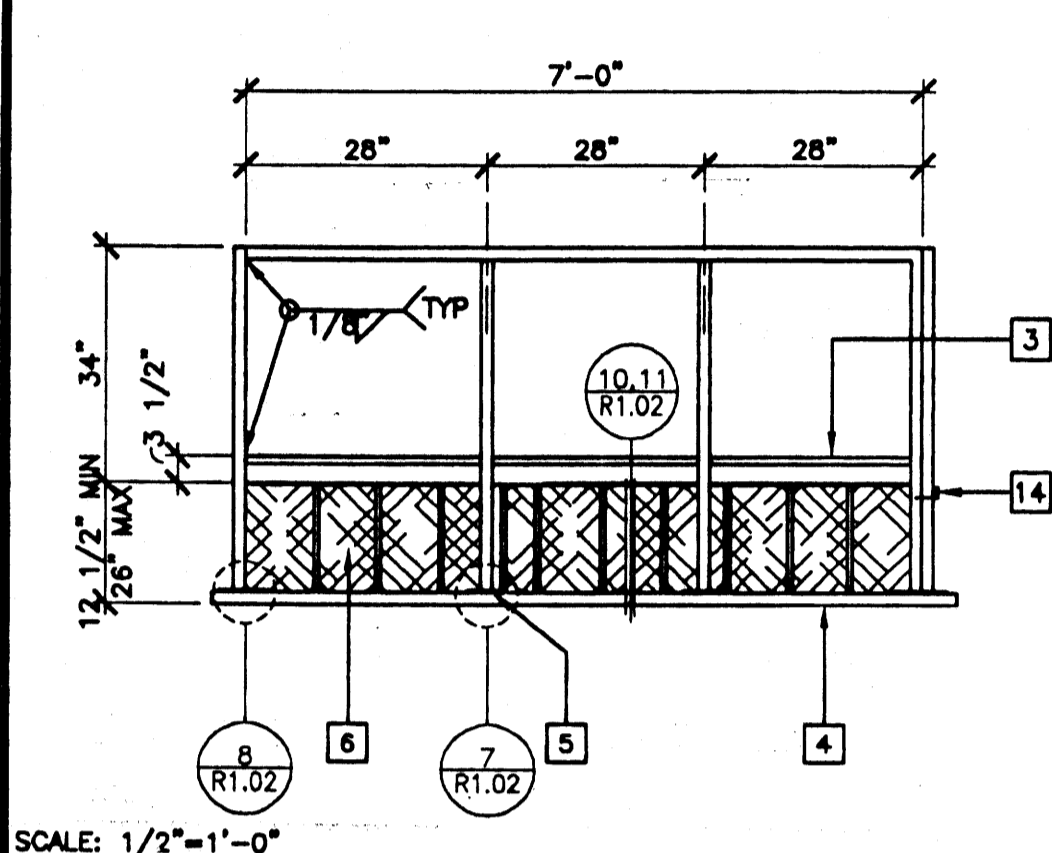


LANDING ELEVATION

13

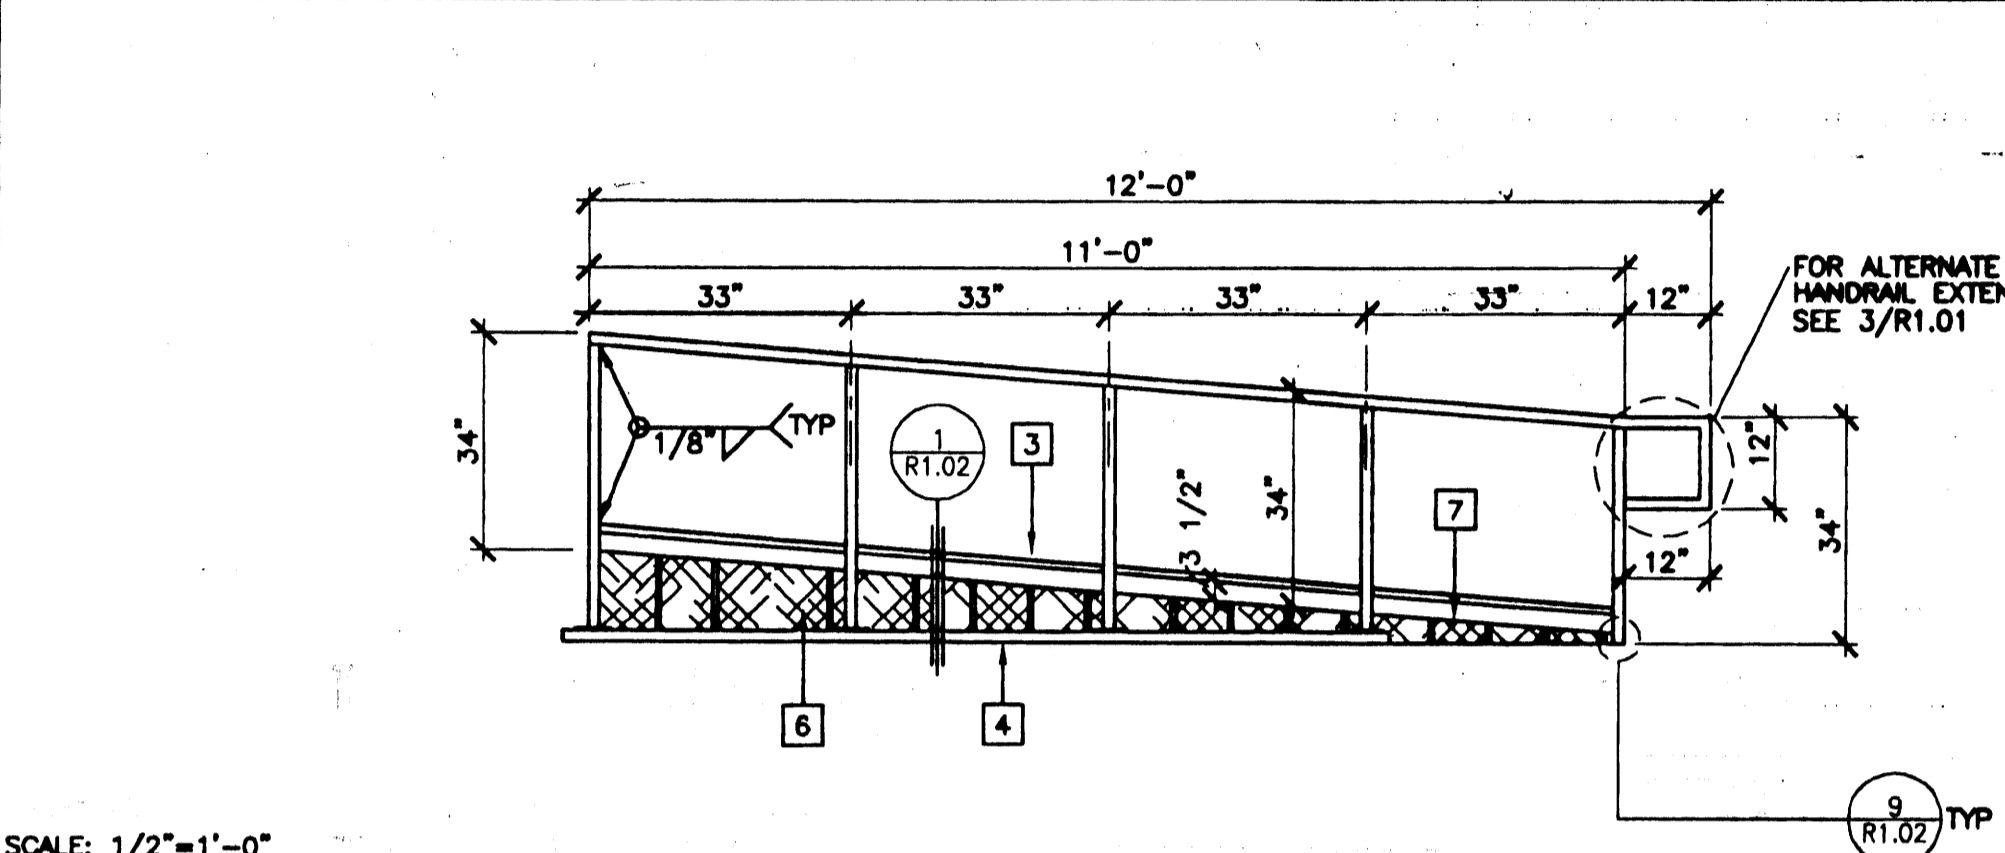


RAMP ELEVATION

8

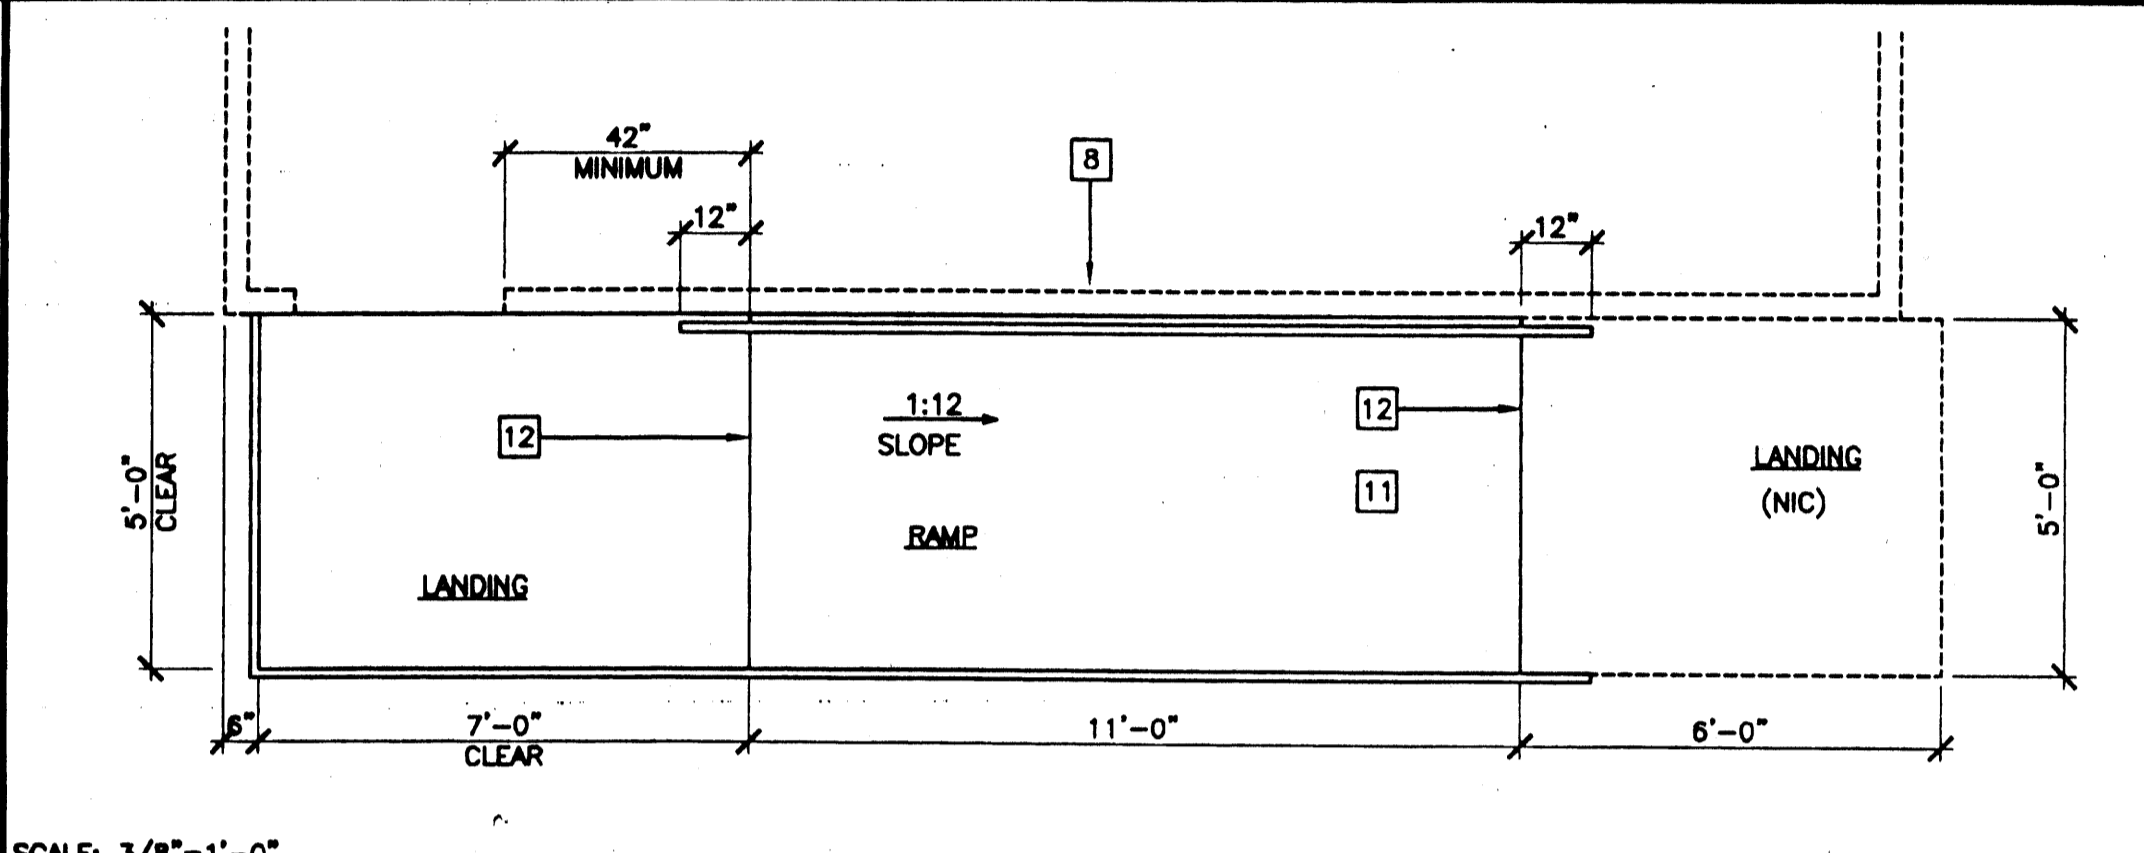


RAMP AND LANDING AT BUILDING

2

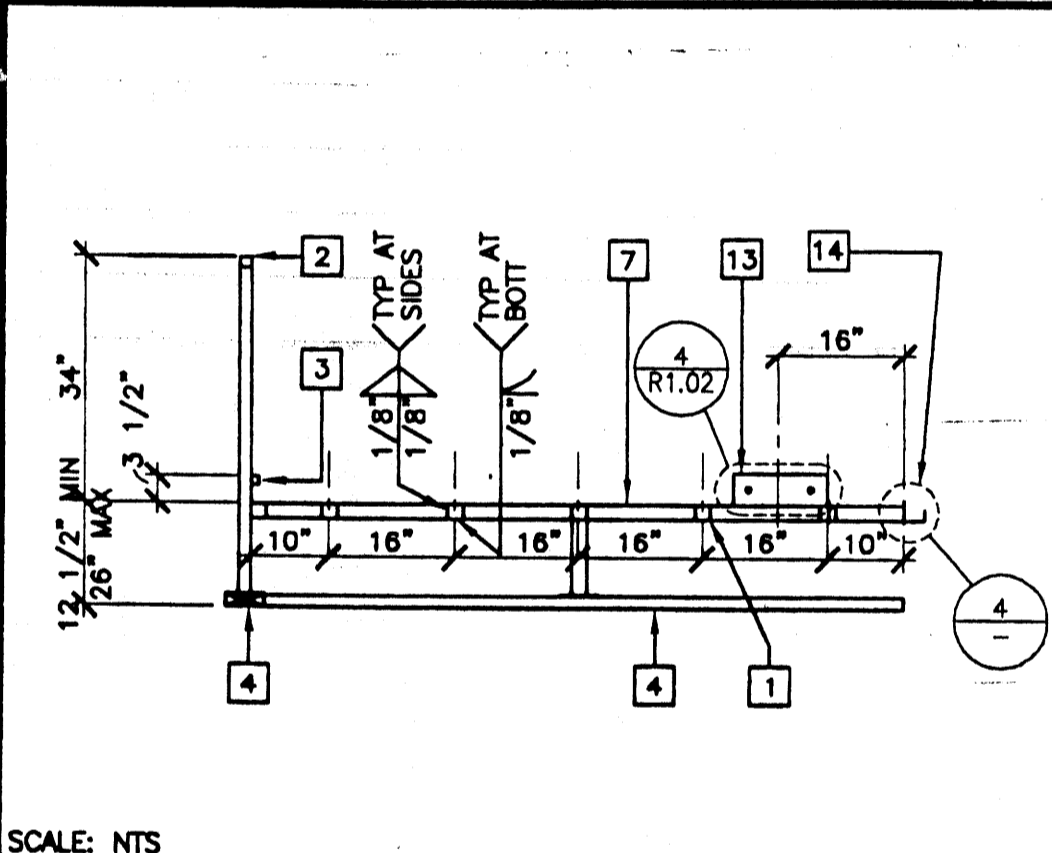


SECTION AT LANDING

14

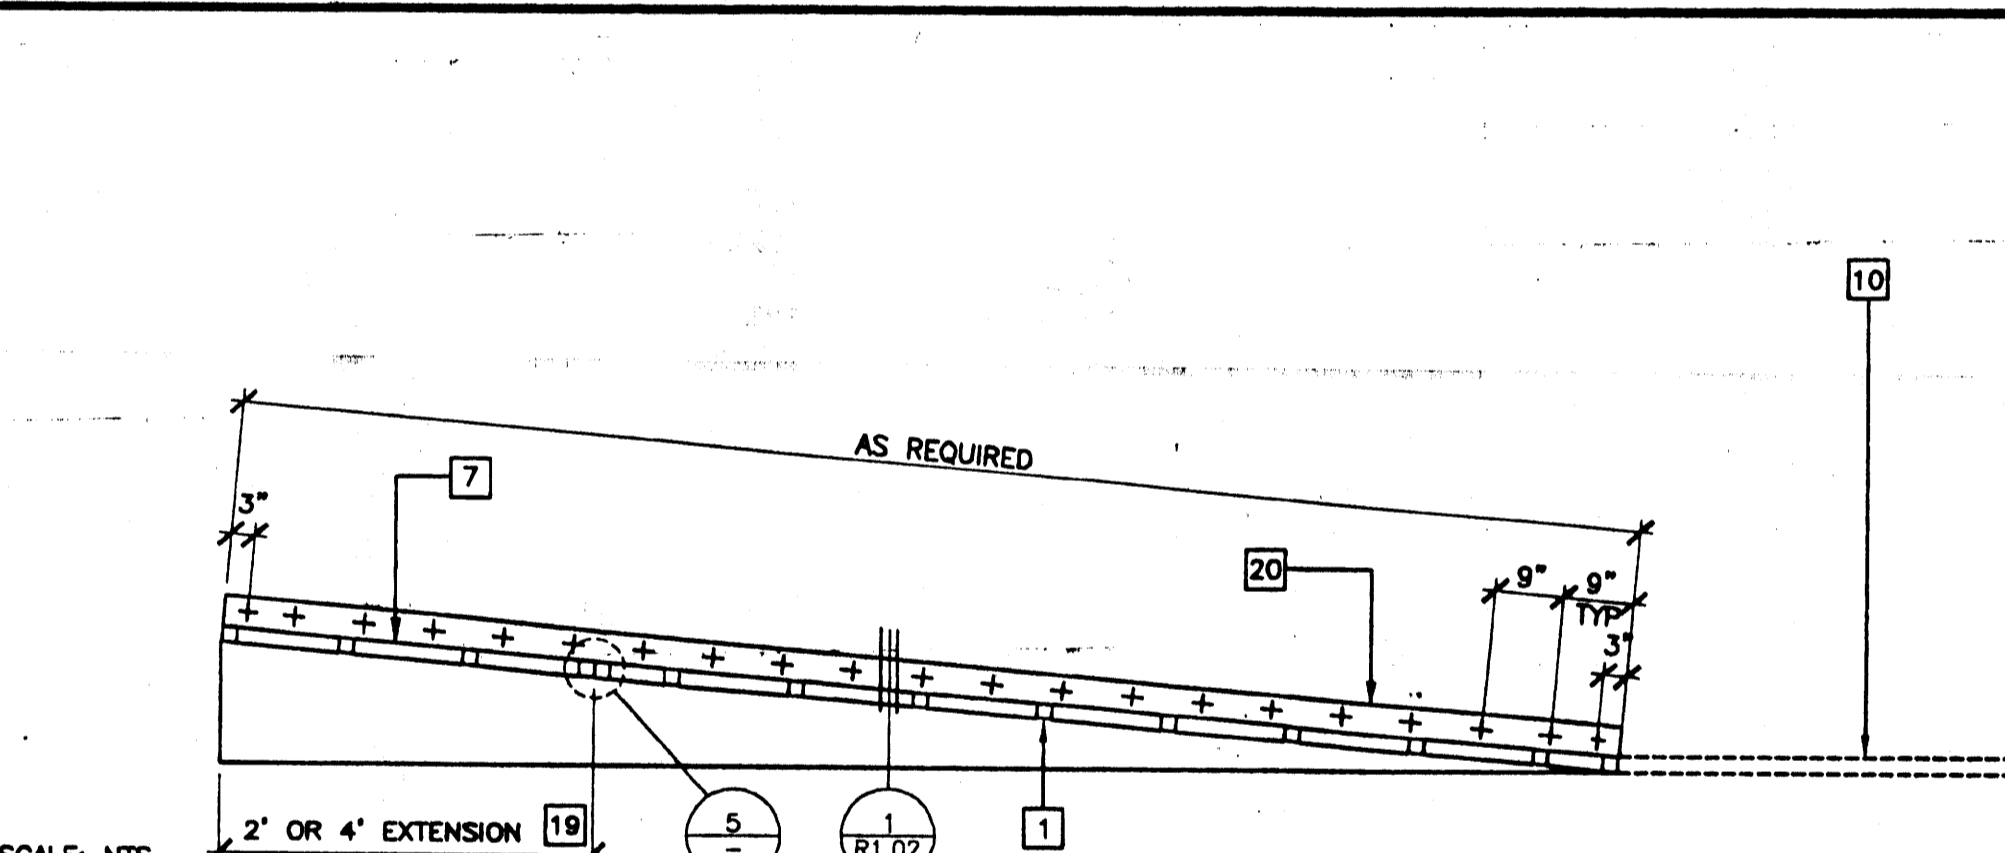


LONGITUDINAL SECTION AT RAMP

9

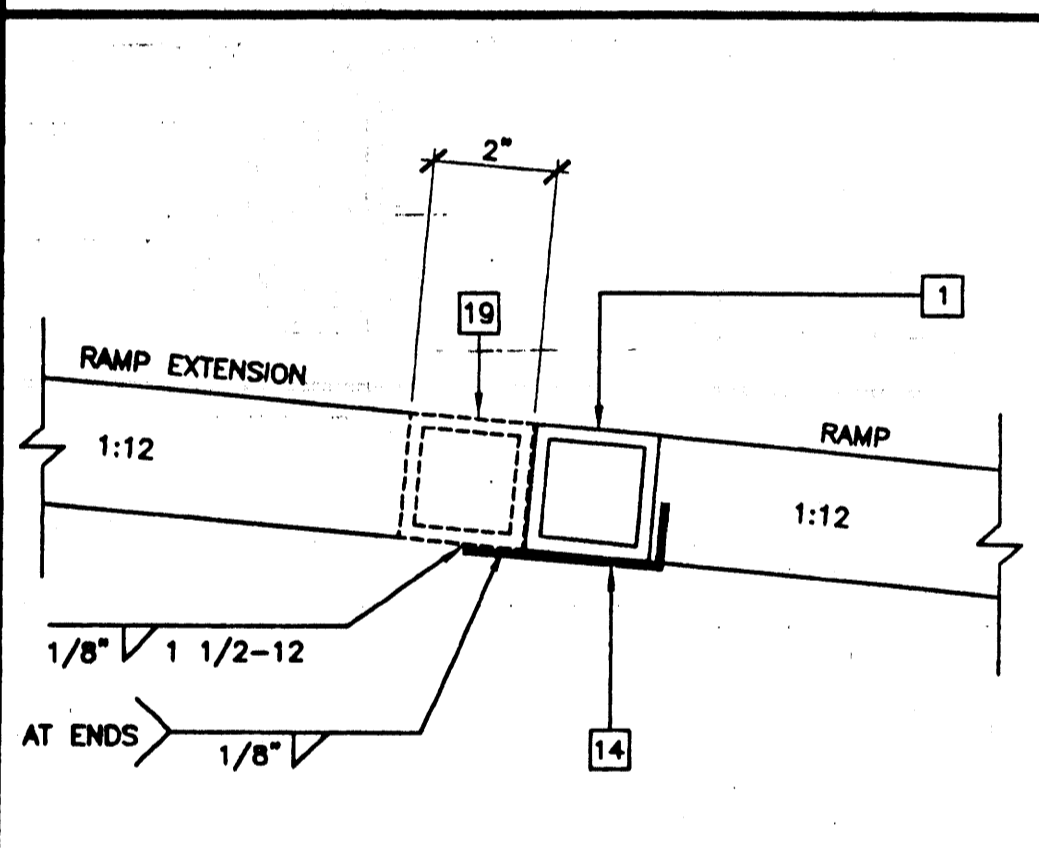


RAMP EXTENSION TO RAMP

5

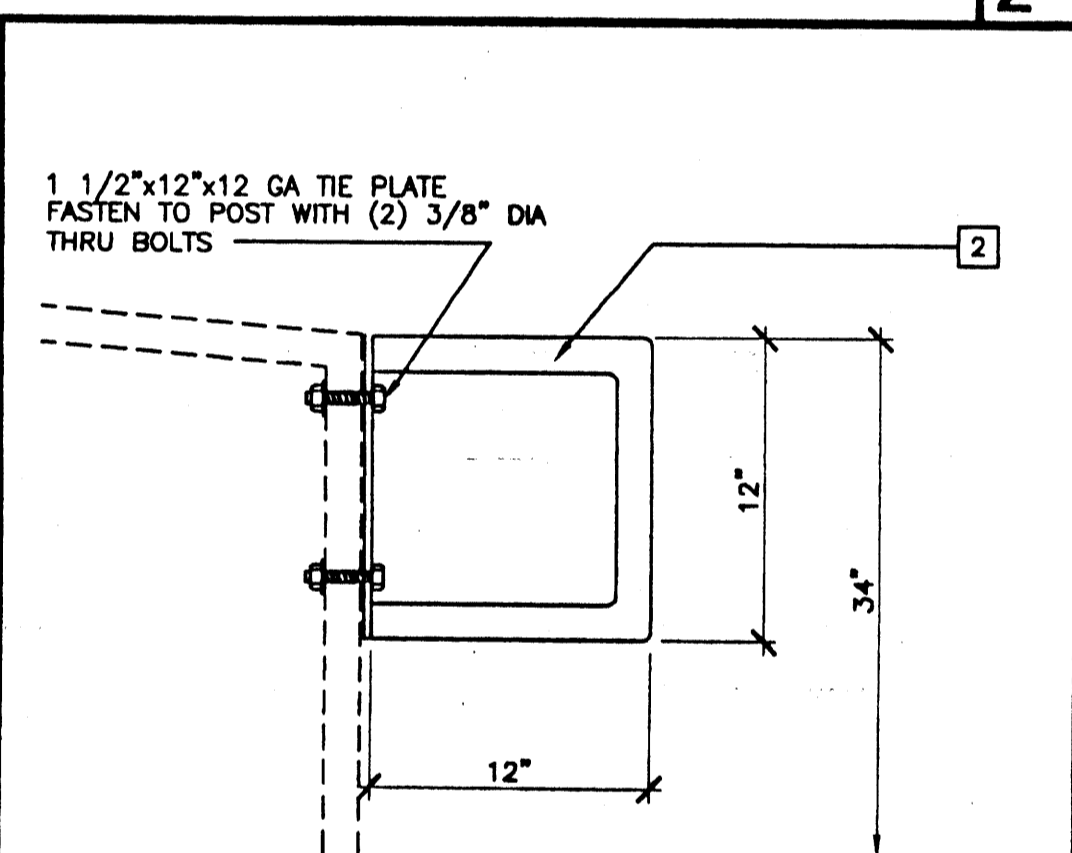


ALTERNATE GUARD RAIL EXTENSION

3

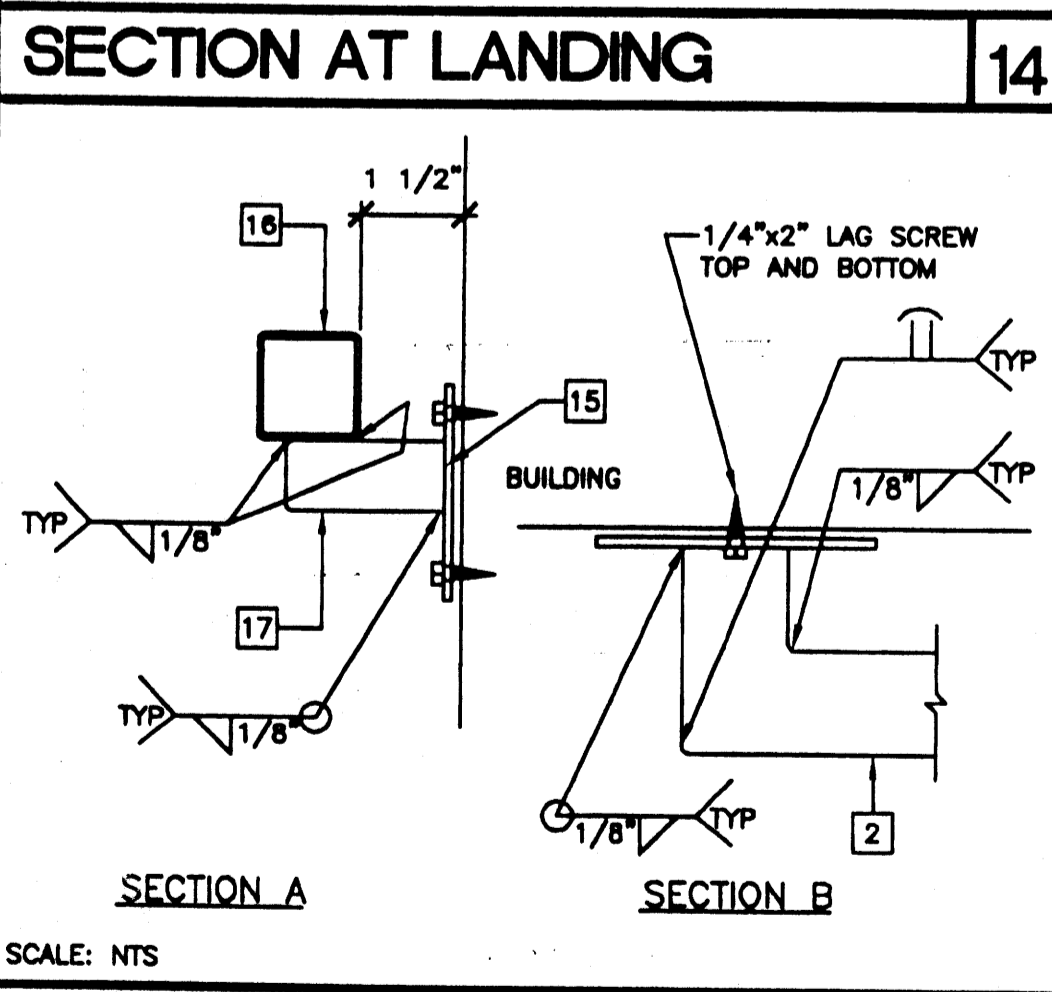


HANDRAIL CONNECTION

15

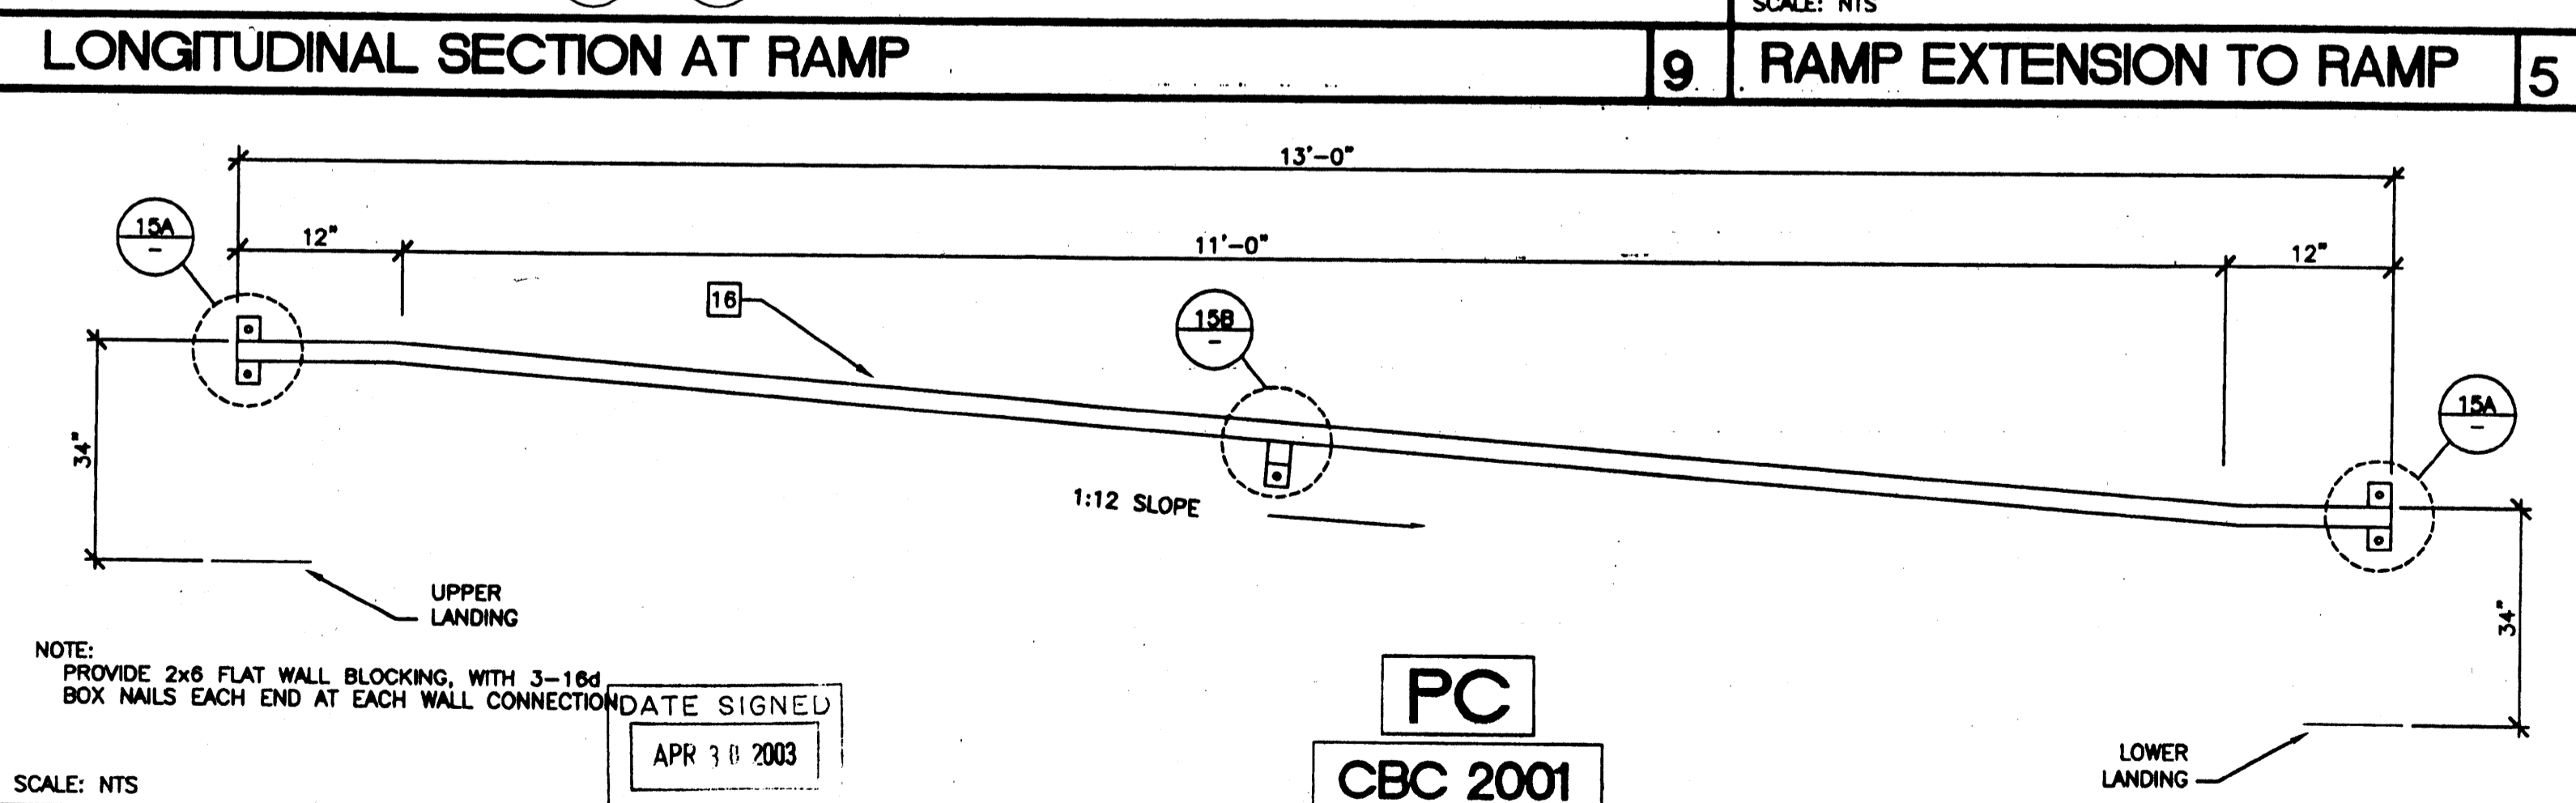

HANDRAIL ATTACHED TO BUILDING (OPTIONAL)

6

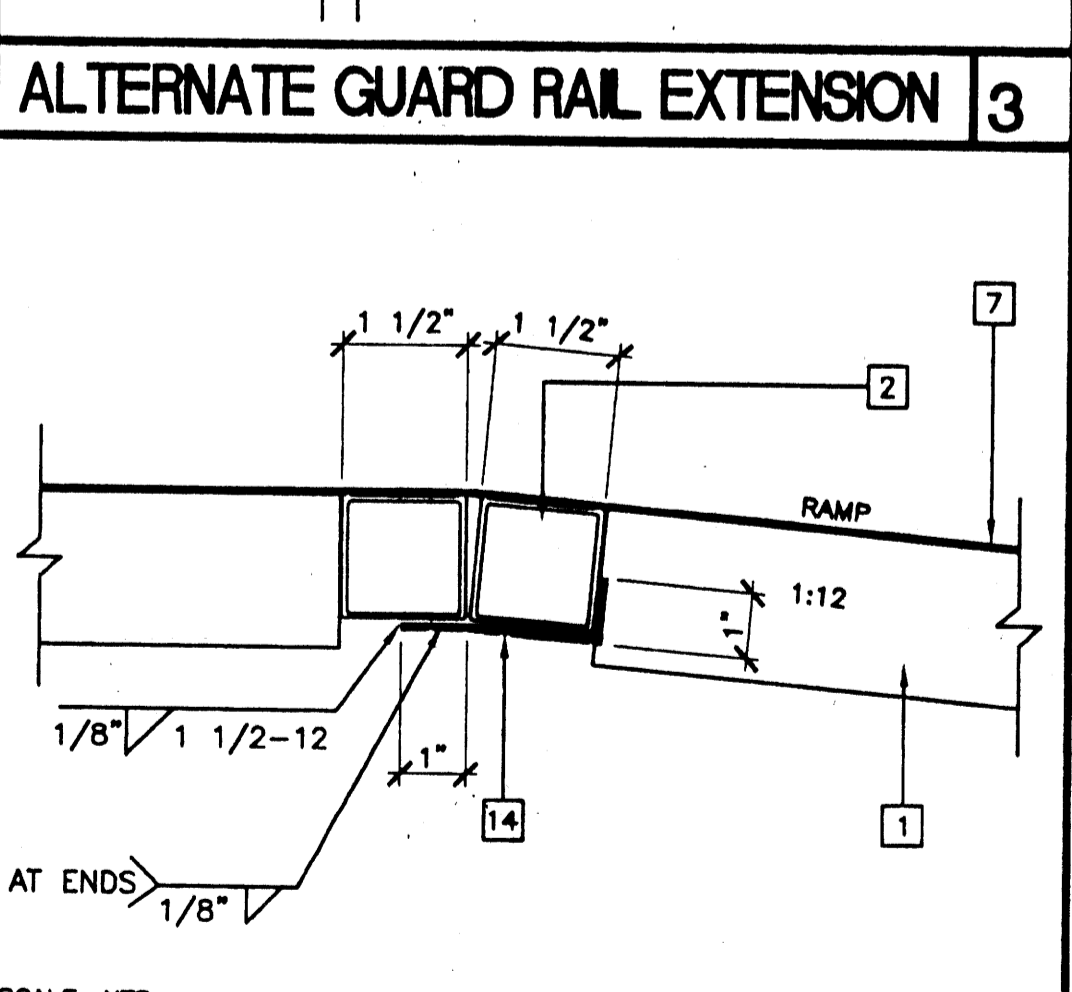

RAMP AT LANDING

4

KEY NOTES

- 1 TS 2"x2"x1/2 GA
- 2 TS 1 1/2"x1 1/2"x1/4 GA (Fy = 39ksi) ROUNDED OR BEVELED AT CORNERS
- 3 TS 1"x1"x1/8 GA WHEELCHAIR GUIDE
- 4 2"x6" PRESSURE TREATED SILL PLATE
- 5 2"x4"x1/2 GA BASE PLATE WITH (2) 1/4"x1" LAGS
- 6 SKIRTING: PLYWOOD TO MATCH BUILDING SIDING. BLOCK ALL EDGES. ATTACH WITH Bd AT 6" OC EDGES AND 12" OC FIELD. AT EDGE CONNECTION TO TUBE STEEL USE #14x2" TEK SCREWS AT 6" OC
- 7 12 GA METAL DECK: NON-SLIP SURFACE. DESIGN COEFFICIENT OF FRICTION GREATER THAN 0.6. MAINTAINABLE FOR 1 YEAR
- 8 EXISTING BUILDING
- 9 6"x10"x12 GA BASE PLATE AT RAMP TOE
- 10 LOWER LANDING BY DISTRICT
- 11 RAMP BY MODTECH
- 12 FLUSH TRANSITION
- 13 6"x12"x10 GA PLATE WITH (2) 1/4"x3" LAGS TO STRUCTURAL FRAME OF BUILDING
- 14 3"x1"x3"-0"x10 GA BENT PLATE
- 15 2"x4"x 1/8" PLATE
- 16 TS 1 1/2"x1 1/2"x1/4 GA HANDRAIL - CONTINUOUS AND UNINTERRUPTED. ROUNDED OR BEVELED AT CORNERS
- 17 TS 1"x1"x1/8 GA RAIL SUPPORT
- 18 LINE OF RAMP/LANDING ABOVE
- 19 RAMP EXTENSION FRAME
- 20 6"x10 GA CONTINUOUS PLATE WITH 1/4"x2" TEK SCREWS AT 9" OC INTO WOOD OR FOUNDATION BLOCKS OR #14x2" TEK SCREWS INTO STEEL AT 9" OC
- 21 NOTCH BOTTOM PLATE (MUD SILL) AS REQUIRED TO CLEAR RAMP TOE. MAX NOTCH 1 1/2"x4"-0" LONG.
- 22 NOTCH BOTTOM PLATE (MUD SILL) AS REQUIRED TO CLEAR RAMP TOE. MAX NOTCH 1 1/2"x4"-0" LONG.

NOTES

1. RAMP: RAMP SHALL NOT SLOPE MORE THAN 1" IN 12"
2. HANDRAILS: HANDRAILS AT BOTH SIDES OF RAMP AT 34" HEIGHT.
3. SURFACE: LANDING & RAMP TO HAVE NON-SLIP SURFACE ANCOR GRIP II AS MANUFACTURED BY AMERICAN CHEMICAL COMPANY (OR EQUAL)
4. GROUNDING: PROVIDE GROUNDING OF RAMP TO BUILDING FRAME WITH #8 COPPER TO BOTH GROUND LUGS.
5. ARCHITECT SITE/RAMP/LANDING PLANNING: DUE TO VARYING SITE CONDITIONS THE MAXIMUM HEIGHT OF FINISH FLOOR FROM GRADE IS 28". THEREFORE IT IS POSSIBLE THAT THE ACCESS RAMP ATTACHED TO THE BUILDING COULD BE 28'-0" AT A SLOPE OF 1:12. ARCHITECT MUST TAKE INTO ACCOUNT THAT THE RAMP SUPPLIED BY MODTECH INC. IS 11'-0" AT A SLOPE OF 1:12. THEREFORE THE ARCHITECT WILL HAVE TO DESIGN AND PROVIDE DETAILS OF RAMP EXTENSIONS AND BOTTOM LANDING DEPENDING ON PARTICULAR SITE CONDITIONS. IN NO WAY IS MODTECH INC RESPONSIBLE FOR ANY RAMP EXTENSION EXCEEDING THE ORIGINAL PLAN AS SHOWN ON THIS SHEET
6. ALL 1 1/4" AND 1 1/2" TUBE STEEL TO BE OF ASTM A500 GRADE A STEEL (Fy = 39 KSI)

PLS: NOT PER 15
 RES: A-SHIRT (CC-Money)
 SSS: J. COMAN.

REVISED

IDENTIFICATION STAMP
 DIV. OF THE STATE ARCHITECT
 OFFICE OF REGULATION SERVICES
 04 104812
 AC: PLS
 DATE: MAY 1 3 2003

REVISIONS

NO.	DESCRIPTION	DATE

Electrical Engineer's Seal

Mechanical Engineer's Seal

PC Professional of Record Seal

Architect's Seal

REGISTERED PROFESSIONAL ENGINEER
 No. 3602
 STATE OF CALIFORNIA
 LICENSE EXPIRES 6-30-2004

REGISTERED ARCHITECT
 No. 93025
 STATE OF CALIFORNIA
 EXPIRES 9-30-03

IDENTIFICATION STAMP
 DIV. OF THE STATE ARCHITECT
 OFFICE OF REGULATION SERVICES
 PC-04
 104801
 AC: PLS
 DATE: 5/1/03

MODTECH™
 2830 BARRETT AVENUE PH (909) 943-4014
 PERRIS, CALIF. 92571 FAX (909) 940-0427

PROJECT NUMBER:

MODTECH, INC. 2002
 CLASS LEASING INC STOCKPILE # 67
 100- 24 x 40 CLASSROOM BUILDINGS
 A# 04-104812 05-15-2003 5' RAMPS

DRAWN BY: STRA-67
 CHECKED BY:
 DATE:
 MODTECH Index No.


5 FOOT RAMP/LANDING

R5.01


PROJECT NO. PC-04-104801 FILE PATH: 2440-RS.01.DWG

KEY NOTES

- 1 [FLOOR BEAM, COPE TO MATE WITH HEADER - 1/S1.01
- 2 [FLOOR HEADER - 1/S1.01
- 3] FLOOR JOIST - 2/S1.01
- 4] BLOCKING AT MIDSPAN OF FLOOR HEADER - 5/S1.01
- 5 11/16" HOLE AT MIDDEPTH FOR HANDLING
- 6 11/16" MODLINE BOLT HOLE. 2/S3
- 7 5" SQUARE HAND HOLES AT EACH MODLINE BOLT LOCATION
- 8 EDGE NAILING AT FLOOR BEAM OR HEADER - #10x1 3/4" SELF TAPPING FLAT HEAD SCREWS AT 8"OC
- 9 EDGE NAILING OR FIELD NAILING - AEROSMITH AKN .144 DRIVE PINS AT 8"OC, FIELD NAILING TO BE 10" OC FOR PURLIN SPACING OF 32" OR LESS
- 10 5"x8"x1/4" STEEL ANCHOR PLATE, FOR OPTIONAL CONCRETE FOUNDATION ONLY.
- 11 SHIPPING HOLD DOWN - 3 1/2"x3 1/2"x1/4" TUBE STEEL CUT TO 1 3/4" HEIGHT
- 12 PLYWOOD FLOOR SHEATHING: APA PS 1-83, 1 1/8" THICK STURD-I-FLOOR WITH 48" OC SPAN RATING - LAYOUT PATTERN SHOWN IS TYPICAL. ~~AS AN ALTERNATE USE WE CAN HAVE 1 1/8" THICK OSB STURD-FLOOR PL-115~~

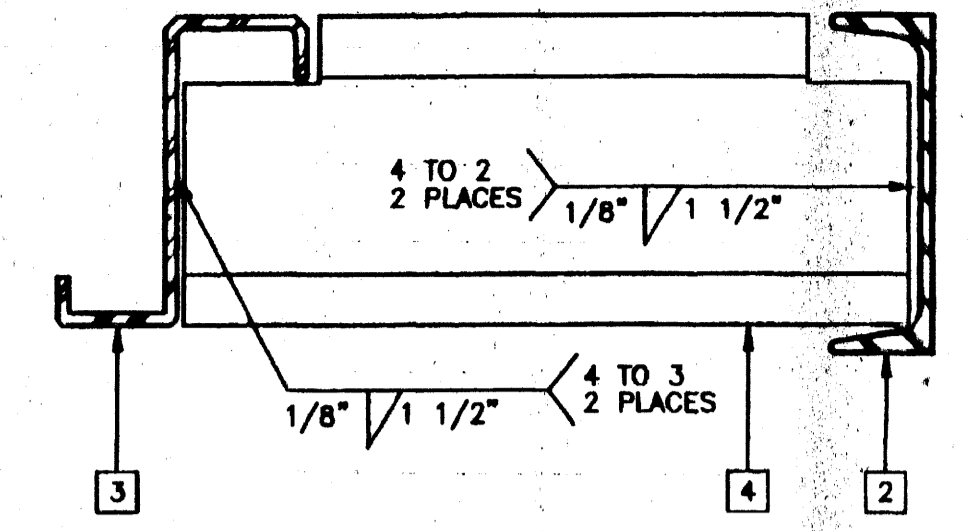


FLOOR HEADER BLOCKING 5

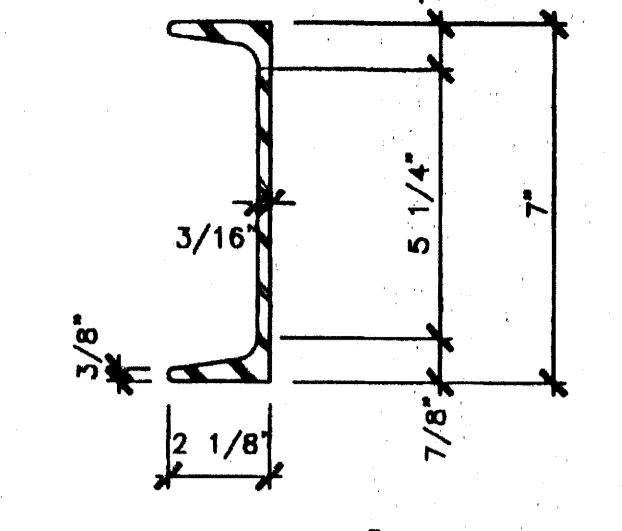


C7x9.8 - ASTM A-36

FLOOR BEAM/HEADER 1

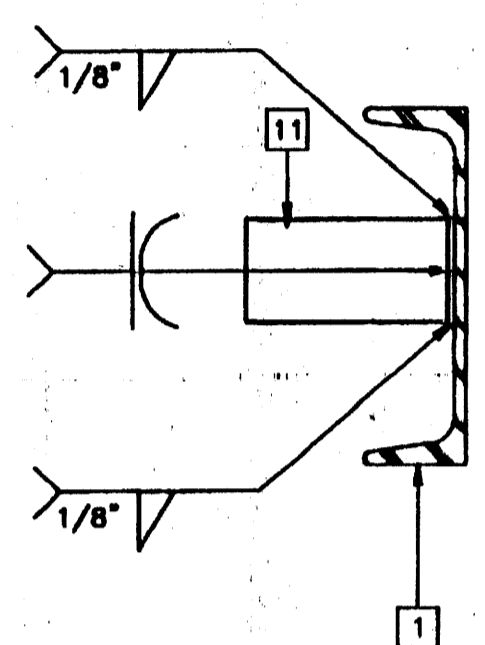


SHIPPING HOLD DOWN 6

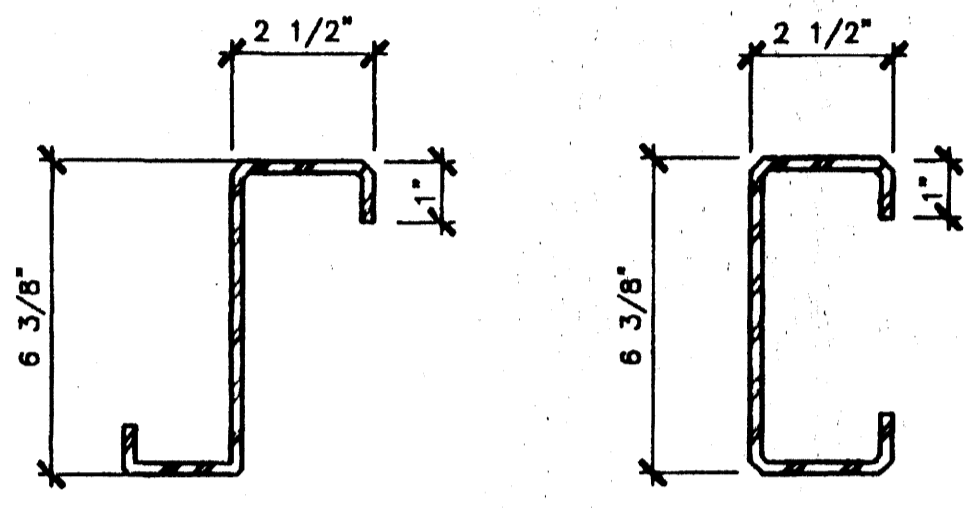


ASTM A-570, GRADE 33

FLOOR JOIST 2

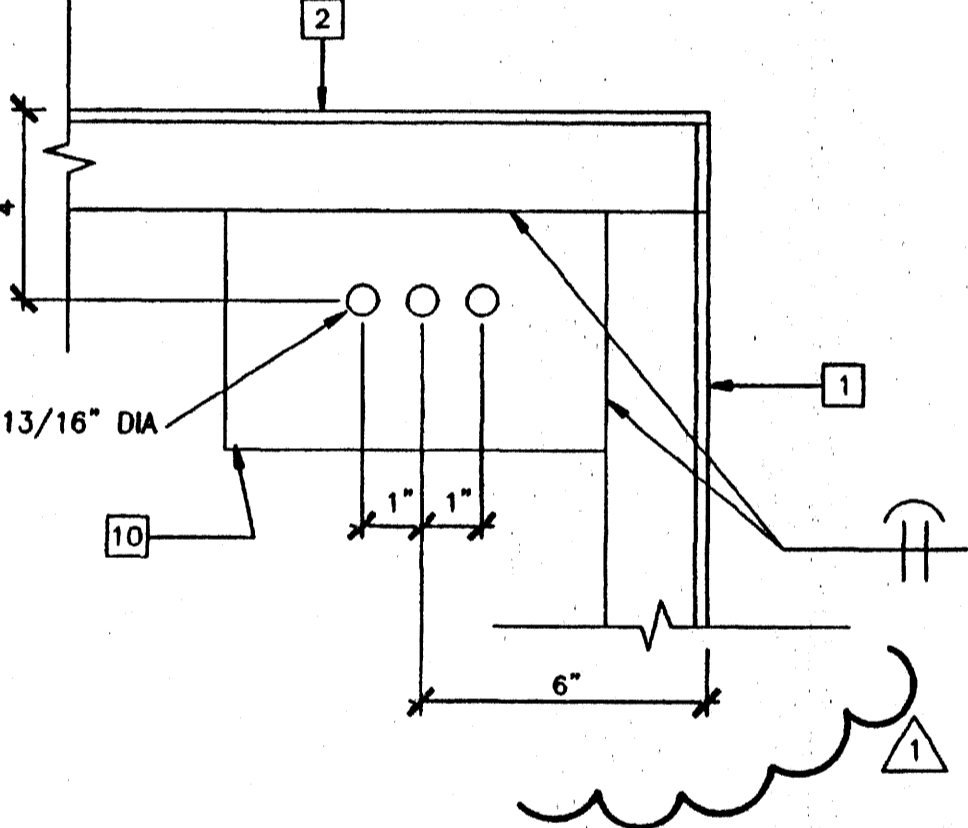


ANCHOR PLATE (CONCRETE FOUNDATION) 3

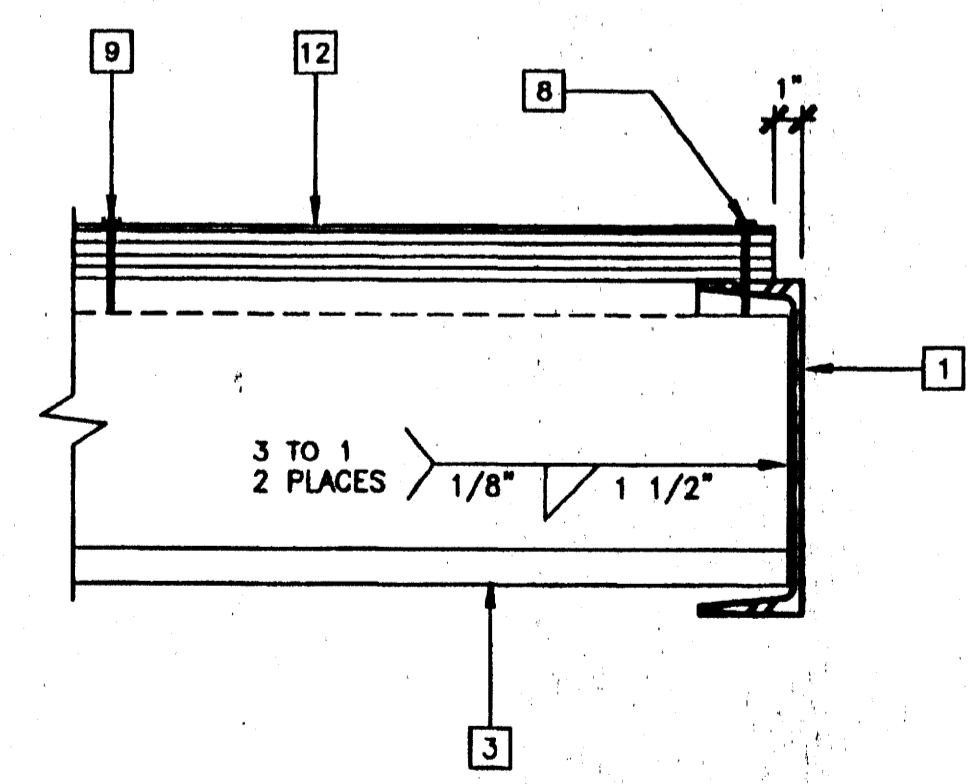

FLOOR JOIST TO FLOOR BEAM 4

FLOOR JOIST TABLE

LIVE LOAD PSF	JOIST SPACING STANDARD	OPTIONAL UP GRADE TO STIFFEN FLOOR		
		32"	24"	16"
50	48"	32"	24"	16"
50+20	32"	24"	16"	12"
100	24"	16"	12"	N/A
125	16"	12"	N/A	N/A

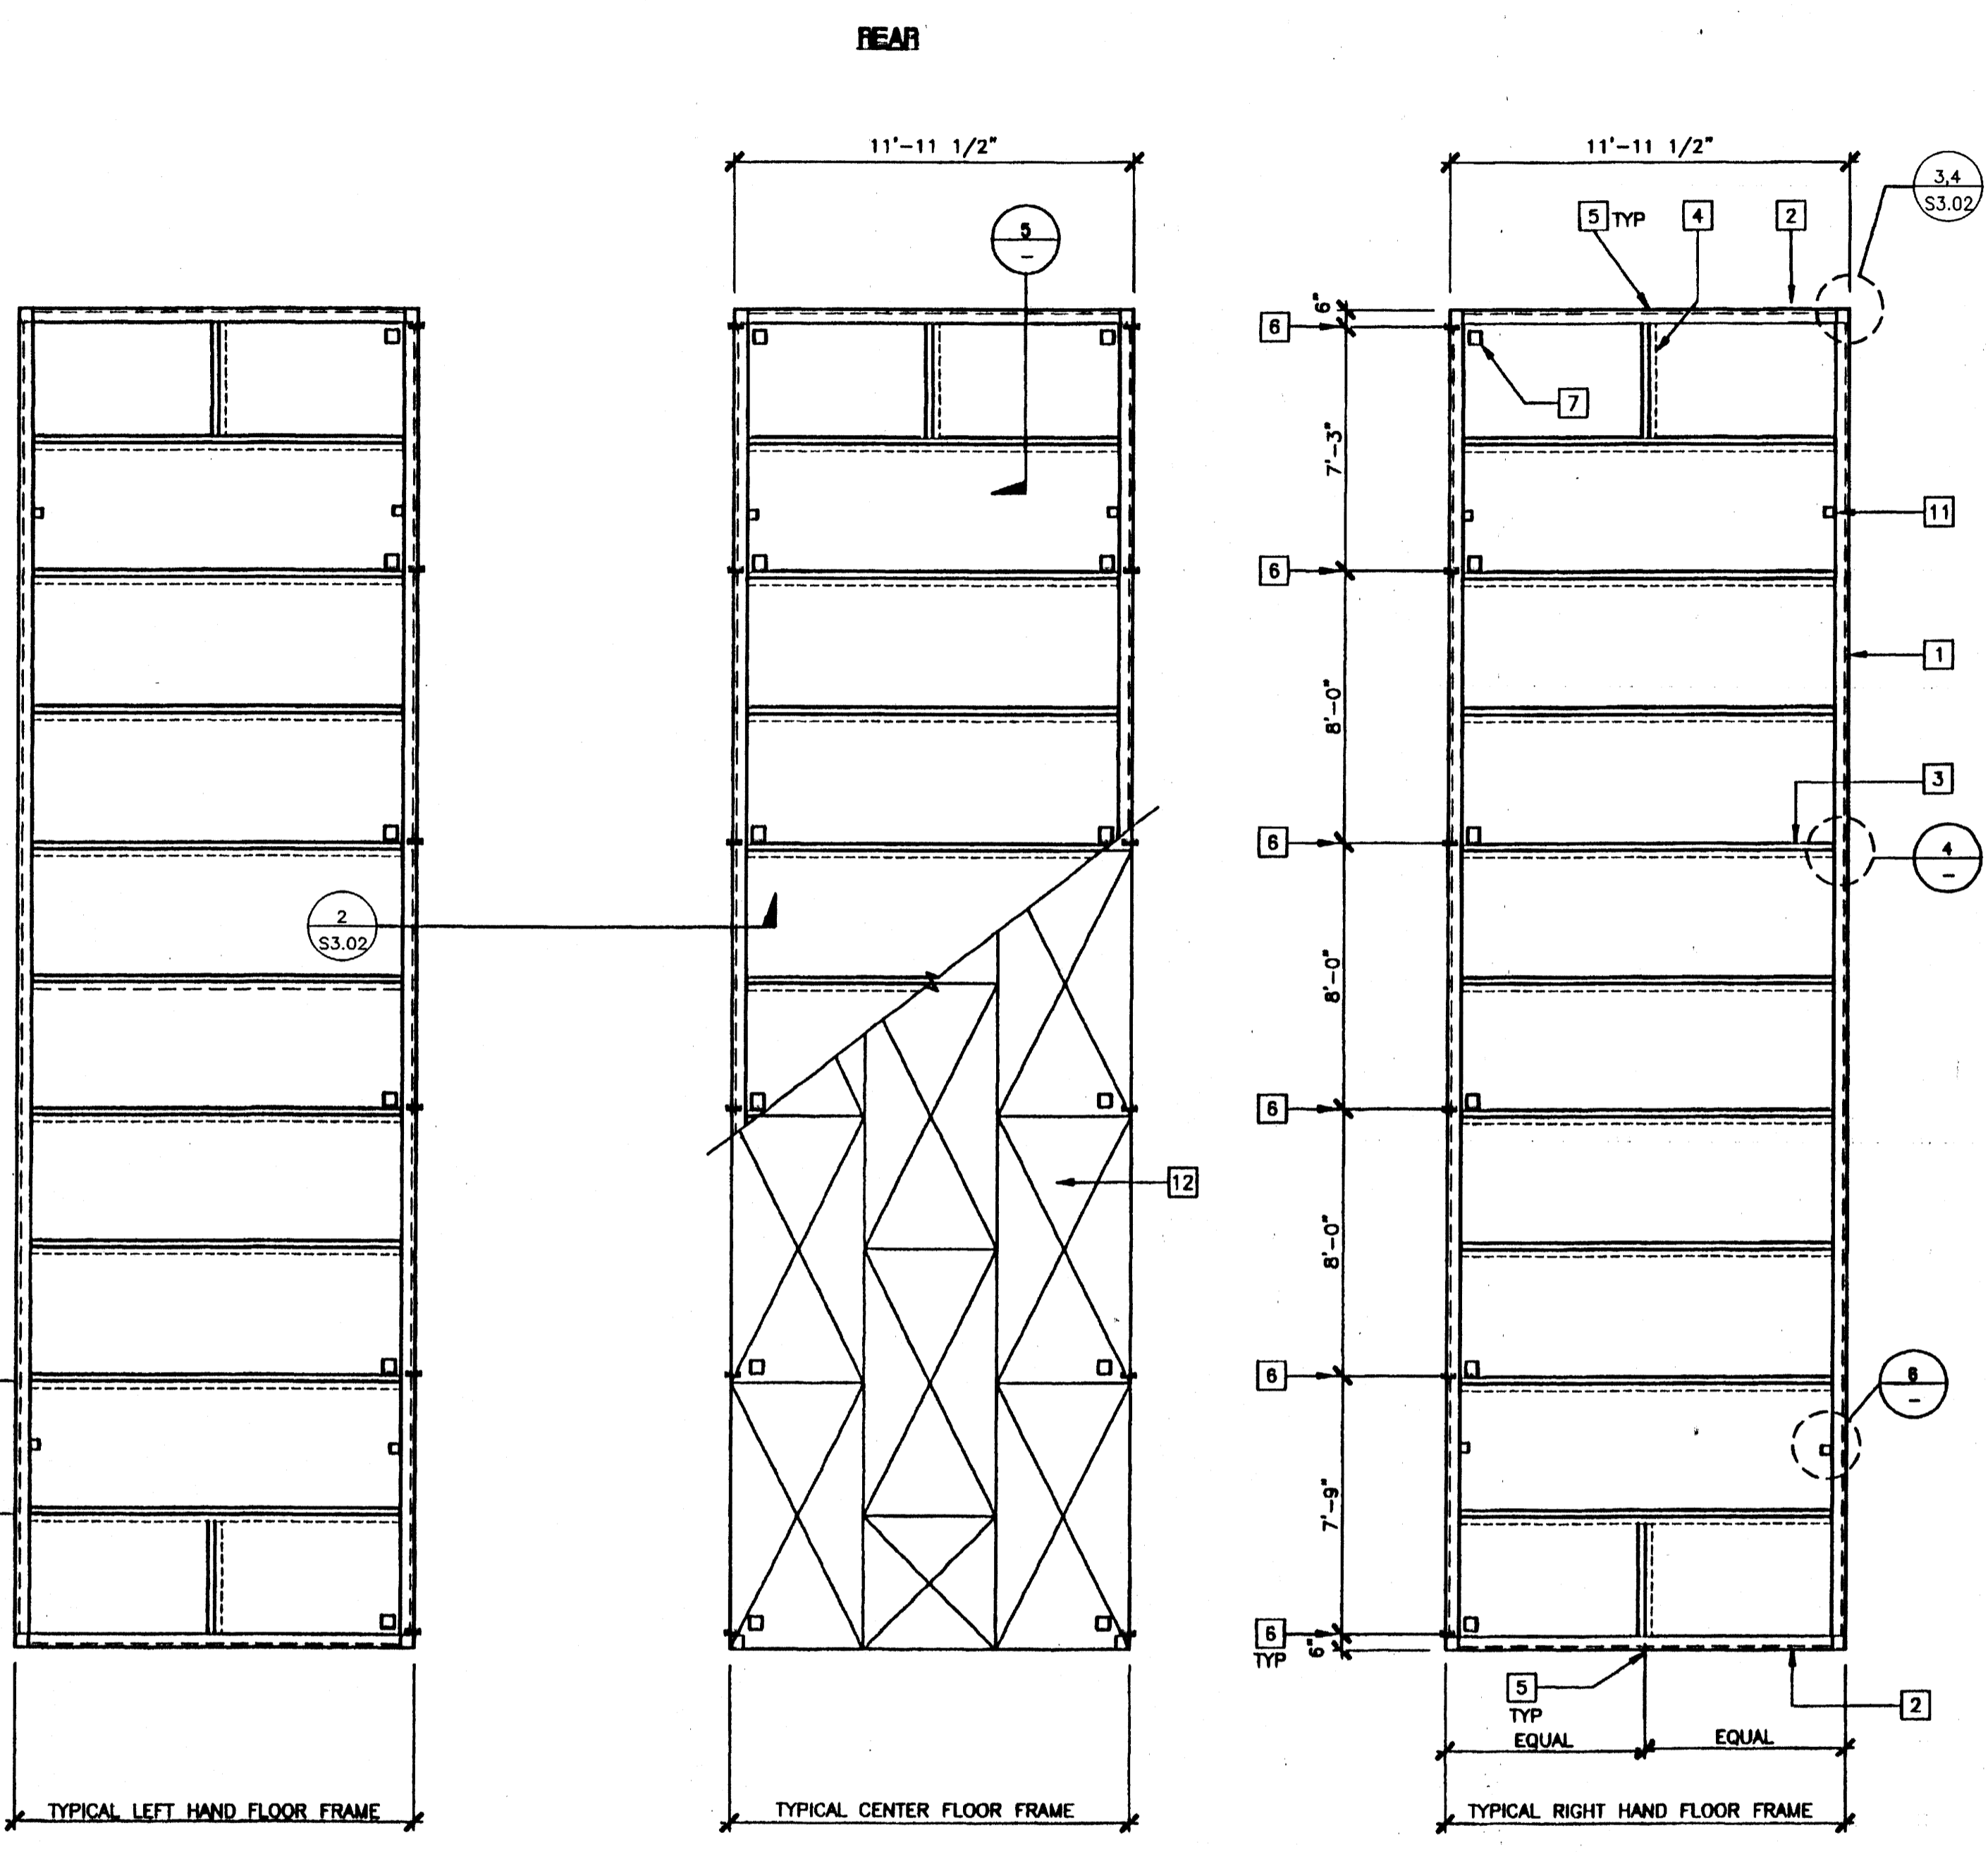

FLOOR FRAMING PLAN

SCALE: 1/4" = 1'-0"

PC
CBC 1998

REVISIONS

1	SP	MODTECH ENGINEERING CHANGE	9/21/00
2	SP	MODTECH ENGINEERING CHANGE	09/28/00
3	SP	REVISED FLOOR JOIST TABLE	12/12/00

Professional Engineer's Seals for Electrical, Mechanical, and Structural disciplines.

Architect's Seal for George C. Edwards, State of California, License No. 2956.

Identification Stamp: DIV. OF THE STATE ARCHITECT, OFFICE OF REGULATION SERVICES, PC-04, 101268, REVISED 02/2000.






MODTECH INC.
2830 BARRETT AVENUE
PERRIS, CALIF. 92572
PH (909) 943-4014
FAX (909) 940-0427

PROJECT NUMBER: 4373
COLTON U.S.D.
MODTECH, INC. 2002

DRAWN BY: KK
DATE: 11/19/02
CHECKED BY: STKP-67
DATE: 4012-124
MODTECH Index No.
S1.01

REVISED DEC 13 2000

PROJECT NO. 4373
FILE PATH: 2440-ST.01.DWG

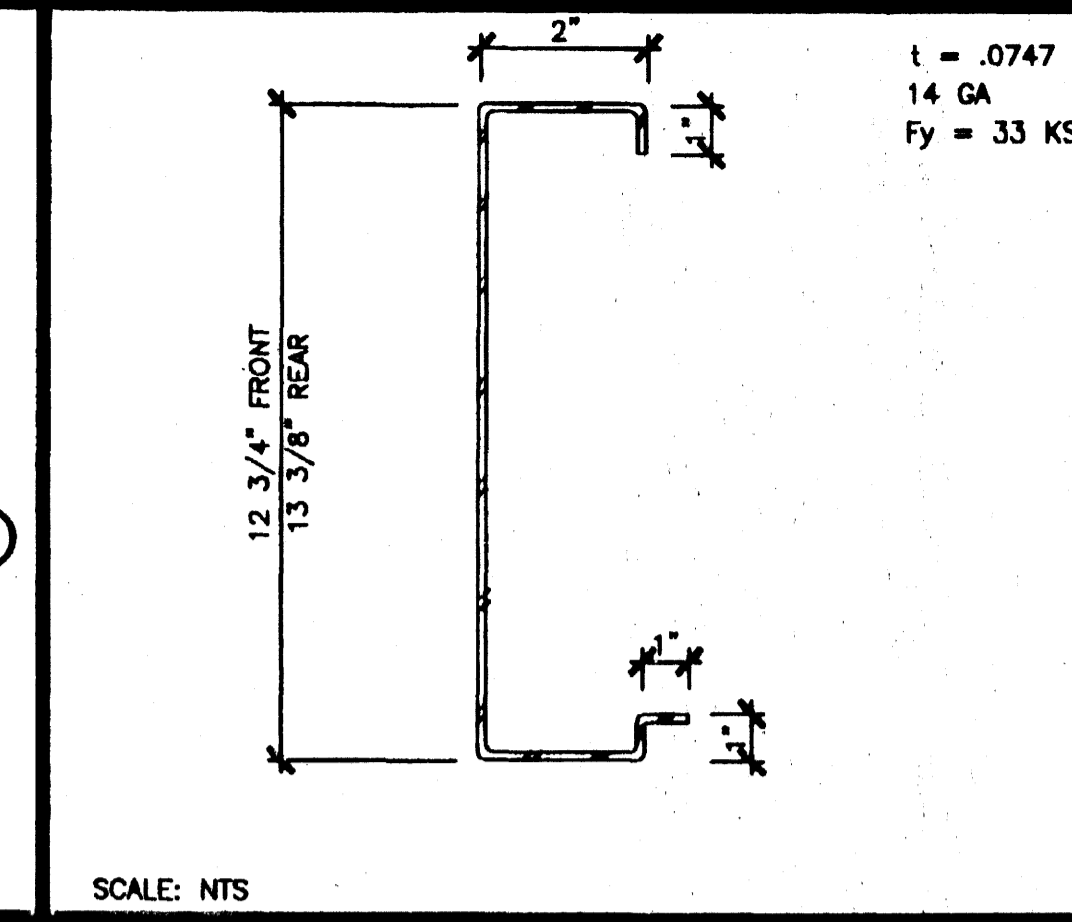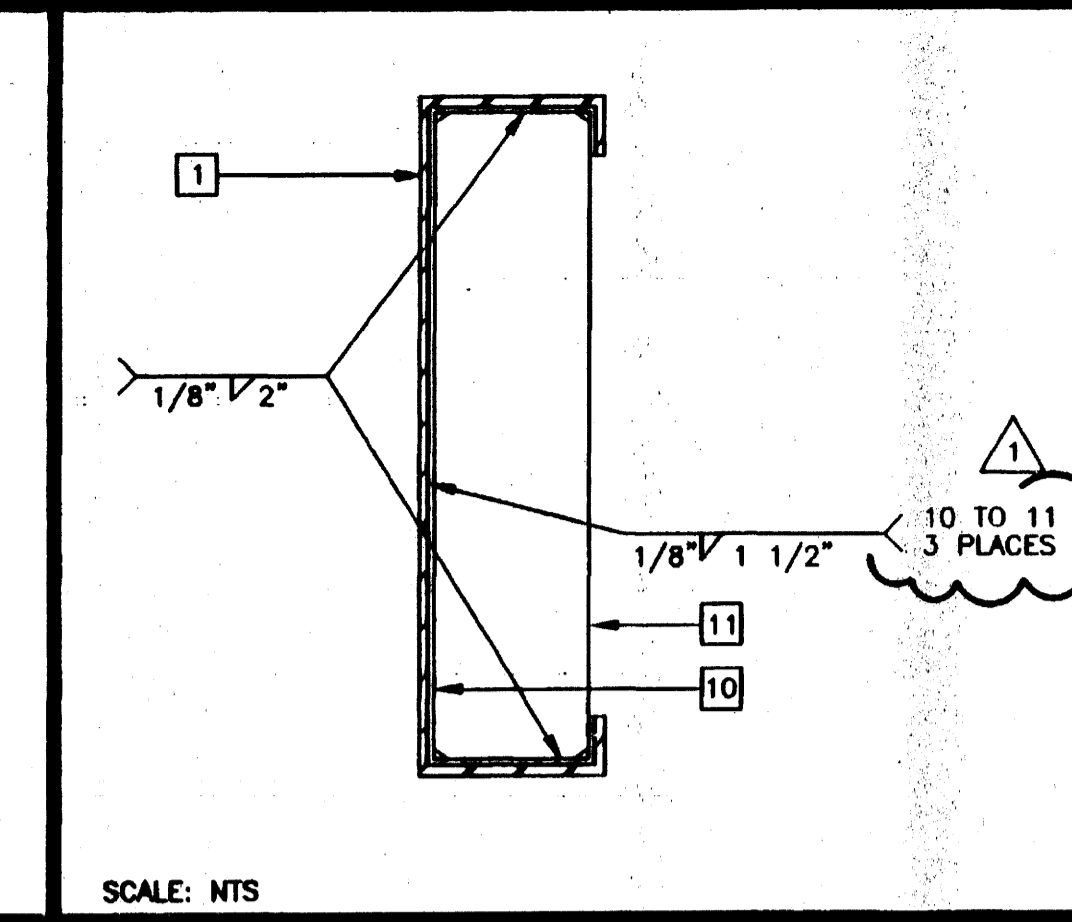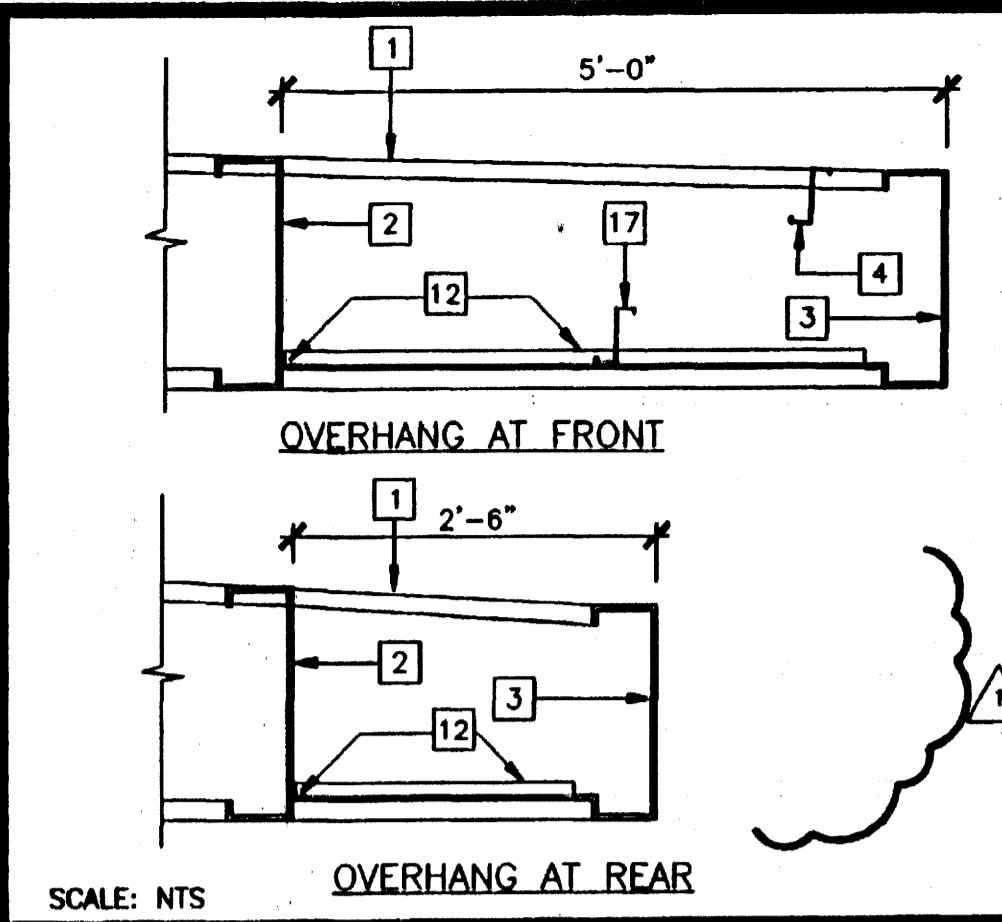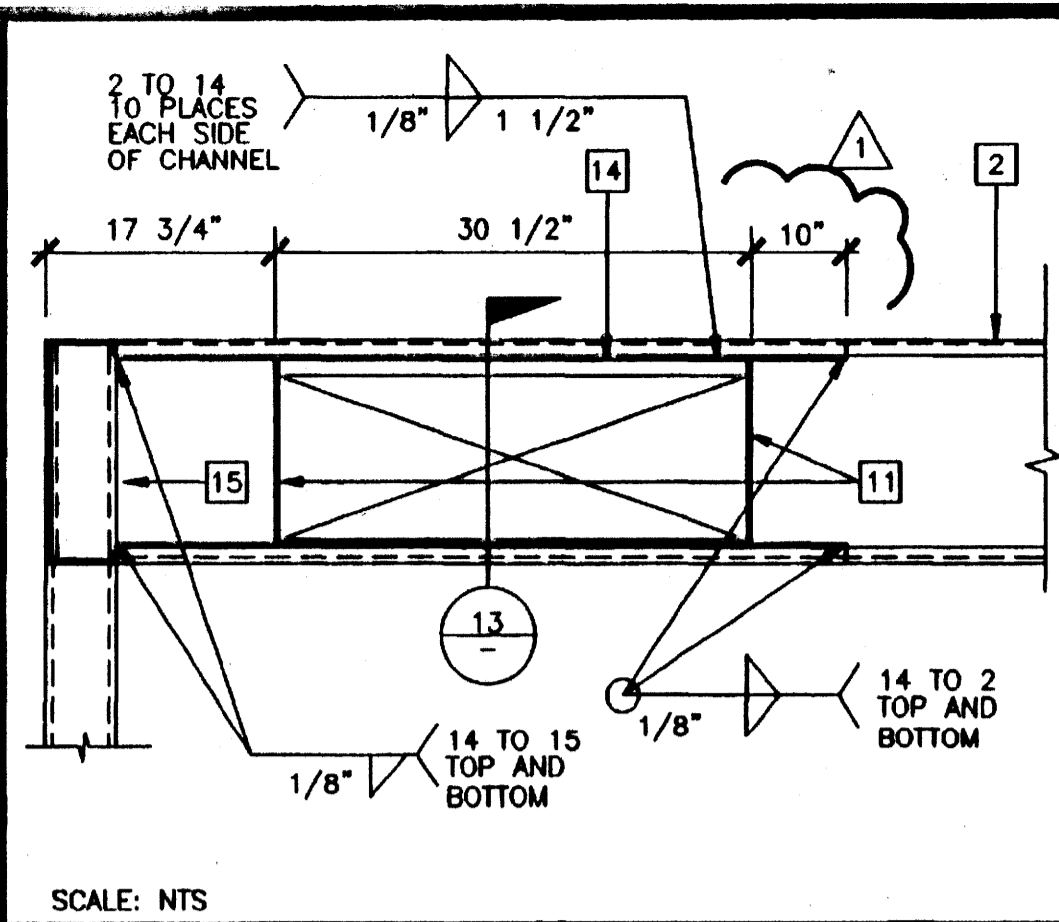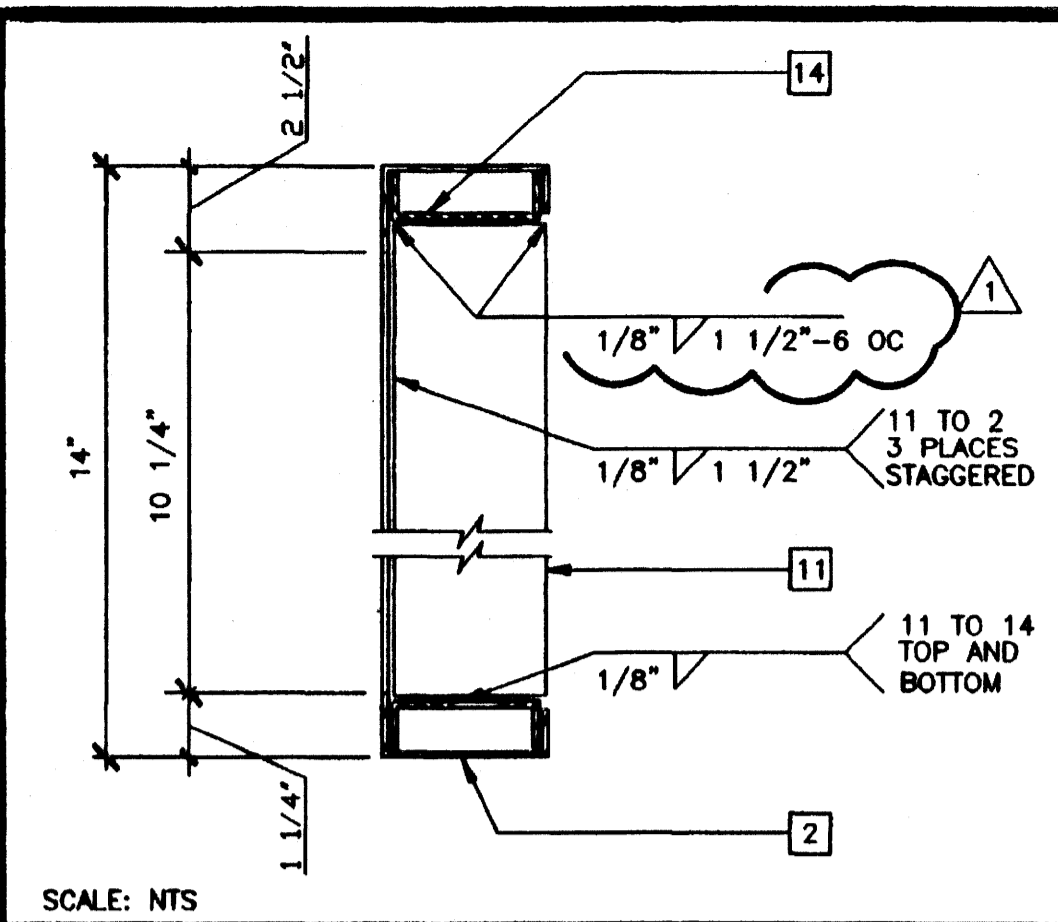

- ### KEY NOTES
- [1] TAPERED ROOF BEAM - 1/2S2.01
 - [2] ROOF HEADER - 2/52.01
 - [3] ROOF FASCIA - 3/52.01
 - [4] ROOF PURLIN - 4/52.01
 - [5] RIDGE LINE
 - [6] 11/16" DIA DRILLED HOLE - 5/S3.01
 - [7] EDGE NAIL THIS LINE
 - [8] PLYWOOD ROOF SHEATHING, 3/4" CD EXPOSURE 1, P.1.1 48/24, PSI-83 PLYCLIPS AT 16" OC MAX ON LONG EDGES #10x1 1/4" SELF TAPPING FLAT HEAD SCREWS AT 8" OC TO PERIMETER FRAME OR ALTERNATE USE AEROSMITH AKN 1.44 DRIVE PINS AT 8" OC TO PERIMETER FRAME, AEROSMITH AKN 1.44,0175 DRIVE PINS AT 8" OC AT SUPPORTED EDGES AND 8" OC FIELD NAILING TO PURLINS, PLYWOOD PATTERN SHOWN IS TYPICAL
 - [9] OPTIONAL BEAM SPLICE LOCATIONS
 - [10] 10 GA BENT PLATE BACK UP
 - [11] 1/4" FULL DEPTH STIFFENER PLATE
 - [12] 1/2"x1/2"x16 GA ANGLE, TACK WELD TO HEADER AND ROOF BEAM
 - [13] PURLIN SIZE BLOCKING AT HEADER MIDSPAN FOR 80 MPH DESIGN WIND LOAD ONLY
 - [14] 3 1/4"x1" CHANNEL STIFFENER
 - [15] TUBE STEEL STIFFENER
 - [16] LOCATION OF ADDITIONAL PURLIN FOR BUILDINGS THAT EXCEED 2180 SF
 - [17] Z STIFFENER AT SOFFIT CLOSURE - 4/52.01
 - [18] 6"x2 1/2"x14 GA FRAMING FOR ROUGH OPENING OF OPTIONAL ROOF MOUNT HVAC, SPACING AND LOCATION WILL VARY - 18,19/A6.01 (HV)














HVAC OPENING IN ROOF HEADER 13

HVAC OPENING IN ROOF HEADER 12

OVERHANGS 11

STIFFENER PLATE AT SPLICE 7

ROOF FASCIA 3

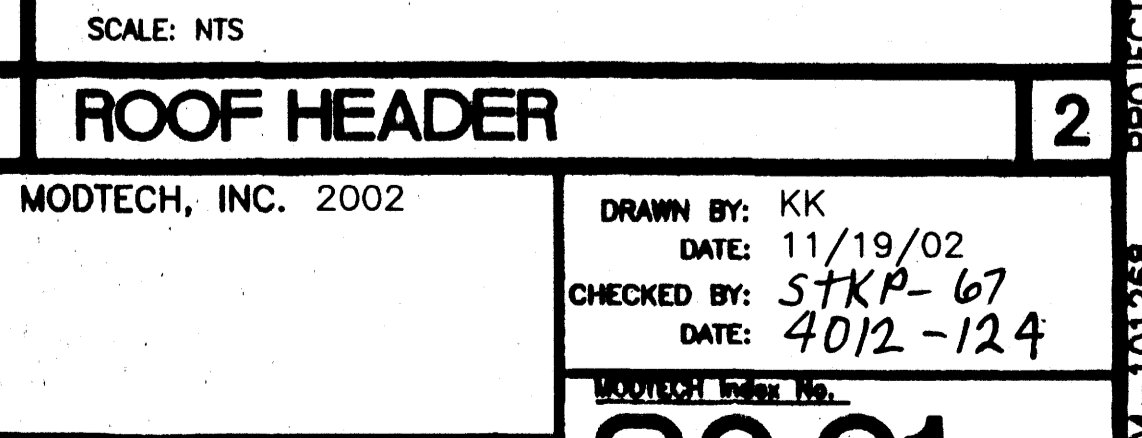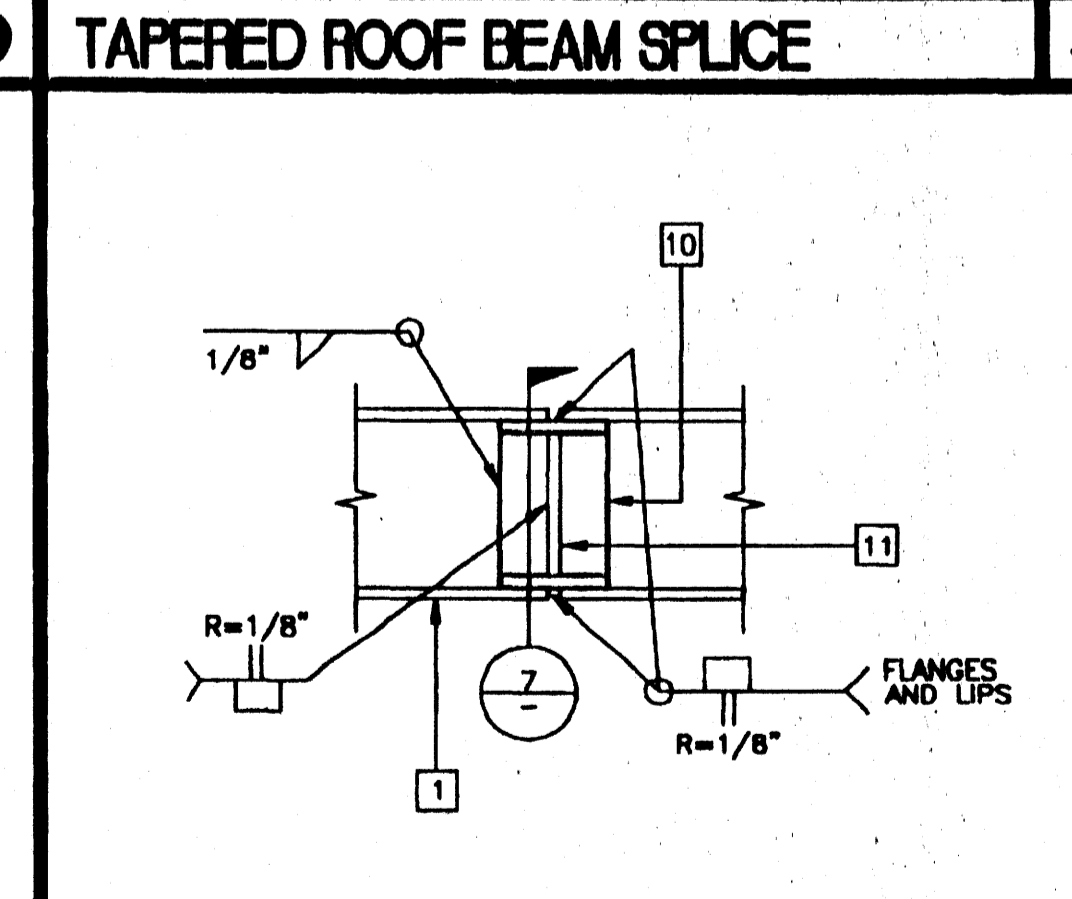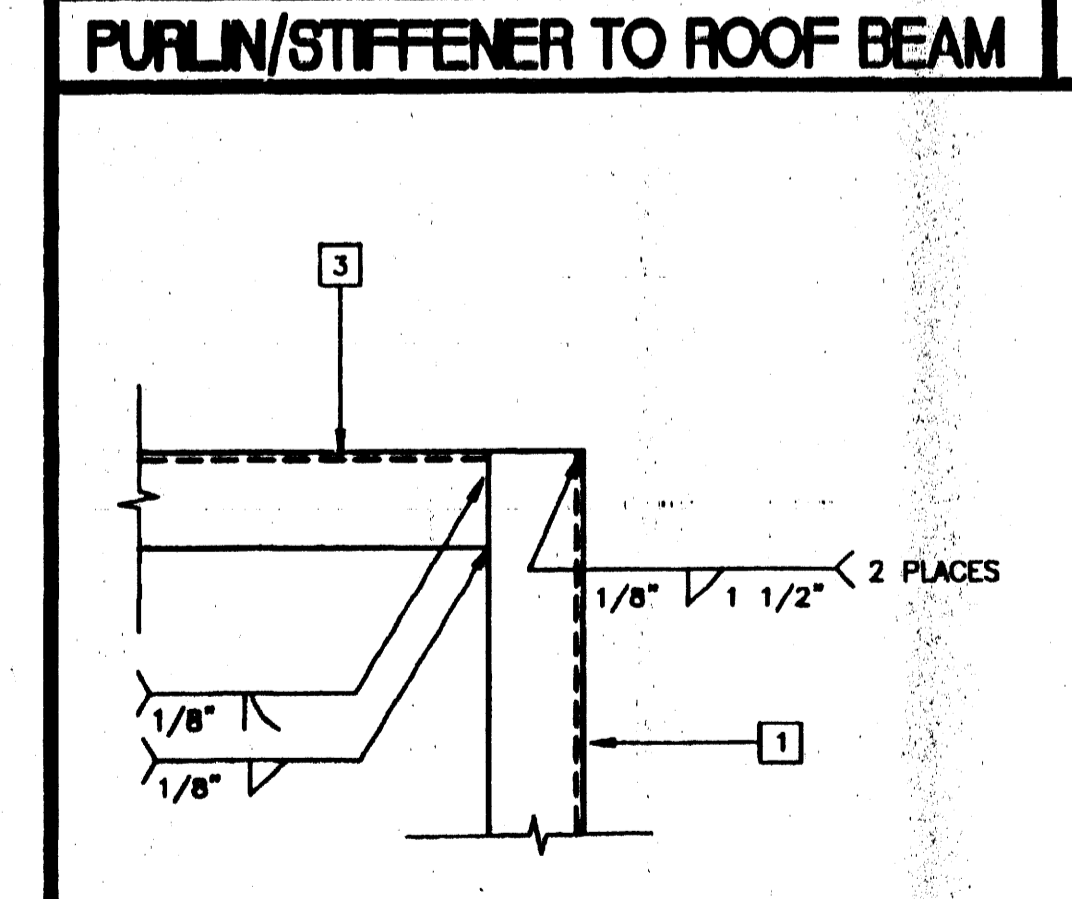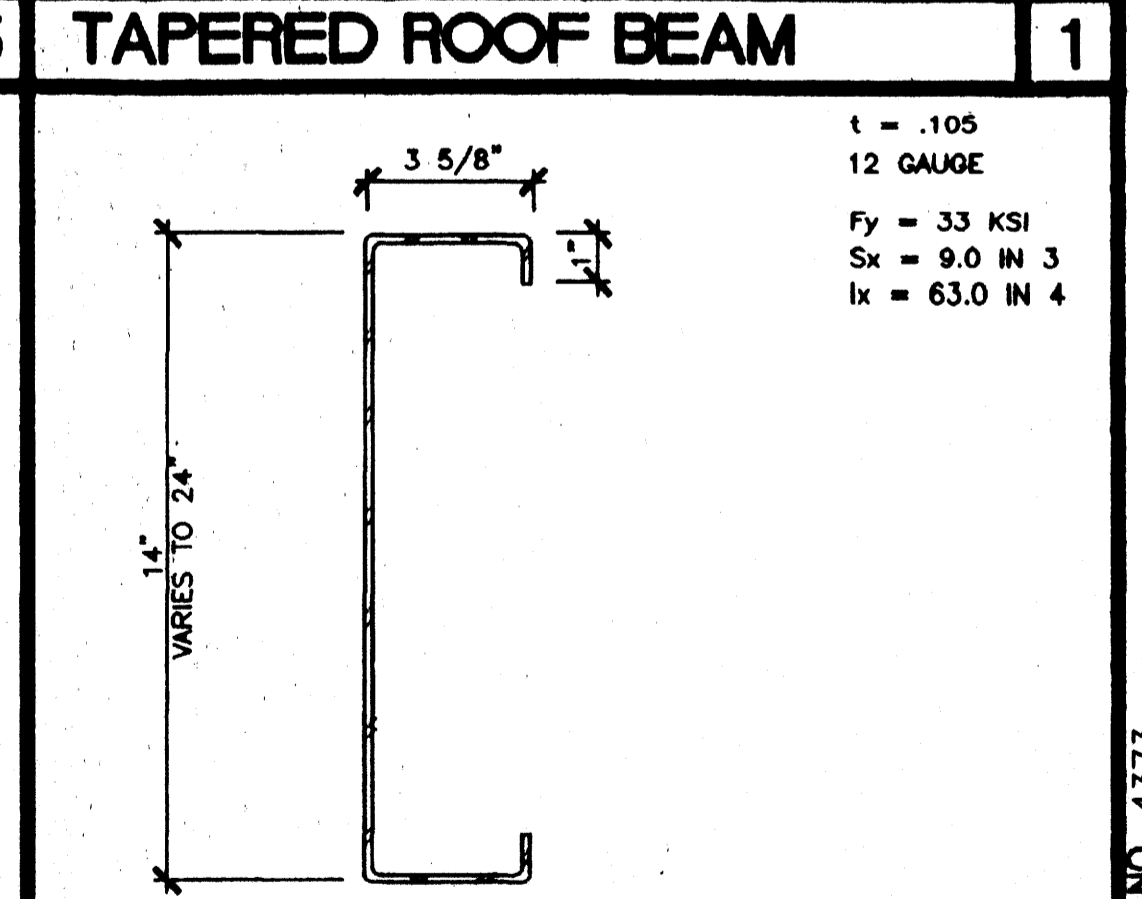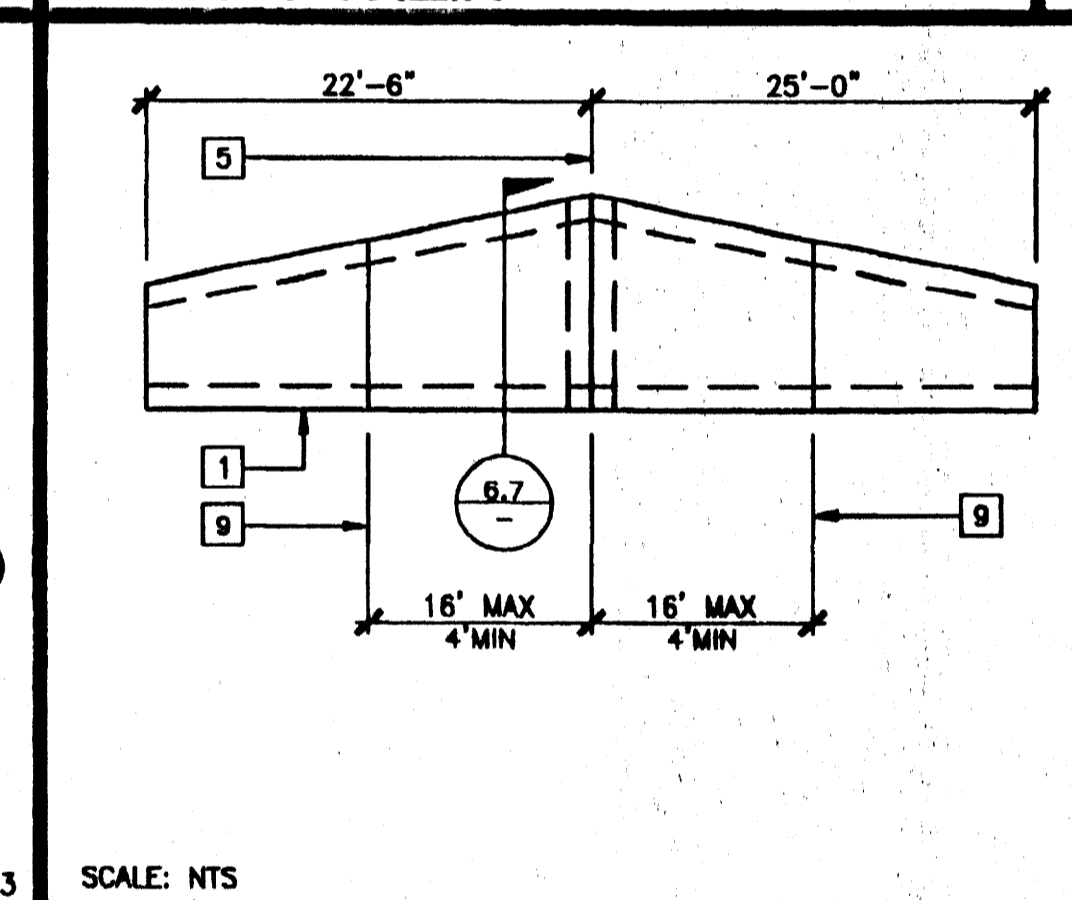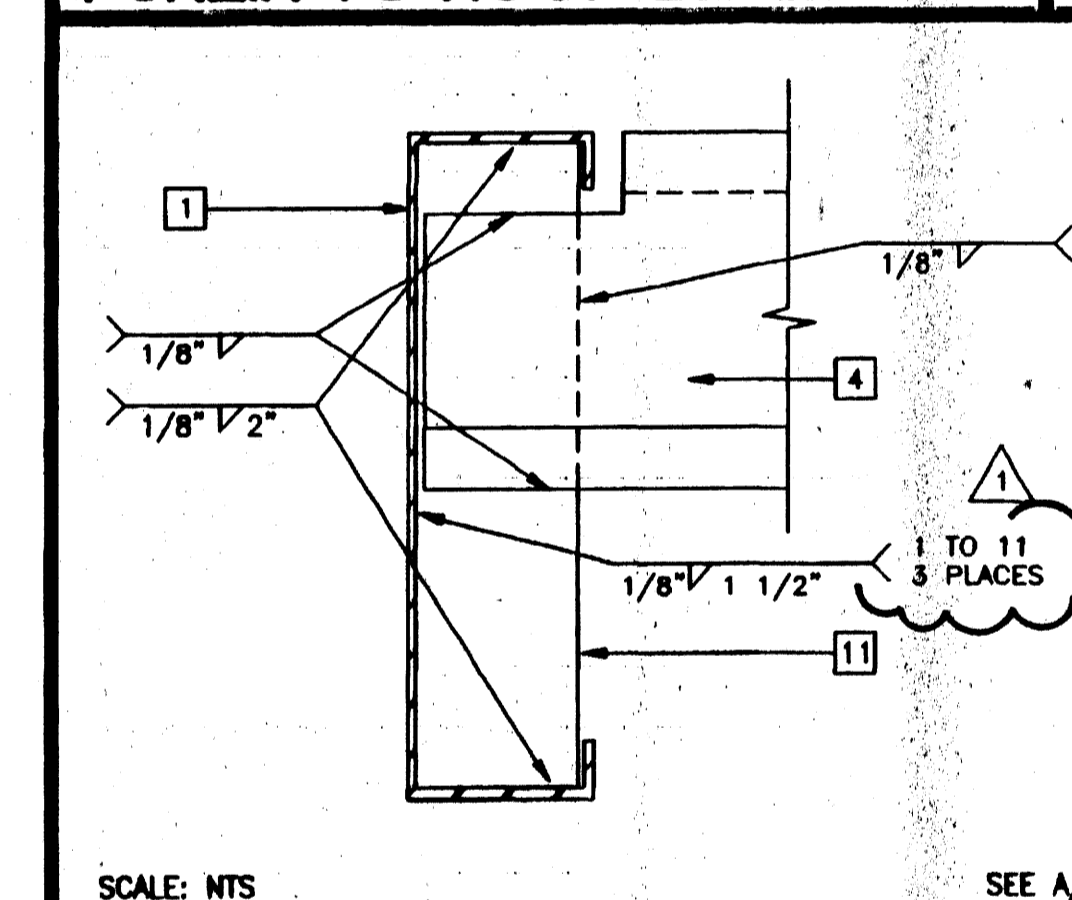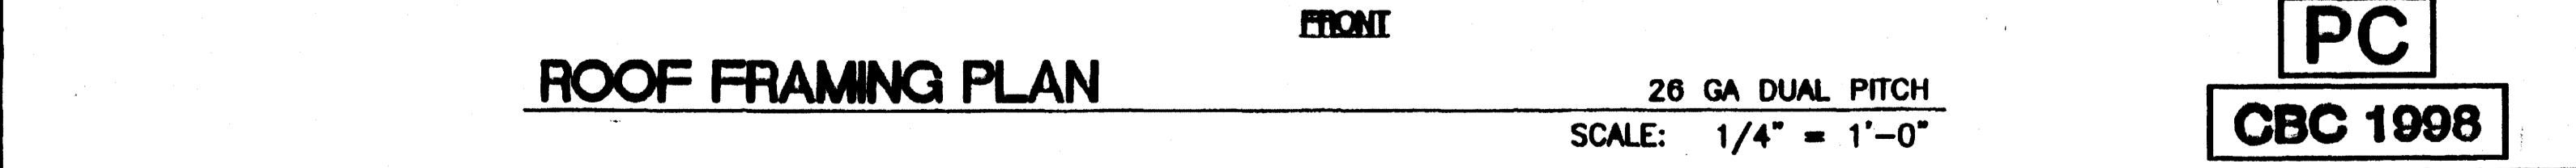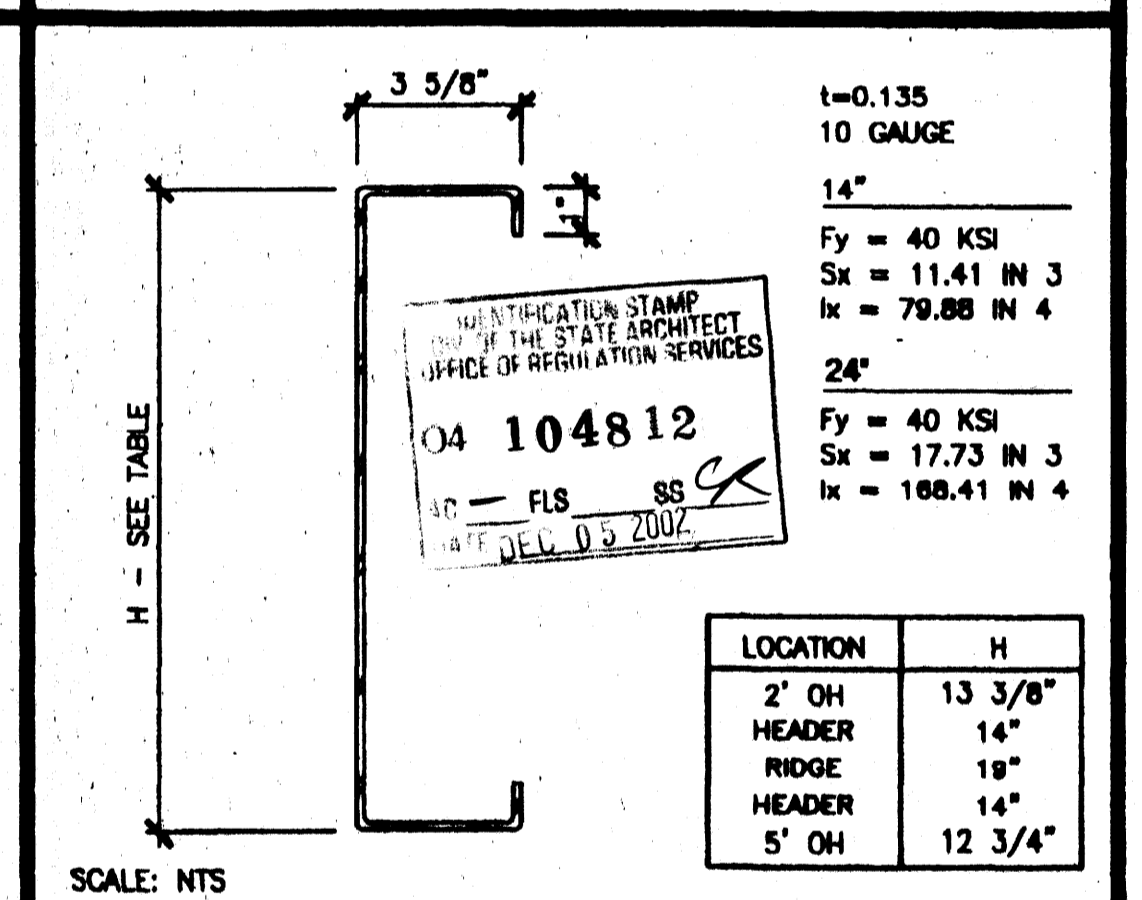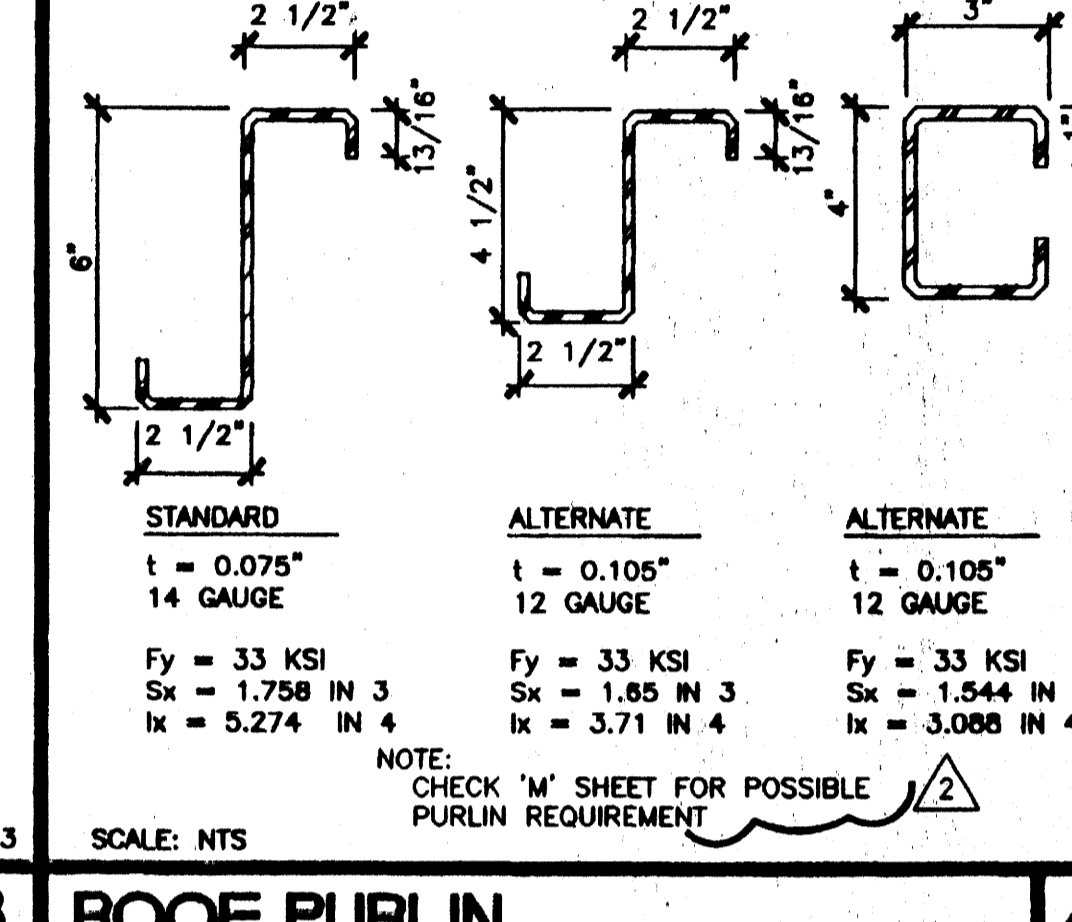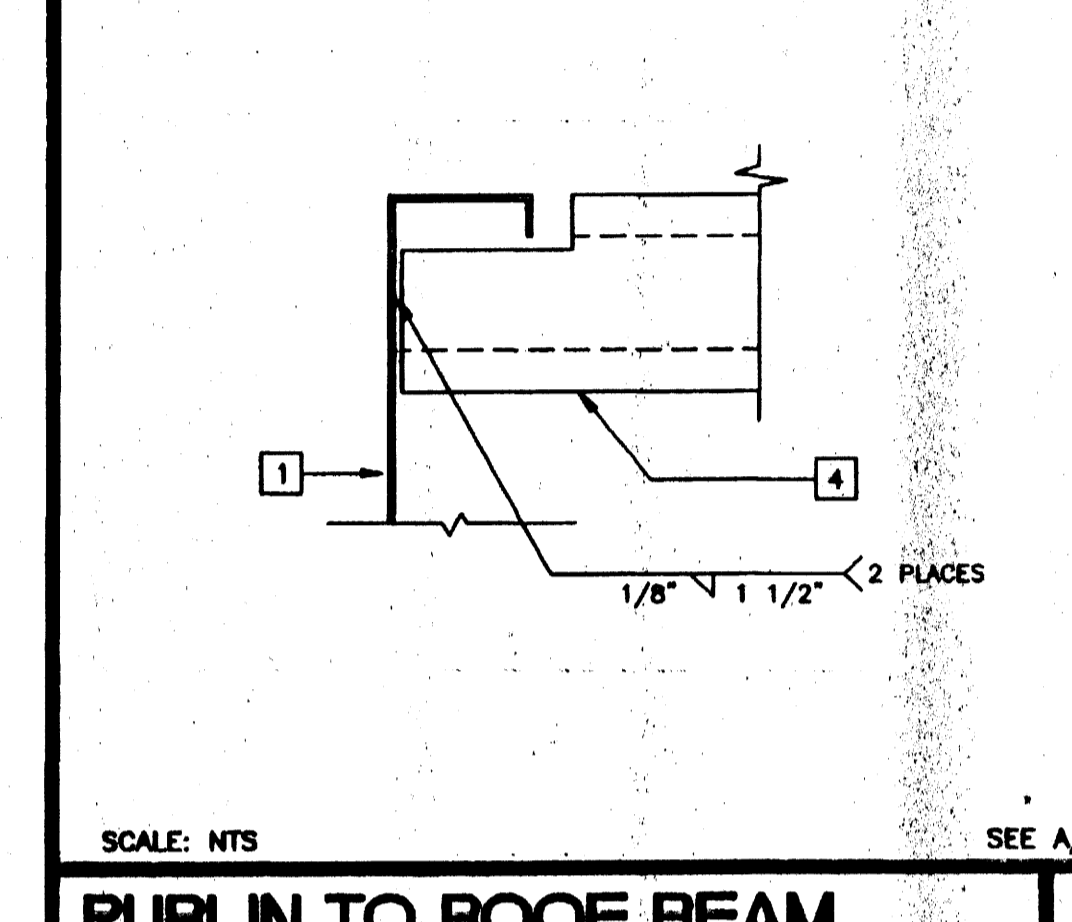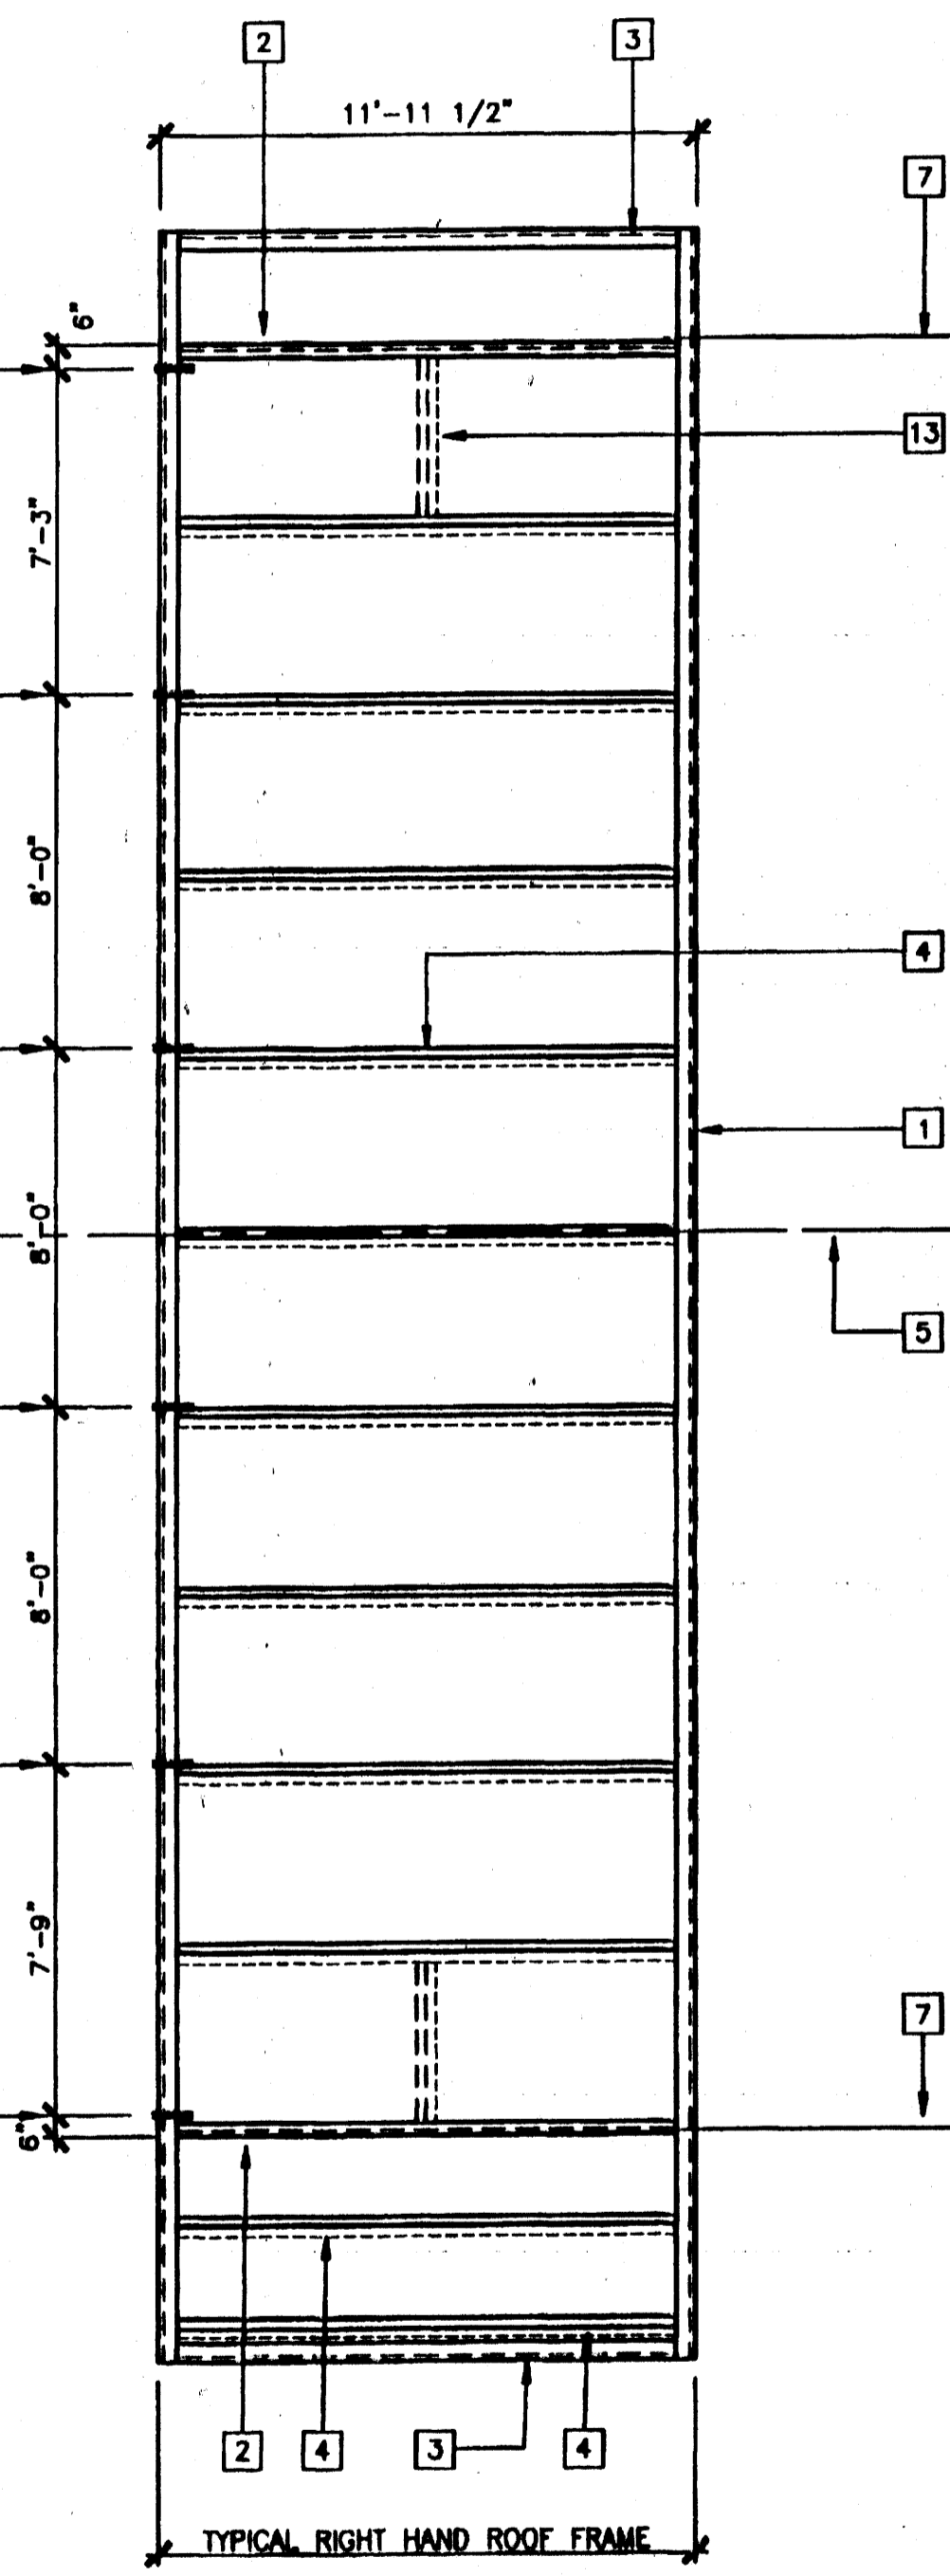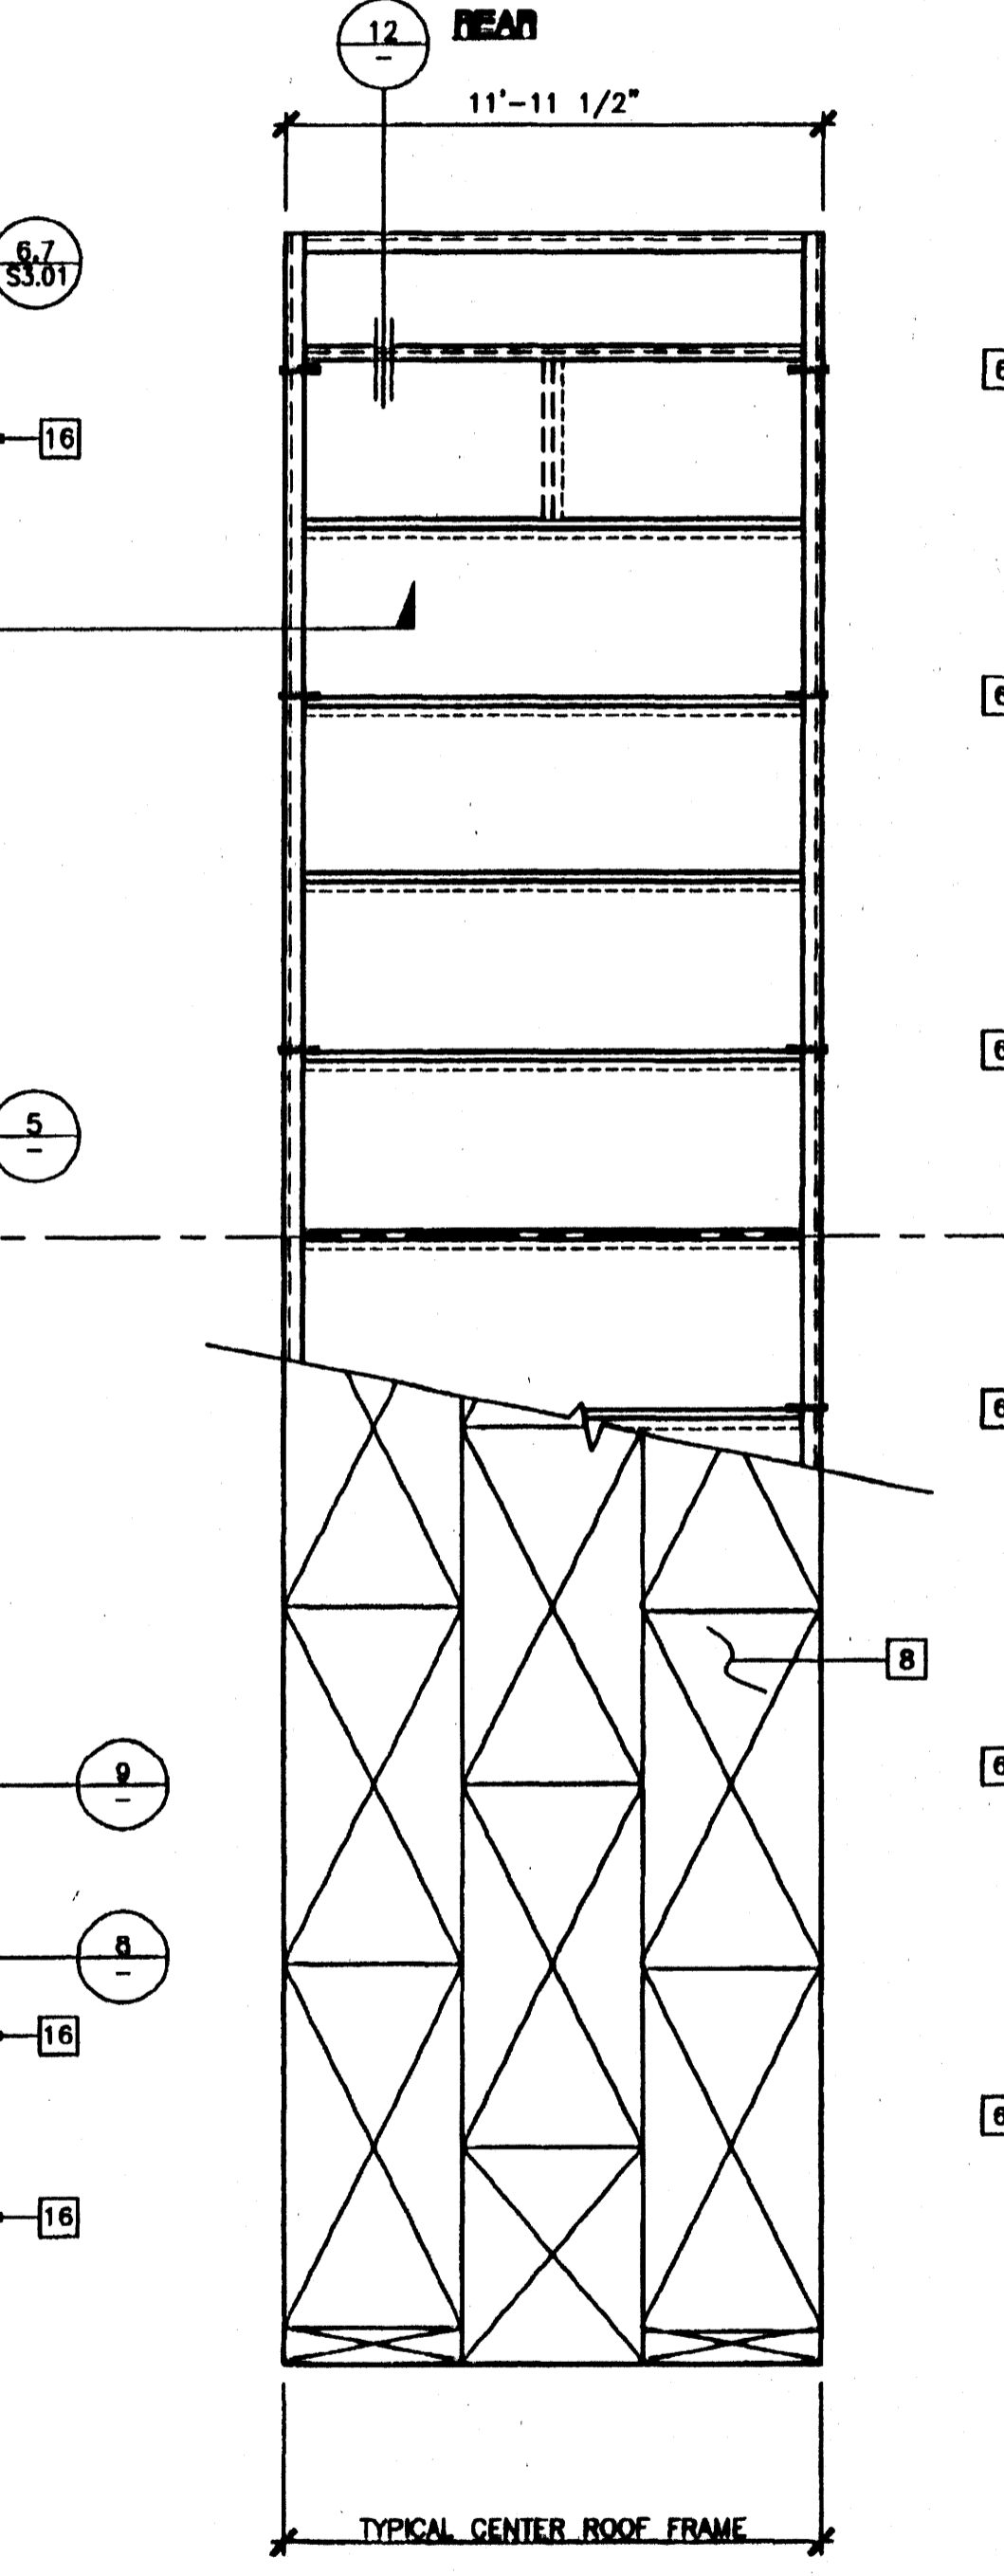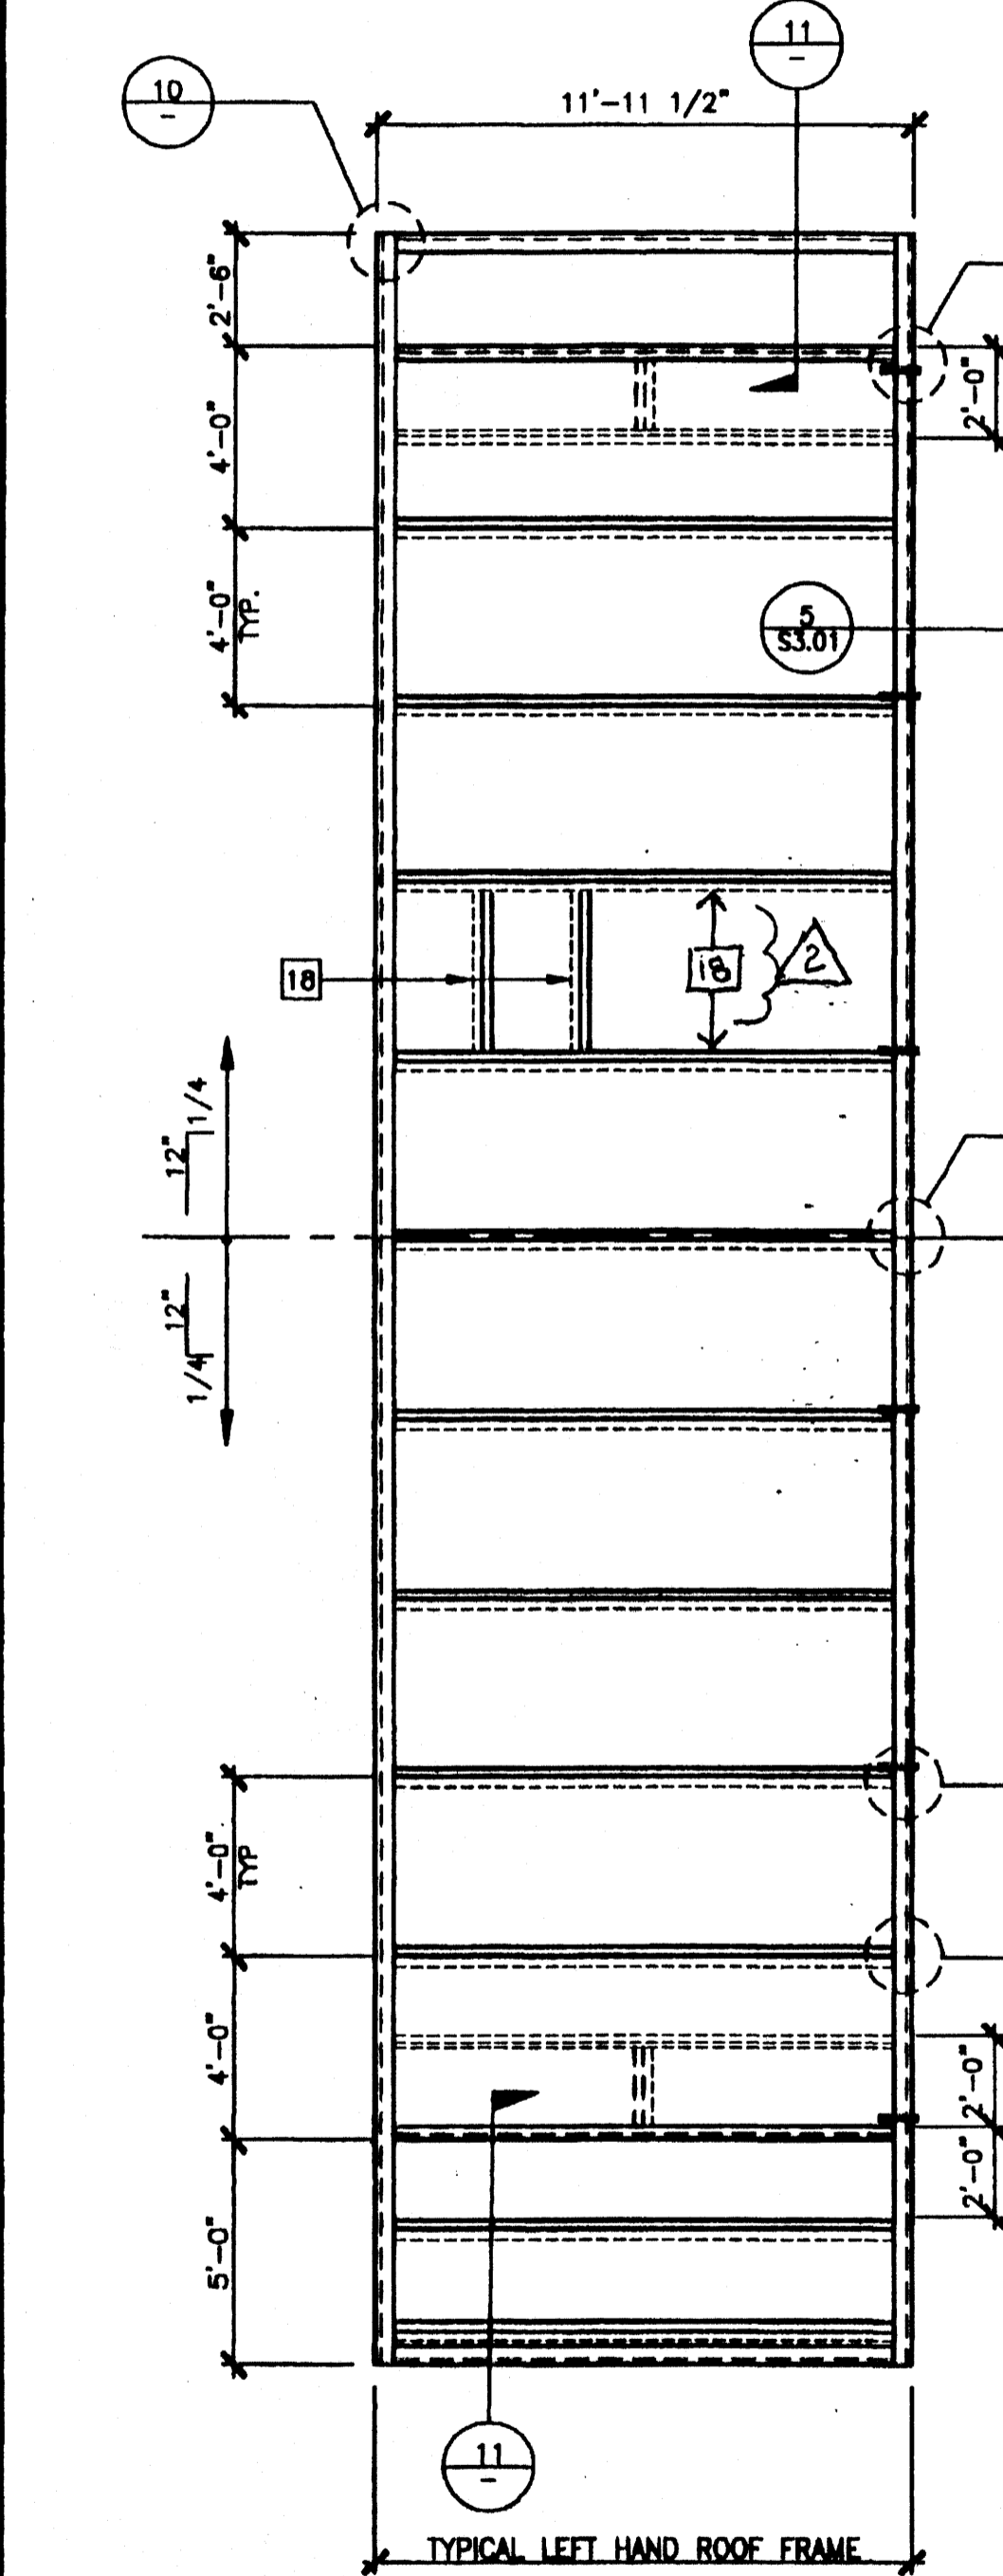

REVISIONS		
SP	MODTECH ENGINEERING CHANGE	09/28/00
SP	ADDED REFERENCE NOTE	11/9/00






Electrical Engineer's Seal
Mechanical Engineer's Seal
Structural Engineer's Seal
Architect's Seal
PC-04
101268
MODTECH INC.
2830 BARRETT AVENUE
PERRIS, CALIF. 92572
PH (909) 943-4014
FAX (909) 940-0427

PROJECT NUMBER: 4373
COLTON U.S.D.
MODTECH, INC. 2002
DRAWN BY: KK
DATE: 11/19/02
CHECKED BY: STKP-67
DATE: 4012-124

ROOF FRAMING PLAN 26 GA DUAL PITCH

S2.01

FILE PATH: 2440-S2.01.DWG PROJECT NO. 4373 PC-04-101268

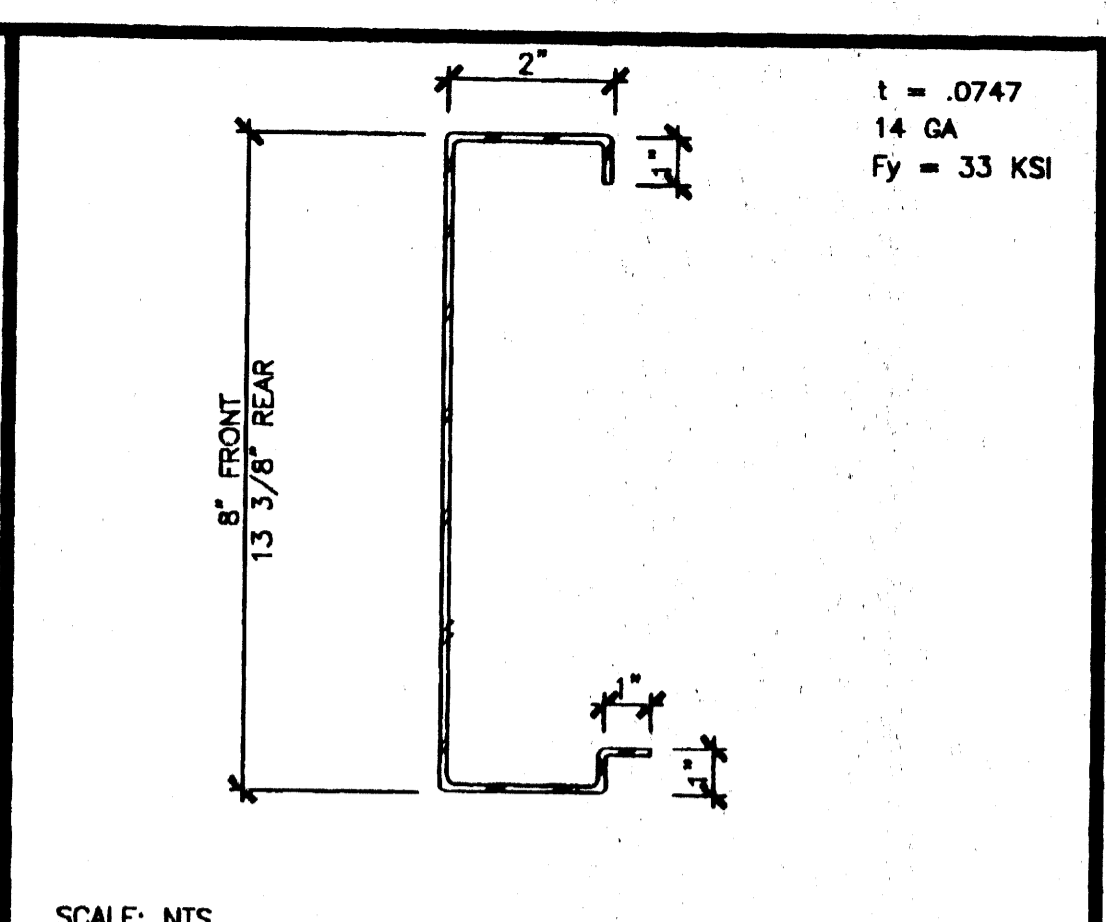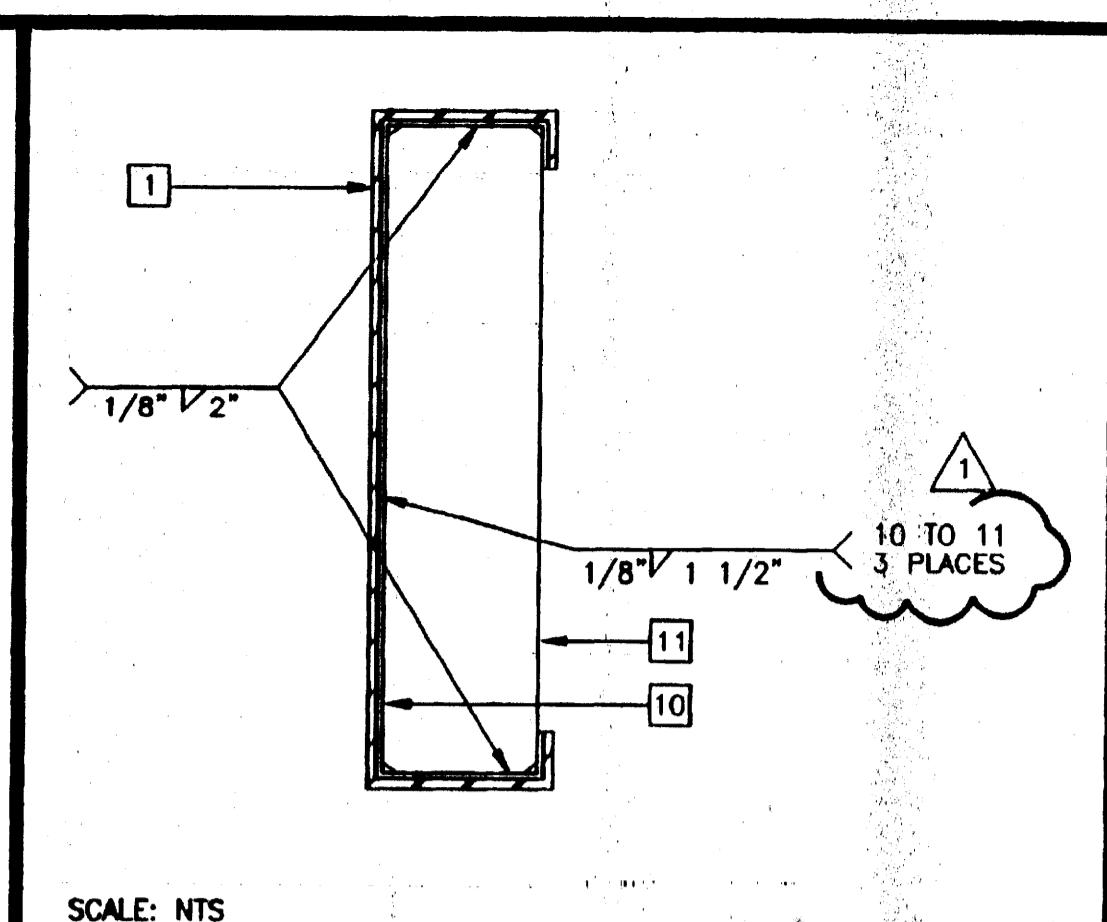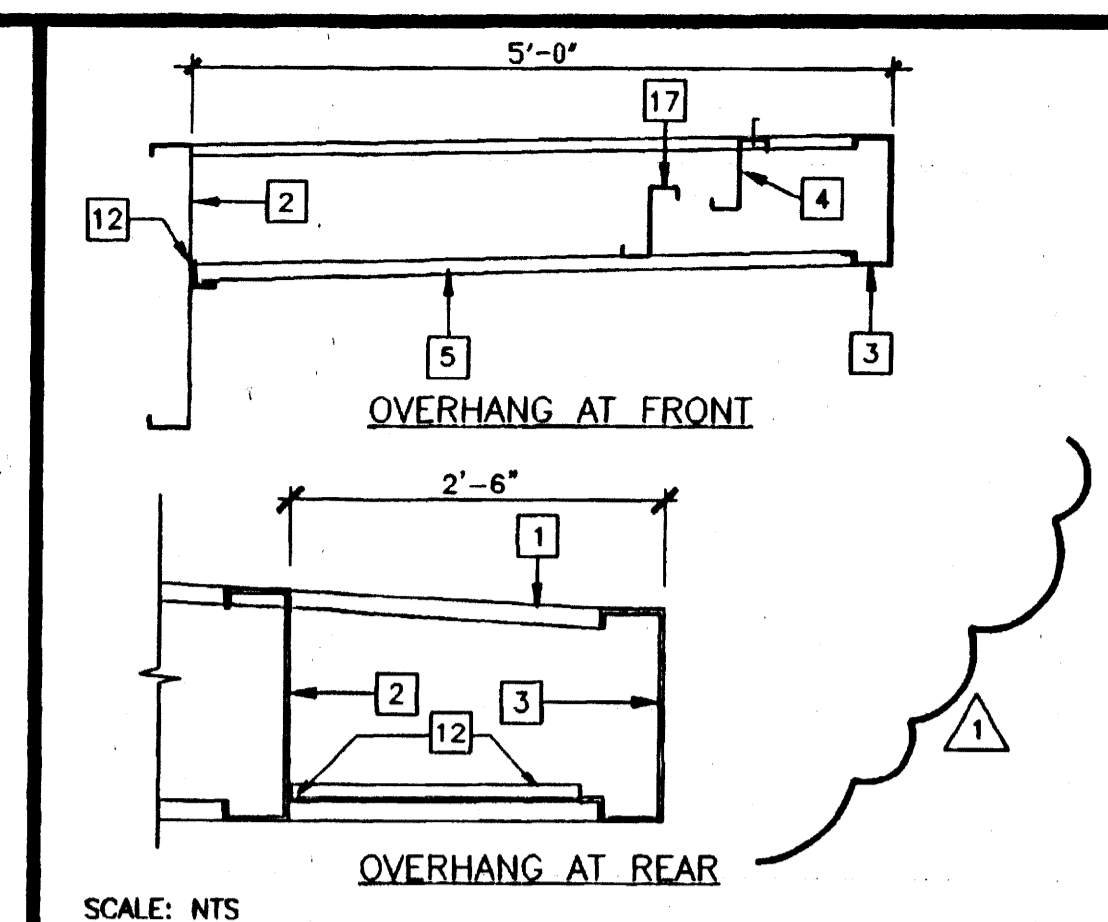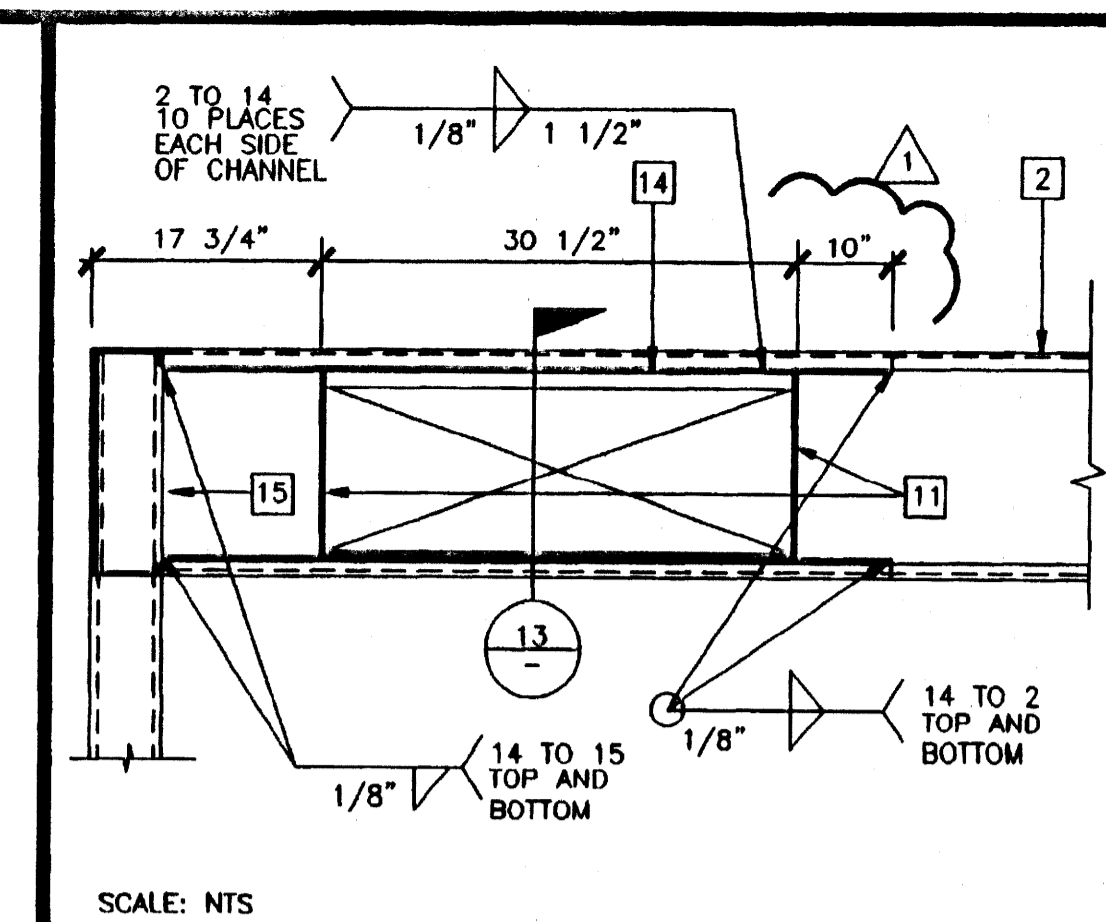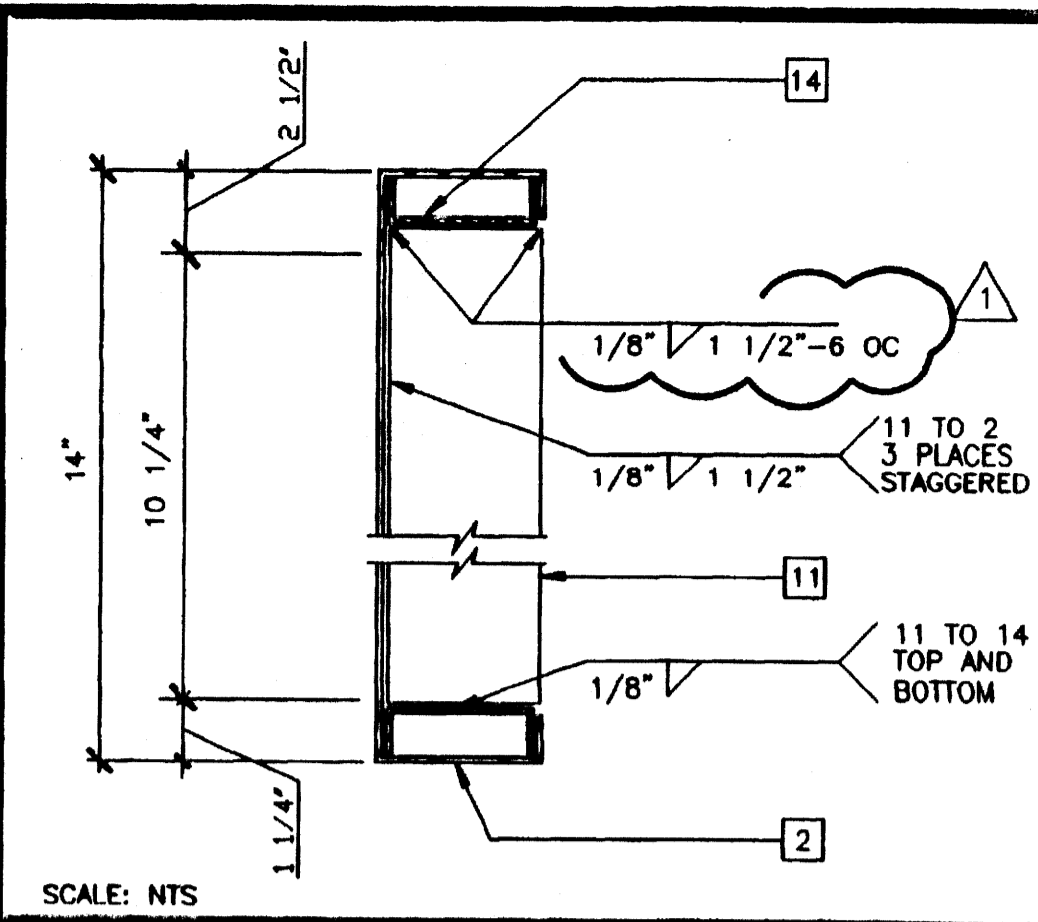

KEY NOTES

- [TAPERED ROOF BEAM - 1/S2.02
- [ROOF HEADER - 2/S2.02
- [ROOF FASCIA - 3/S2.02
- [ROOF PURLIN - 4/S2.02
- ROOF OVERHANG BEAM - 10/S3.02
- 11/16" DIA DRILLED HOLE - 5/S3.02
- EDGE NAIL THIS LINE
- PLYWOOD ROOF SHEATHING, 3/4" CD EXPOSURE 1, P-1.1 48/24, PSI-B3 PLYCLIPS AT 16" OC MAX ON LONG EDGES #10x1 1/4" SELF TAPPING FLAT HEAD SCREWS AT 6" OC TO PERIMETER FRAME OR ALTERNATE USE AEROSMITH AKN 144 DRIVE PINS AT 6" OC TO PERIMETER FRAME, AEROSMITH AKN 144.0175 DRIVE PINS AT 6" OC AT SUPPORTED EDGES AND 6" OC CHANNEL NAILING TO PURLINS, PLYWOOD PATTERN SHOWN IS TYPICAL
- OPTIONAL BEAM SPLICE LOCATIONS
- 10 GA BENT PLATE BACK UP
- 1/4" FULL DEPTH STIFFENER PLATE
- 1/2"x1/2"x16 GA ANGLE, TACK WELD TO HEADER AND ROOF BEAM
- PURLIN SIZE BLOCKING AT HEADER MIDSPAN FOR 80 MPH DESIGN WIND LOAD ONLY
- 3 1/4"x1" CHANNEL STIFFENER
- TUBE STEEL STIFFENER
- LOCATION OF ADDITIONAL PURLIN FOR BUILDINGS THAT EXCEED 2160 SF
- Z STIFFENER AT SOFFIT CLOSURE - 4/S2.01
- FRAMING FOR ROUGH OPENING OF OPTIONAL ROOF MOUNT HVAC, SPACING AND LOCATION WILL VARY - 18,19/A6.01 (RV)






HVAC OPENING IN ROOF HEADER 13

HVAC OPENING IN ROOF HEADER 12

OVERHANGS 11

STIFFENER PLATE AT BEAM SPLICE 7

ROOF FASCIA 3

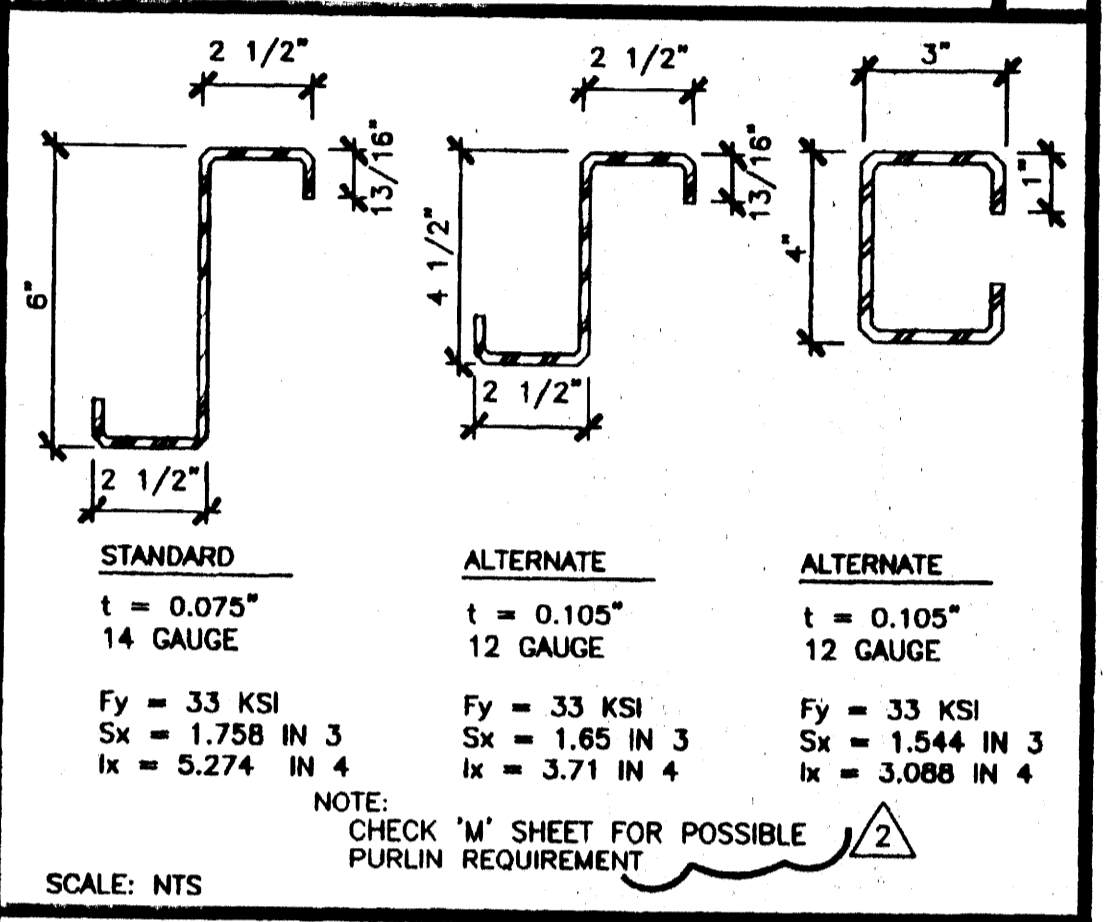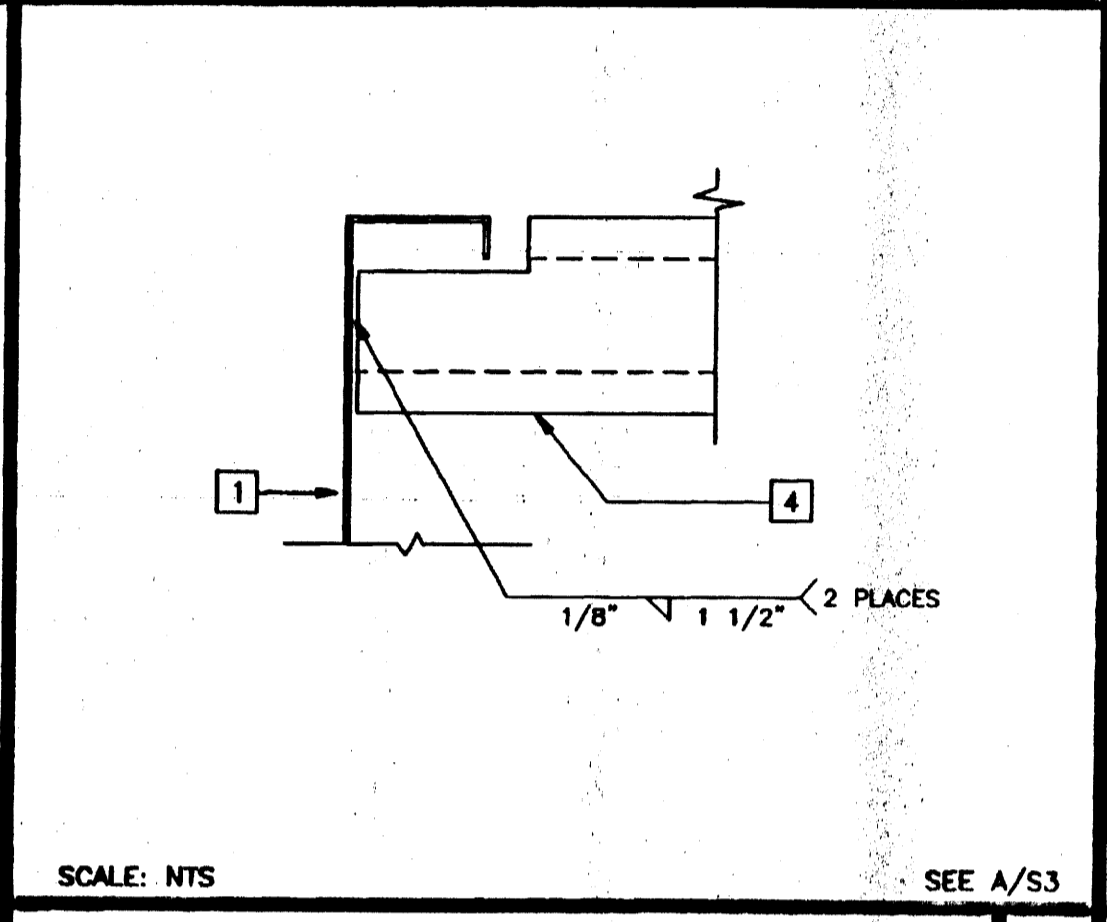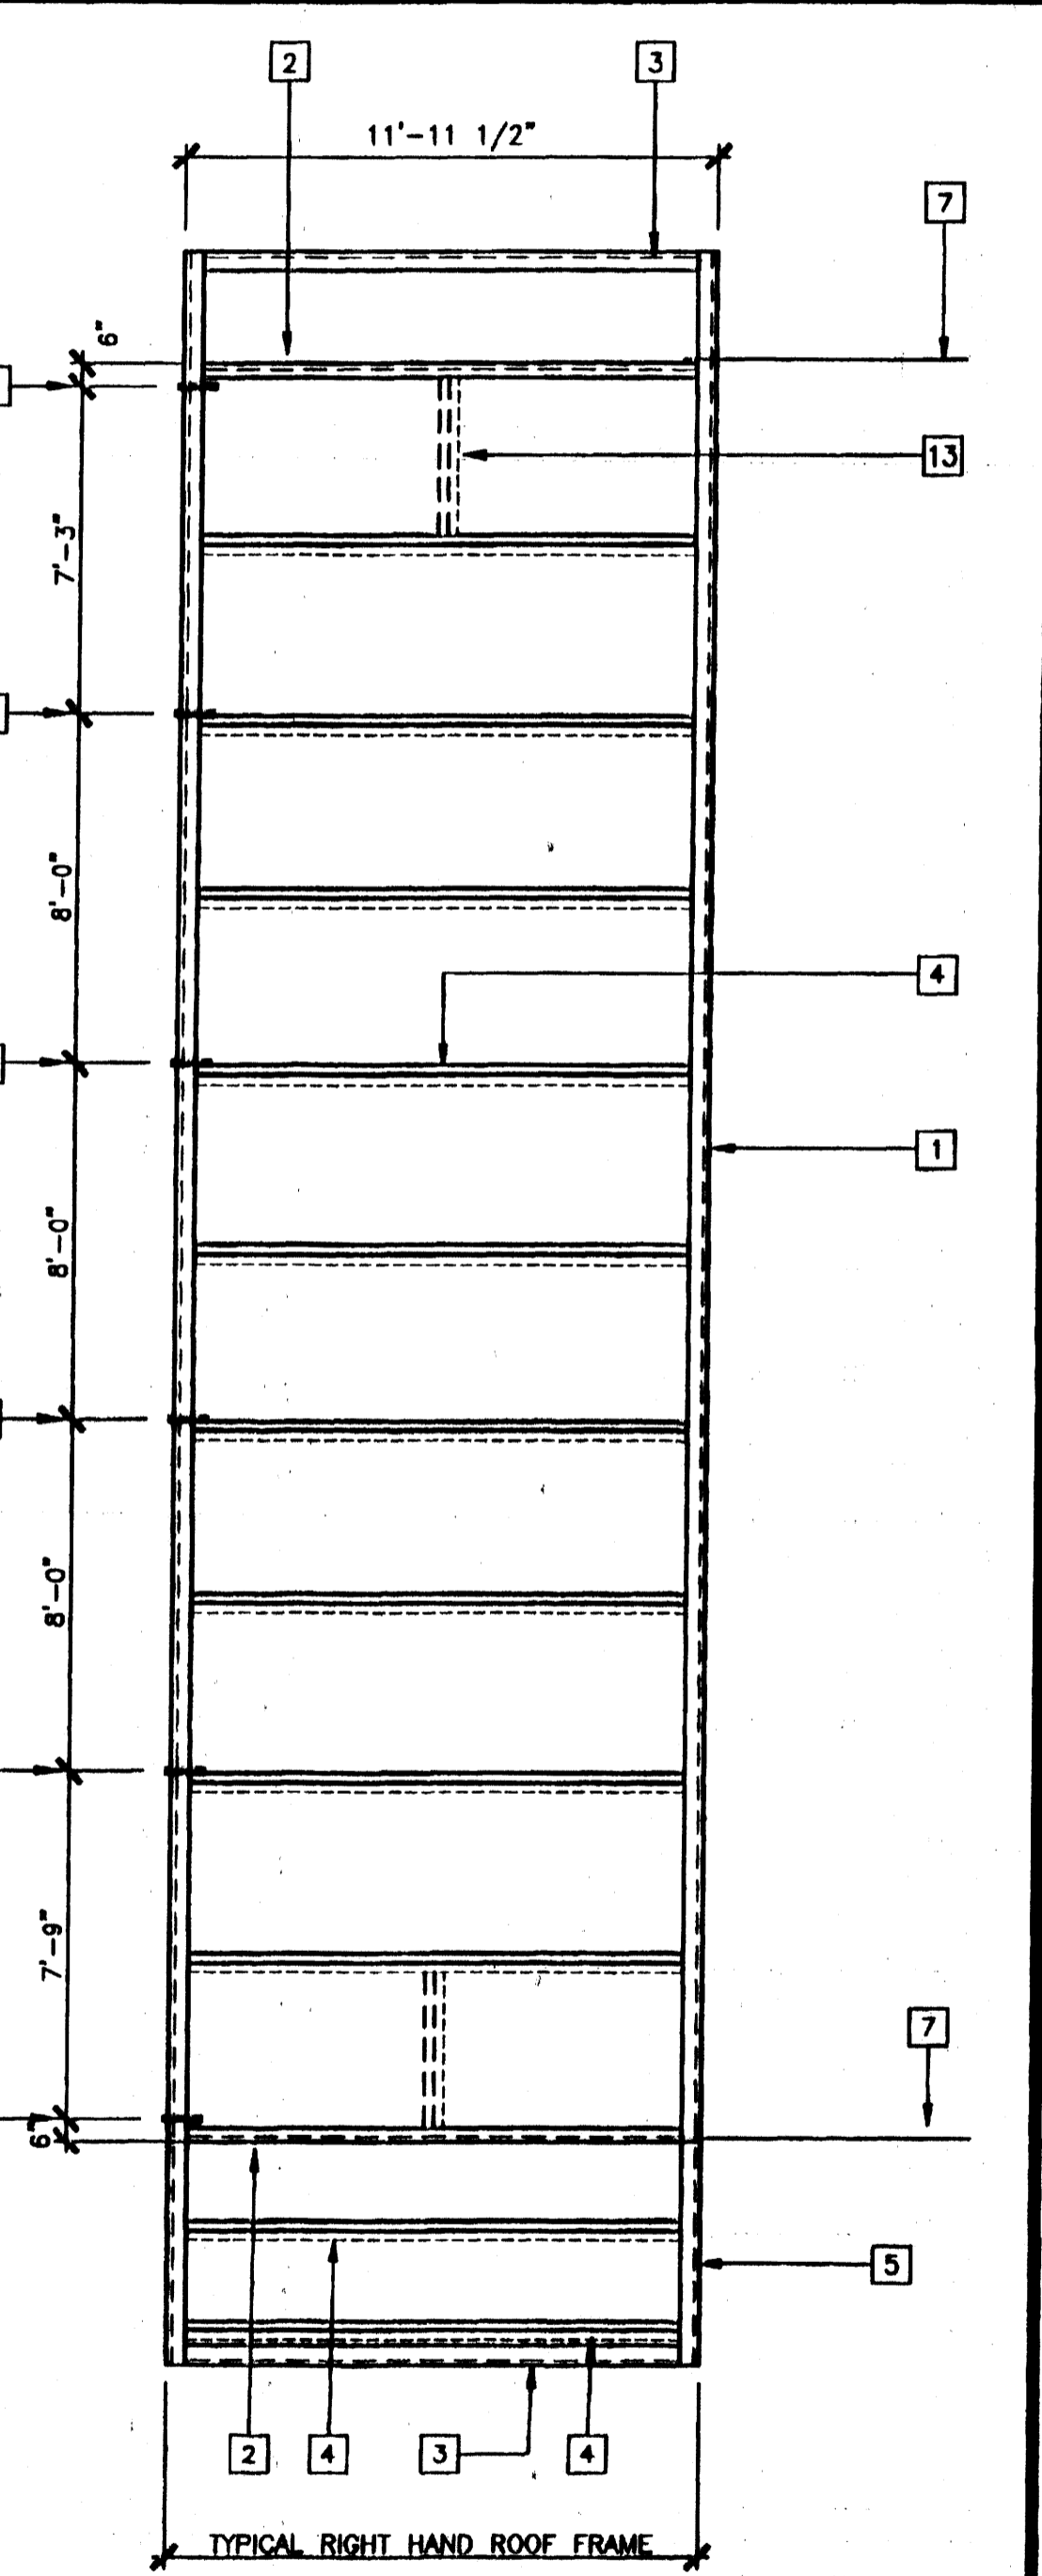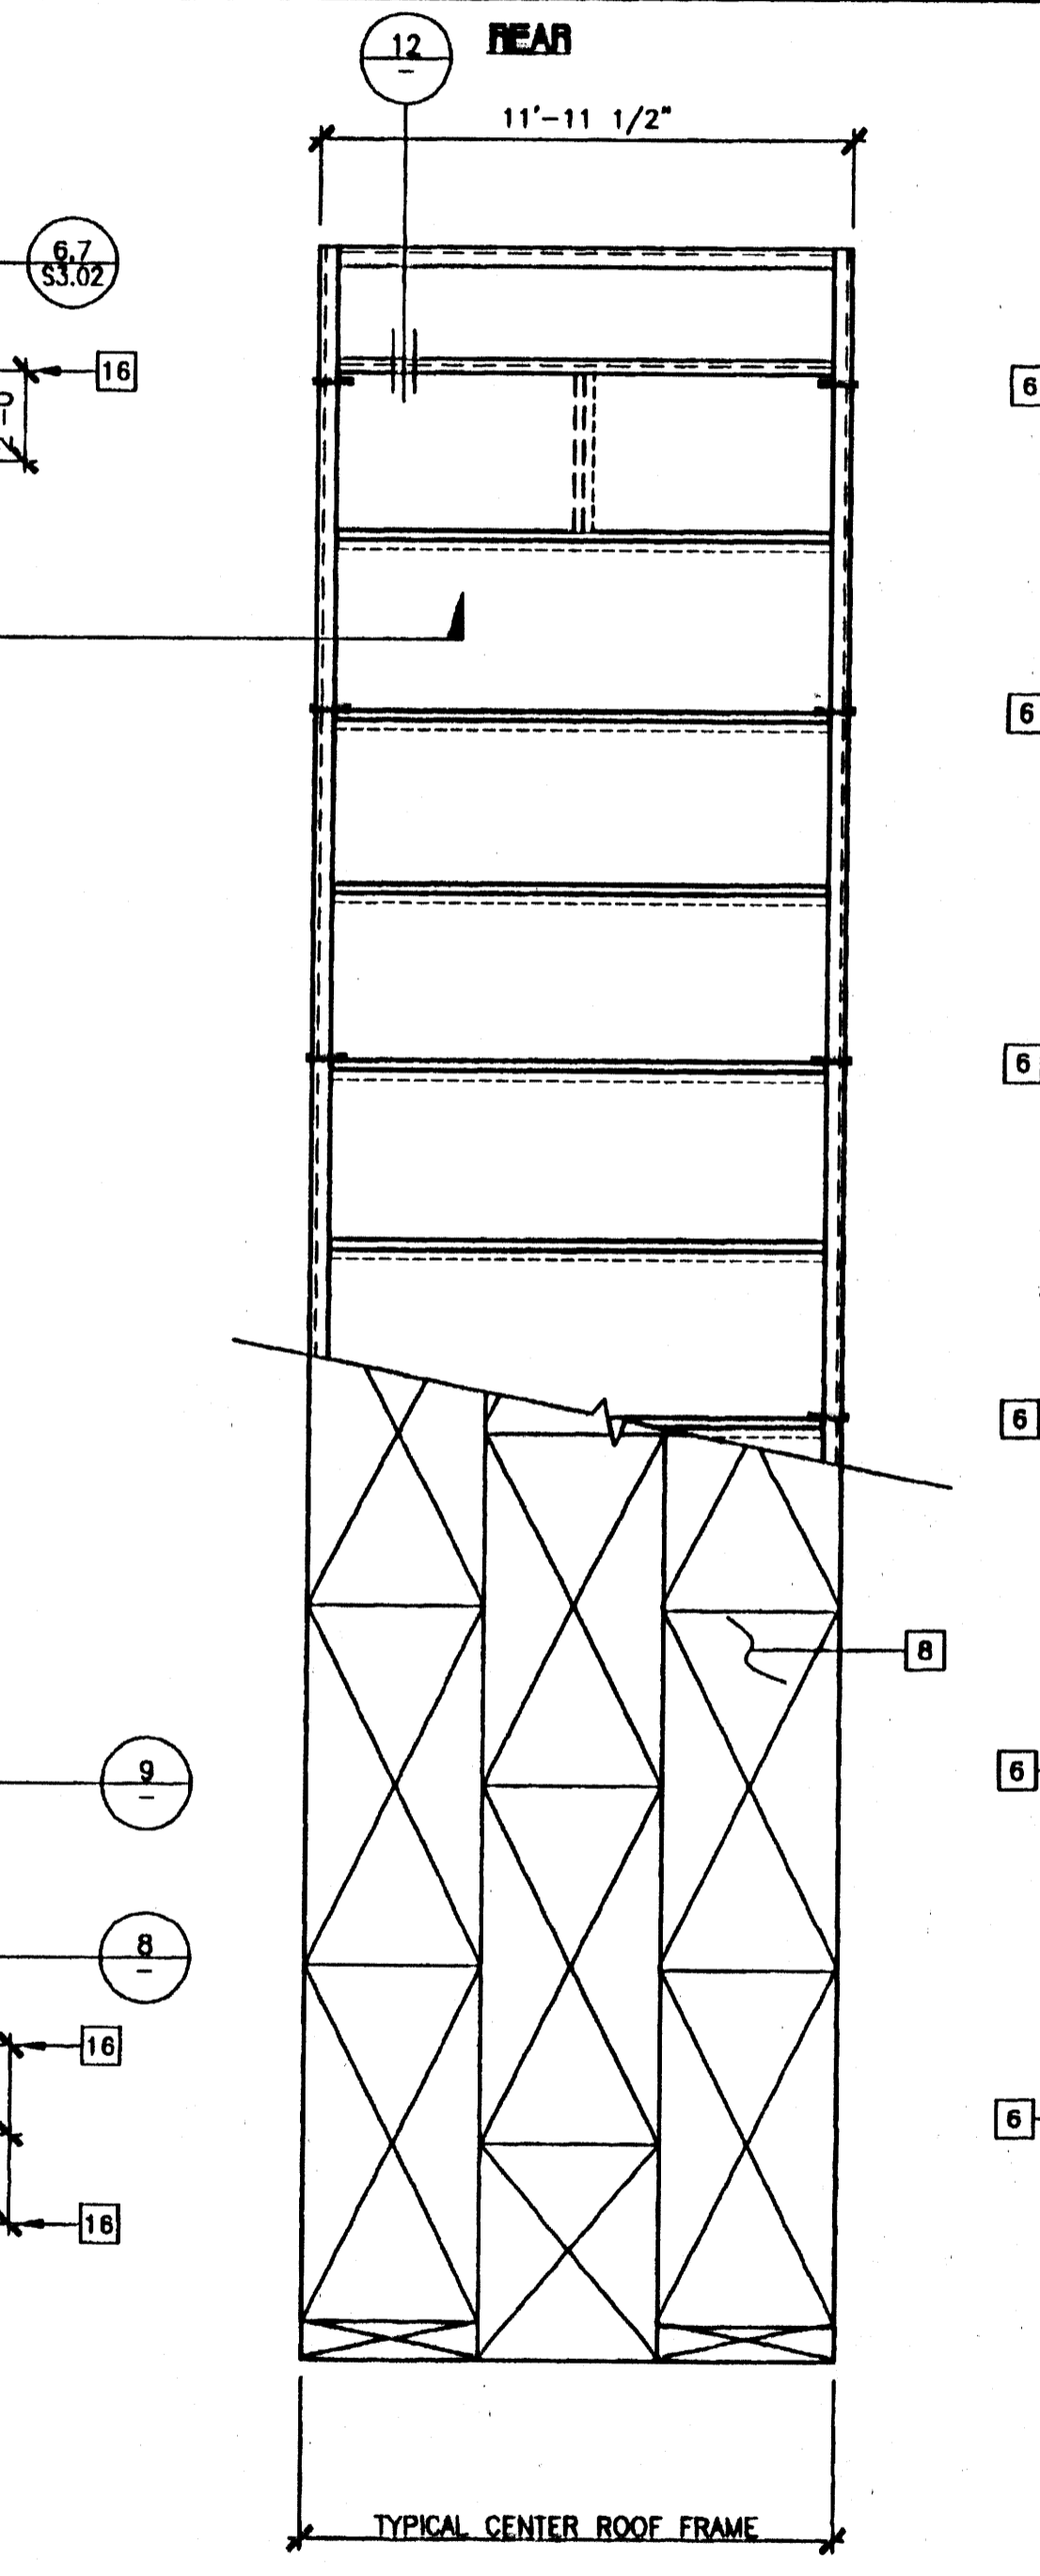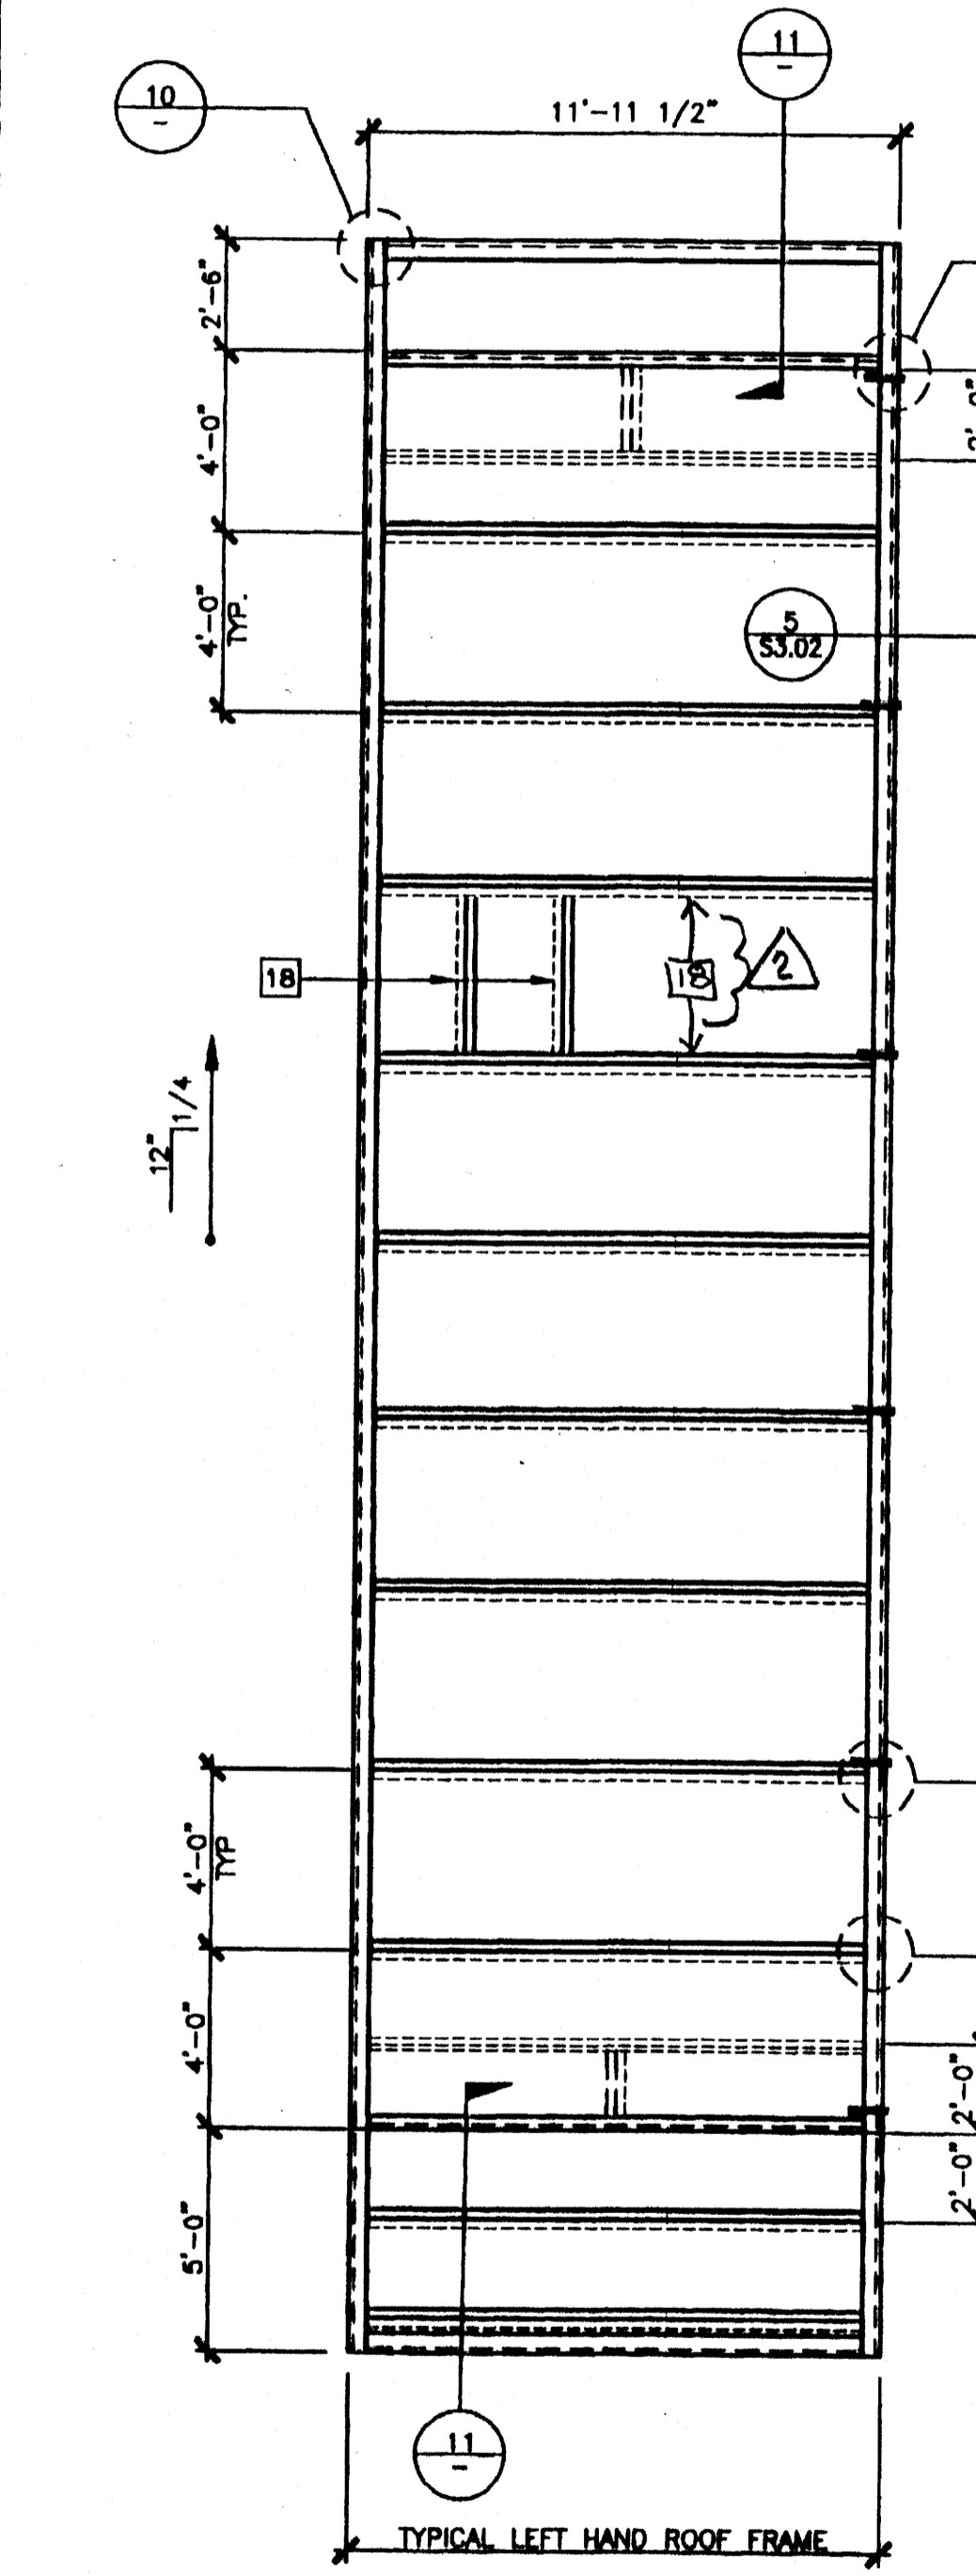

KEY NOTES

- OPTIONAL BEAM SPLICE LOCATIONS
- 10 GA BENT PLATE BACK UP
- 1/4" FULL DEPTH STIFFENER PLATE
- 1/2"x1/2"x16 GA ANGLE, TACK WELD TO HEADER AND ROOF BEAM
- PURLIN SIZE BLOCKING AT HEADER MIDSPAN FOR 80 MPH DESIGN WIND LOAD ONLY
- 3 1/4"x1" CHANNEL STIFFENER
- TUBE STEEL STIFFENER
- LOCATION OF ADDITIONAL PURLIN FOR BUILDINGS THAT EXCEED 2160 SF
- Z STIFFENER AT SOFFIT CLOSURE - 4/S2.01
- FRAMING FOR ROUGH OPENING OF OPTIONAL ROOF MOUNT HVAC, SPACING AND LOCATION WILL VARY - 18,19/A6.01 (RV)

TYPICAL LEFT HAND ROOF FRAME

TYPICAL CENTER ROOF FRAME

TYPICAL RIGHT HAND ROOF FRAME



PURLIN TO ROOF BEAM 8

ROOF PURLIN 4

ROOF FRAMING PLAN

26 GA MONO PITCH

SCALE: 1/4" = 1'-0"

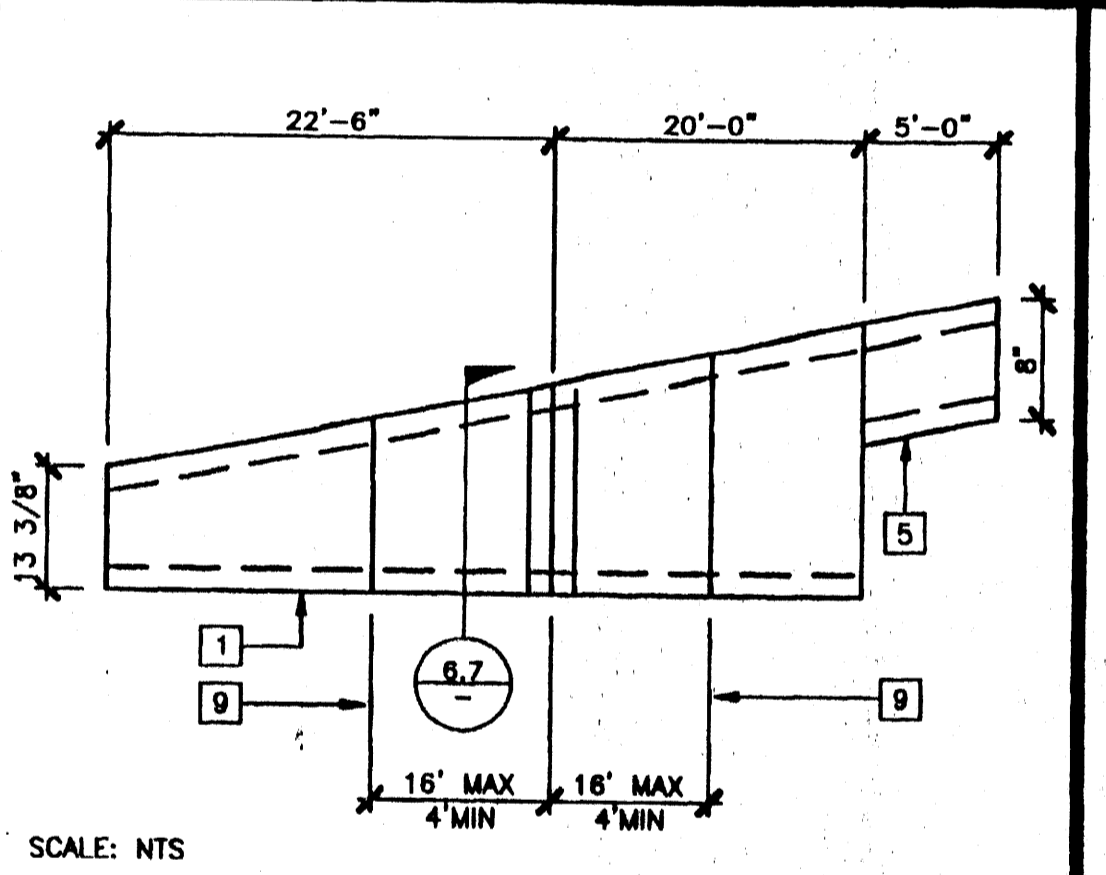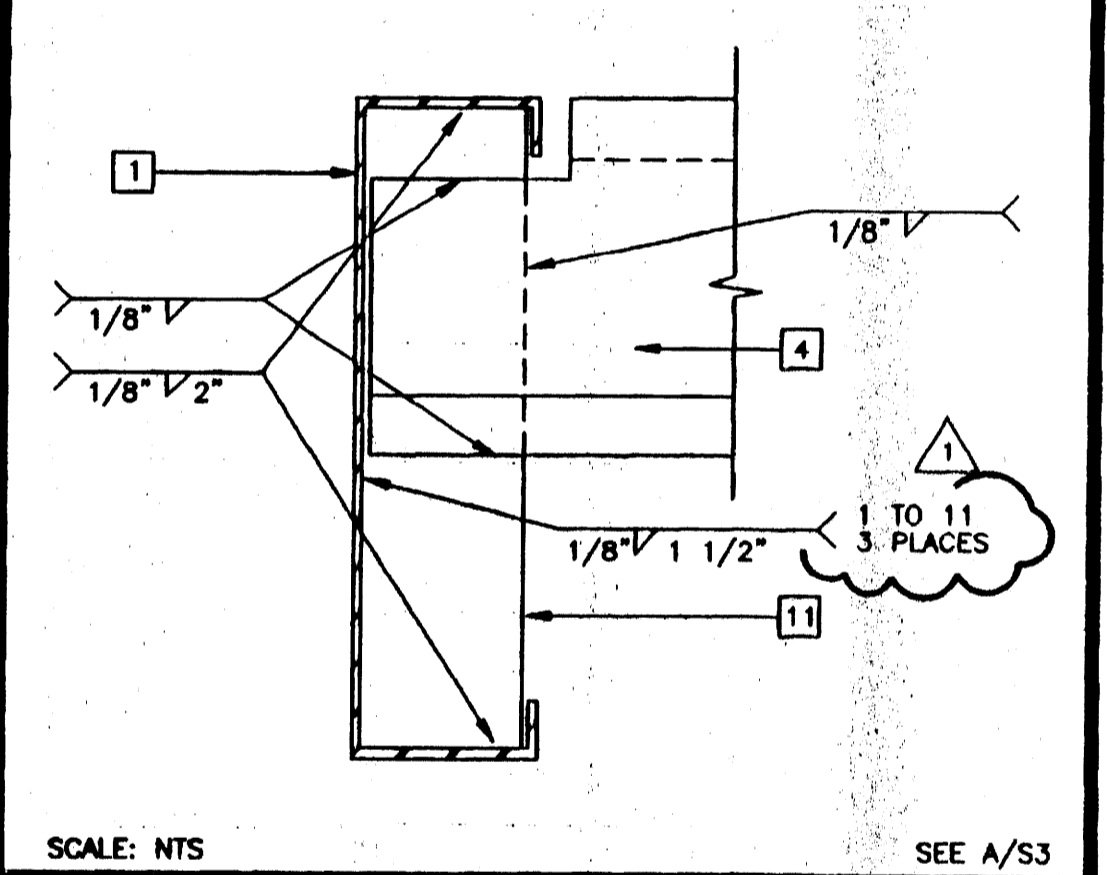



KEY NOTES

- OPTIONAL BEAM SPLICE LOCATIONS
- 10 GA BENT PLATE BACK UP
- 1/4" FULL DEPTH STIFFENER PLATE
- 1/2"x1/2"x16 GA ANGLE, TACK WELD TO HEADER AND ROOF BEAM
- PURLIN SIZE BLOCKING AT HEADER MIDSPAN FOR 80 MPH DESIGN WIND LOAD ONLY
- 3 1/4"x1" CHANNEL STIFFENER
- TUBE STEEL STIFFENER
- LOCATION OF ADDITIONAL PURLIN FOR BUILDINGS THAT EXCEED 2160 SF
- Z STIFFENER AT SOFFIT CLOSURE - 4/S2.01
- FRAMING FOR ROUGH OPENING OF OPTIONAL ROOF MOUNT HVAC, SPACING AND LOCATION WILL VARY - 18,19/A6.01 (RV)

PURLIN/STIFFENER TO ROOF BEAM 9

TAPERED ROOF BEAM SPLICE 5

TAPERED ROOF BEAM 1

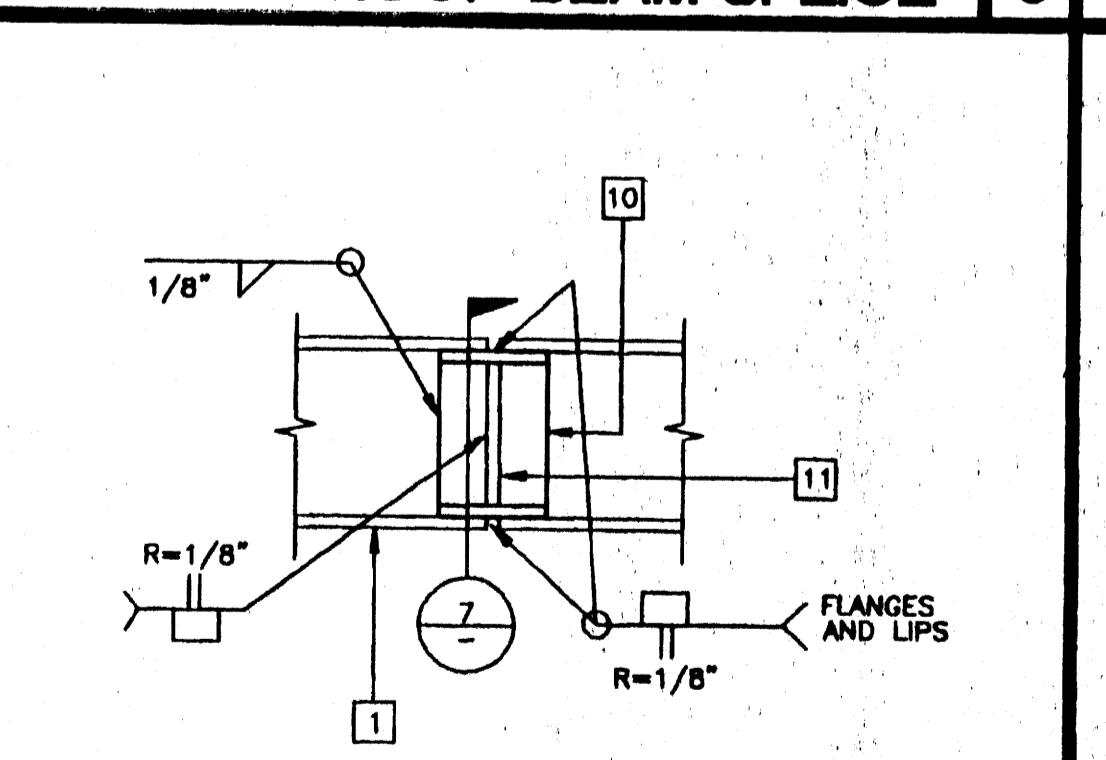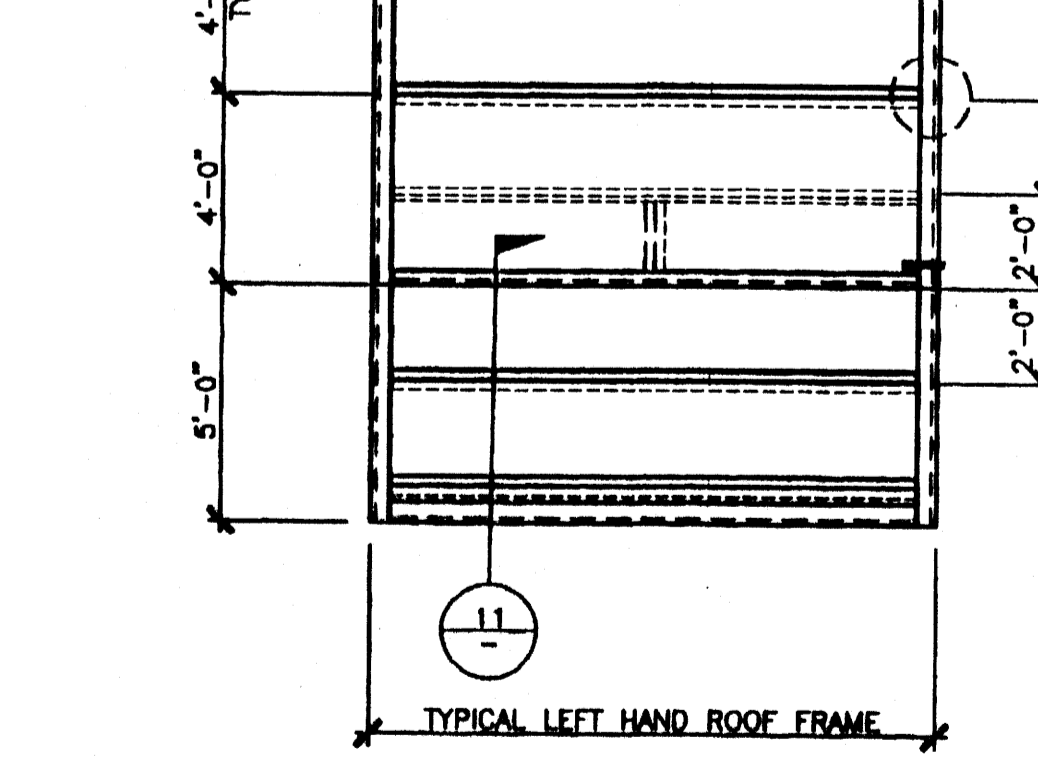

KEY NOTES

- OPTIONAL BEAM SPLICE LOCATIONS
- 10 GA BENT PLATE BACK UP
- 1/4" FULL DEPTH STIFFENER PLATE
- 1/2"x1/2"x16 GA ANGLE, TACK WELD TO HEADER AND ROOF BEAM
- PURLIN SIZE BLOCKING AT HEADER MIDSPAN FOR 80 MPH DESIGN WIND LOAD ONLY
- 3 1/4"x1" CHANNEL STIFFENER
- TUBE STEEL STIFFENER
- LOCATION OF ADDITIONAL PURLIN FOR BUILDINGS THAT EXCEED 2160 SF
- Z STIFFENER AT SOFFIT CLOSURE - 4/S2.01
- FRAMING FOR ROUGH OPENING OF OPTIONAL ROOF MOUNT HVAC, SPACING AND LOCATION WILL VARY - 18,19/A6.01 (RV)

PURLIN TO ROOF BEAM 10

BEAM SPLICE 6

ROOF HEADER 2

REVISIONS

SP	MODTECH ENGINEERING CHANGE	09/28/00
SP	ADDED REFERENCE NOTE	11/9/00

Electrical Engineer's Seal

Mechanical Engineer's Seal

Structural Engineer's Seal




Architect's Seal

IDENTIFICATION STAMP
DIV. OF THE STATE ARCHITECT
OFFICE OF REGULATION SERVICES
PC-04
101268
DATE: SEP 07 1999
REVISED NOV 09 2000

MODTECH INC.
2830 BARRETT AVENUE
PERRIS, CALIF. 92572
PH (909) 943-4014
FAX (909) 940-0427

PROJECT NUMBER: 4373-
COLTON U.S.D.

© MODTECH, INC. 2002
DRAWN BY: KK
DATE: 11/19/02
CHECKED BY: STKP-67
DATE: 4/12-12 4
MODTECH Index No.

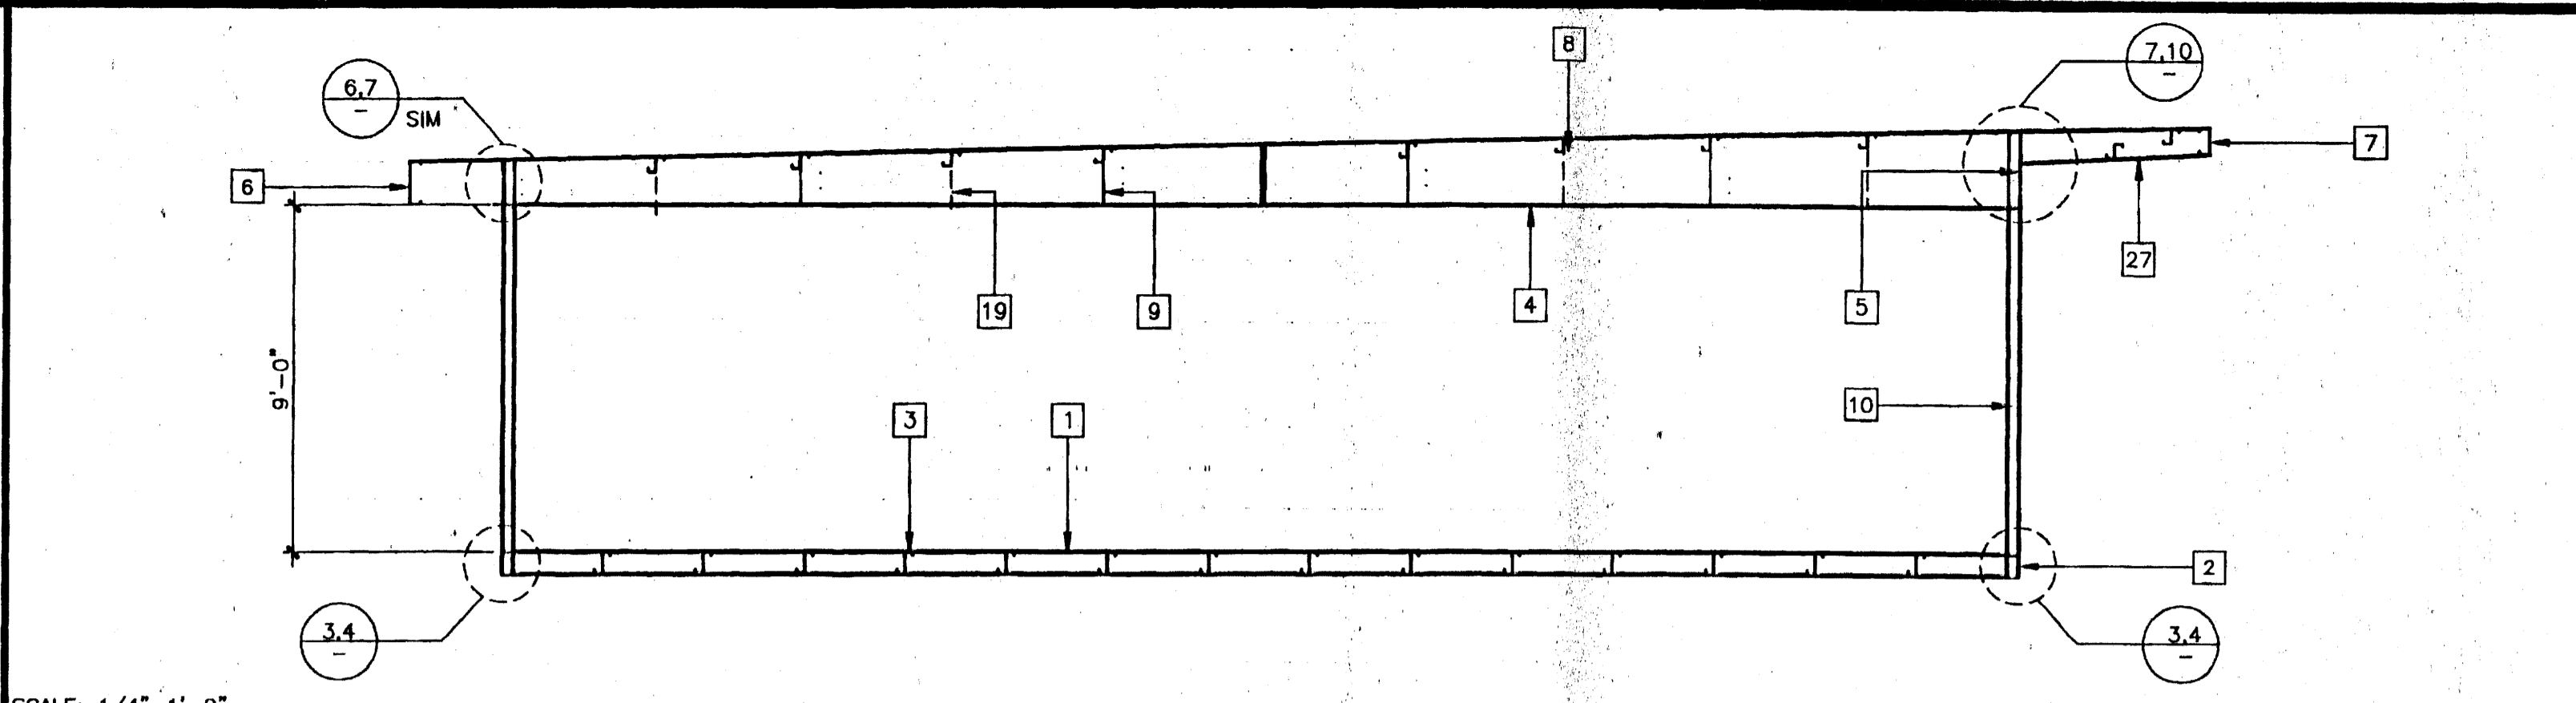
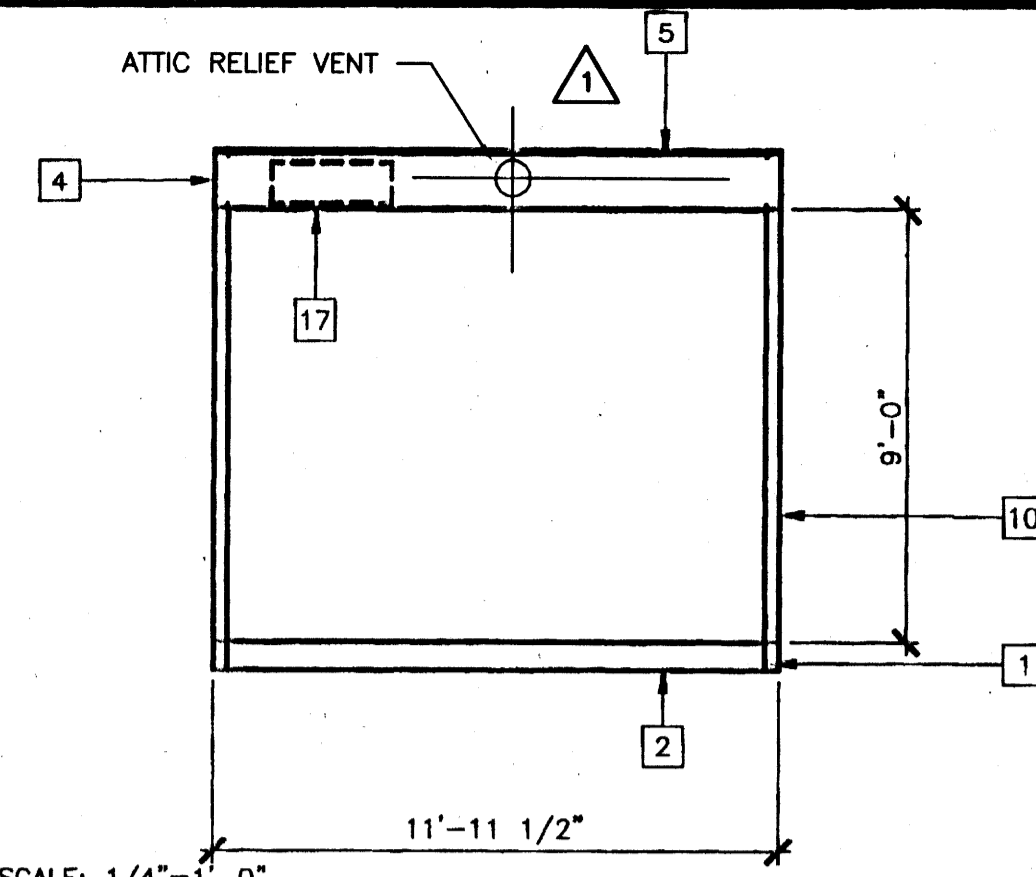
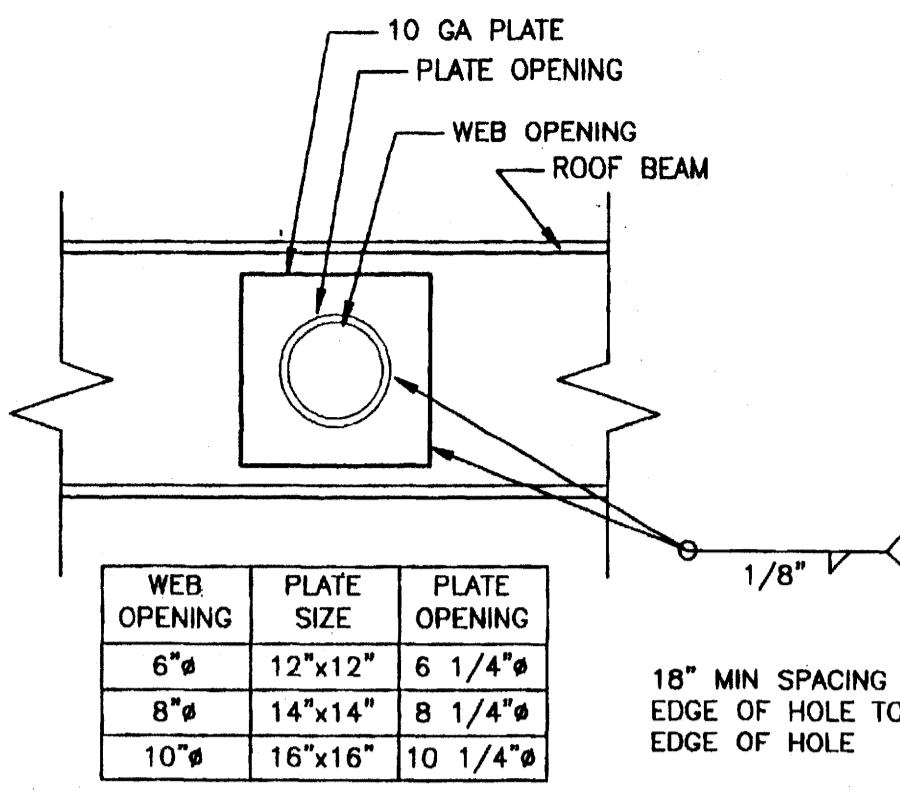


- ### KEY NOTES
- FLOOR BEAM - 1/S1
 - FLOOR HEADER - 1/S1
 - FLOOR JOIST - 2/S1
 - TAPERED ROOF BEAM - 1/S2.02
 - ROOF HEADER - 2/S2.02
 - ROOF FASCIA AT 2'-6" OVERHANG - 3/S2.02
 - ROOF FASCIA AT 5'-0" OVERHANG - 3/S2.02
 - ROOF PURLIN - 4/S2.02
 - 1/4" FULL DEPTH STIFFENER PLATE AT 8'-0" OC TYPICAL ALIGN WITH PURLIN - 9/S2.02
 - TUBE STEEL COLUMN, SEE TABLE BELOW - 8/S3.02
 - 3 1/2"x3 1/2"x1/4" TUBE STEEL STUB
 - (1) 3"x3"x10 GA TUBE STEEL BACK UP TUBE OR (4) 10 GA BACK UP PLATES
 - 3 1/2"x3 1/2"x1/4" ANGLE STIFFENER
 - BACK-UP PLATE - 10 GA MIN
 - 1/4" BASE PLATE - INSERT FLUSH WITH STIFFENER TUBE
 - HVAC DUCT OPENING - 12/S2.02
 - NOT USED
 - 1/4" FULL DEPTH STIFFENER PLATE AT 4'-0" OC AT EXTERIOR SIDEWALLS ONLY FOR 80 MPH DESIGN WIND LOAD ONLY
 - HAND HOLE AT BOLT LOCATION
 - 5/8" MB A307 AT MODULE CONNECTION JOINT - SEE FLOOR/ROOF FRAMING PLANS
 - FLOOR SHEATHING
 - MODULE JOINT
 - NOT USED
 - 3 1/2"x4 1/2"x1/4" PLATE UNDER BEAM FLANGE
 - STEEL ANGLE WELD TAB
 - 8"x3 1/2"x1/4 GA OVERHANG BEAM - 3/S2.02

OPTIONAL BEAM PENETRATION 11

SECTION AT END WALL B

SECTION AT SIDE WALL A

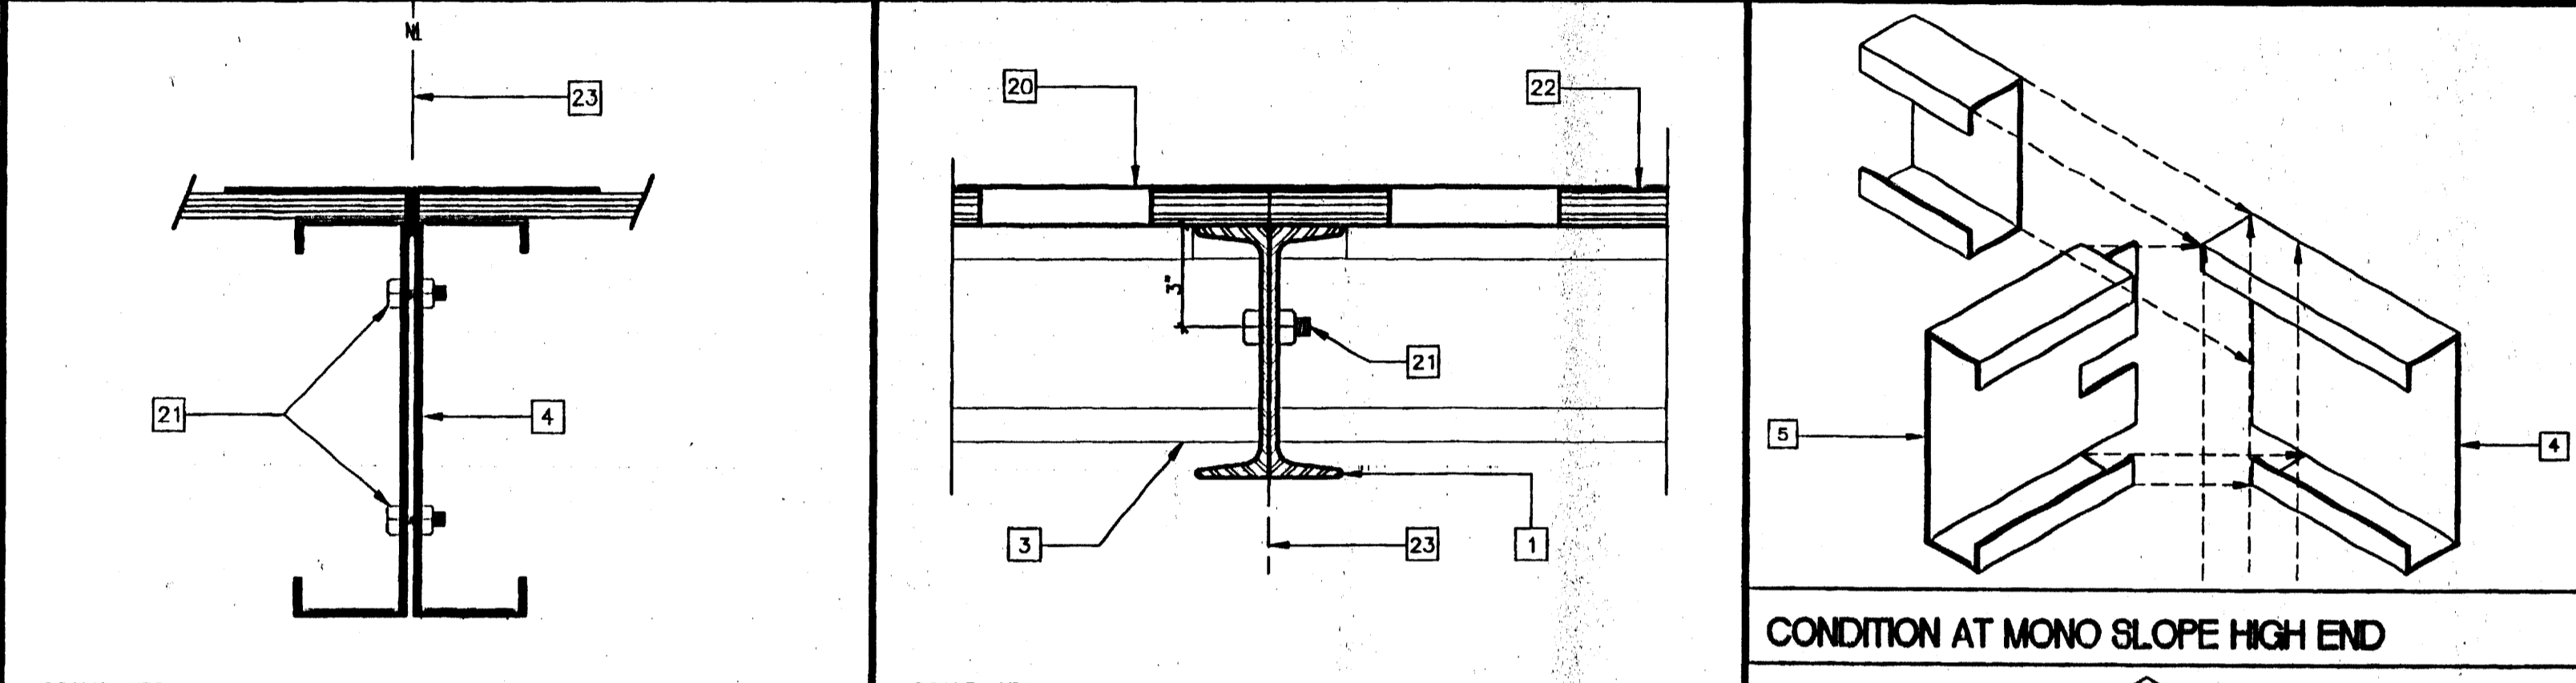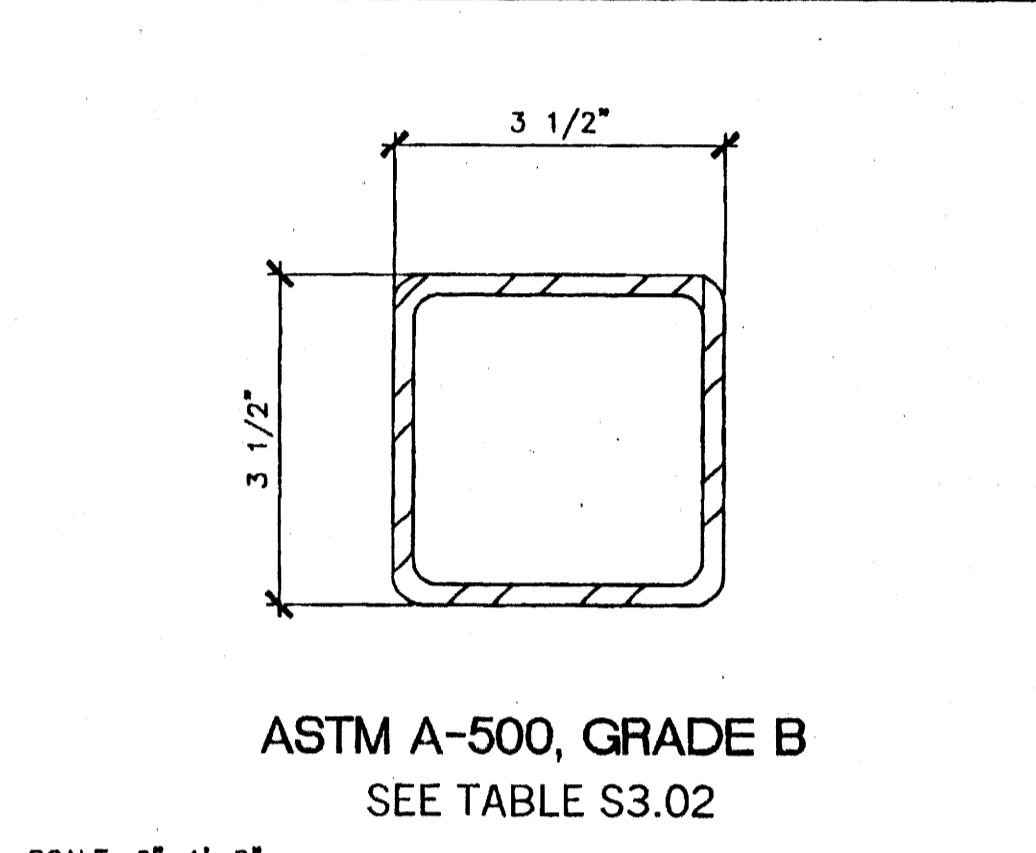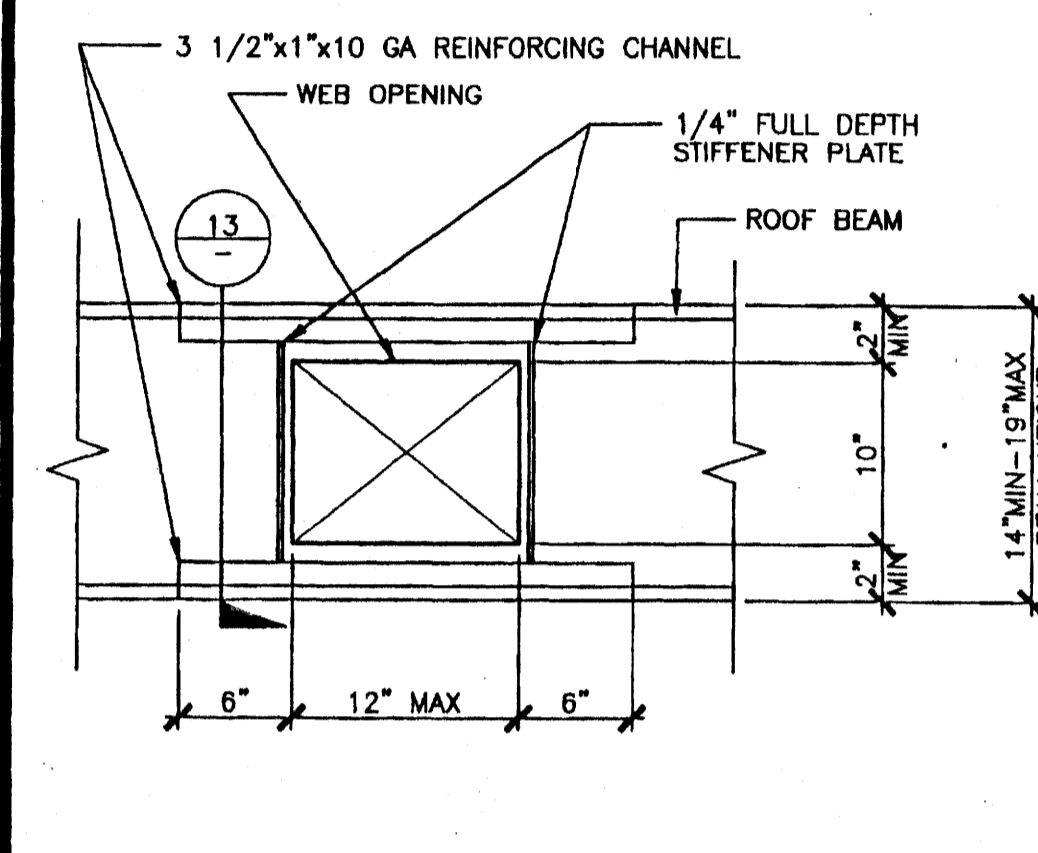






OPTIONAL BEAM PENETRATION 11

TUBE STEEL COLUMN/STIFFENER 8

MODULE CONNECTION AT ROOF 5

MODULE CONNECTION AT FLOOR 2

CONDITION AT MONO SLOPE HIGH END

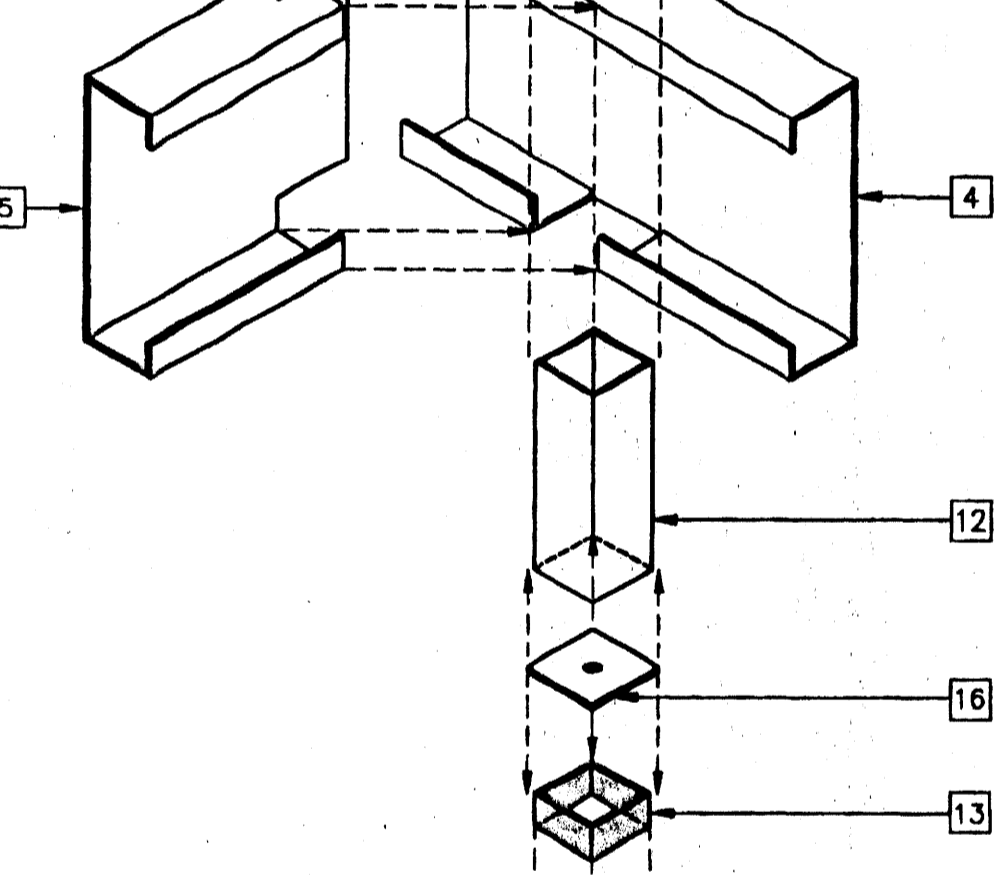
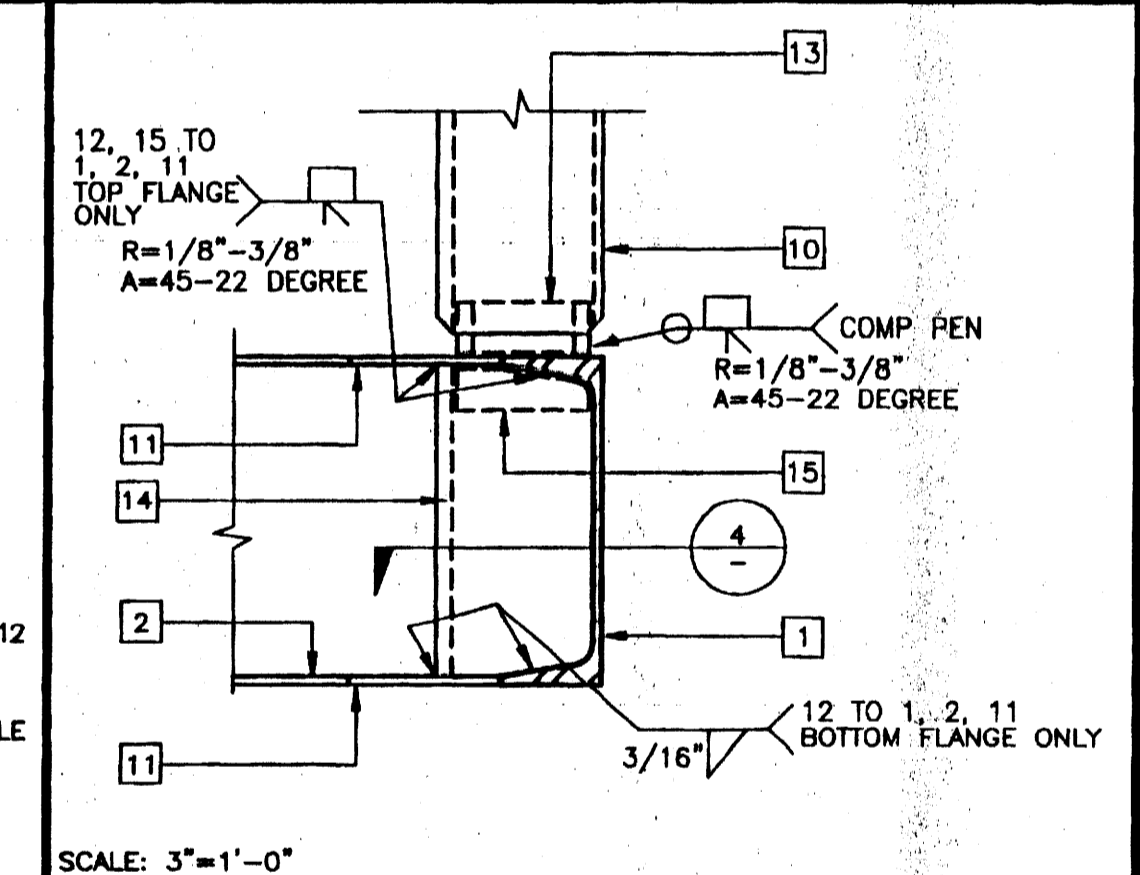
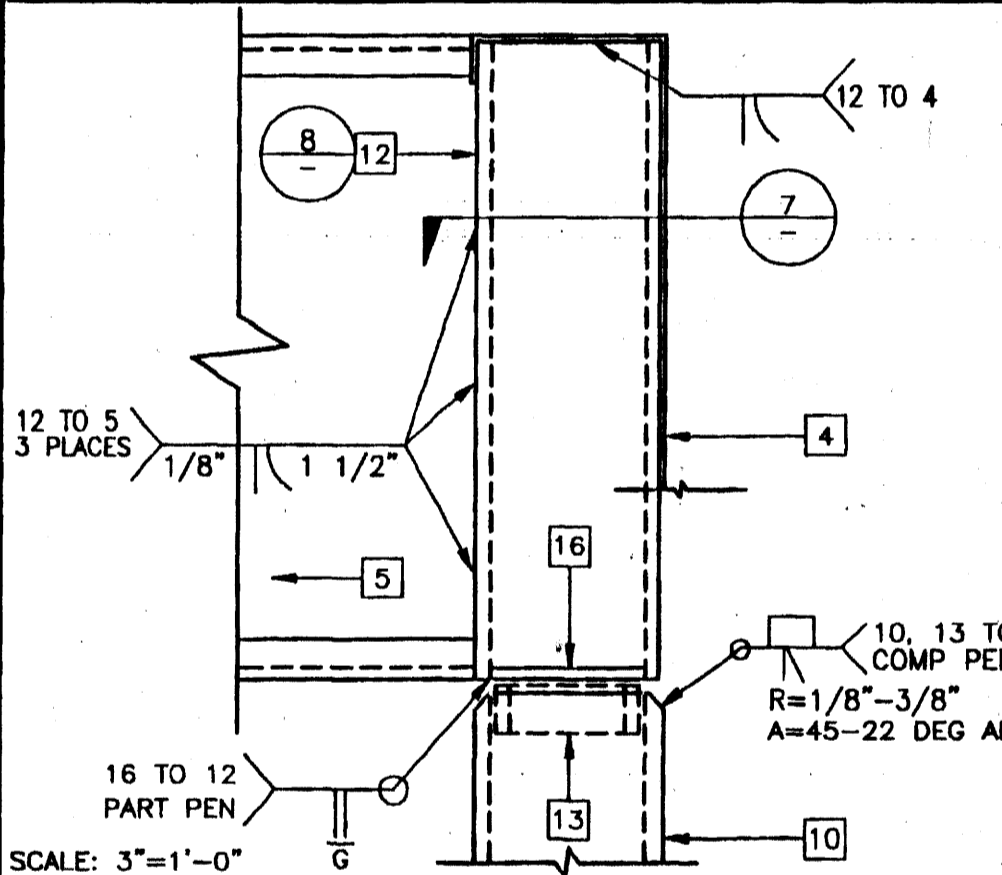
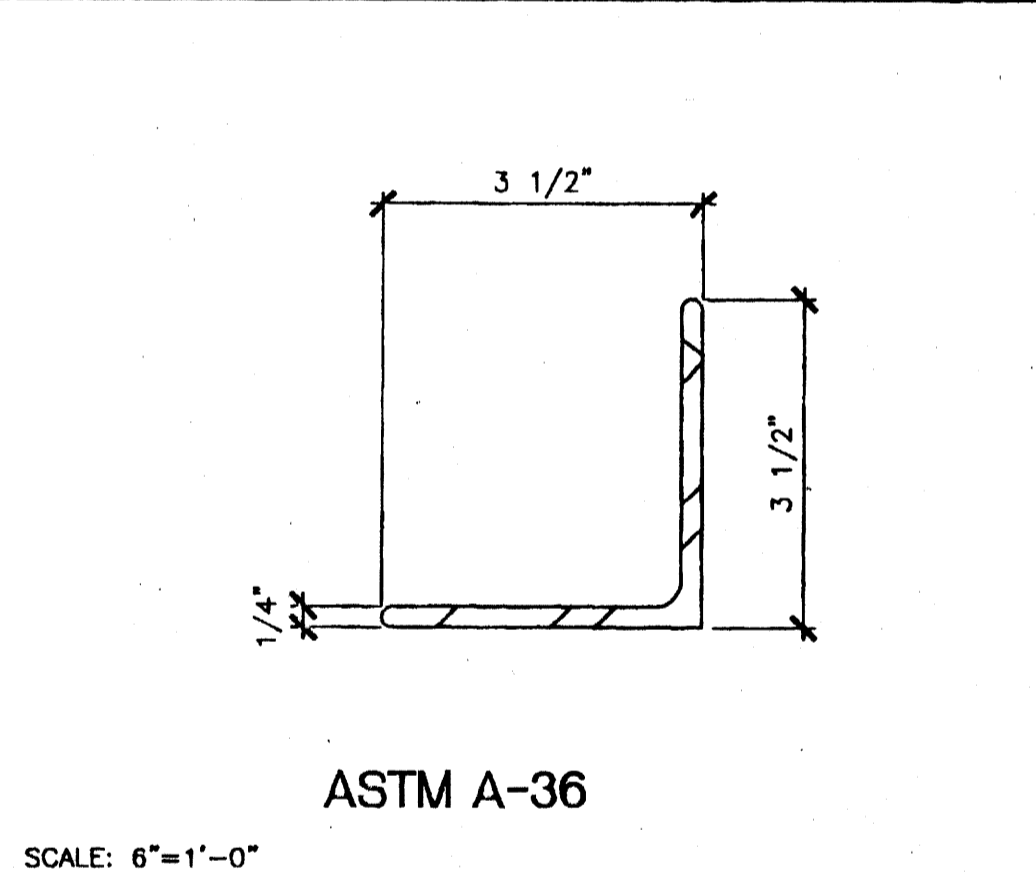
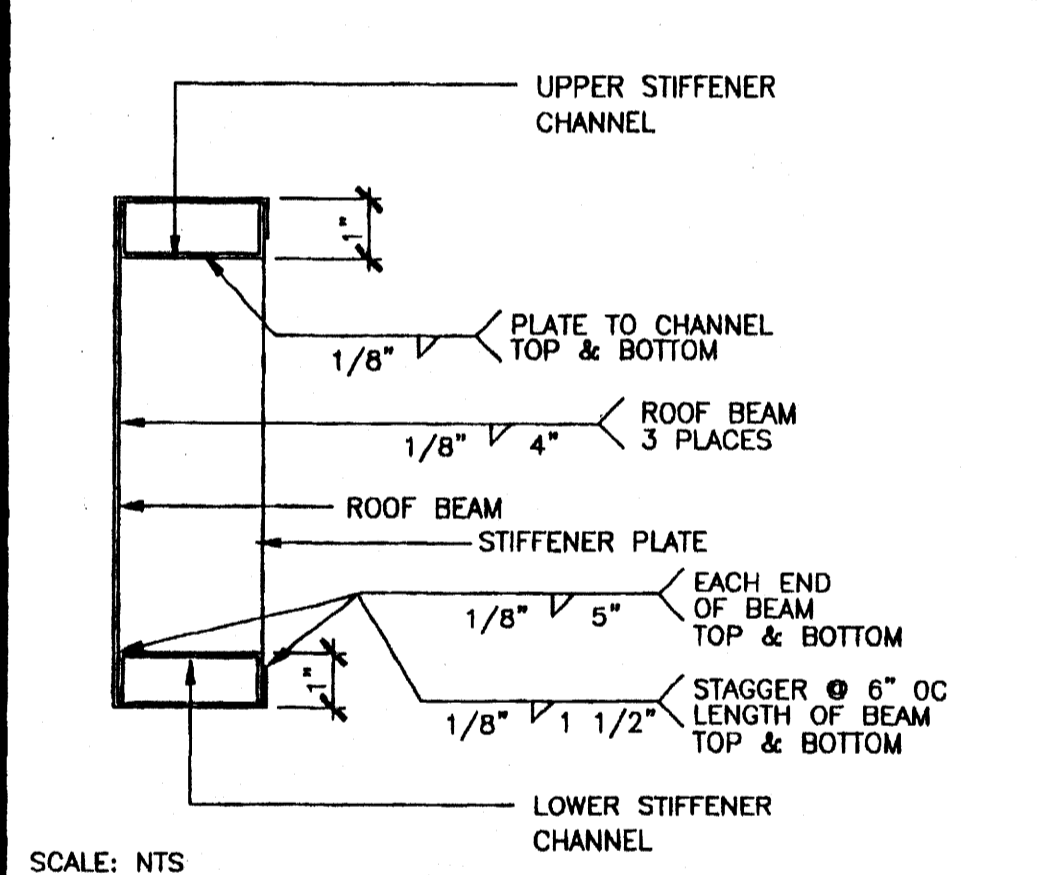


PENETRATION REINFORCEMENT 12

STIFFENER ANGLE 9

COLUMN AT ROOF 6

COLUMN AT FLOOR 3

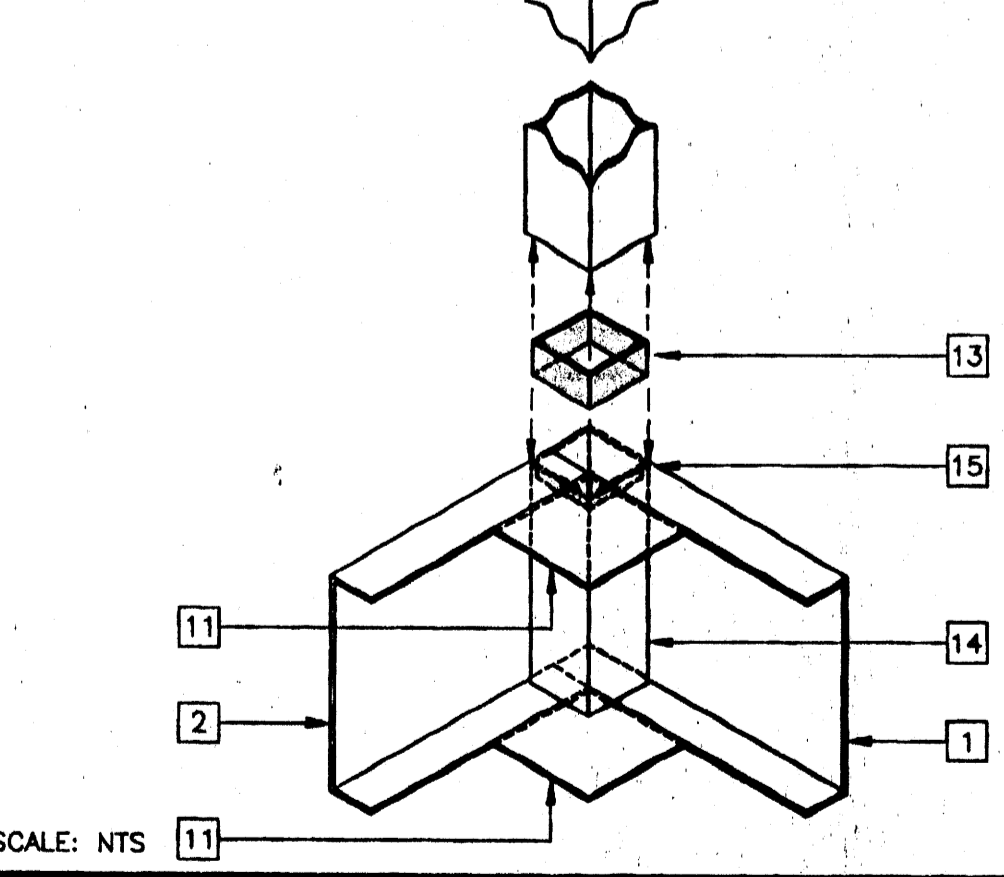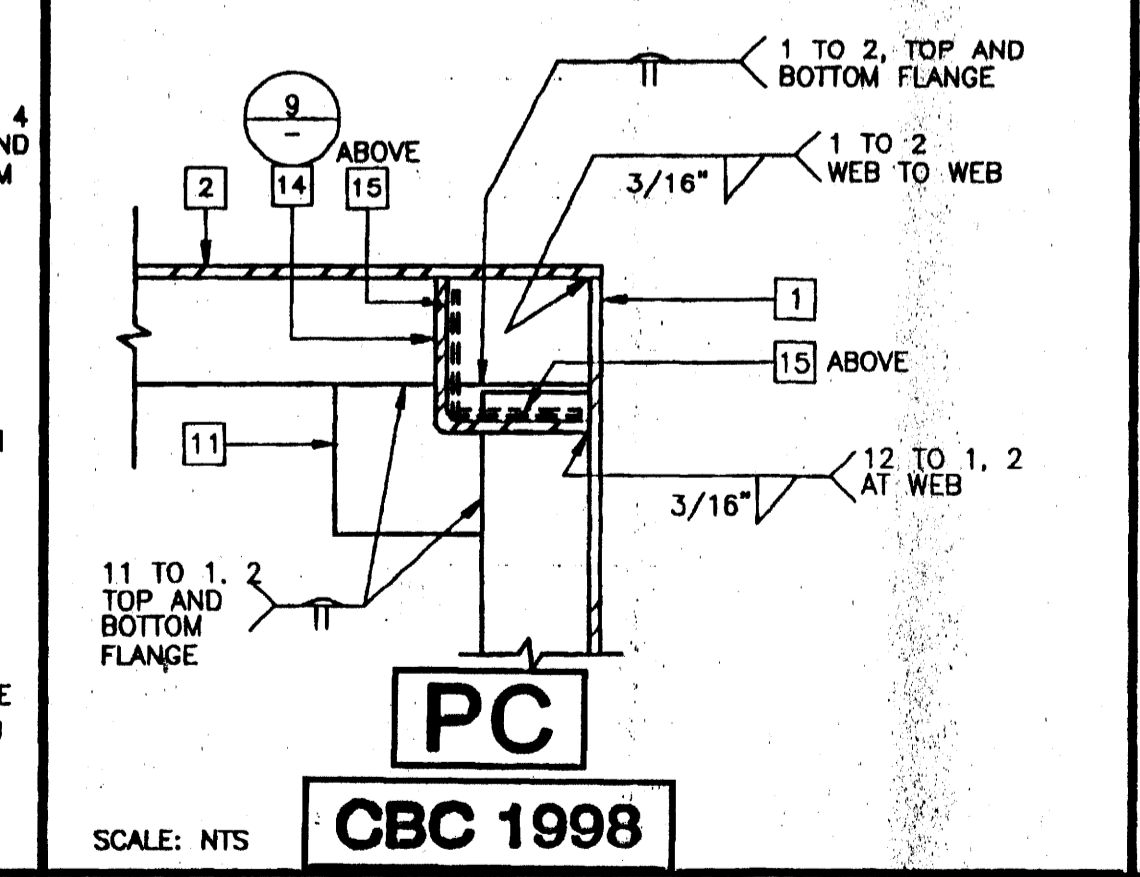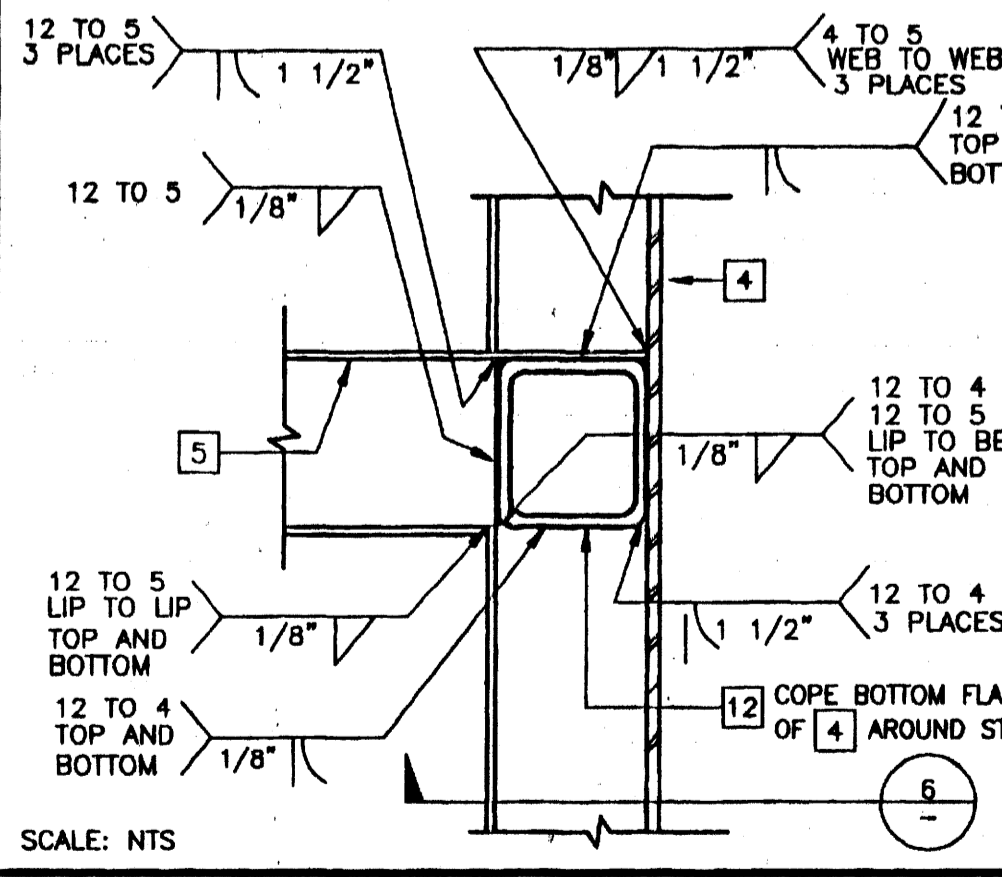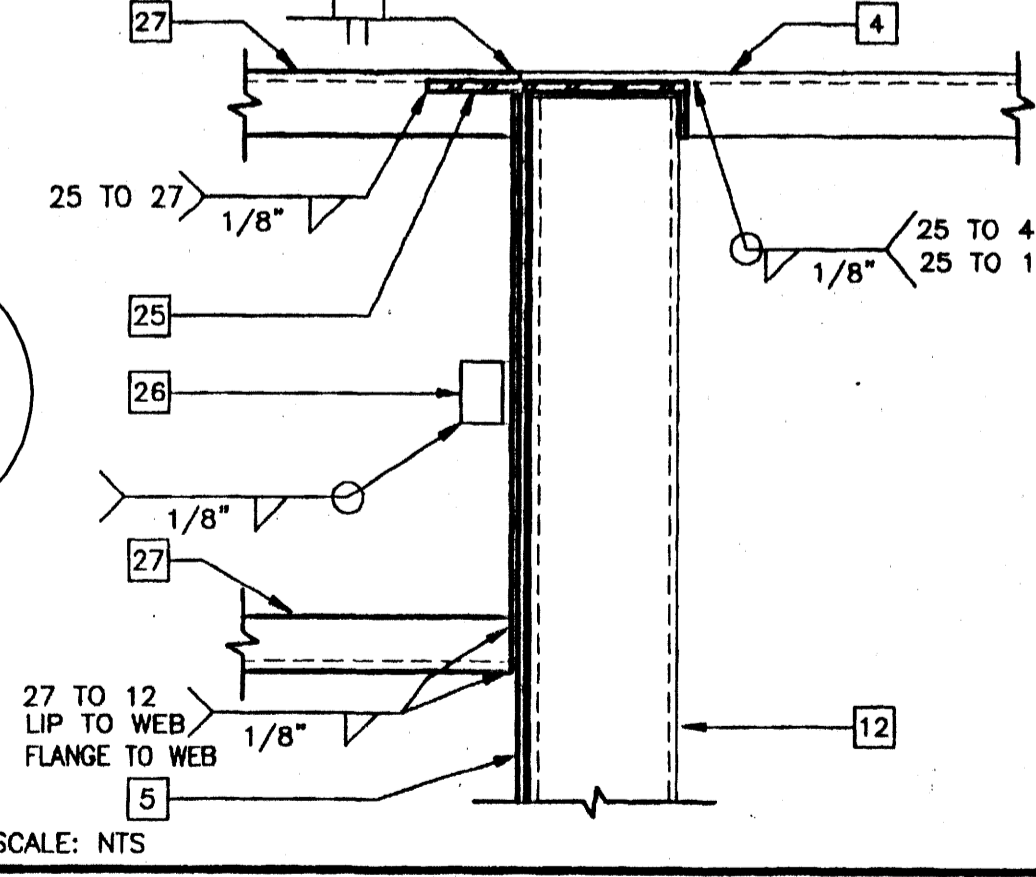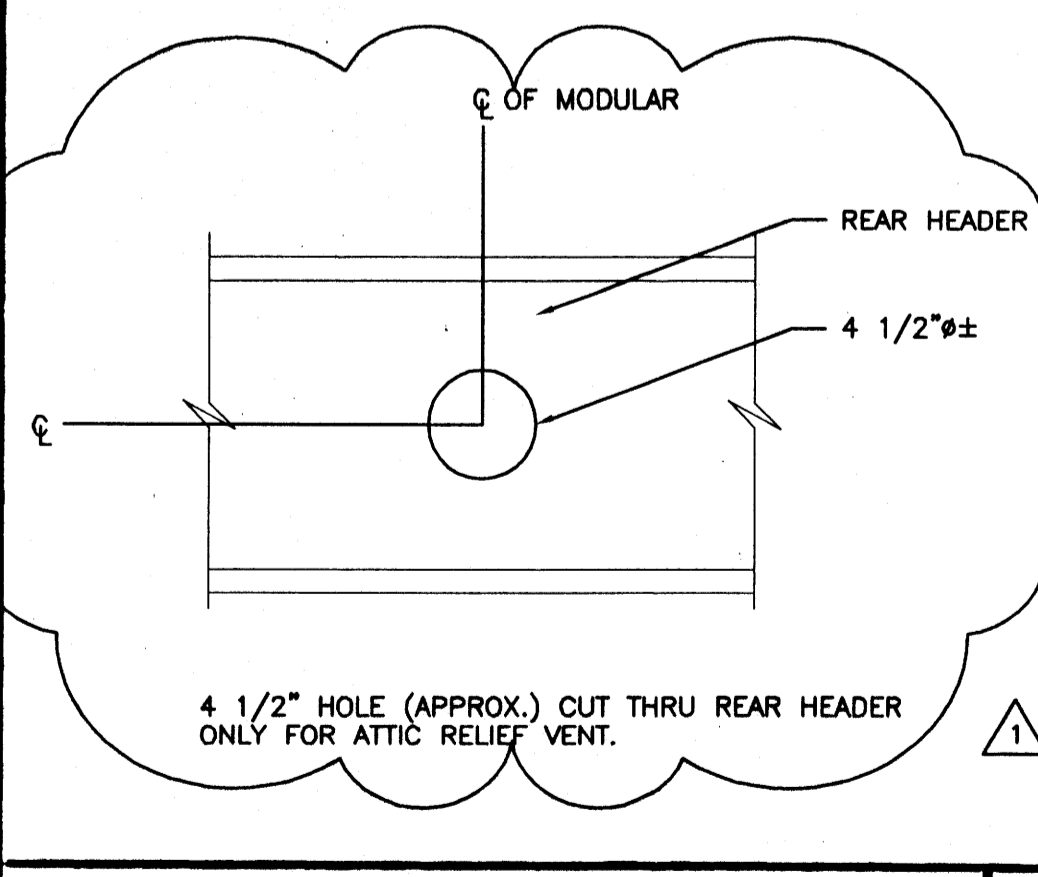

ATTIC RELIEF VENT 1

OVERHANG AT ROOF BEAM 10

STIFFENER AT ROOF 7

STIFFENER AT FLOOR 4

COLUMN AT FLOOR AND ROOF 1

COLUMN SIZE TABLE

DESIGN WIND LOAD	COLUMN SIZE
70 MPH	3 1/2"x3 1/2"x1/4"
80 MPH	3 1/2"x3 1/2"x5/16"

REVISIONS

NO.	DESCRIPTION	DATE
1	ADDED ATTIC RELIEF VENT	11/19/02
2		
3		
4		

Electrical Engineer's Seal
Mechanical Engineer's Seal
Structural Engineer's Seal
Architect's Seal

IDENTIFICATION STAMP
DIV. OF THE STATE ARCHITECT
OFFICE OF REGULATION SERVICES
PC-04
101268
AC: FLS SS
DATE: SEP 07 1999




MODTECH INC.
2830 BARRETT AVENUE
PERRIS, CALIF. 92572
PH (909) 943-4014
FAX (909) 940-0427

PROJECT NUMBER: 4373-M, 4378-M, 4384, 4438 © MODTECH, INC. 2002
4474
















DRAWN BY: KK
DATE: 11/19/02
CHECKED BY: STKP-67
DATE: 10/12-124
MODTECH Index No.
S3.02

STRUCTURAL FRAMING 26 GA MONO PITCH S3.02

FILE PATH: 2440-S3.02.DWG PROJECT NO. 4373 PC-04-101268

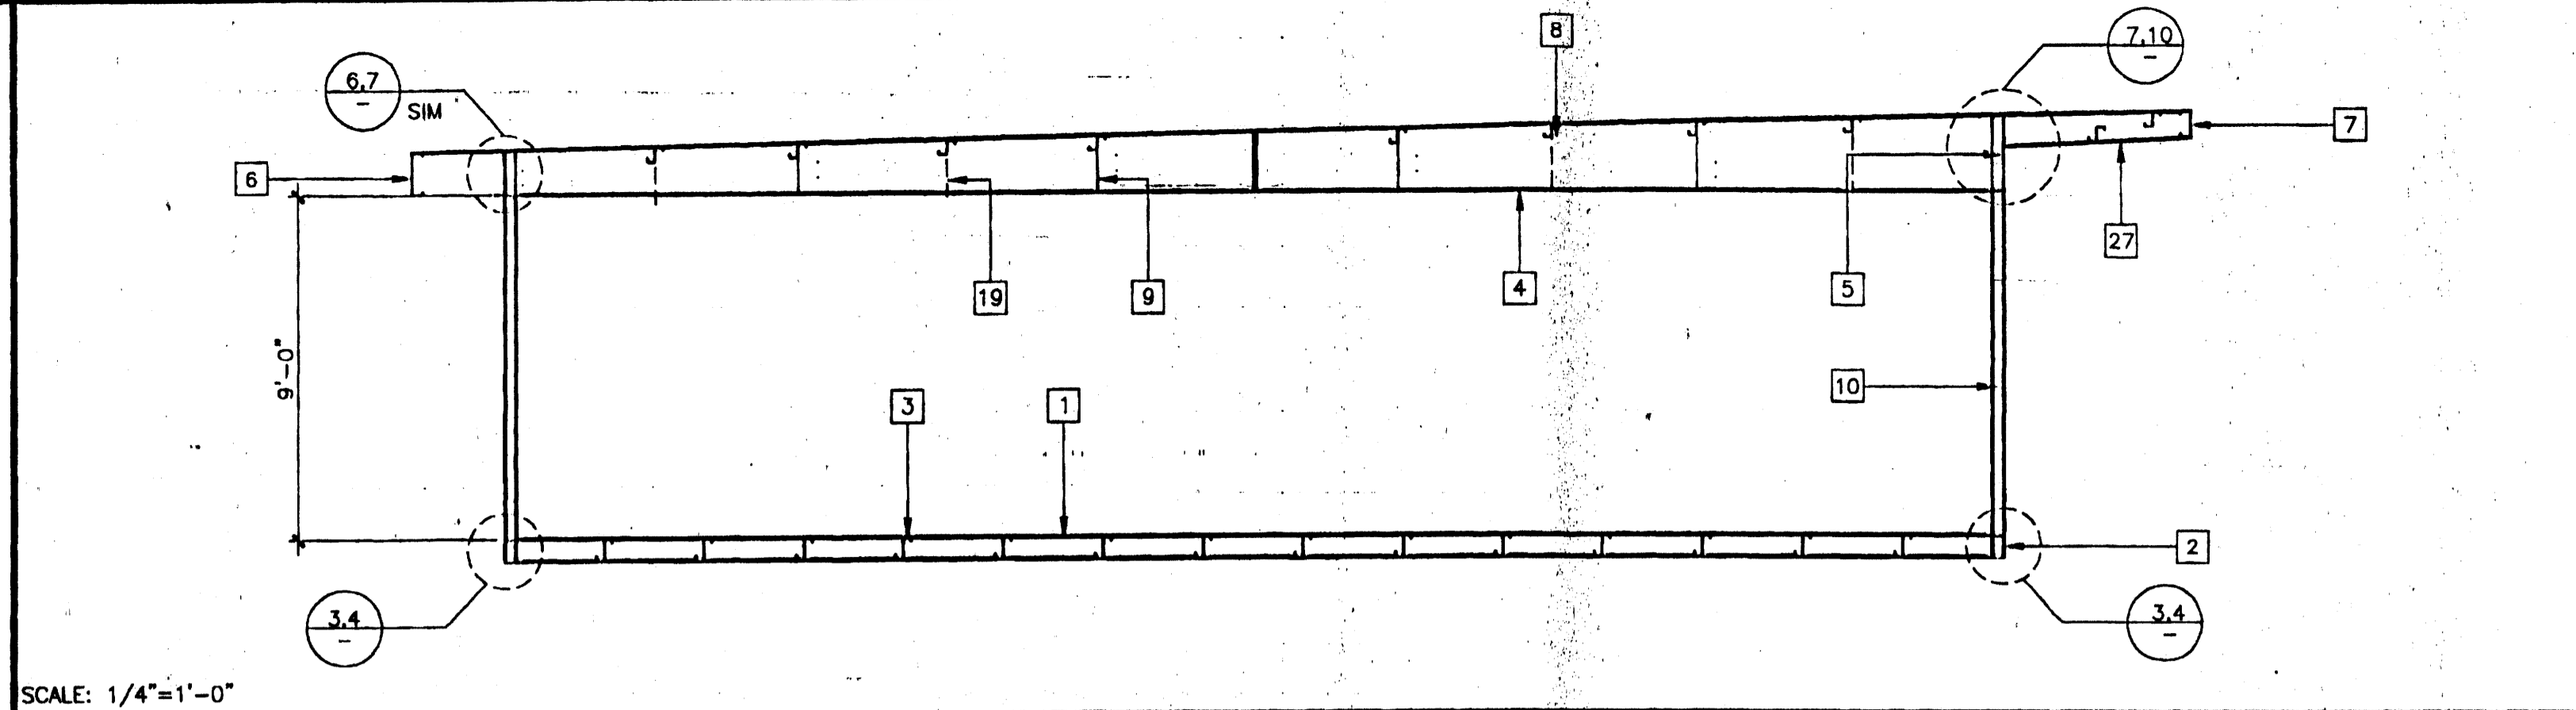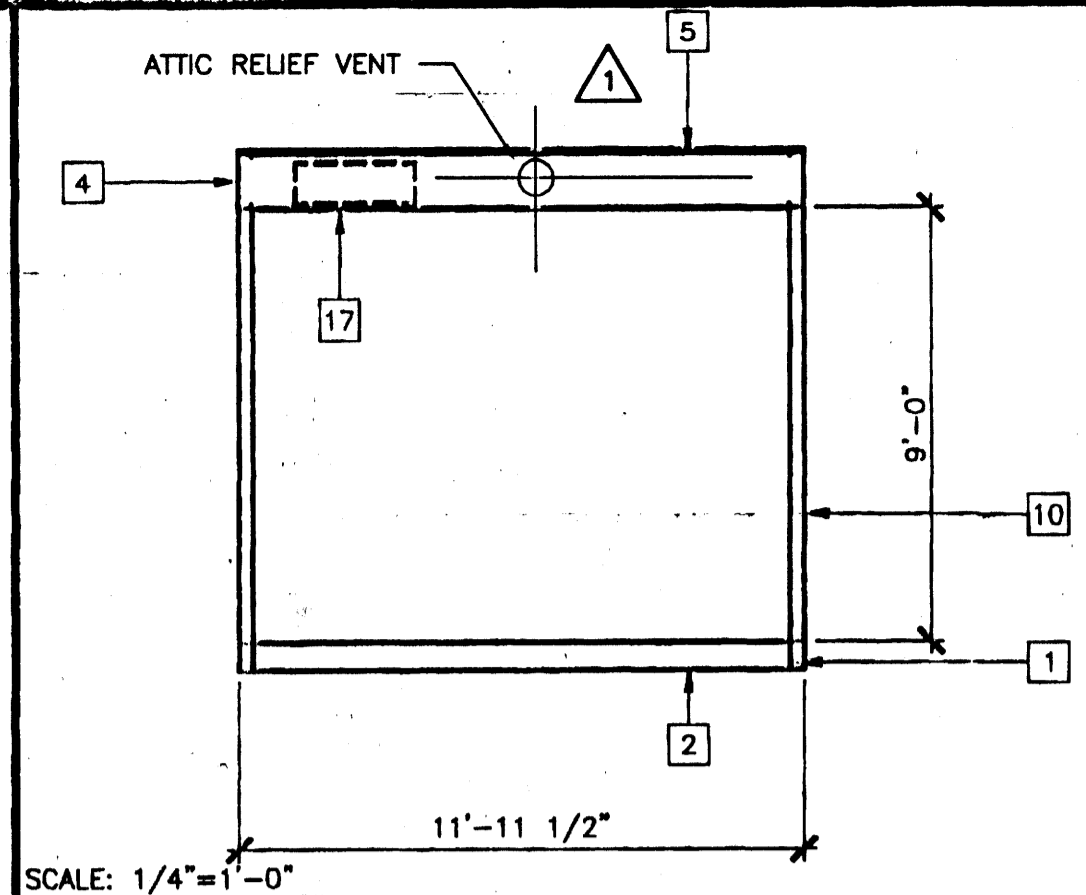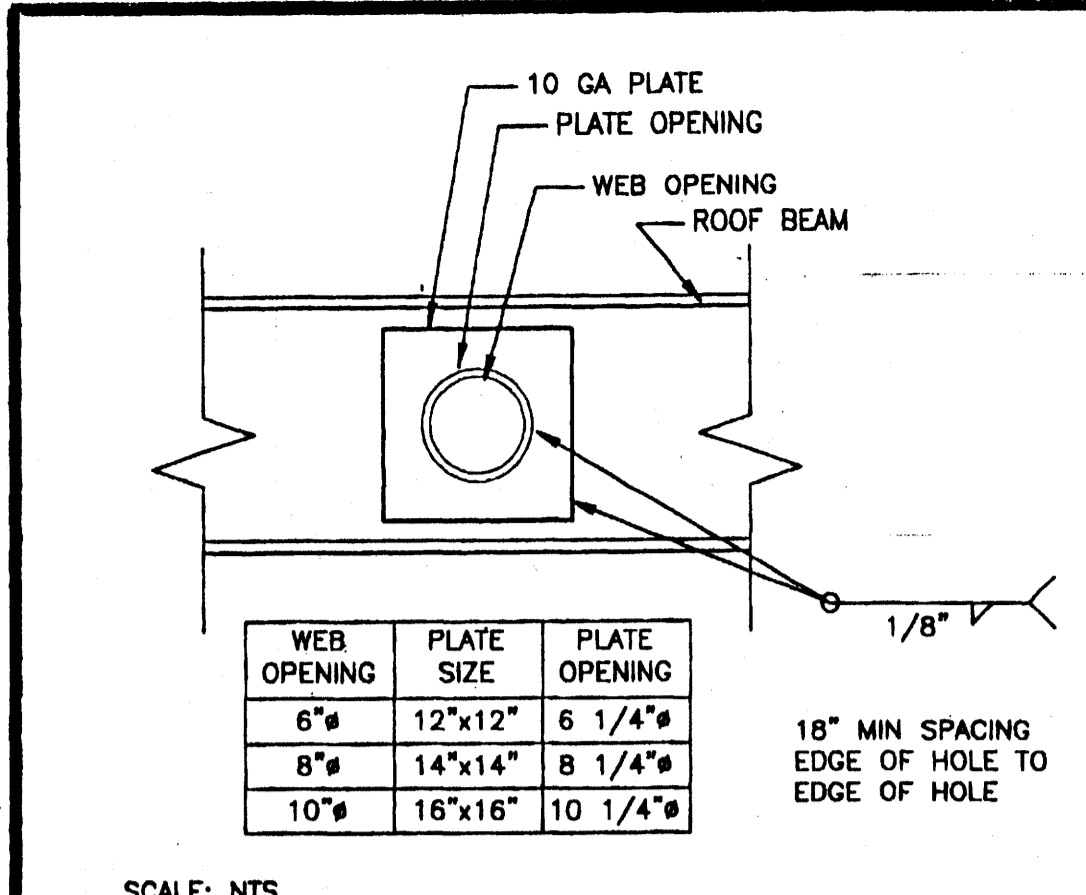

- ### KEY NOTES
- FLOOR BEAM - 1/S1
 - FLOOR HEADER - 1/S1
 - FLOOR JOIST - 2/S1
 - TAPERED ROOF BEAM - 1/S2.02
 - ROOF HEADER - 2/S2.02
 - ROOF FASCIA AT 2'-6" OVERHANG - 3/S2.02
 - ROOF FASCIA AT 5'-0" OVERHANG - 3/S2.02
 - ROOF PURLIN - 4/S2.02
 - 1/4" FULL DEPTH STIFFENER PLATE AT 8'-0" OC TYPICAL ALIGN WITH PURLIN - 9/S2.02
 - TUBE STEEL COLUMN, SEE TABLE BELOW - 8/S3.02
 - 3 1/2"x3 1/2"x1/4" STEEL STIFFENER PLATE. WHEN CONCRETE FOUNDATIONS ARE USED REPLACE LOWER PLATE WITH 5"x8"x1/4" ANCHOR BOLT PLATE - 3/S1
 - 3 1/2"x3 1/2"x1/4" TUBE STEEL STUB
 - (1) 3"x3"x10 GA TUBE STEEL BACK UP TUBE OR (4) 10 GA BACK UP PLATES
 - 3 1/2"x3 1/2"x1/4" ANGLE STIFFENER
 - BACK-UP PLATE - 10 GA MIN
 - 1/4" BASE PLATE - INSERT FLUSH WITH STIFFENER TUBE
 - HVAC DUCT OPENING - 12/S2.02
 - NOT USED
 - 1/4" FULL DEPTH STIFFENER PLATE AT 4'-0" OC AT EXTERIOR SIDEWALLS ONLY FOR 80 MPH DESIGN WIND LOAD ONLY
 - HAND HOLE AT BOLT LOCATION
 - 5/8" MB A307 AT MODULE CONNECTION JOINT - SEE FLOOR/ROOF FRAMING PLANS
 - FLOOR SHEATHING
 - MODULE JOINT
 - NOT USED
 - 3 1/2"x4 1/2"x1/4" PLATE UNDER BEAM FLANGE
 - STEEL ANGLE WELD TAB
 - 8"x3 1/2"x14 GA OVERHANG BEAM - 3/S2.02

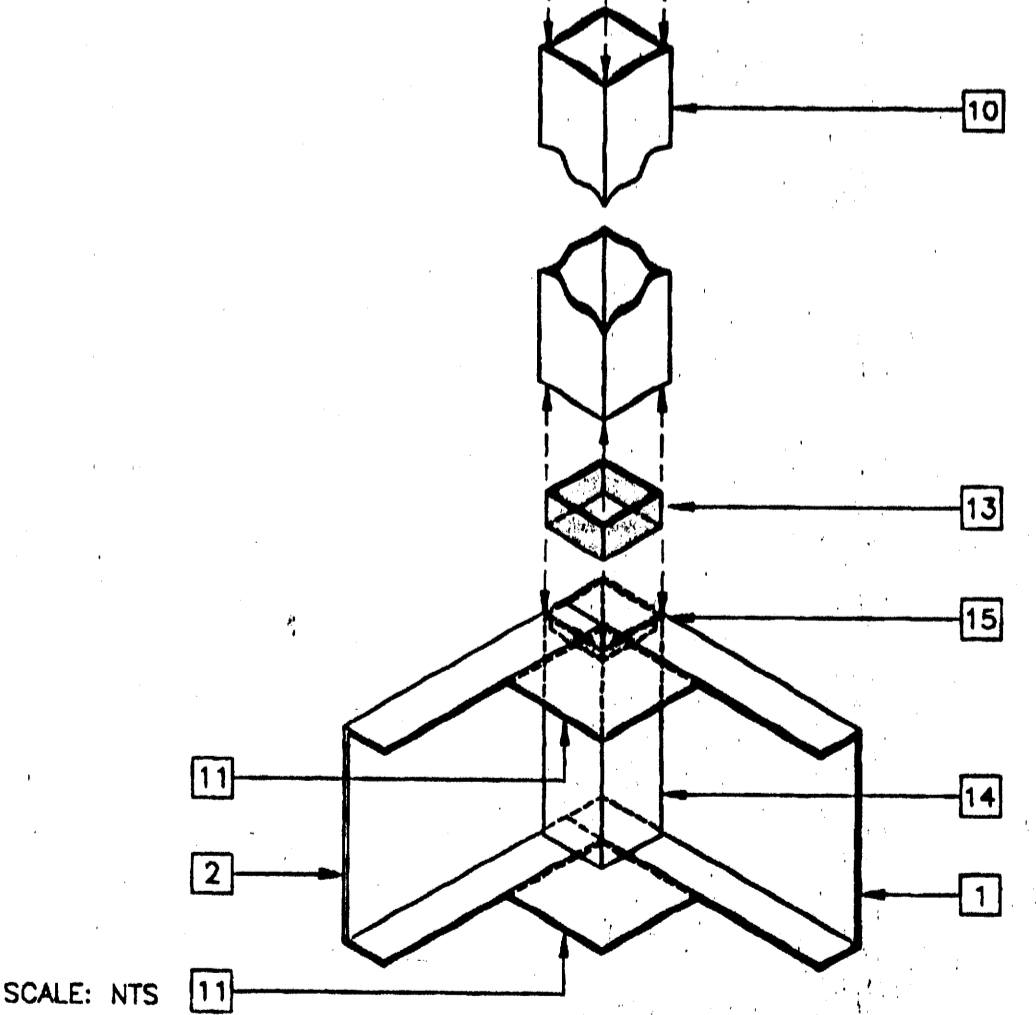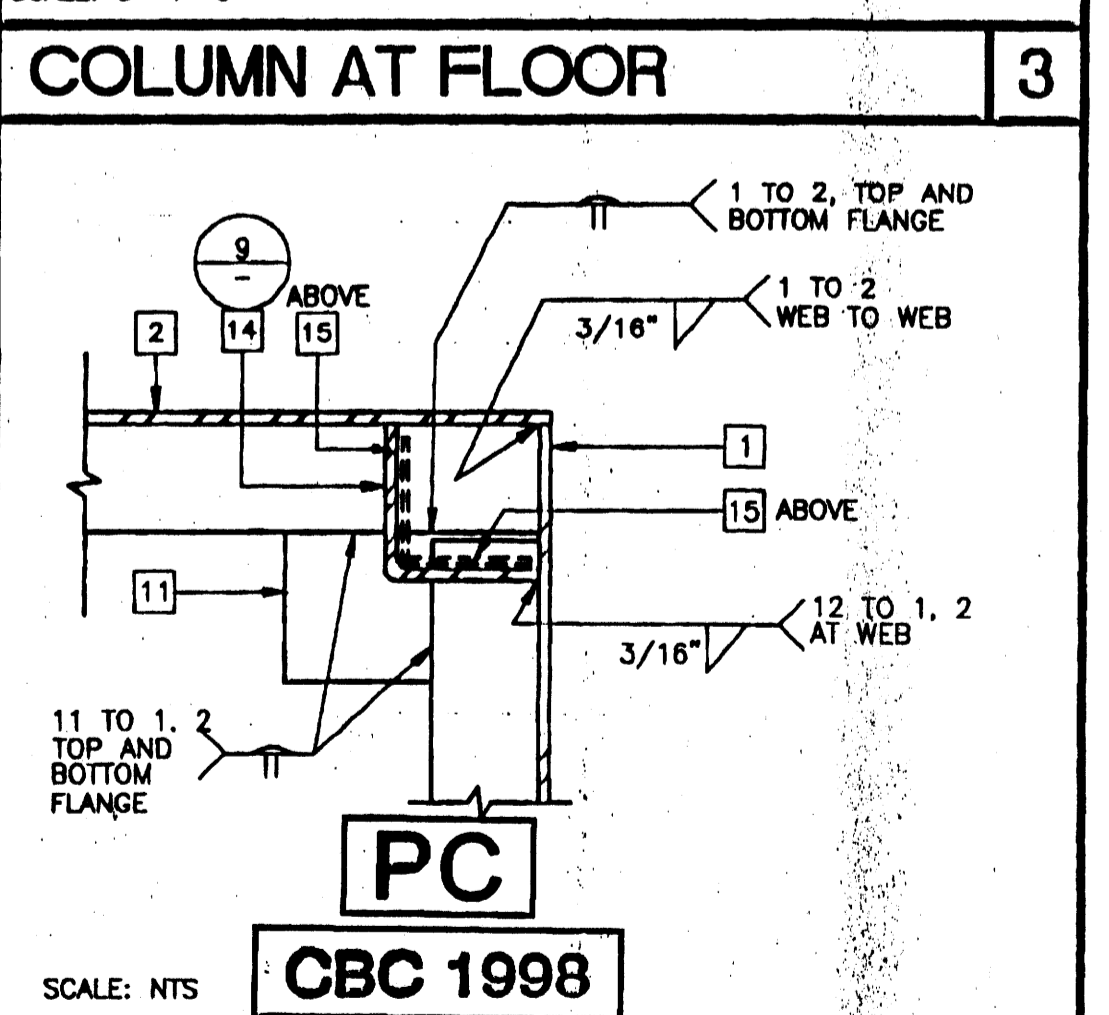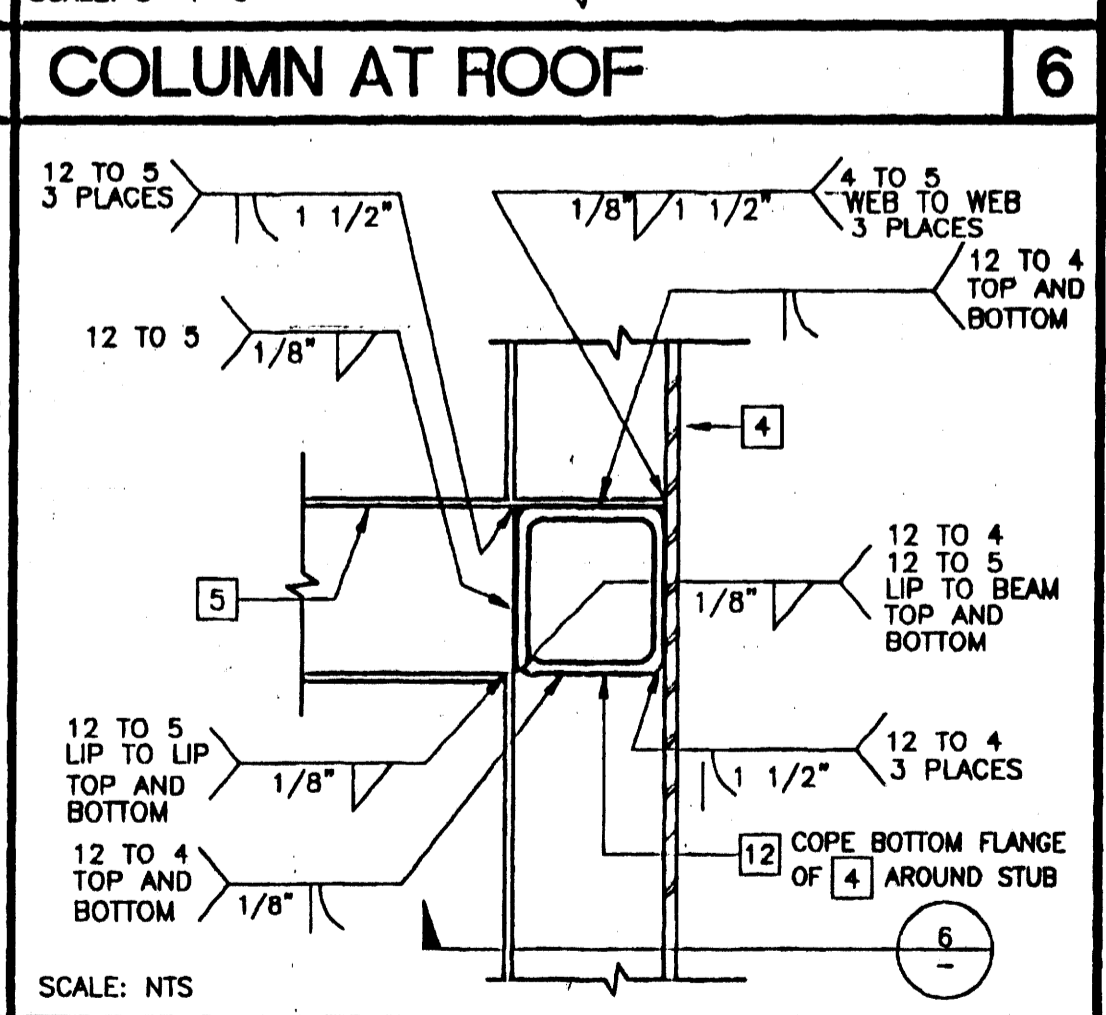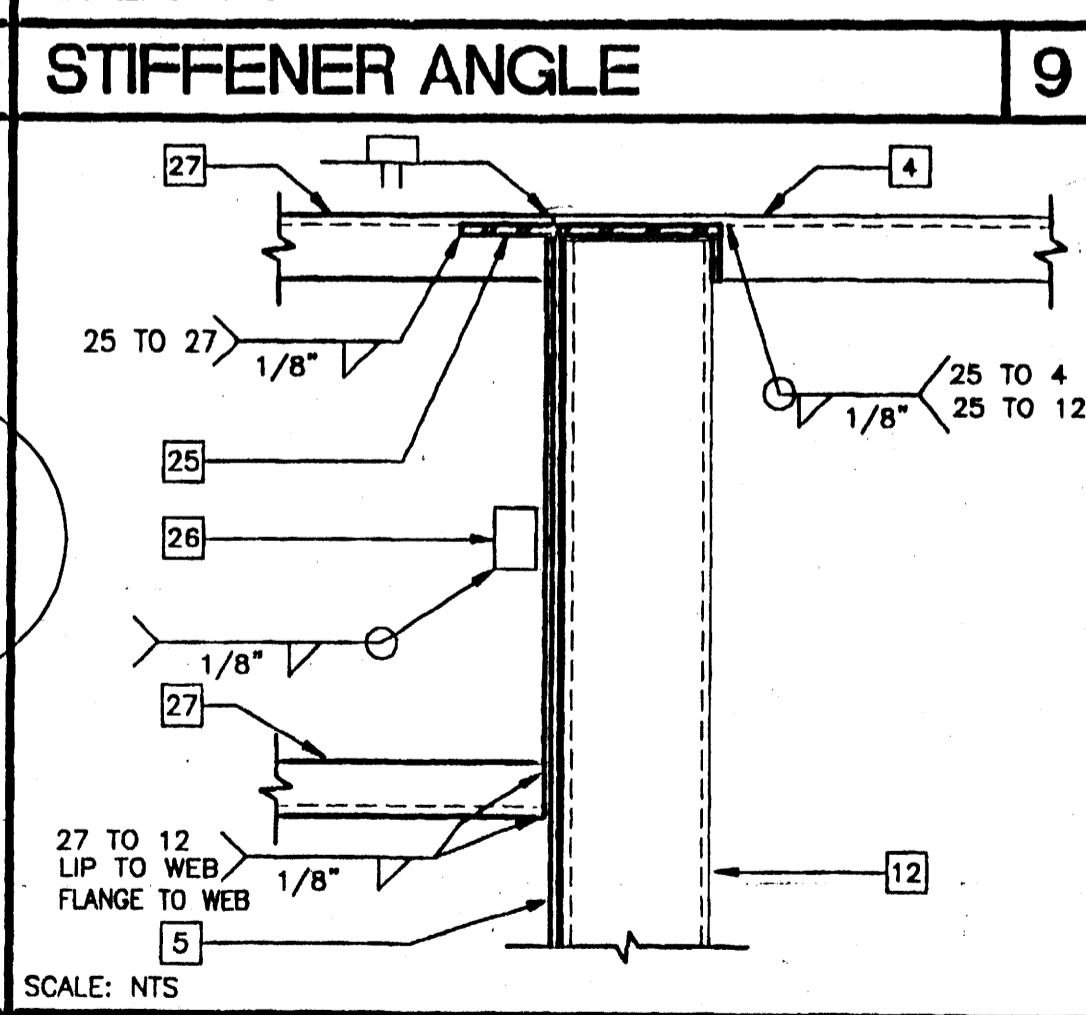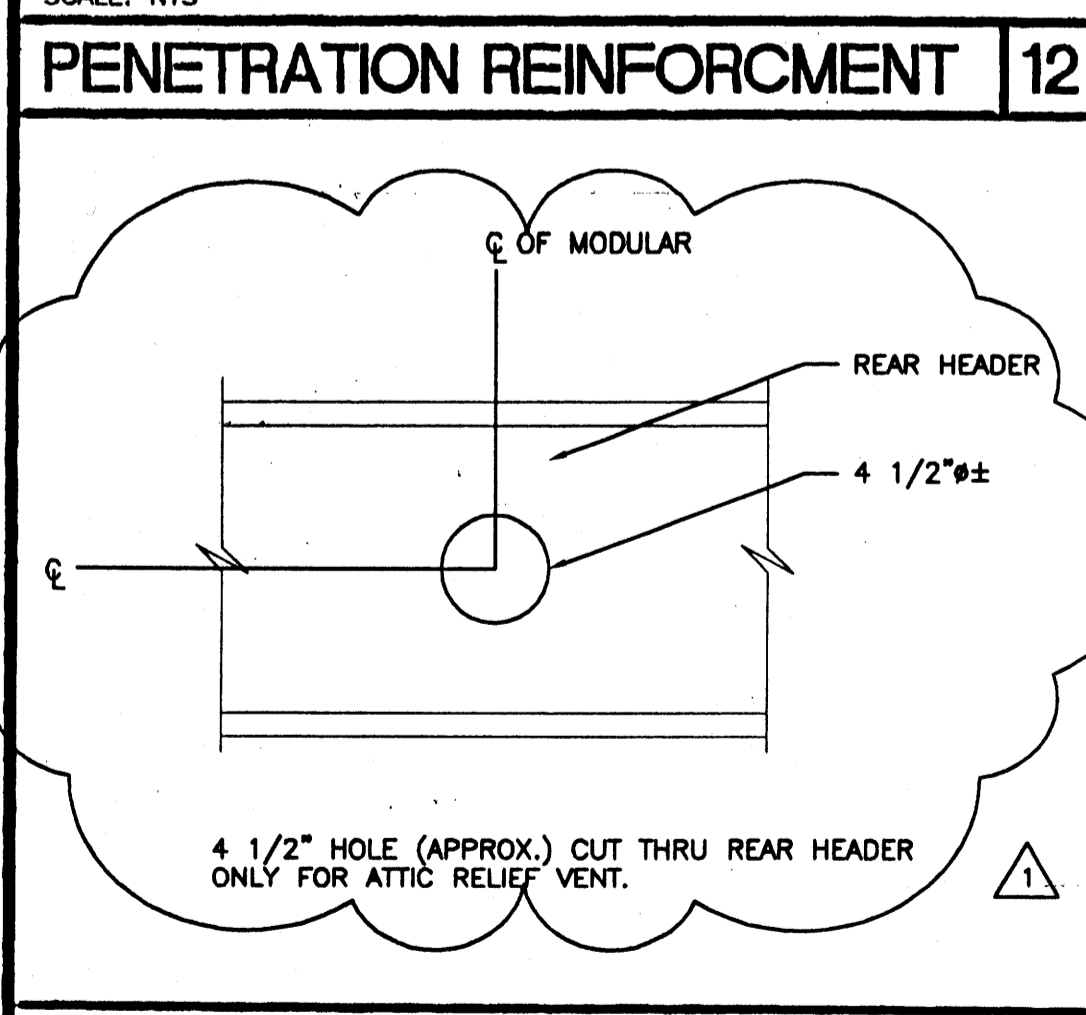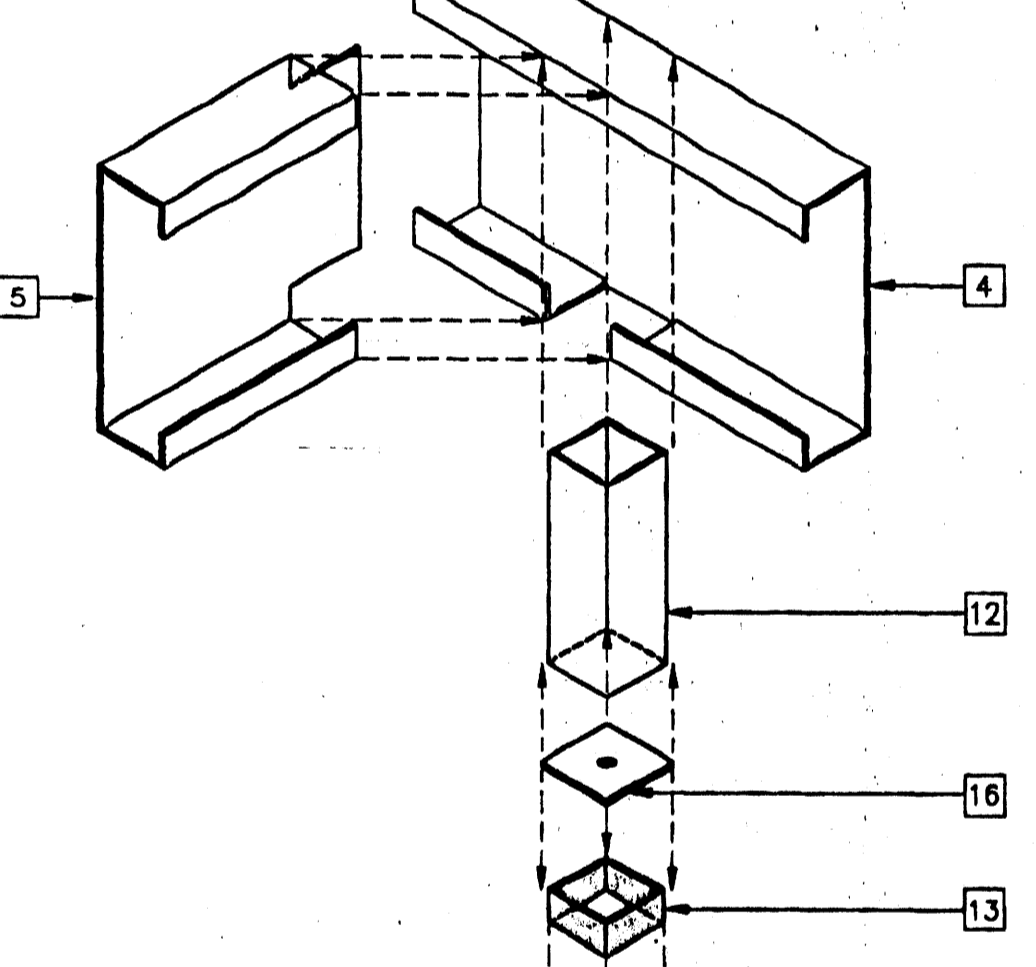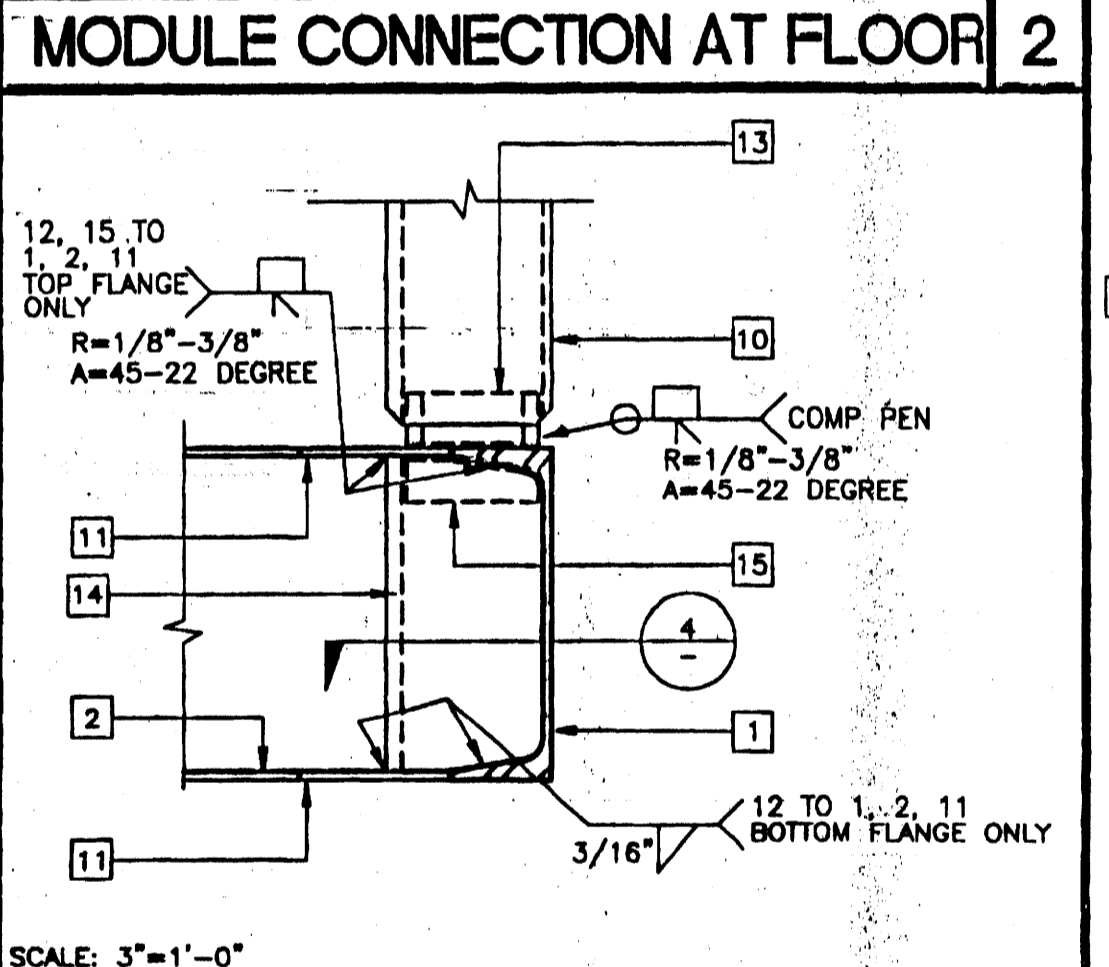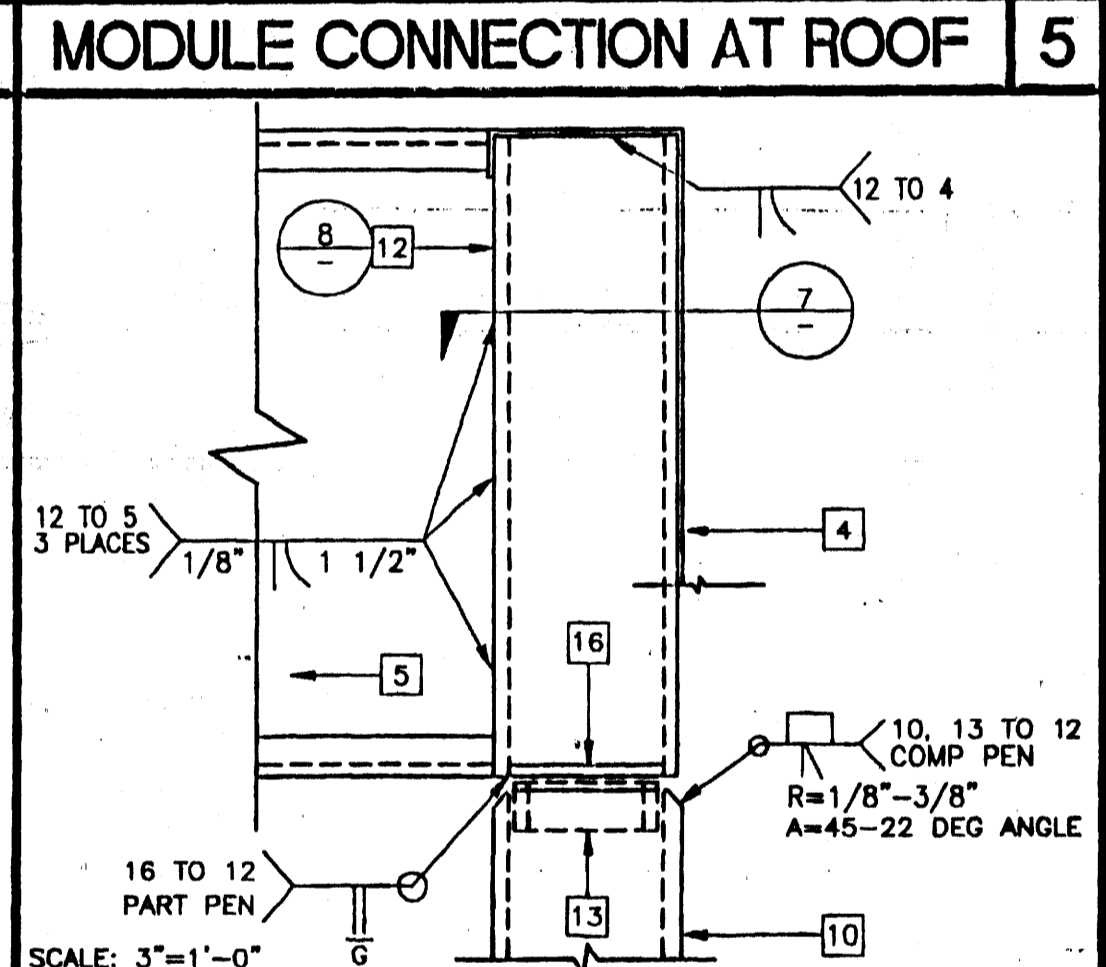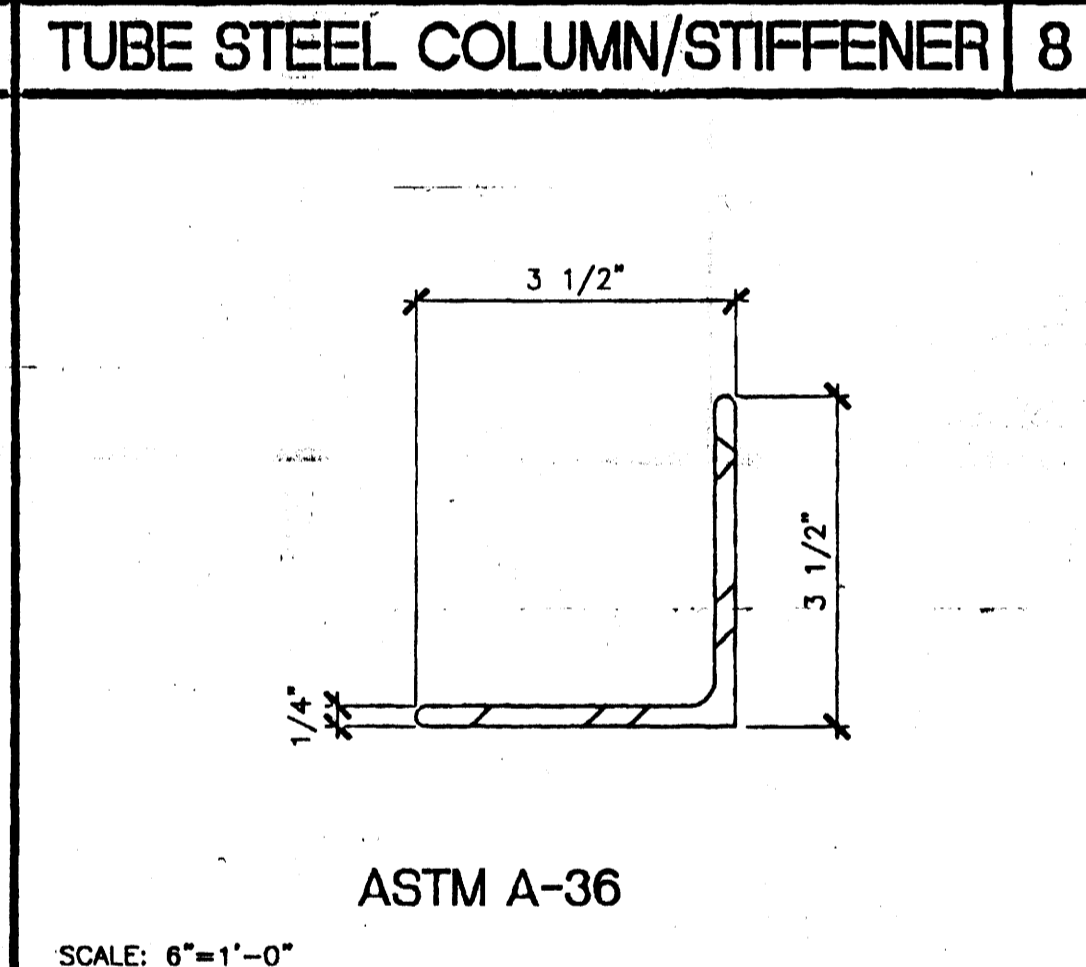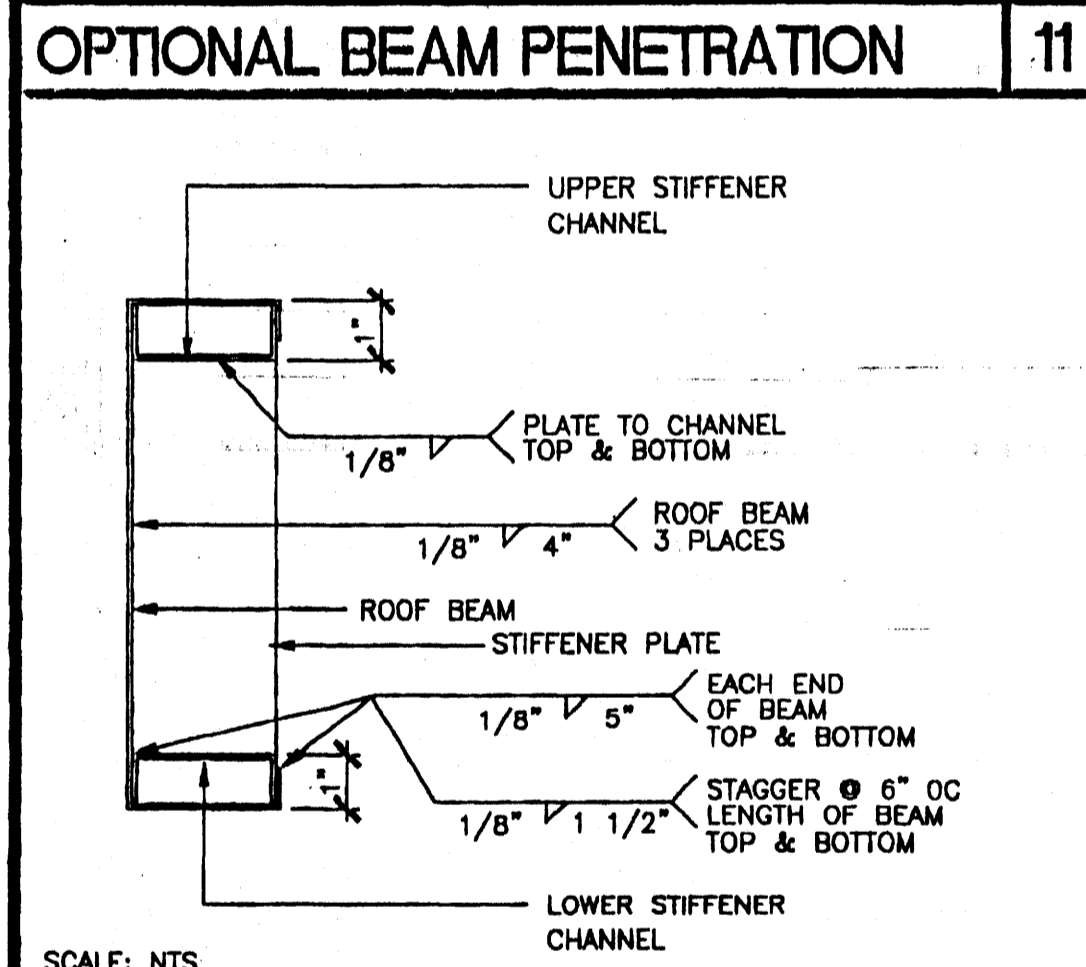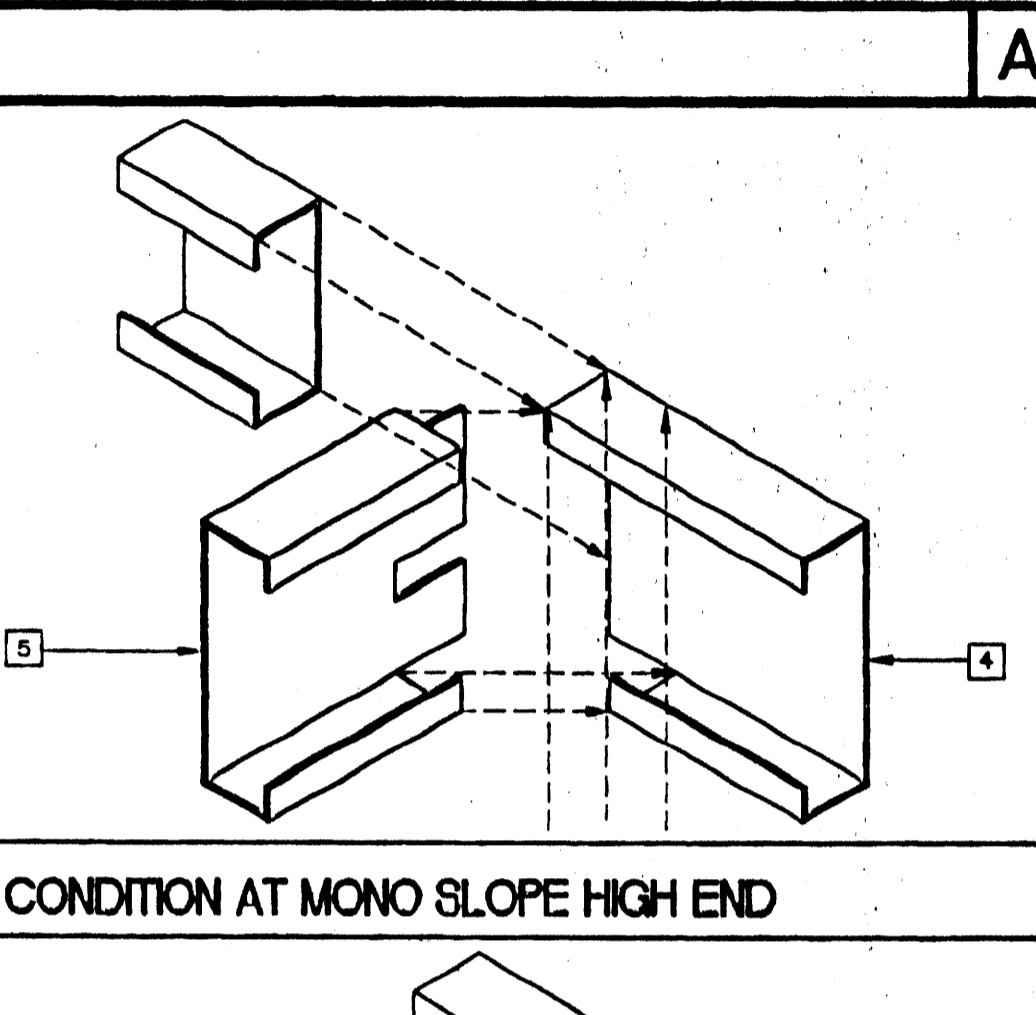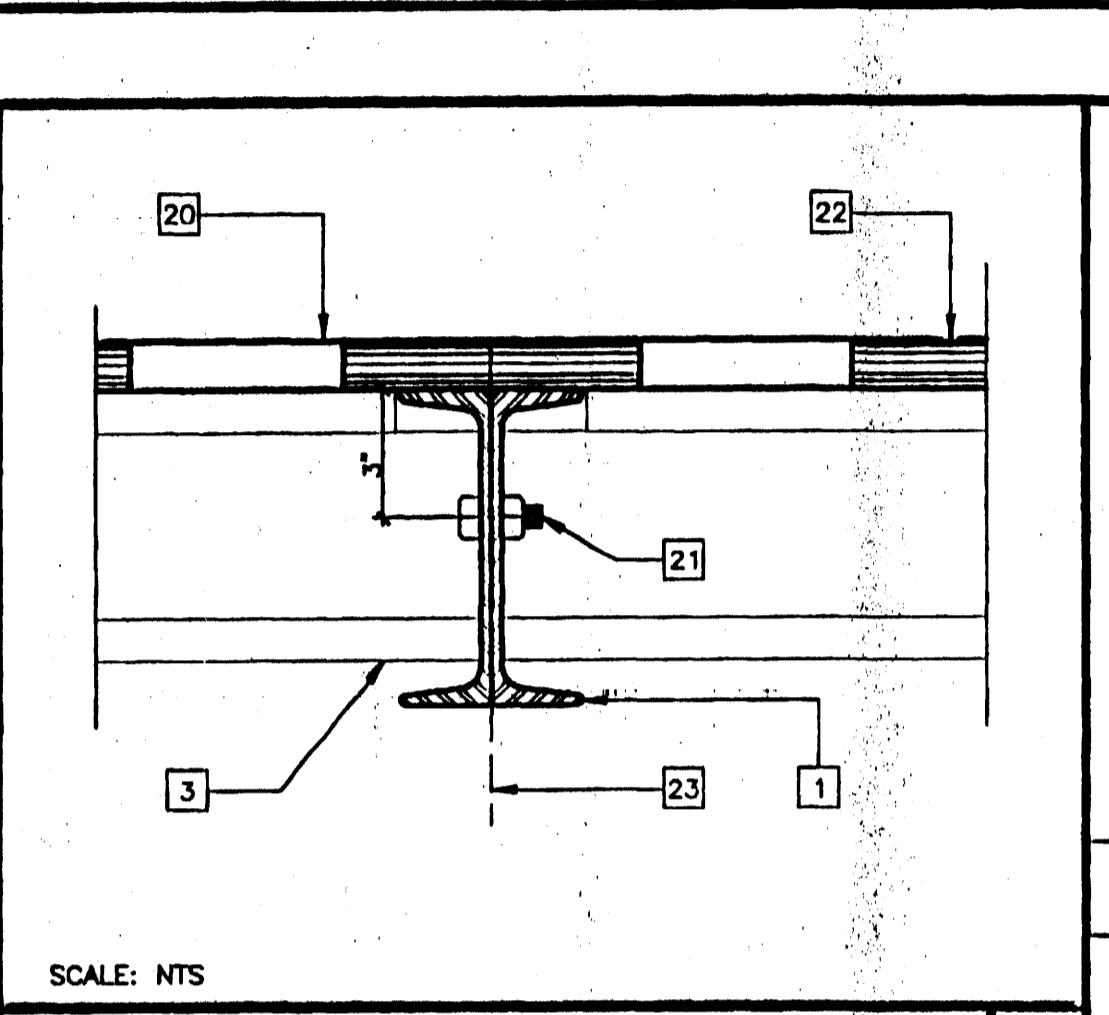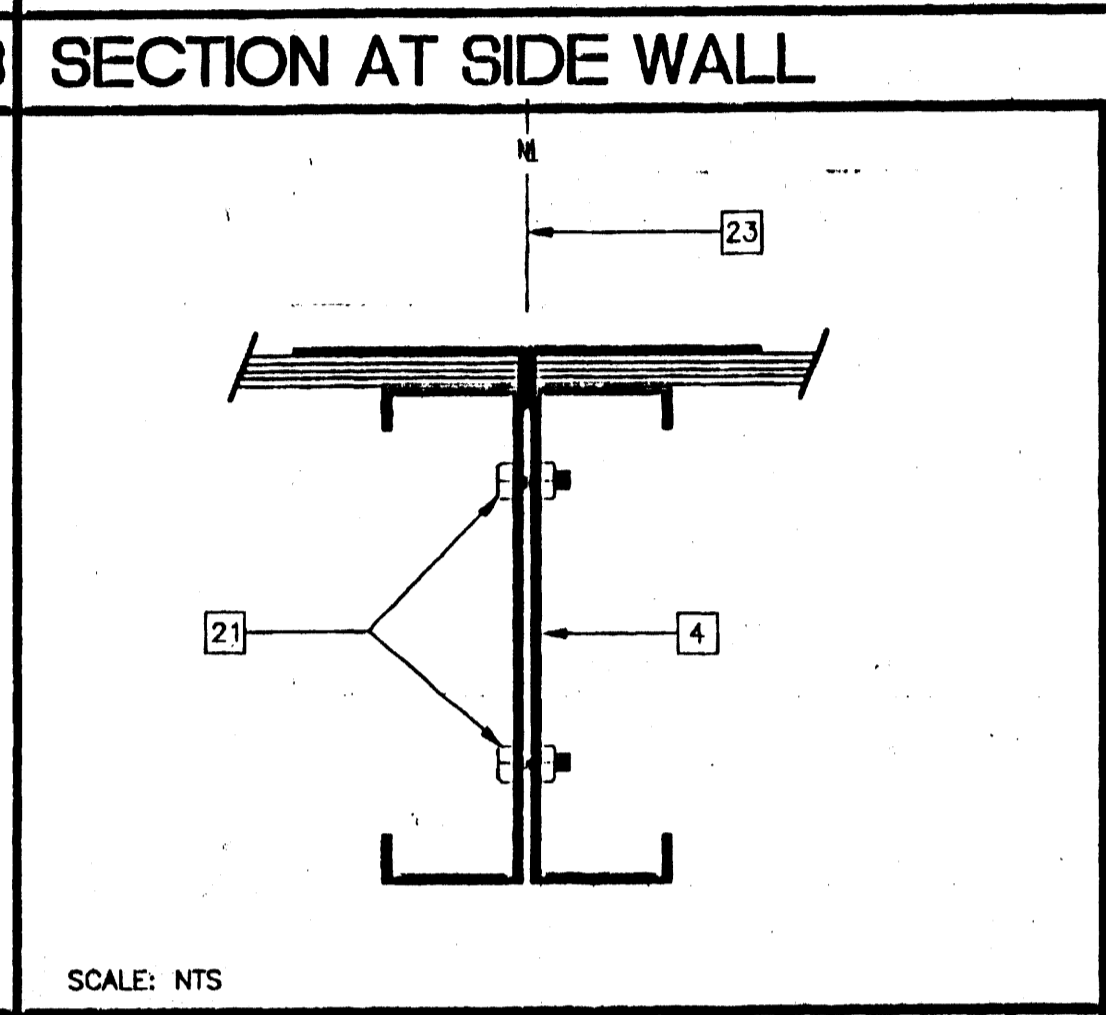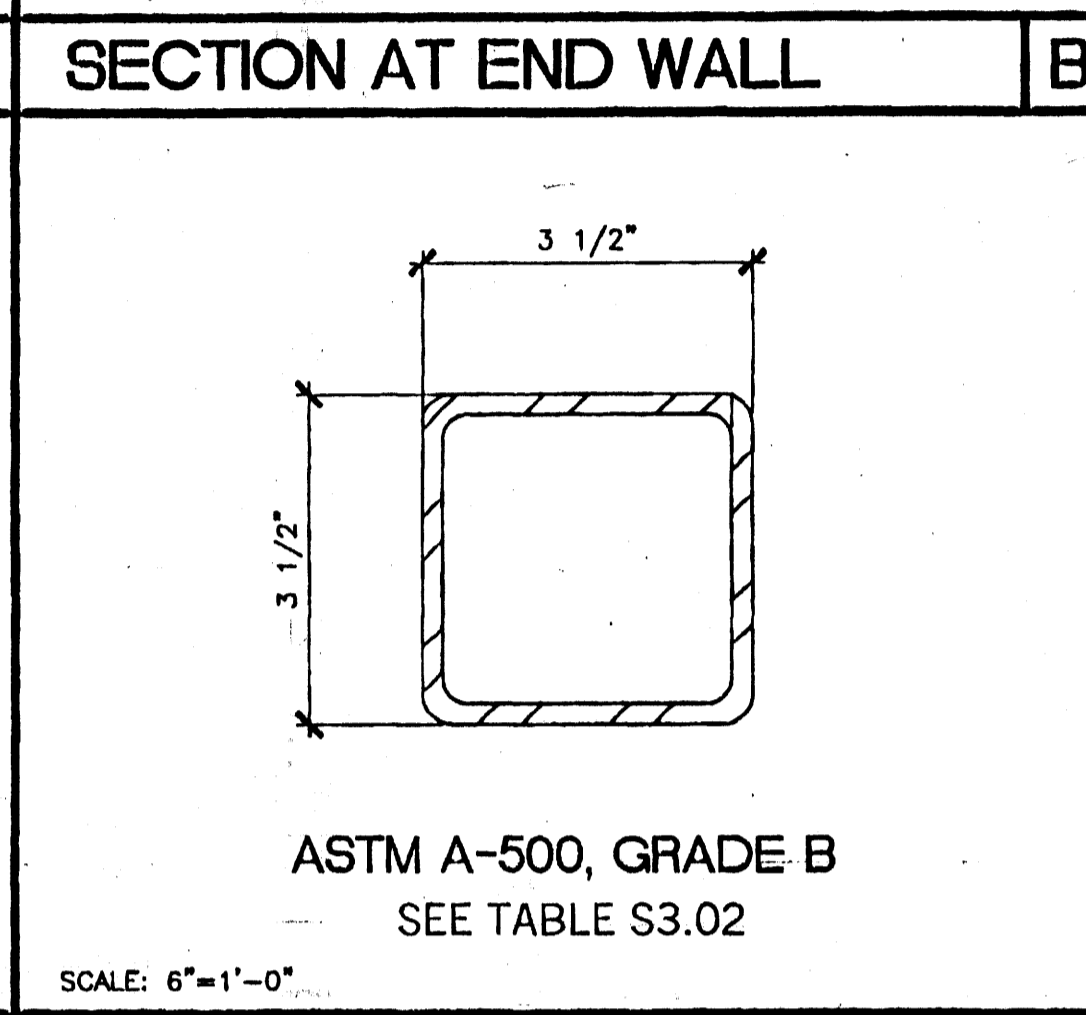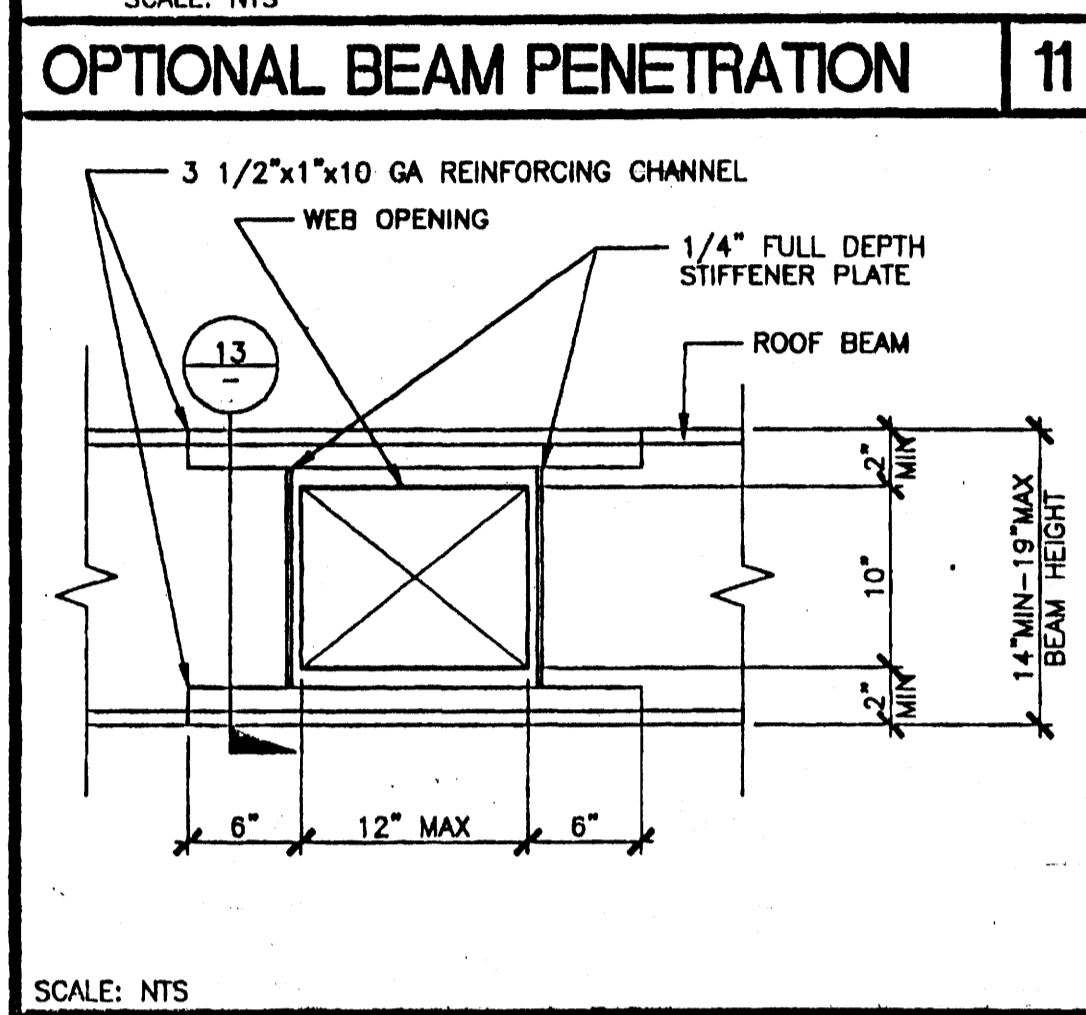

COLUMN SIZE TABLE

DESIGN WIND LOAD	COLUMN SIZE
70 MPH	3 1/2"x3 1/2"x1/4"
80 MPH	3 1/2"x3 1/2"x5/16"

REVISIONS

NO.	DESCRIPTION	DATE
1	ADDED ATTIC RELIEF VENT	11/19/02

Electrical Engineer's Seal
Mechanical Engineer's Seal
Structural Engineer's Seal
Architect's Seal

IDENTIFICATION STAMP
DIV. OF THE STATE ARCHITECT
OFFICE OF REGULATION SERVICES
PC-04
101268
DATE: SEP 07 1999


MODTECH INC.
2830 BARRETT AVENUE
PERRIS, CALIF. 92572
PH (909) 943-4014
FAX (909) 940-0427

PROJECT NUMBER: 4373-M, 4378-M, 4384-M © MODTECH, INC. 2002
4474-
10-24 x 40 CLASSROOMS A# 04-104812
SERIAL # 46974-01/02 TO 46978-01/02
SERIAL # 47176-01/02 TO 47176-01/02
4474 STOCK-LATHROP STOCKPILE #67


DRAWN BY: KK
DATE: 11/19/02
CHECKED BY: STKP-67
DATE: 4012-124
MODTECH Index No.
S3.02

STRUCTURAL FRAMING 26 GA MONO PITCH


FILE PATH: 2440-S3.02.DWG PROJECT NO. 4373

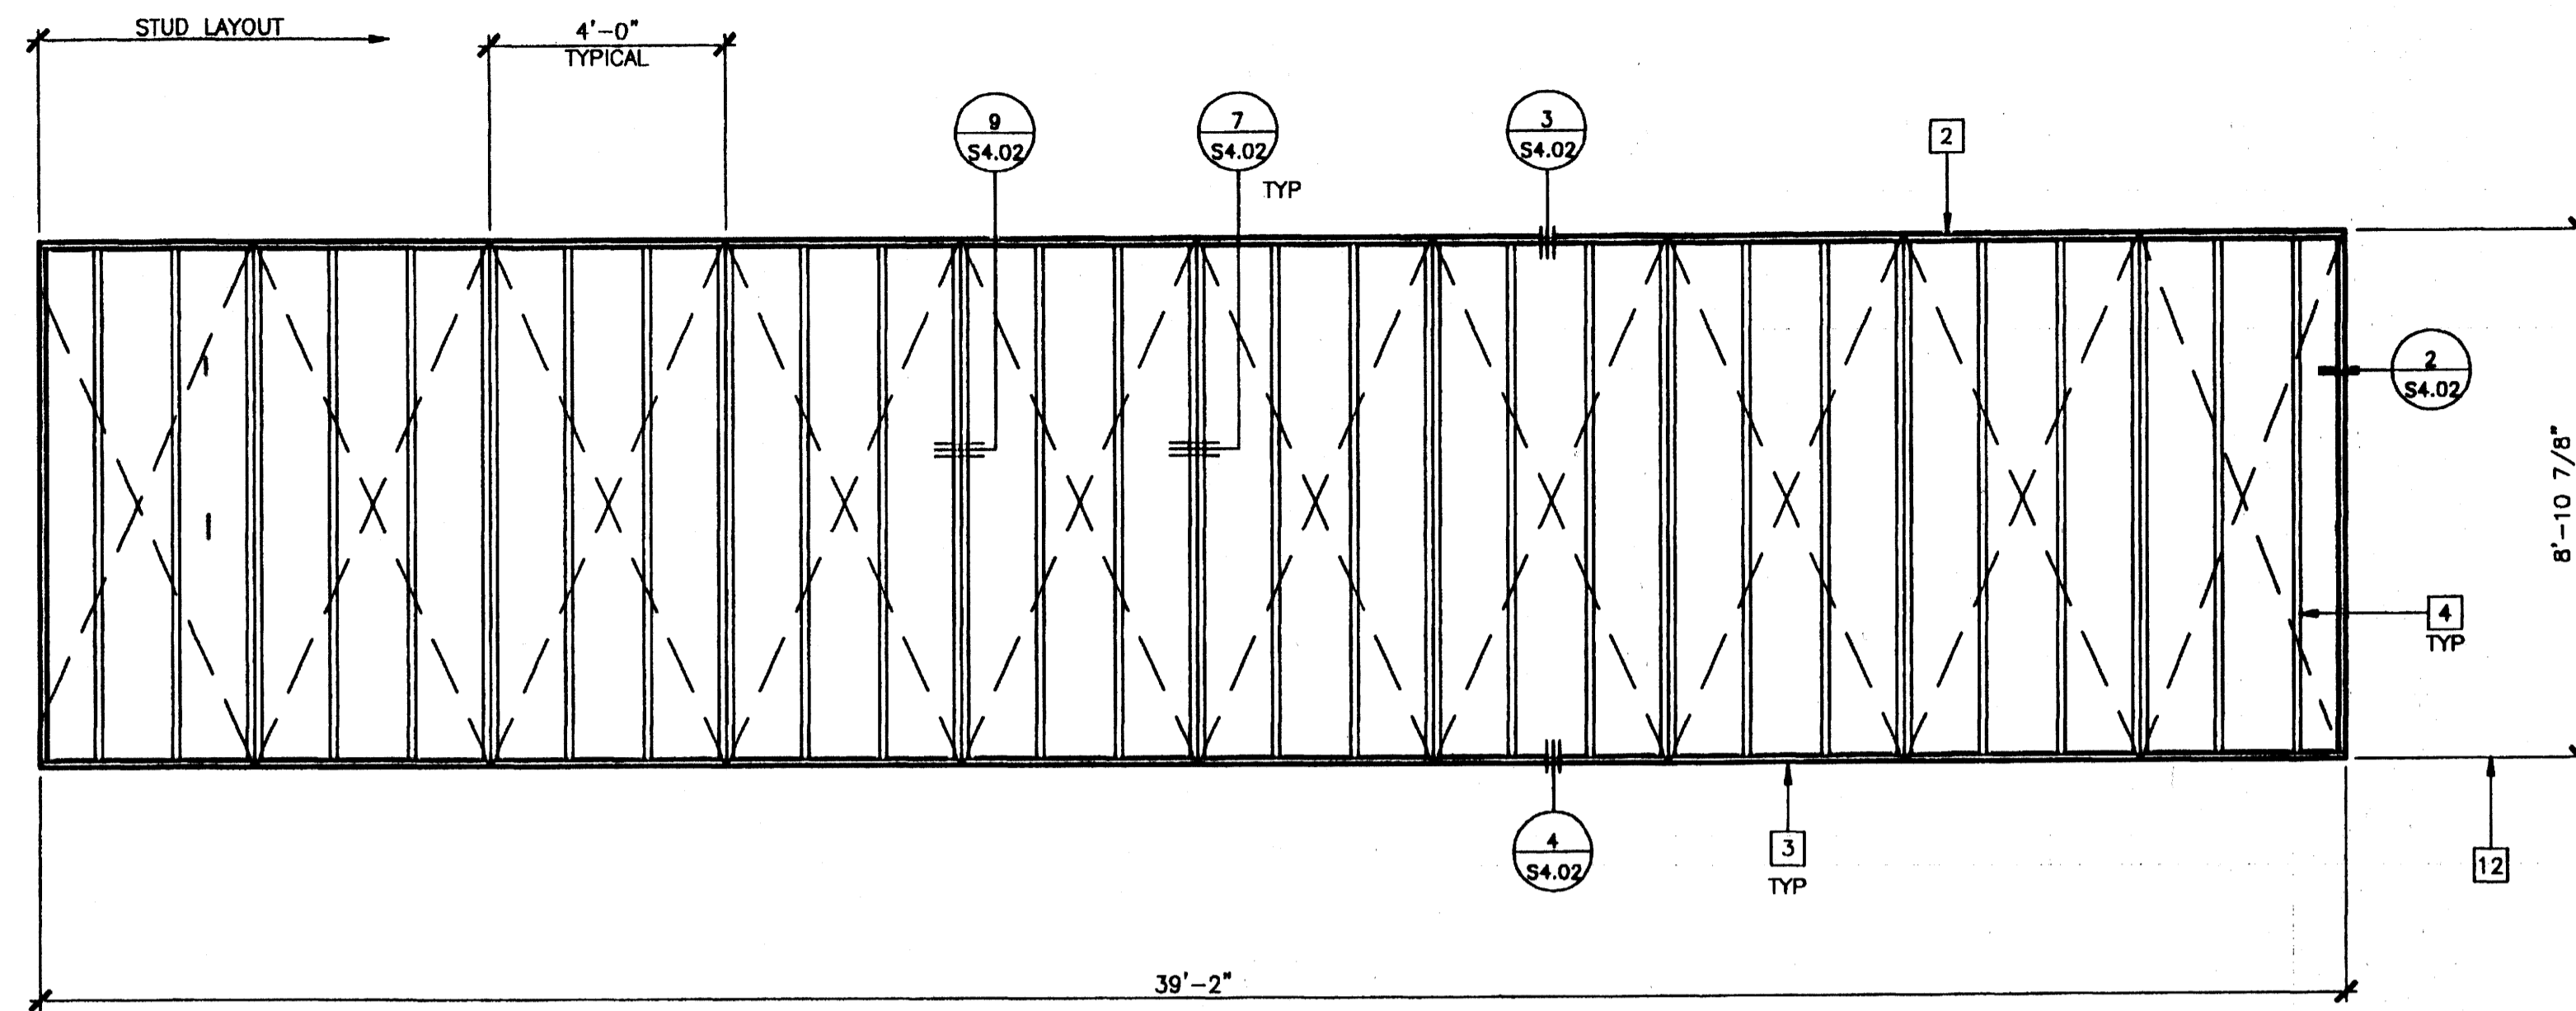


TYPICAL SIDE WALL

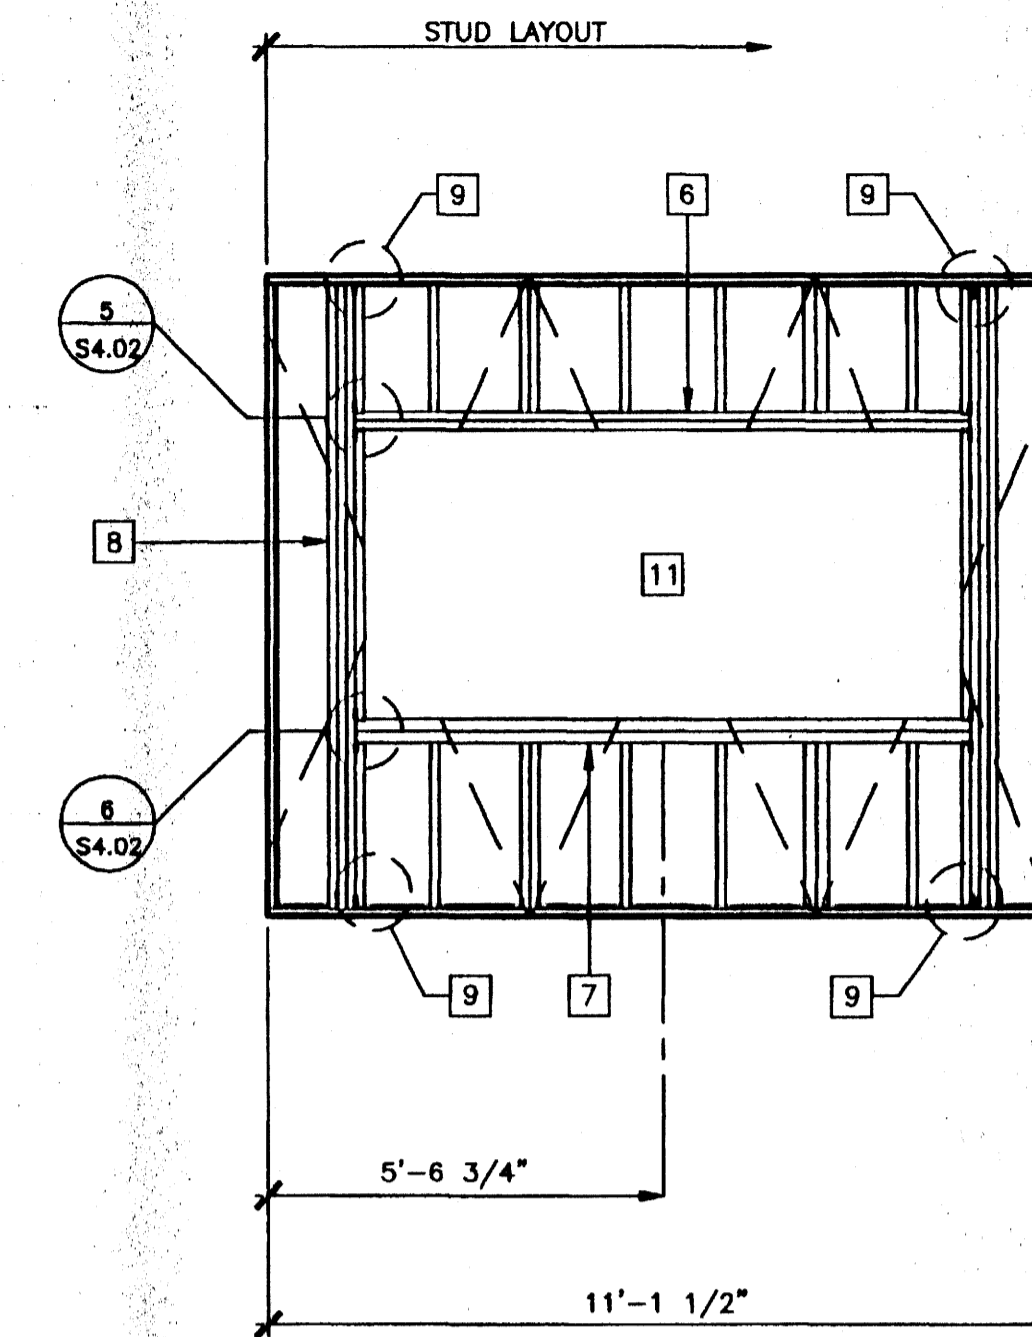


TYPICAL WINDOW

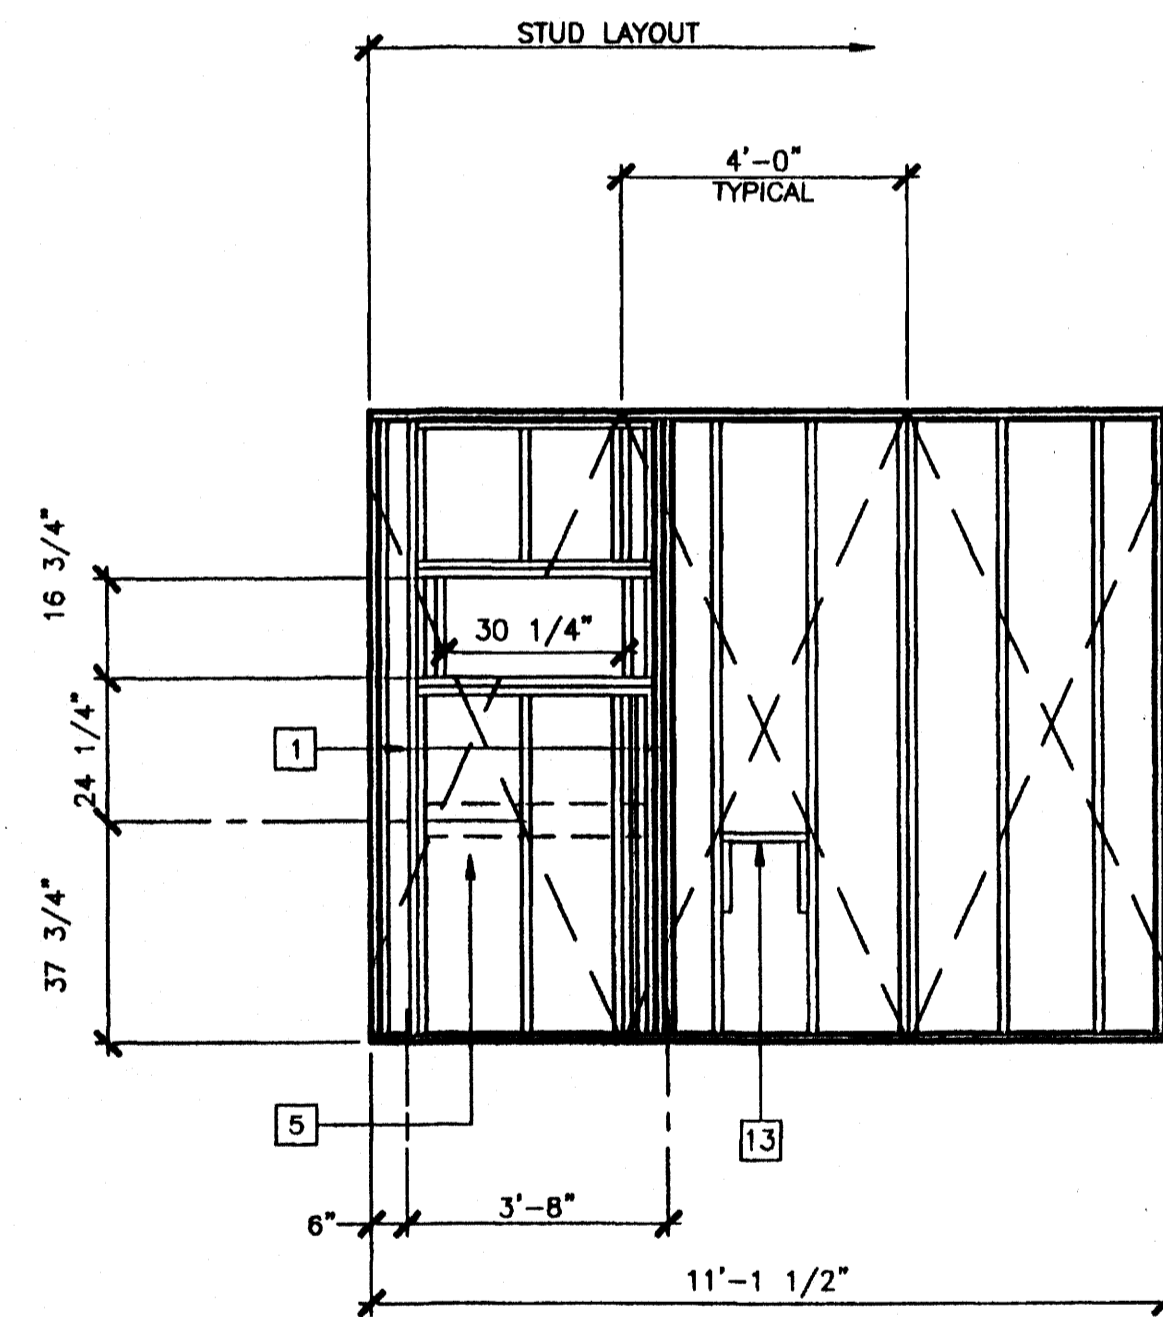

TYPICAL HVAC

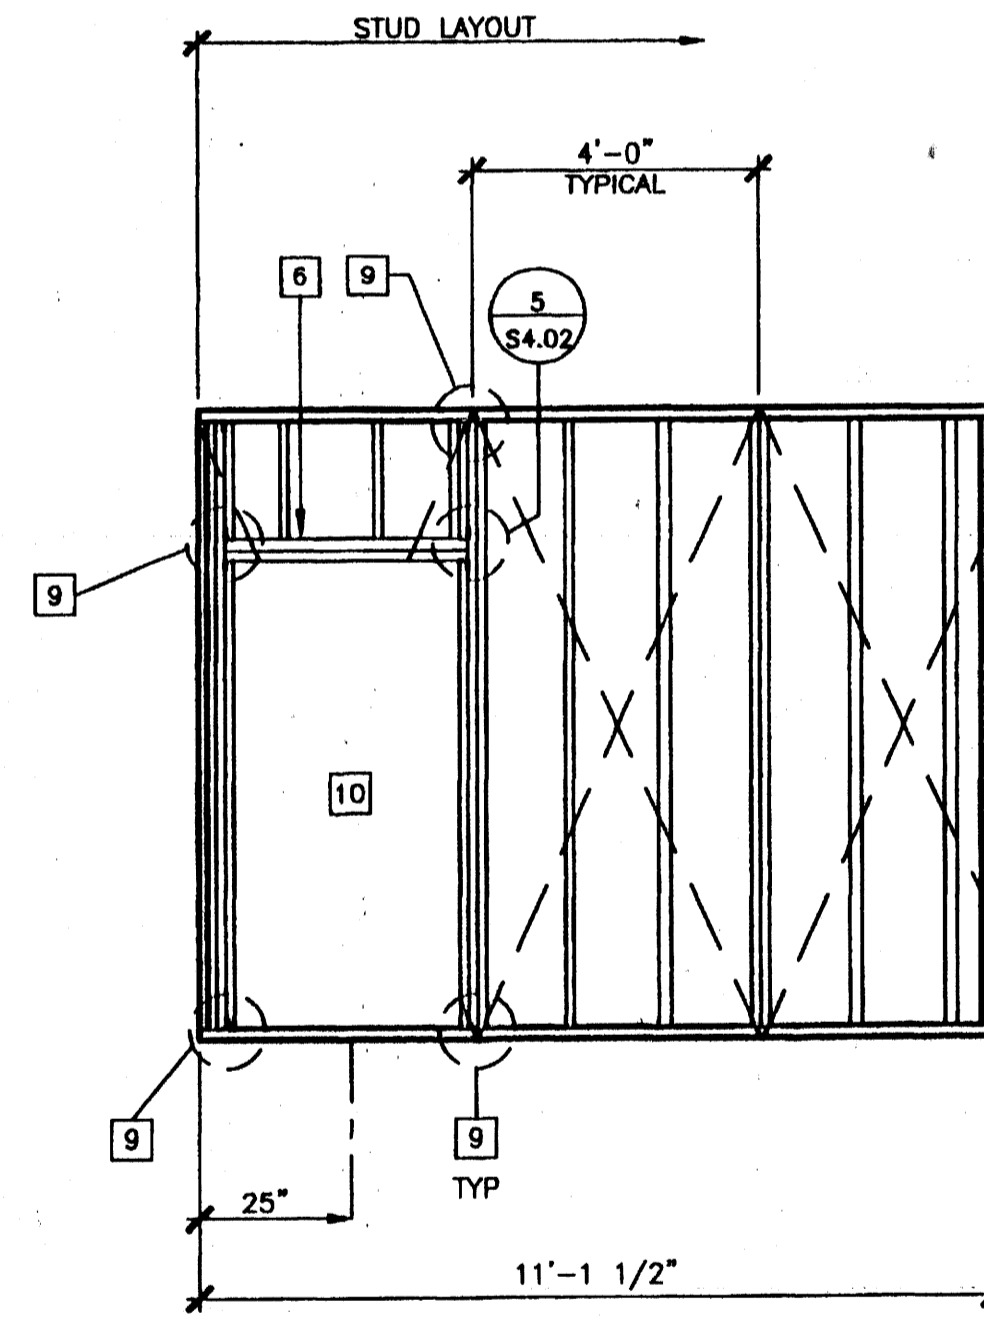


TYPICAL DOOR

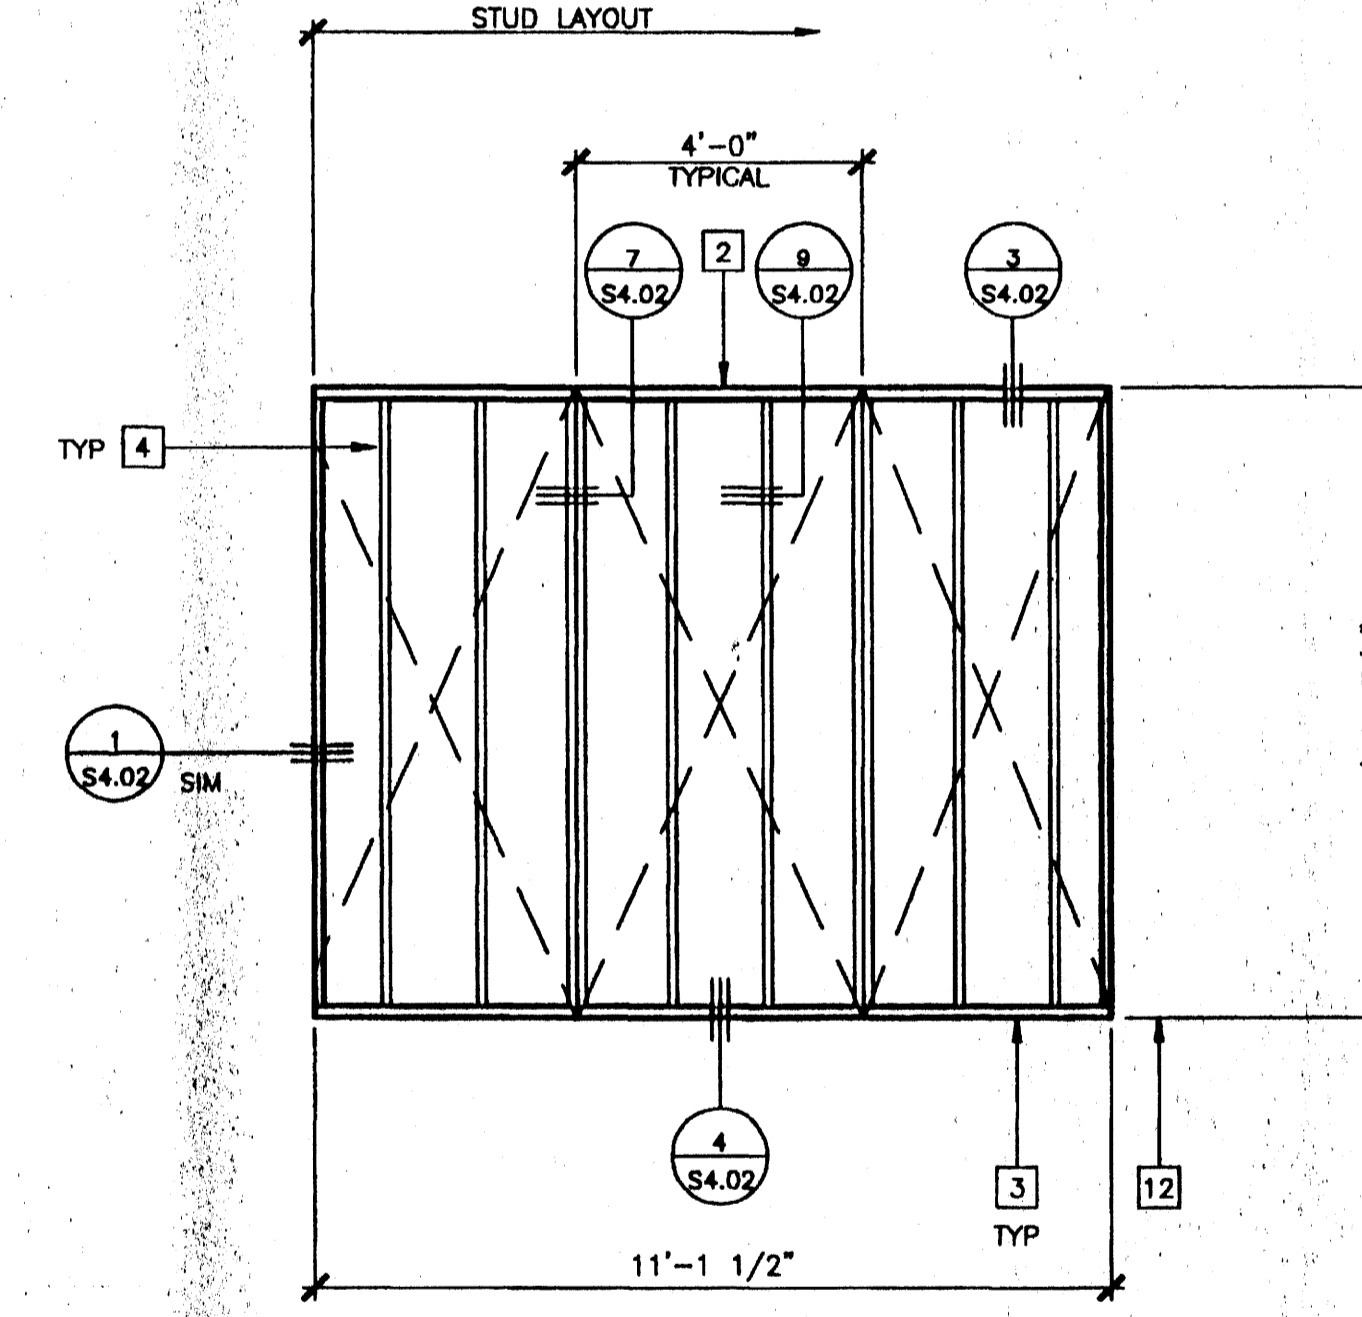

TYPICAL END WALL

KEY NOTES

- 1 4"x4" POST
- 2 2"x4" TOP PLATE
- 3 2"x4" FLOOR SILL PLATE
- 4 2"x4" STUDS AT 16" OC TYPICAL - FOR BUILDINGS EXCEEDING 2160 SF ONLY USE 12" OC SPACING WITHIN 4'-0" OF BUILDING CORNERS
- 5 2"x6" LET IN FOR AC SUPPORT
- 6 2"x4" HEADER - 13/S4.02
- 7 2"x4" SILL - 13/S4.02
- 8 2"x4" FULL HEIGHT KING STUDS AND 2"x4" TRIMMER 13/S4.02
- 9 A 34 CLIPS AT HEADER AND SILL TO FULL HEIGHT STUDS AND FULL HEIGHT STUDS TO TOP AND BOTTOM PLATES
- 10 REQUIRED OPENING FOR A 3068 DOOR - 13/S4.02
- 11 REQUIRED OPENING FOR A 8040 WINDOW - 13/S4.02
- 12 FINISH FLOOR LINE
- 13 FRAME FOR ELECTRICAL PANEL
- 14 PROVIDE 2x6 FLAT WALL BLOCKING WITH 3-16d BOX NAILS EACH END AT EACH HANDRAIL CONNECTION - 6/R1.01 SEE FLOOR PLAN FOR RAMP LOCATION.

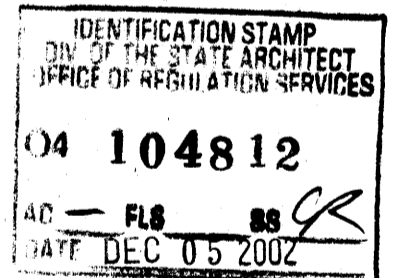

WALL FRAMING ELEVATIONS

WOOD STUDS
SCALE: 3/8" = 1'-0"

PC
CBC 1998

REVISIONS			
NO.	DESCRIPTION	DATE	BY
1	MODTECH ENGINEERING CHANGE	09/28/00	
2			
3			
4			


Electrical Engineer's Seal

Mechanical Engineer's Seal

Structural Engineer's Seal

Architect's Seal

IDENTIFICATION STAMP
DIV. OF THE STATE ARCHITECT
OFFICE OF REGULATION SERVICES
PC-04
101268
REVISED OCT 02 2000

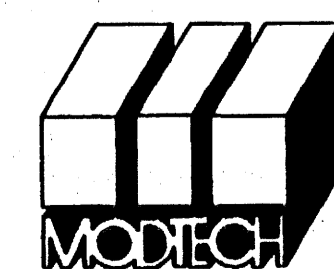

MODTECH INC.
2830 BARRETT AVENUE
PERRIS, CALIF. 92572
PH (909) 943-4014
FAX (909) 940-0427

PROJECT NUMBER: 4373
COLTON U.S.D.

© MODTECH, INC. 2002

DRAWN BY: KK
DATE: 11/19/02
CHECKED BY: STKP-67
DATE: 4012-124

WALL FRAMING

WOOD STUDS

S4.01




FILE PATH: 2440-S4.01.DWG PROJECT NO. 4373 PC-04-101268

NOTE: ALL NAILS SHALL BE BOX NAILS UNLESS OTHERWISE NOTED

CONNECTION	NAILING ¹
1. JOIST TO SILL OR GIRDER, TOENAIL	3-Bd
2. BRIDGING TO JOIST, TOENAIL EACH END	2-Bd
3. 1"x8" SUBFLOOR OR LESS TO EACH JOIST, FACE NAIL	2-Bd
4. WIDER THAN 1"x8" SUBFLOOR TO EACH JOIST, FACE NAIL	3-Bd
5. 2" SUBFLOOR TO JOIST OR GIRDER, BLIND AND FACE NAIL	2-16d
6. SOLE PLATE TO JOIST OR BLOCKING, TYPICAL FACE NAIL	16d AT 16" OC
SOLE PLATE TO JOIST OR BLOCKING, AT BRACED WALL PANELS	3-16d PER 16"
7. TOP PLATE TO STUD, END NAIL	2-16d
8. STUD TO SOLE PLATE	4-8d, TOENAIL OR 2-16d, END NAIL
9. DOUBLE STUDS, FACE NAIL	16d AT 24" OC
10. DOUBLE TOP PLATES, TYPICAL FACE NAIL	16d AT 16" OC
DOUBLE TOP PLATES, LAP SPLICE	8-16d
11. BLOCKING BETWEEN JOISTS OR RAFTERS TO TOP PLATE, TOENAIL	3-8d
12. RIM JOIST TO TOP PLATE, TOENAIL	8d AT 6" OC
13. TOP PLATES, LAPS AND INTERSECTIONS, FACE NAIL	2-16d
14. CONTINUOUS HEADER, TWO PIECES, ALONG EACH EDGE	16d AT 16" OC
15. CEILING JOIST TO PLATE, TOENAIL	3-8d
16. CONTINUOUS HEADER TO STUD, TOENAIL	4-8d
17. CEILING JOISTS, LAPS OVER PARTITIONS, FACE NAIL	3-16d
18. CEILING JOISTS, TO PARALLEL RAFTERS, FACE NAIL	3-16d
19. RAFTER TO PLATE, TOENAIL	3-8d
20. 1" BRACE TO EACH STUD AND PLATE, FACE NAIL	2-8d
21. 1"x8" OR LESS SHEATHING TO EACH BEARING, FACE NAIL	2-8d
22. WIDER THAN 1"x8" SHEATHING TO EACH BEARING, FACE NAIL	3-8d
23. BUILT-UP CORNER STUDS	16d AT 24" OC
24. BUILT-UP GIRDER AND BEAMS, AT TOP AND BOTTOM AND STAGGERED 2-20d AT ENDS AND AT EACH SPLICE	20d AT 32" OC
25. 2" PLANKS	2-16d AT EACH BEARING
26. WOOD STRUCTURAL PANELS AND PARTICLEBOARD ² SUBFLOOR AND WALL SHEATHING (TO FRAMING):	
1/2" AND LESS	8d ³ OR 6d ³
19/32"-3/4"	8d ³ OR 6d ³
7/8"-1"	10d ⁴ OR 8d ⁵
1 1/8"-1 1/4"	10d ⁴ OR 8d ⁵
COMBINATION SUBFLOOR-UNDERLAYMENT (TO FRAMING)	
3/4" AND LESS	8d ⁵
7/8"-1"	8d ⁵
1 1/8"-1 1/4"	10d ⁴ OR 8d ⁵
27. PANEL SIDING (TO FRAMING) ² :	
1/2" OR LESS	8d ⁶
5/8"	8d ⁶
28. FIBERBOARD SHEATHING: ⁷	
1/2"	NO. 11 GA ⁸
	NO. 16 GA ⁸
	NO. 11 GA ⁸
	NO. 16 GA ⁸
29. INTERIOR PANELING	
1/4"	4d ¹⁰
3/8"	6d ¹¹













OPENING	HEADER	SILL	JAMB	HEIGHT	WIDTH
3068	(2)2"x4"	N/A	(2)2"x4"	81 1/4"	36"
8040	(3)2"x4"	(2)2"x4"	(3)2"x4"	47 5/8"	95 3/4"

* = 4 JAMB STUDS FOR 80 MPH DESIGN WIND LOAD

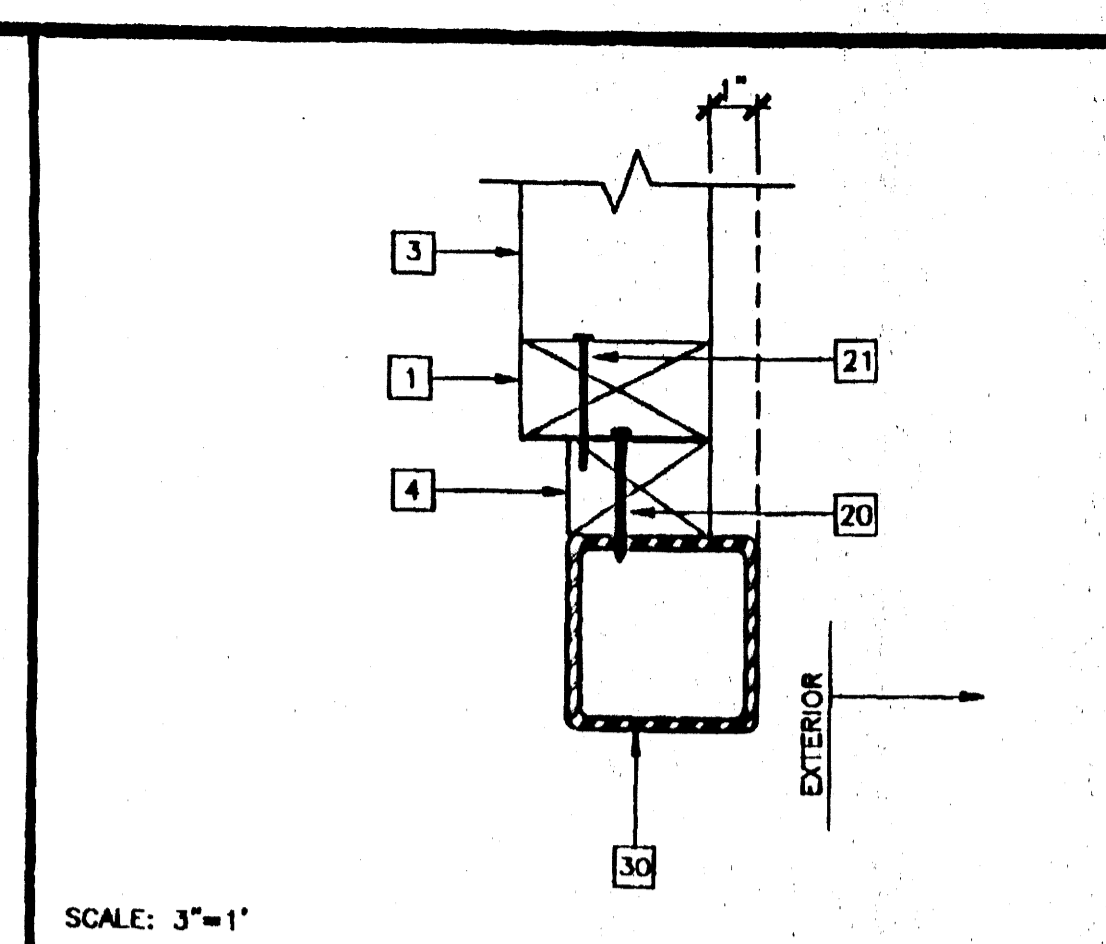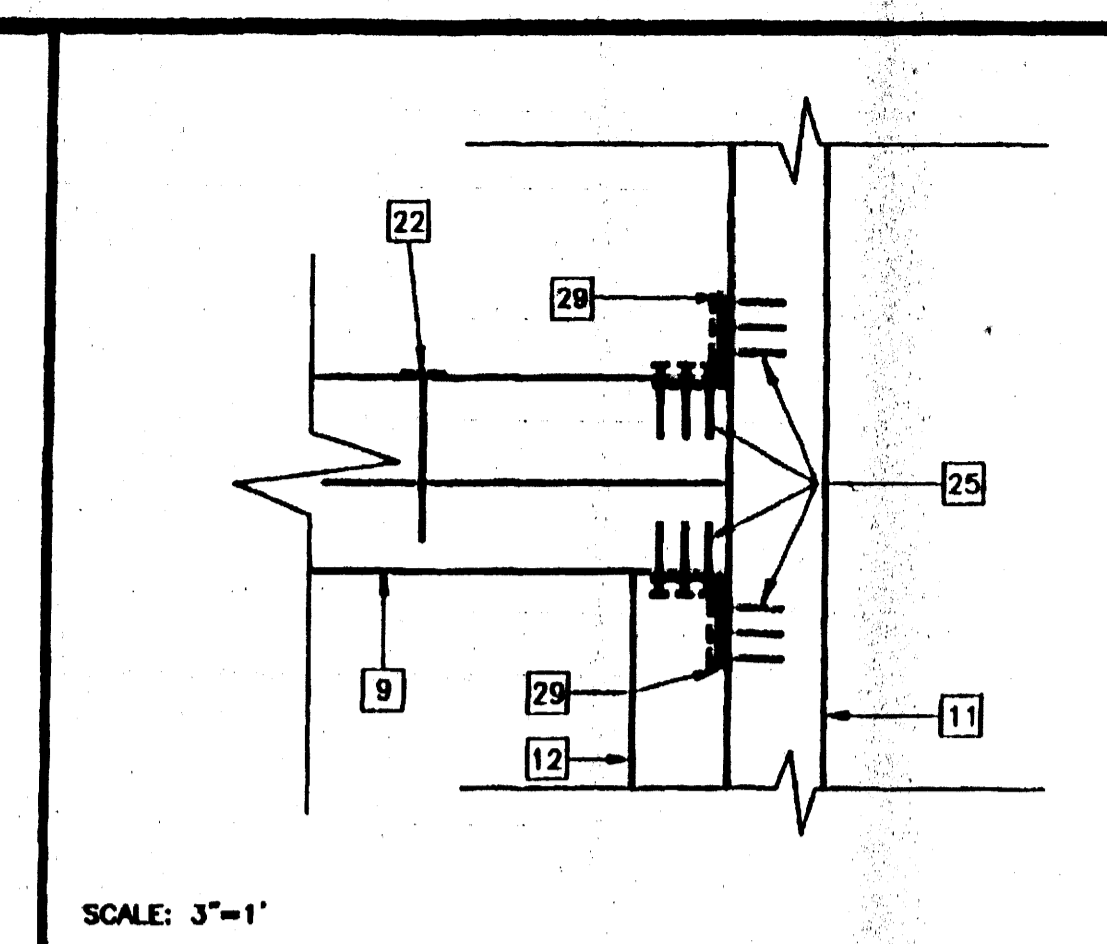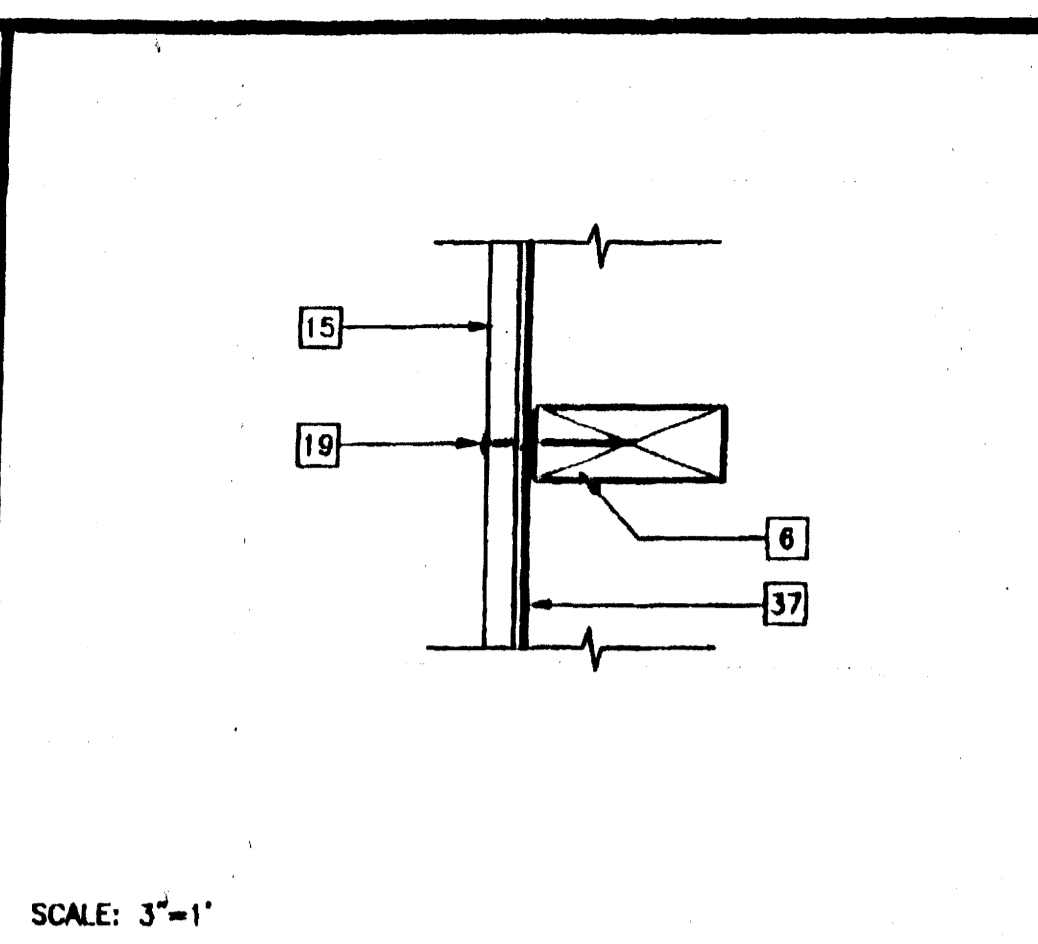




KEY NOTES

- 2"x4" END PLATE
- 2"x4" TOP PLATE
- 2"x4" FLOOR SILL PLATE
- 2"x NAILER AT END WALL
- 2"x4" NAILER AT SIDE WALL
- 2"x4" AT 16" OC
- DOUBLE 2"x4" STUDS AT PLYWOOD EDGES
- 2"x4" BLOCKING
- HEADER - 13/54.02
- WINDOW SILL - 13/54.02
- FULL HEIGHT JAMB STUDS - 13/54.02
- 2"x4" TRIMMER STUD
- 2"x4" DOUBLE TOP PLATE AT INTERIOR PARTITIONS
- 2"x4" BRACE AT 8'-0" OC MAX AT 45" MAX (STAGGERED)
- EXTERIOR SHEATHING NAIL WITH 8d GALVANIZED BOX NAILS AT 6" OC EDGE NAILING, 12" OC FIELD NAILING
- FLOOR SHEATHING
- ROOF SHEATHING
- EDGE NAILING 8d ELECTRO GALVANIZED AT 6" OC
- FIELD NAILING 8d ELECTRO GALVANIZED AT 12" OC
- #10 STMS AT 24" OC OR 0.145# SHOT PIN AT 24" OC
- 16d AT 24" OC
- 16d NAIL AT 16" OC
- 16d BOX NAILS AT 8" OC
- 10 STMS AT 16" OC OR AEROSMITH AKN 0.144 DRIVE PIN AT 16" OC
- 8d x 1 1/2" NAILS
- 1/4" DIA x 2 1/2" EYE LAG SCREW AT 8'-0" OC (2" EMBEDMENT)
- #12 x 2" TYPE A HEX HEAD SCREWS WITH WASHERS TYPICAL FOR 3
- A35 CLIP BOTH SIDES OF BRACE TO TOP PLATE
- A34 CLIPS AT HEADER AND SILL TO FULL HEIGHT STUDS AND FULL HEIGHT STUDS TO TOP AND BOTTOM PLATES
- TUBE STEEL COLUMN (STR)
- ROOF BEAM OR HEADER (STR)
- FLOOR BEAM OR HEADER (STR)
- ROOF PURLIN (STR)
- 12 GA BRACE WIRES ATTACH TO EYE LAG SCREWS AND TO ROOF PURLINS AT 8'-0" OC - ENDS TO HAVE 3 BRACE WIRES IN 1 1/2" (STAGGERED)
- LAP JOINT
- 2" FLASHING
- WATERPROOF MEMBRANE
- EDGE NAIL AT FLOOR BEAM OR HEADER - #10 x 1 3/4" SELF TAPPING FLAT HEAD SCREWS AT 6" OC
- EDGE NAIL 16d BOX NAIL AT 24" OC
- SEALANT TYP (SEE SPECS)
- 2"x4" FLAT NAILER WITH 6d BOX NAIL AT 16" OC
- 2"x4" STUD WITH 5/8" TYPE 'X' GYP BOARD BOTH SIDES TO ROOF TRIM TO CLEAR PURLINS/BRACE, CAULK AT ROOF
- STC WITH 2-8d TOP PLATE AND 1-8d IN SLOT
- STC BENT FLAT WITH 2-8d TO TOP WALL PLATE AND 1-8d IN SLOT AT 48" OC ALTERNATE SIDES
- 2"x4" FLAT WITH 2-#12x2" STS EACH PURLIN
- 2"x4" FLAT WITH 3-6d BOX NAIL TO ROOF SHEATHING
- 2"x4" FLAT BRACE WITH 2-#12x2" STS EACH END AT 48" OC

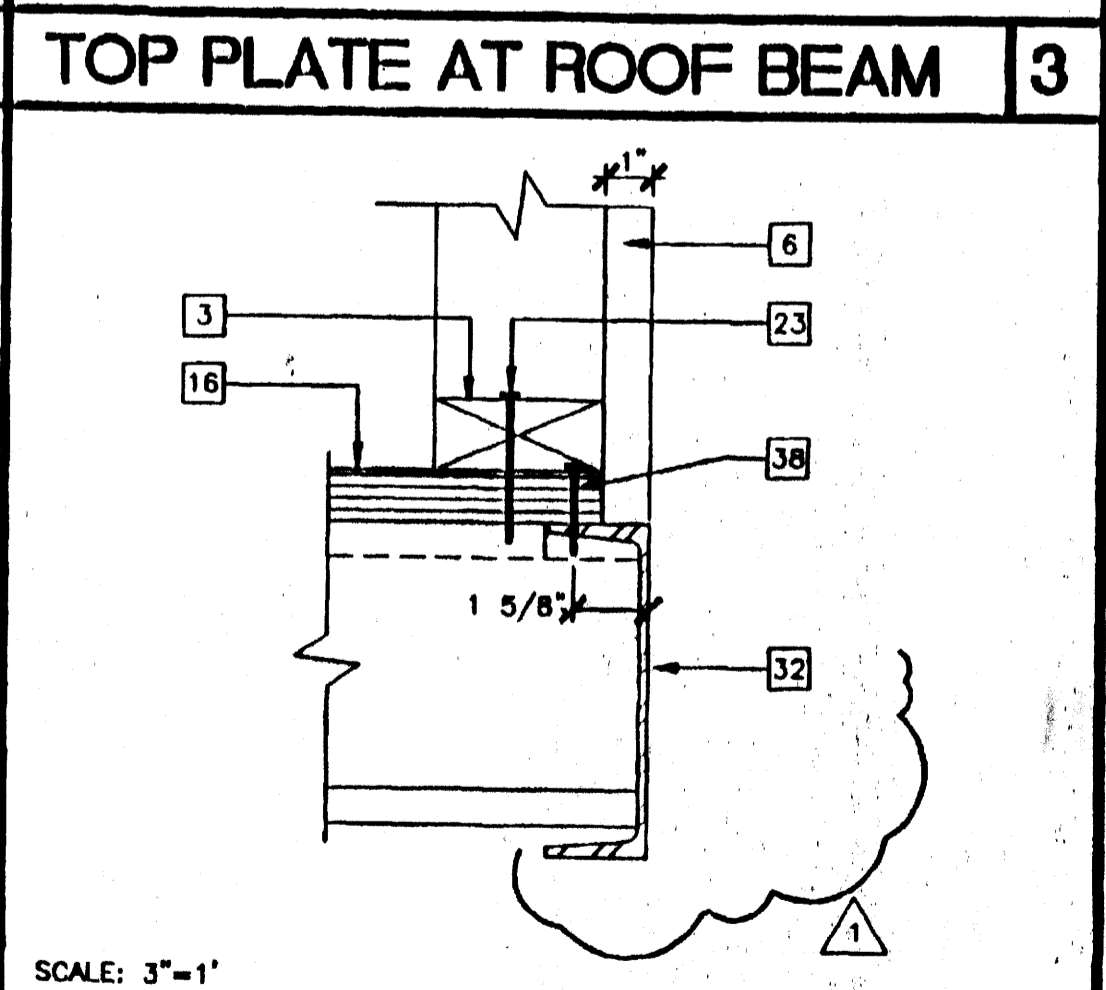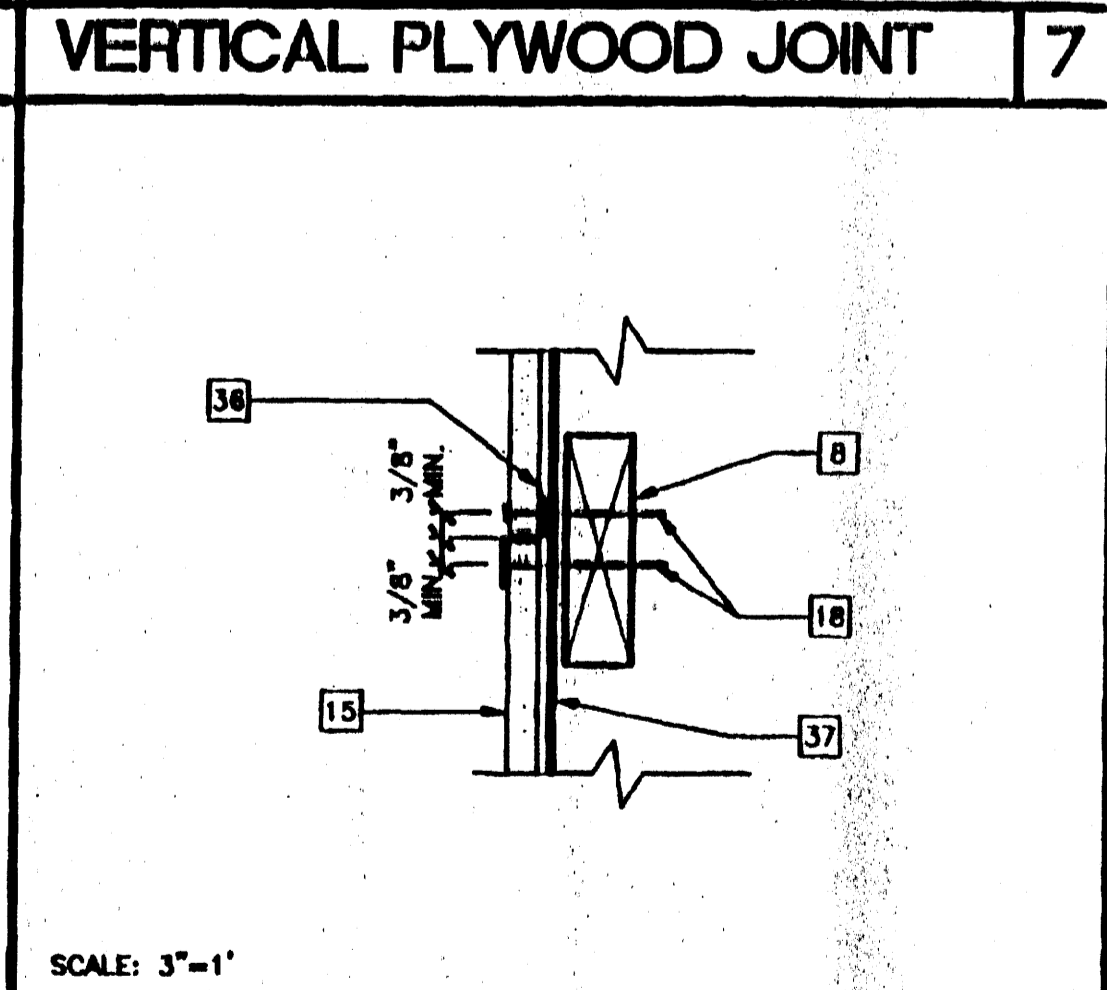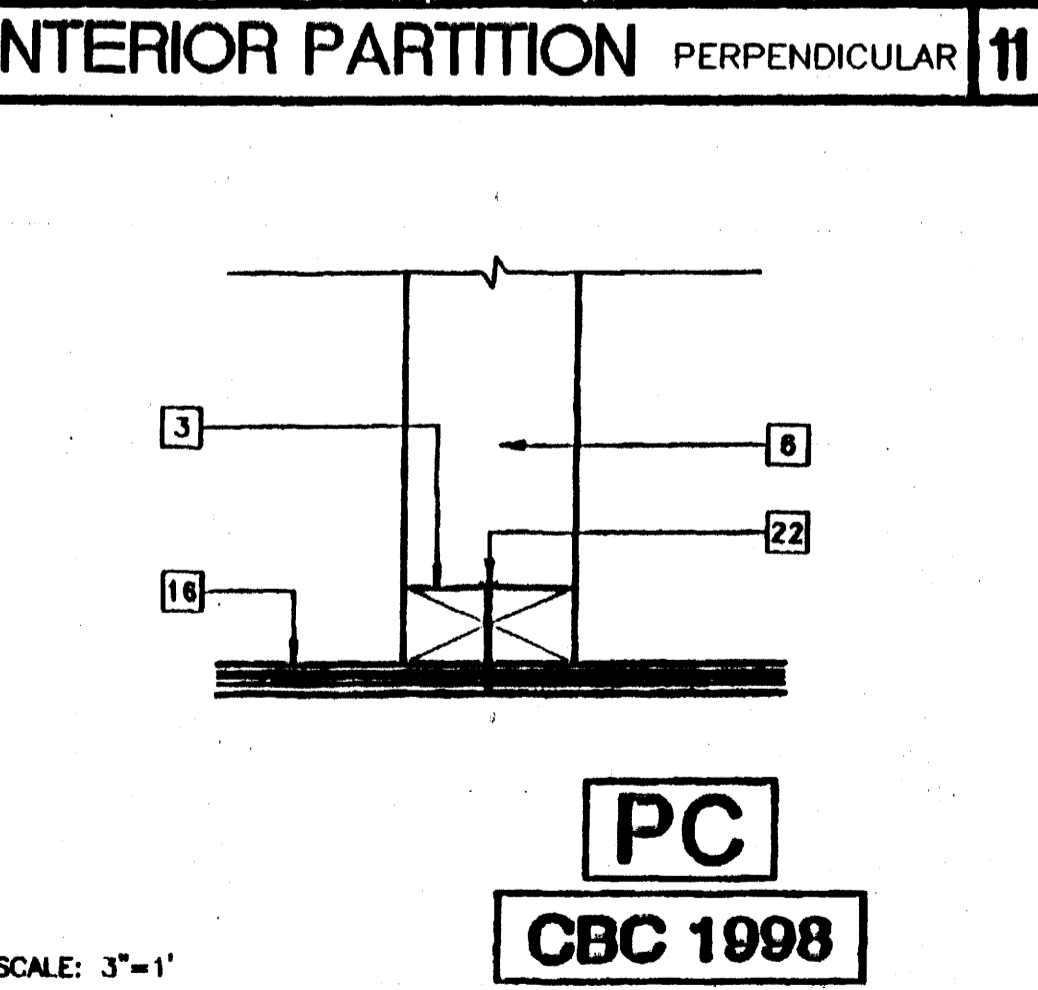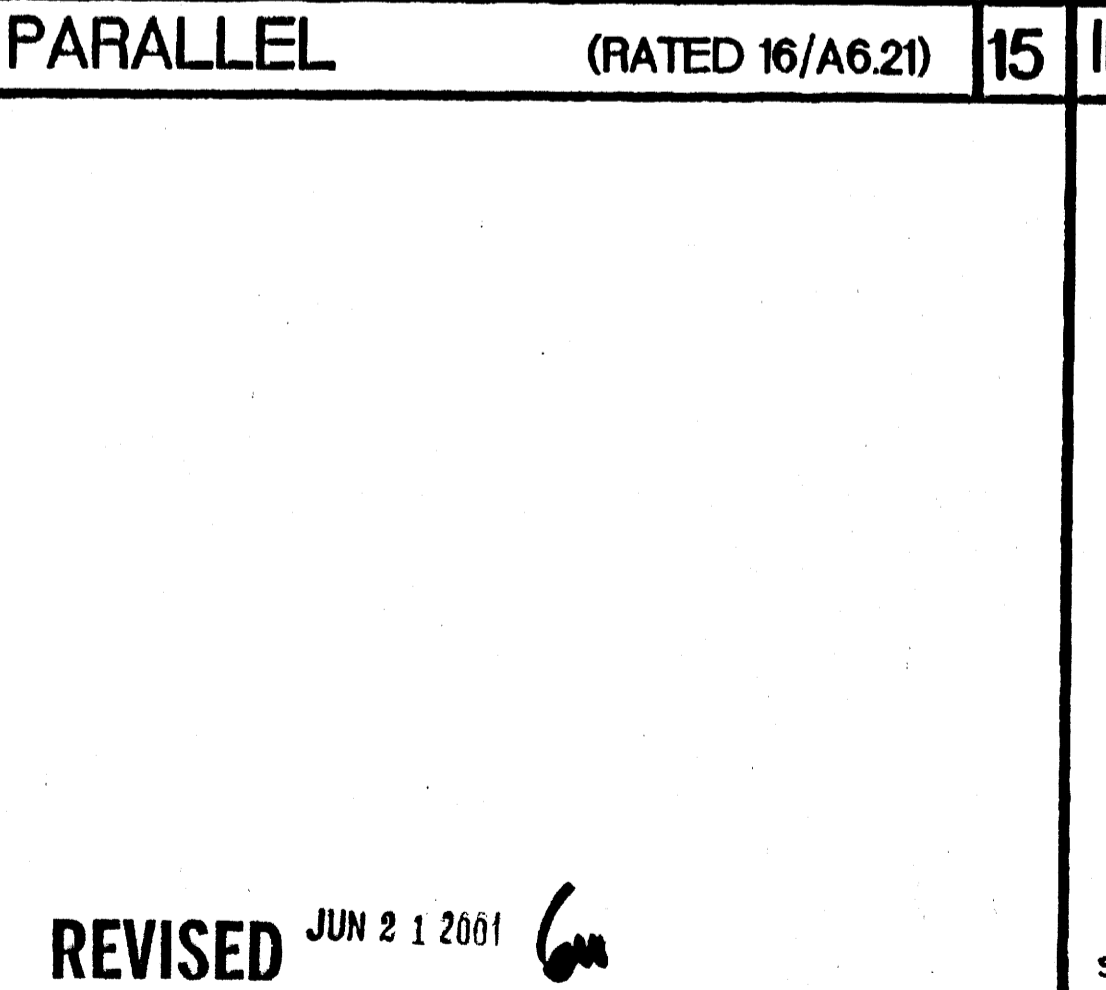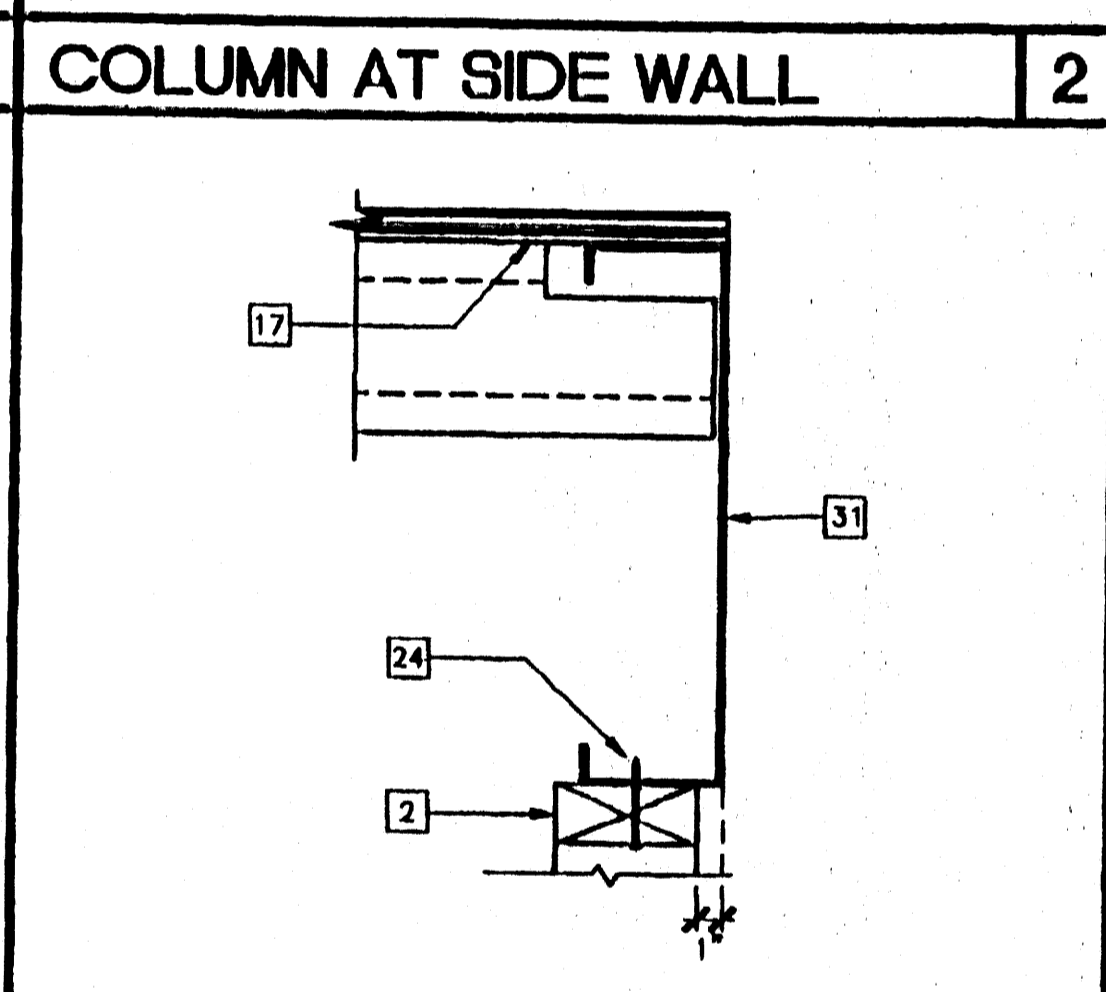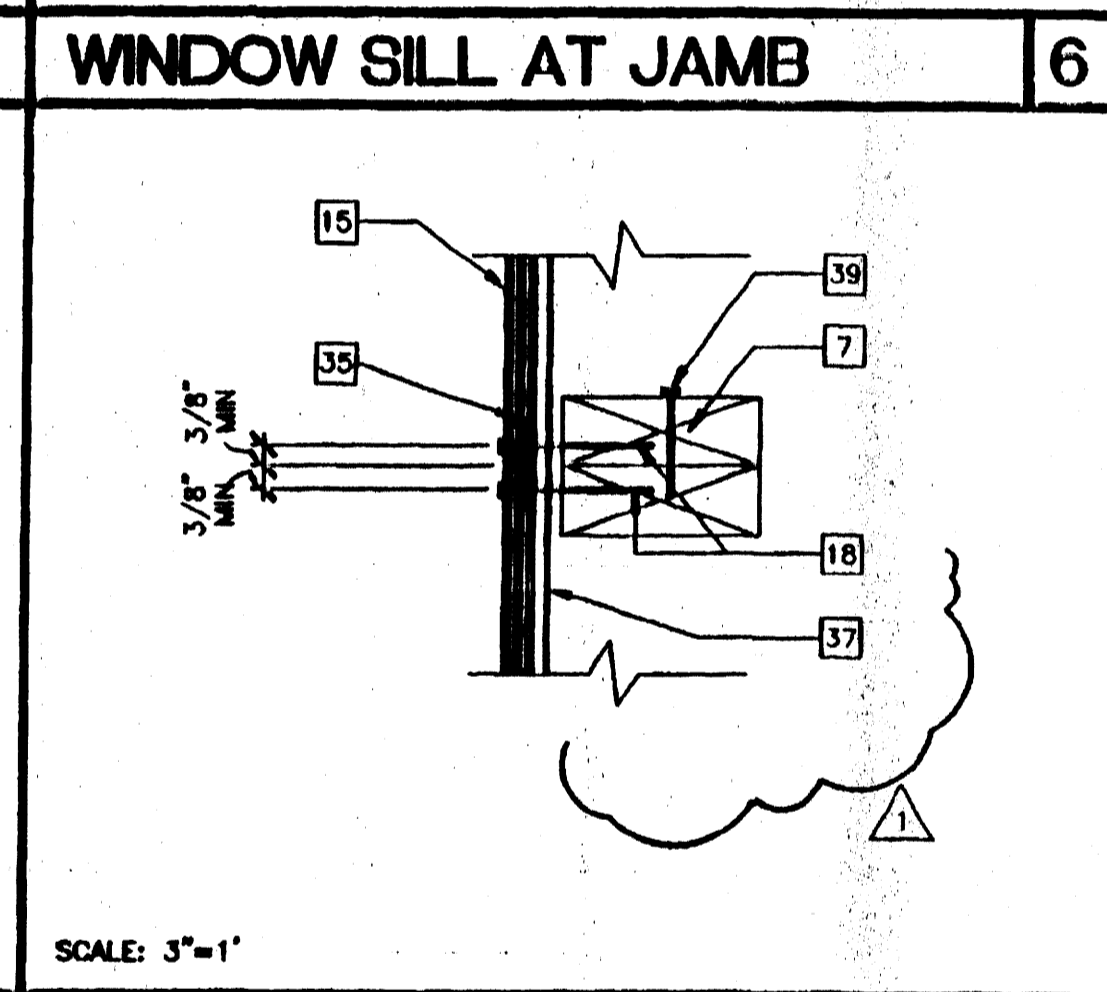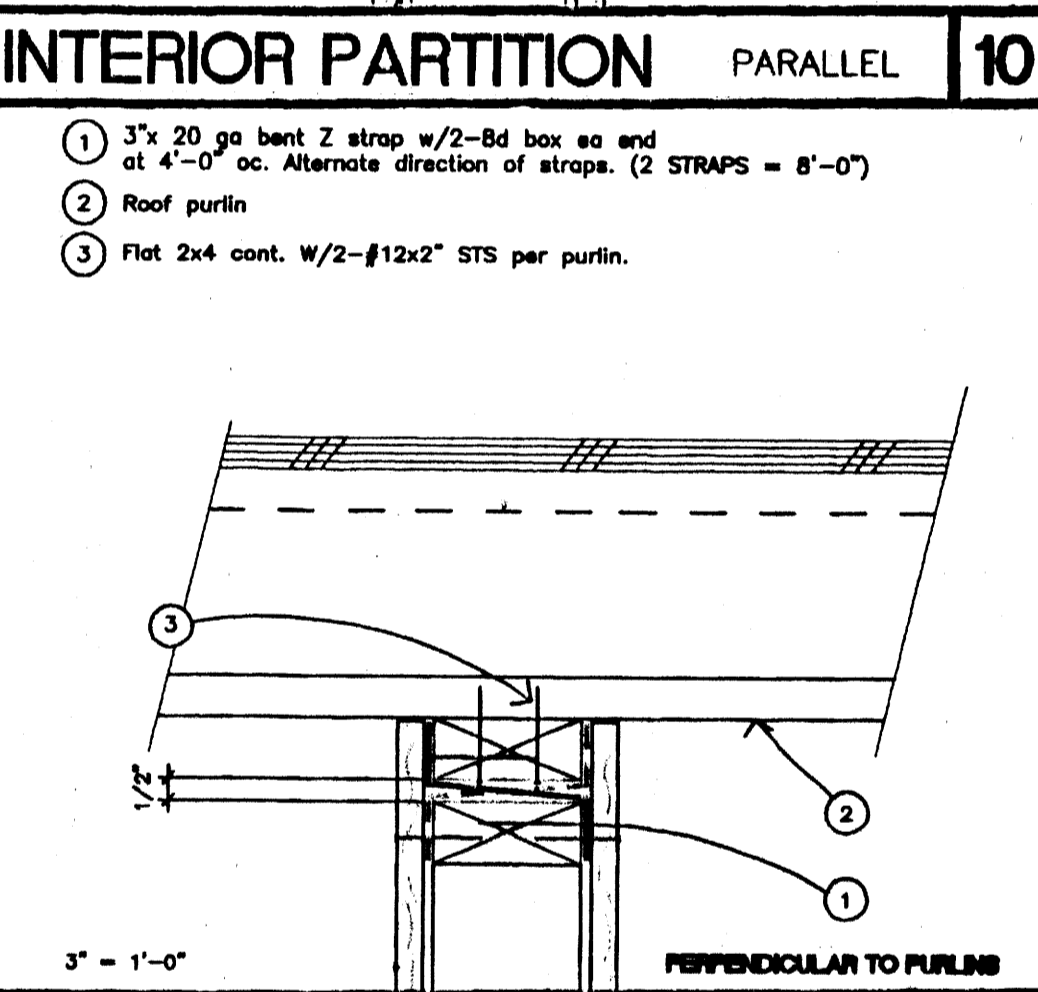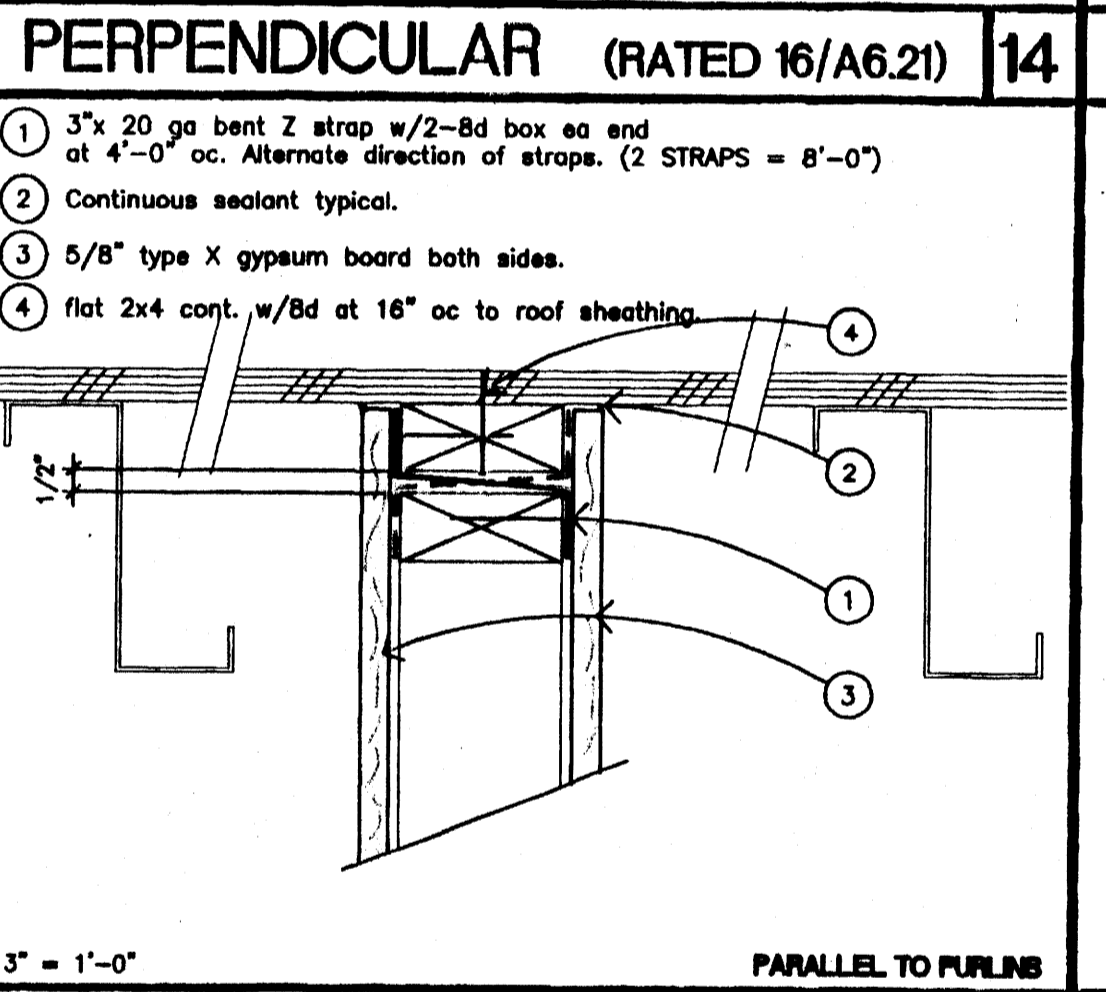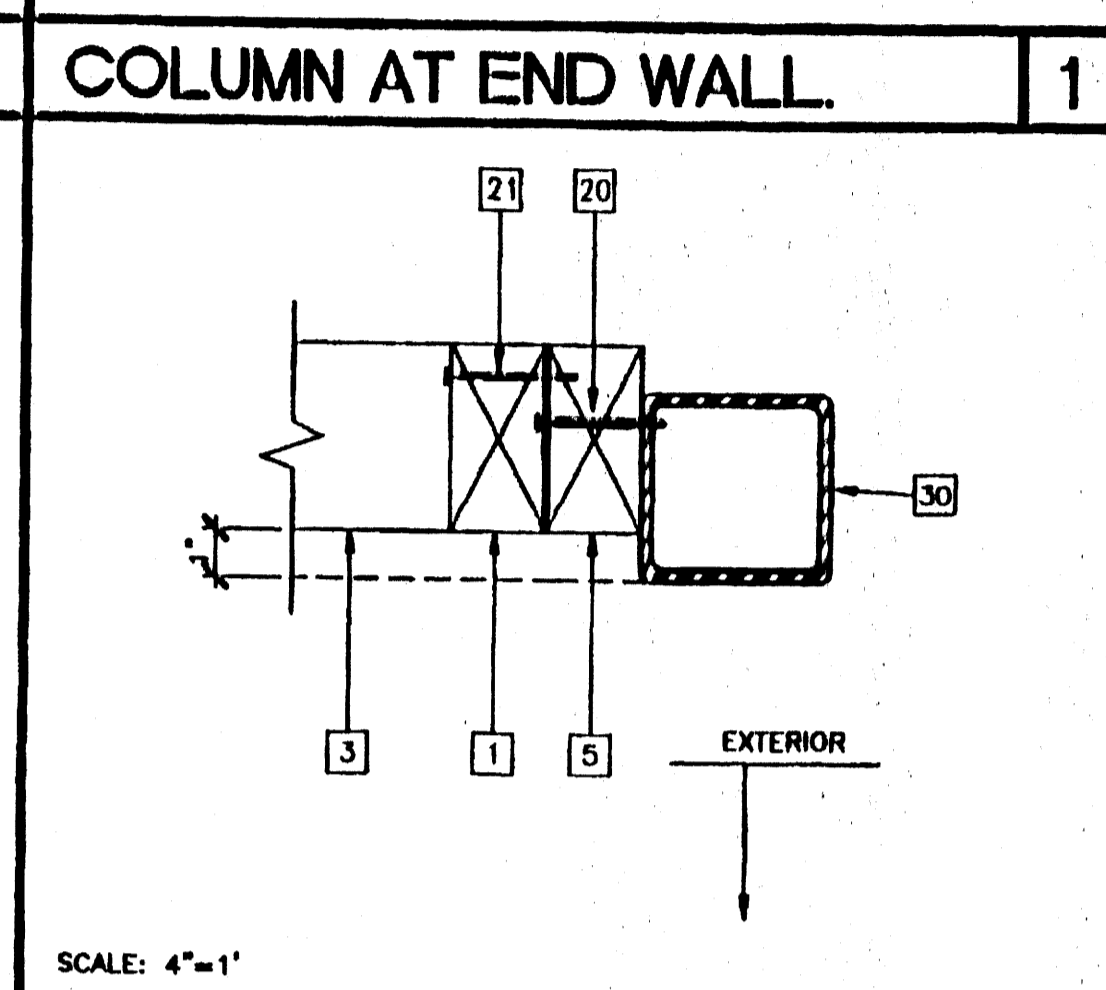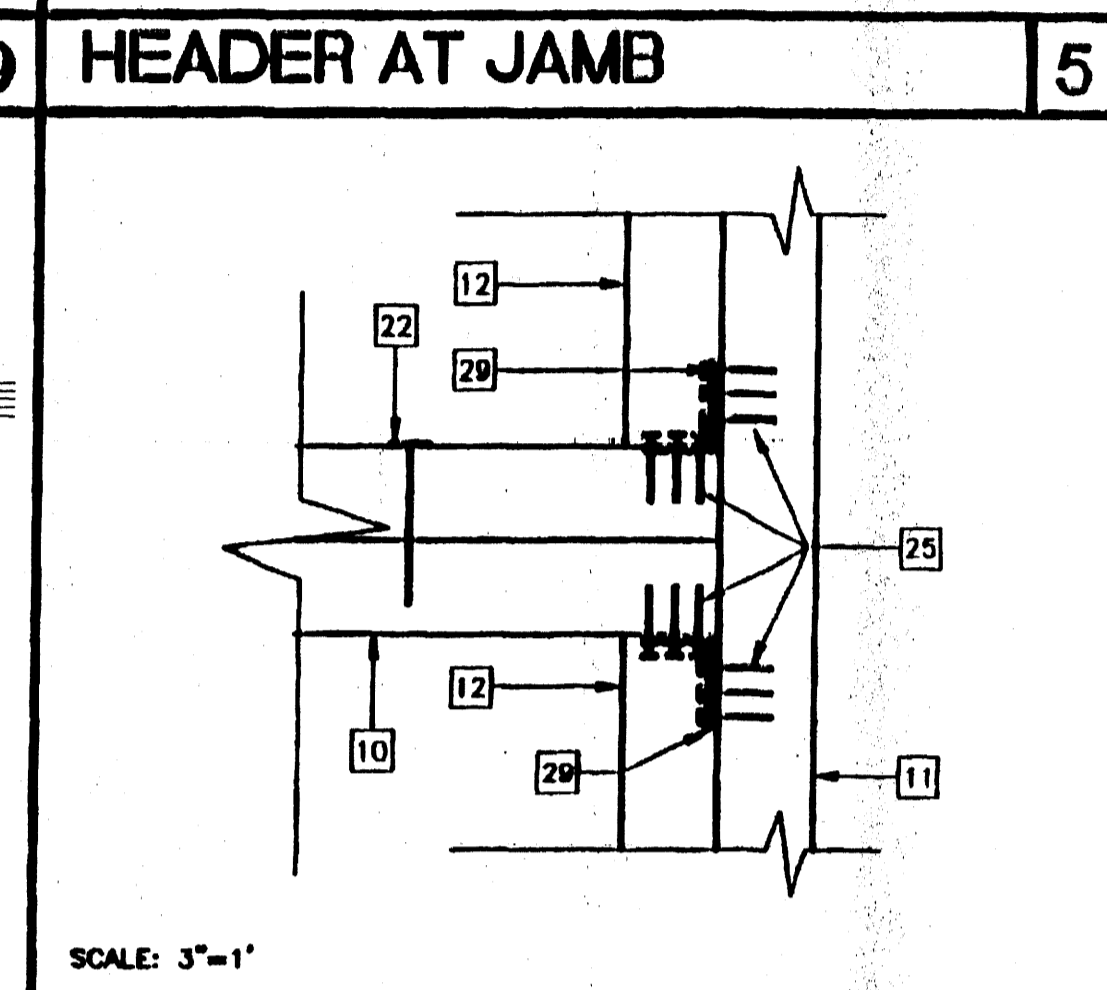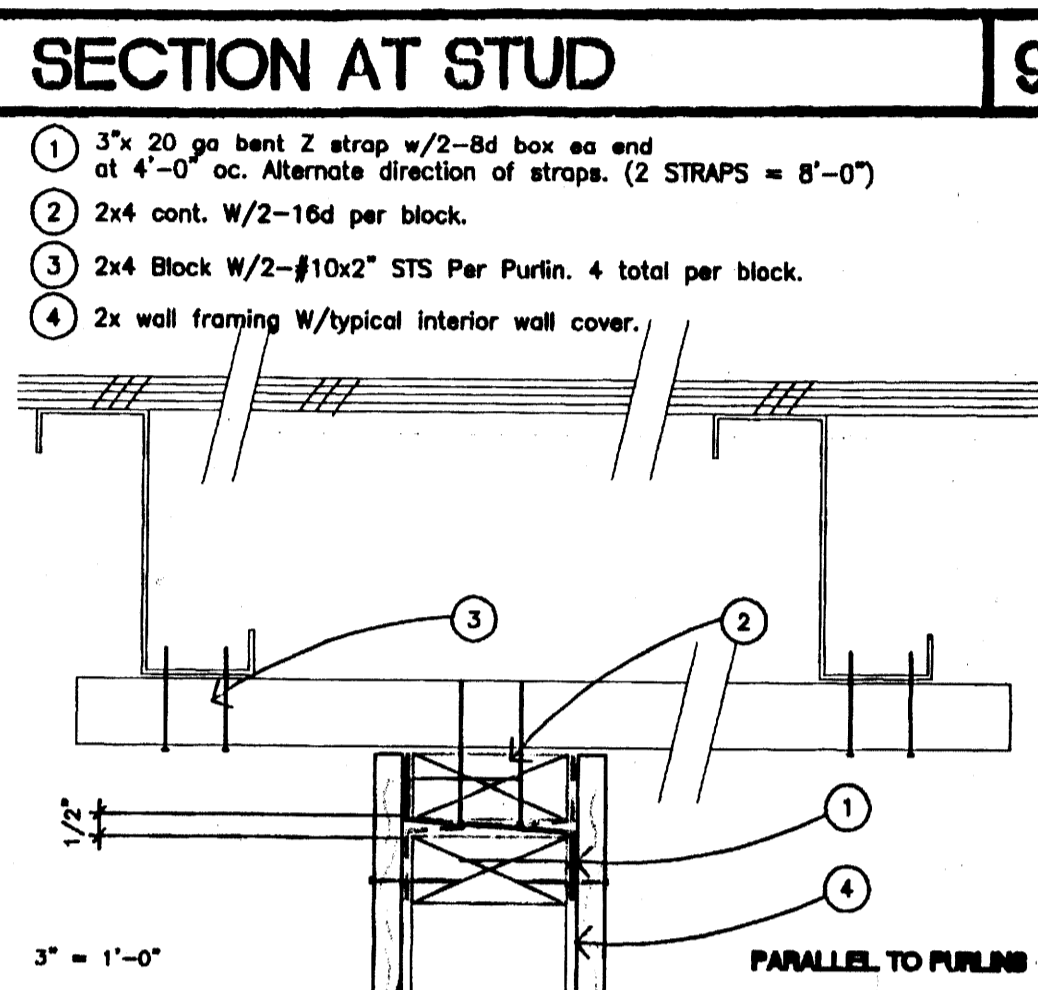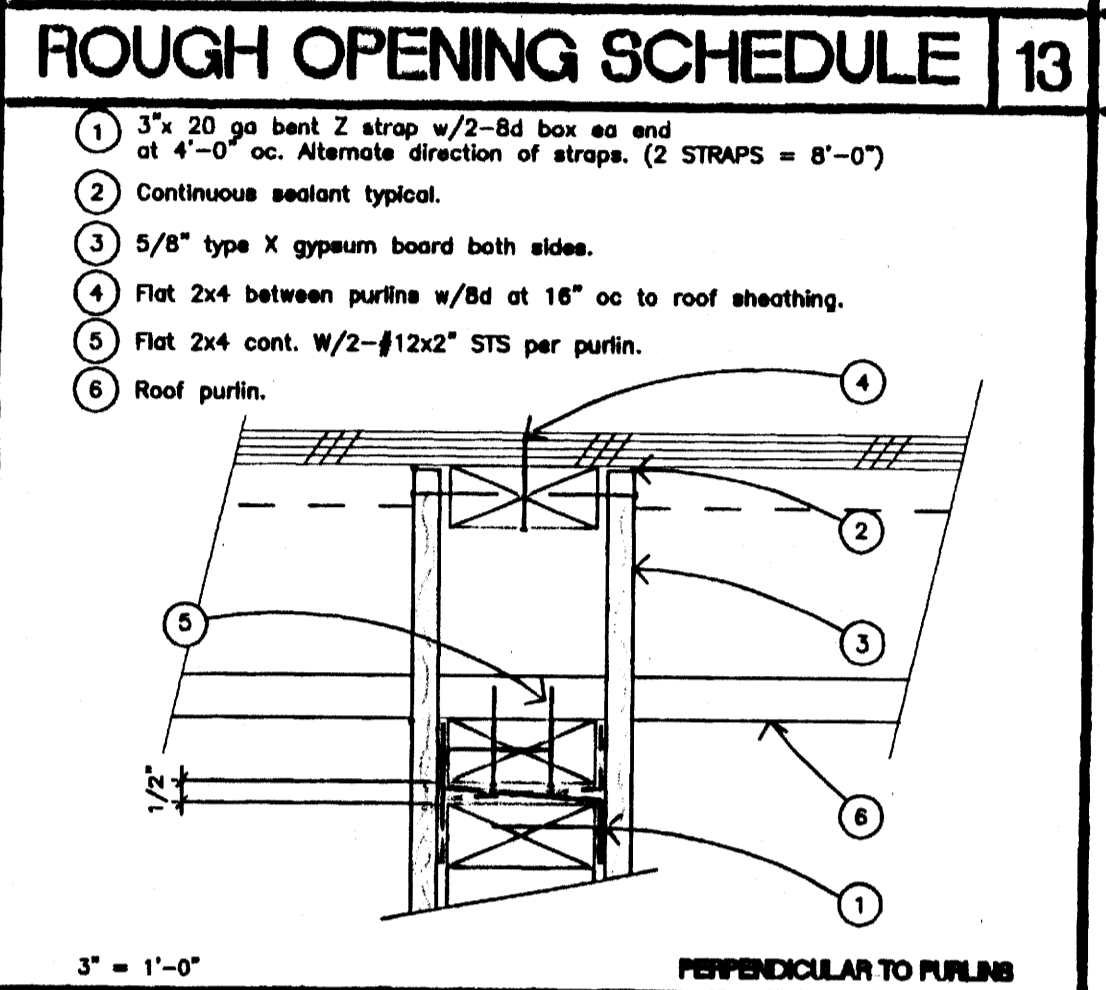

NAILING SCHEDULE

NO.	DESCRIPTION	QUANTITY
1	3"x 20 ga bent Z strap w/2-8d box ea end at 4'-0" oc. Alternate direction of straps. (2 STRAPS = 8'-0")	
2	Continuous sealant typical.	
3	5/8" type X gypsum board both sides.	
4	Flat 2x4 between purlins w/8d at 16" oc to roof sheathing.	
5	Flat 2x4 cont. w/2-#12x2" STS per purlin.	
6	Roof purlin.	

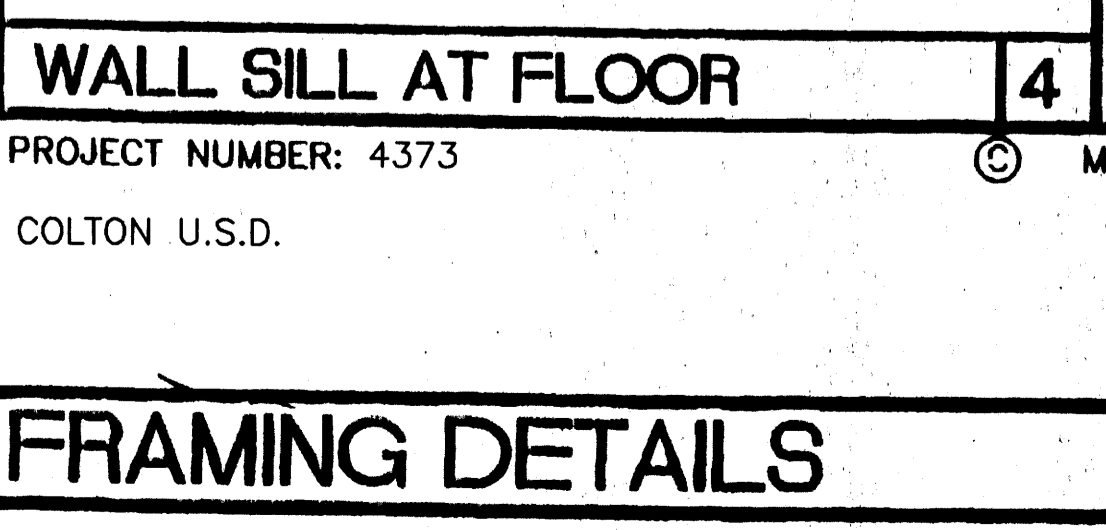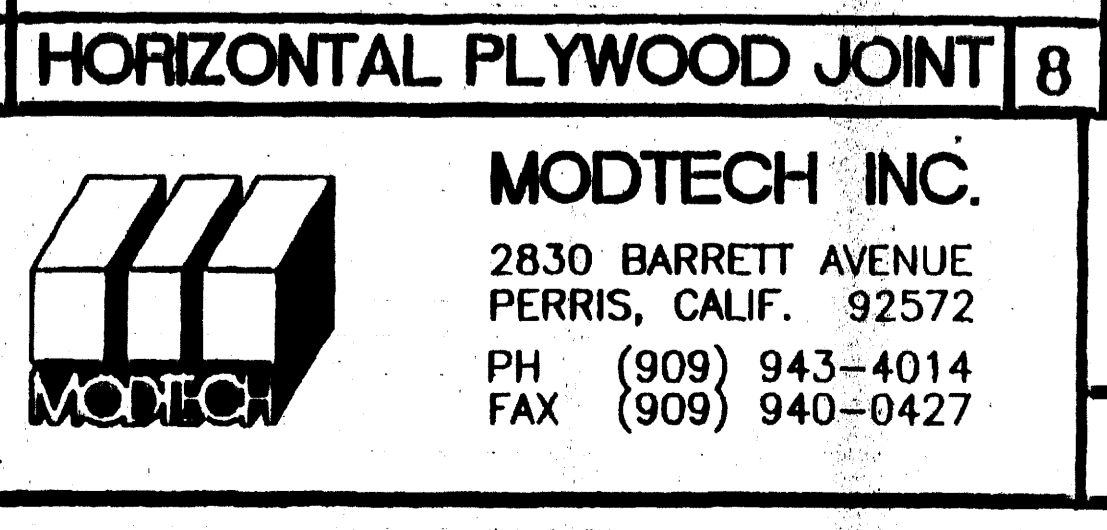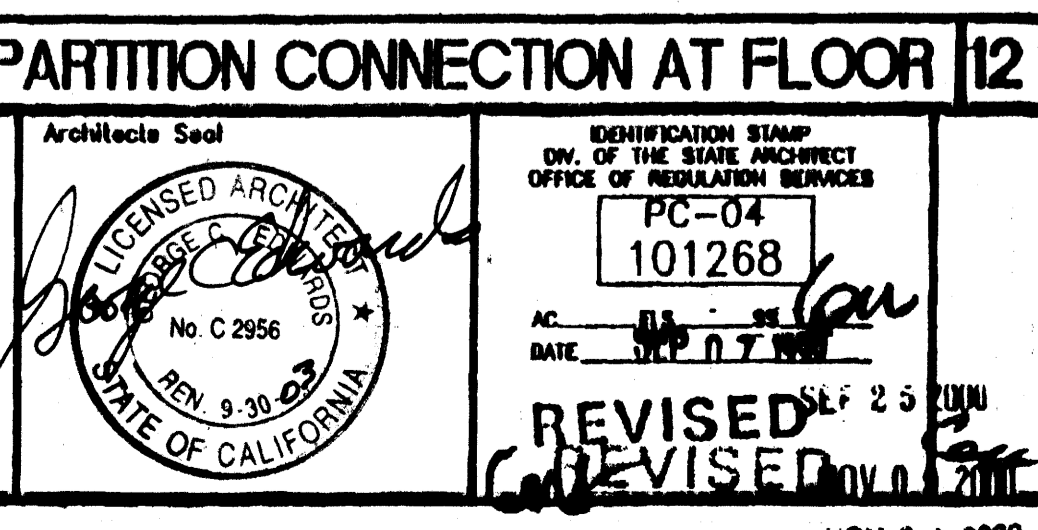

REVISIONS

NO.	DESCRIPTION	DATE
SP	MODTECH ENGINEERING CHANGE	9/21/00
SP	MODTECH ENGINEERING CHANGE	11/9/00
SP	REVISED DETAILS #10, 11	11/22/00

REVISIONS JUN 21 2001

PC
CBC 1998

MODTECH INC.
2830 BARRETT AVENUE
PERRIS, CALIF. 92572
PH (909) 943-4014
FAX (909) 940-0427

PROJECT NUMBER: 4373
COLTON U.S.D.

MODTECH, INC. 2002
DRAWN BY: KK
DATE: 11/19/02
CHECKED BY: STKP-67
DATE: 4/12-124