


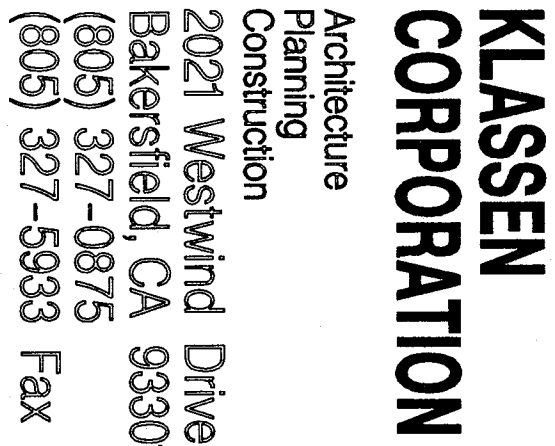

BAKERSFIELD, CA.

Sheet title:
INTERIOR ELEVATIONS - 'C'

Date:		Revisions:	
10-94	A	AS BUILT'S	

Drawn by: done

Job no: 1223


Dgn. file: mmo9_2d

Sheet:

A.09

Sheet of: 30

Date: March 8, 1993

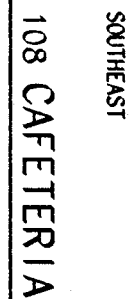[illegible]OFFICE OF THE STATE ARCHIVIST
ACCESS ONLINE: www.ohiohistorycentral.org