



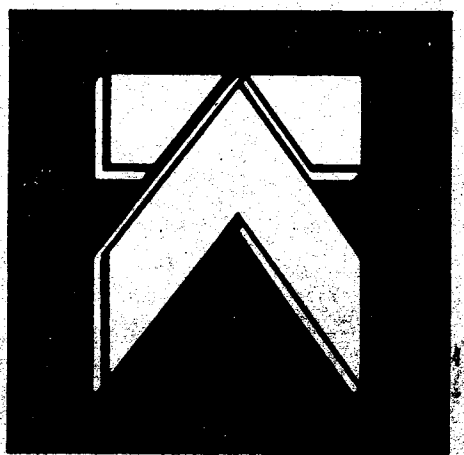

KLASSEN CORPORATION
Architect
Planning
Construction
2021 Westwind Drive
Bakersfield, CA 93301
(805) 327-0875
(805) 327-9393 FAX

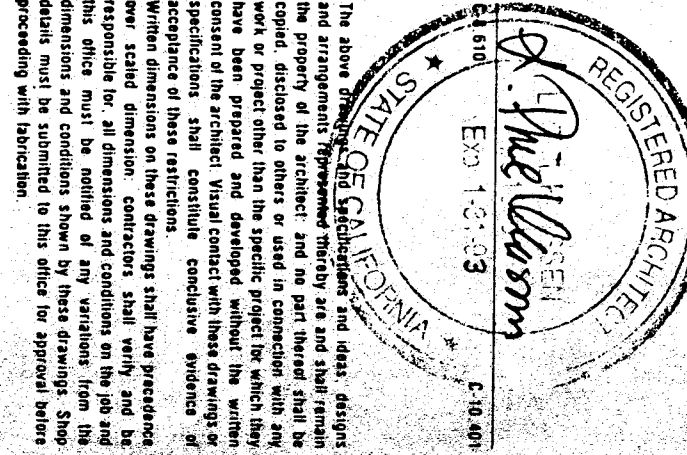

BAKERSFIELD CITY SCHOOL DISTRICT
MESA MARIN ELEMENTARY SCHOOL

Sheet title: **CAFETERIA SECTIONS**

JEWETT STREET
BAKERSFIELD, CALIFORNIA

WALTER A. KUNER
STRUCTURAL ENGINEER
1710 OAK STREET
BAKERSFIELD, CALIFORNIA 93301
PH (805) 324-2414
FAX (805) 324-2414

Date	Issued for:

Date	Revisions:
7-2-93	ADD #4, Item 2
10-94	AS BUILT

