




01 COURTYARD CIRCLE 3/16" = 1'-0"

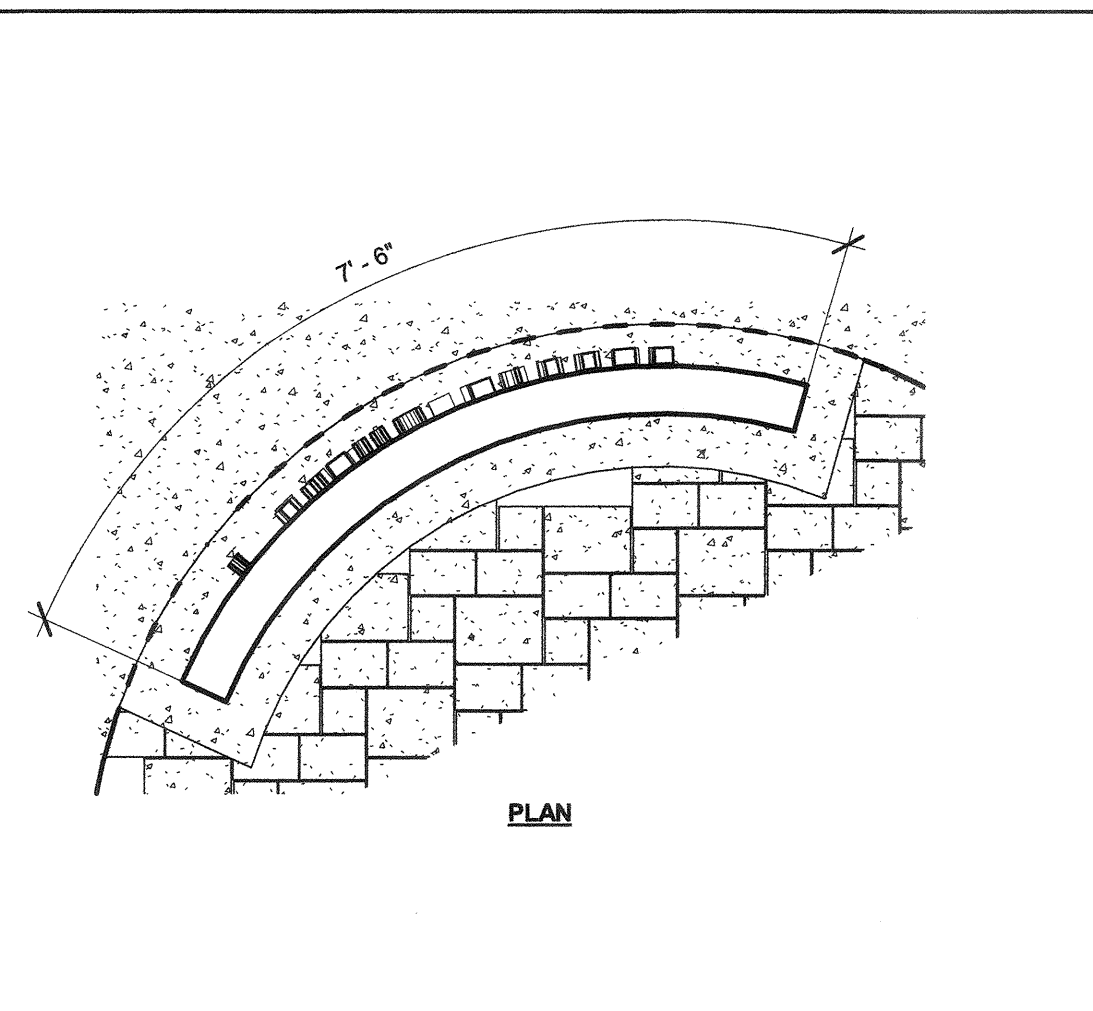


02 MARQUEE SIGN 1/2" = 1'-0"

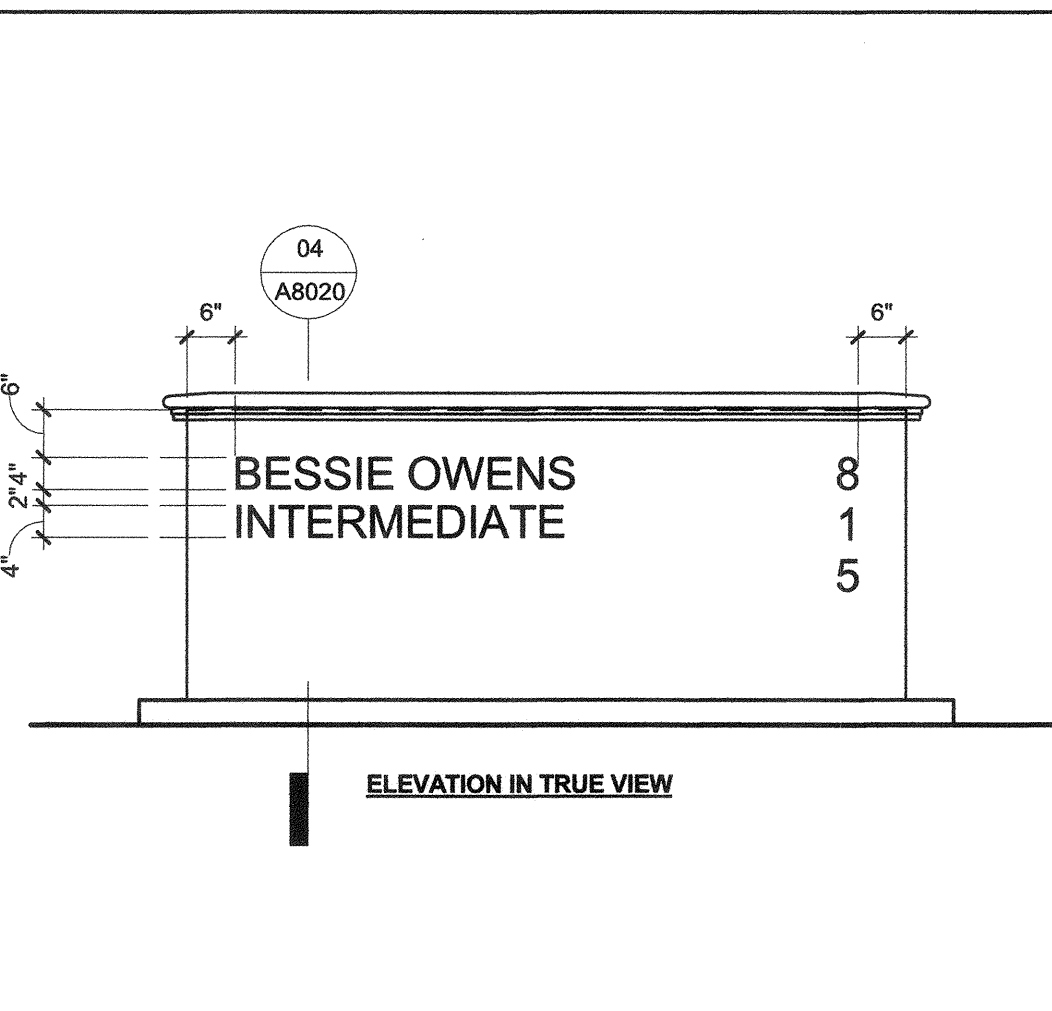


04 MARQUEE SIGN 1" = 1'-0"

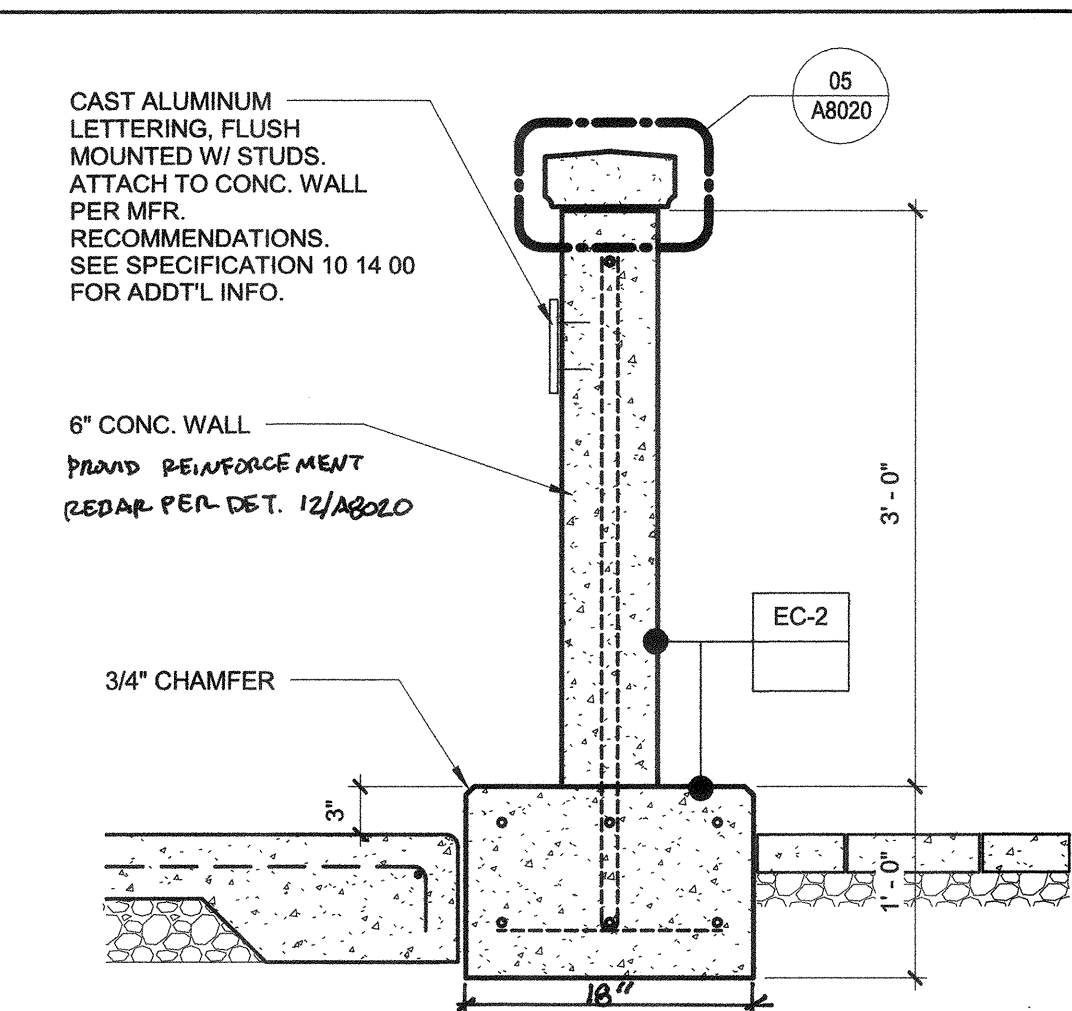


05 WALL CAP 3" = 1'-0"

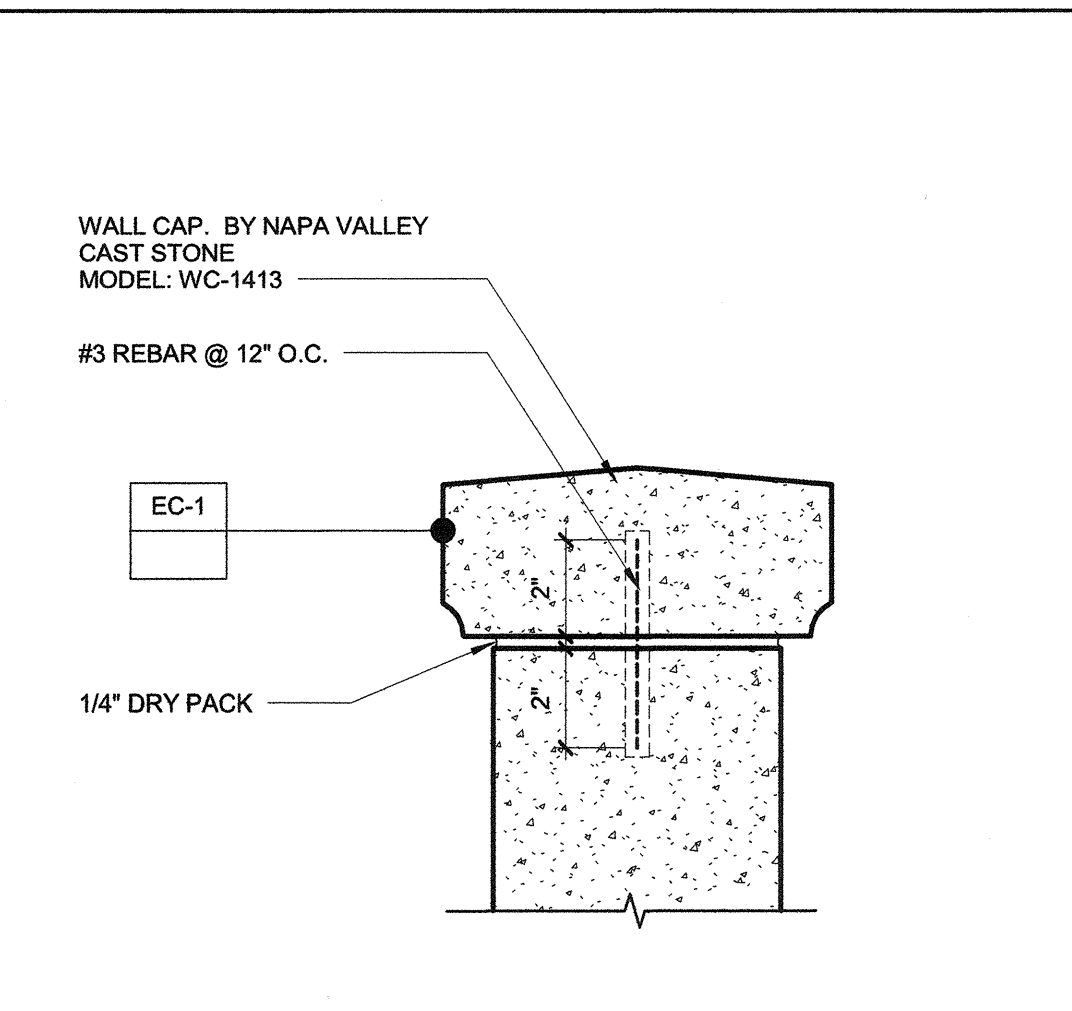


05 WALL CAP 3" = 1'-0"

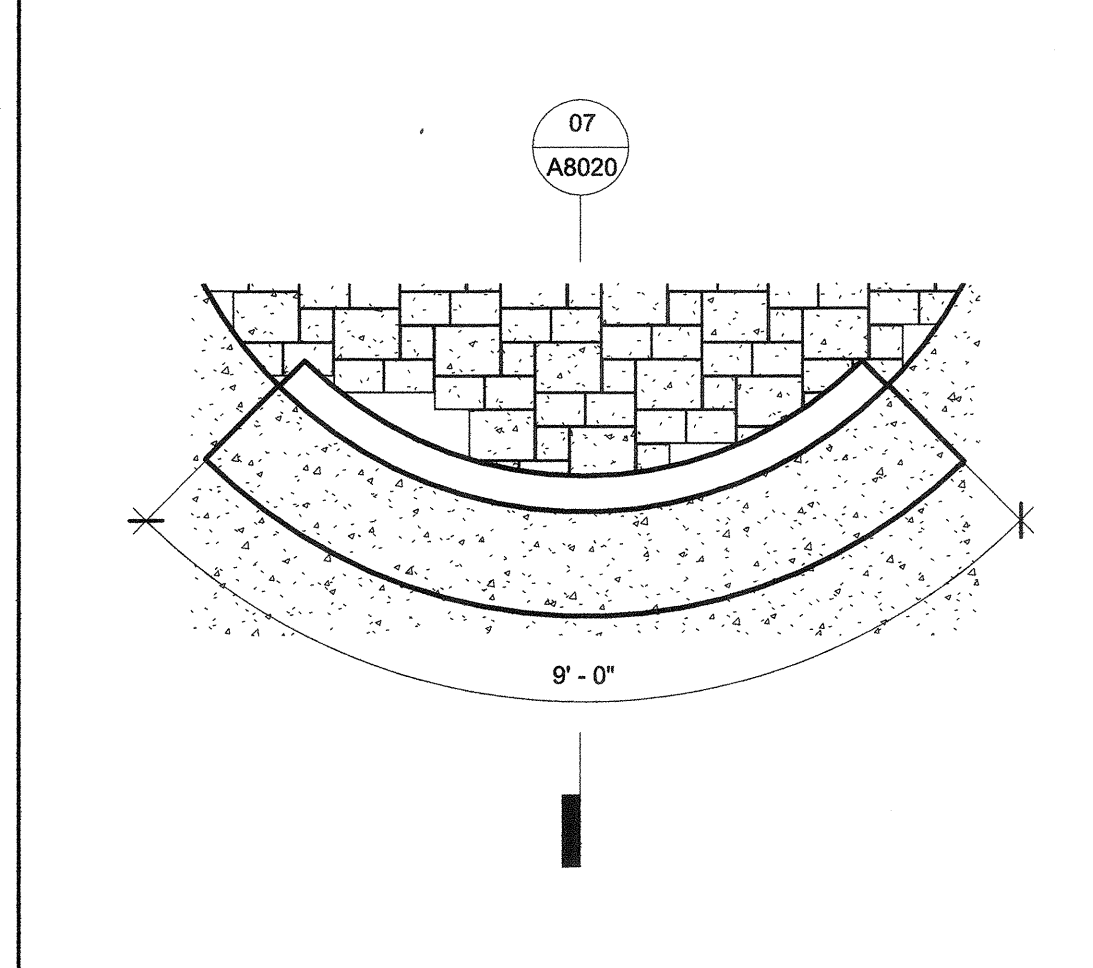


06 CURVED SEATING 3/8" = 1'-0"

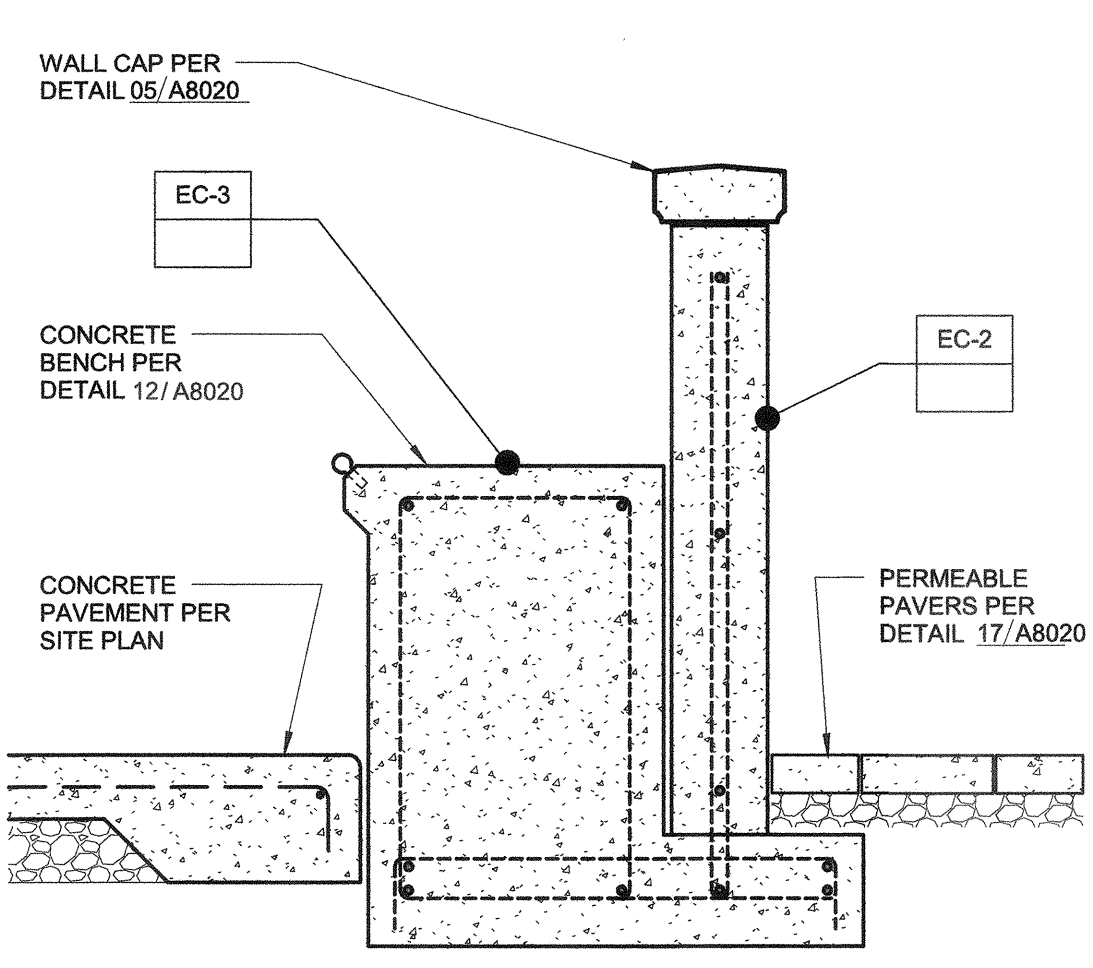


07 CONCRETE BENCH 1" = 1'-0"

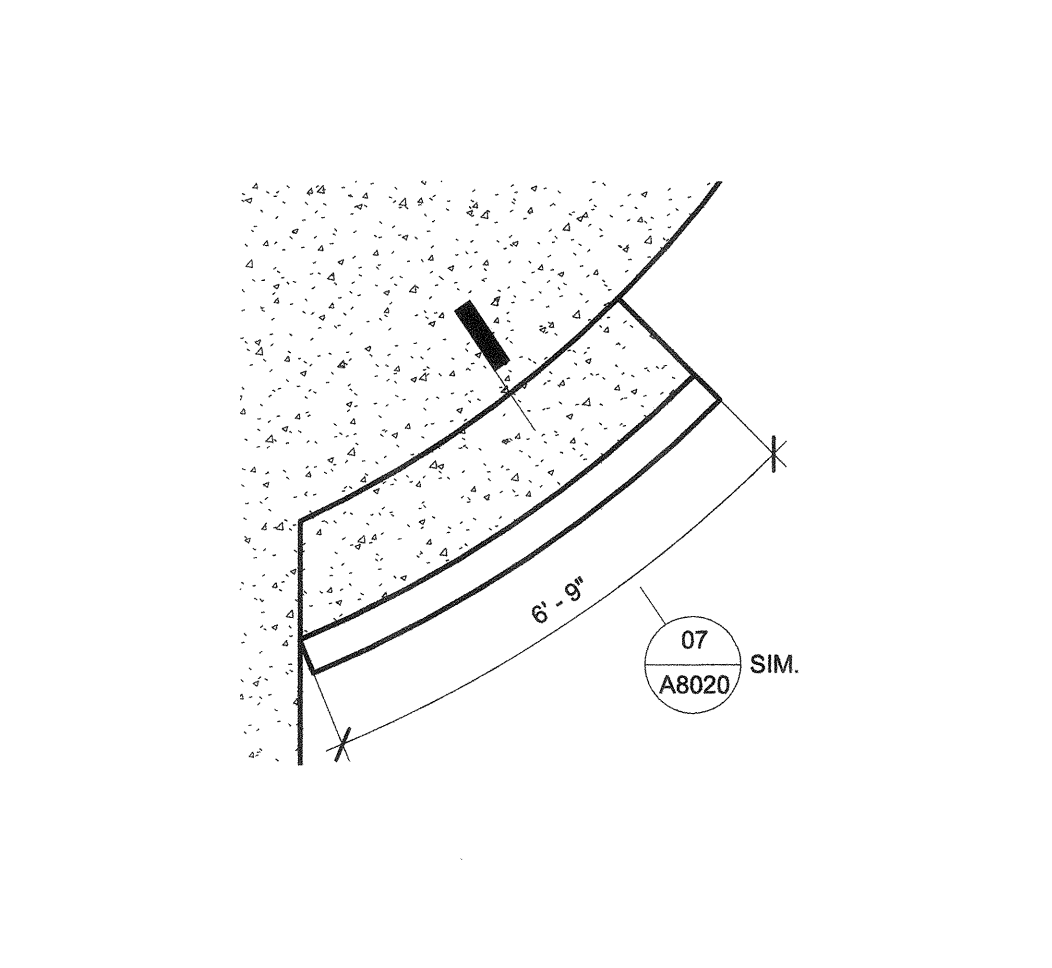


08 CURVED SEATING 3/8" = 1'-0"

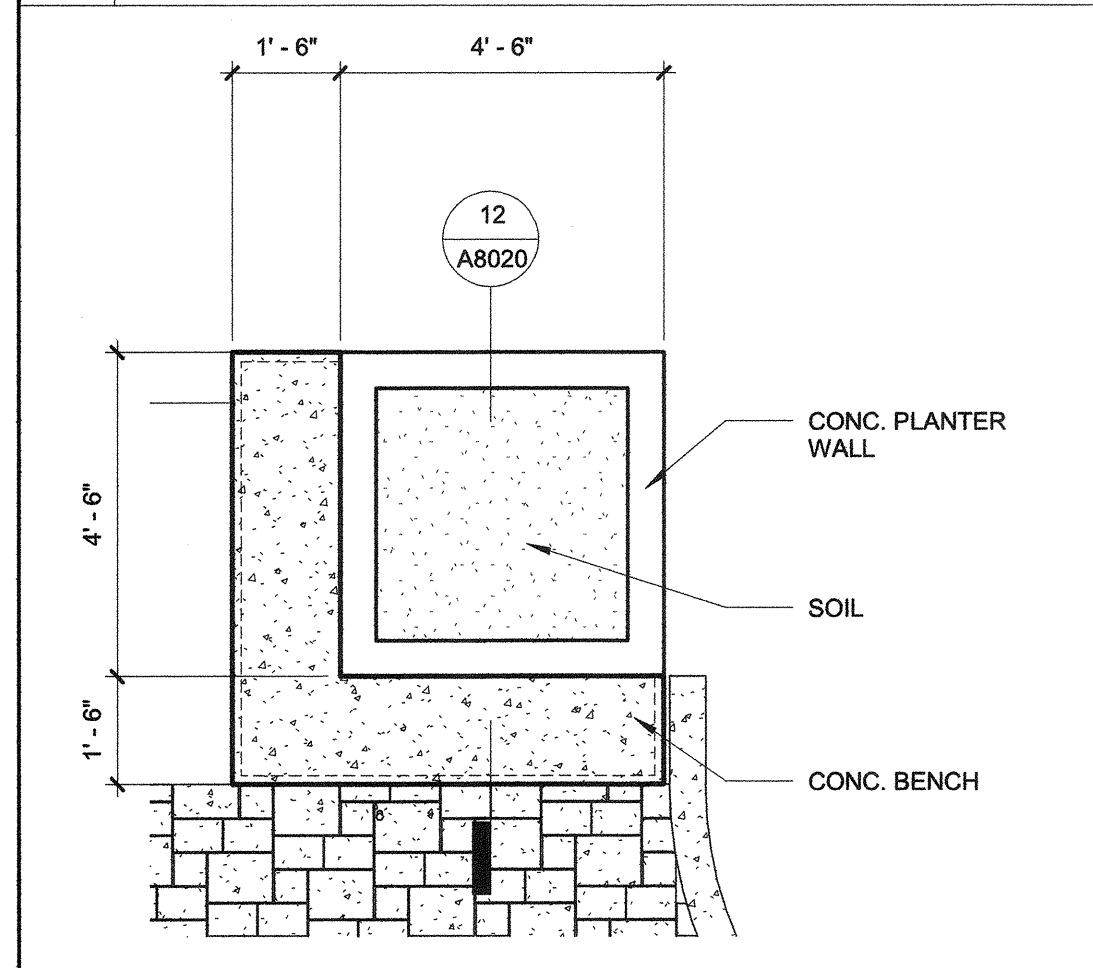


11 PLANTER / SEATING 3/8" = 1'-0"

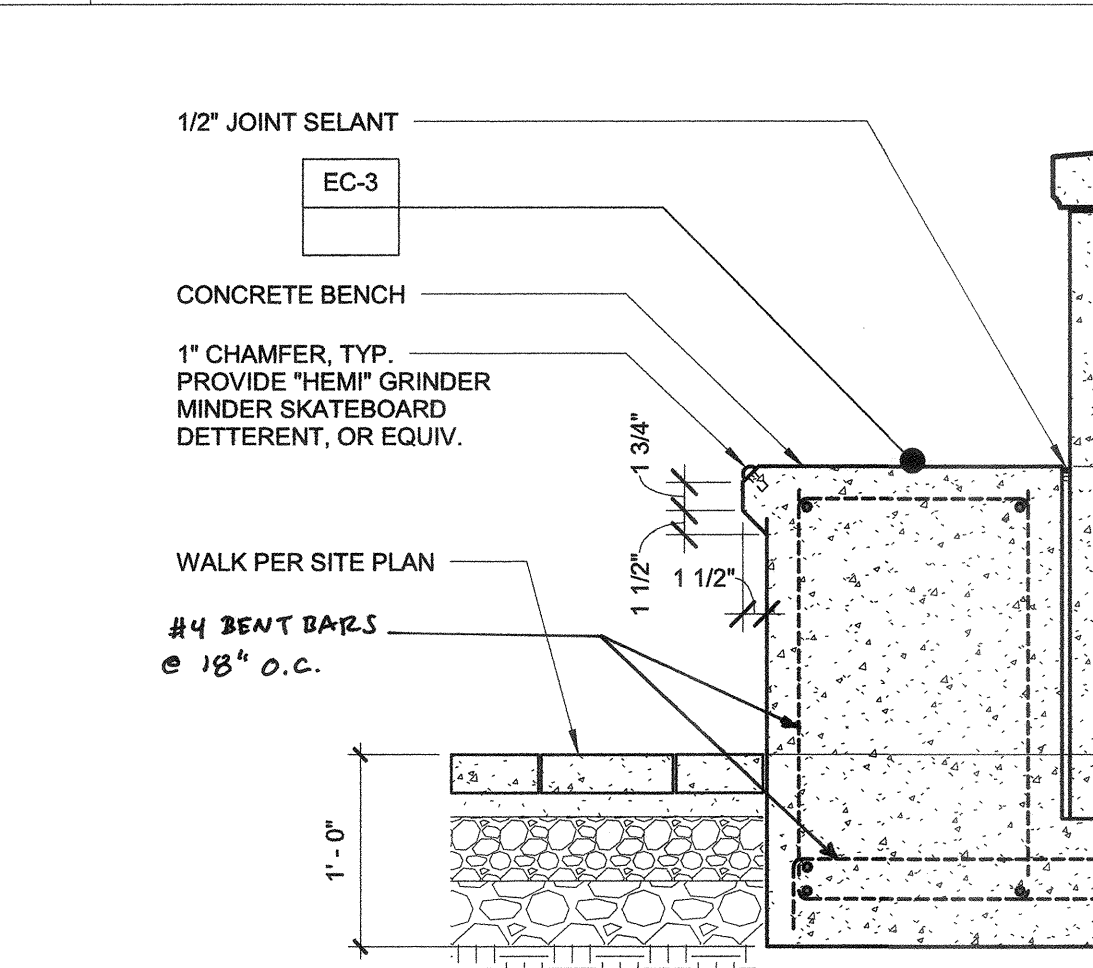


12 CONCRETE BENCH 1" = 1'-0"

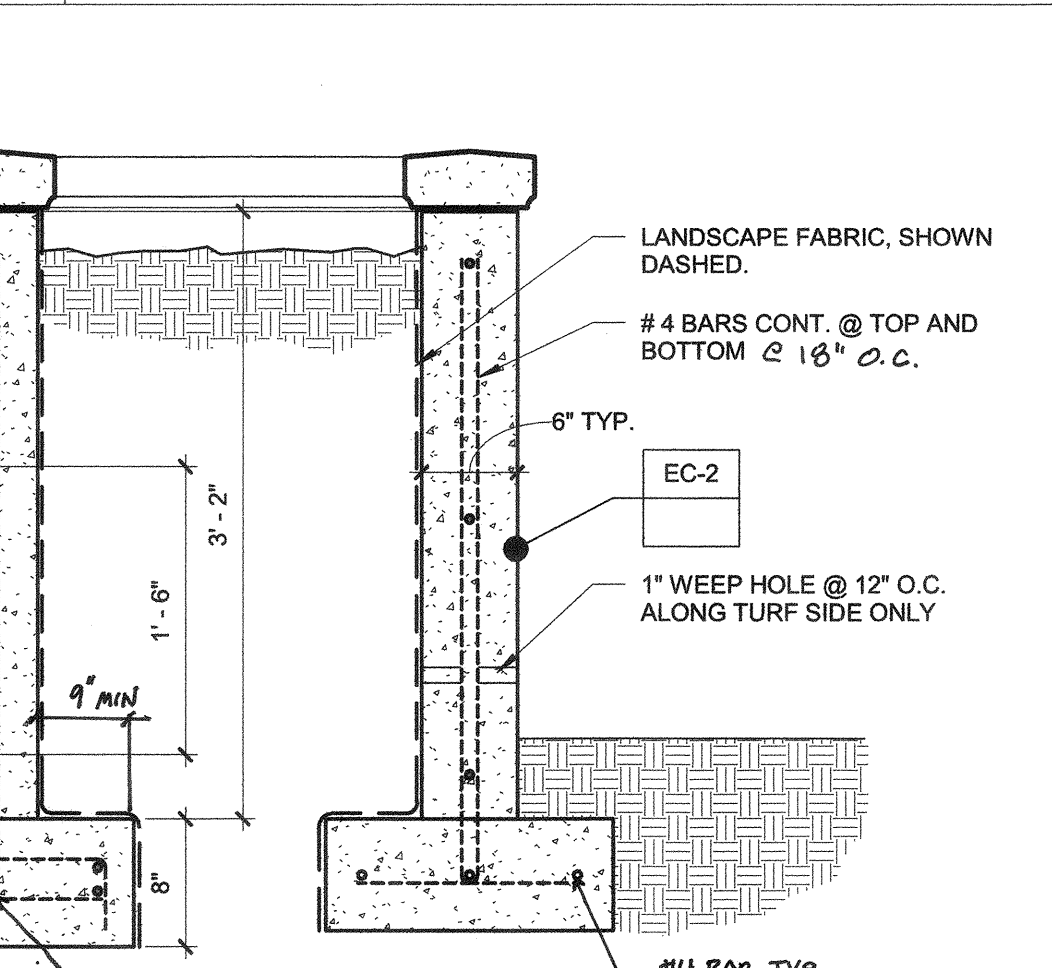


12 CONCRETE BENCH 1" = 1'-0"

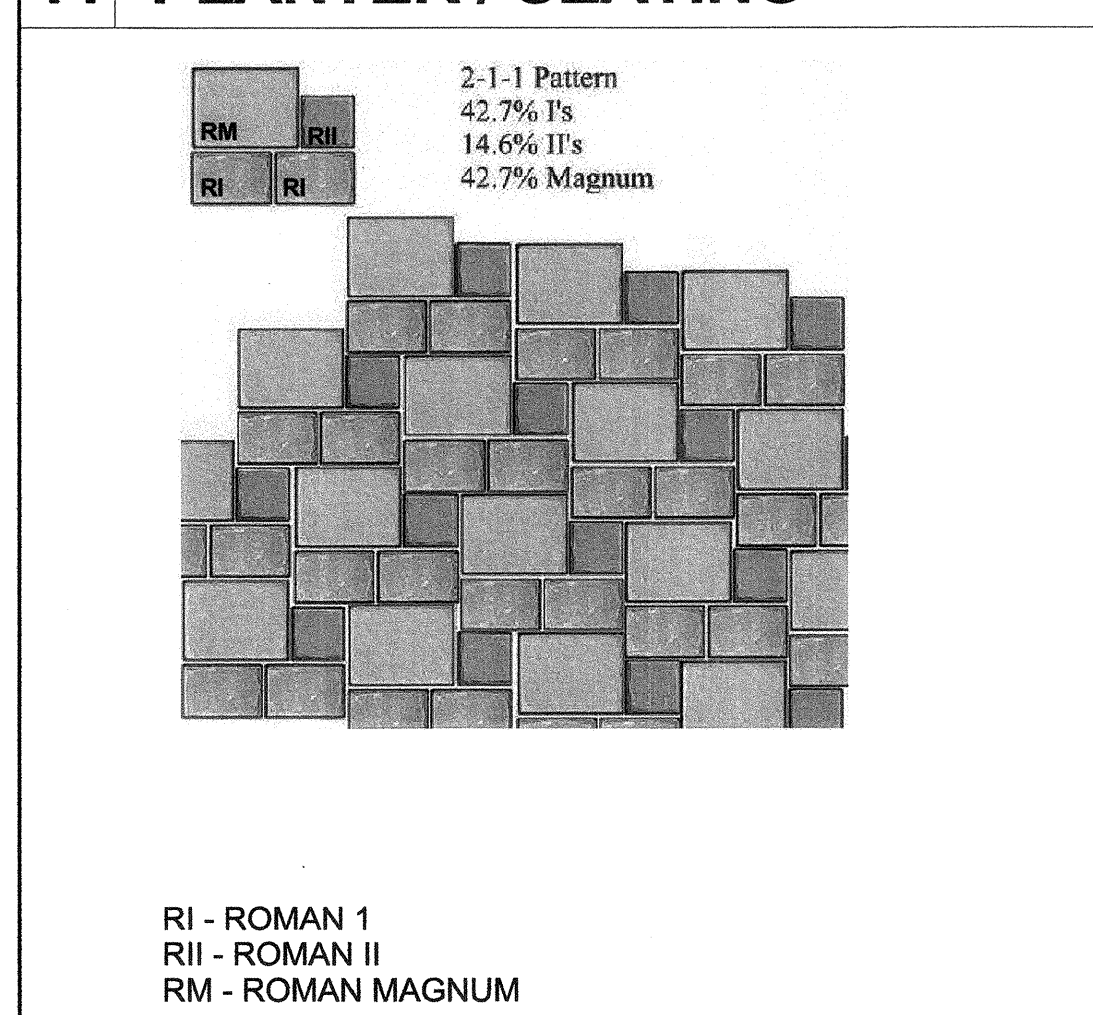


16 PAVER PATTERN 12" = 1'-0"

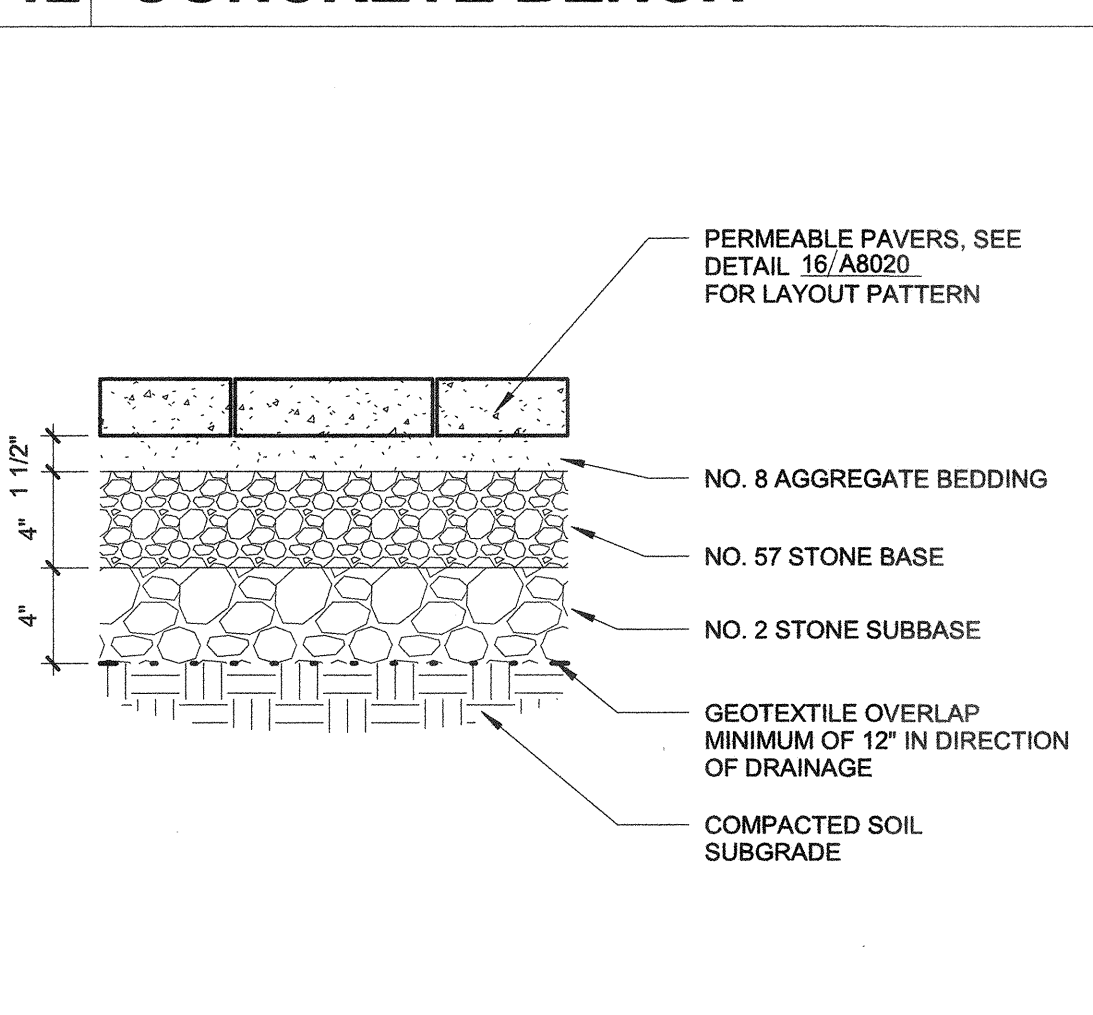


17 PAVER SECTION 1 1/2" = 1'-0"

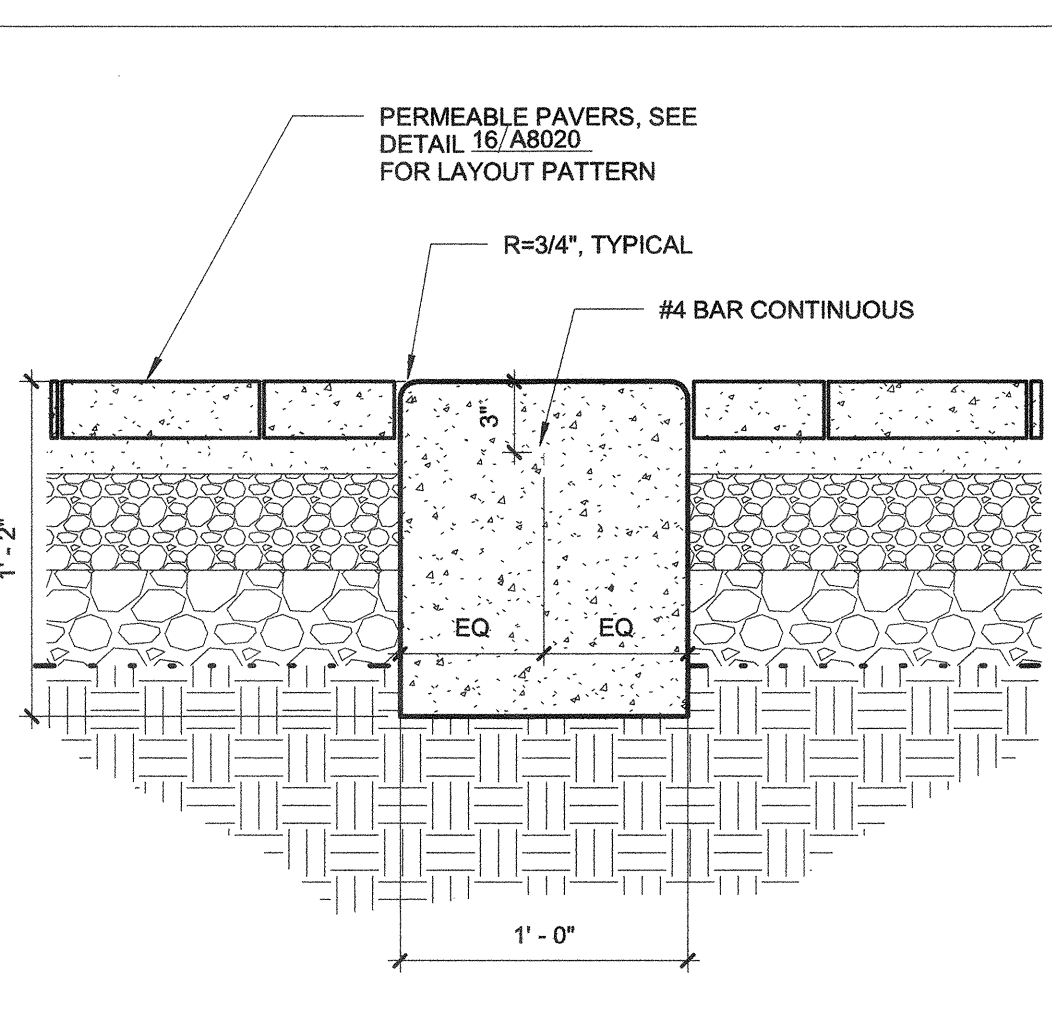

18 CONCRETE @ PAVERS 1 1/2" = 1'-0"

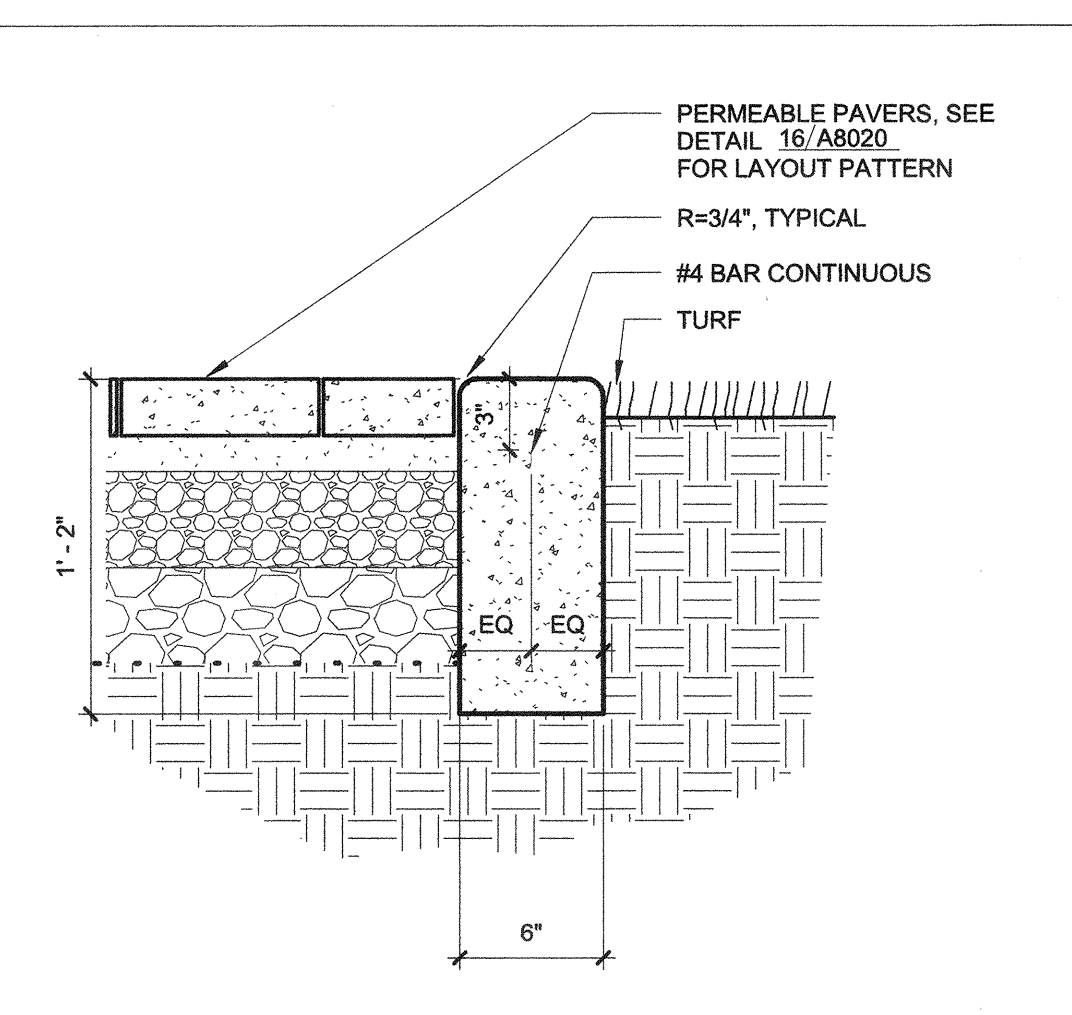

19 CONCRETE @ PAVERS 1 1/2" = 1'-0"

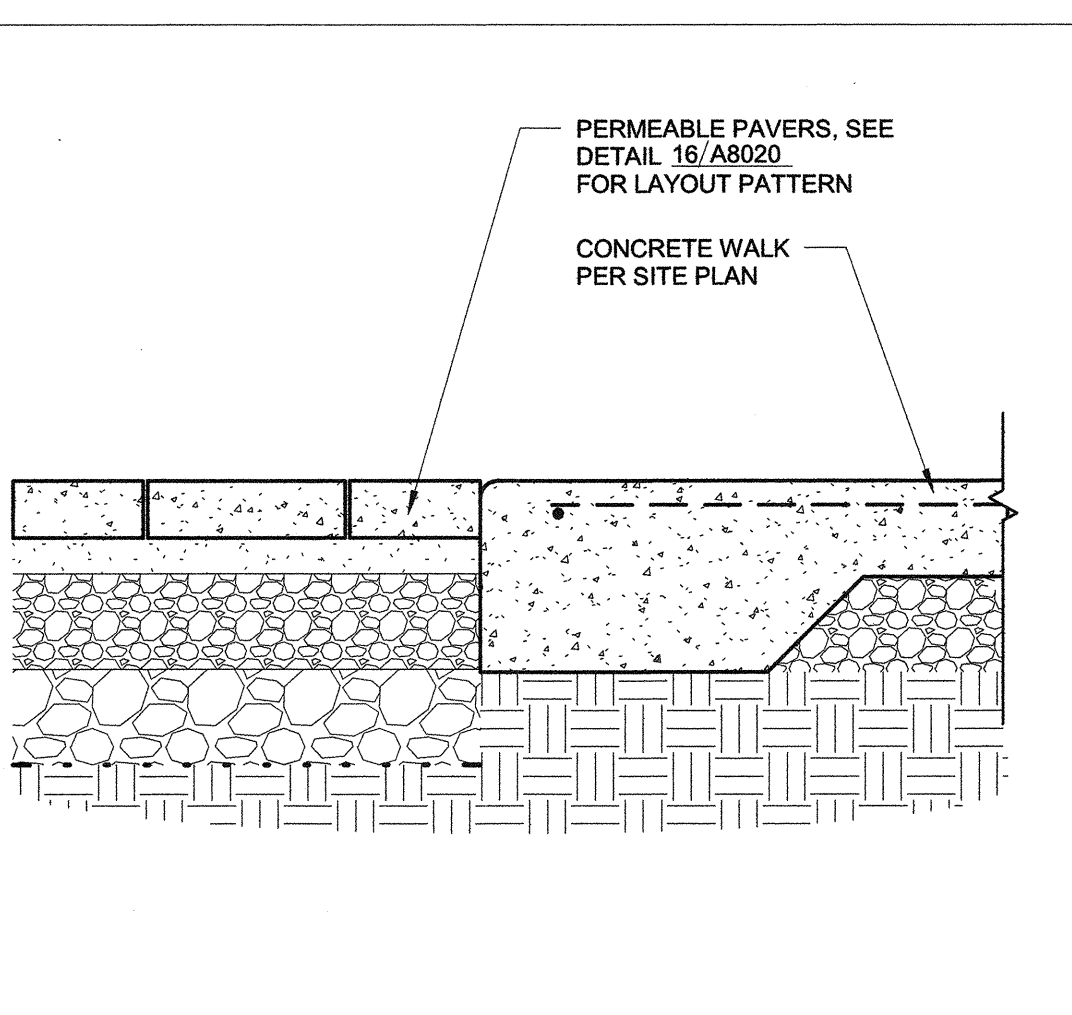


20 PAVER - WALK 1 1/2" = 1'-0"

PRIME CONSULTANT

ARCHITECTURE PLANNING

IBI San Luis Obispo
4119 Broad Street, Suite 210
San Luis Obispo, CA 93401
805.546.0433 fax: 805.546.0504
ibigroup.com

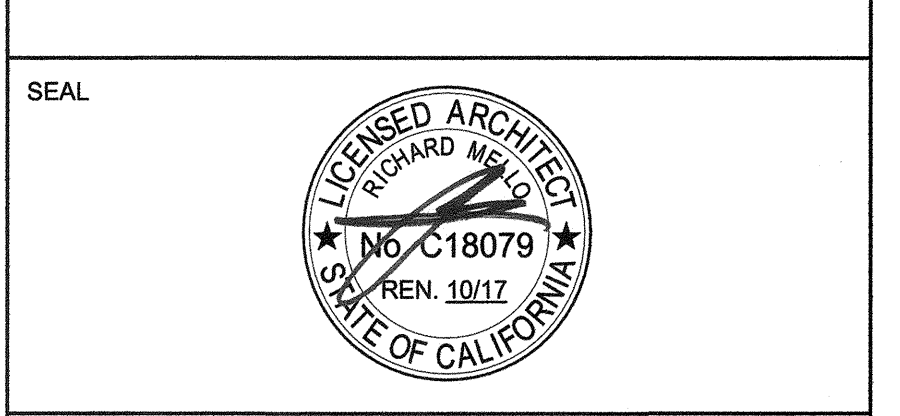

COPYRIGHT: Any reproduction or distribution for any purpose other than authorized by IBI Group is forbidden.

COPYRIGHT 2017 IBI GROUP


REVISIONS			
NO.	DATE	APPRD.	DESCRIPTION

CONSULTANT

AGENCY INFORMATION:

AGENCY TRACKING NO. 63321-241
FILE NO. 15-6

IDENTIFICATION STAMP
DIV. OF THE STATE ARCHITECT
OFFICE OF REGULATION SERVICES
03-118380
AG. No. 15-6 SS. A
DATE OCT 25 2017

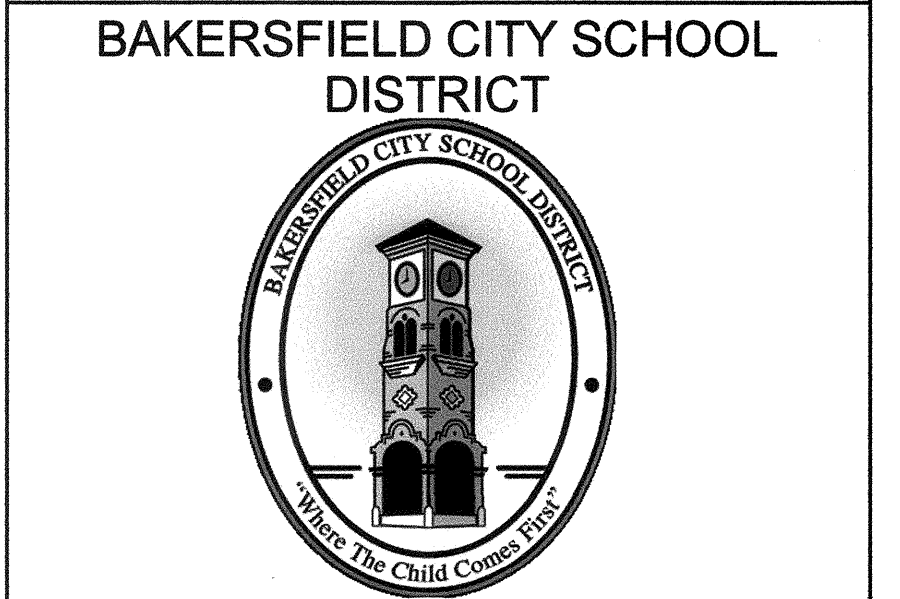

BAKERSFIELD CITY SCHOOL DISTRICT

BESSIE OWENS INTERMEDIATE RELOCATABLES A101 - A106

815 EUREKA ST. BAKERSFIELD CA, 93305

OPSC or OSHPD PROJ. NO. 16241.000

PROJECT NO. 16241.000

DRAWN BY: rRr

CHKD BY: RM

ISSUE DATE: 08/29/2017

SHEET TITLE

DETAILS

SHEET NUMBER

A8020

CONSTRUCTION DOCUMENTS

PLOT DATE: 8/25/2017 8:26:15 AM C:\Users\Carlo.Zaragoza\Documents\REV170206\A101-A106\A8020.dwg Site_Bessie-A8020-170206_Carlo.Zaragoza.rvt