



**American Modular Systems**

787 Sprackels Ave Manteca, CA 95336  
 Phone (209) 825-1921 • Fax (209) 825-7018  
 americanmodular.com

MODULAR MANUFACTURER PROPRIETARY STATEMENT

THESE DRAWINGS AND THE MATERIAL CONTAINED THEREIN ARE THE PROPERTY OF AMERICAN MODULAR SYSTEMS, INC. (AMS) AND SHALL NOT BE REPRODUCED, COPIED OR OTHERWISE DISPOSED OF DIRECTLY OR INDIRECTLY AND SHALL NOT BE USED IN WHOLE OR IN PART TO ASSIST IN THE MAKING OF OR FOR THE PURPOSE OF FURNISHING ANY INFORMATION FOR THE MAKING OF DRAWINGS, PRINTS, APPARATUS OR PARTS THEREOF WITHOUT THE FULL KNOWLEDGE AND WRITTEN CONSENT OF AMS. ALL PATENTABLE MATERIAL CONTAINED HEREIN AND ORIGINATING WITH AMS SHALL BE THE SOLE PROPERTY OF AMS.

PRE-CHECKED SET NAME

**24' x 40' THRU 120' x 40'  
2:12 PITCHED ROOF**

SITE SPECIFIC PROJECT NAME


SHEET TITLE

**MOMENT FRAME  
ELEVATIONS & DETAILS**

AGENCY TRACKING NO. 63321-241  
FILE NO. 15-6


IDENTIFICATION STAMP  
 DIV. OF THE STATE ARCHITECT  
 OFFICE OF REGULATION SERVICES  
**03-118380**  
 AC: FLS SS: CL  
 DATE: OCT 25 2017

MANUFACTURER PROFESSIONAL OF RECORD ON PC

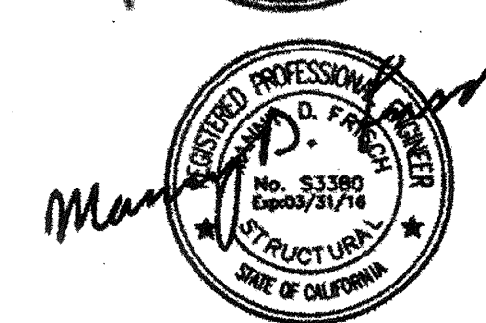


05/19/2015

PROJECT SPECIFIC STATE AGENCY APPROVAL

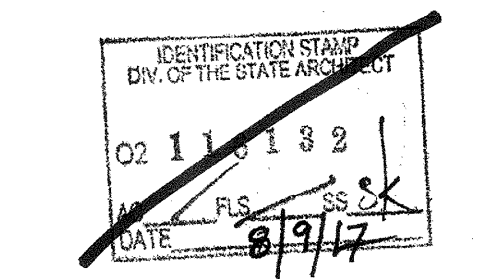

ORIGINAL PC STATE AGENCY APPROVAL

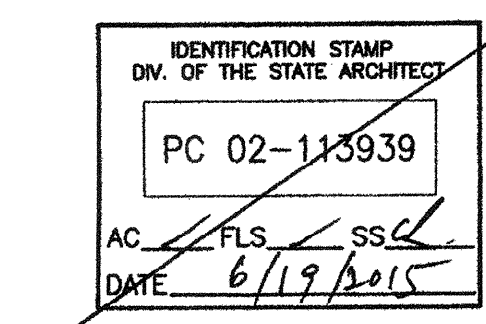


PRE-CHECK (PC) DOCUMENT - CODE: 2013 CBC  
 A SEPARATE PROJECT APPLICATION FOR CONSTRUCTION IS REQUIRED

REVISIONS


DRAWN BY: AS NOTED  
 SCALE: AS NOTED  
 DATE: SHEET NUMBER

**S5.0**

- 1 HSS COLUMN - SEE SCHEDULES BELOW
- 2 FLOOR BEAM - SEE SCHEDULES BELOW
- 3 LONGITUDINAL ROOF BEAM - SEE SCHEDULES BELOW
- 4 TRANSVERSE ROOF BEAM - SEE SCHEDULES BELOW  
14" MIN 18" MAX
- 5 6" Ø MAX OPENING IN WEB OF ROOF BEAM WITHOUT WEB REINFORCEMENT  
MINIMUM SPACING OF HOLES @ 48" O.C.  
HOLES MAY OCCUR @ ANY LOCATION ALONG LENGTH OF ROOF BEAM EXCEPT AS NOTED OTHERWISE ON FRAMING ELEVATION. - SEE 6/SS.1  
NOTE: IF HOLE IS 3" OR LESS THEY MAY BE SPACED @ 24" O.C. MINIMUM
- 6 4" Ø MAX OPENING IN WEB OF FLOOR BEAM WITHOUT WEB REINFORCEMENT  
MINIMUM SPACING OF HOLES @ 48" O.C.  
HOLES MAY OCCUR @ ANY LOCATION ALONG LENGTH OF FLOOR BEAM WITH DIRECT FOUNDATION SUPPORT BELOW. OPENINGS ARE NOT ALLOWED WHERE BEAMS ARE SPANNING BETWEEN FOUNDATIONS OR ACROSS VENT OPENINGS. SEE 6/SS.1.  
NOTE: IF HOLE IS 2" OR LESS THEY MAY BE SPACED @ 24" O.C. MINIMUM
- 7 14 GA OUTRIGGER CHANNEL (FORMED SOFFIT CEE) AT OPTIONAL ENCLOSED OVERHANG REFER TO DETAIL 1A OR 1B/SS.1 & S0.0 FOR PROPERTIES
- 8 12" x 30" MAX OPENING REFER TO DETAIL 4A/SS.1 FOR OPENING REINFORCEMENT

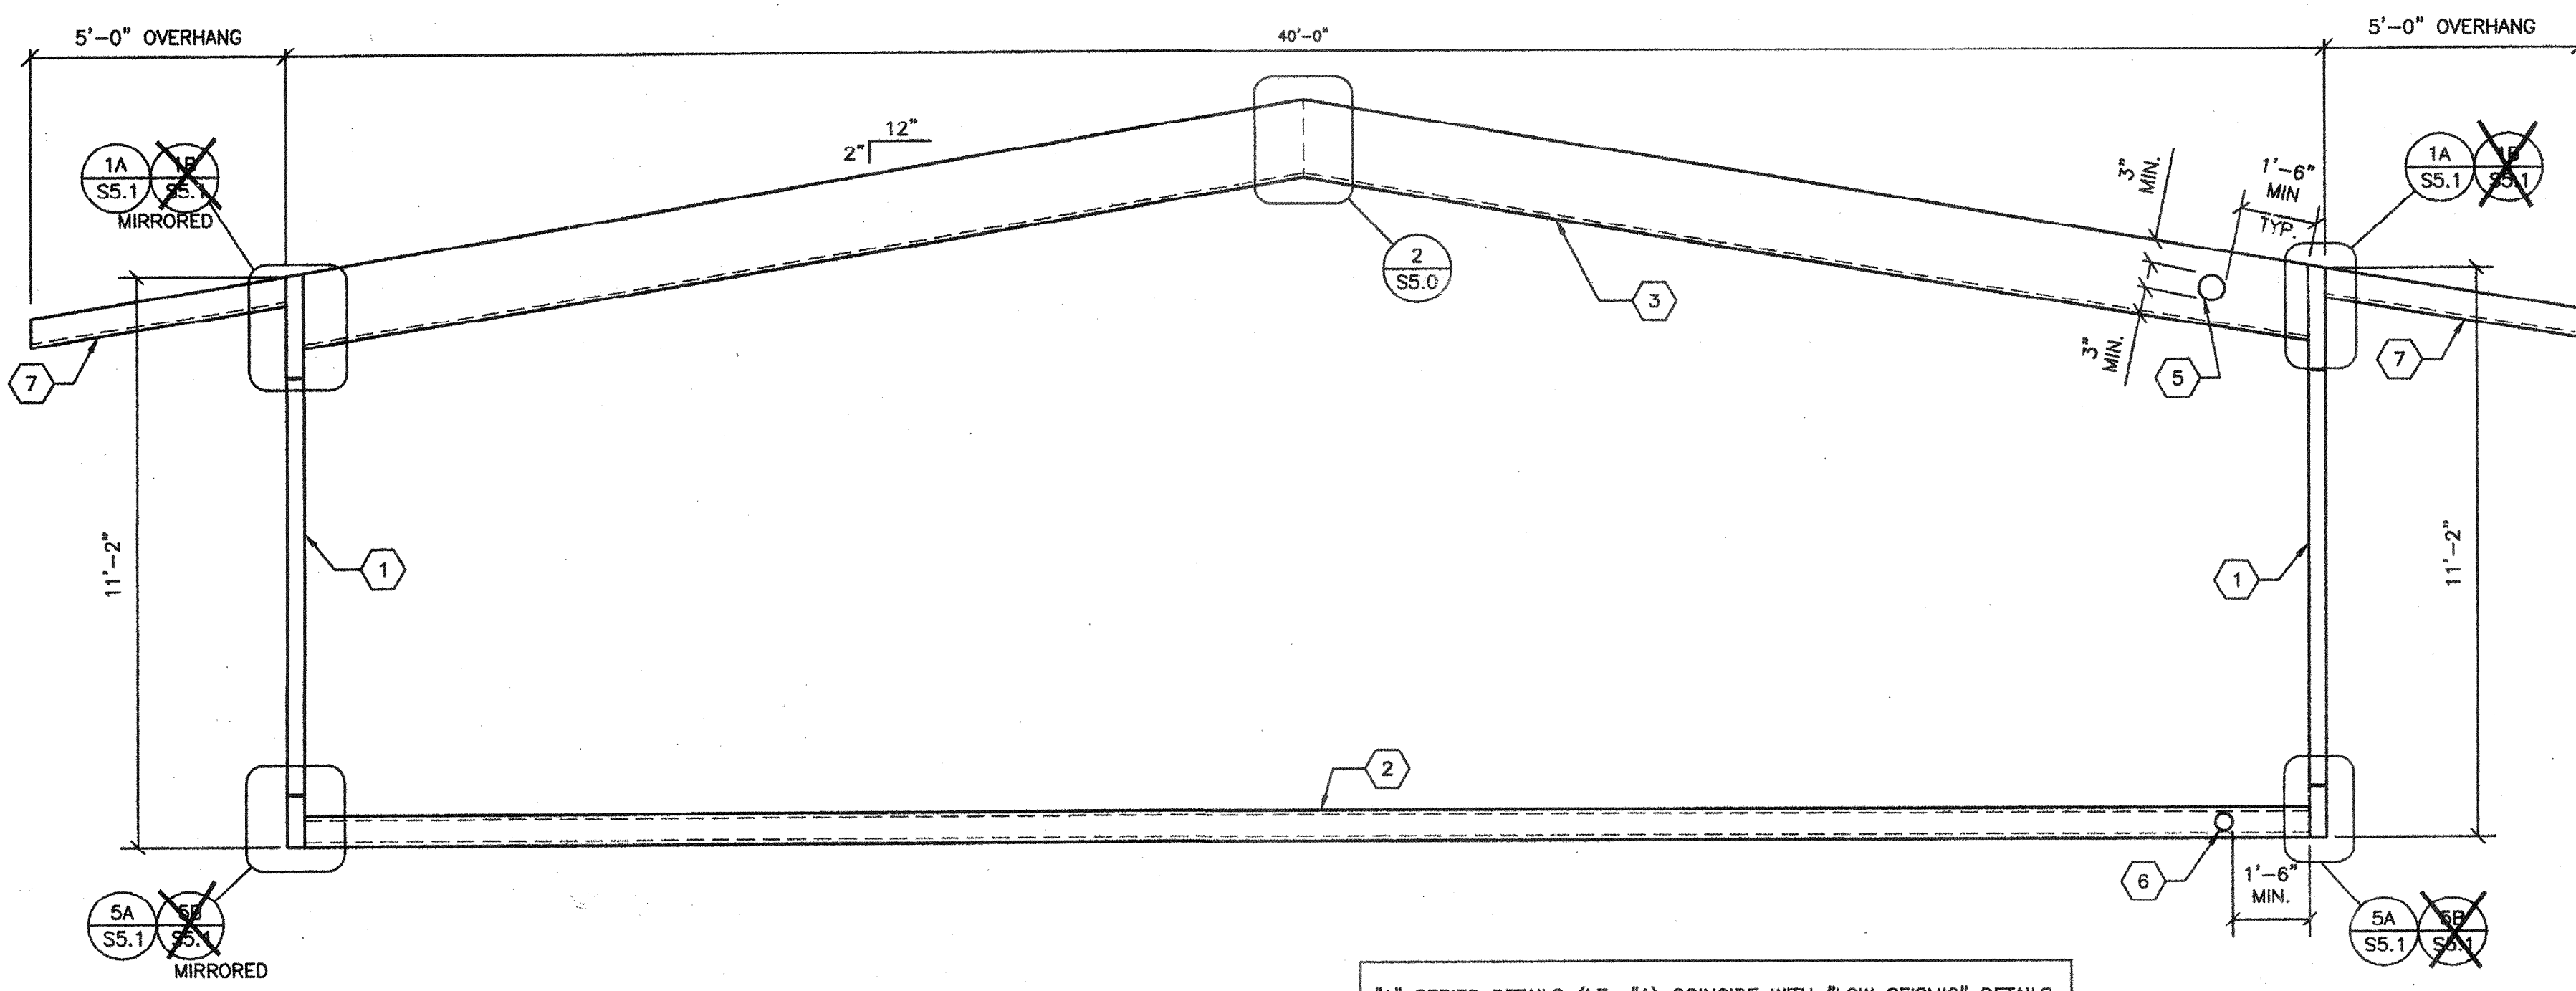


"A" SERIES DETAILS (I.E. #A) COINCIDE WITH "LOW SEISMIC" DETAILS.  
 "B" SERIES DETAILS COINCIDE WITH "HIGH SEISMIC" DETAILS.

TYPICAL LONGITUDINAL FRAME ELEVATION

SCALE: 3/8"=1'-0"

KEY NOTES

THE WELDING PROCEDURE QUALIFICATION TEST RECORD AND WELDING PROCEDURE SPECIFICATION FOR THIS WELD SHALL BE PREPARED IN ACCORDANCE WITH AWS D1.3-08 AND SUBMITTED TO THE STRUCTURAL ENGINEER FOR REVIEW AND SUBMITTAL TO THE D.S.A. TYPICAL ALL DETAILS THIS SHEET. ALL WELDS USED IN PRIMARY MEMBERS AND CONNECTIONS IN THE LATERAL FORCE-RESISTING SYSTEMS SHALL BE MADE WITH FILLER METAL THAT HAS A MINIMUM CHARPY V-NOTCH TOUGHNESS OF 20 FT.-LBS AT ZERO DEGREES F, AS DETERMINED BY AWS CLASSIFICATION.

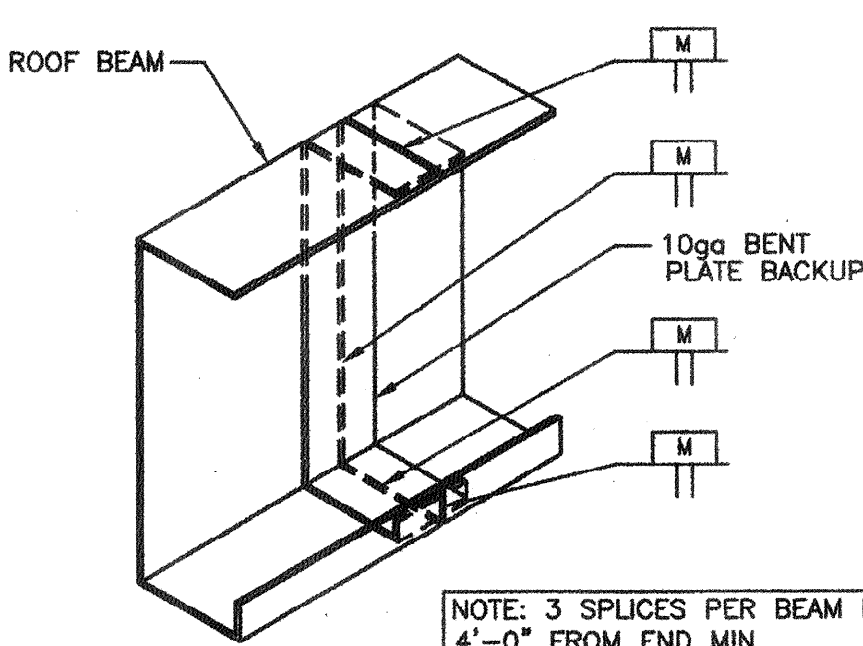

NOTE: 3 SPLICES PER BEAM MAX  
 4'-0" FROM END MIN

TYPICAL BEAM SLICE



SCALE: 1 1/2"=1'-0"

FRAME MEMBER SCHEDULE - (LOW SEISMIC)

3A

FLOOR BEAMS		ALT. FLOOR BEAMS		COLUMNS	LONGITUDINAL ROOF CHANNEL	TRANSVERSE ROOF CHANNEL
PLYWOOD FLOOR	STRUCTO-CRETE OR CONCRETE FLOOR	PLYWOOD FLOOR	SC OR CONC FLOOR			
C9x13.4 (50 KSI)	C9x13.4 (50 KSI)	C10x15.3	C10x15.3	HSS 6x4x5/16 (SEE ORIENTATION BELOW)	10GA	10GA

NOTE: SEE ALL SECTION PROPERTIES ON SHEET S0.0

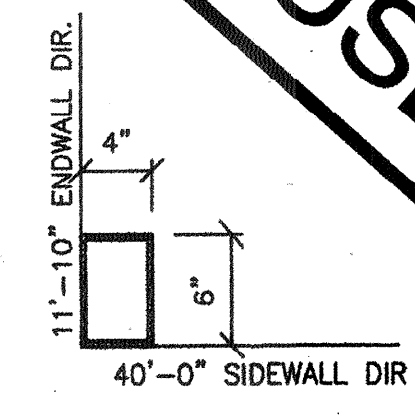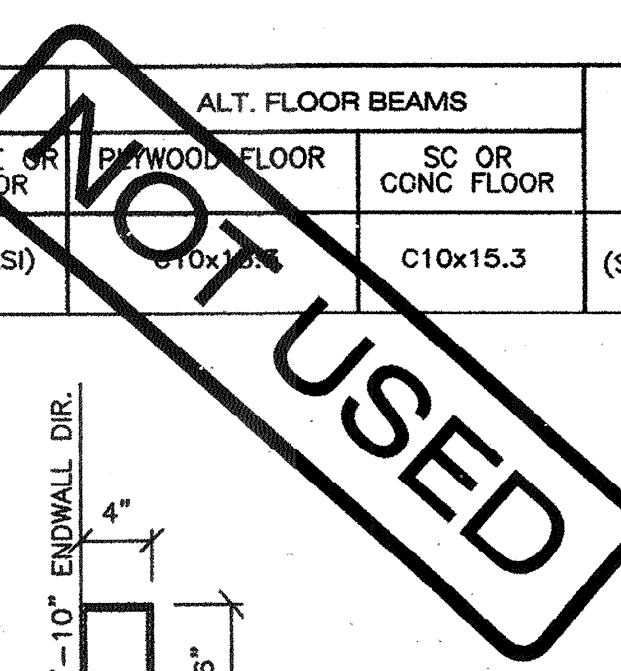


OVERHANG CORNER DETAIL

SCALE: 1 1/2"=1'-0"

FRAME MEMBER SCHEDULE - (HIGH SEISMIC)

3B

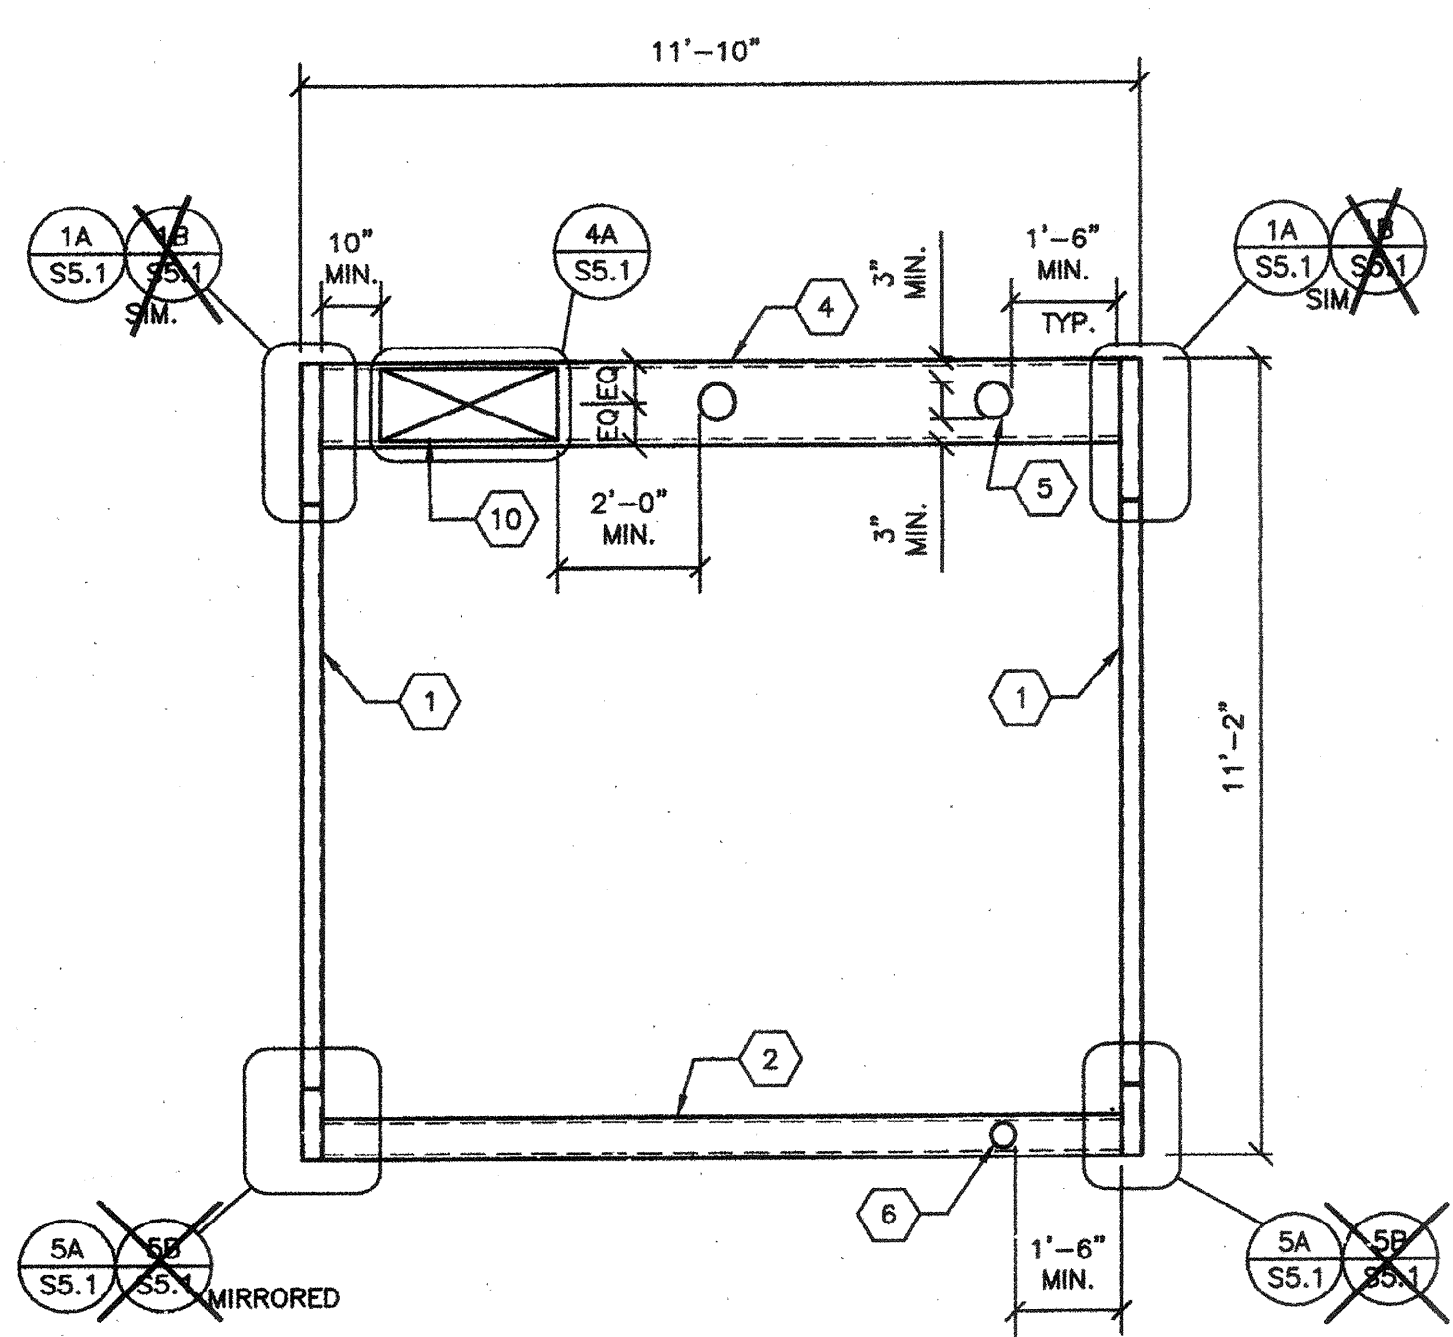

NOTE: "A" SERIES DETAILS (I.E. #A) COINCIDE WITH "LOW SEISMIC" DETAILS.  
 "B" SERIES DETAILS COINCIDE WITH "HIGH SEISMIC" DETAILS.

TYPICAL TRANSVERSE FRAME ELEVATION

SCALE: 3/8"=1'-0"