


**KEY.**  
 X/F AIR CONDITIONING/TONNAGE  
 L LIGHTING  
 E-G EVAPORATIVE COOLER  
 OR CLASSROOM  
 MF MULTI-PURPOSE  
 K KINDERGARDEN  
 U UTILITY  
 A ADMINISTRATIVE  
 C CAFETERIA  
 L LIBRARY  
 B BAND  
 D DIRE. CONFERENCE  
 WINDOWS TO BE REMOVED  
 CONTROL FILM  
 TO MATCH EXISTING

1" = 20'-0"

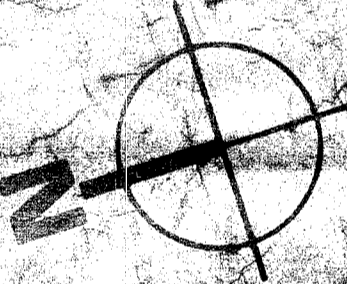

- Sheet Index**
- A1 pier plan
  - A2 plan, elevations & details
  - M1 air conditioning units A-B-G-D
  - M2 air conditioning units B-F-G
  - M3 air conditioning schedules & details
  - M4 air conditioning unit
  - E1 electrical plan, one-line diagram, feeder schedule
  - E2 Multi-Purpose Bldg. A&B Lighting & SMC
  - E3 Units C-D-E-F-G Lighting & A/C
  - E4 panel schedules, fixture schedules, details

Lincoln St High School

8944

722.00'

12/17  
 12/17