

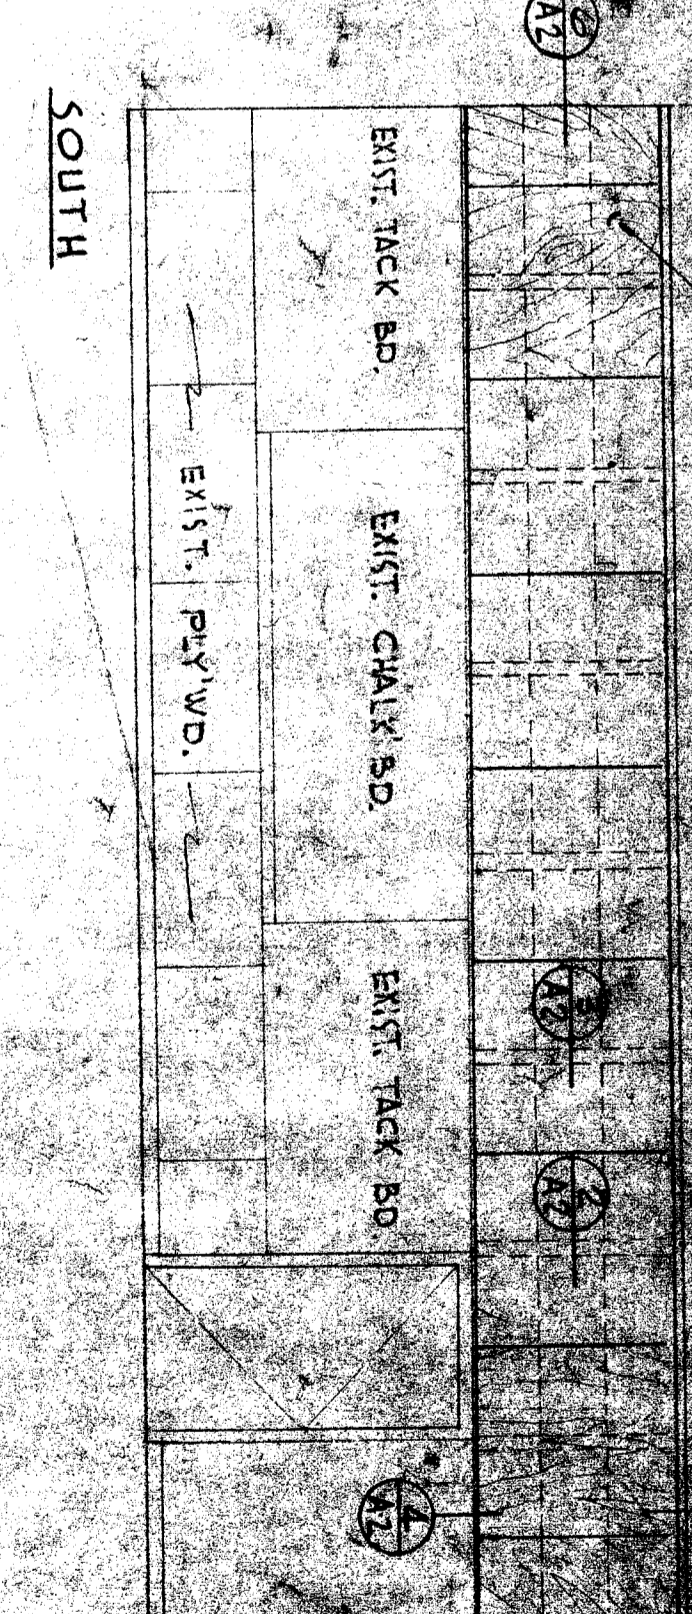
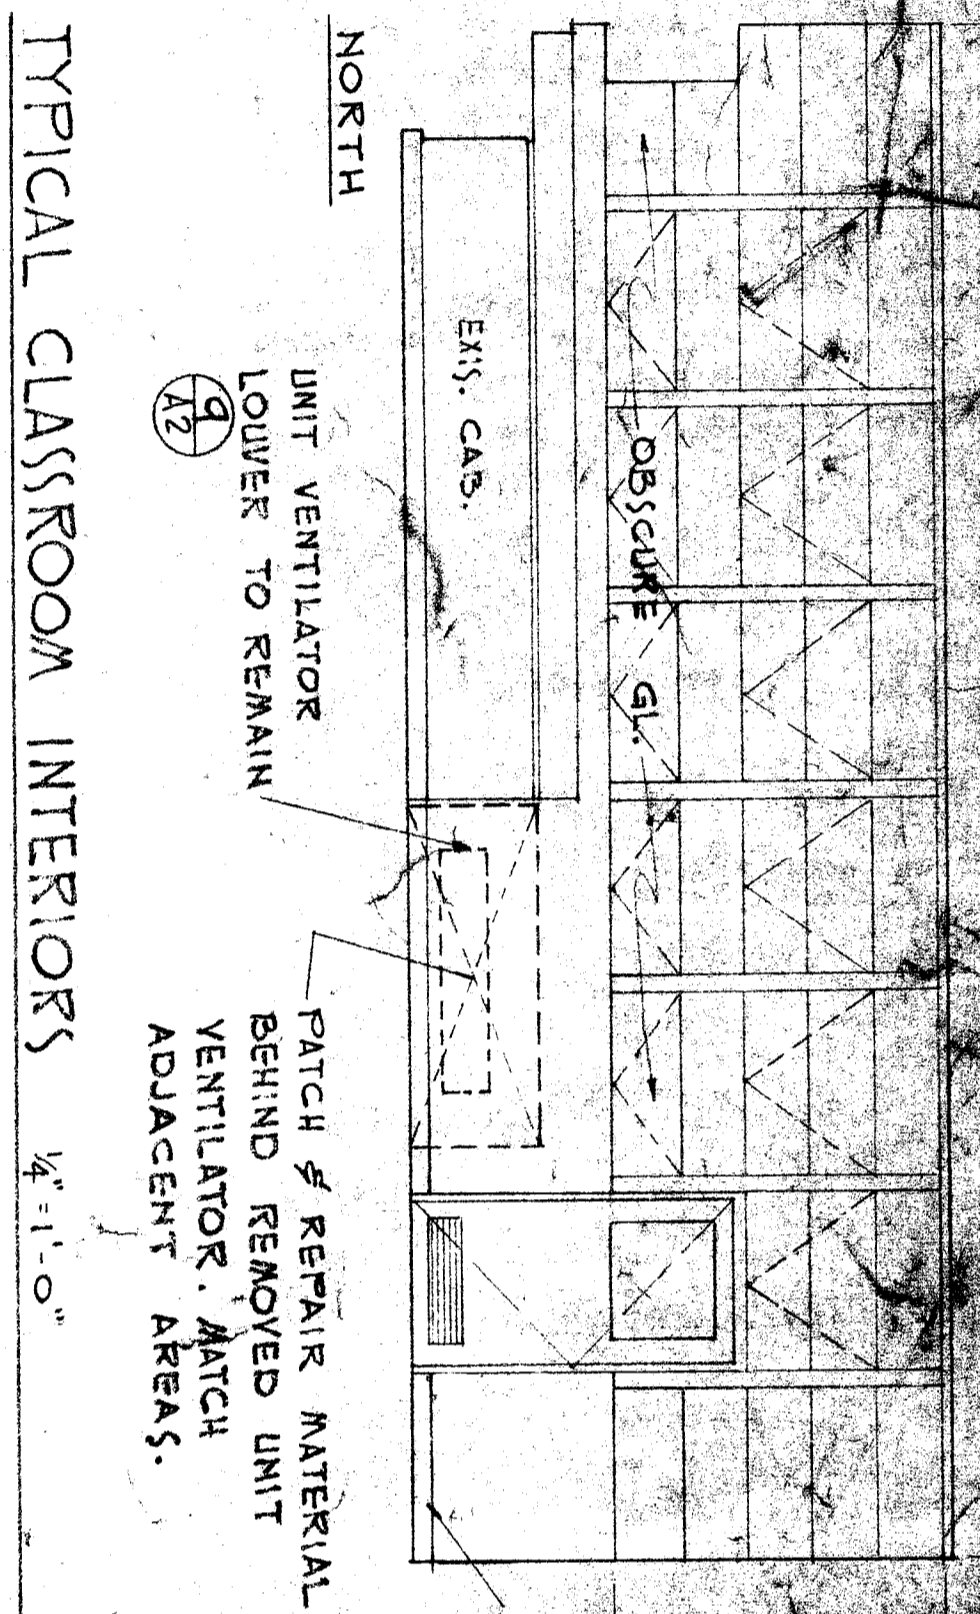
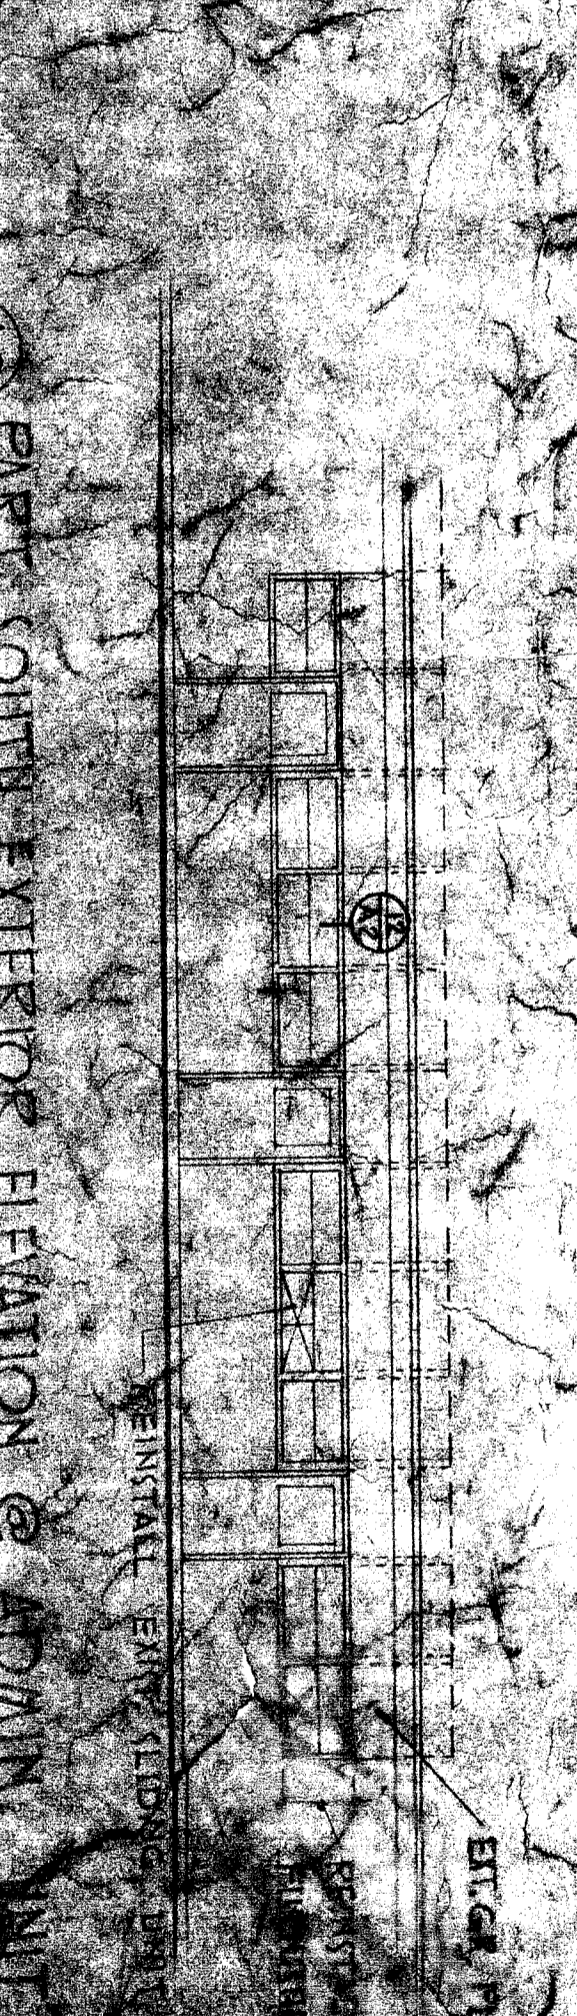
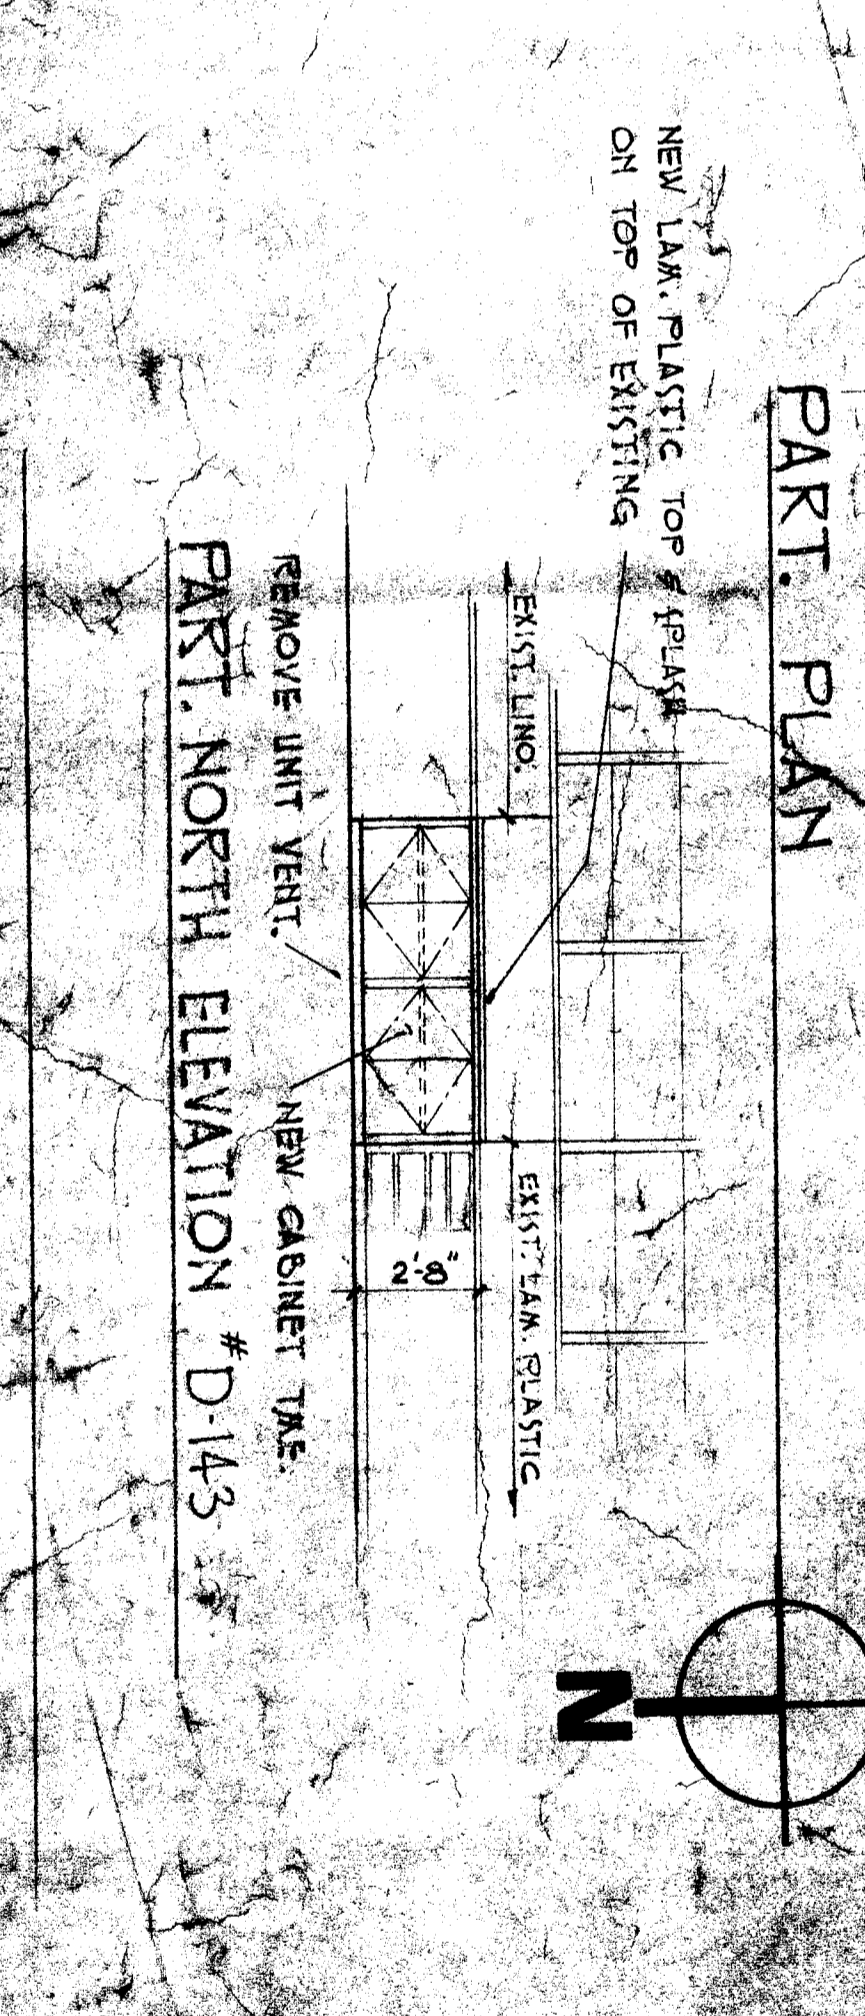
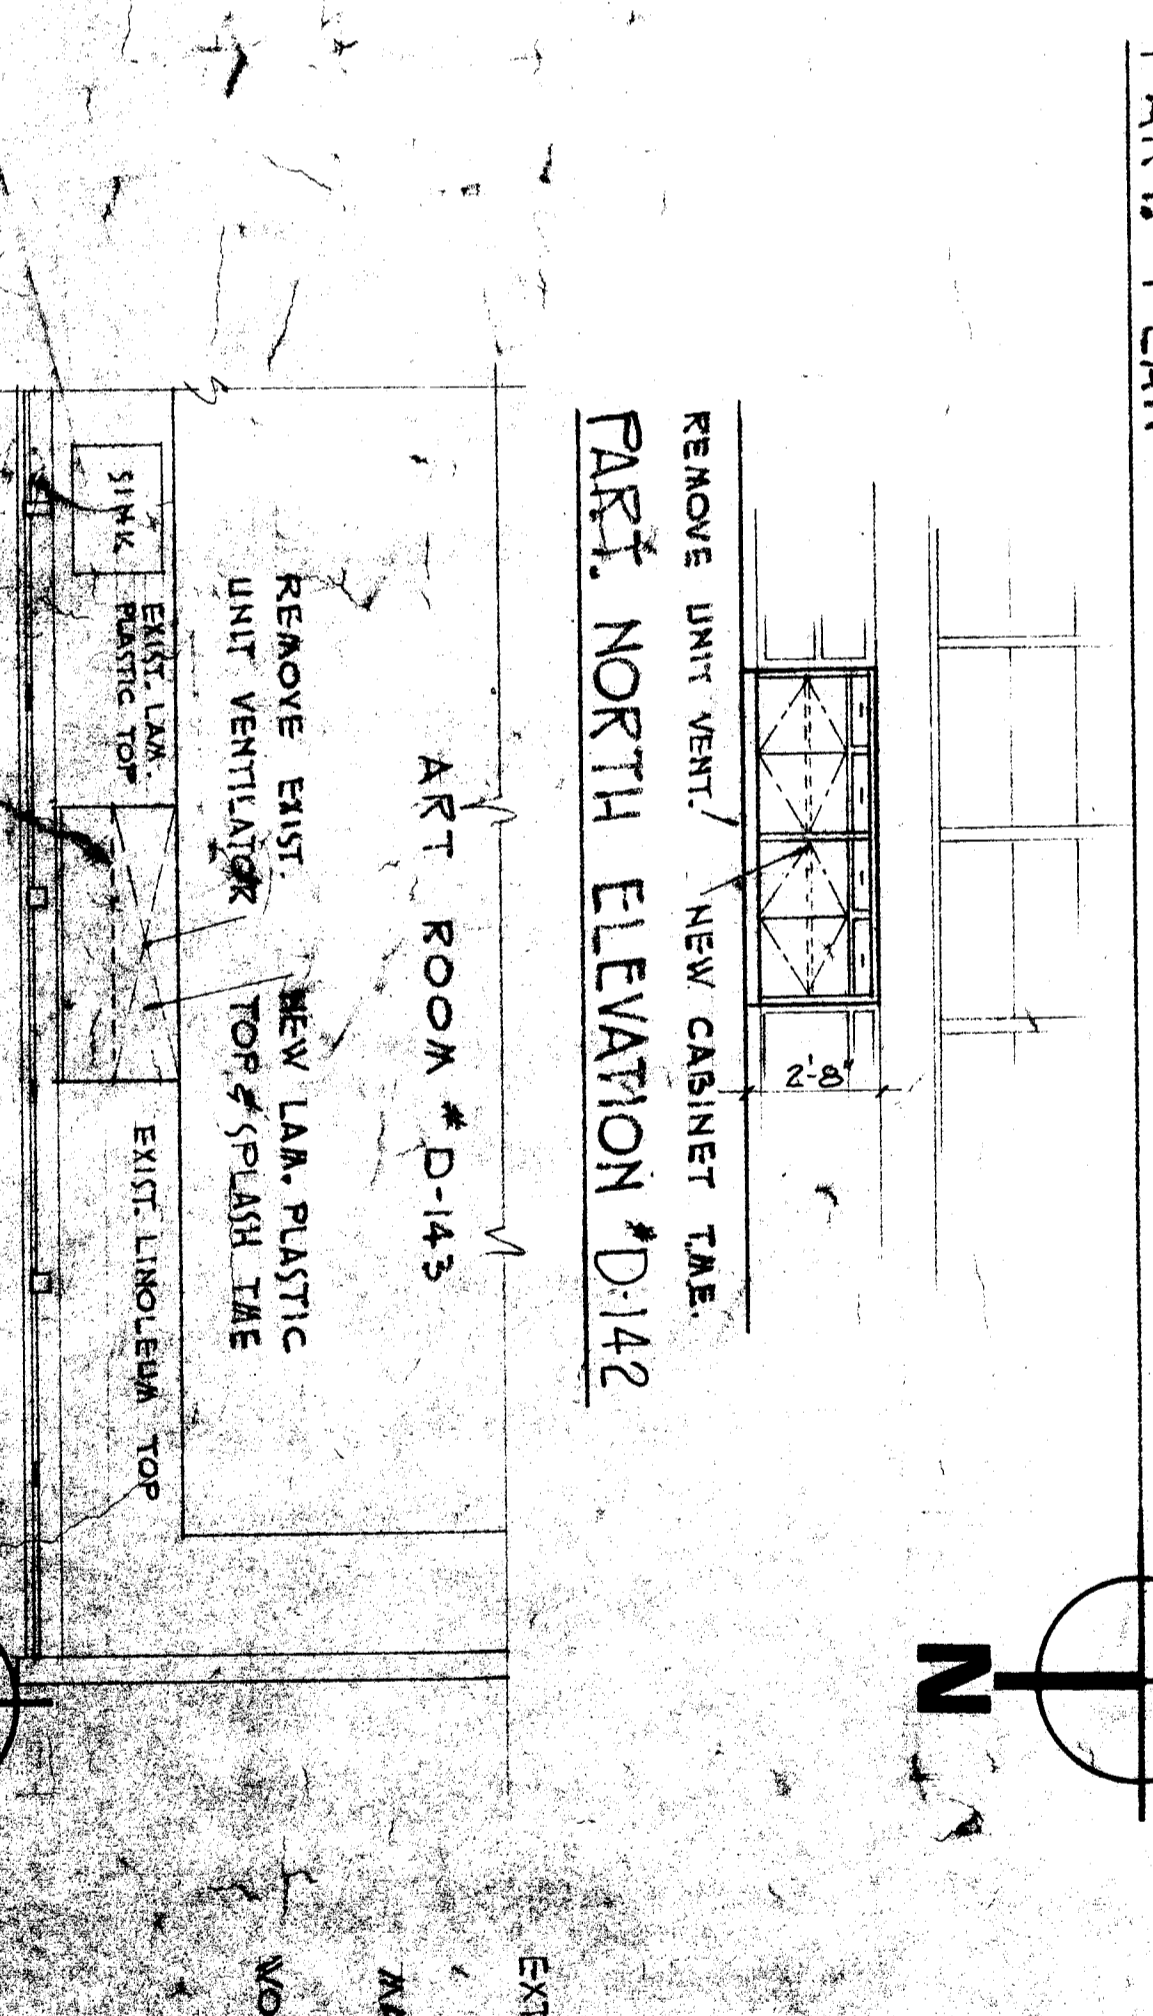
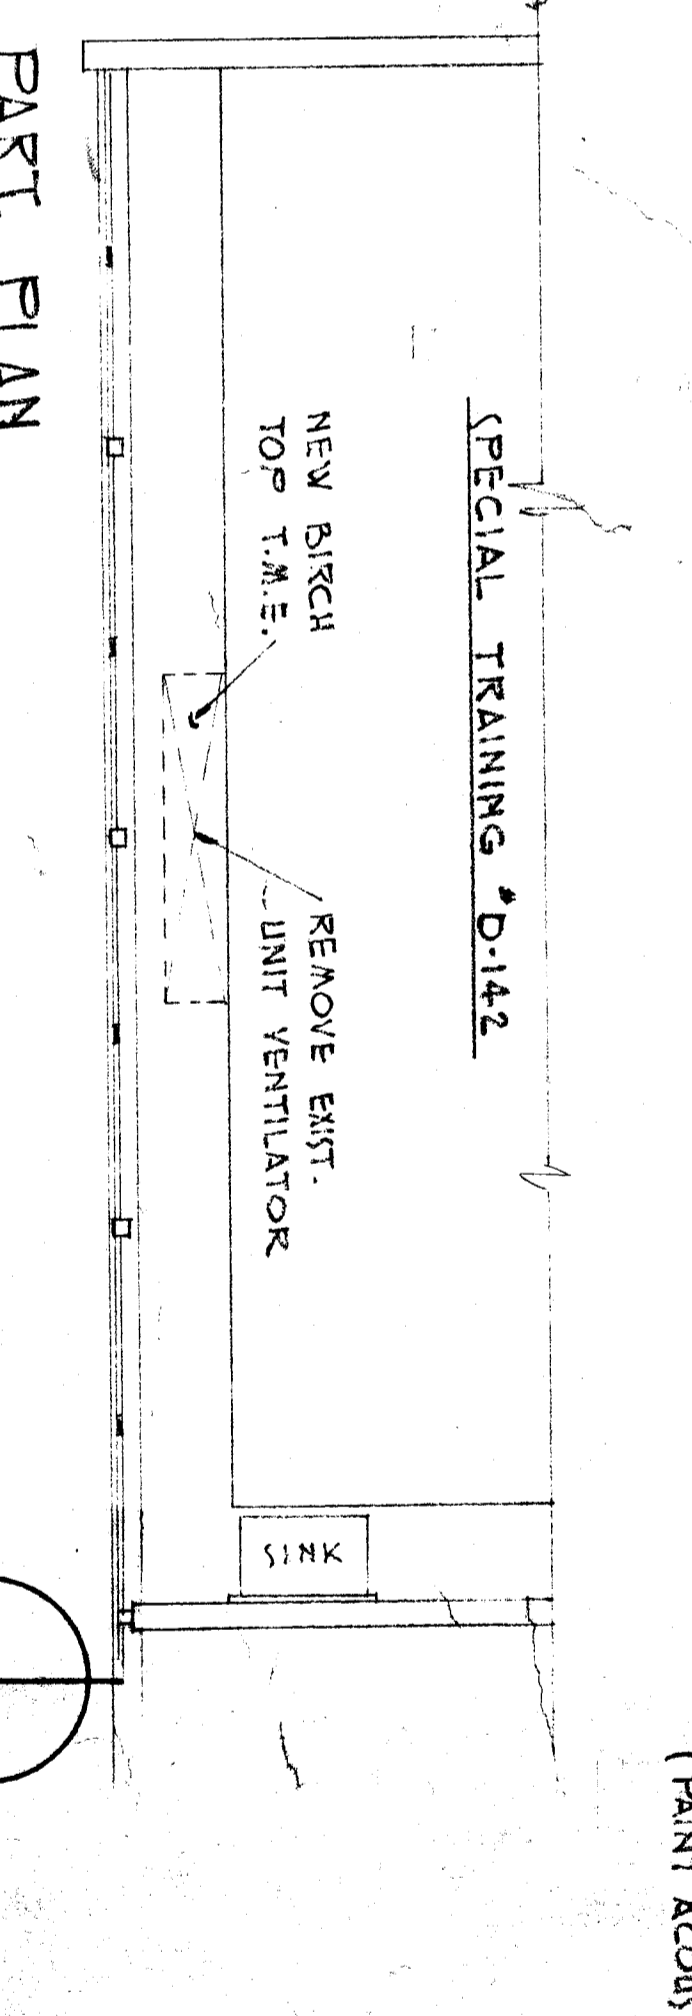
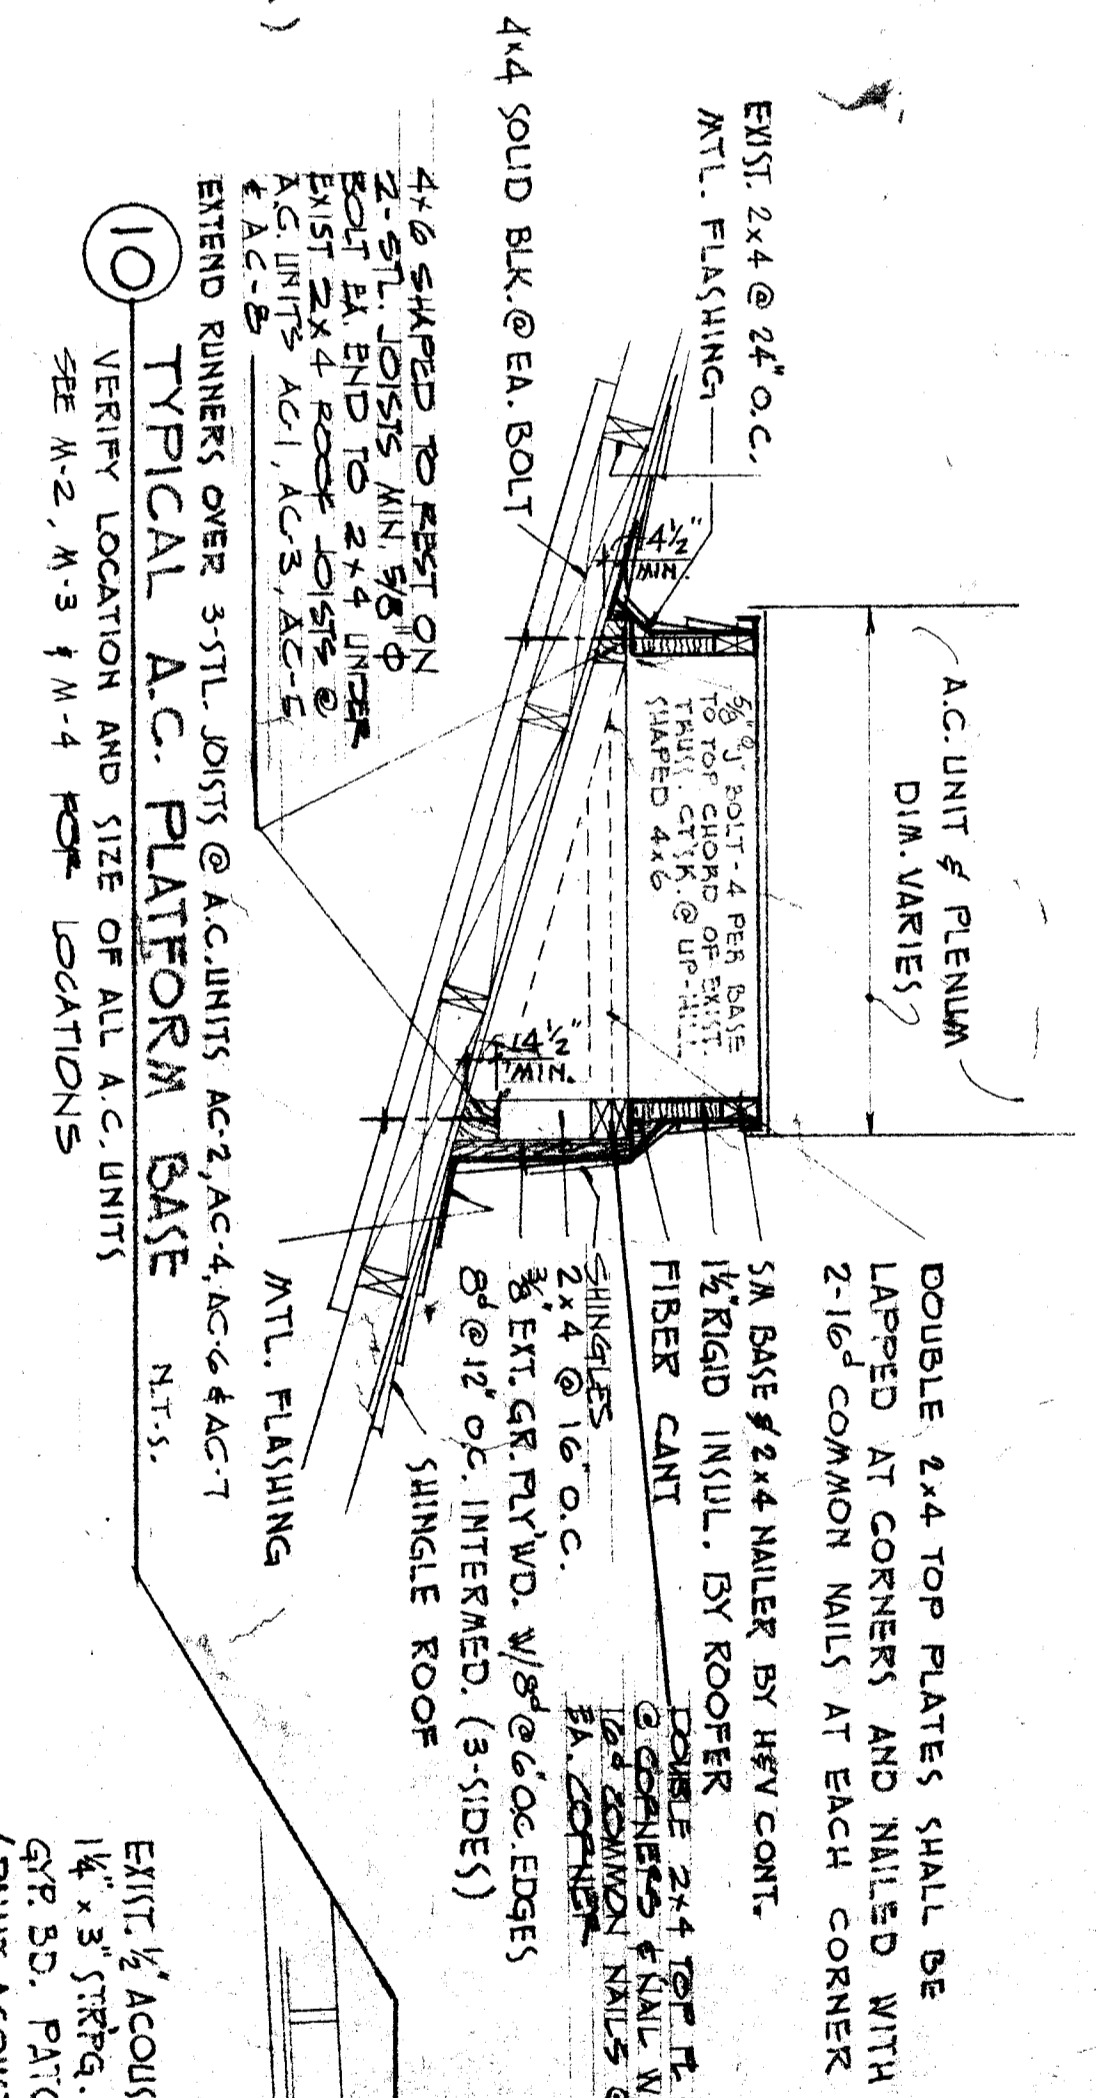
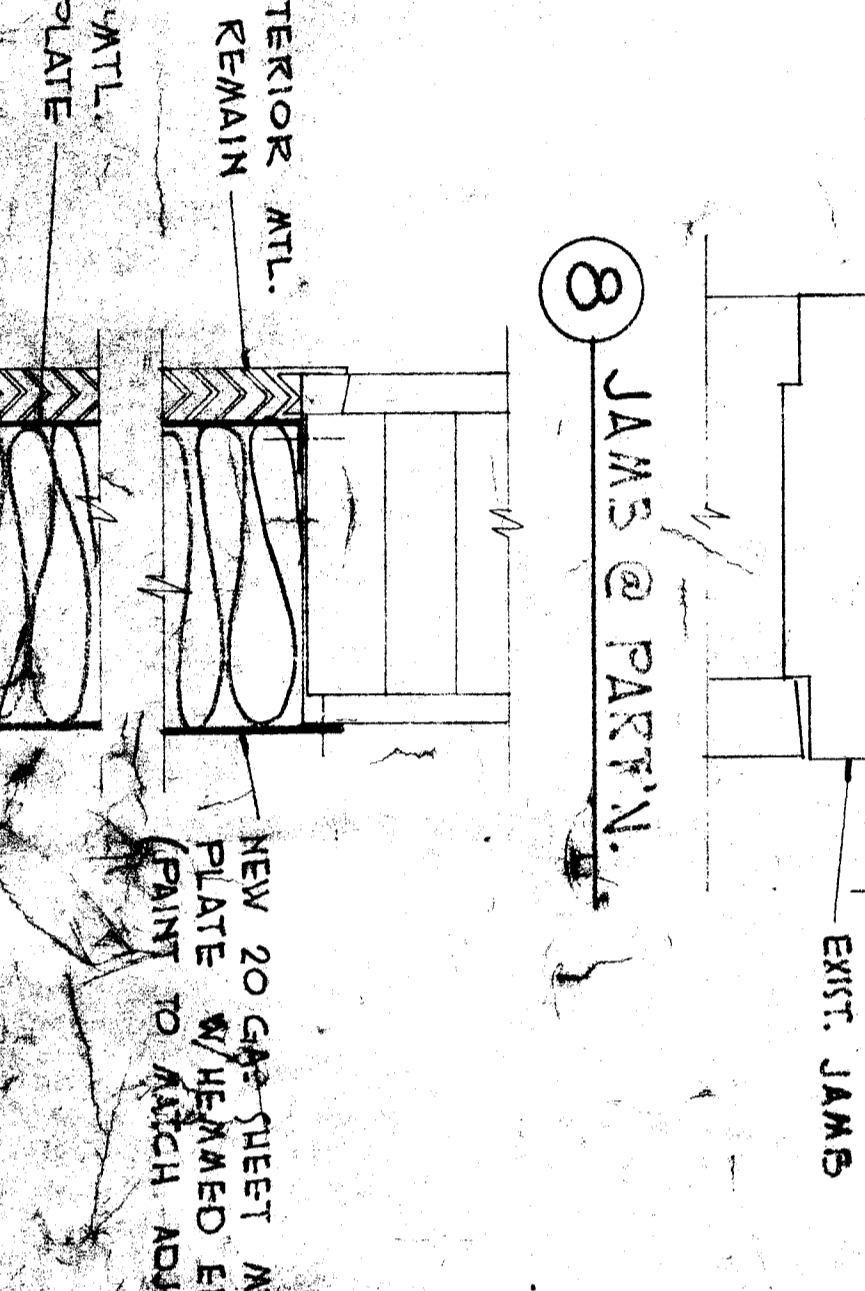
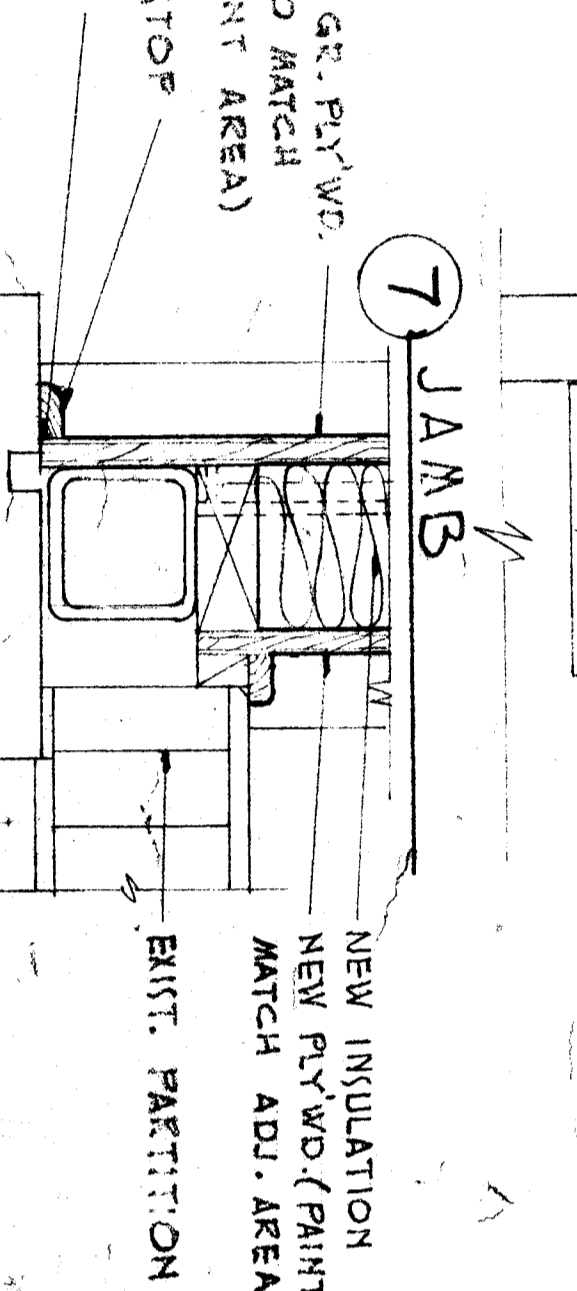
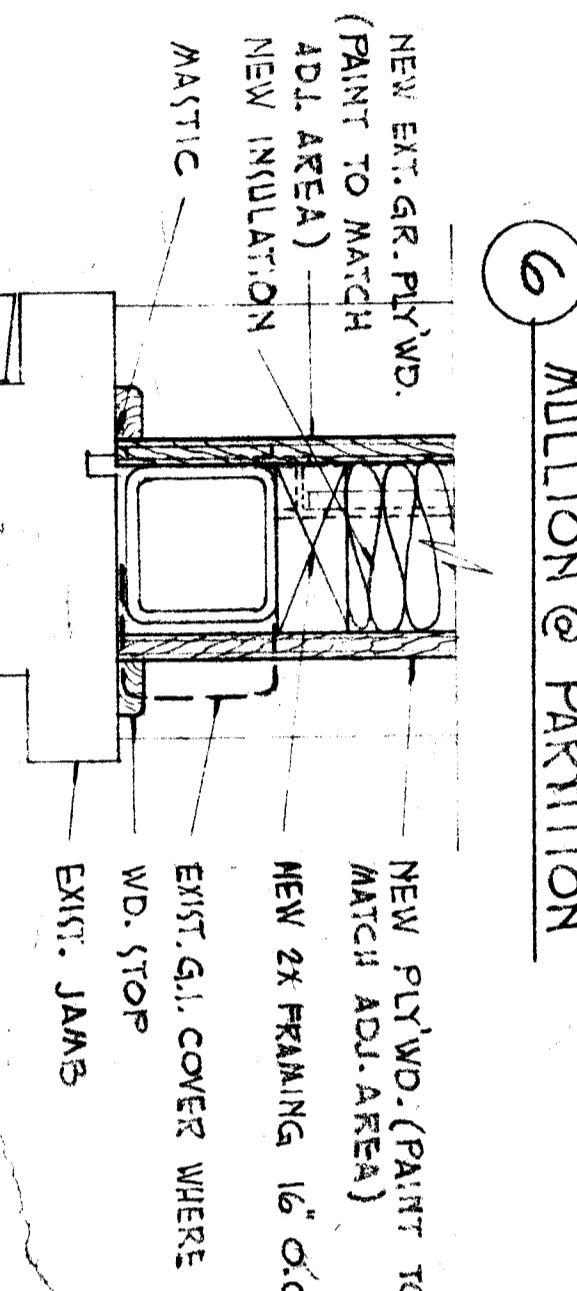
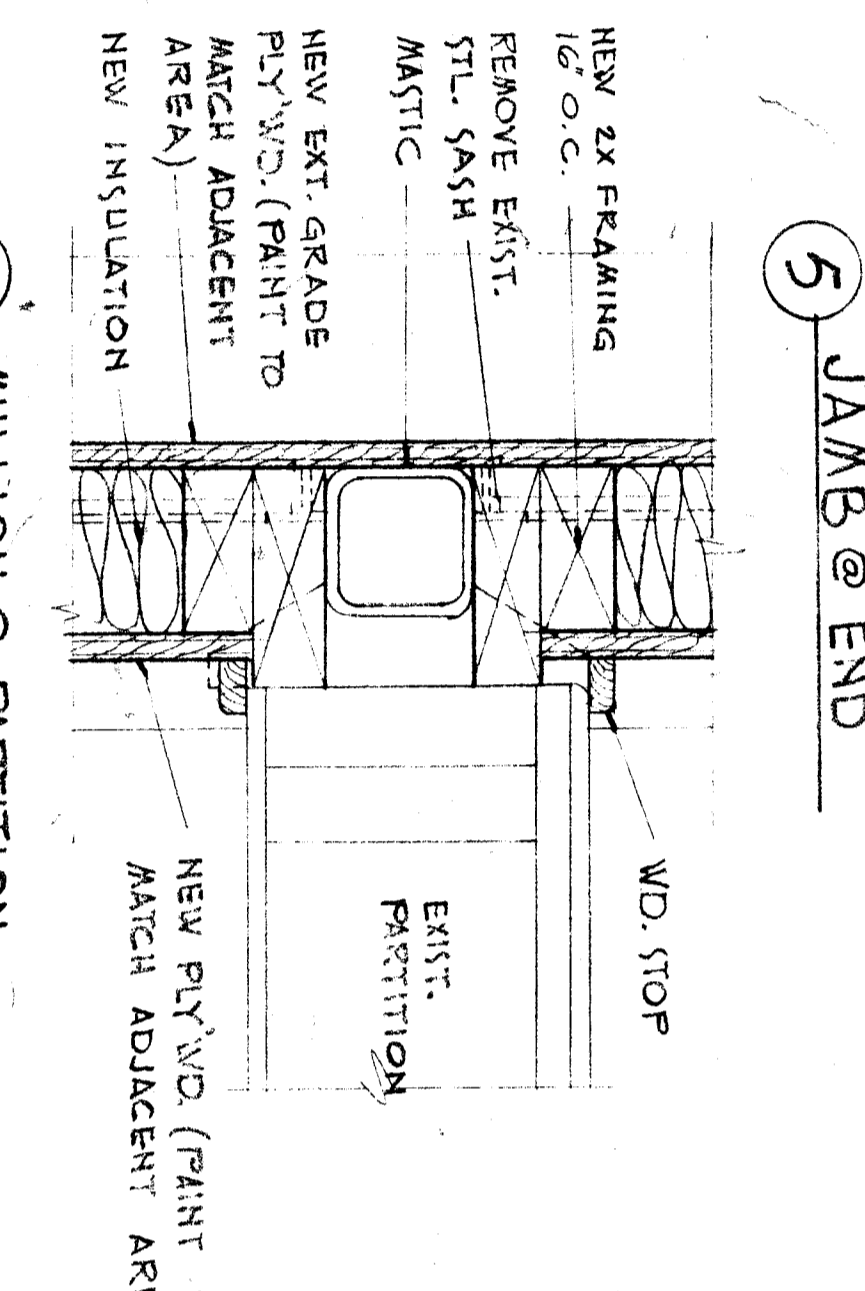
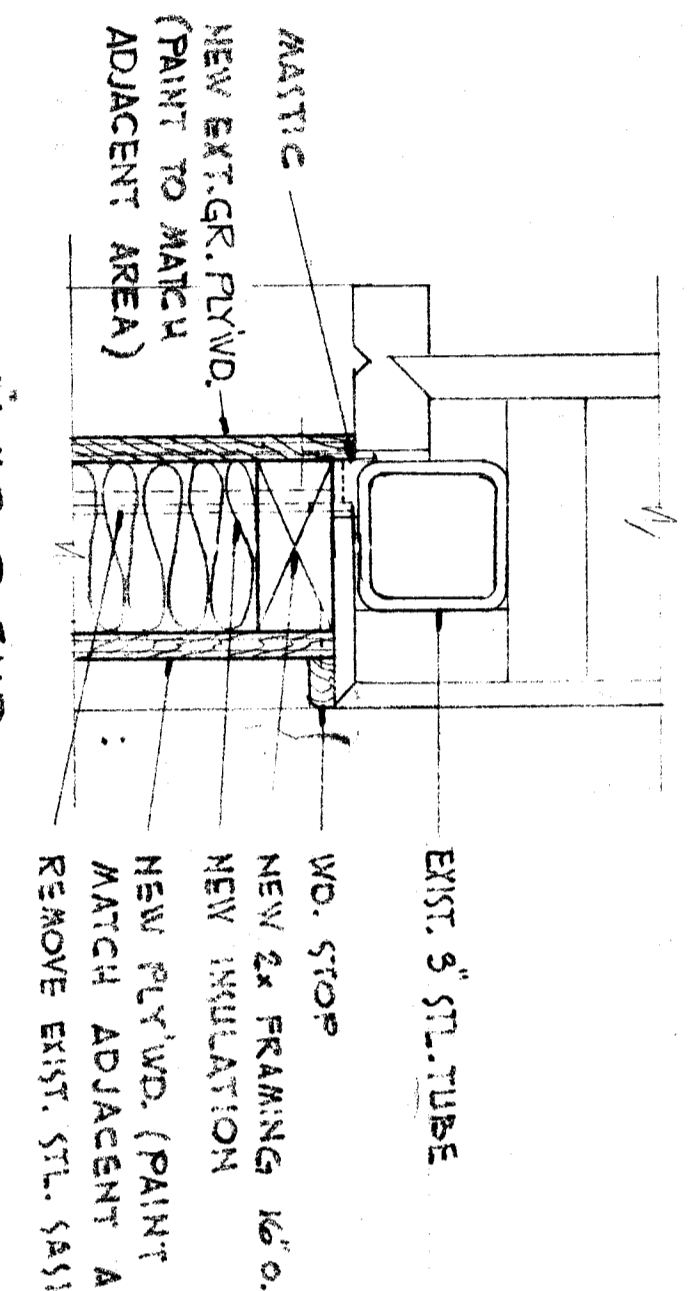
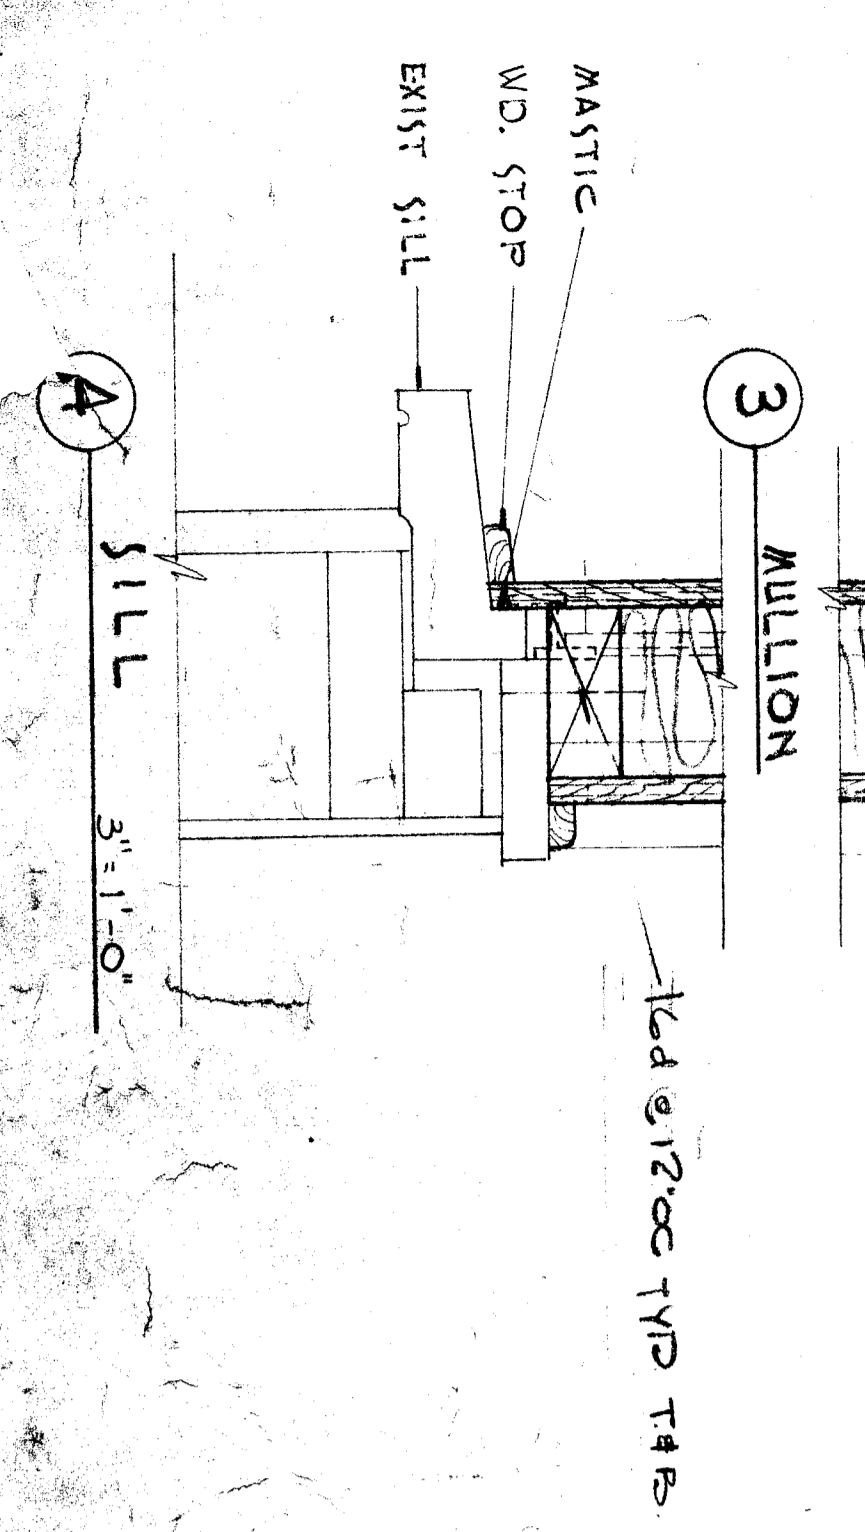
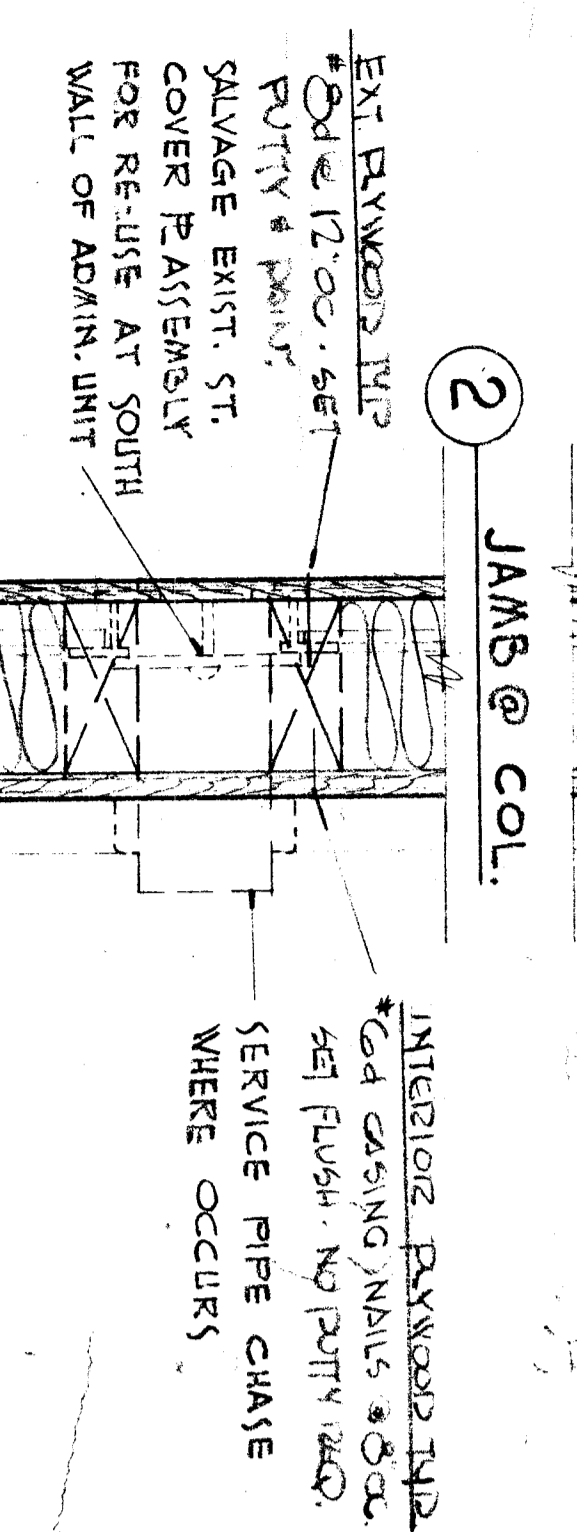
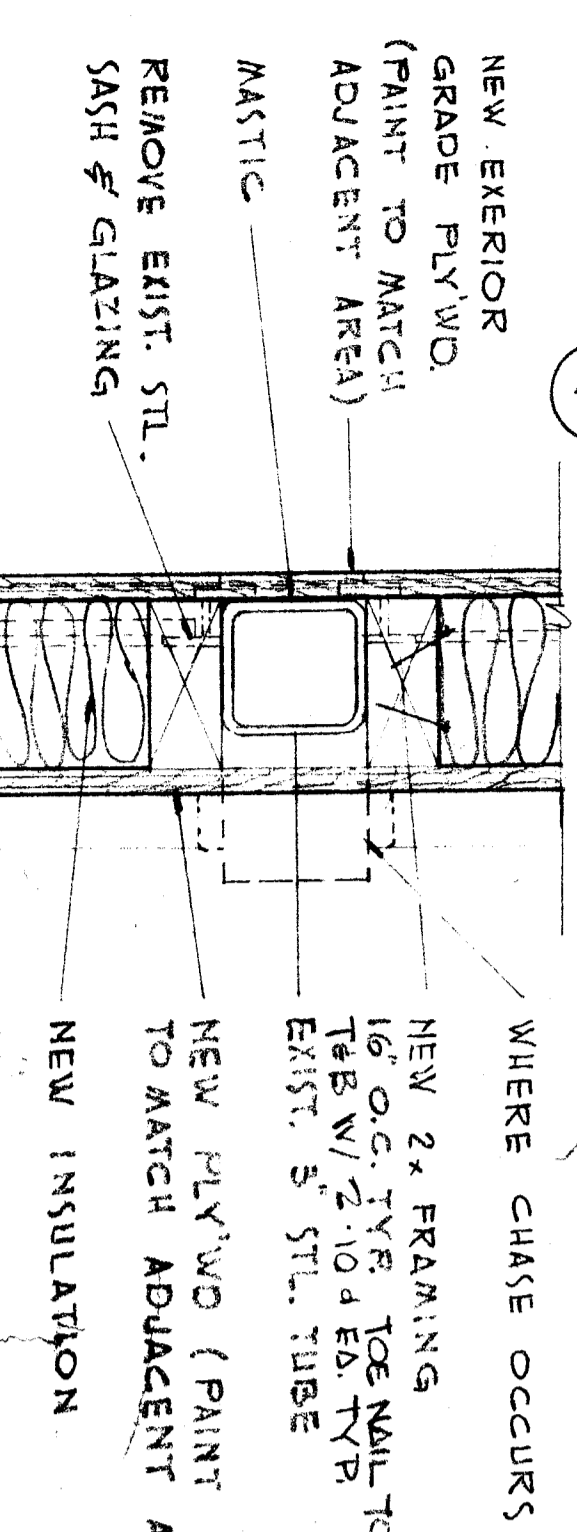


DO NOT REMOVE WALL TO REVEAL AIR
CONCRETE. PLAN INCL. DR. SEE PLAN.

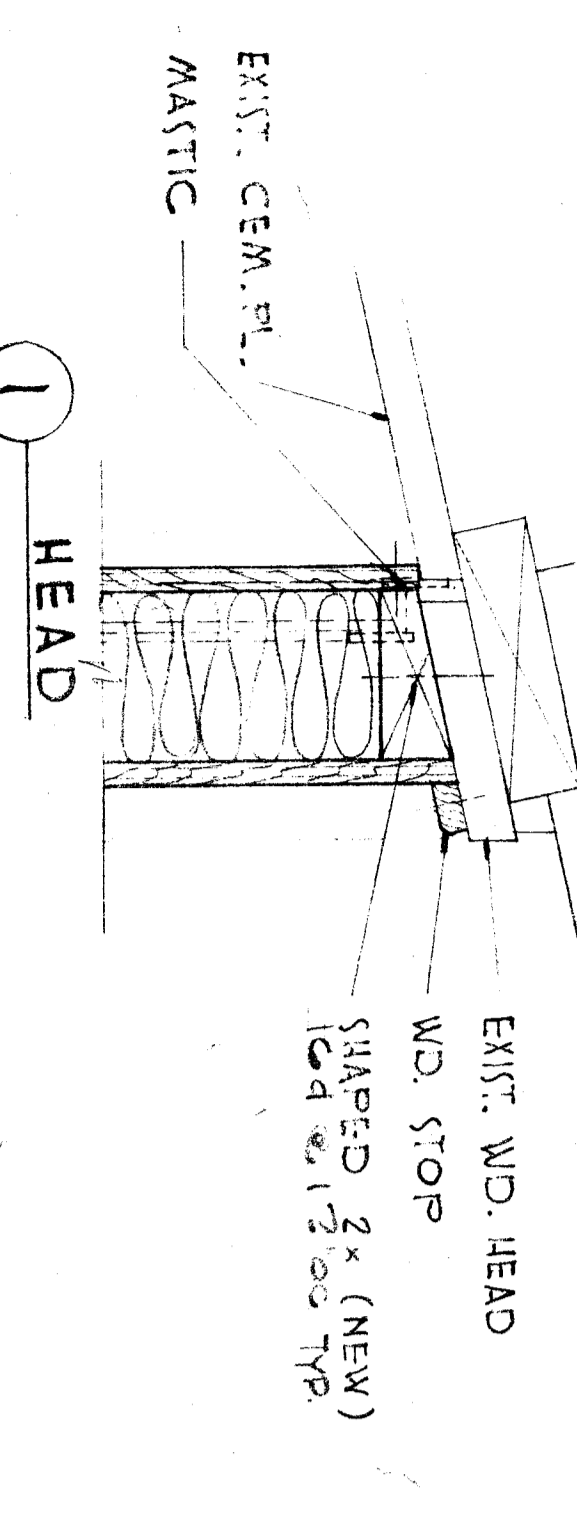

SEE MECH. & ELECT. SPECS:
REMOVE EXISTING UNIT VENTILATOR AND
CUT OFF ALL PIPING BELOW FLOOR.
PATCH AND REPAIR CONCRETE FLOOR.
PATCH AND REPAIR UNIL. AIRBORER TILE
TO MATCH EXISTING AS CLOSE AS POSSIBLE
FOR COLOR AND PATTERN.

TYPICAL CLASSROOM PLAN

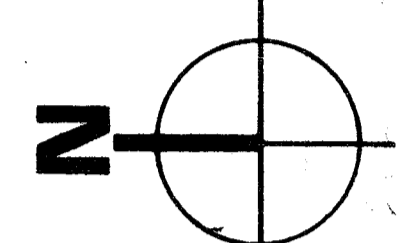

NOTE: WOOD FRAMING UNIT 1
FRAMING 2x4 @ 24 O.C. TYP.
TO MATCH TO EXIST. ADJACENT AREA
DO NOT REMOVE WALL TO REVEAL AIR
CONCRETE. PLAN INCL. DR. SEE PLAN.

EXIT 1/2" ACQU. TILE OVER
1 1/2" x 3" STRIP, 16 O.C. @ 1/2"
GR. SD. PATCH & REPAIR T.M.E.
(PAINT ACOUSTIC TILE @ S. WALL)

