



MULTI-PURPOSE - CAFETERIUM

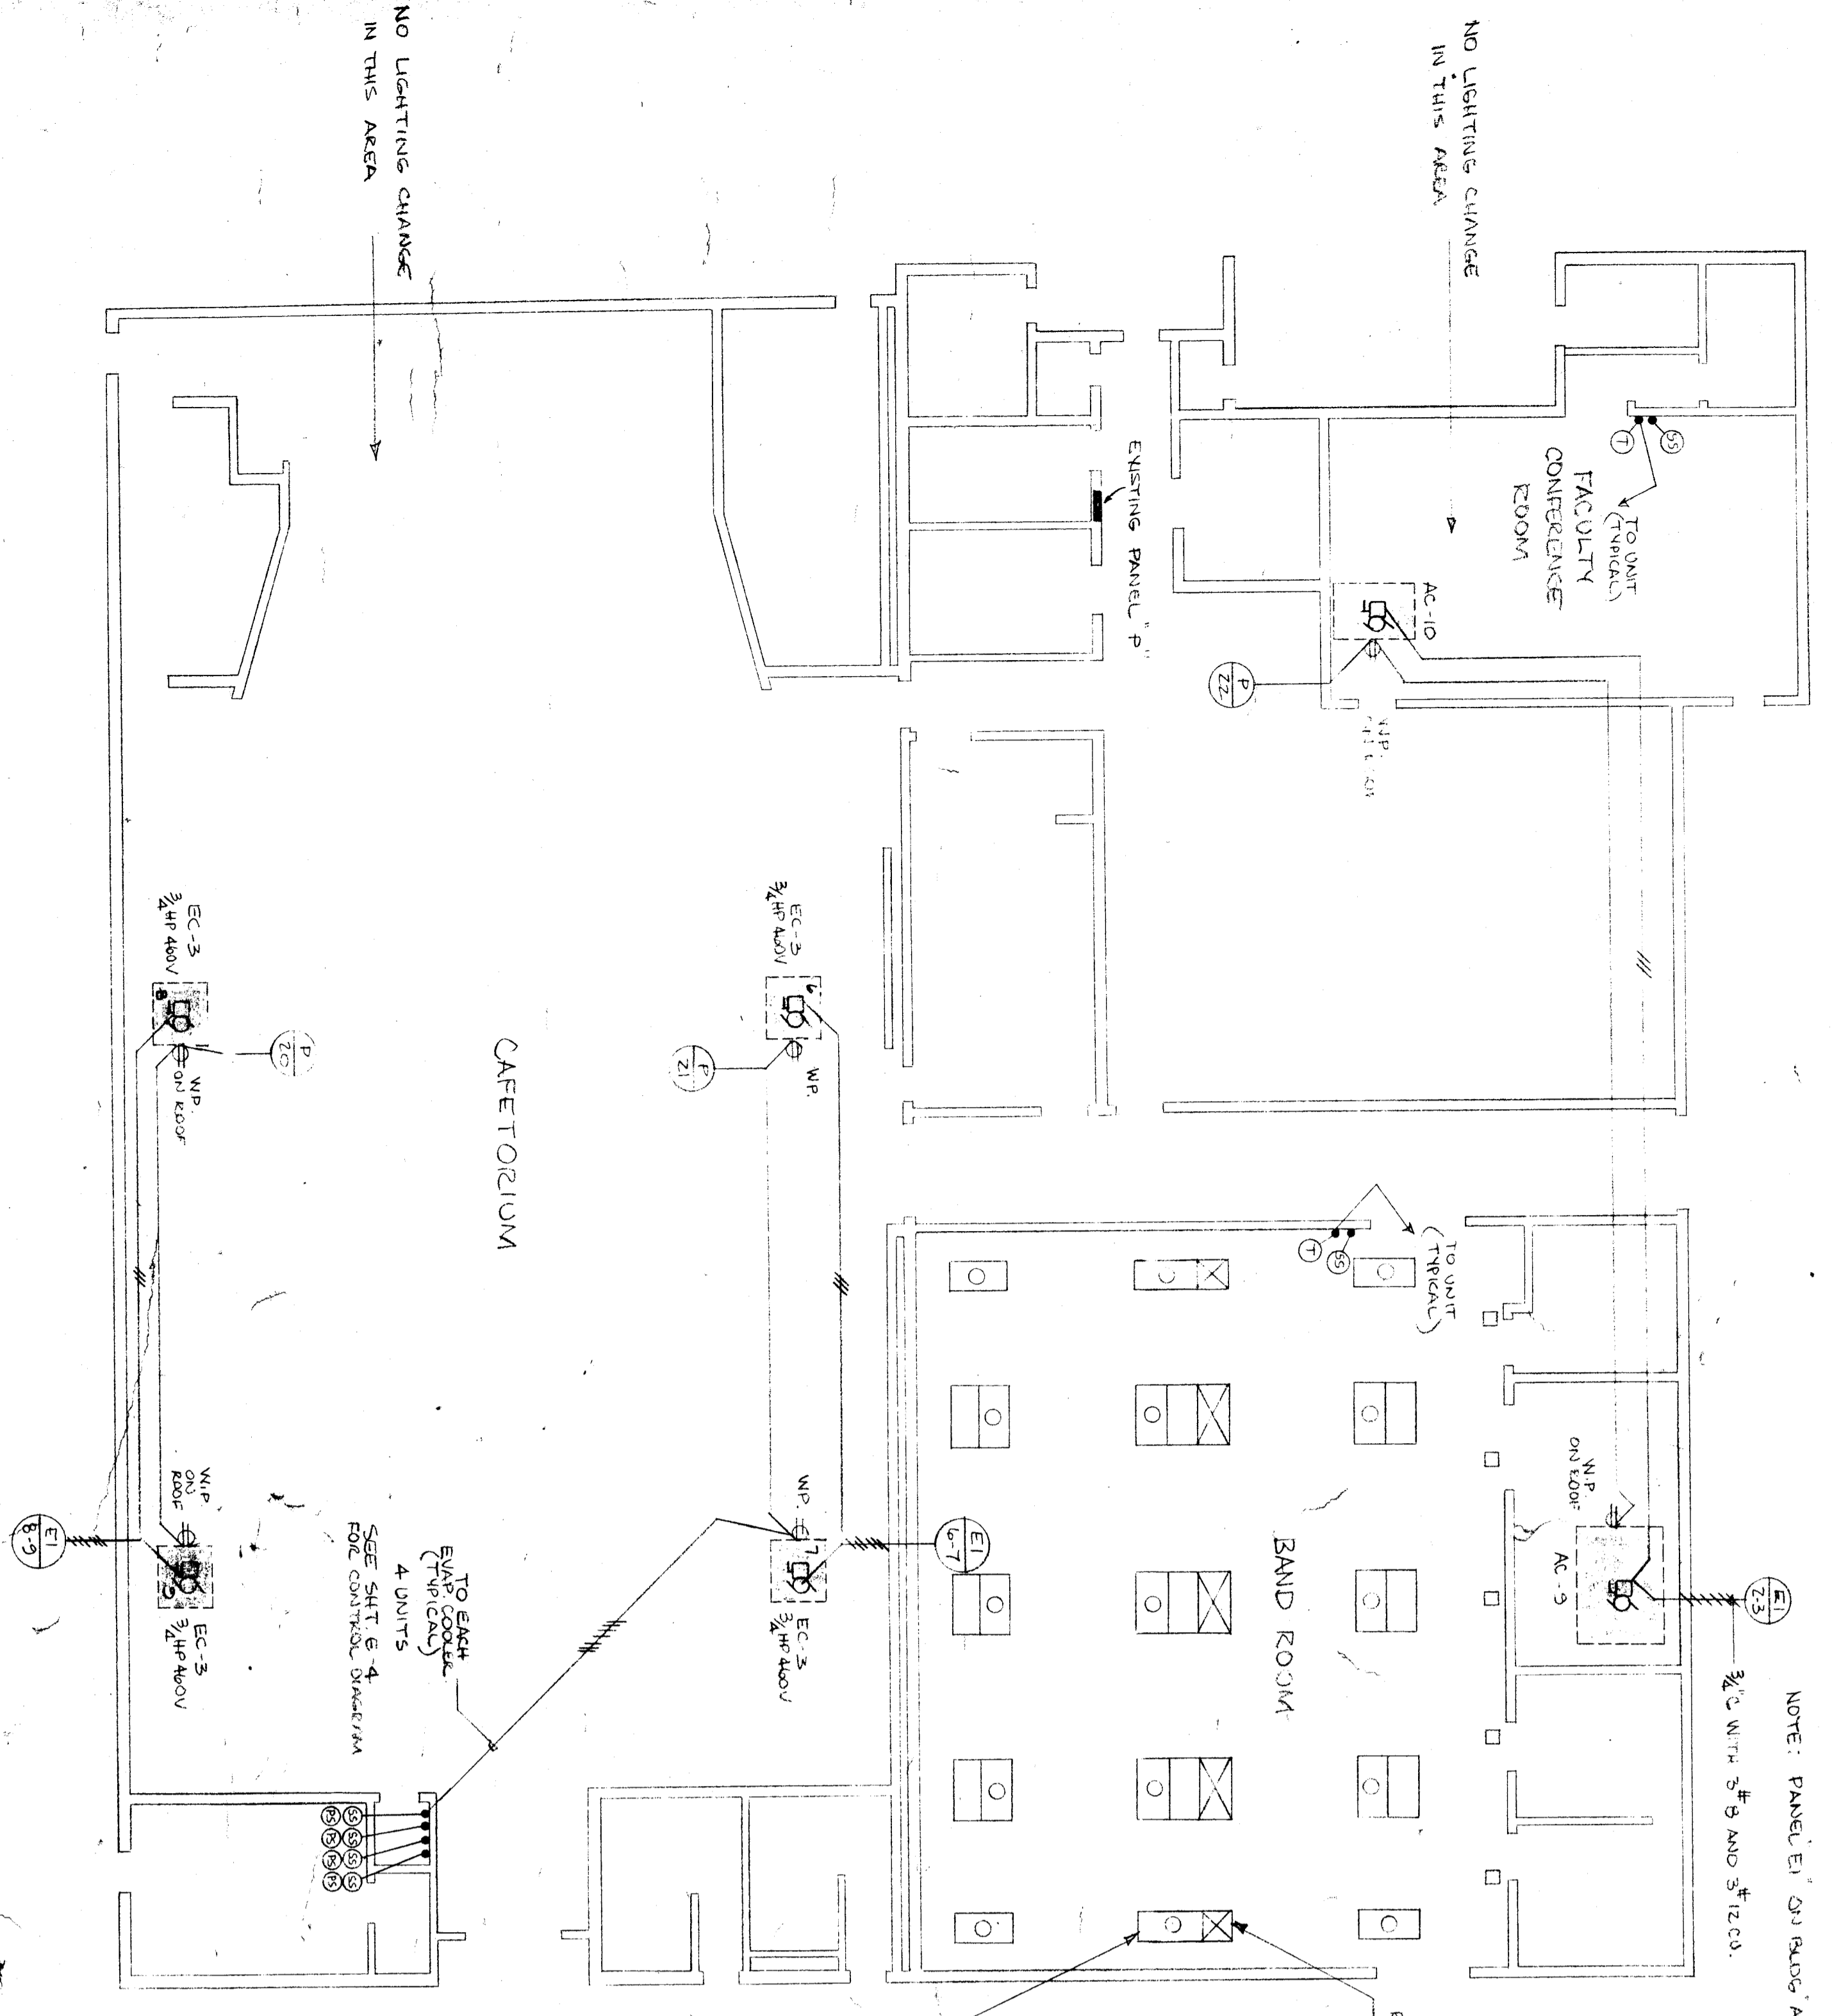

SCALE: 1/8" = 1'-0"

BUILDING 'B'

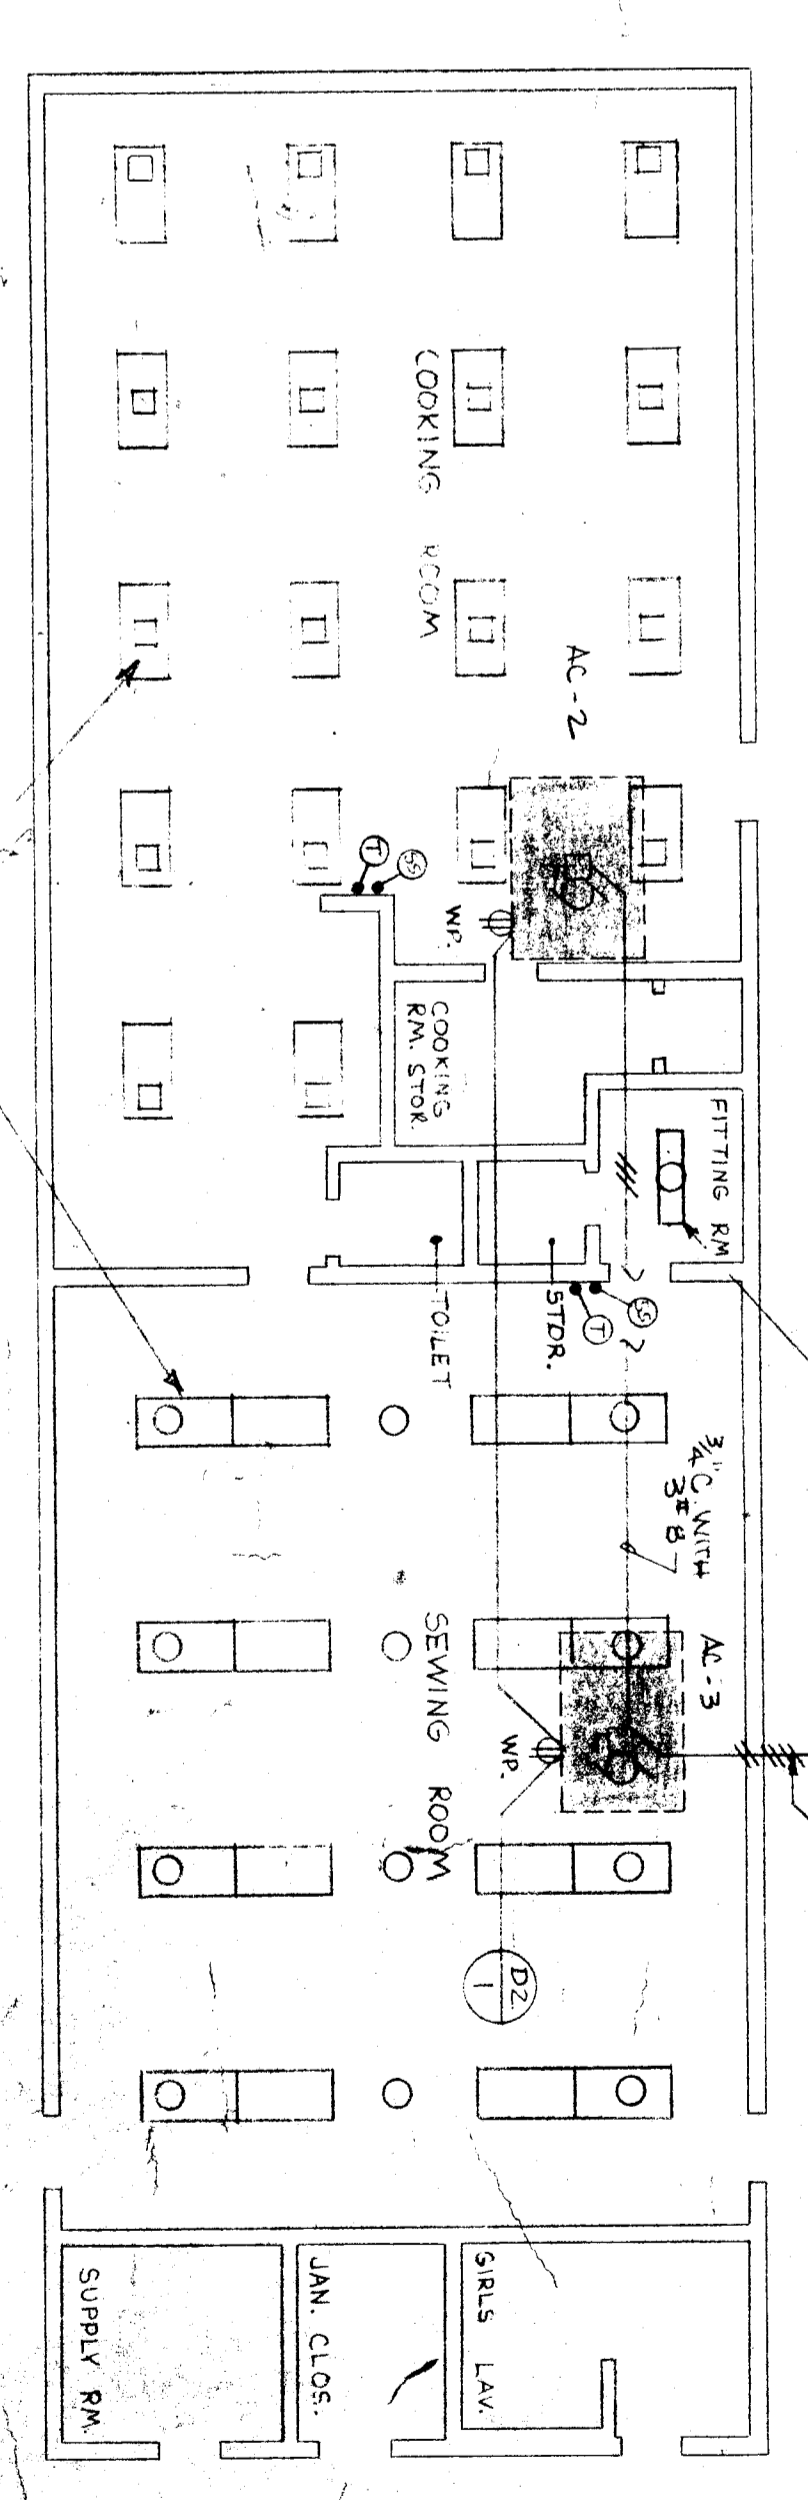

BUILDING 'A'

