



1	REPAIR AIR DUCT
2	REPAIR AIR DUCT
3	INDIRECT WATER
4	INDIRECT WATER
BUIL. NO.	ROOM NAME	SUPPLY	FAN	E.B.C.	HP	V	Φ	STAGE	FURNACE			DIRECT EXPANSION			CONDENSING UNIT			FILTERS			D.A.M.P.E.R.S.	OPERATING WEIGHT	SER.	REMARKS		
									INPUT BTU/HR.	OUTPUT BTU/HR.	EUT. AIR.	AREA VEL. SQ. FT./HR.	EUT. AIR. CAPACITY BTU/HR.	AREA VEL. SQ. FT./HR.	EUT. AIR. CAPACITY BTU/HR.	AREA VEL. SQ. FT./HR.	SIZE OF	SIZE	O.A.	R.A.						
AC-1	TYPICAL CLASSROOM	1,800	.5	1	140	3	1.071	125,000	93,750	60,000	42,500	4.0	150	8.0	1.0	1.0	1.0	1.0	1.0	1.0	1.0	875 LBS.	7.0	1		
AC-2	COOKING ROOM	3,000	.7	2	1	1	1.071	150,000	112,500	65,000	7.5	140	8.0	1.0	1.0	1.0	1.0	1.0	1.0	1.0	300	2,700	1,050 LBS.	6.7	1	
AC-3	SEWING ROOM	1,800	.5	1	1	1	1.071	125,000	93,750	60,000	4.0	150	8.0	1.0	1.0	1.0	1.0	1.0	1.0	1.0	300	2,700	1,050 LBS.	6.7	1	
AC-4	ADMIN. EAST ZONE	1,200	.3	1/2	1	1	1.071	90,000	67,500	40,000	4.0	150	8.0	1.0	1.0	1.0	1.0	1.0	1.0	1.0	300	2,700	1,050 LBS.	6.7	1	
AC-5	ADMIN. WEST ZONE	1,200	.3	1/2	1	1	1.071	90,000	67,500	40,000	4.0	150	8.0	1.0	1.0	1.0	1.0	1.0	1.0	1.0	300	2,700	1,050 LBS.	6.7	1	
AC-6	LIBRARY	2,200	.5	3/4	1	1	1.071	120,000	90,000	55,000	4.0	150	8.0	1.0	1.0	1.0	1.0	1.0	1.0	1.0	300	2,700	1,050 LBS.	6.7	1	
AC-7	ART ROOM	2,200	.5	3/4	1	1	1.071	120,000	90,000	55,000	4.0	150	8.0	1.0	1.0	1.0	1.0	1.0	1.0	1.0	300	2,700	1,050 LBS.	6.7	1	
AC-8	VOCAL MUSIC ROOM	1,800	.5	1	1	1	1.071	125,000	93,750	60,000	4.0	150	8.0	1.0	1.0	1.0	1.0	1.0	1.0	1.0	300	2,700	1,050 LBS.	6.7	1	
AC-9	HAND ROOM	3,000	.7	2	1	1	1.071	150,000	112,500	65,000	7.5	140	8.0	1.0	1.0	1.0	1.0	1.0	1.0	1.0	300	2,700	1,050 LBS.	6.7	1	
AC-10	FACULTY CONFERENCE	1,200	.3	3/4	1	1	1.071	90,000	67,500	40,000	4.0	150	8.0	1.0	1.0	1.0	1.0	1.0	1.0	1.0	300	2,700	1,050 LBS.	6.7	1	
UH-1	WOOD SHOP	1,195	.5	1/2	120	1	1.071	105,000	78,750	48,000	4.0	150	8.0	1.0	1.0	1.0	1.0	1.0	1.0	1.0	300	2,700	1,050 LBS.	6.7	2	REGRD.
UH-2	METAL SHOP	850	.5	1/2	120	1	1.071	75,000	56,250	33,000	4.0	150	8.0	1.0	1.0	1.0	1.0	1.0	1.0	1.0	300	2,700	1,050 LBS.	6.7	2	REGRD.
DF-1	CATERING	9,400	.5	—	—	—	—	2,072	3,150,000	2,362,500	1,438,000	11.8	183	—	—	—	—	—	—	—	—	—	—	—	—	—
EC-1	WOOD SHOP	9,100	.5	1	150	3	—	—	—	—	—	—	—	—	—	—	—	—	—	—	—	—	—	—	—	—
EC-2	METAL SHOP	9,800	.5	1	150	3	—	—	—	—	—	—	—	—	—	—	—	—	—	—	—	—	—	—	—	—
EC-3	CATERING	9,700	.5	3/4	150	3	—	—	—	—	—	—	—	—	—	—	—	—	—	—	—	—	—	—	—	—


① CONDENSER FAN RATED @ 400 V, 1/4
 ② CONDENSER FAN RATED @ 208 V, 1/4
 * UNIT FURNISHED WITH VERTICAL TO HORIZONTAL CONVERSION KIT

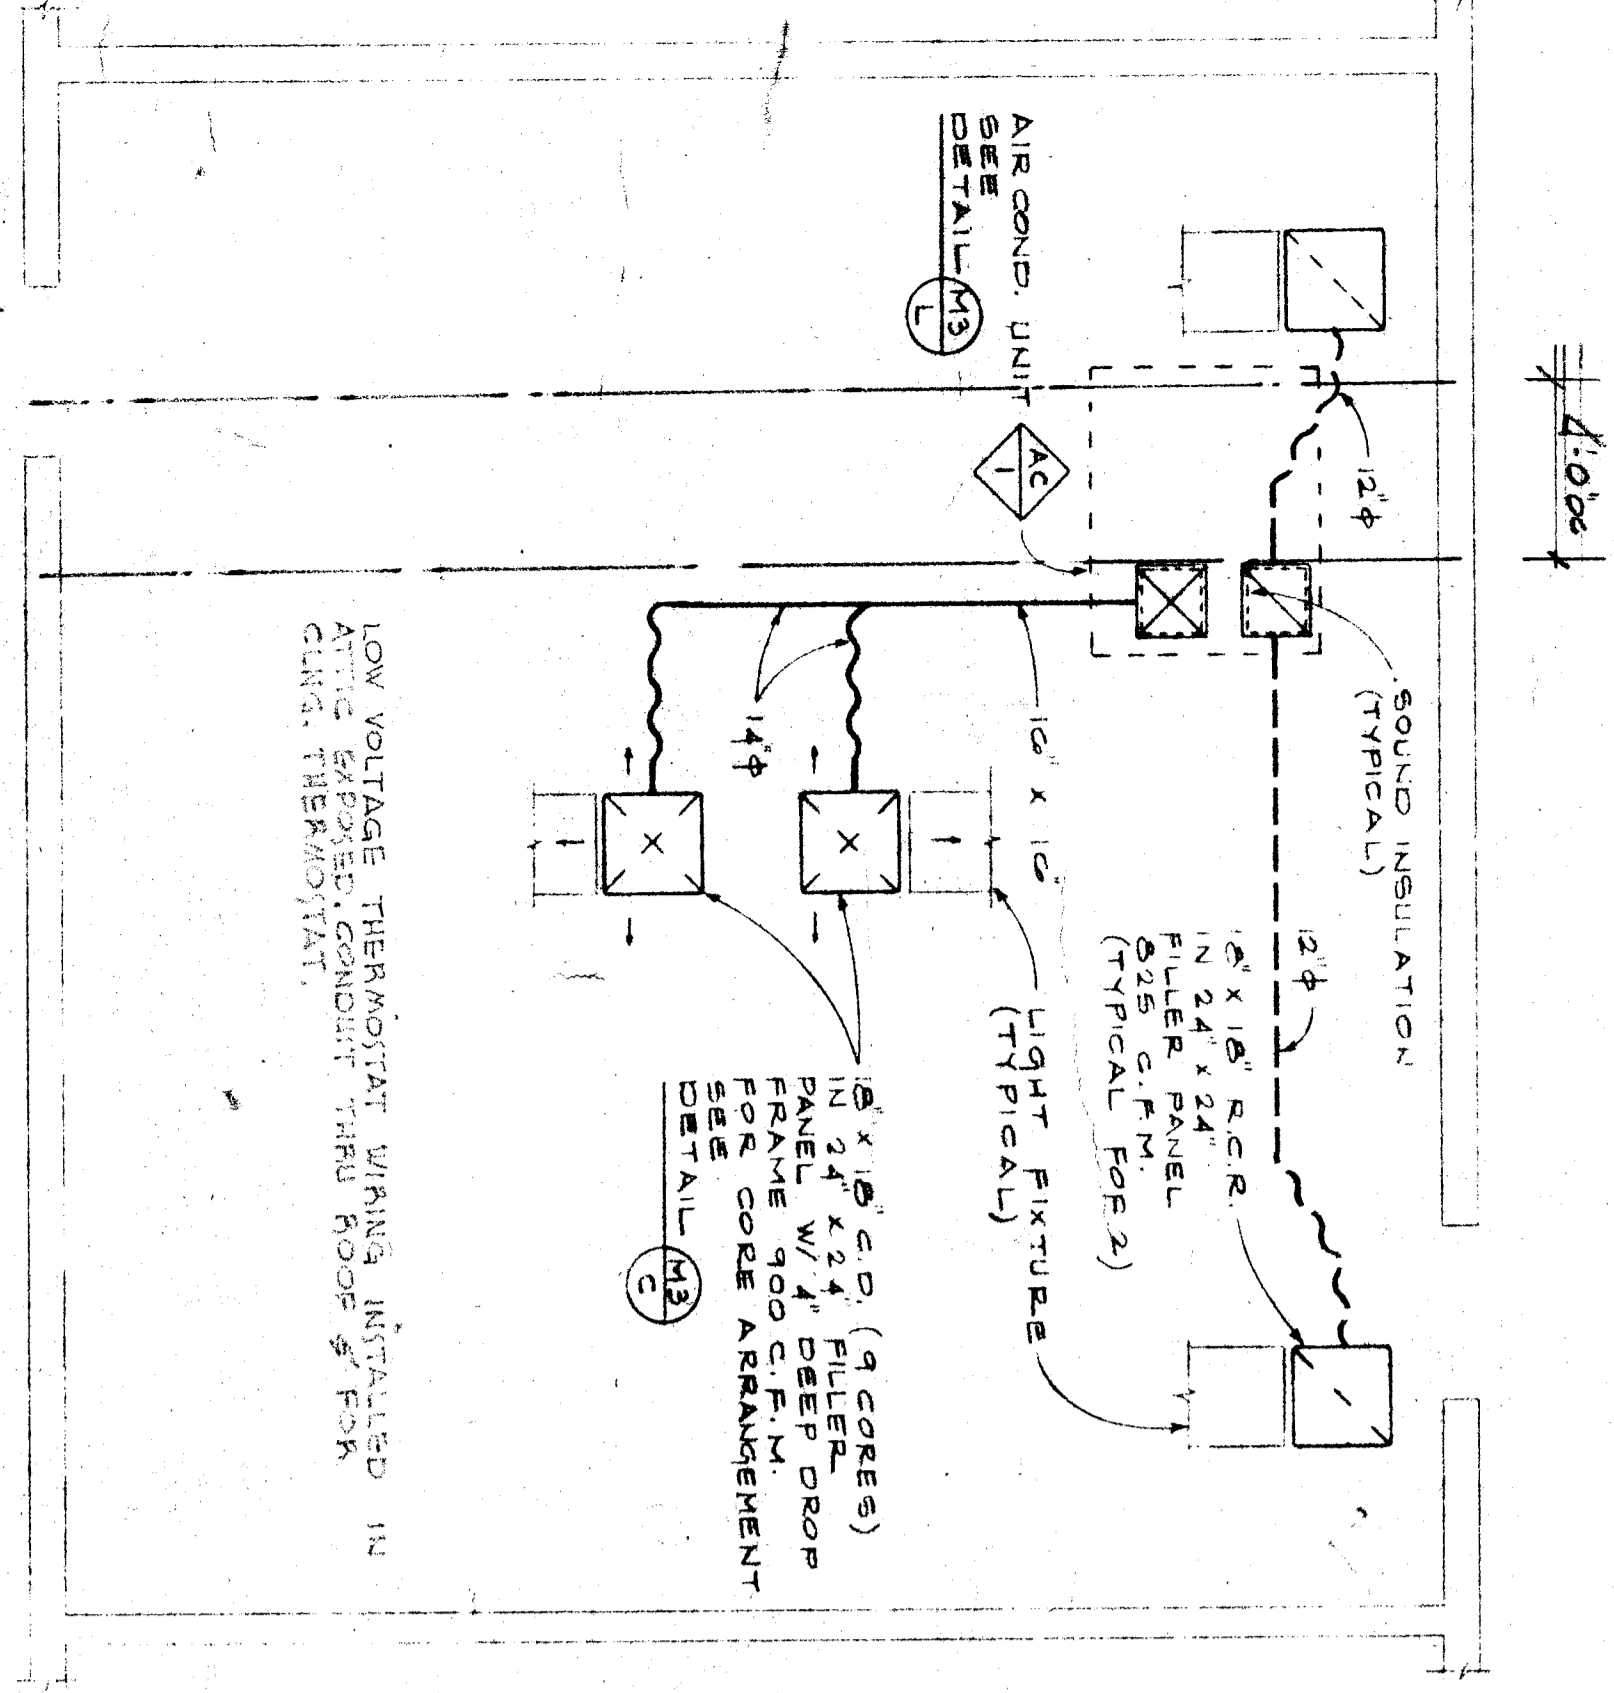


TYPICAL CLASSROOM PLAN
 SCALE: 1/4" = 1'-0"
 DETAIL: 1/4"

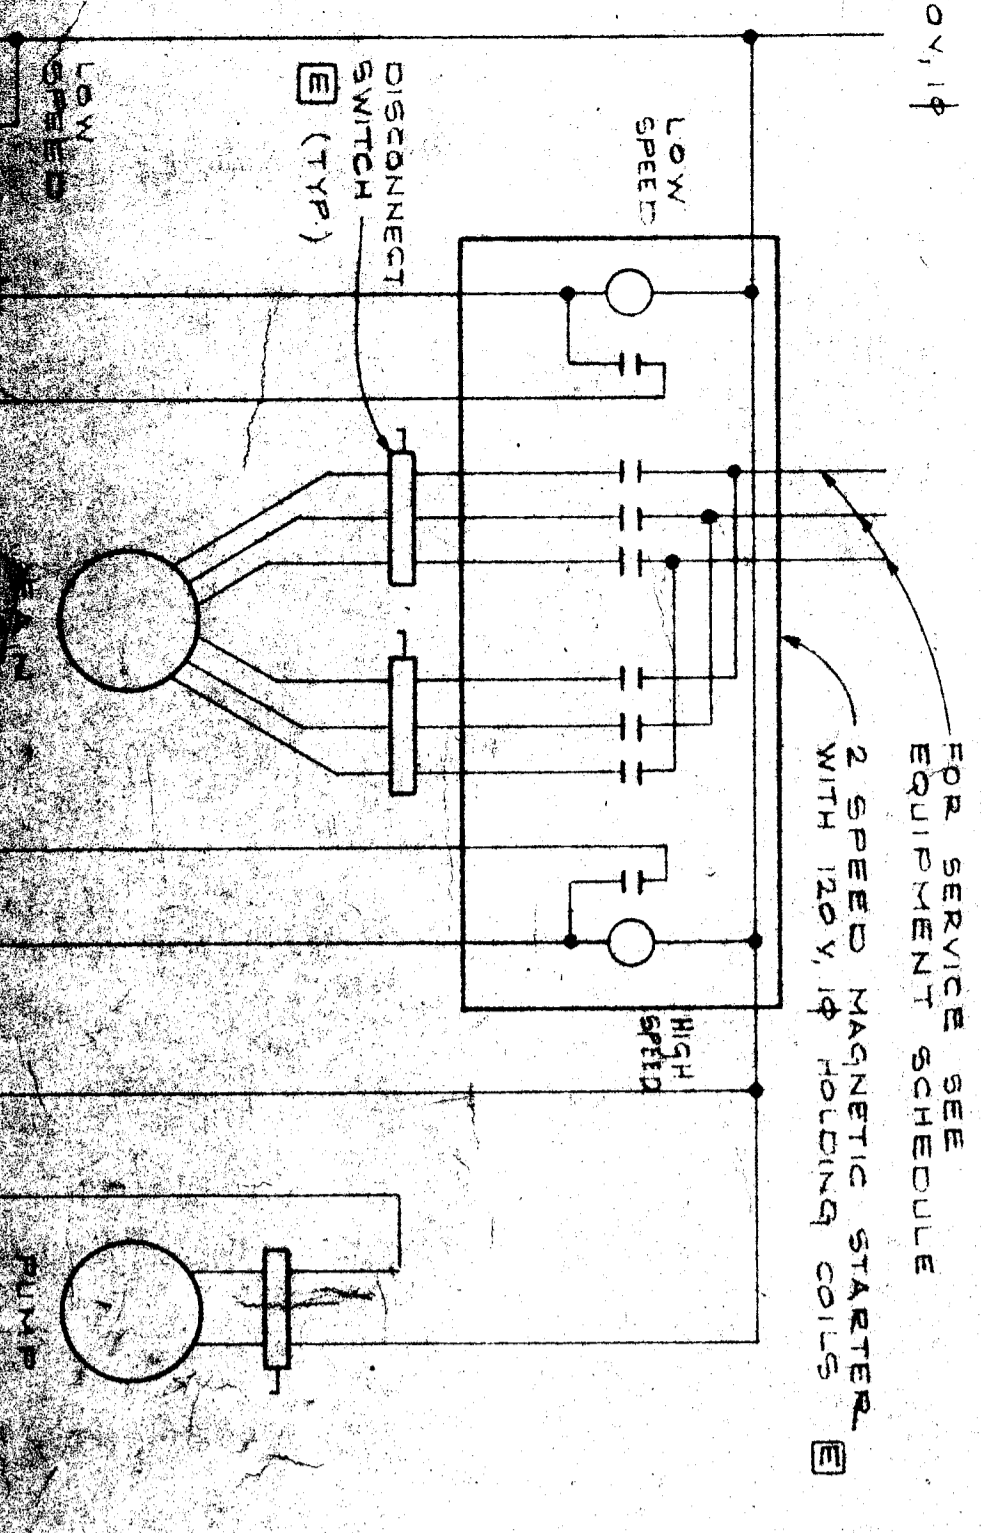


120V, 1ϕ
 EQUIPMENT SEE EQUIPMENT SCHEDULE
 2 SPEED MAGNETIC STARTER
 LOW SPEED
 HIGH SPEED
 DISCONNECT SWITCH (TYP)

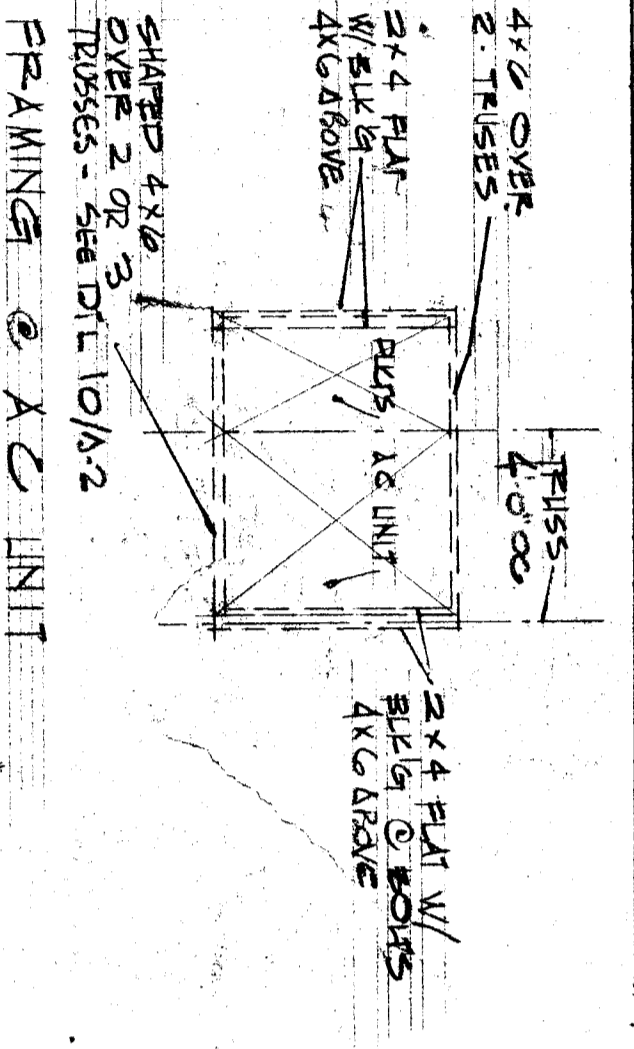


TYPICAL SQUARE CEILING DIFFUSER
 NO SCALE: DETAIL: 1/4"

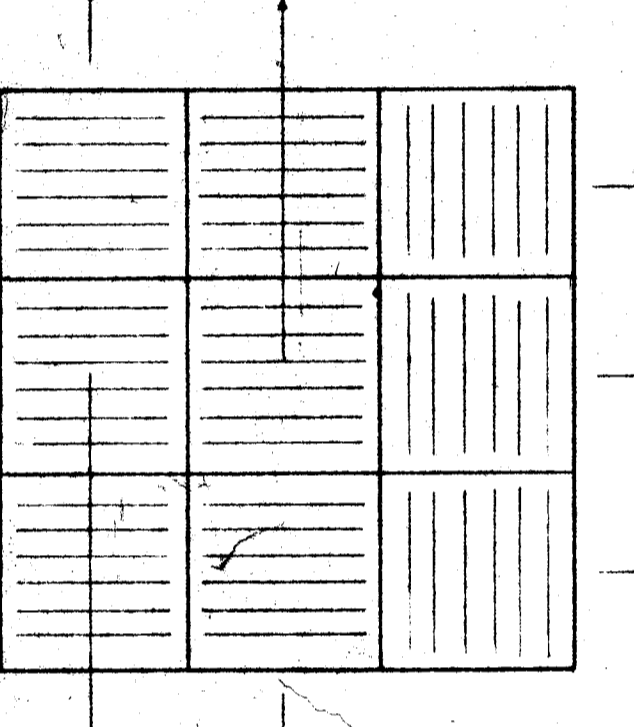


TYPICAL CLASSROOM CEILING DIFFUSER
 NO SCALE: DETAIL: 1/4"

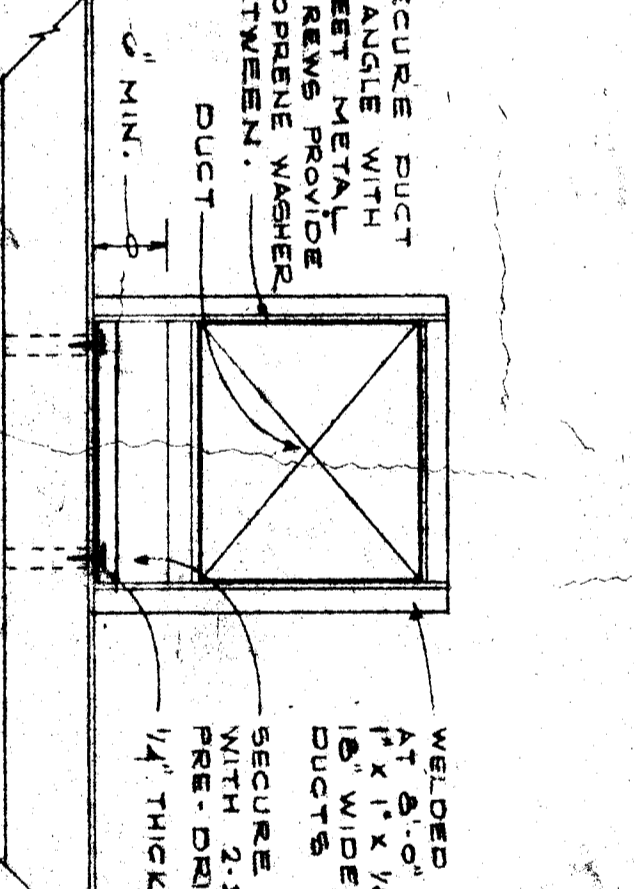


DUCT ON ROOF SUPPORT
 NO SCALE: DETAIL: 1/4"

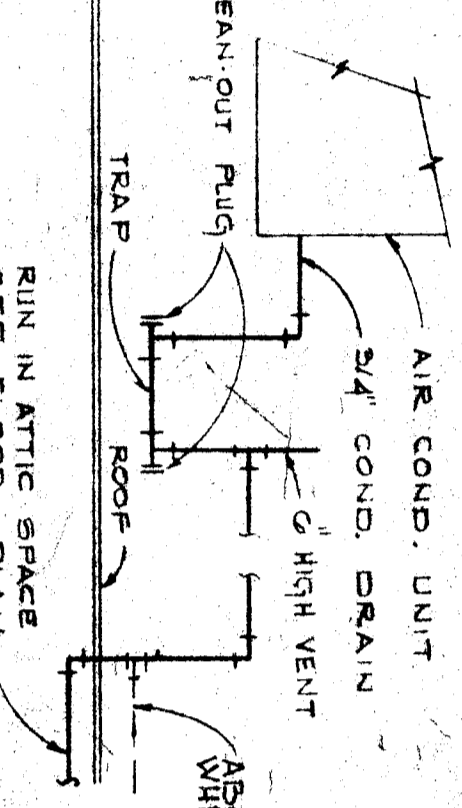


CONDENSATE DRAIN
 NO SCALE: DETAIL: 1/4"

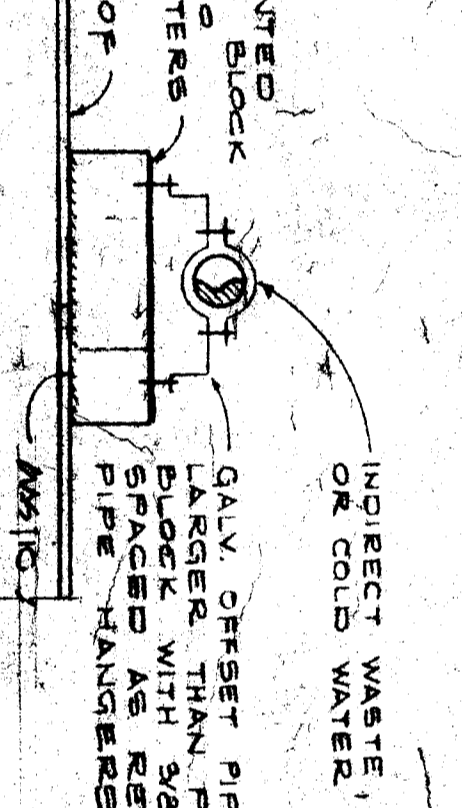


TYPICAL CLASSROOM CEILING DIFFUSER
 NO SCALE: DETAIL: 1/4"

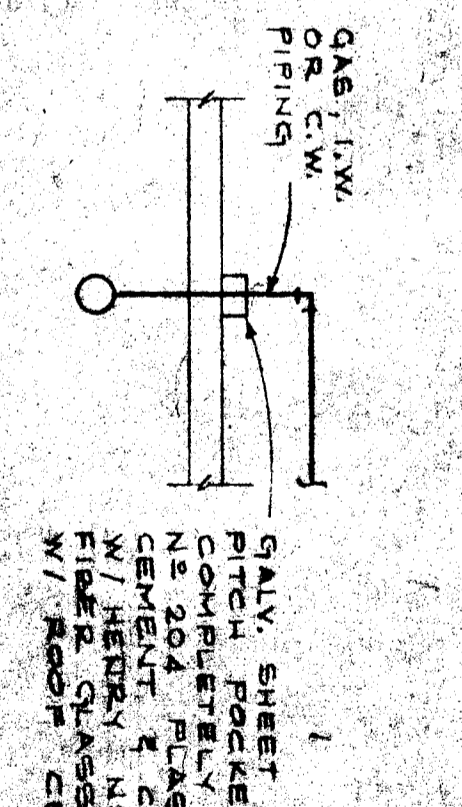

PIPING THRU ROOF
 NO SCALE: DETAIL: 1/4"

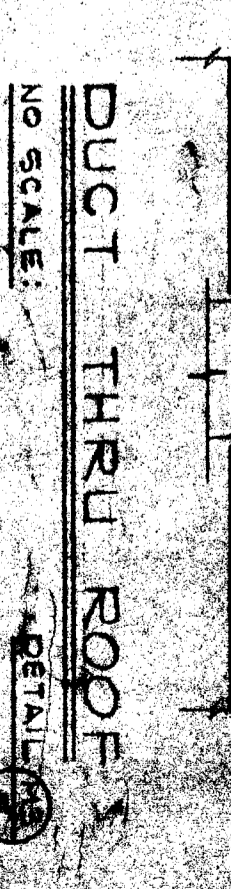

DUCT THRU ROOF
 NO SCALE: DETAIL: 1/4"

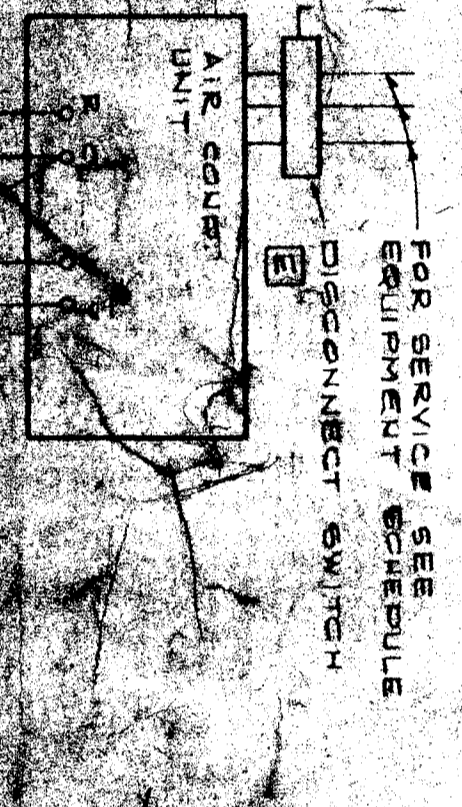

FOR SERVICE SEE EQUIPMENT SCHEDULE
 DISCONNECT SWITCH
 AIR COND. UNIT



FOR SERVICE SEE EQUIPMENT SCHEDULE
 DISCONNECT SWITCH
 AIR COND. UNIT



FOR SERVICE SEE EQUIPMENT SCHEDULE
 DISCONNECT SWITCH
 AIR COND. UNIT