


NOTE: THE EXIST. SHOP WING IS TO BE DEMOLISHED AND THE NEW SHOP WING IS TO BE CONSTRUCTED IN THE SAME LOCATION. THE EXIST. SHOP WING IS TO BE DEMOLISHED AND THE NEW SHOP WING IS TO BE CONSTRUCTED IN THE SAME LOCATION. THE EXIST. SHOP WING IS TO BE DEMOLISHED AND THE NEW SHOP WING IS TO BE CONSTRUCTED IN THE SAME LOCATION.

SHEET SCHEDULE

| | |
|-----|---|
| No. | Description |
| 1 | Plot Plan - Sheet Schedule |
| 2 | Face Plan - Section - Shop Building - Shop Building |
| 3 | Elevation |
| 4 | Shop Floor Plan |
| 5 | Section - Shop Building |
| 6 | Details - Shop Building |
| 7 | General Details - Shop Building |
| 8 | Accession - Shop |
| 9 | Electrical Layout |
| 10 | Foundation Plan - Shop Building - Shop Building |
| 11 | Structural Section - Shop Building |
| 12 | Structural Section - Shop Building |

GENERAL NOTES

1. All existing structures shall be demolished and the new structures shall be constructed in the same location.
2. All existing structures shall be demolished and the new structures shall be constructed in the same location.
3. The contractor shall provide all materials and labor for the construction of the new structures.

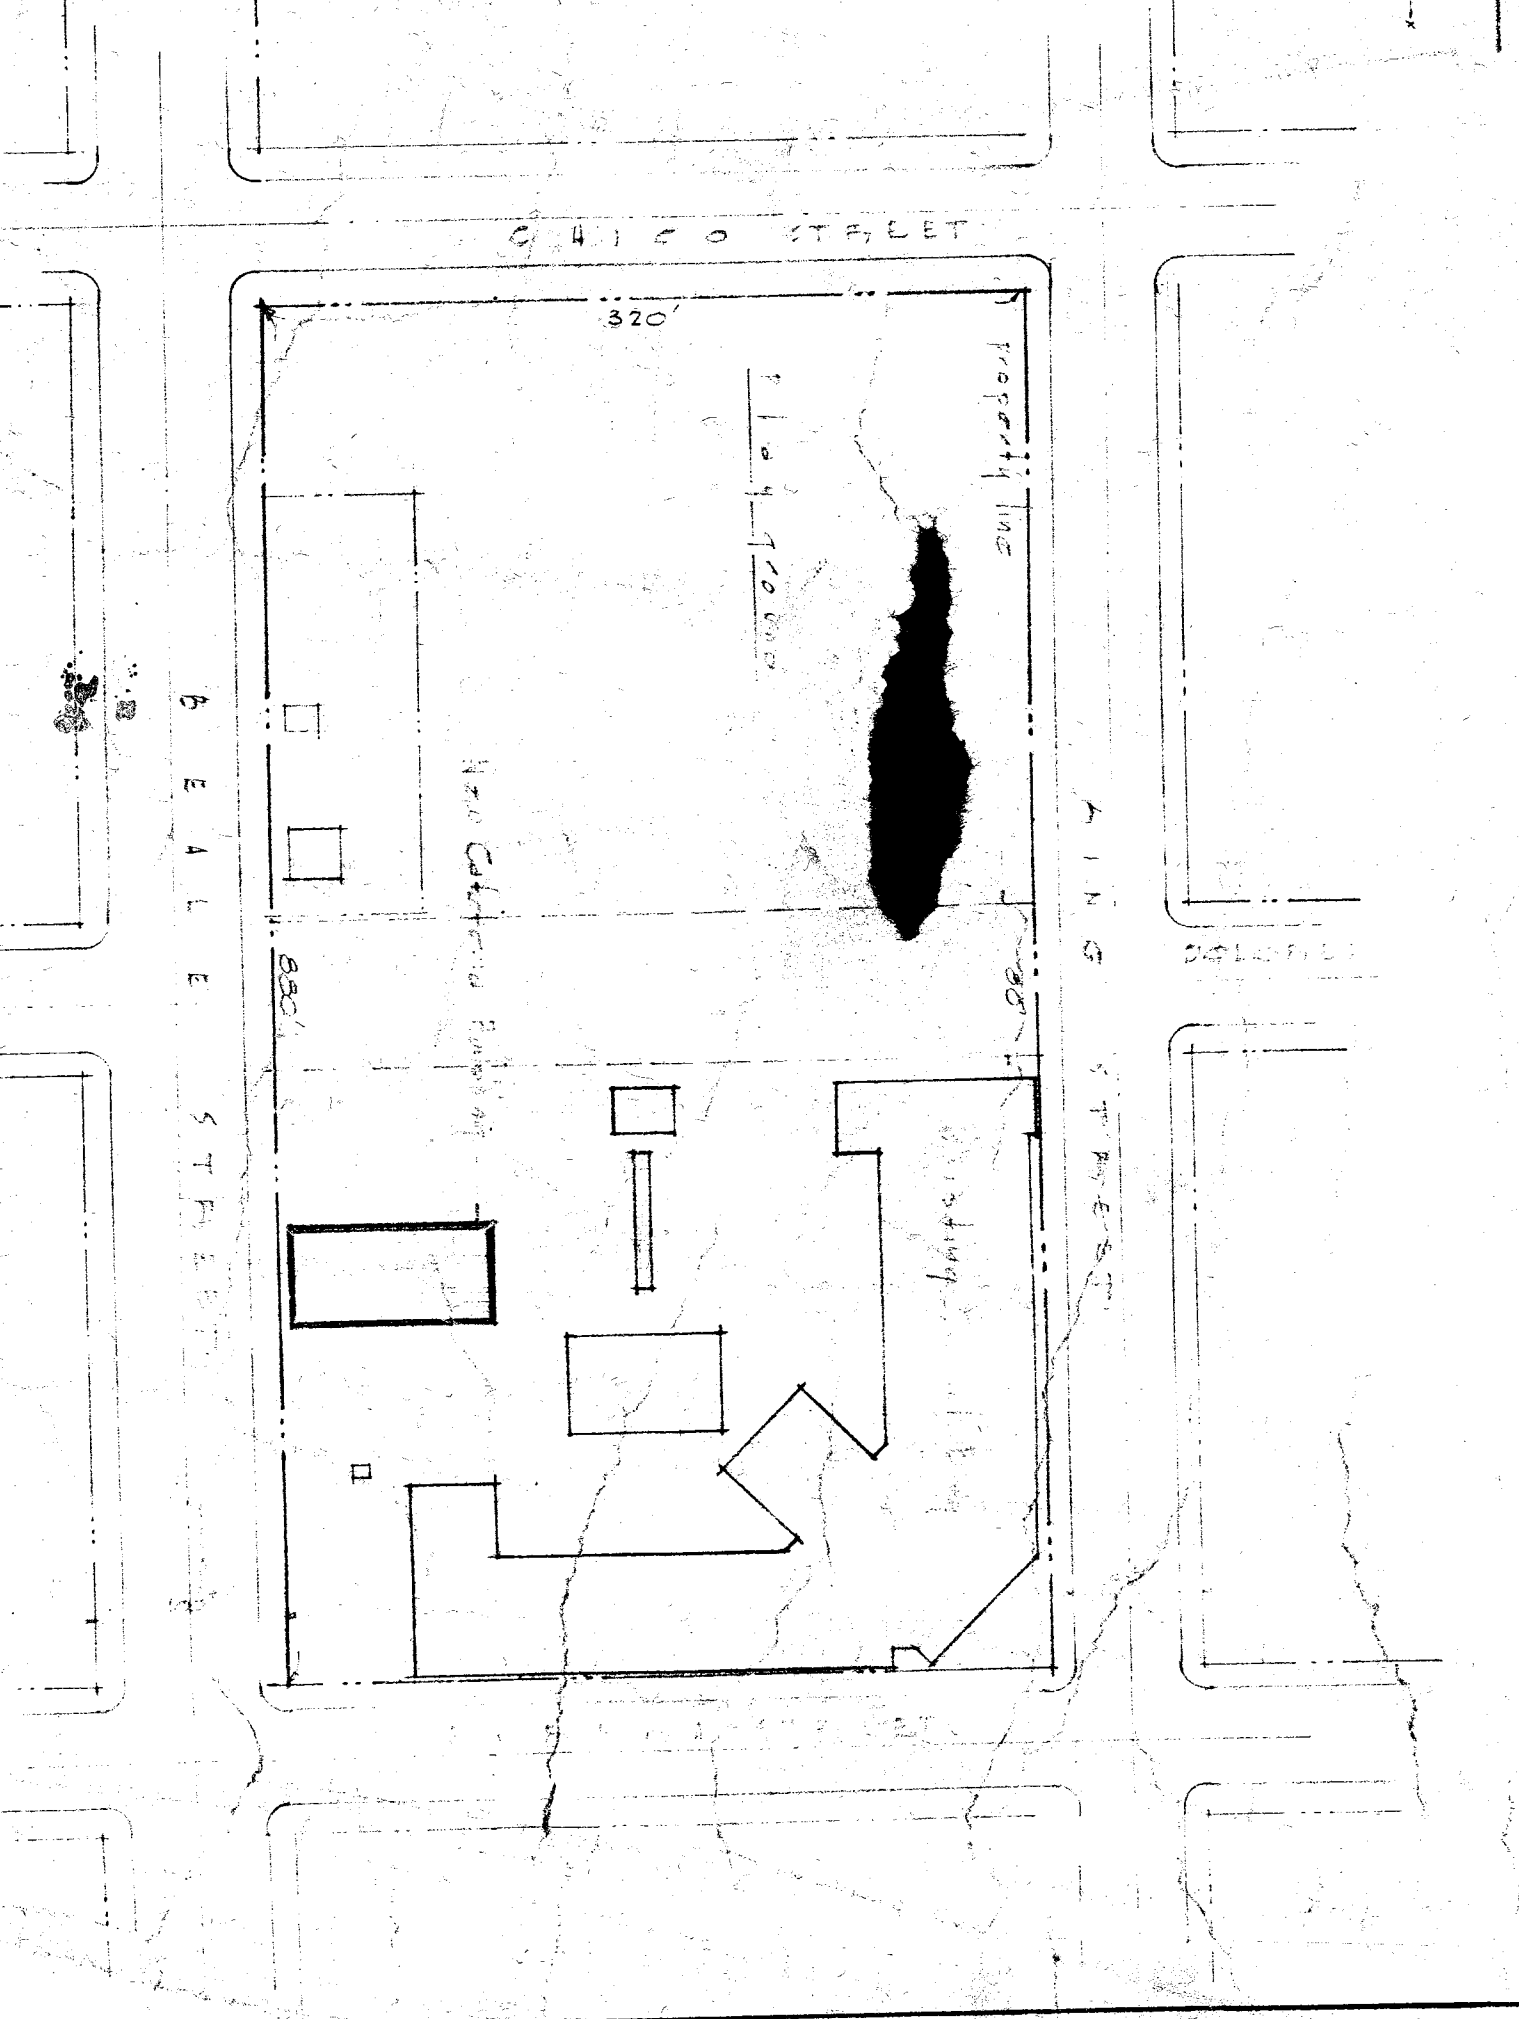

SITE OF CALIFORNIA ARCHITECTURE BOARD
 DIVISION OF ARCHITECTURE
 1774 CHASE
 SAN FRANCISCO, CALIFORNIA 94109
 APPROVED: [Signature]
 DATE: 12-20-50

REVISIONS

| | |
|-----|----------------------------|
| NO. | DESCRIPTION |
| 1 | Plot Plan - Sheet Schedule |
| 2 | NEW CASTLE-HIA BUILDING |

ROBERT N. EDGAR
 ARCHITECT A.I.A.
 2425 KENYON LANE, OAKLAND, CALIFORNIA
 BAKERSFIELD, CALIFORNIA
 12-20-50

1
 SHEET
 1 OF 16 SHEETS