




INTERIOR ELEVATION - EAST WALL - KITCHEN

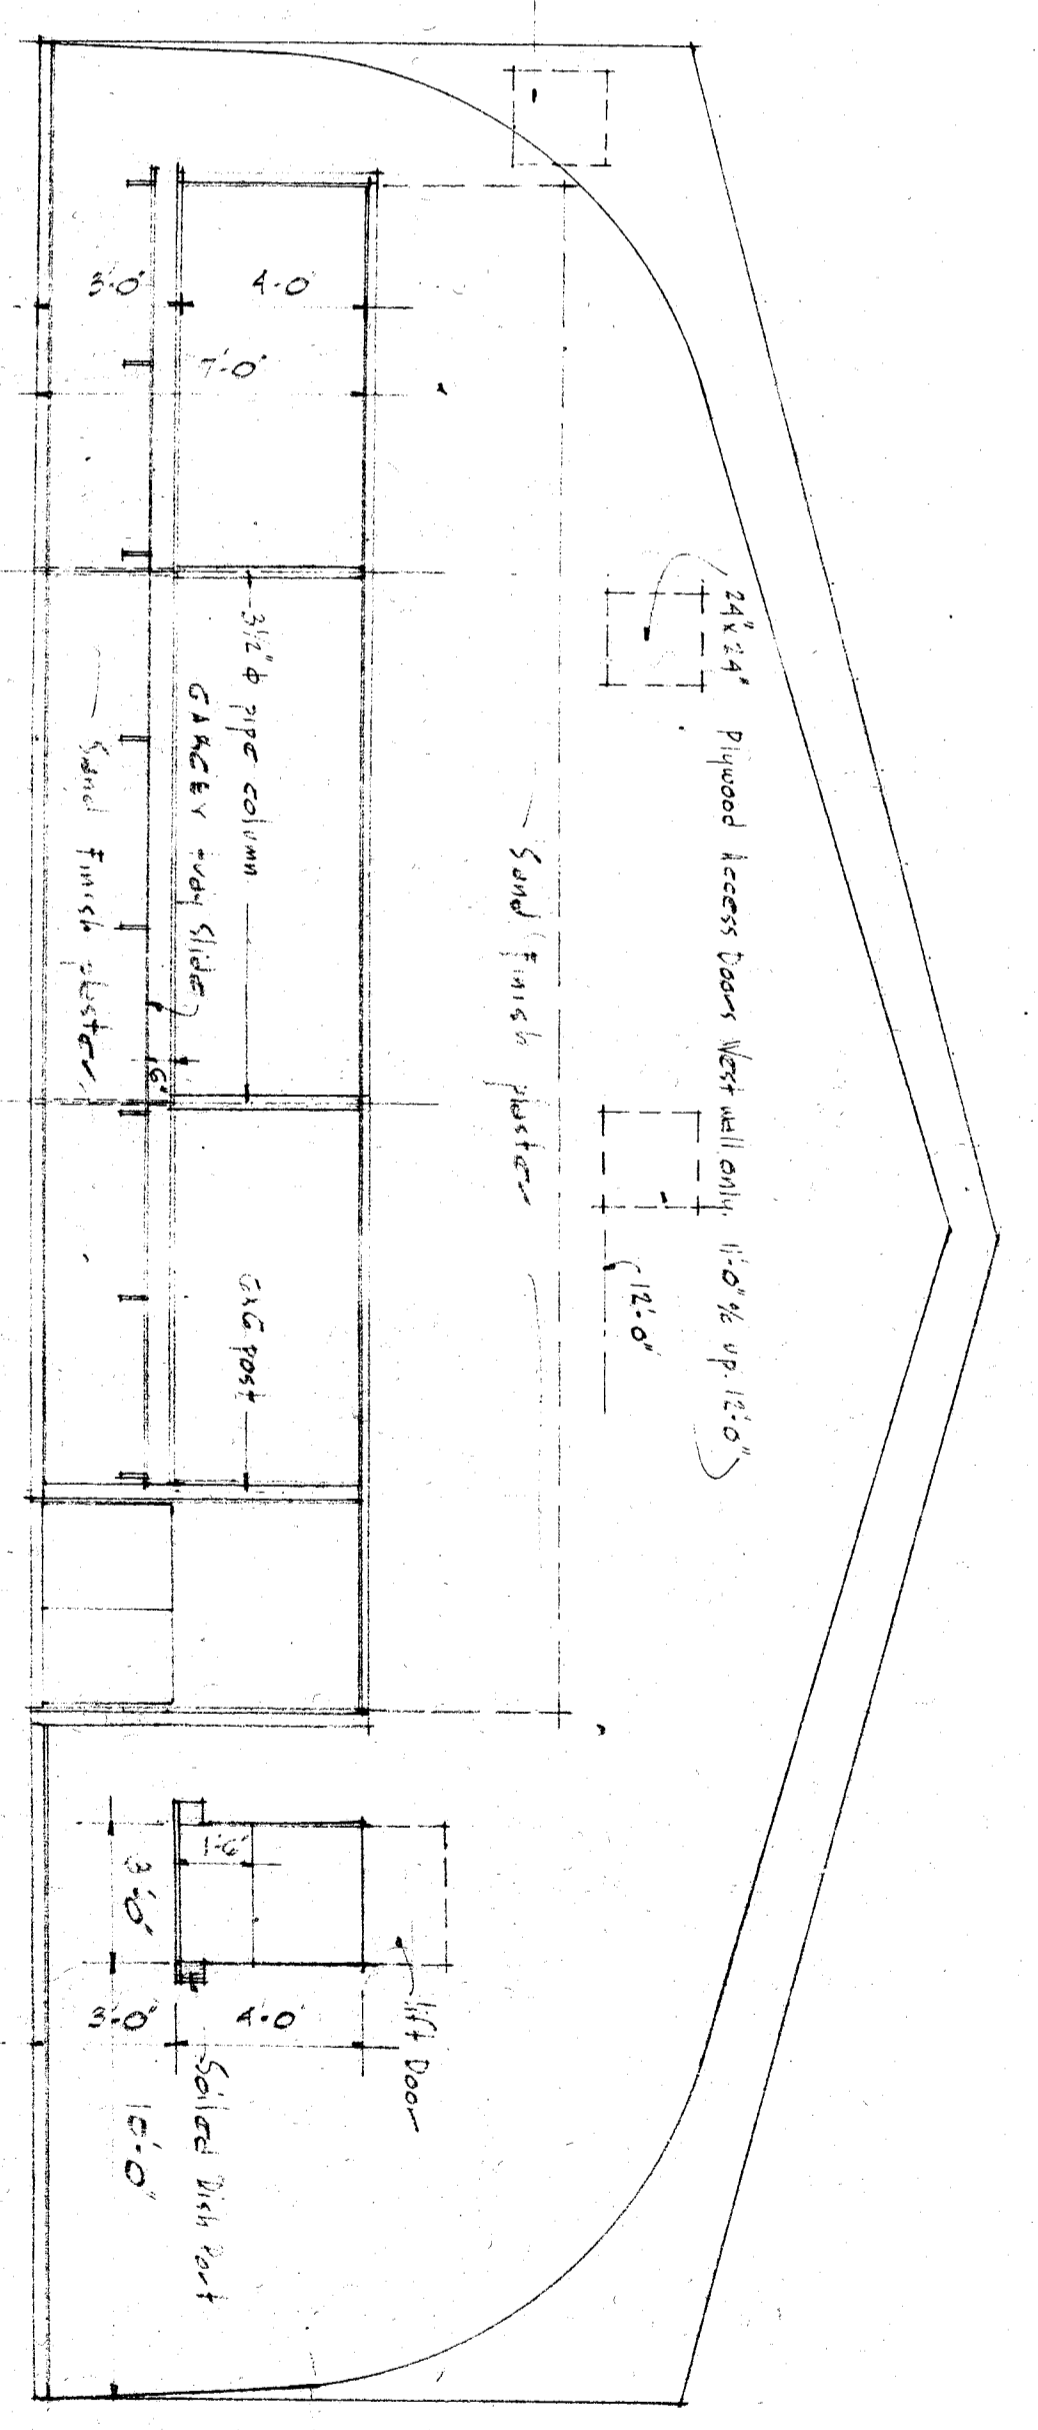


INTERIOR ELEVATION - EAST WALL - DINING ROOM

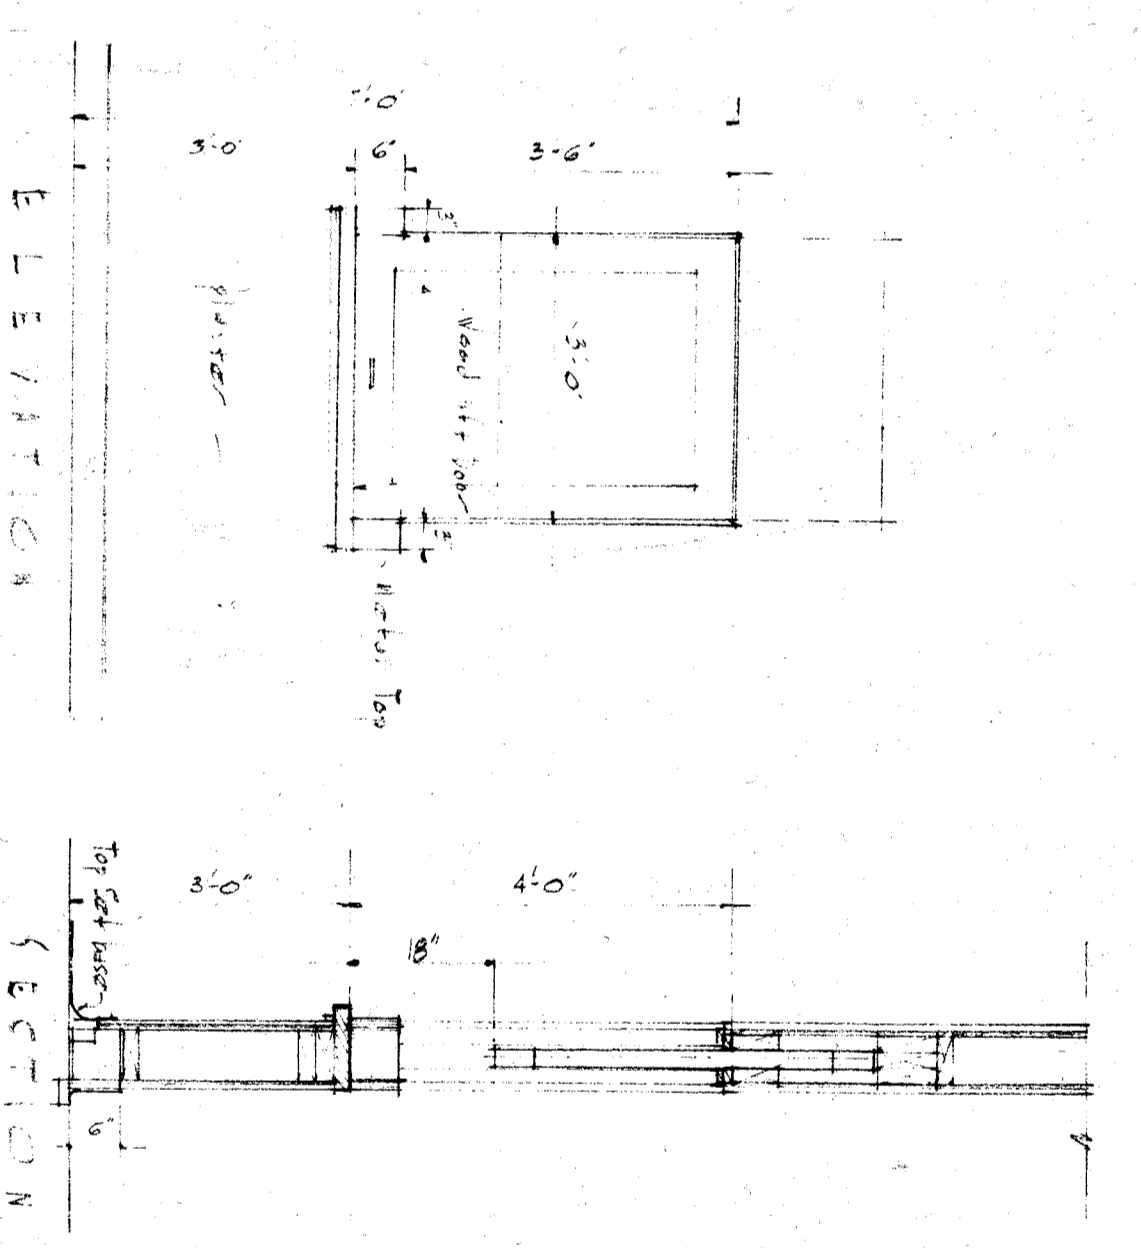


WINDOW DETAIL

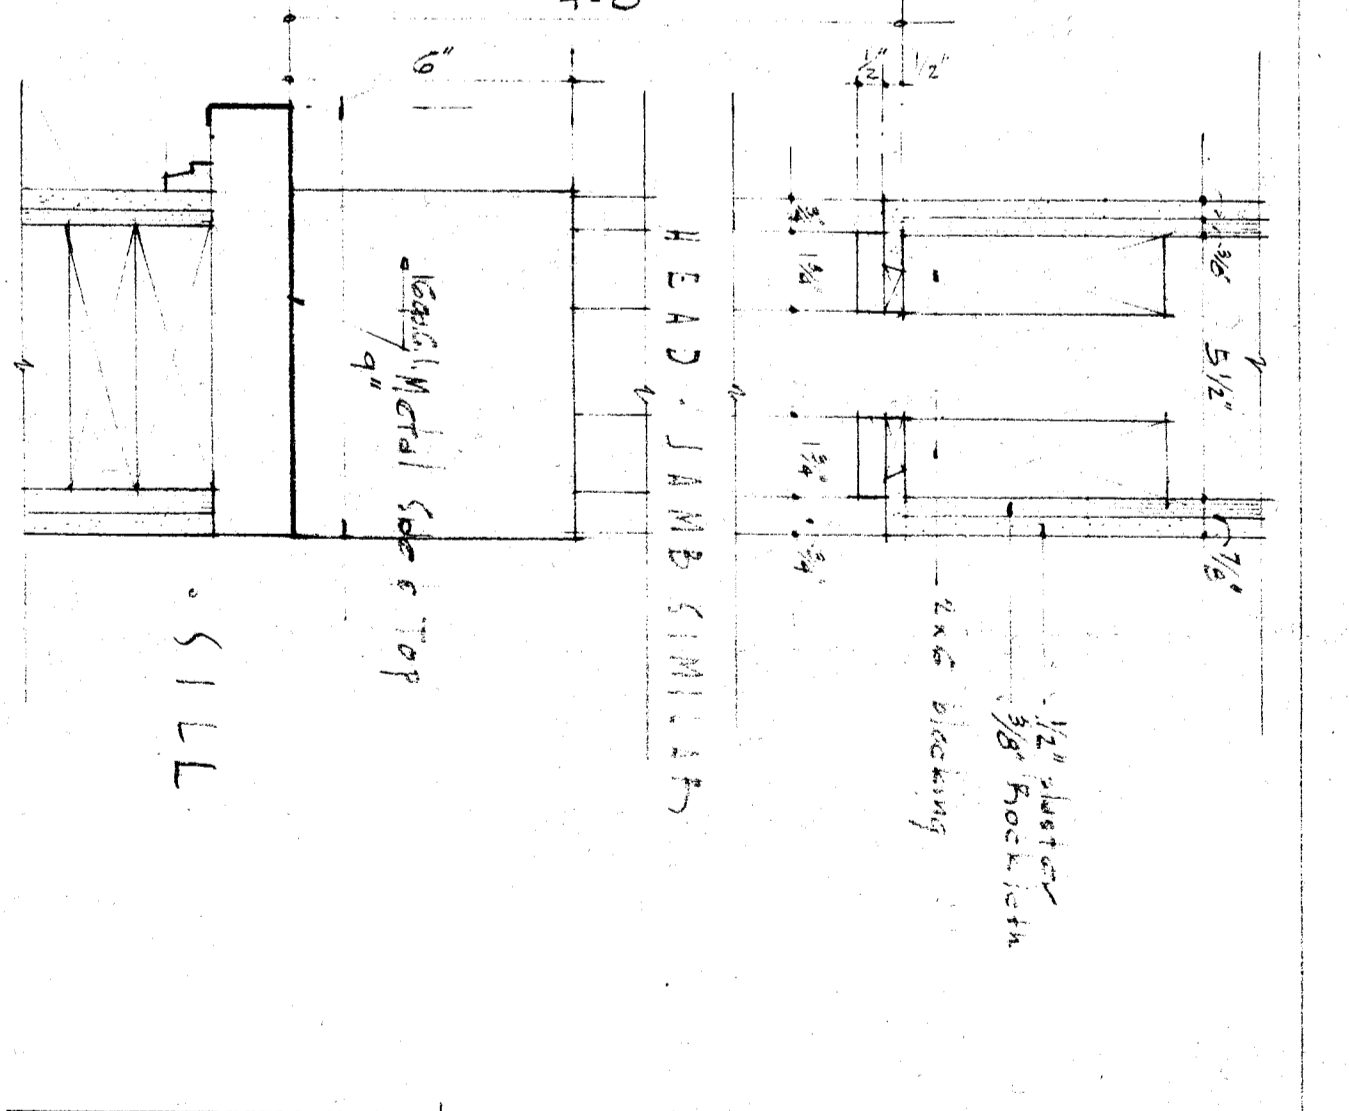

WINDOW DETAIL

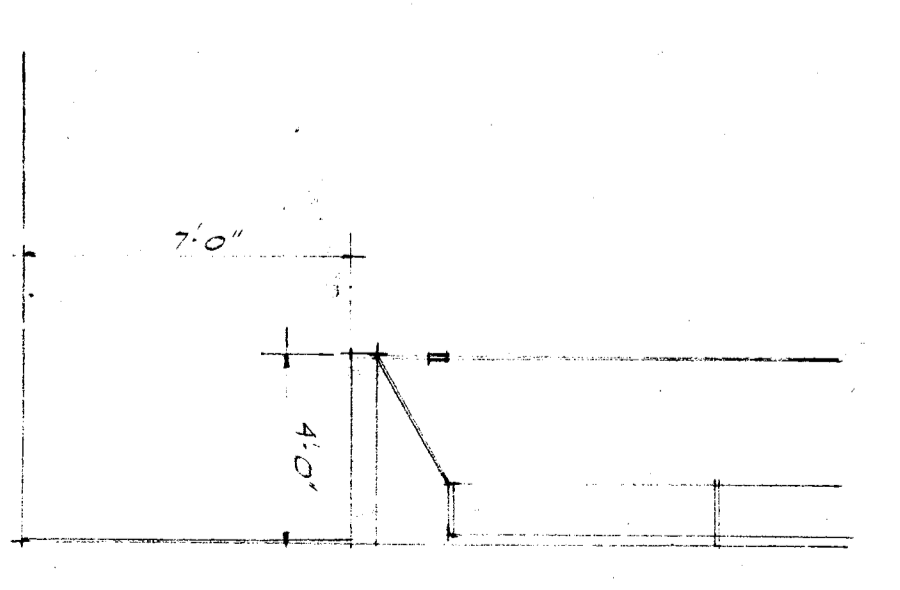

SECTION RANGE HOOD

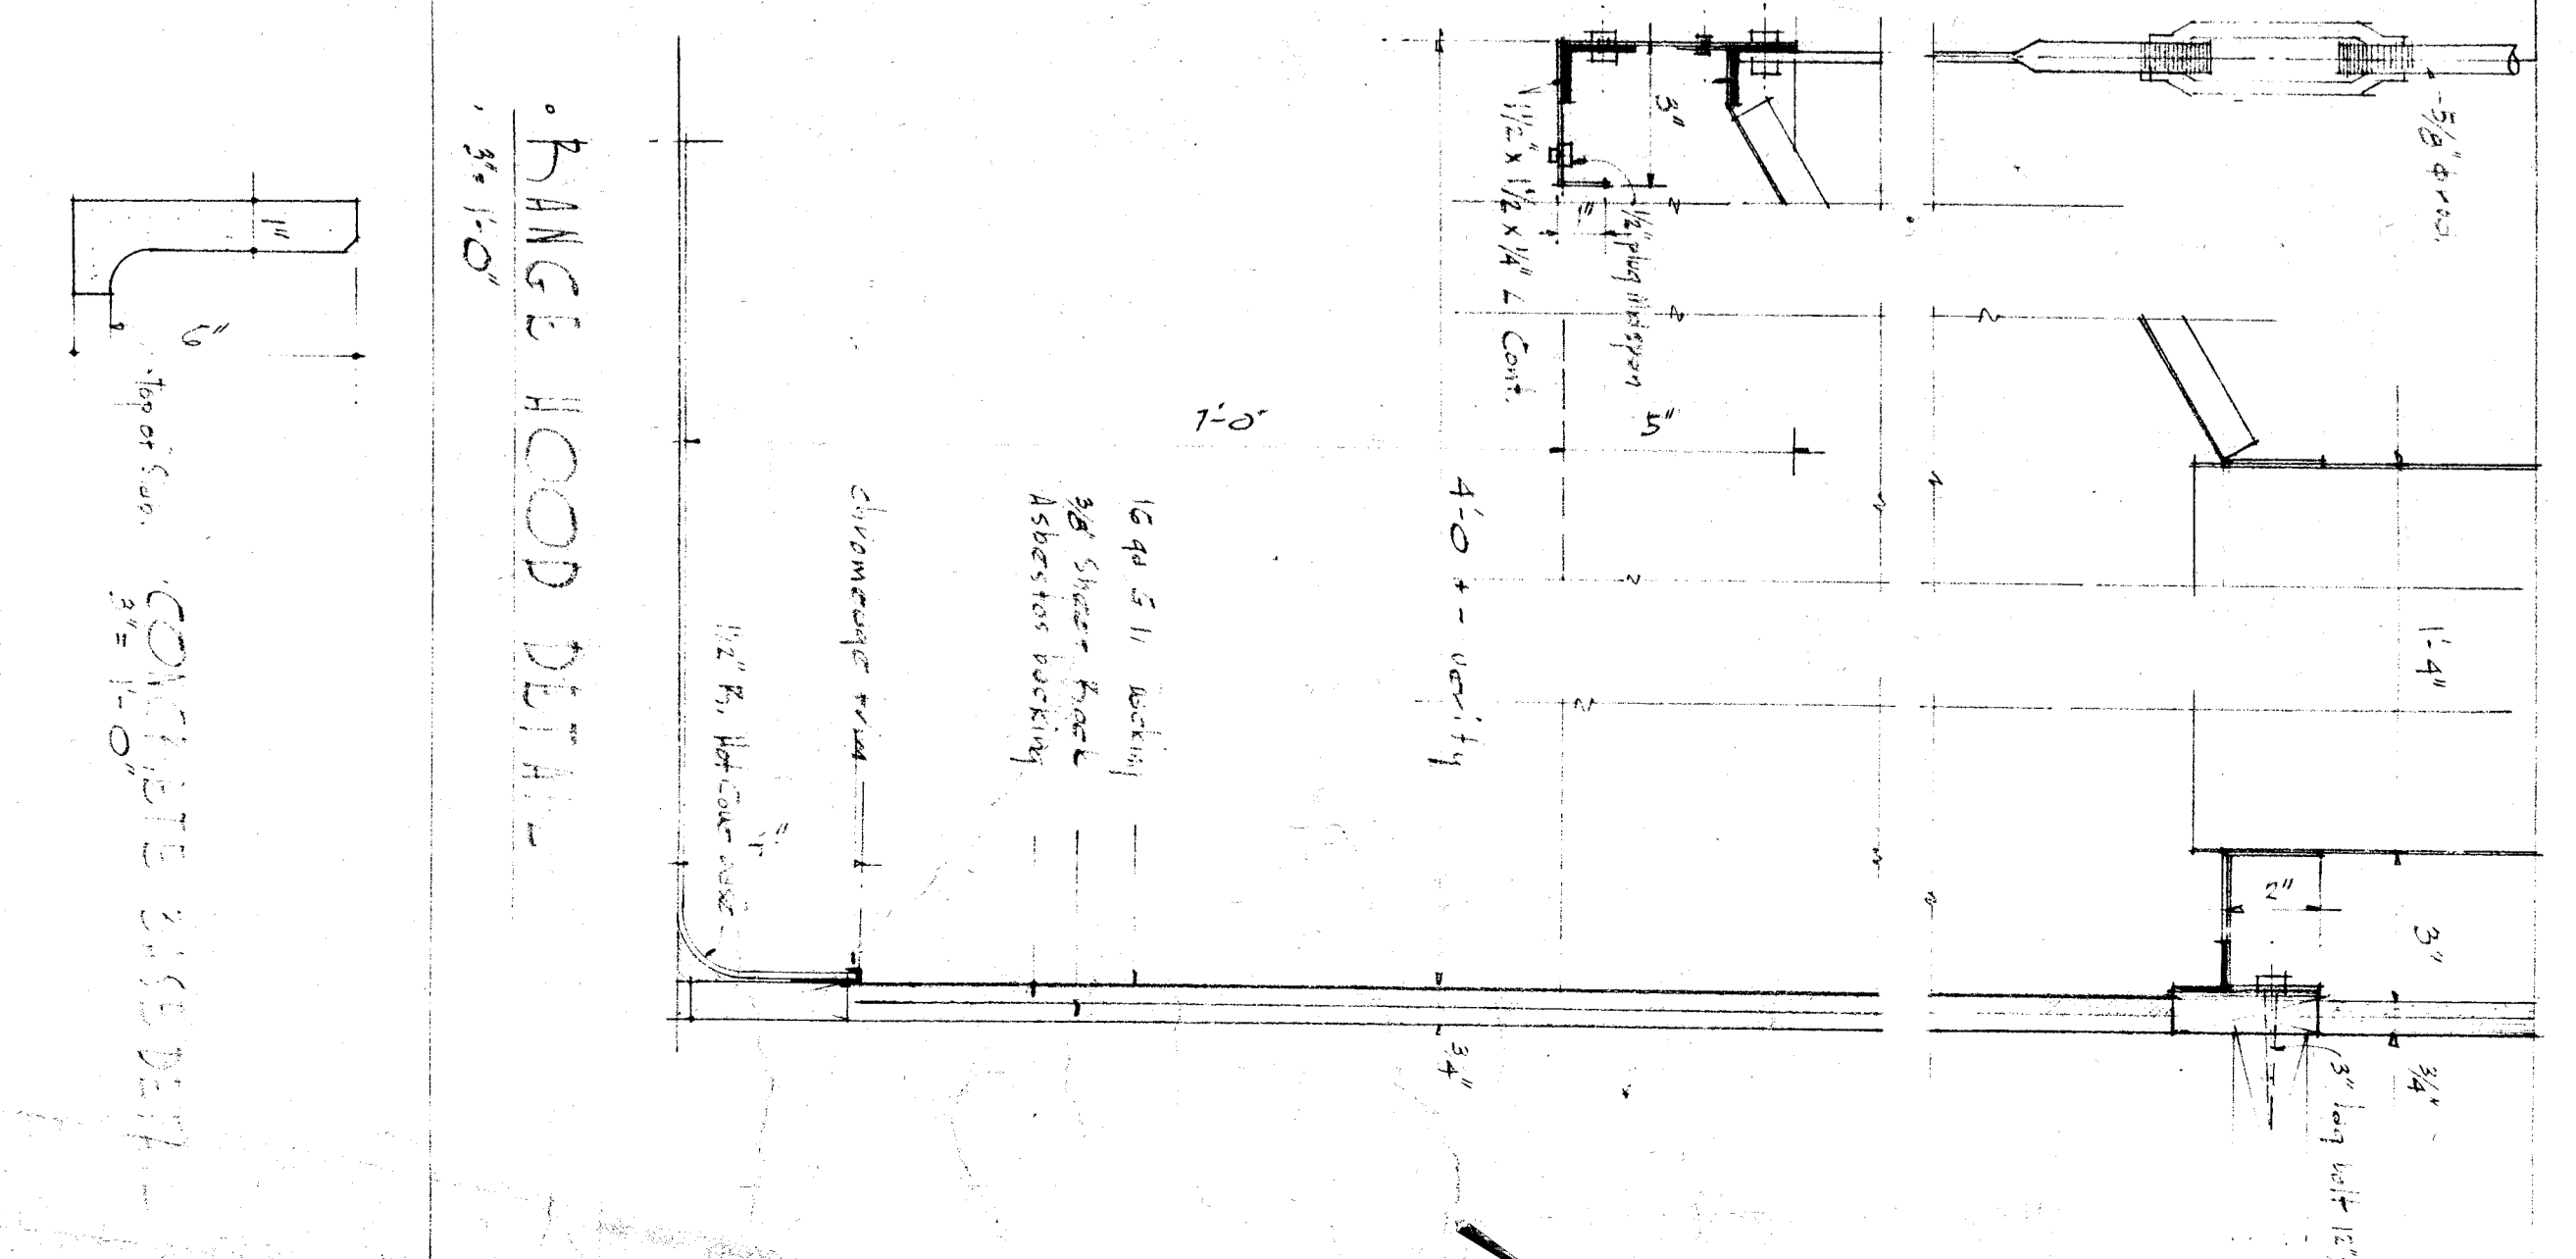

RANGE HOOD DETAIL

STATE OF CALIFORNIA DIVISION OF INDUSTRIAL RELATIONS DIVISION OF LABOR CONTRACTS APPROVED AUG 23 1980 <i>Henry M. Jackson</i>	ARKLEFIELD CITY CONTRACT 1015 1/2 ST. N. ARKLEFIELD, CALIFORNIA 7-80-250	ROBERT N. EDDY ARCHITECT - AIA 4855 W. 12th St. BAKERSFIELD, CALIFORNIA 7-80-250	REVISIONS 1. 5/15/80 2. 7/15/80 3. 8/25/80 4. 8/25/80 5. 8/25/80	SHEET <b>5</b> OF 15 SHEETS
---	---	--	---	-----------------------------------