




JUNCTION 1

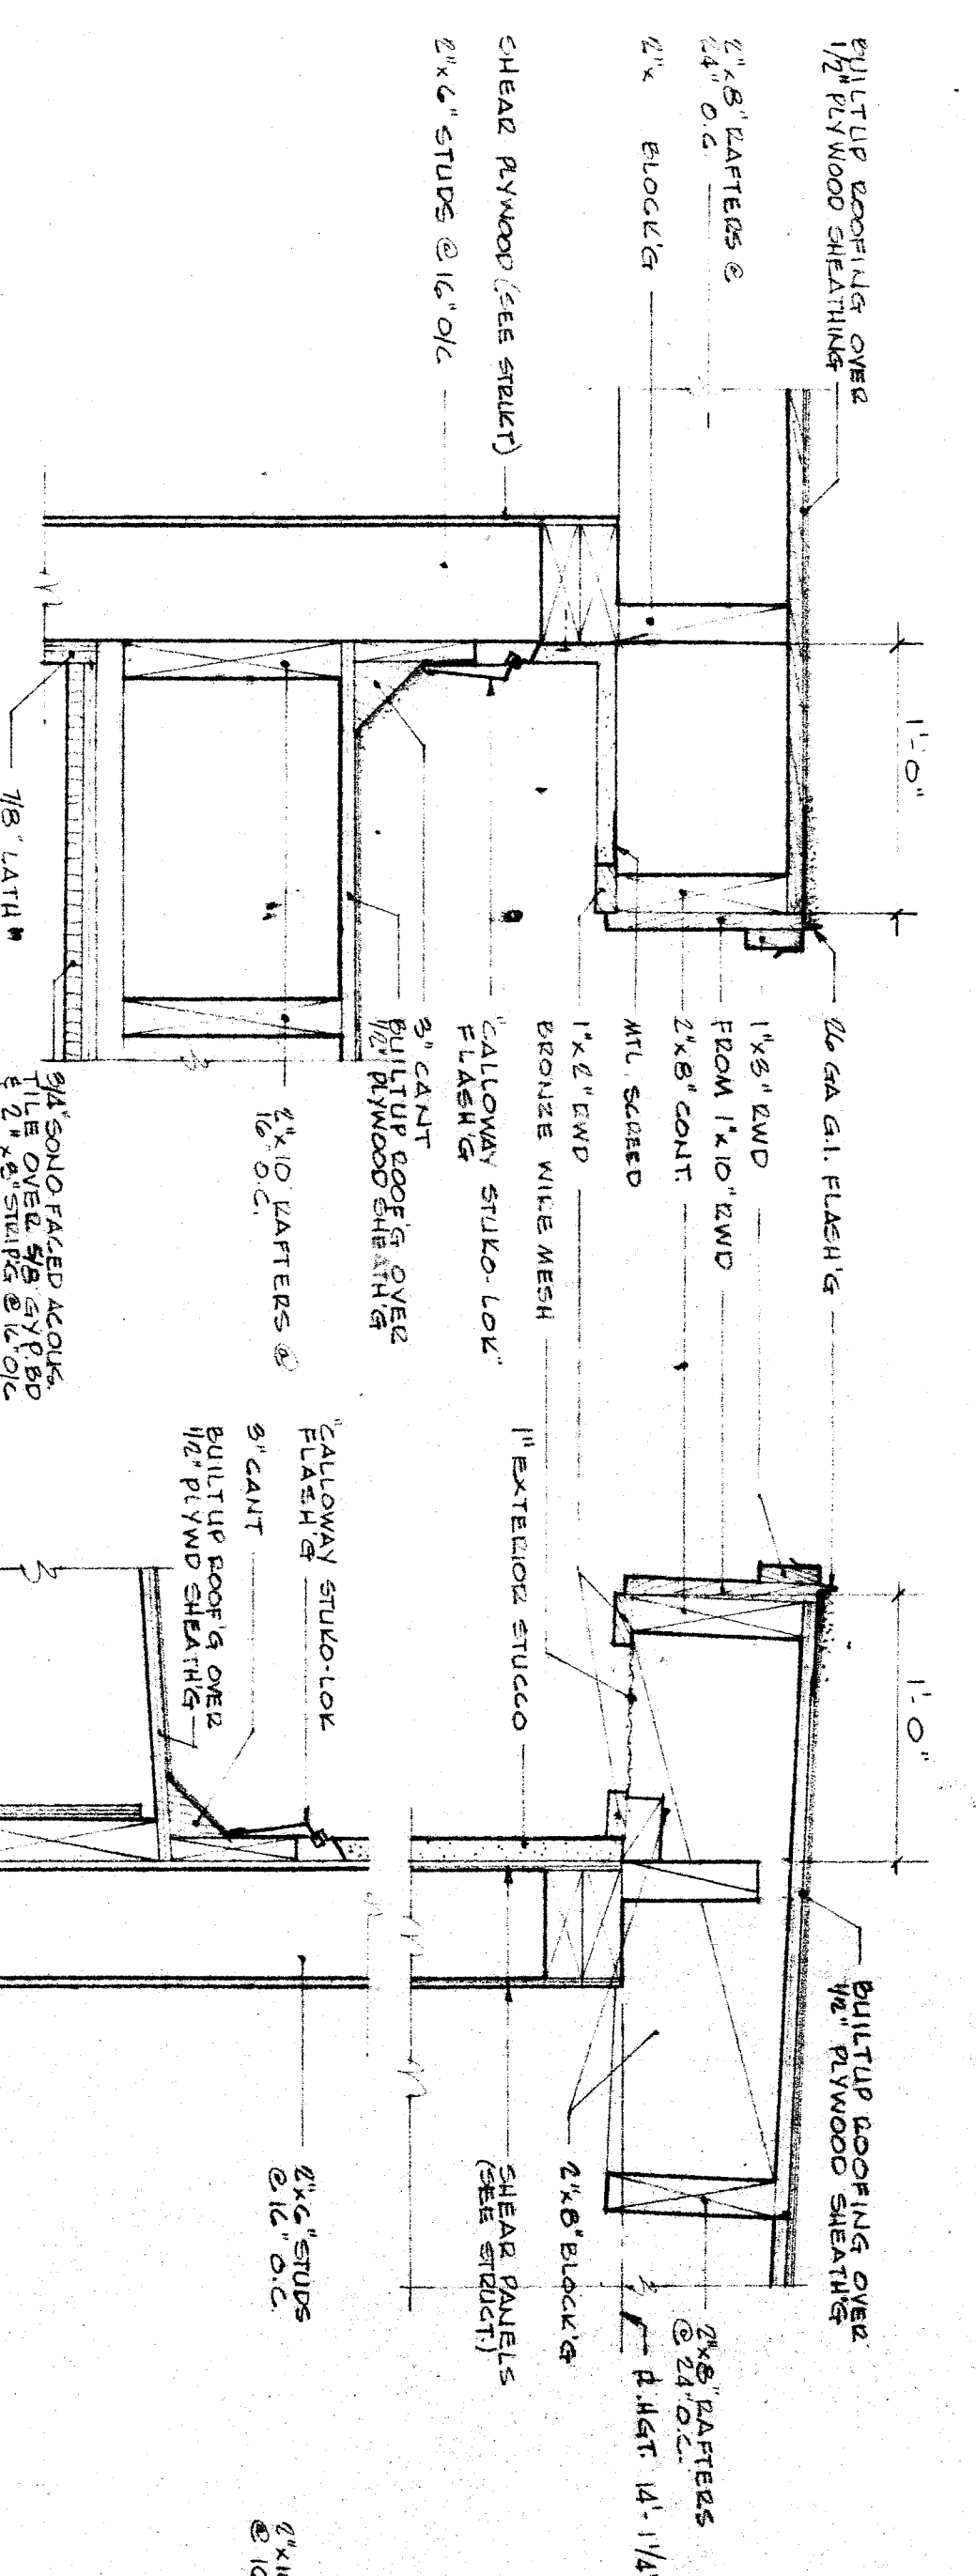


FACIA & FLASHING 2

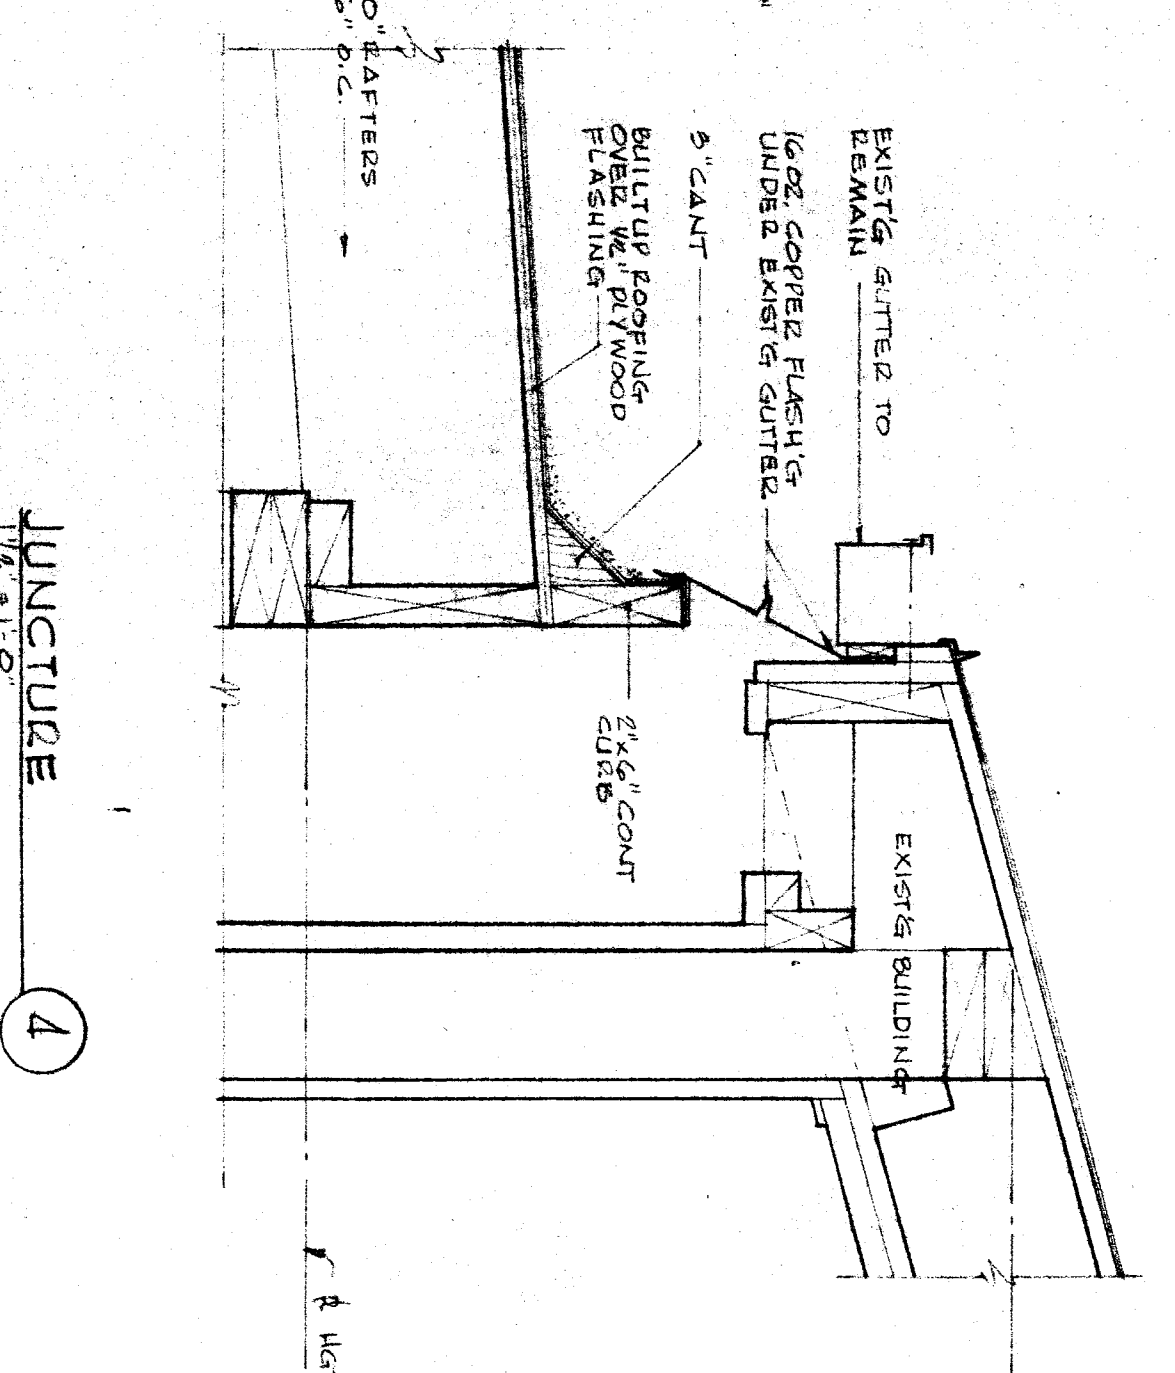


JUNCTION 4

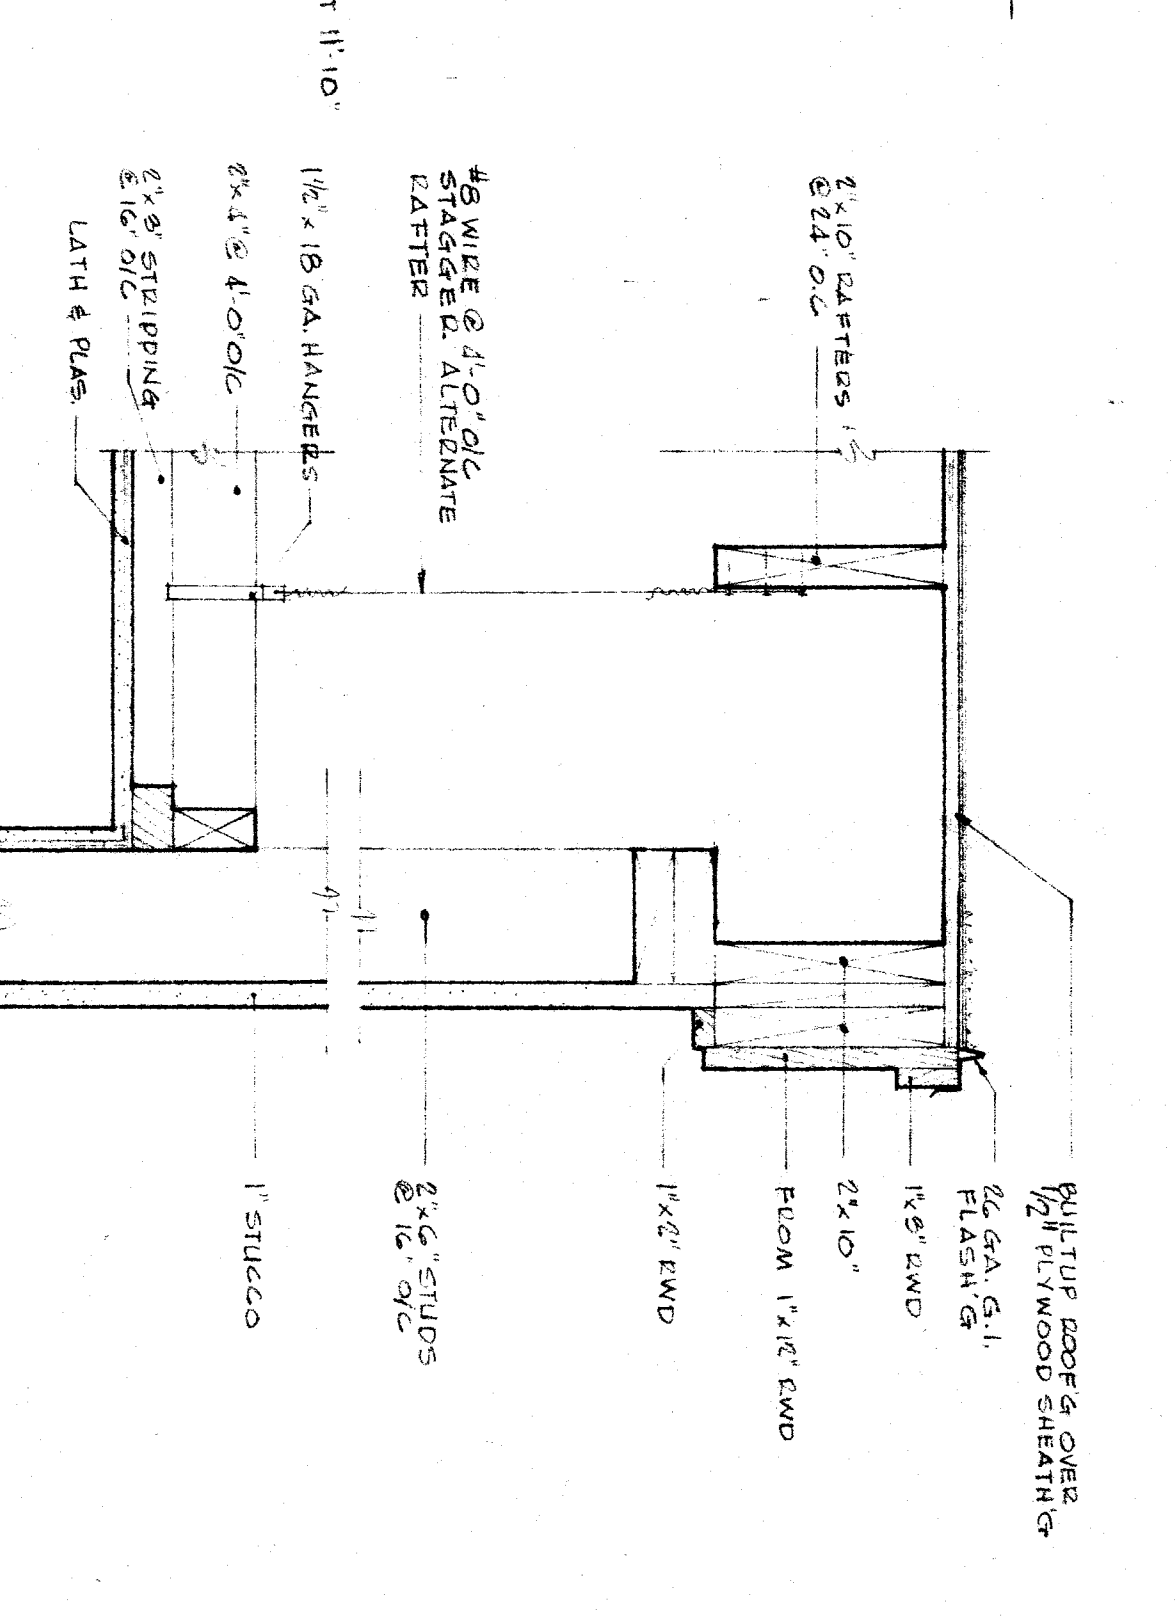


FACIA 5

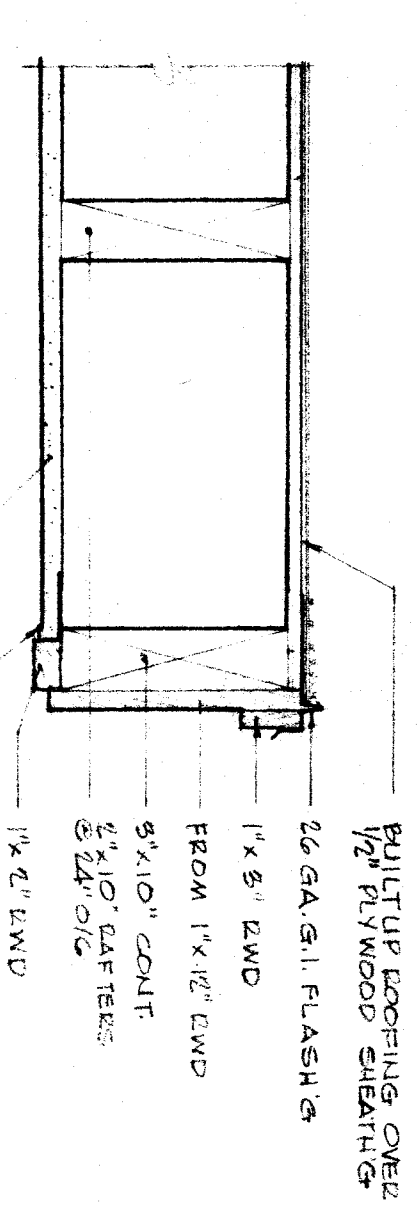

FACIA 6

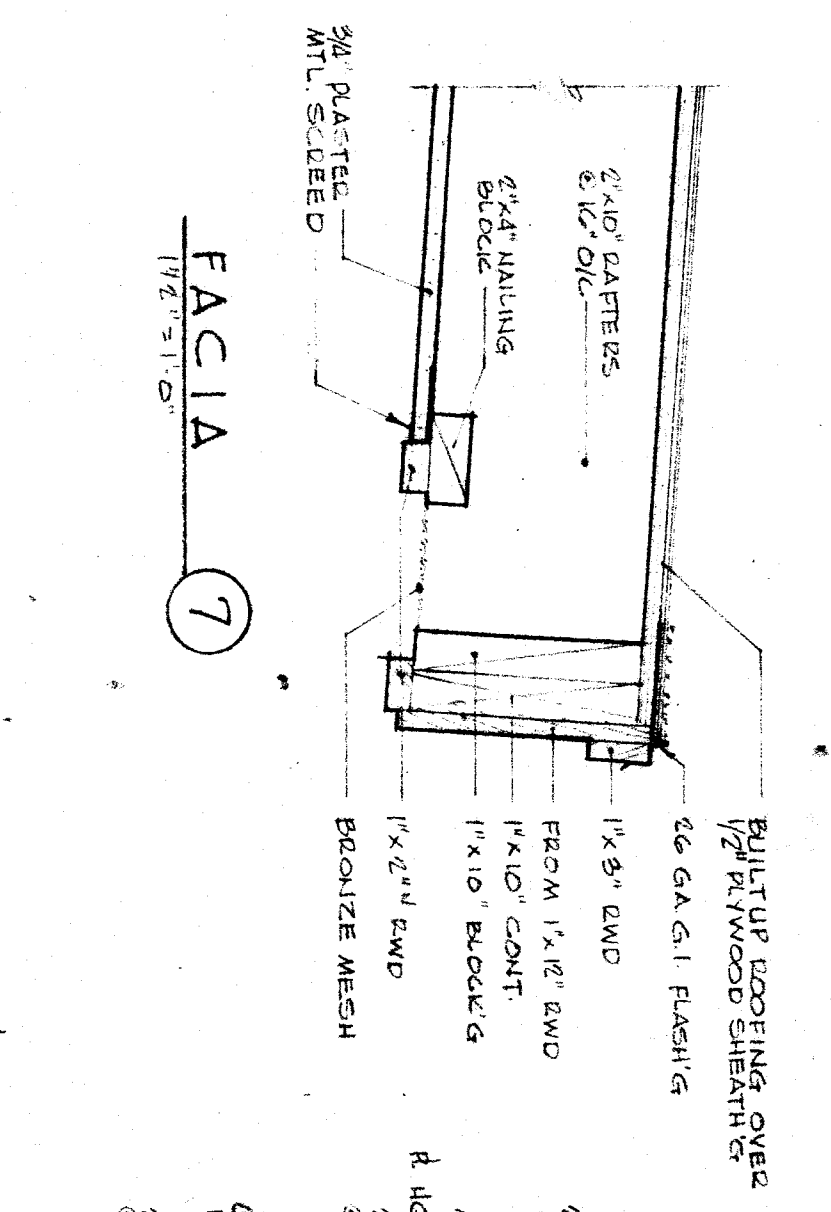


FACIA 7

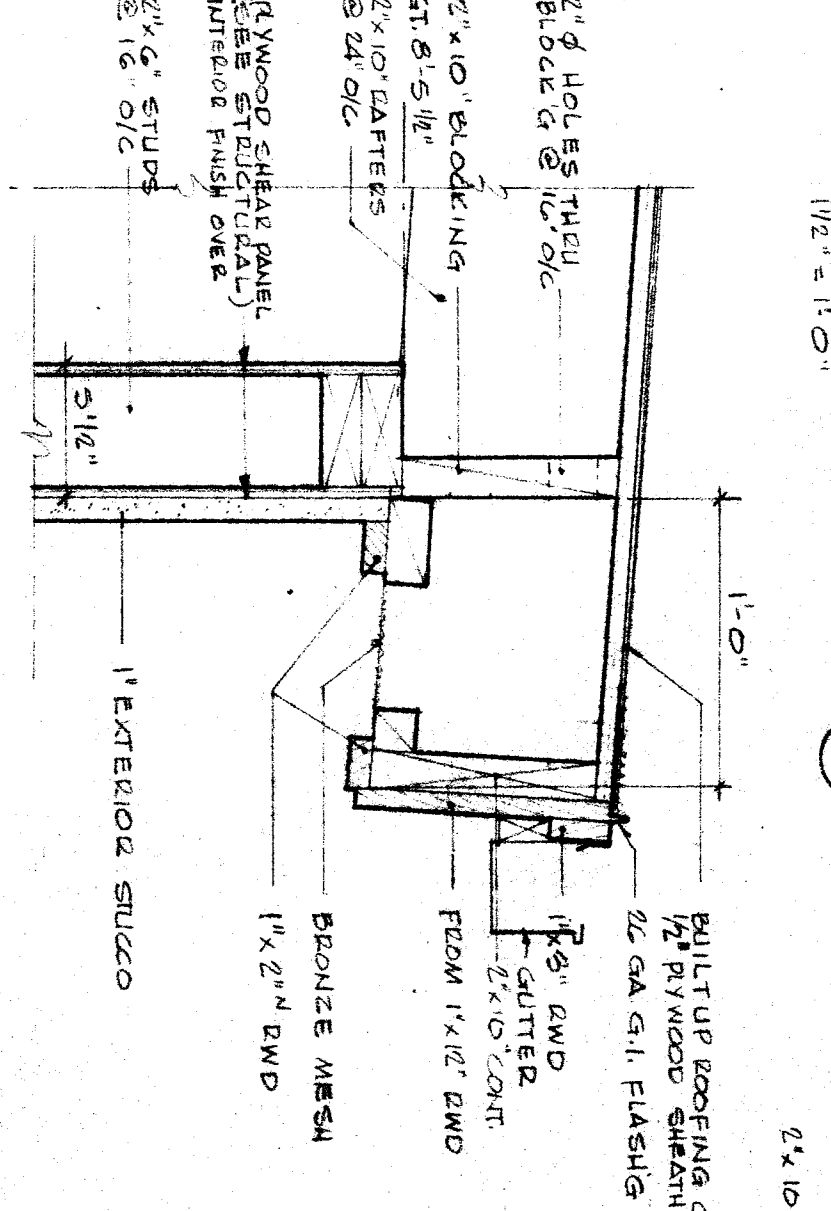


FACIA & FLASHING 8


FACIA 8

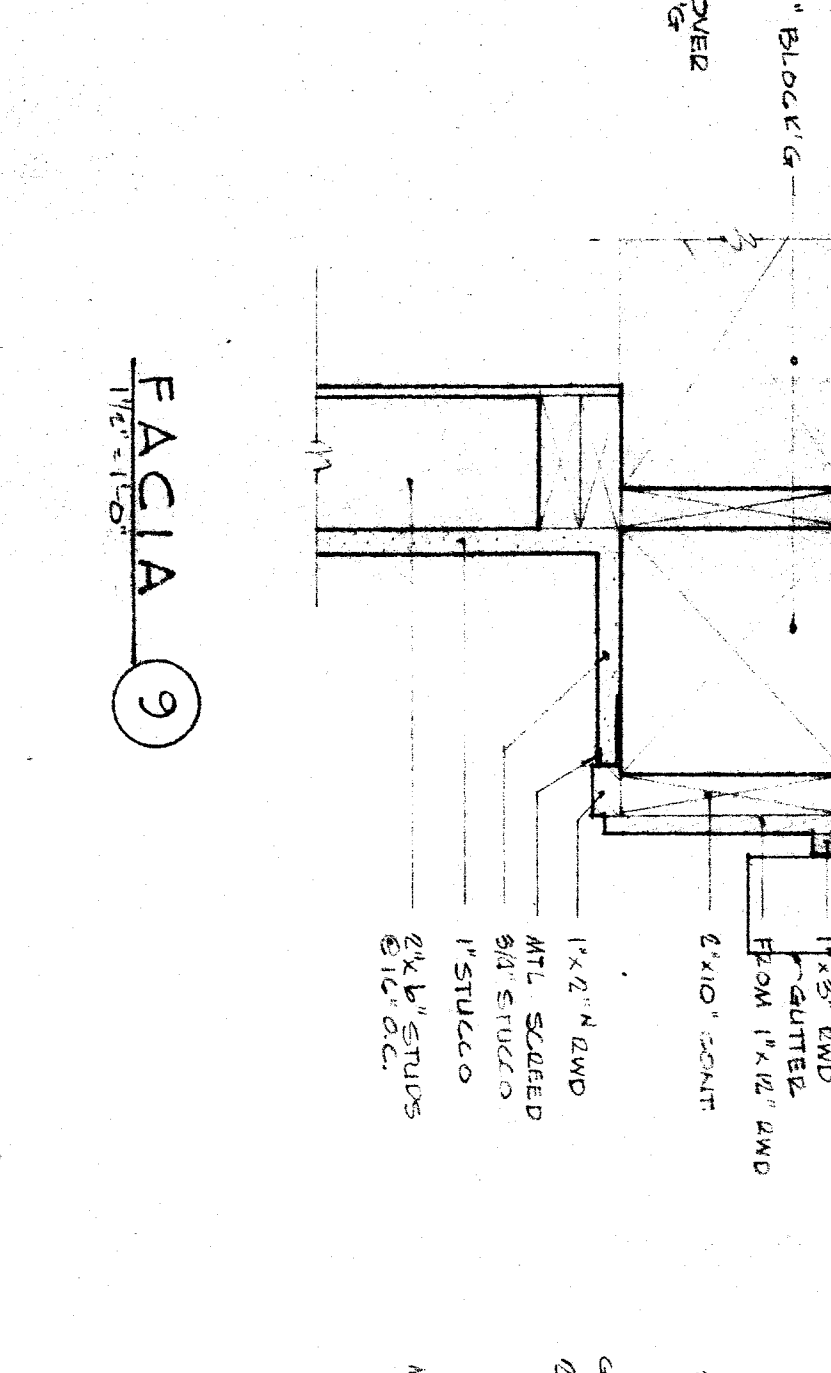


FACIA 9

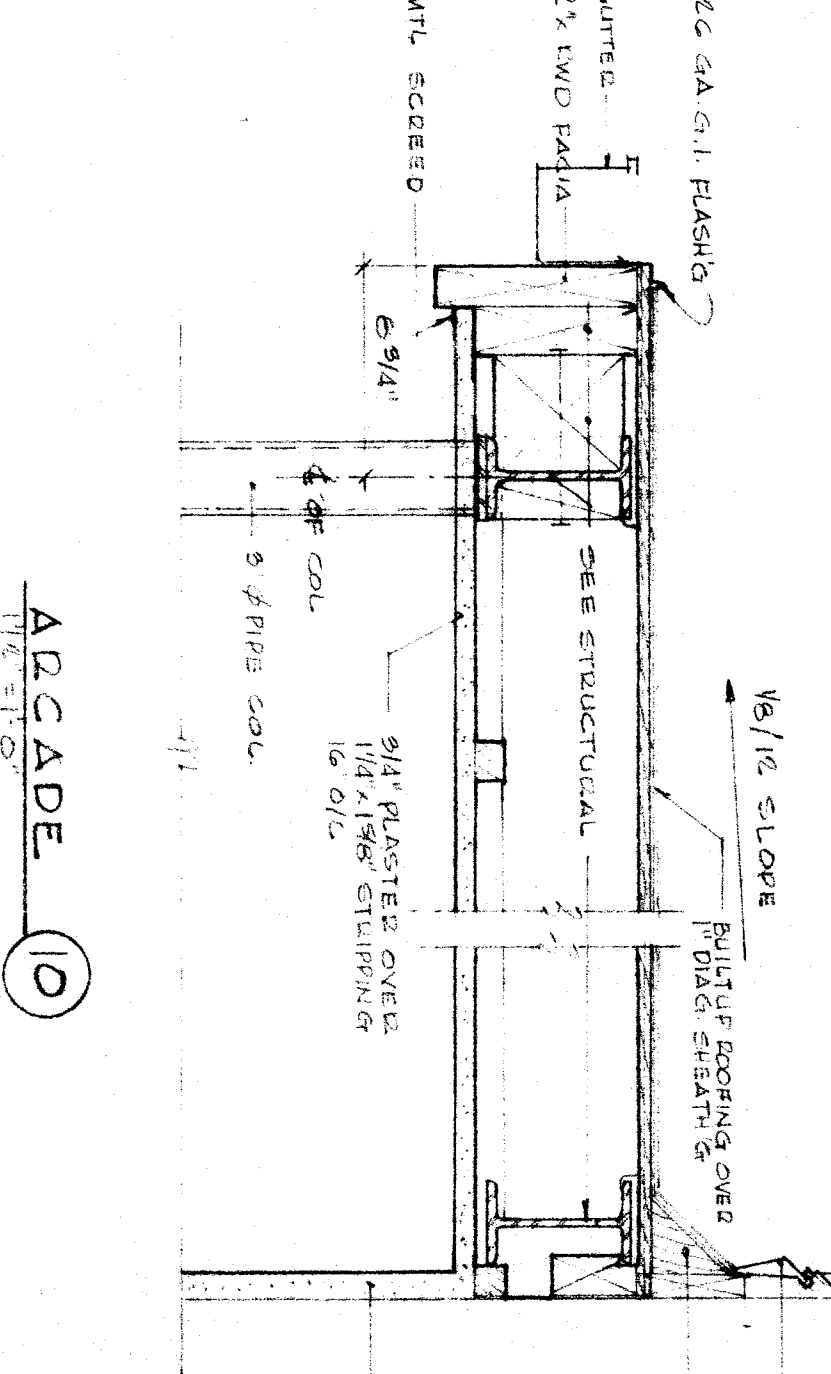


FACIA 10

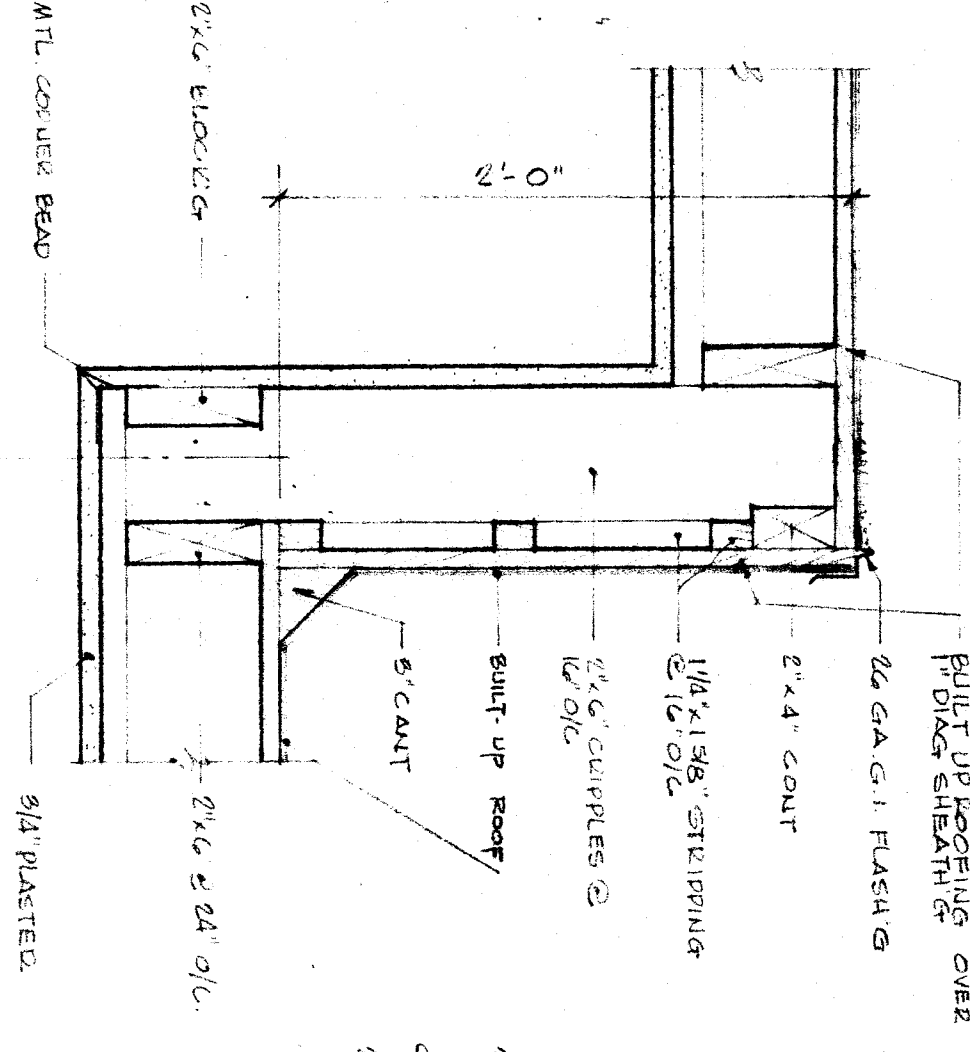


VERTICAL DROP ARCADE 11

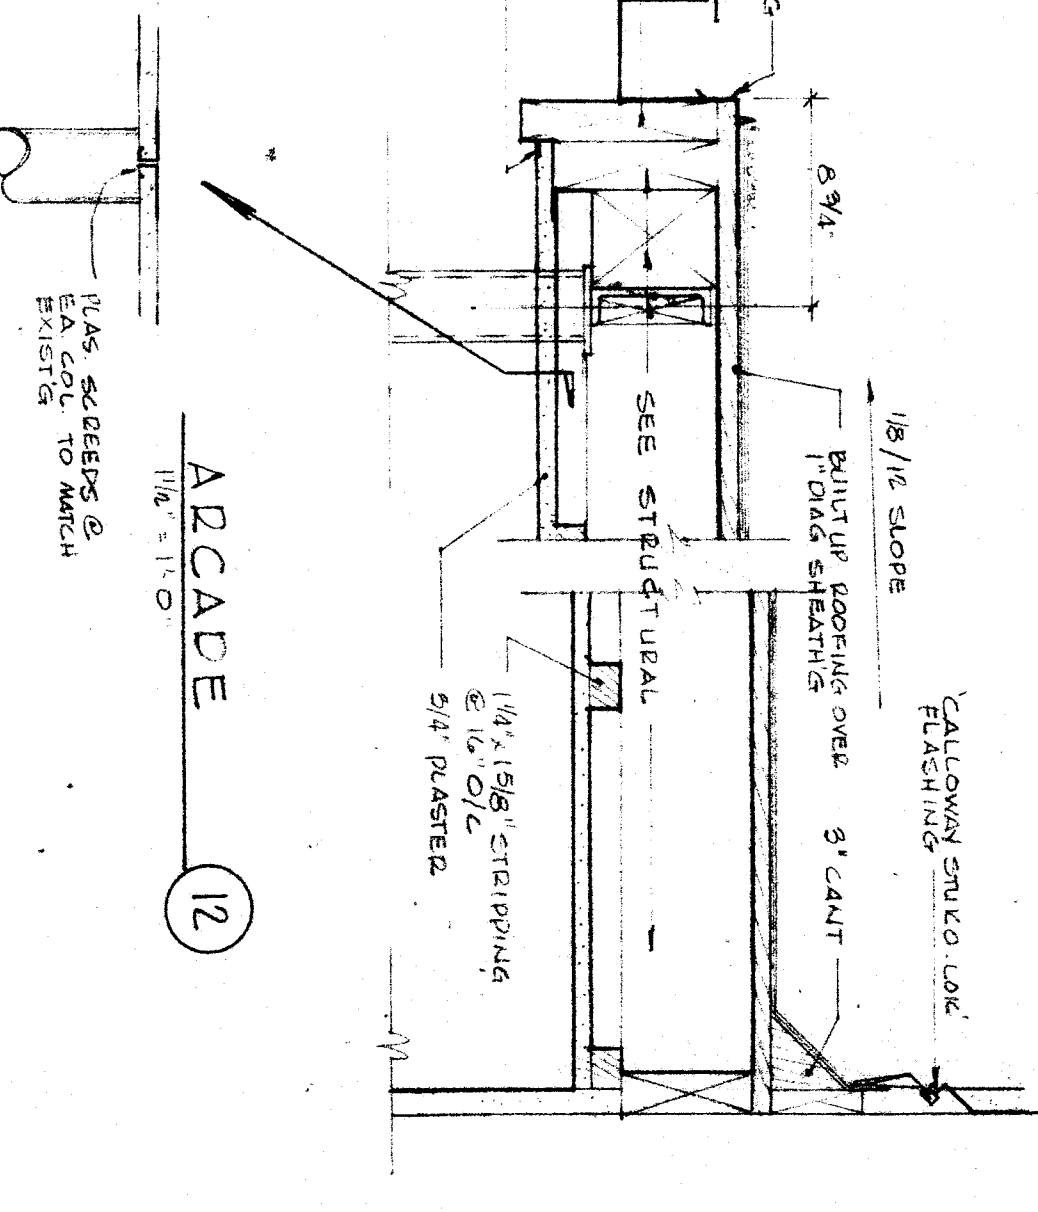


ARCADE 12

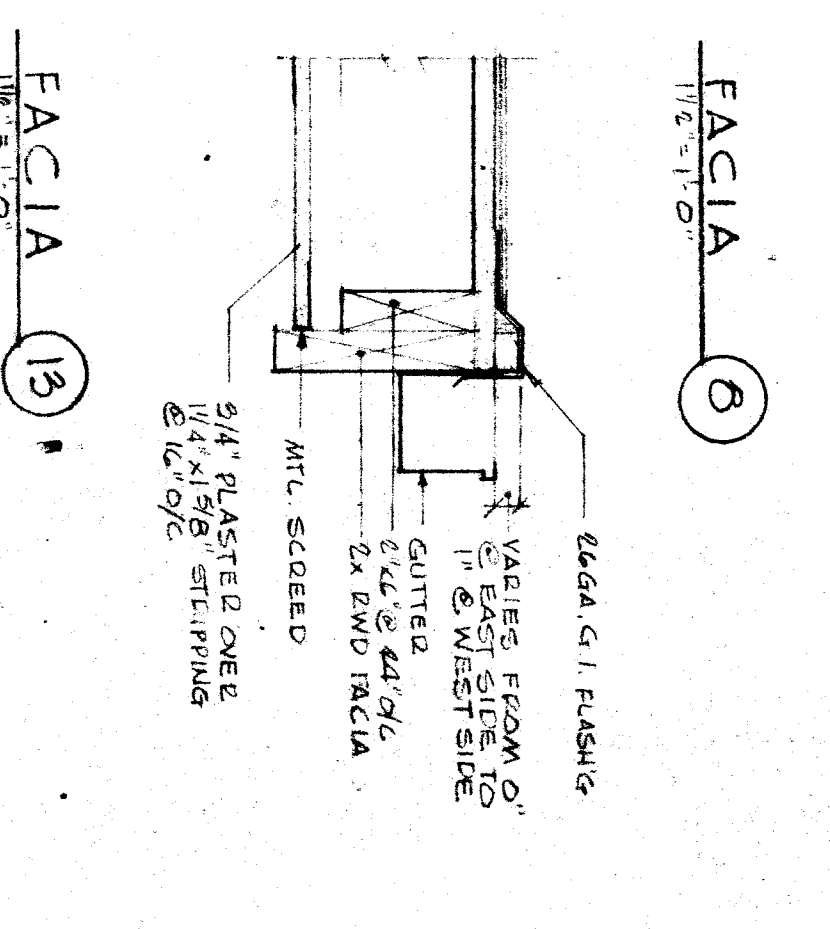


FACIA 13

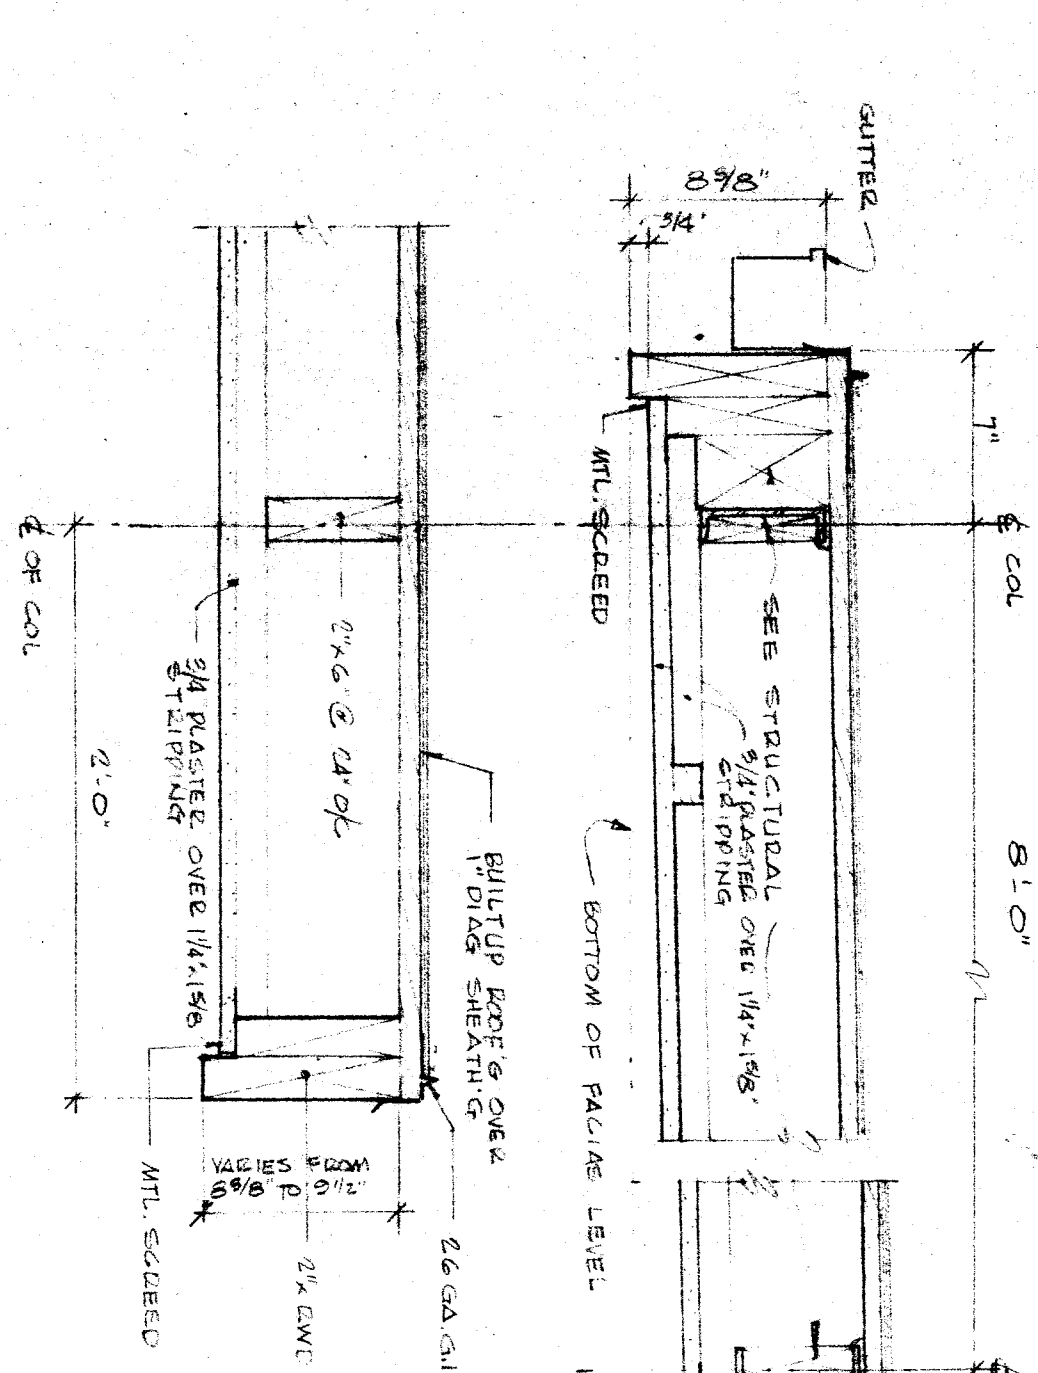


ARCADE OVERLAP 14

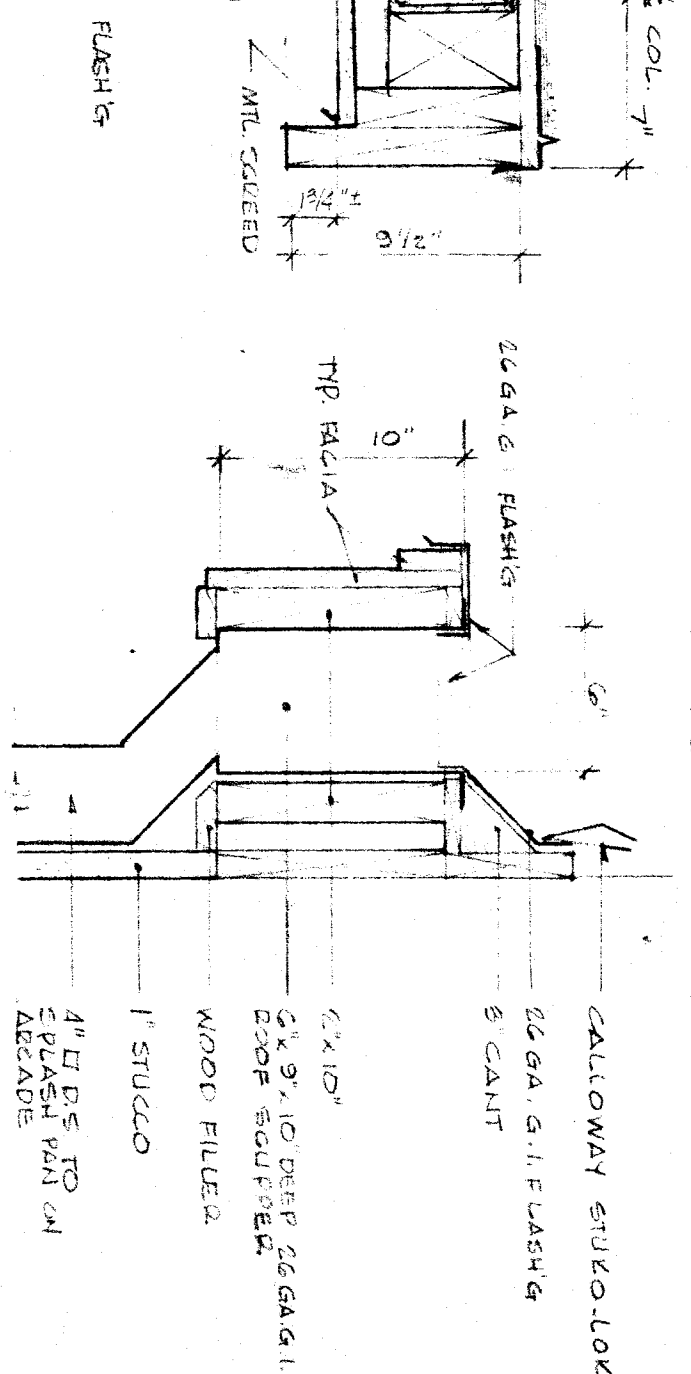

SCUPPER 15

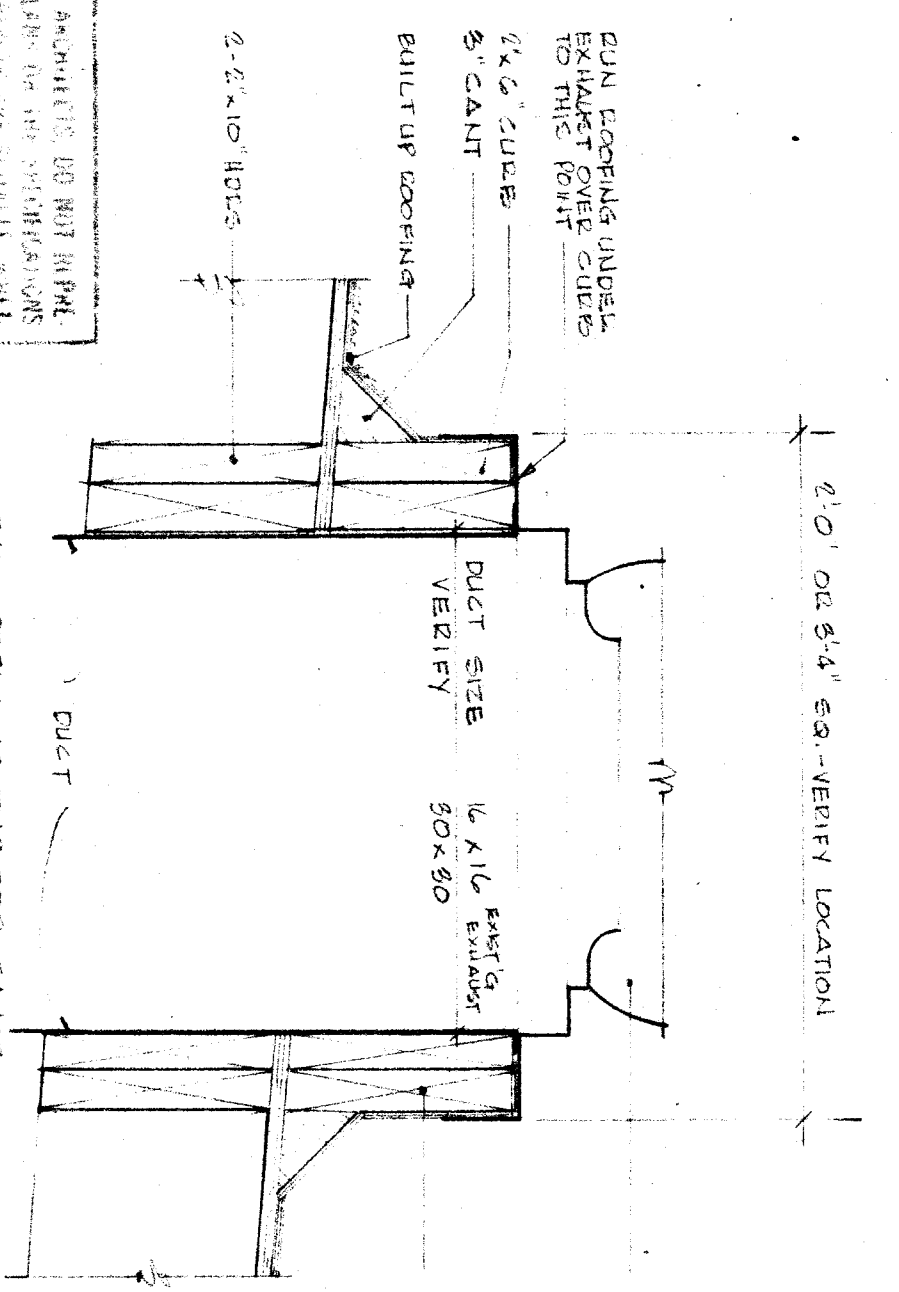


EXHAUST CURB 16

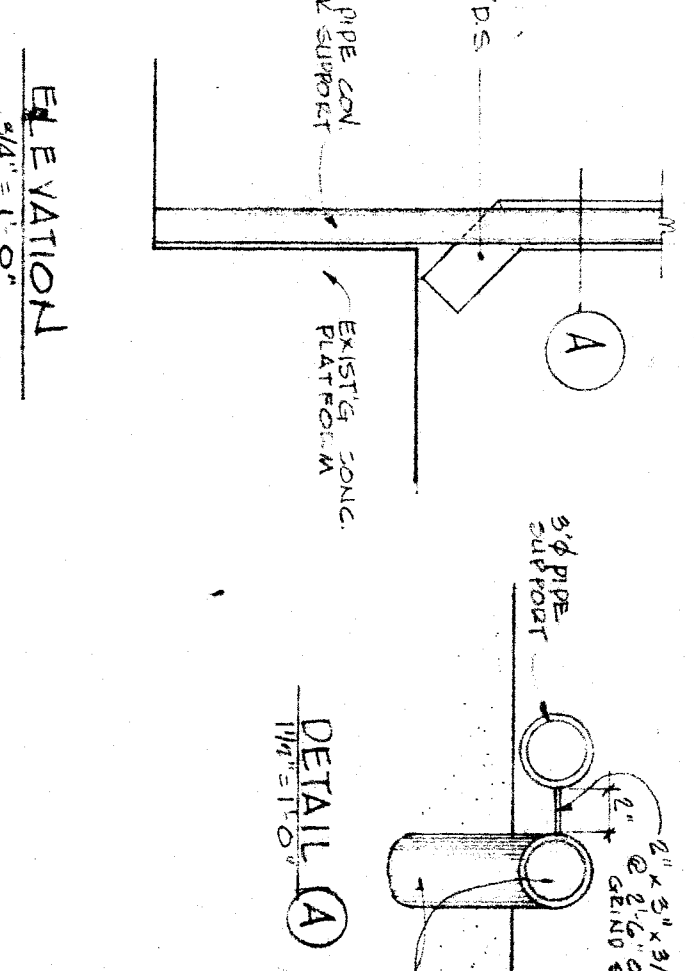


ELEVATION 17


DOWNSPOUT DETAIL 17

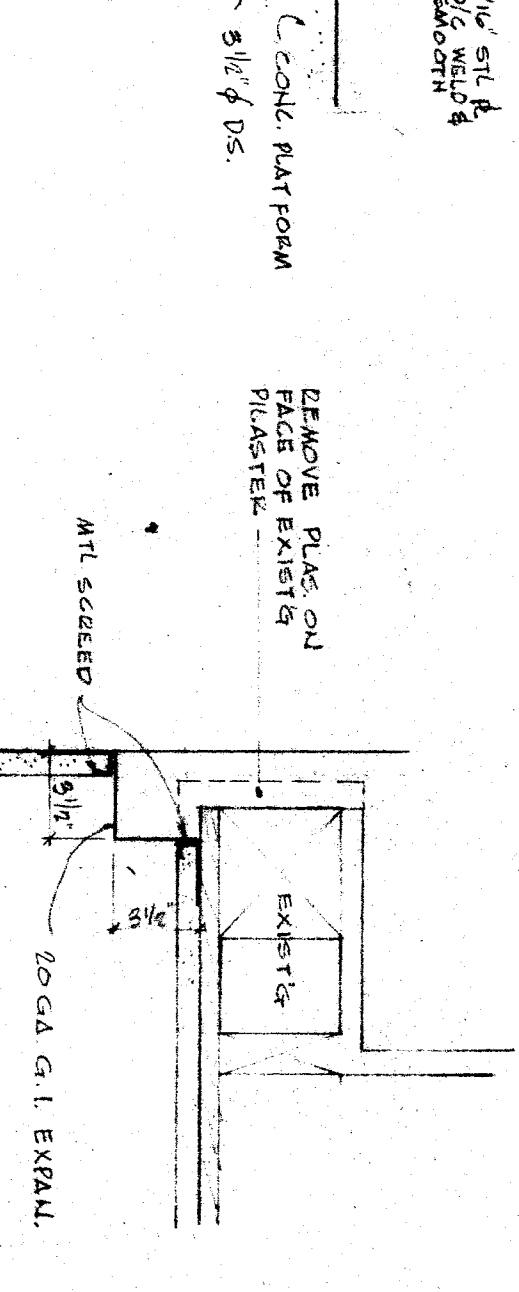


EXPANSION JOINT 18

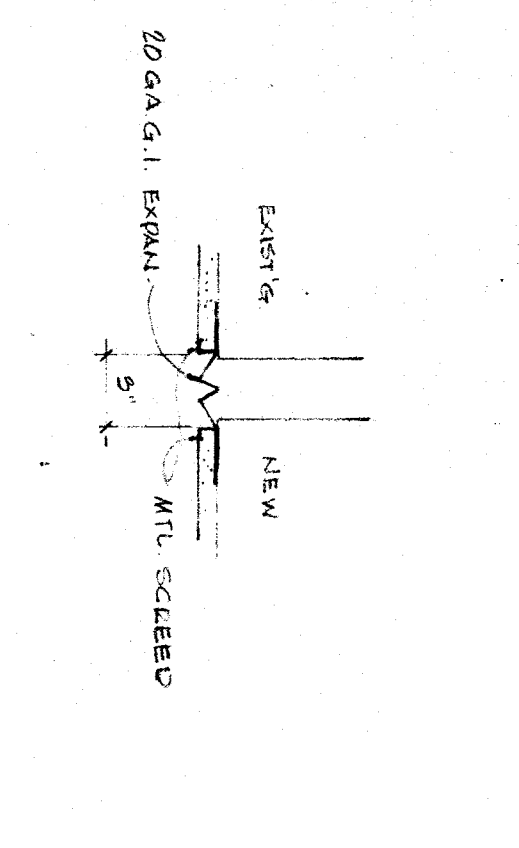

EXPANSION JOINT 19

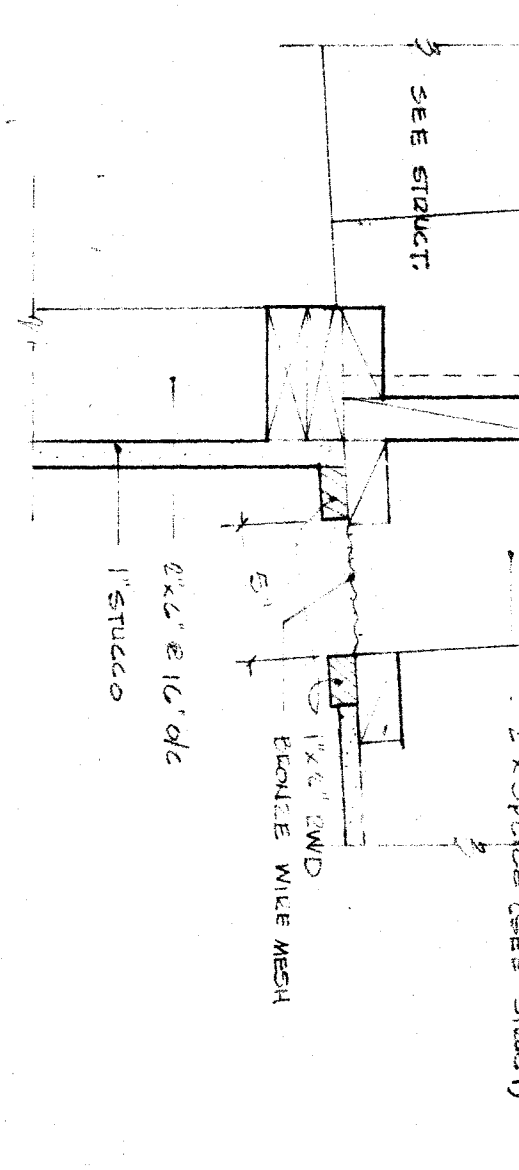

SCREEN VENT 20

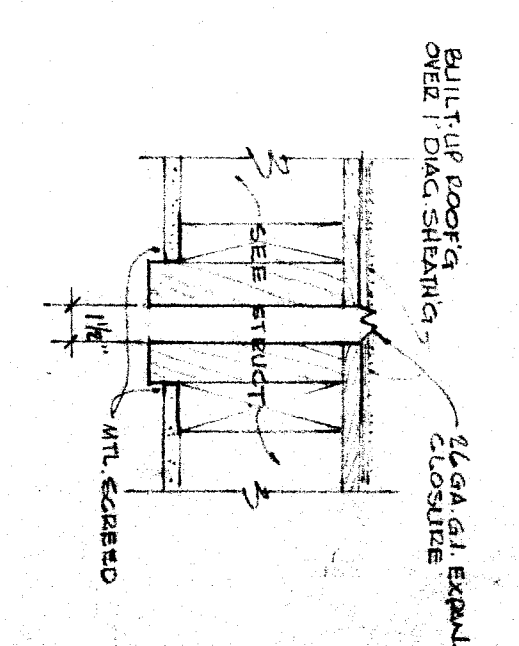

JOINING NEW & EXISTING ARCADES 21

BAKERSFIELD CITY SCHOOL DISTRICT APPROVED BY: _____ DATE: _____

EDDY AND PAINTER ARCHITECTS 2901 H. STREET BAKERSFIELD, CALIFORNIA FA. 59048

DOOF DETAILS MULTI-USE BLDG. LINCOLN JR. HIGH SCHOOL BAKERSFIELD DISTRICT BAKERSFIELD KERN COUNTY CALIFORNIA

DATE	2-15-60	REVISION	
NO.	50269	BY	SP
REVISION		DATE	

EDDY AND PAINTER ARCHITECTS 2901 H. STREET BAKERSFIELD, CALIFORNIA FA. 59048

DOOF DETAILS MULTI-USE BLDG. LINCOLN JR. HIGH SCHOOL BAKERSFIELD DISTRICT BAKERSFIELD KERN COUNTY CALIFORNIA