


SECTION 1 As shown
SECTION 2 As shown

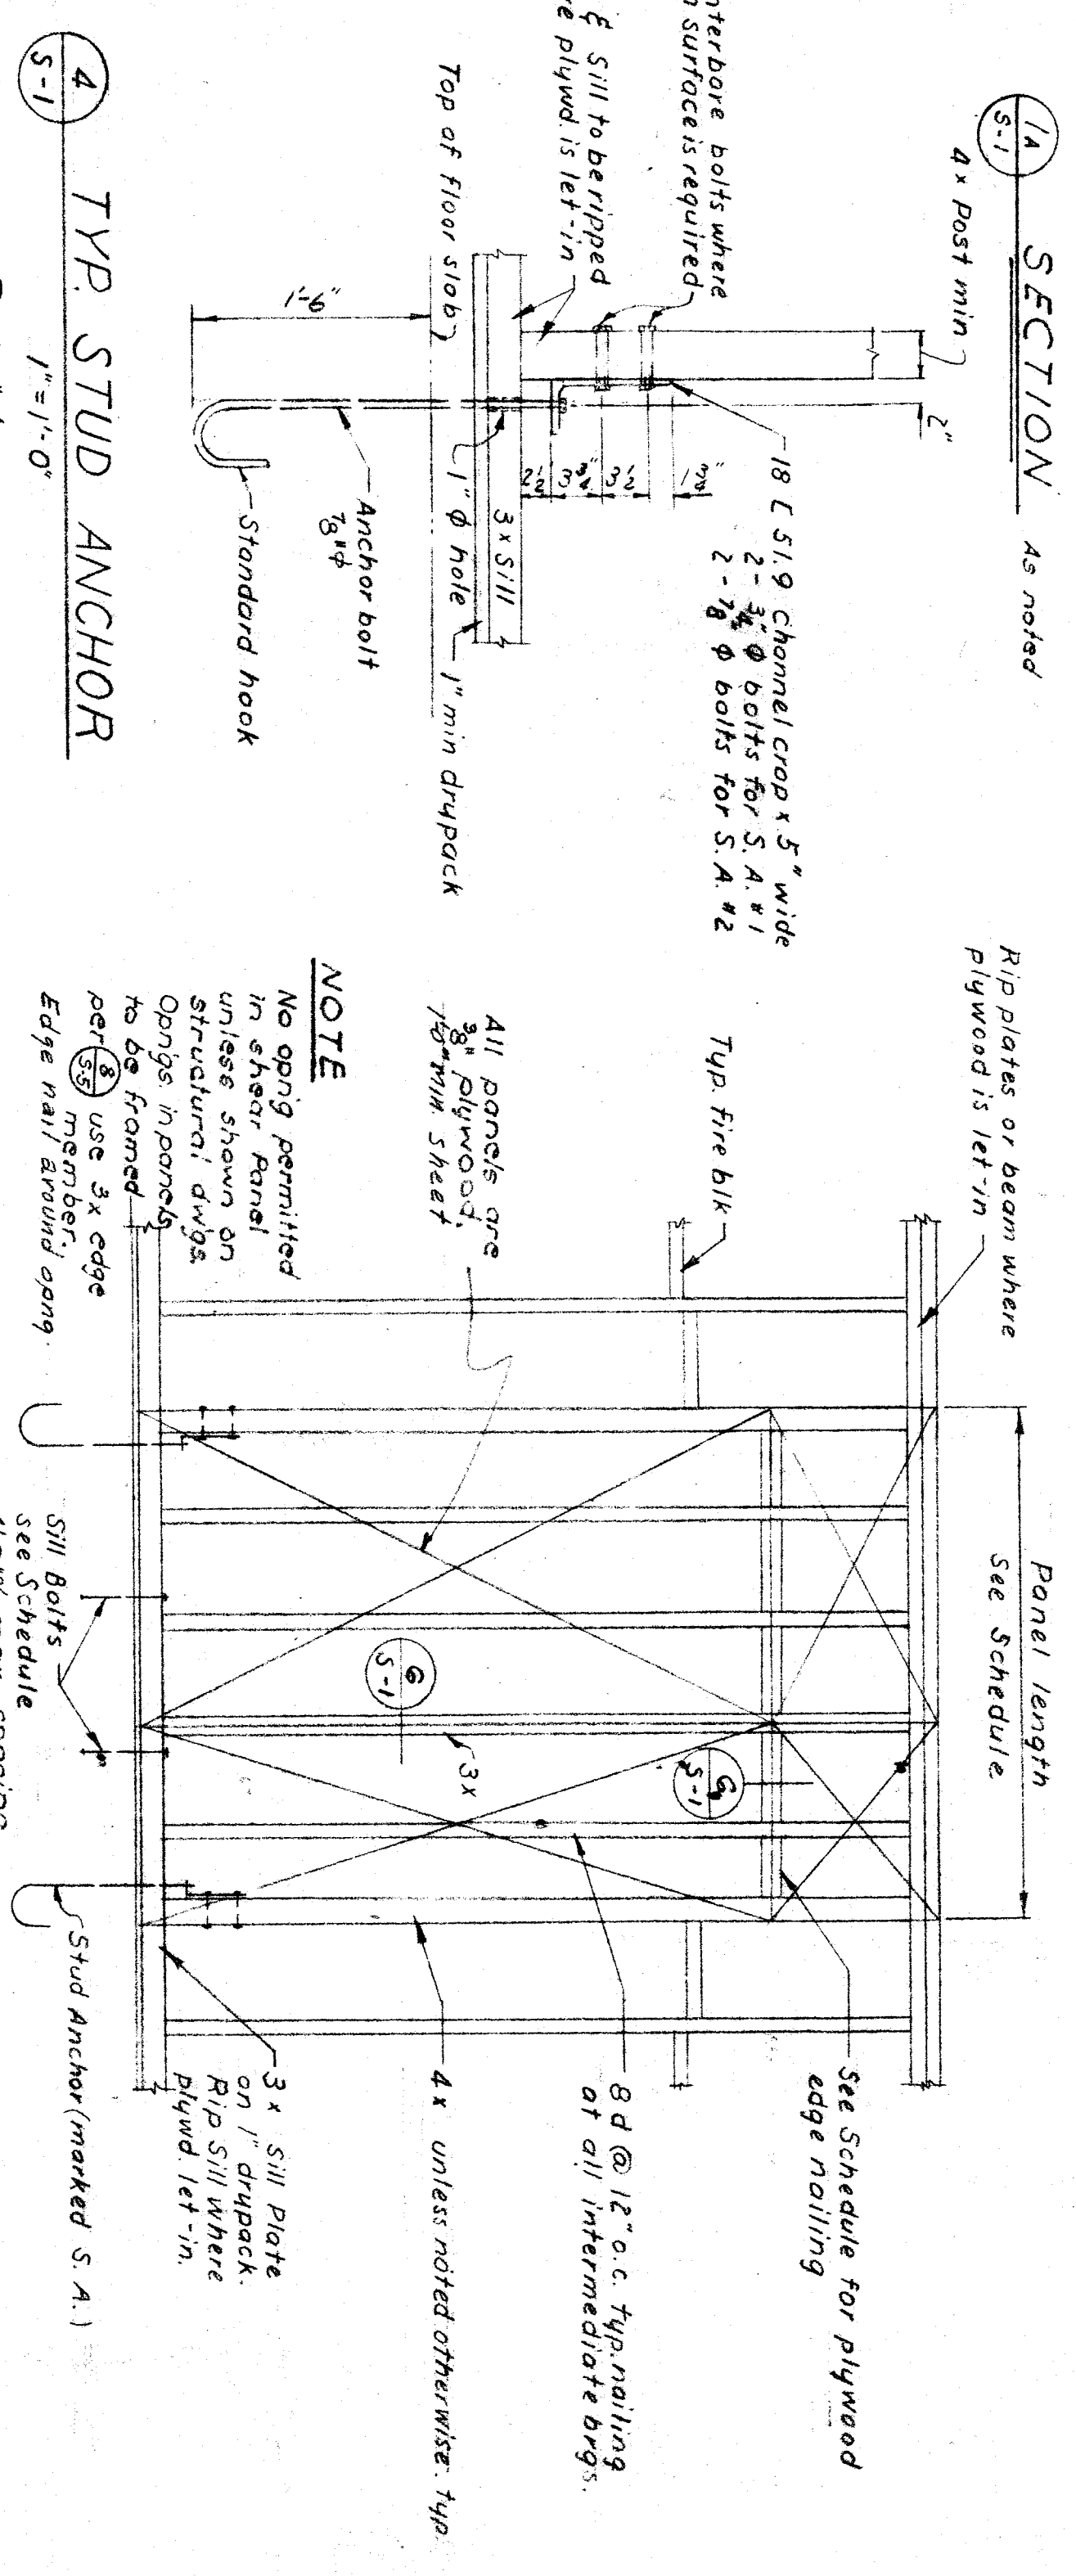


TYP STUD ANCHOR
TYPICAL SHEAR PANEL (MARKED S.P.#)

3/8" PLYWOOD PANEL SCHEDULE Unless noted otherwise.

SHEAR PANEL No	LENGTH	LOCATION	NAILING	SILL BOLTS	REFERENCE, DETAIL
S.P. 1	14'-0"	Let-in, both faces	8 @ 4" o/c	See elev. (S-2)	
S.P. 2	14'-0"	Let-in, both faces	8 @ 4" o/c	Sim. to (S-1) at West end (S-2) at East end - (S-3)	
S.P. 3	12'-0"	Let-in, interior wall face	8 @ 4" o/c	Sim. to (S-1) at both ends	
S.P. 4	24'-0"	Stud face, interior face of wall	8 @ 4" o/c	Sim. to (S-1) at East end (S-2) at West end	
S.P. 5	16'-0"	Let-in, exterior face of wall	8 @ 4" o/c	Sim. to (S-1) at South end (S-2) at North end	
S.P. 6	12'-0"	Let-in, both faces	8 @ 4" o/c	Sim. to (S-1) at East end (S-2) at West end - elev. (S-3)	
S.P. 7	32'-0"	Let-in, West wall face	8 @ 4" o/c	See elev. (S-3)	
S.P. 8		Stud face, West wall face	8 @ 4" o/c	Sim. to (S-1) at both ends	
S.P. 9		Stud face, West wall face	8 @ 4" o/c	Sim. to (S-1) at North end	

3/8" PLYWOOD PANEL SCHEDULE

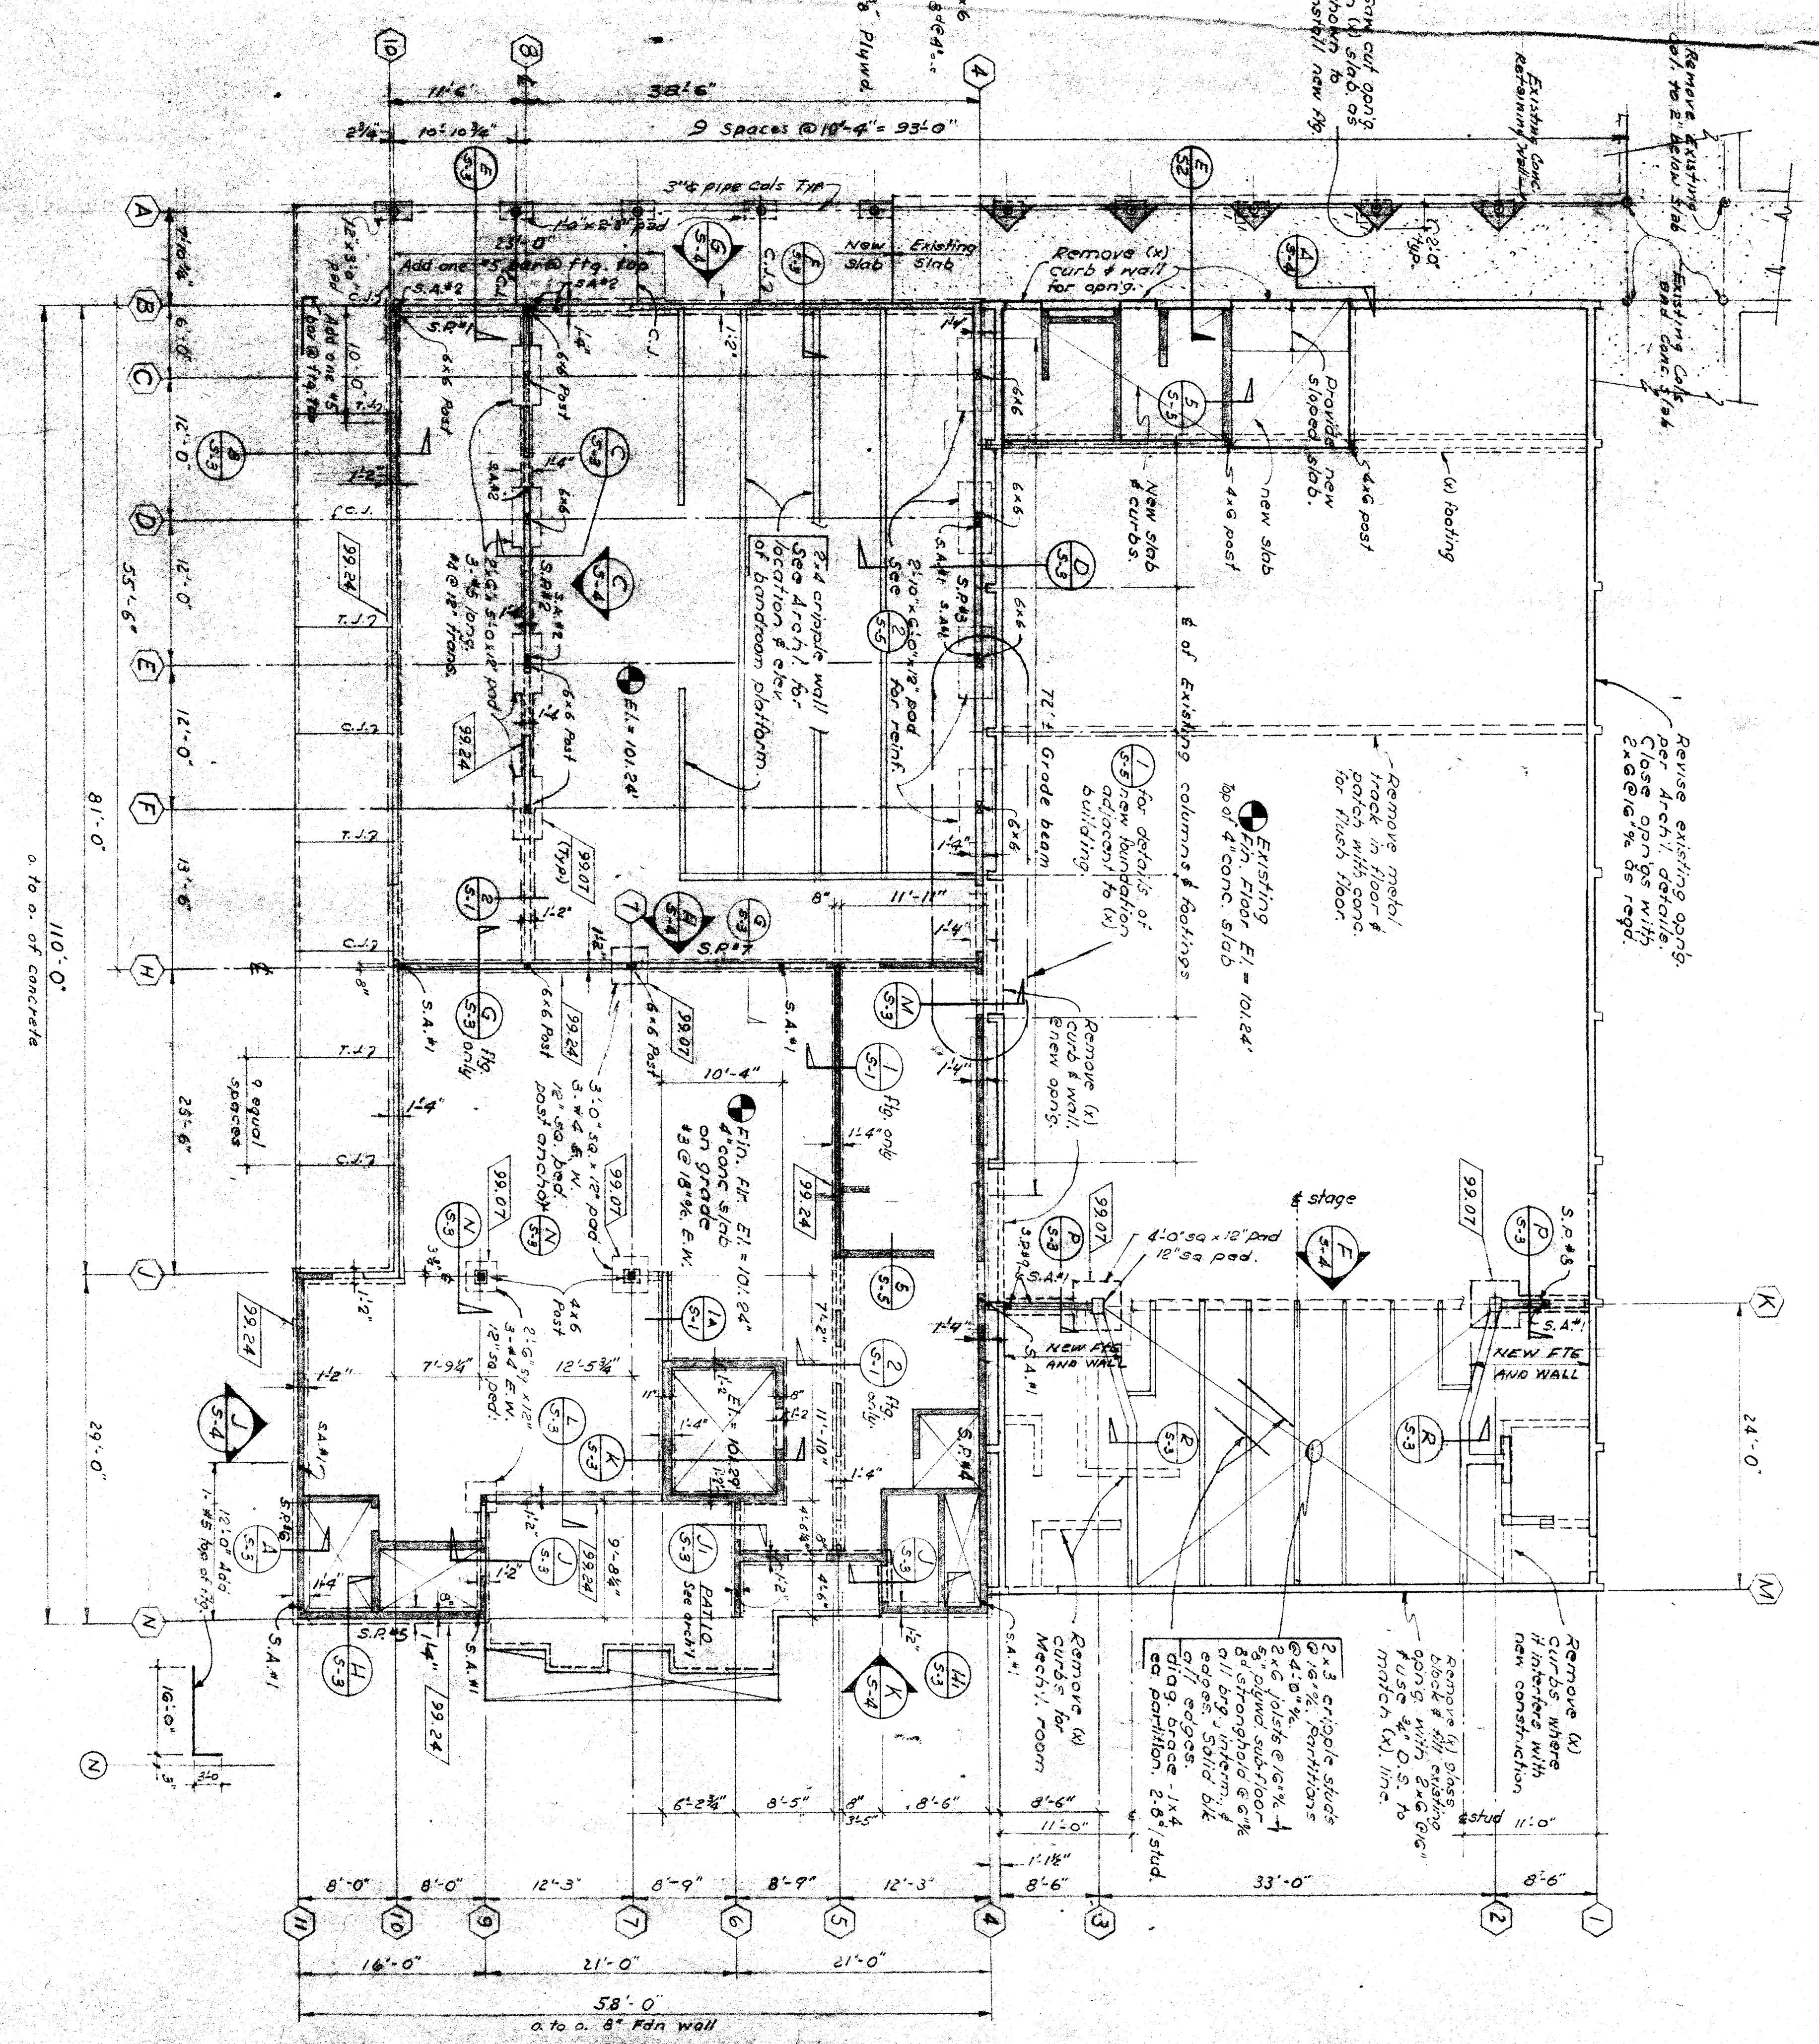

FOUNDATION PLAN

NOTE:
Depress grade slab 2" where gully.
If floor occurs. See elev. drawings
for details and locations of all
depressed areas.

BAKERSFIELD CITY SCHOOL DISTRICT
APPROVED BY: [Signature]

STATE OF CALIFORNIA
COUNTY OF KERN
SUPERVISOR: [Signature]

WHEELER & GUNN
STRUCTURAL ENGINEERS

EDDY AND PAYNTER
ARCHITECTS A.I.A.
2901 H. Street Bakersfield, California FA. 59048

FOUNDATION PLAN & SHEAR PANELS
MULTI-USE BLDG. - LINCOLN JR. HIGH SCHOOL
BAKERSFIELD CITY SCHOOL DISTRICT
KERN COUNTY CALIFORNIA

S-1