


PLAN OF ADMINISTRATION & LIBRARY BLDG. C
SCALE 1/4" = 1'-0"

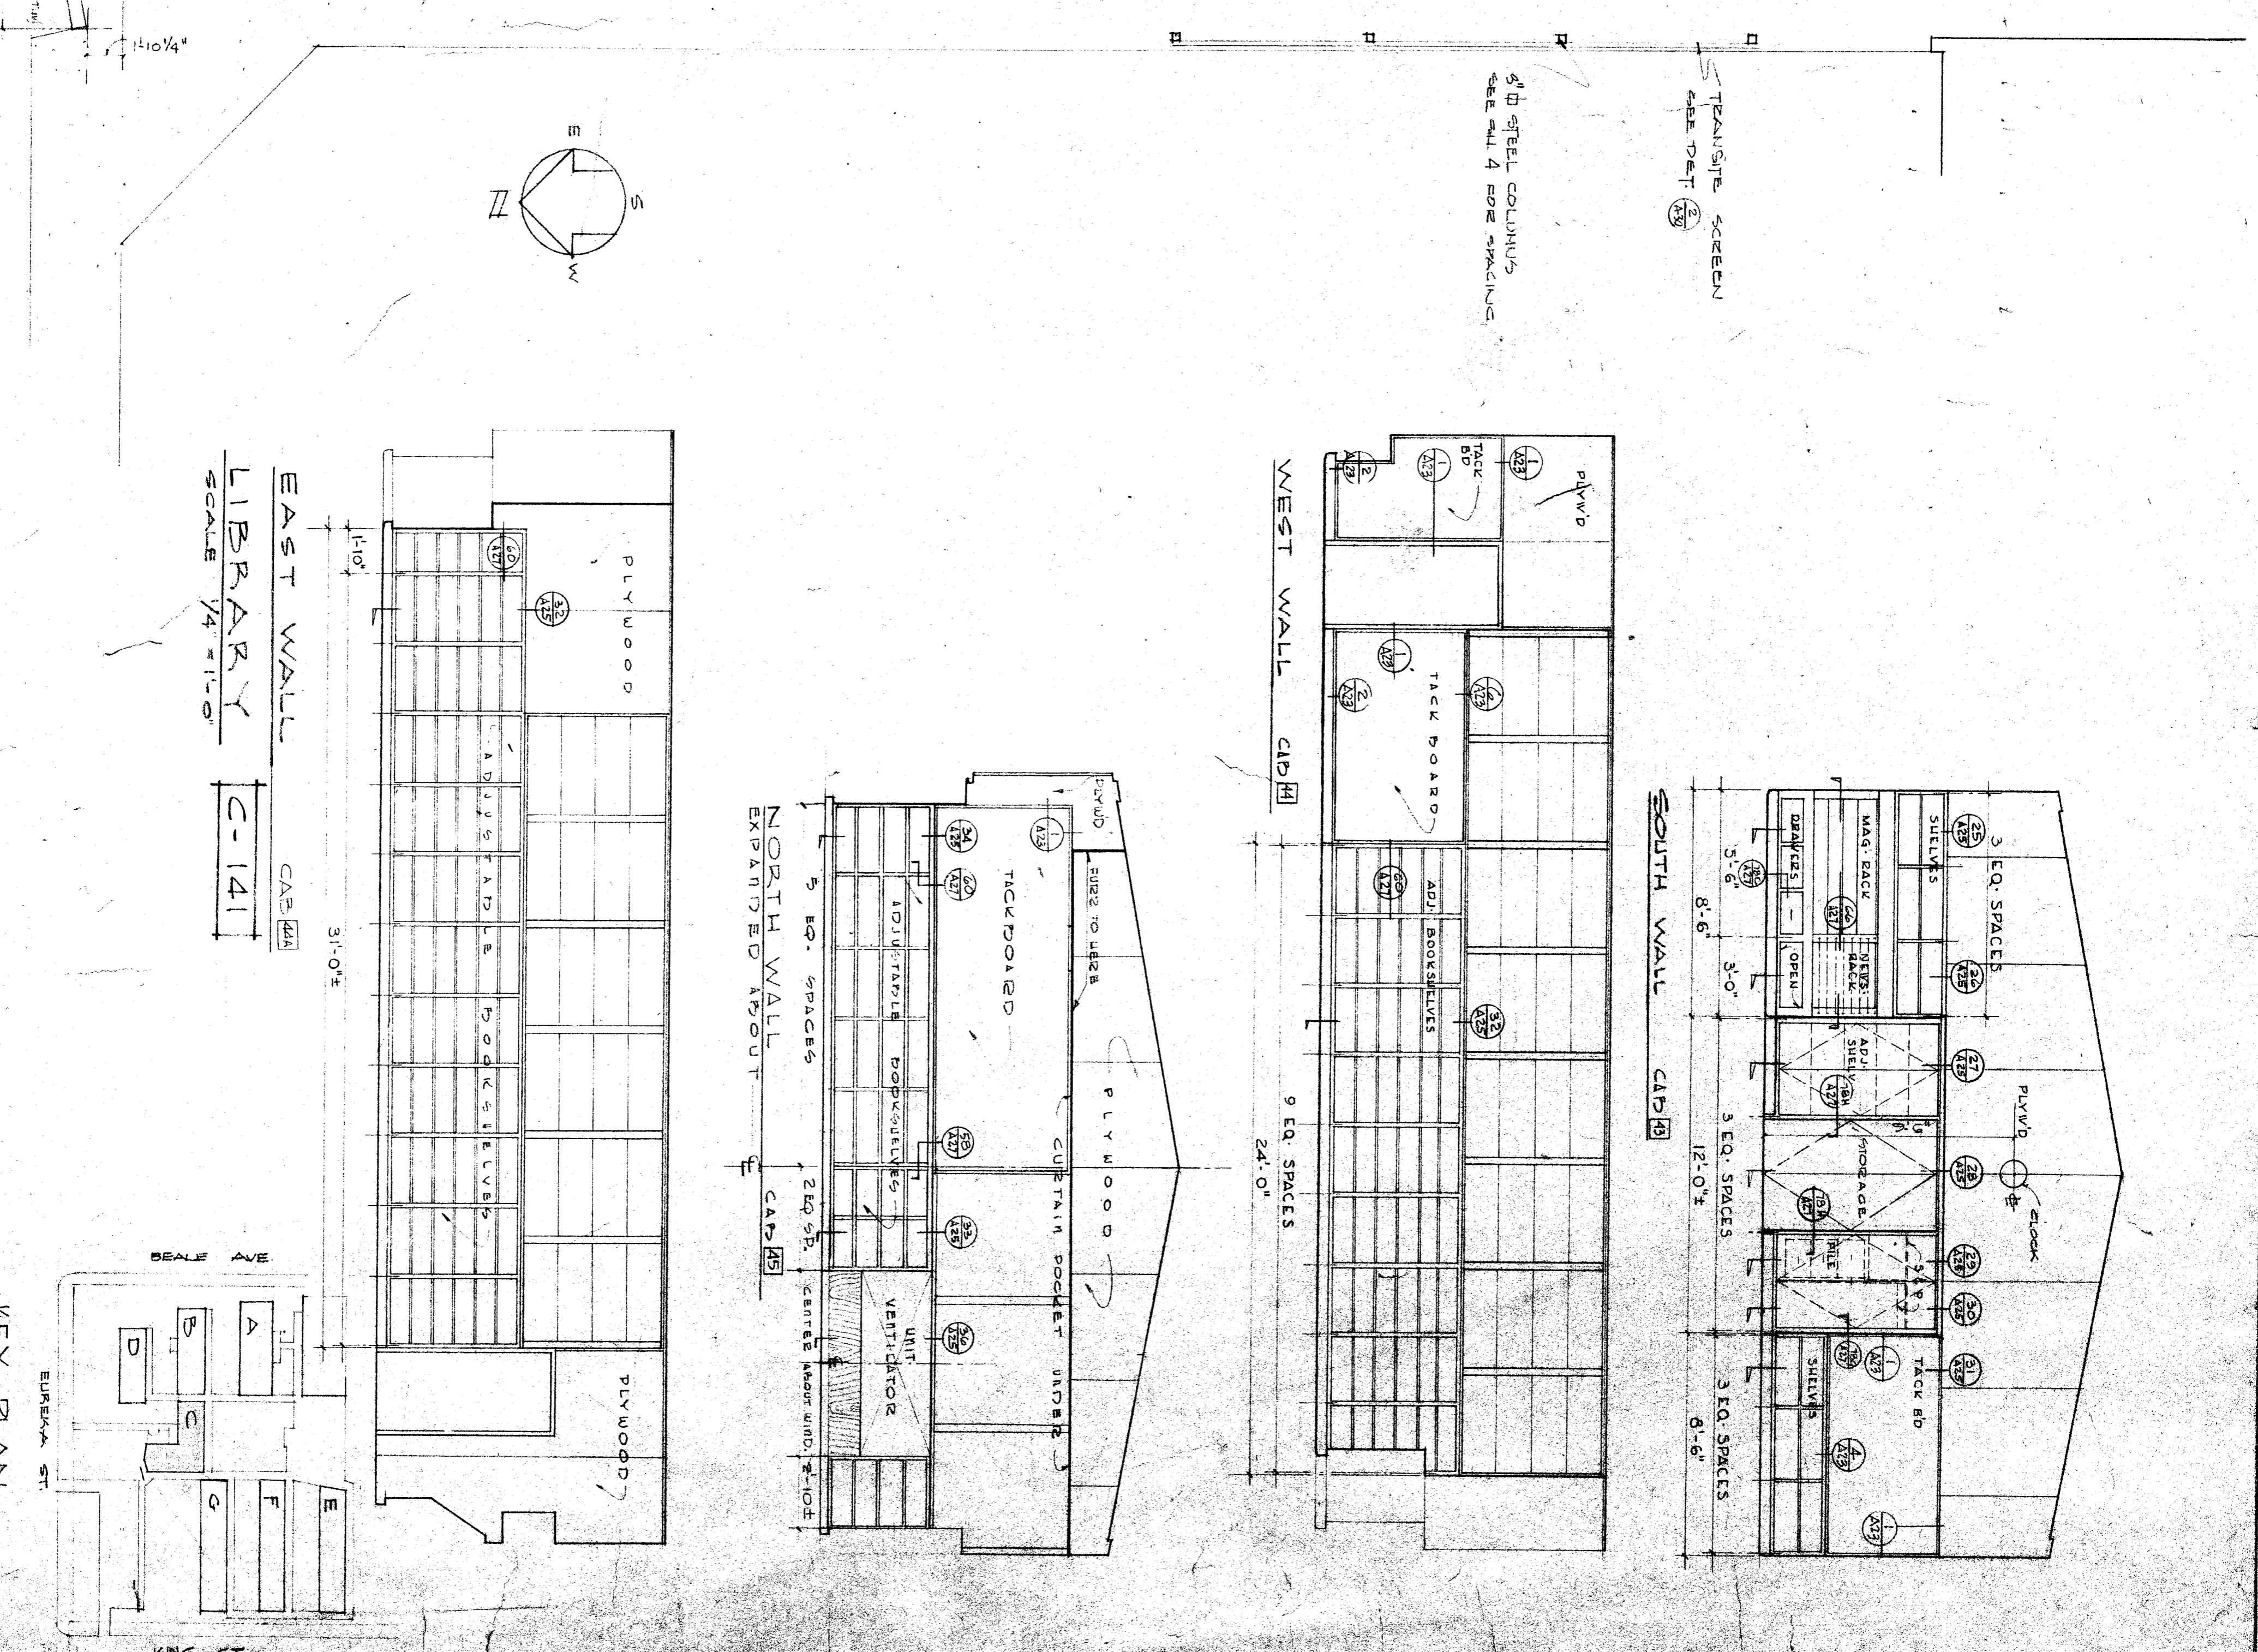

STATE OF CALIFORNIA DIVISION OF PUBLIC WORKS APPROVED	KERN CO. SUPERINTENDENT OF SCHOOLS APPROVED	BAKERSFIELD CITY SCHOOL DISTRICT BOARD OF EDUCATION APPROVED
DATE 1-11-53	DATE 1-11-53	DATE 1-11-53
APPROVED BY [Signature]	APPROVED BY [Signature]	APPROVED BY [Signature]

ROBERT T. N. EDDY
ARCHITECT A.I.A.
2901 H ST. BAKERSFIELD CALIFORNIA PH 59044

BUILDING C ADMINISTRATION PLAN - INTERIOR ELEVATIONS.
LINCOLN JUNIOR HIGH SCHOOL
BAKERSFIELD CITY SCHOOL DISTRICT
KERN COUNTY CALIFORNIA