




NORTH HEALTH EDUCATION CLASSROOM E-143

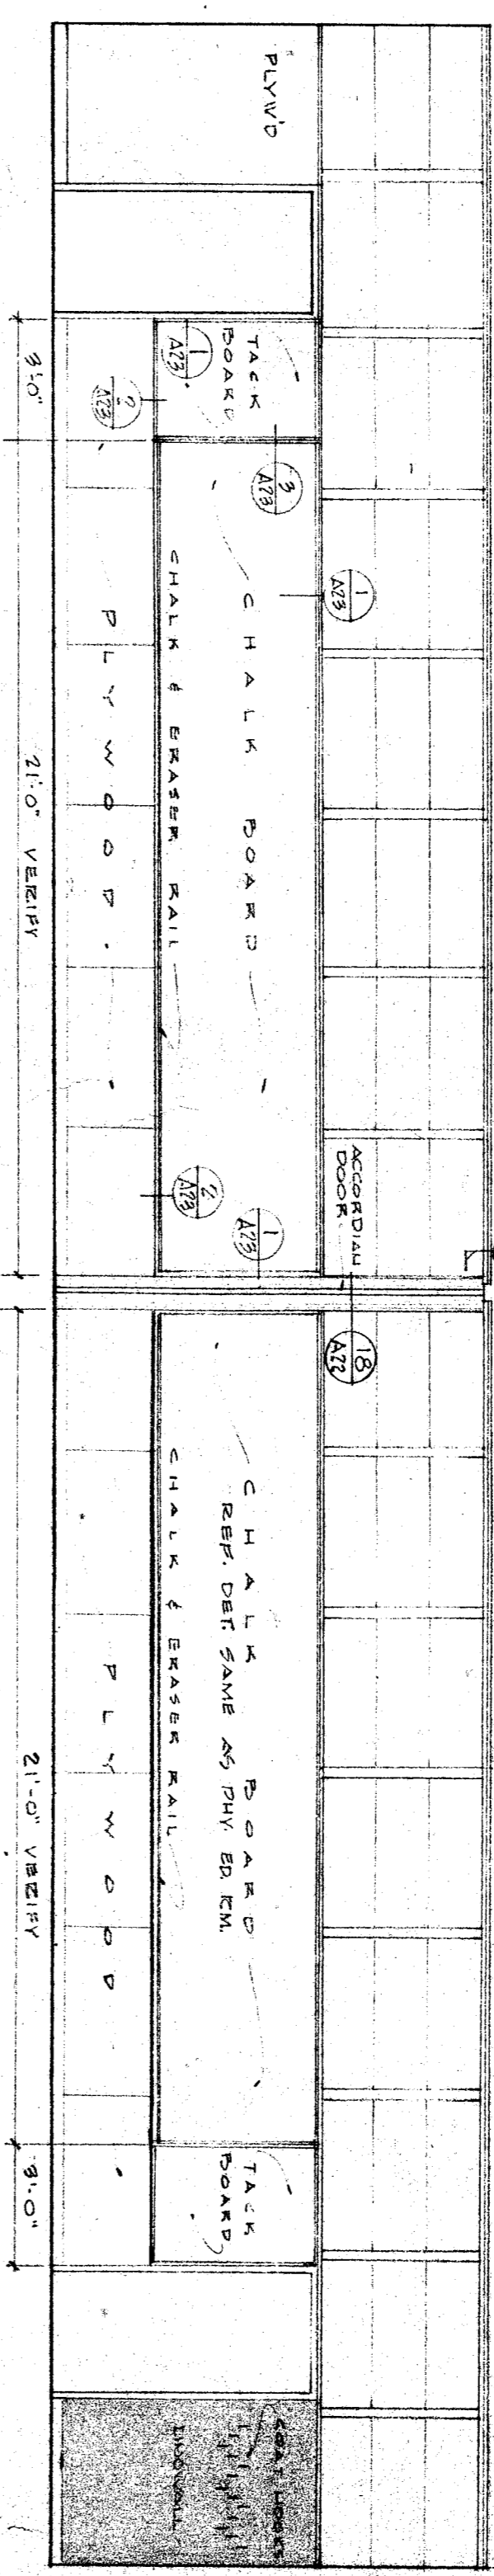


SOUTH HEALTH EDUCATION CLASSROOM E-143

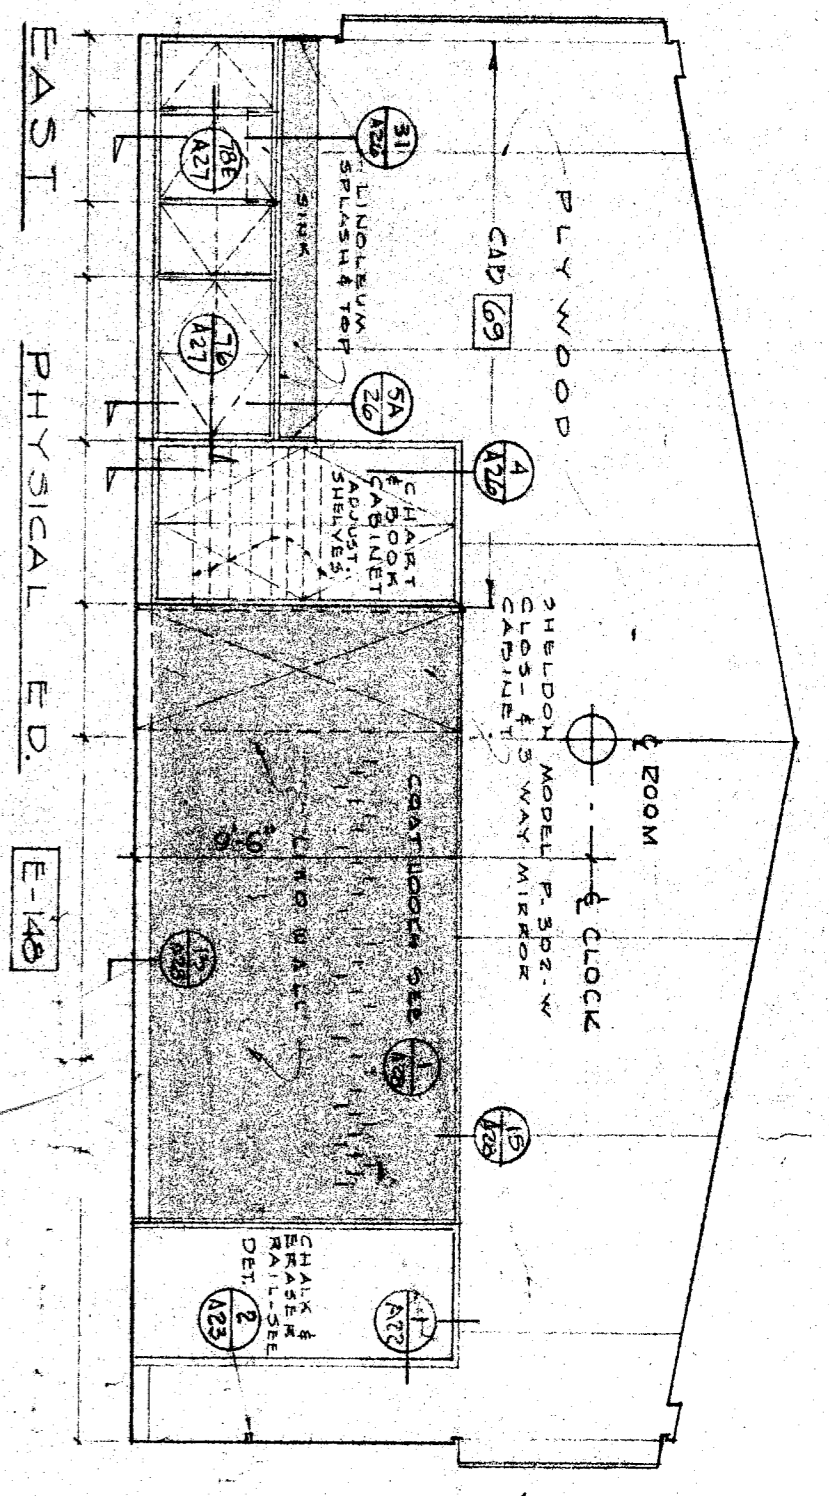


EAST HEALTH ED. E-143

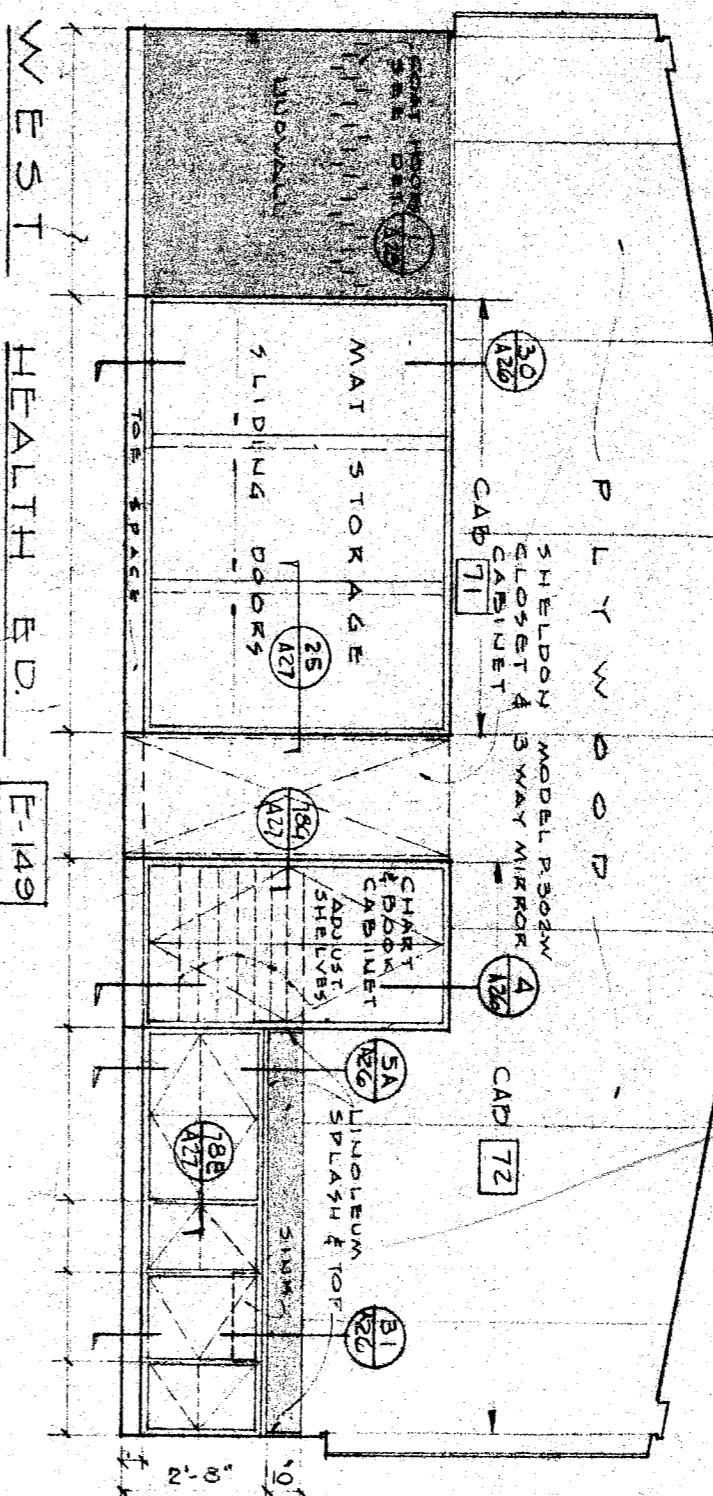


WEST HEALTH ED. E-143

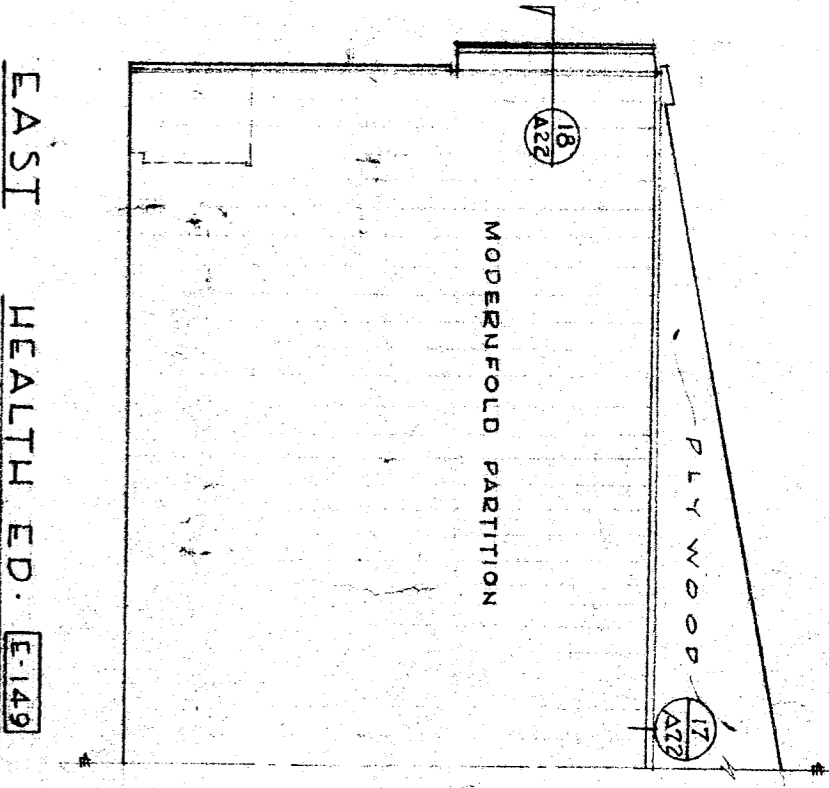


EAST HEALTH ED. E-143

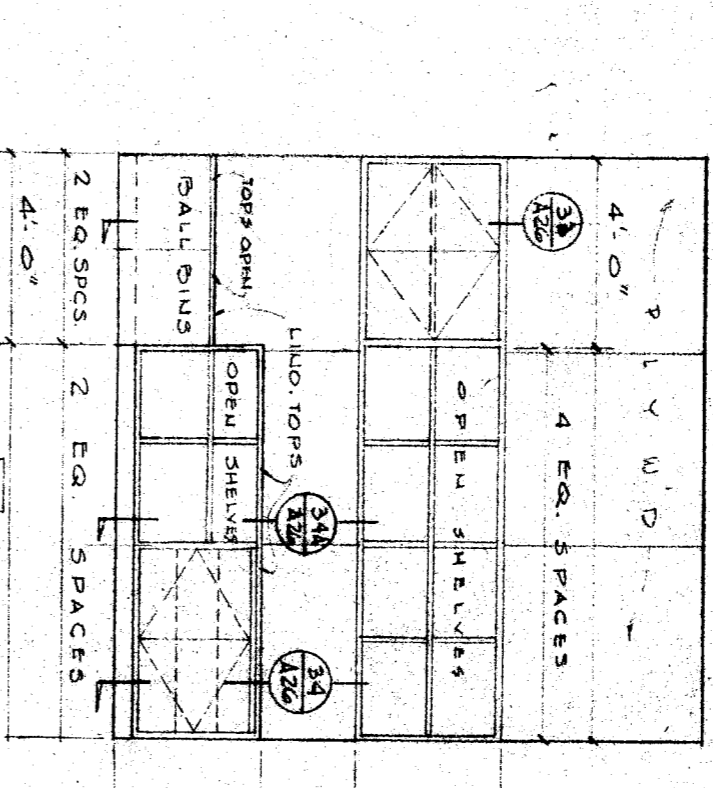


WEST HEALTH ED. E-143

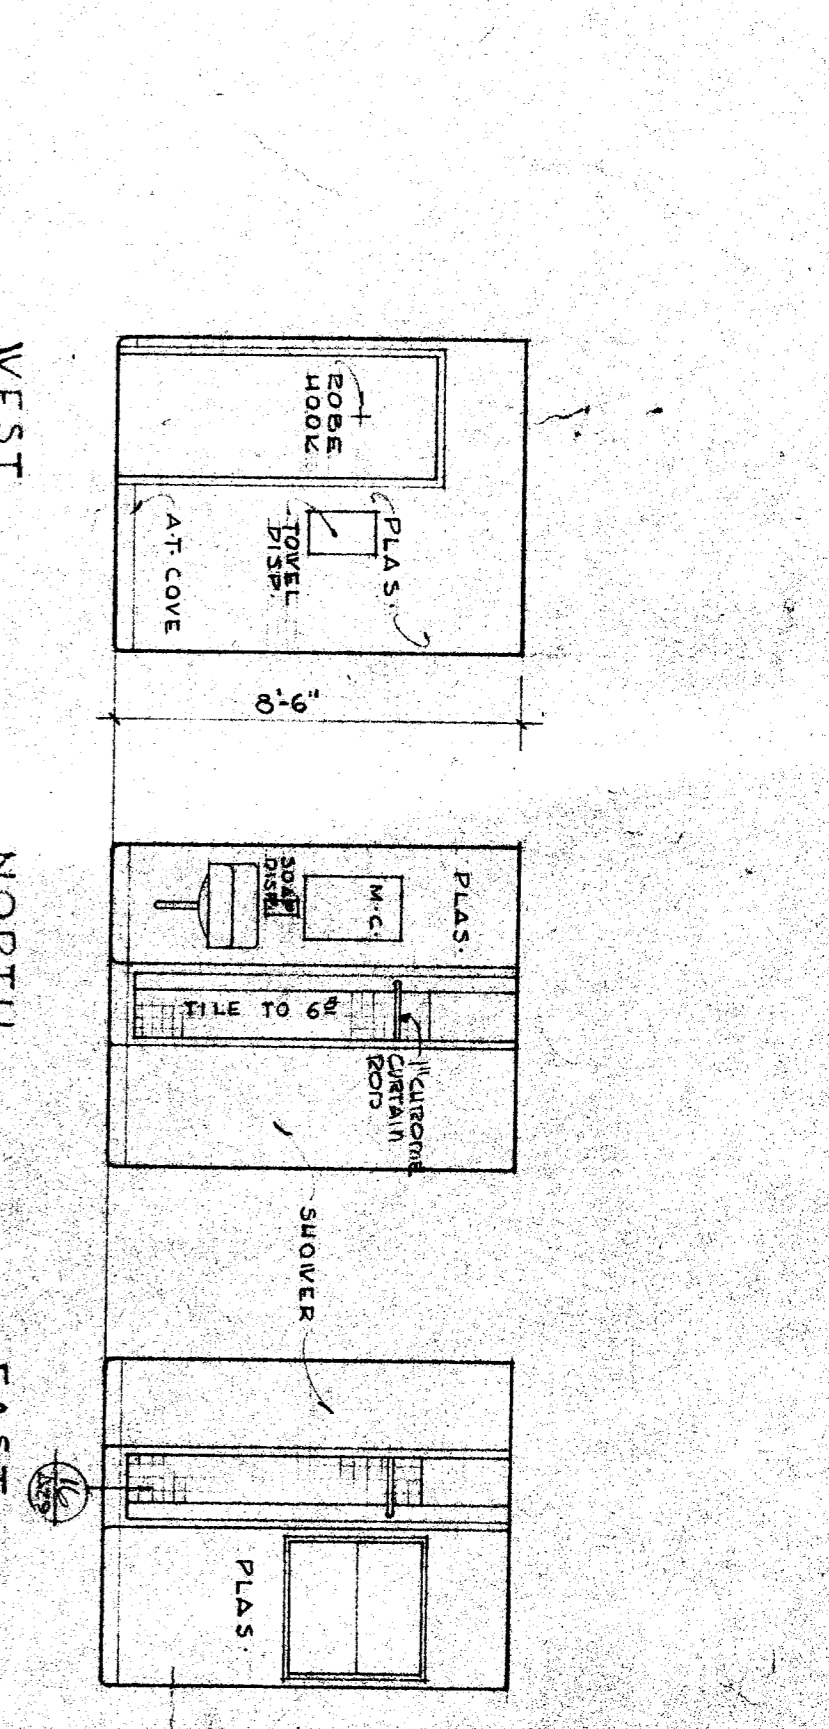


NORTH SHOWER ROOM E-144

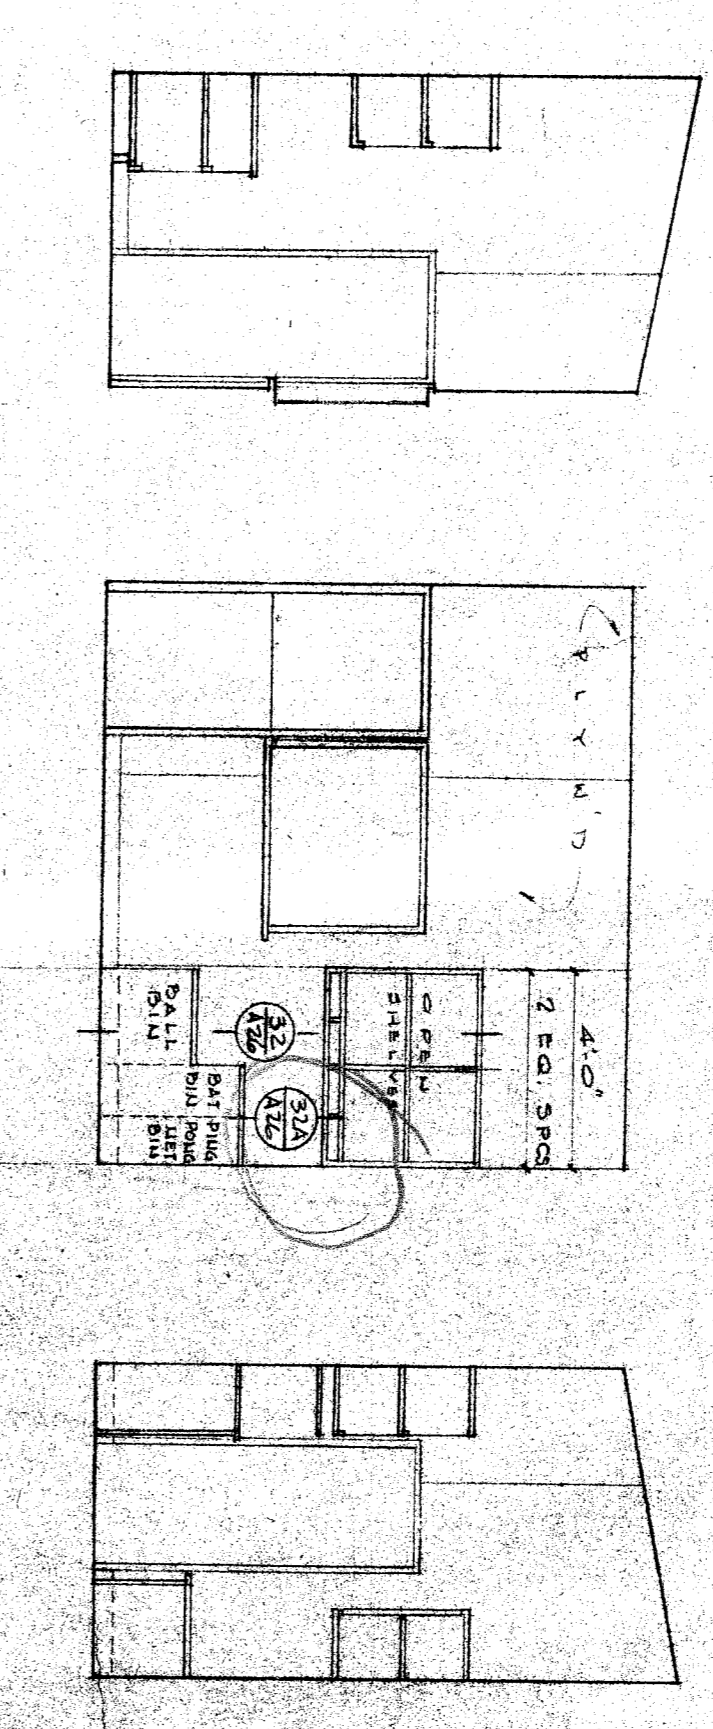


SOUTH SHOWER ROOM E-144

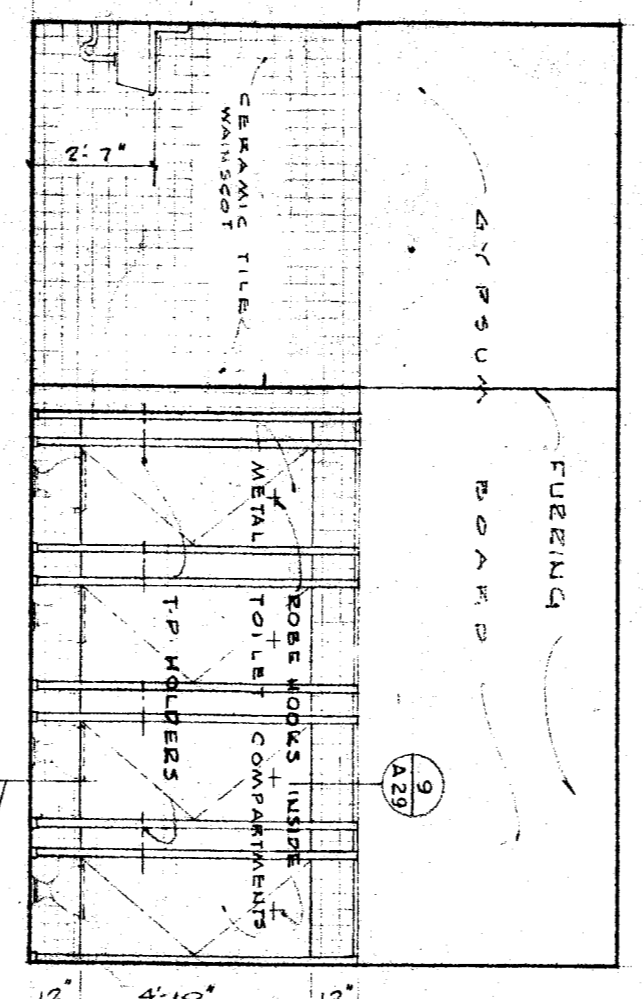


SOUTH BOYS LAVATORY E-147

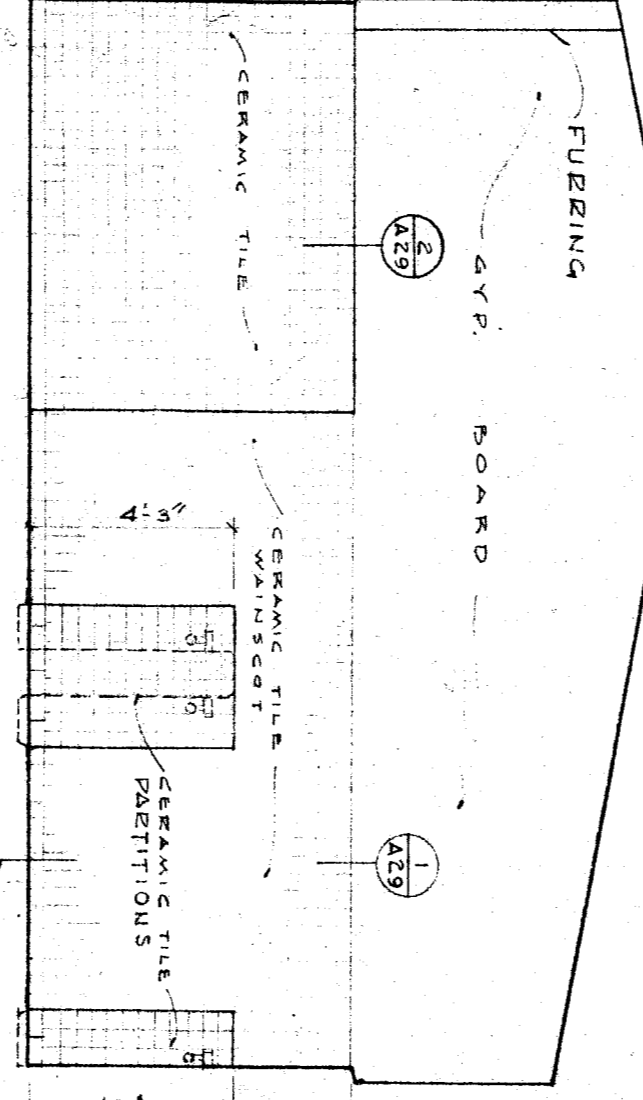


WEST BOYS LAVATORY E-147

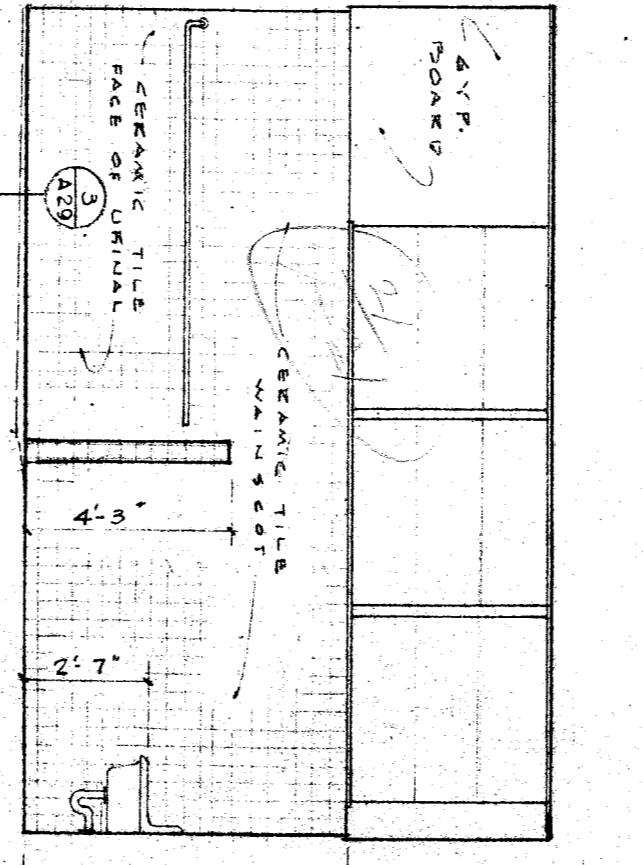


NORTH BOYS LAVATORY E-147

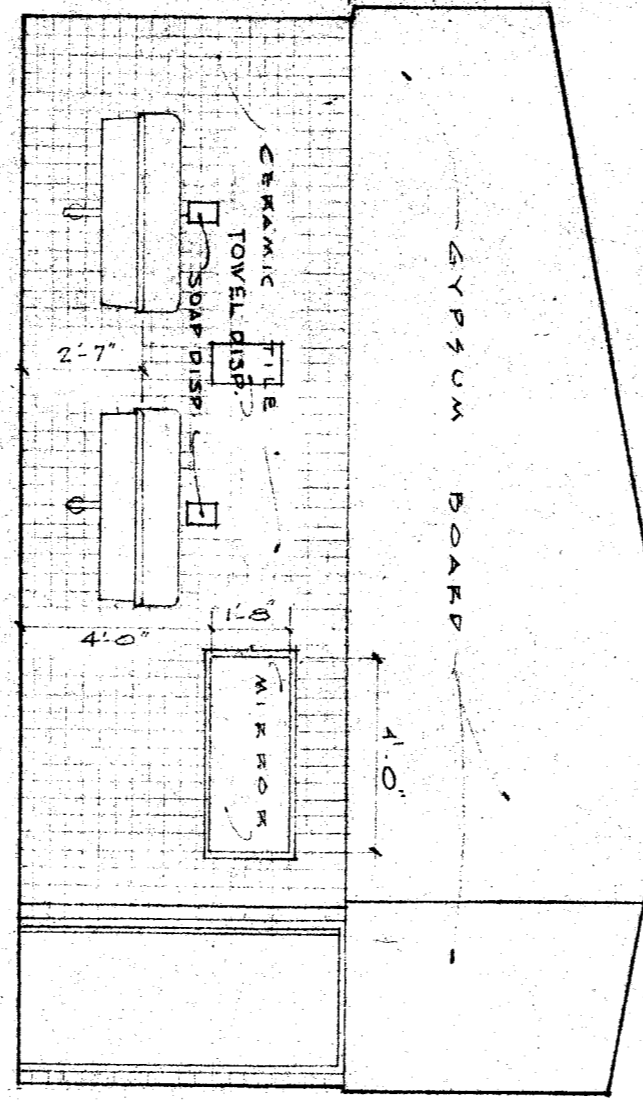


EAST BOYS LAVATORY E-147

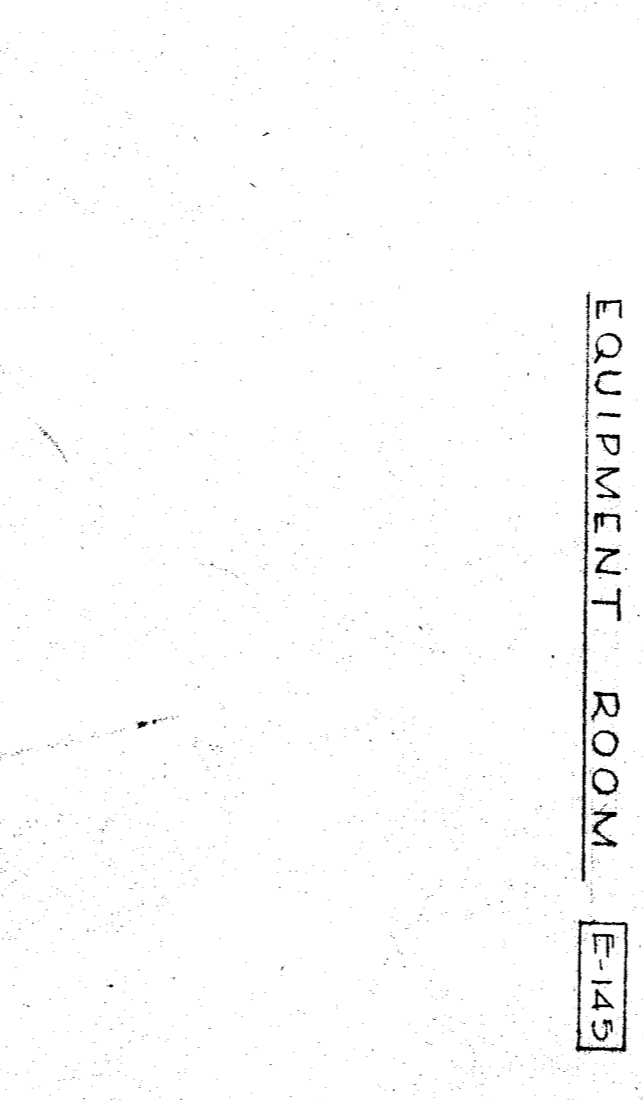


EAST HEATER ROOM E-146

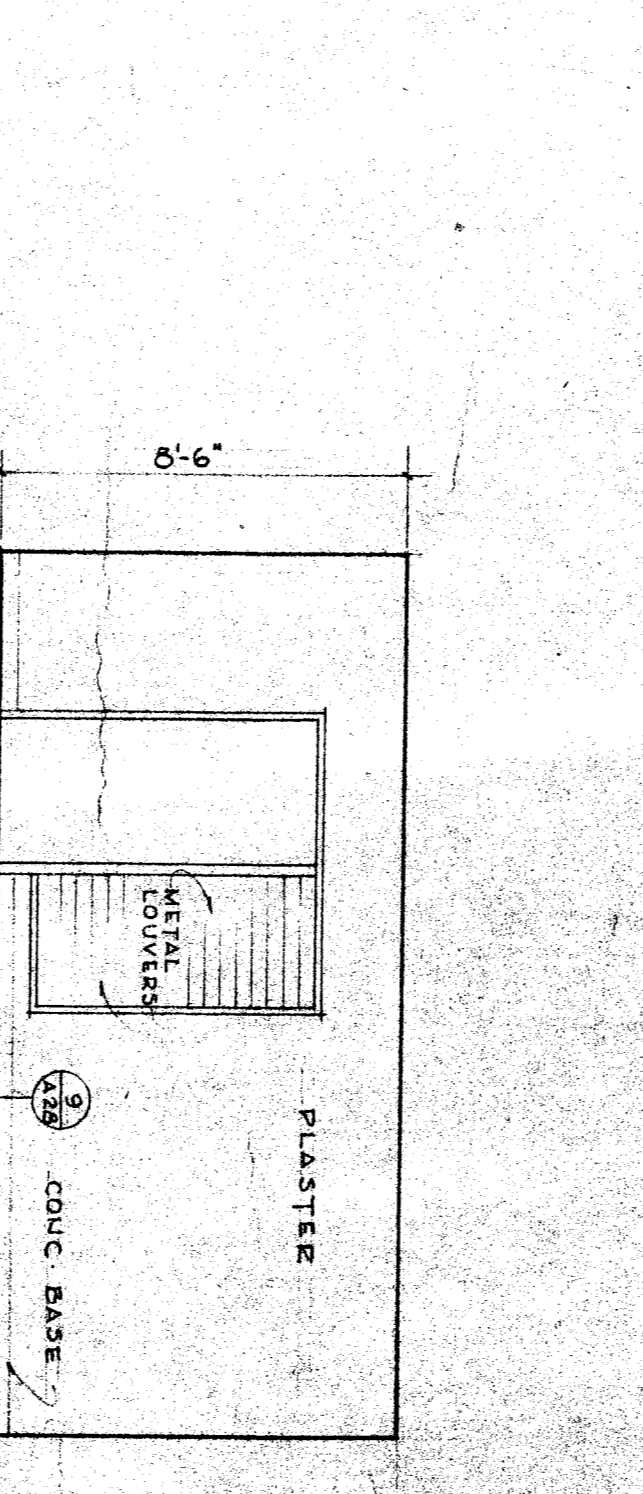


WEST HEATER ROOM E-146

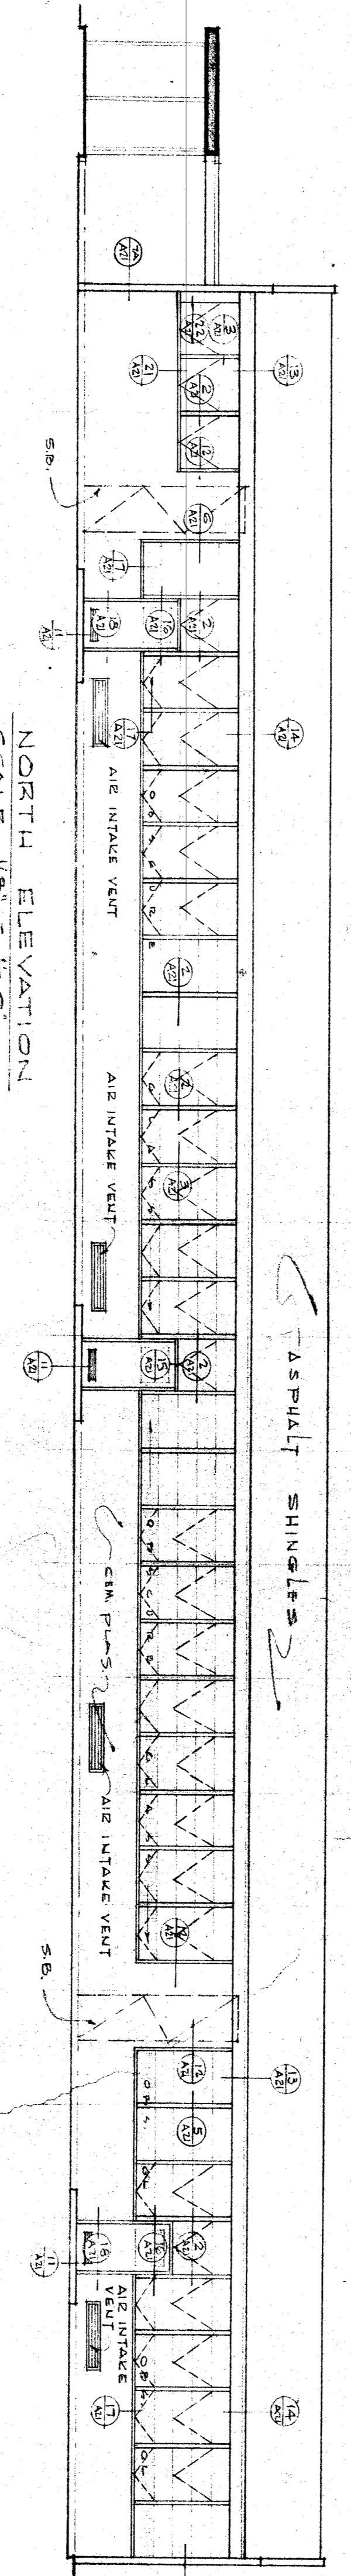


NORTH ELEVATION SCALE 1/8" = 1'-0"

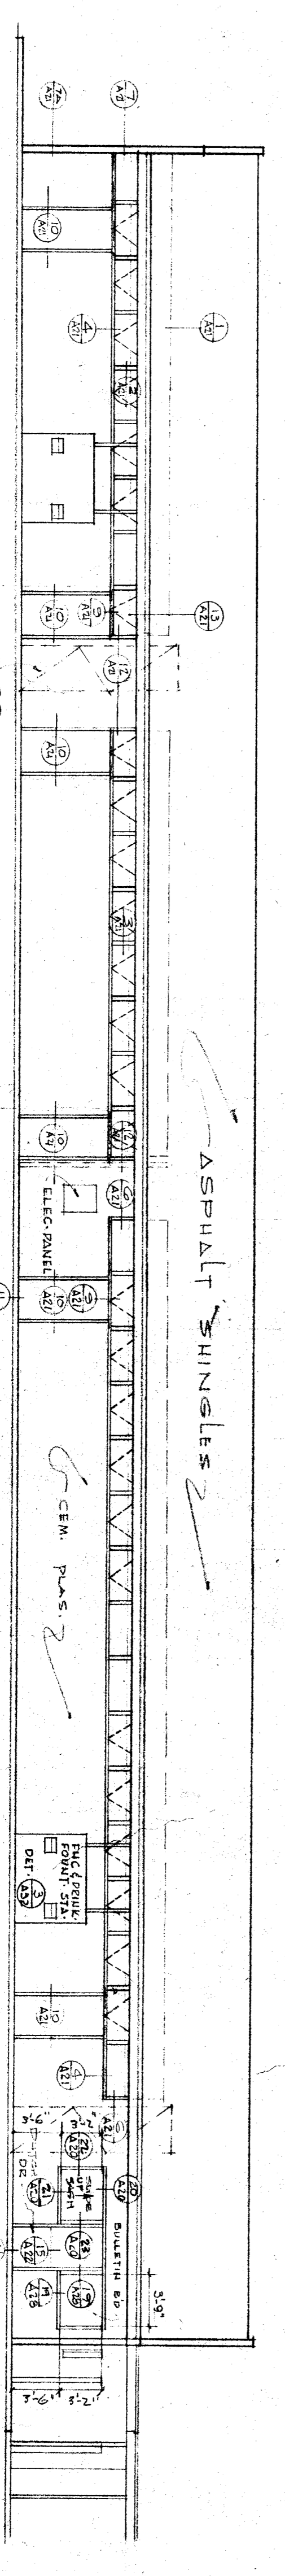

SOUTH ELEVATION SCALE 1/8" = 1'-0"

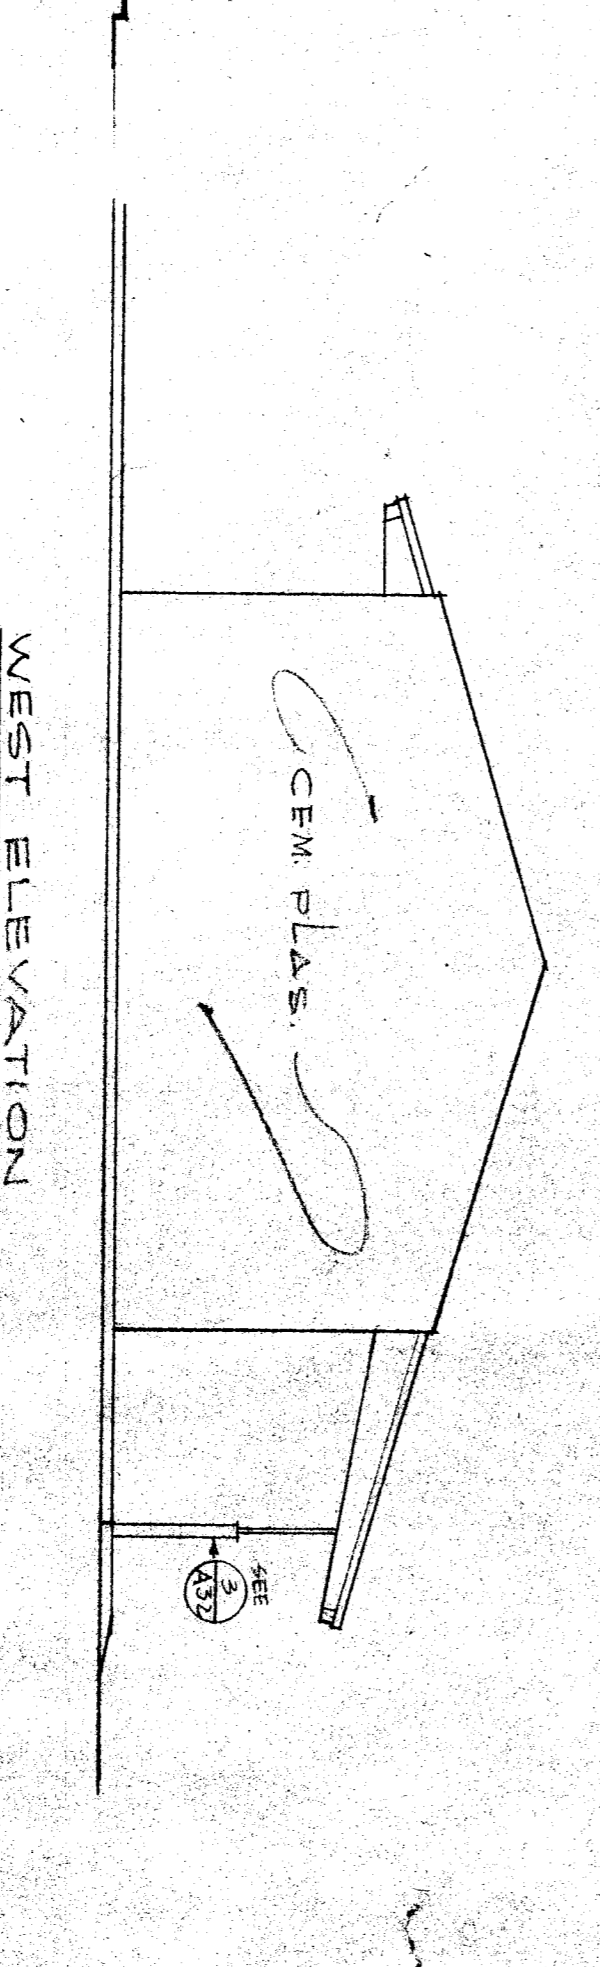

WEST ELEVATION SCALE 1/8" = 1'-0"

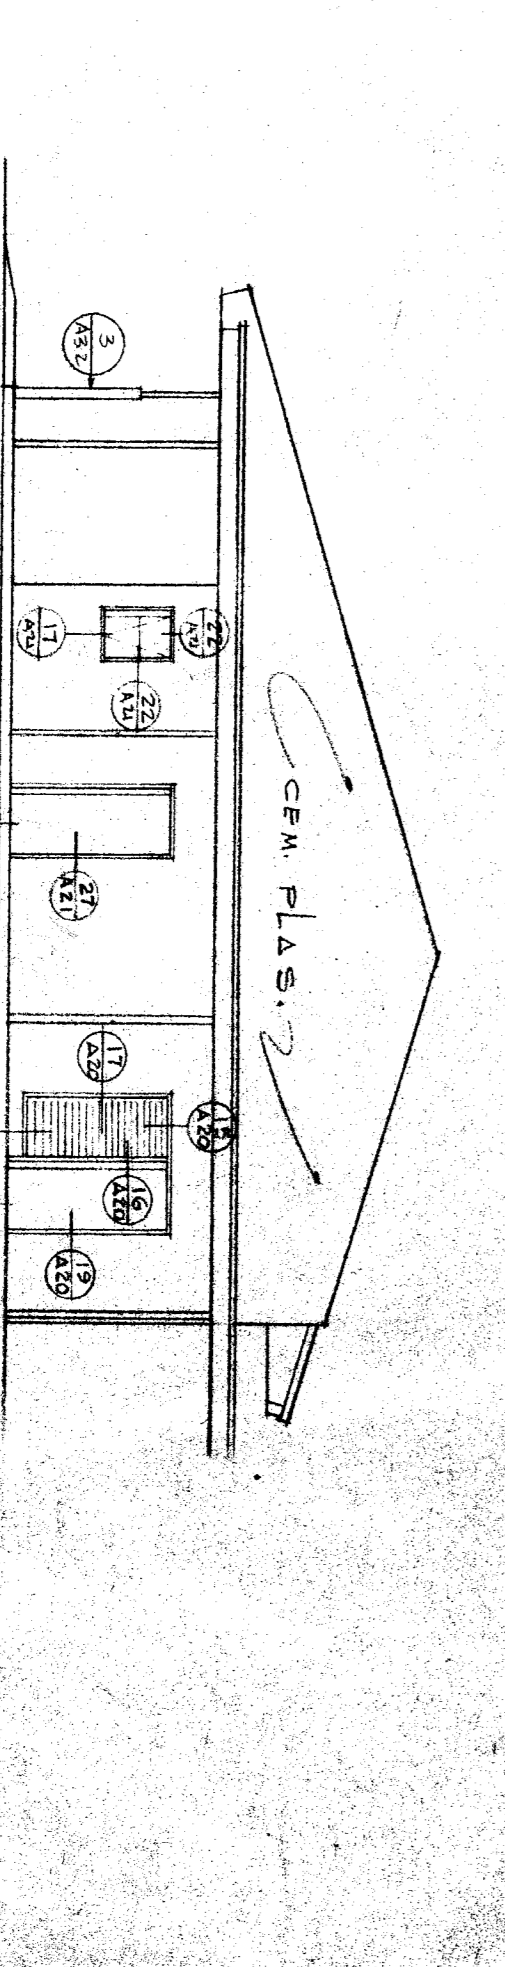

EAST ELEVATION SCALE 1/8" = 1'-0"

STATE OF CALIFORNIA DEPT. OF PUBLIC WORKS DIVISION OF ARCHITECTURE	WERN CO. SUPERINTENDENT OF SCHOOLS APPROVED: _____ DATE: _____	BAKERSFIELD CITY SCHOOL DIST. BOARD OF EDUCATION APPROVED: _____ DATE: _____	REVISIONS
DATE 9-30-57 JOB NO. 119	DRAWN J.P.C. CHECKED R.R.	ROBERT N. ENDY ARCHITECT A.I.A.	BUILDING SPECIAL CLASSROOMS EXTERIOR ELEVATIONS
DATE 10-20-57 JOB NO. 119	DRAWN J.P.C. CHECKED R.R.	ROBERT N. ENDY ARCHITECT A.I.A.	INTERIOR ELEVATIONS
DATE 10-20-57 JOB NO. 119	DRAWN J.P.C. CHECKED R.R.	ROBERT N. ENDY ARCHITECT A.I.A.	LINGOLN JUNIOR HIGH SCHOOL
DATE 10-20-57 JOB NO. 119	DRAWN J.P.C. CHECKED R.R.	ROBERT N. ENDY ARCHITECT A.I.A.	BAKERSFIELD CITY SCHOOL DISTRICT
DATE 10-20-57 JOB NO. 119	DRAWN J.P.C. CHECKED R.R.	ROBERT N. ENDY ARCHITECT A.I.A.	BAKERSFIELD, KERN COUNTY, CALIFORNIA