




PLAN OF HOMEMAKING BLDG. B  
SCALE 1/4" = 1'-0"

NOTE: ALL DIMENSIONS SHOWN FOR INTERIOR STUD PARTITIONS ARE TO FACE OR 2 STUDS.  
NOTE: PROVIDE WINDOW SCREENS AS SPECIFIED THIS BLDG. ONLY.

PLAN OF ATTIC HEATER SPACE  
SCALE 1/4" = 1'-0"

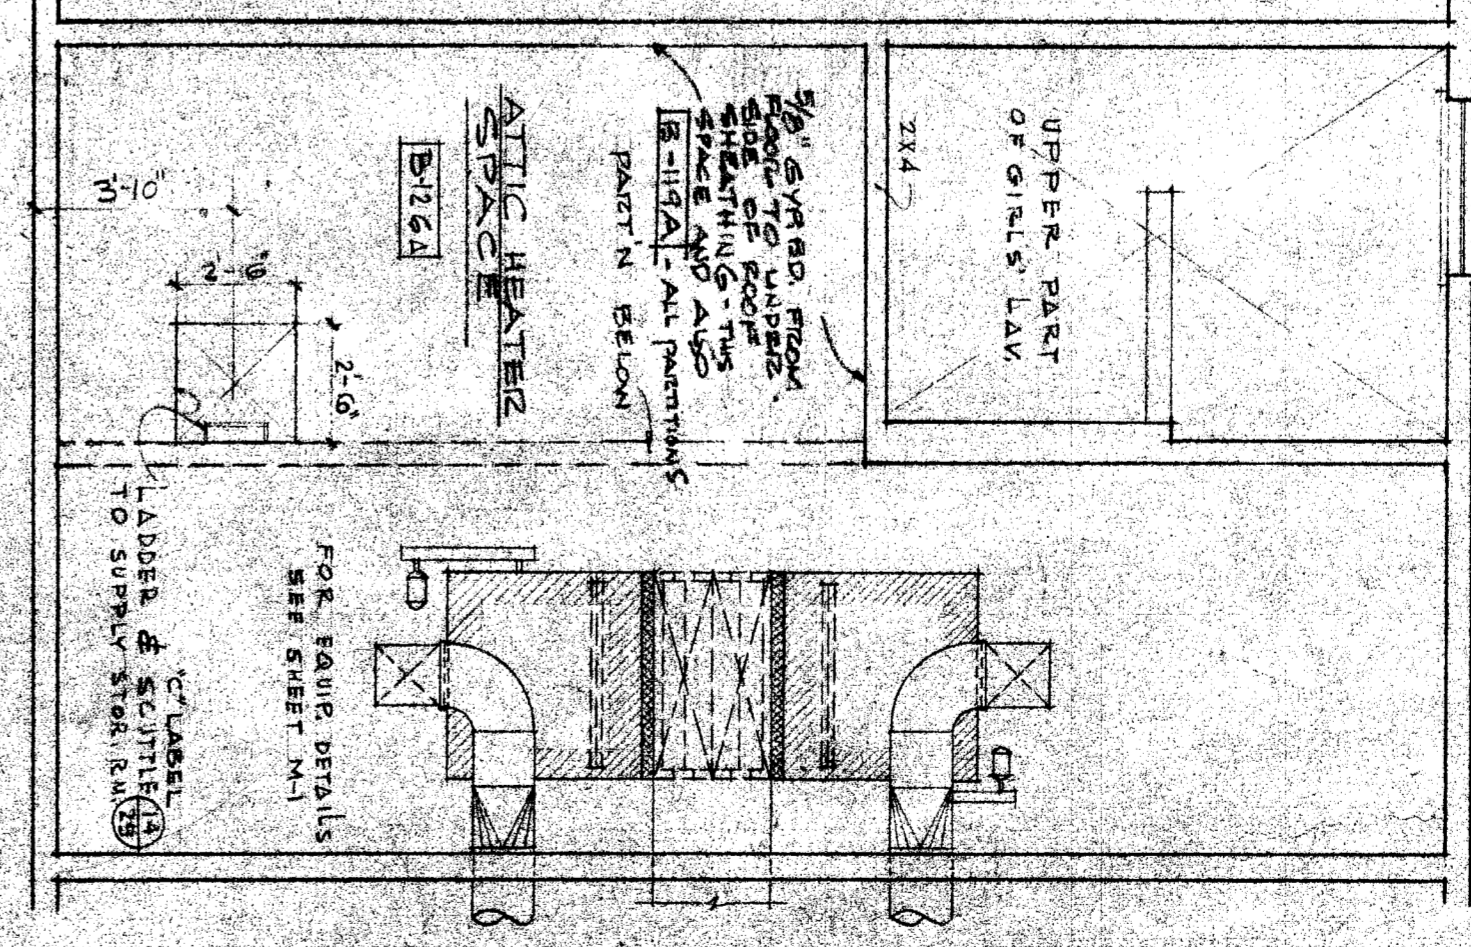


WEST ELEVATION BLDG. B  
SCALE 1/8" = 1'-0"

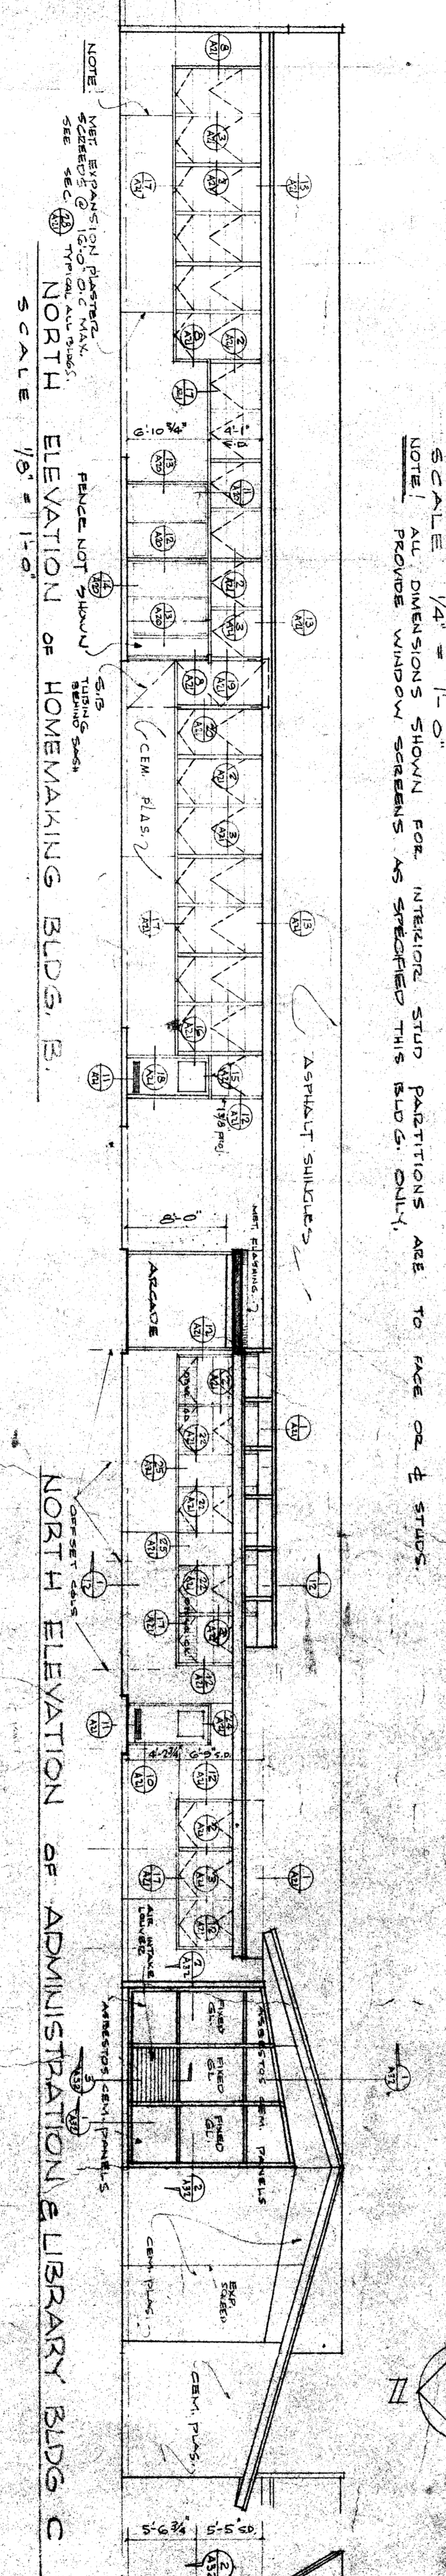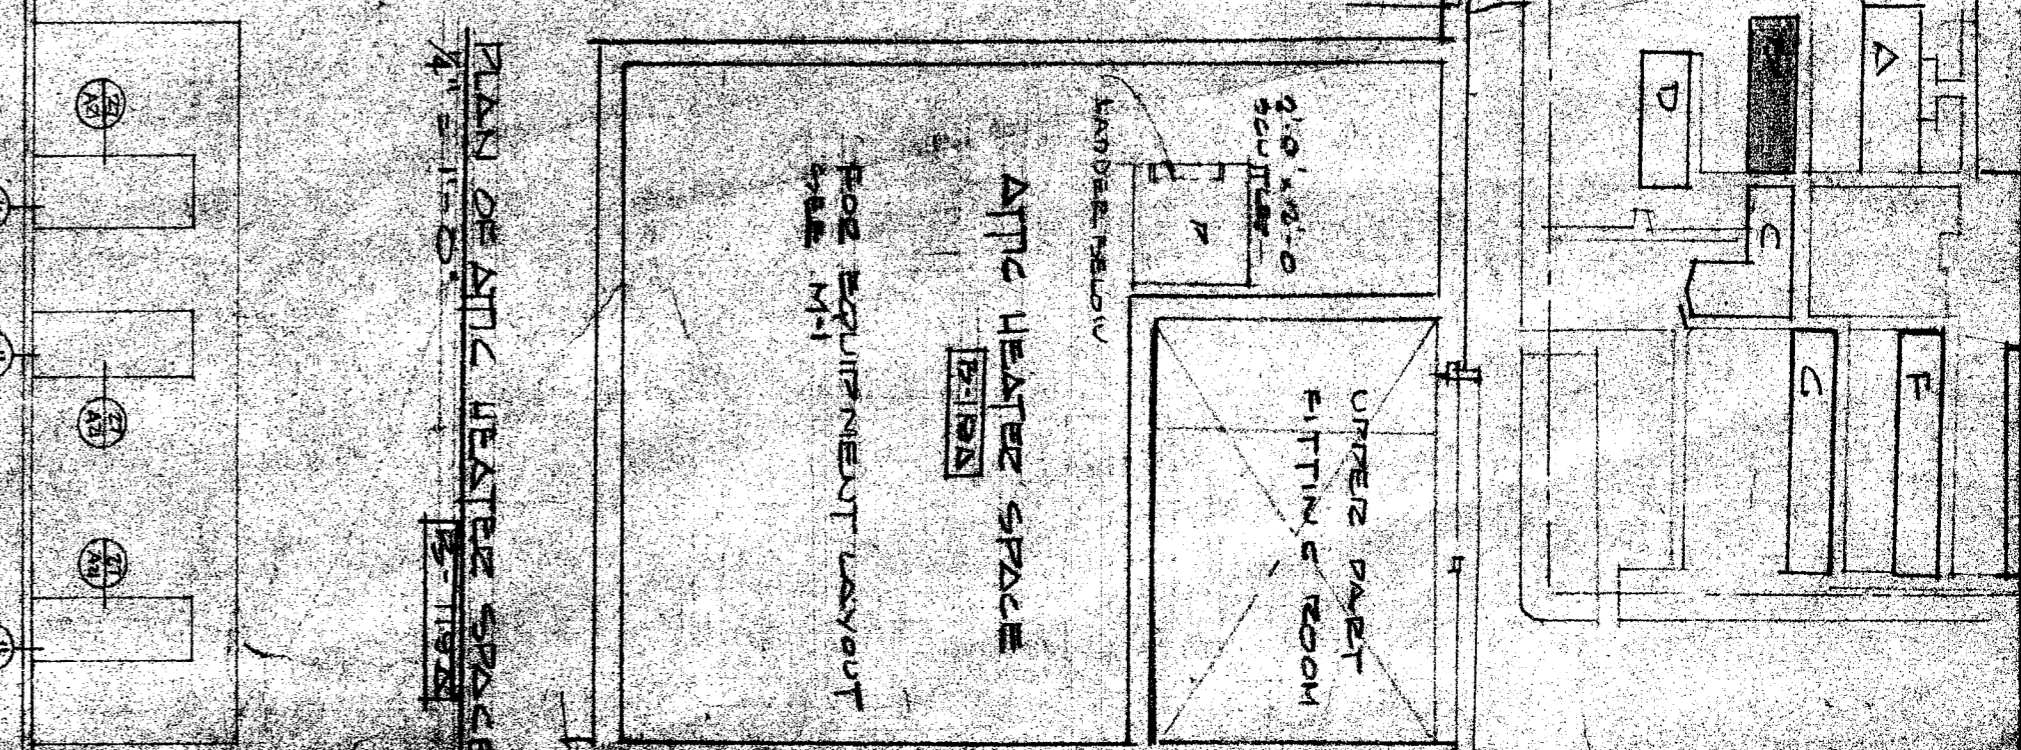

NORTH ELEVATION OF ADMINISTRATION & LIBRARY BLDG. C  
SCALE 1/8" = 1'-0"


WEST ELEVATION OF ADMINISTRATION & LIBRARY BLDG. C  
SCALE 1/8" = 1'-0"

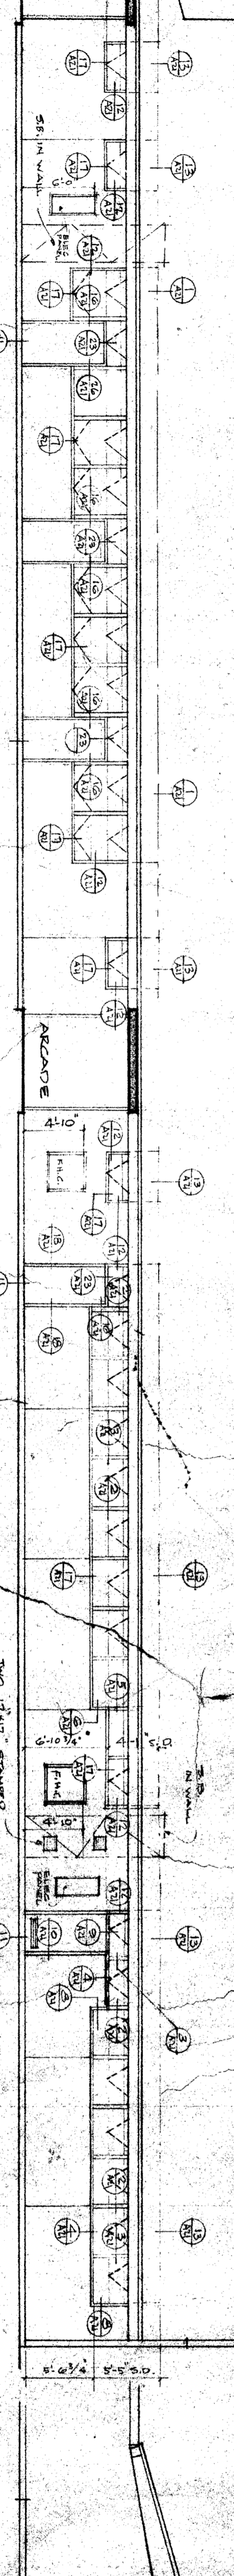

SOUTH ELEVATION OF ADMINISTRATION & LIBRARY BLDG. C  
SCALE 1/8" = 1'-0"

SOUTH ELEVATION OF HOMEMAKING BLDG. B  
SCALE 1/8" = 1'-0"

EAST ELEVATION OF HOMEMAKING BLDG. B  
SCALE 1/8" = 1'-0"

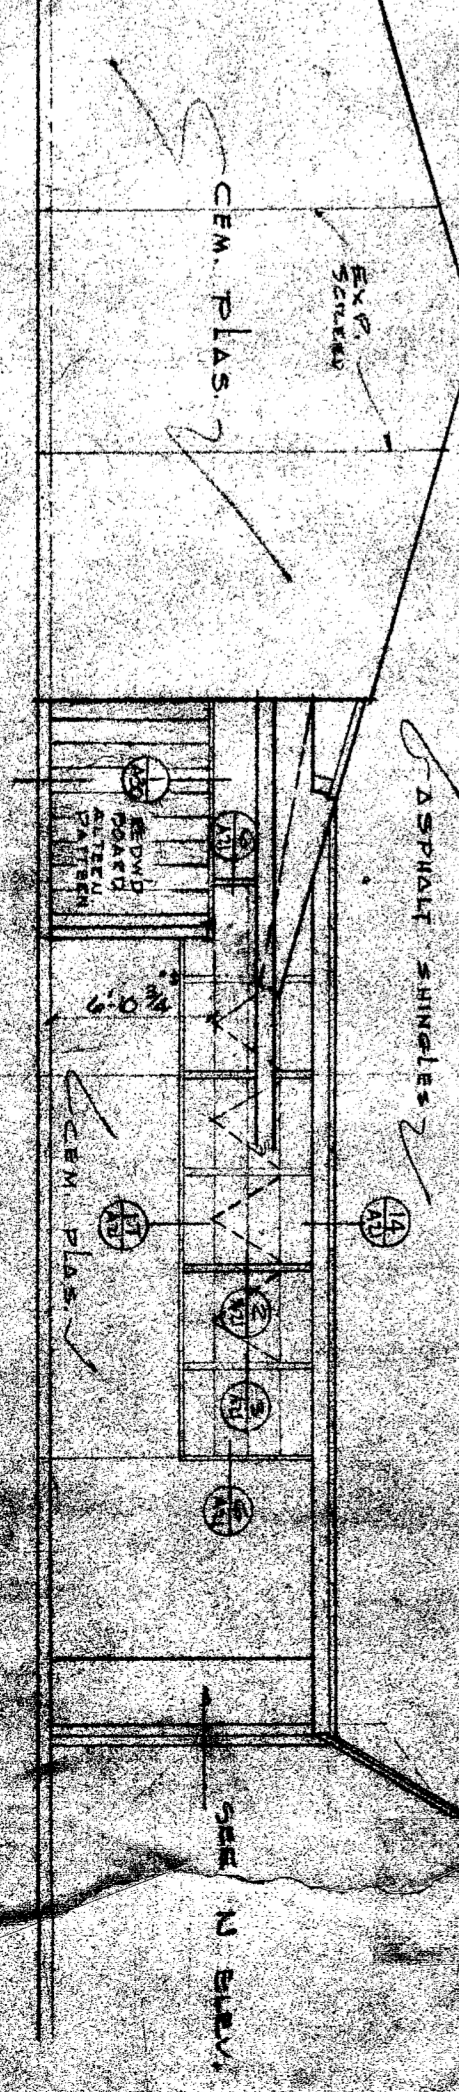

STATE OF CALIFORNIA	DEPT. OF PUBLIC WORKS	REAR CO. SUPERINTENDENT OF SCHOOLS	APPROVED:
DIVISION OF ARCHITECTURE	APPROVED: [Signature]	DATE: 10-30-53	
PROJECT: [Project Name]	DATE: 10-30-53		

DATE: 9-30-53	DRAWING L.P.	ROBERT N. EDDY
JOB NO. 179	CHECKED R.S.	ARCHITECT, A.I.A.
ARCHITECT: [Firm Name]	C-995	9901 H. ST. BAKERSFIELD, CALIFORNIA

BLDG. B HOMEMAKING PLANNING ELEVATIONS	BLDG. C ADMINISTRATION	LINCOLN JUNIOR HIGH SCHOOL
BLDG. C ELEVATIONS	BLDG. B HOMEMAKING	BLDG. C ADMINISTRATION
BLDG. B HOMEMAKING	BLDG. C ADMINISTRATION	BLDG. B HOMEMAKING