

**PANEL A LIGHTING PANELS SCHEDULE**

CCT	OUTLETS	CONNECTED LOAD	REARER	NOTES
1	LIGHT	MATTS	MATTS	AMP POLE
2	OWNER			
1	1	1500	1500	15
2	2	1500	1500	15
3	3	1500	1500	15
4	4	1500	1500	15
5	5	1500	1500	15
6	6	1500	1500	15
7	7	1500	1500	15
8	8	1500	1500	15
9	9	1500	1500	15
10	10	1500	1500	15
11	11	1500	1500	15
12	12	1500	1500	15
13	13	1500	1500	15
14	14	1500	1500	15
15	15	1500	1500	15
16	16	1500	1500	15
17	17	1500	1500	15
18	18	1500	1500	15
19	19	1500	1500	15
20	20	1500	1500	15
21	21	1500	1500	15
22	22	1500	1500	15
23	23	1500	1500	15
24	24	1500	1500	15
25	25	1500	1500	15
26	26	1500	1500	15
27	27	1500	1500	15
28	28	1500	1500	15
29	29	1500	1500	15
30	30	1500	1500	15
TOTAL		4500	4500	45

TIME SWITCH CONTROL

**PANEL B LIGHTING PANELS SCHEDULE**




CCT	OUTLETS	CONNECTED LOAD	REARER	NOTES
1	LIGHT	MATTS	MATTS	AMP POLE
2	OWNER			
1	1	1500	1500	15
2	2	1500	1500	15
3	3	1500	1500	15
4	4	1500	1500	15
5	5	1500	1500	15
6	6	1500	1500	15
7	7	1500	1500	15
8	8	1500	1500	15
9	9	1500	1500	15
10	10	1500	1500	15
11	11	1500	1500	15
12	12	1500	1500	15
13	13	1500	1500	15
14	14	1500	1500	15
15	15	1500	1500	15
16	16	1500	1500	15
17	17	1500	1500	15
18	18	1500	1500	15
19	19	1500	1500	15
20	20	1500	1500	15
21	21	1500	1500	15
22	22	1500	1500	15
23	23	1500	1500	15
24	24	1500	1500	15
25	25	1500	1500	15
26	26	1500	1500	15
27	27	1500	1500	15
28	28	1500	1500	15
29	29	1500	1500	15
30	30	1500	1500	15
TOTAL		4500	4500	45

TIME SWITCH CONTROL

**PANEL C LIGHTING PANELS SCHEDULE**

CCT	OUTLETS	CONNECTED LOAD	REARER	NOTES
1	LIGHT	MATTS	MATTS	AMP POLE
2	OWNER			
1	1	1500	1500	15
2	2	1500	1500	15
3	3	1500	1500	15
4	4	1500	1500	15
5	5	1500	1500	15
6	6	1500	1500	15
7	7	1500	1500	15
8	8	1500	1500	15
9	9	1500	1500	15
10	10	1500	1500	15
11	11	1500	1500	15
12	12	1500	1500	15
13	13	1500	1500	15
14	14	1500	1500	15
15	15	1500	1500	15
16	16	1500	1500	15
17	17	1500	1500	15
18	18	1500	1500	15
19	19	1500	1500	15
20	20	1500	1500	15
21	21	1500	1500	15
22	22	1500	1500	15
23	23	1500	1500	15
24	24	1500	1500	15
25	25	1500	1500	15
26	26	1500	1500	15
27	27	1500	1500	15
28	28	1500	1500	15
29	29	1500	1500	15
30	30	1500	1500	15
TOTAL		4500	4500	45

TIME SWITCH CONTROL

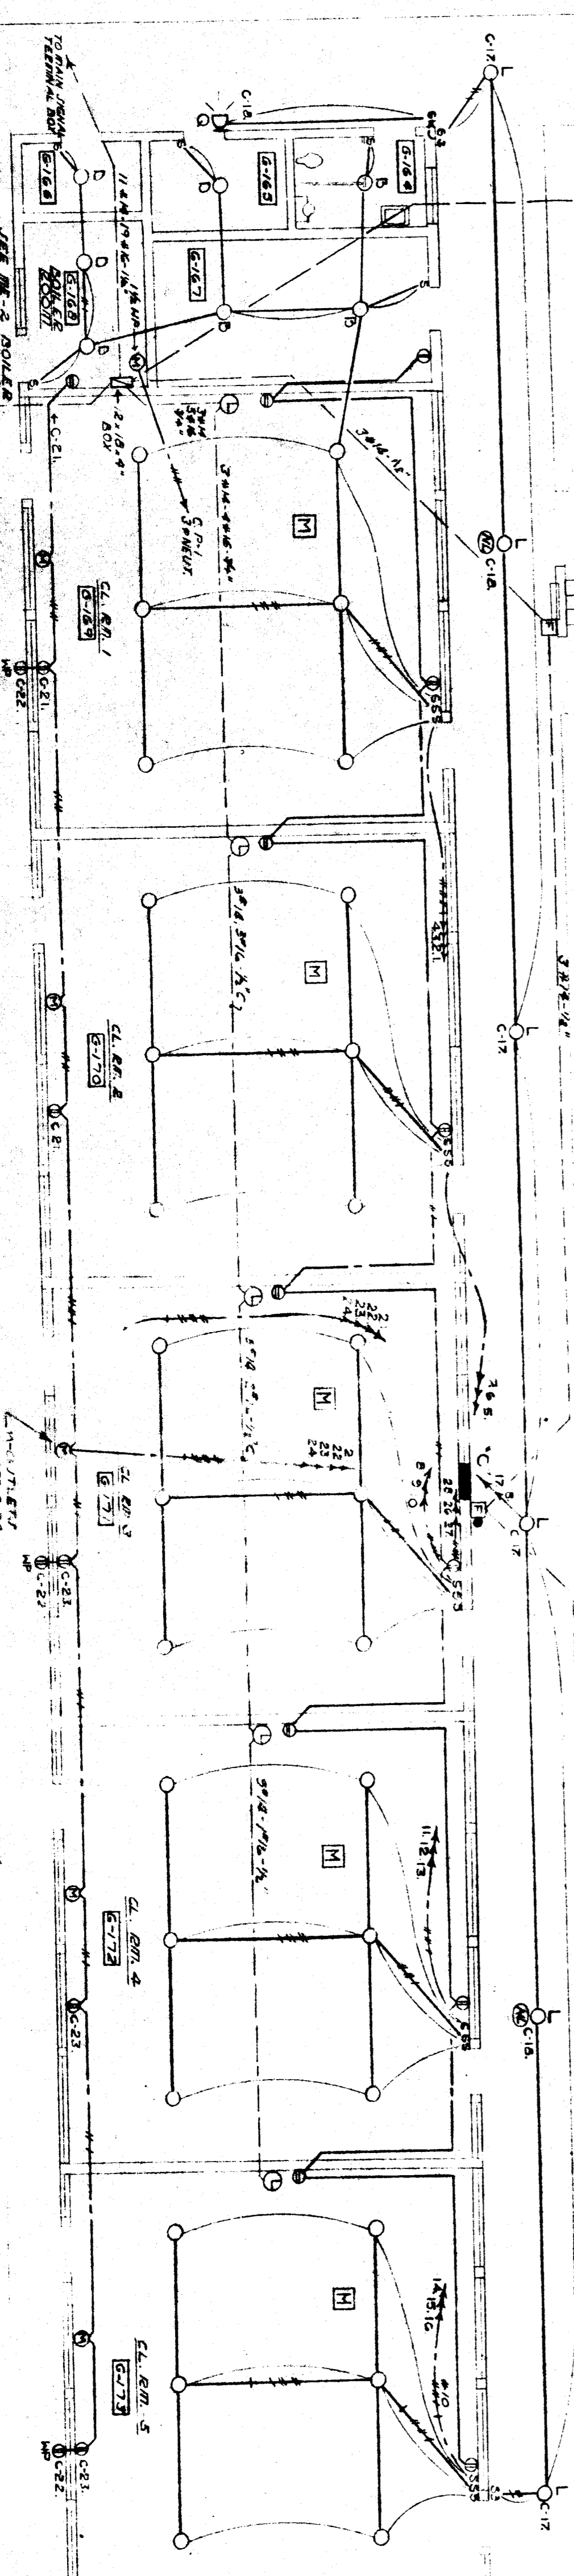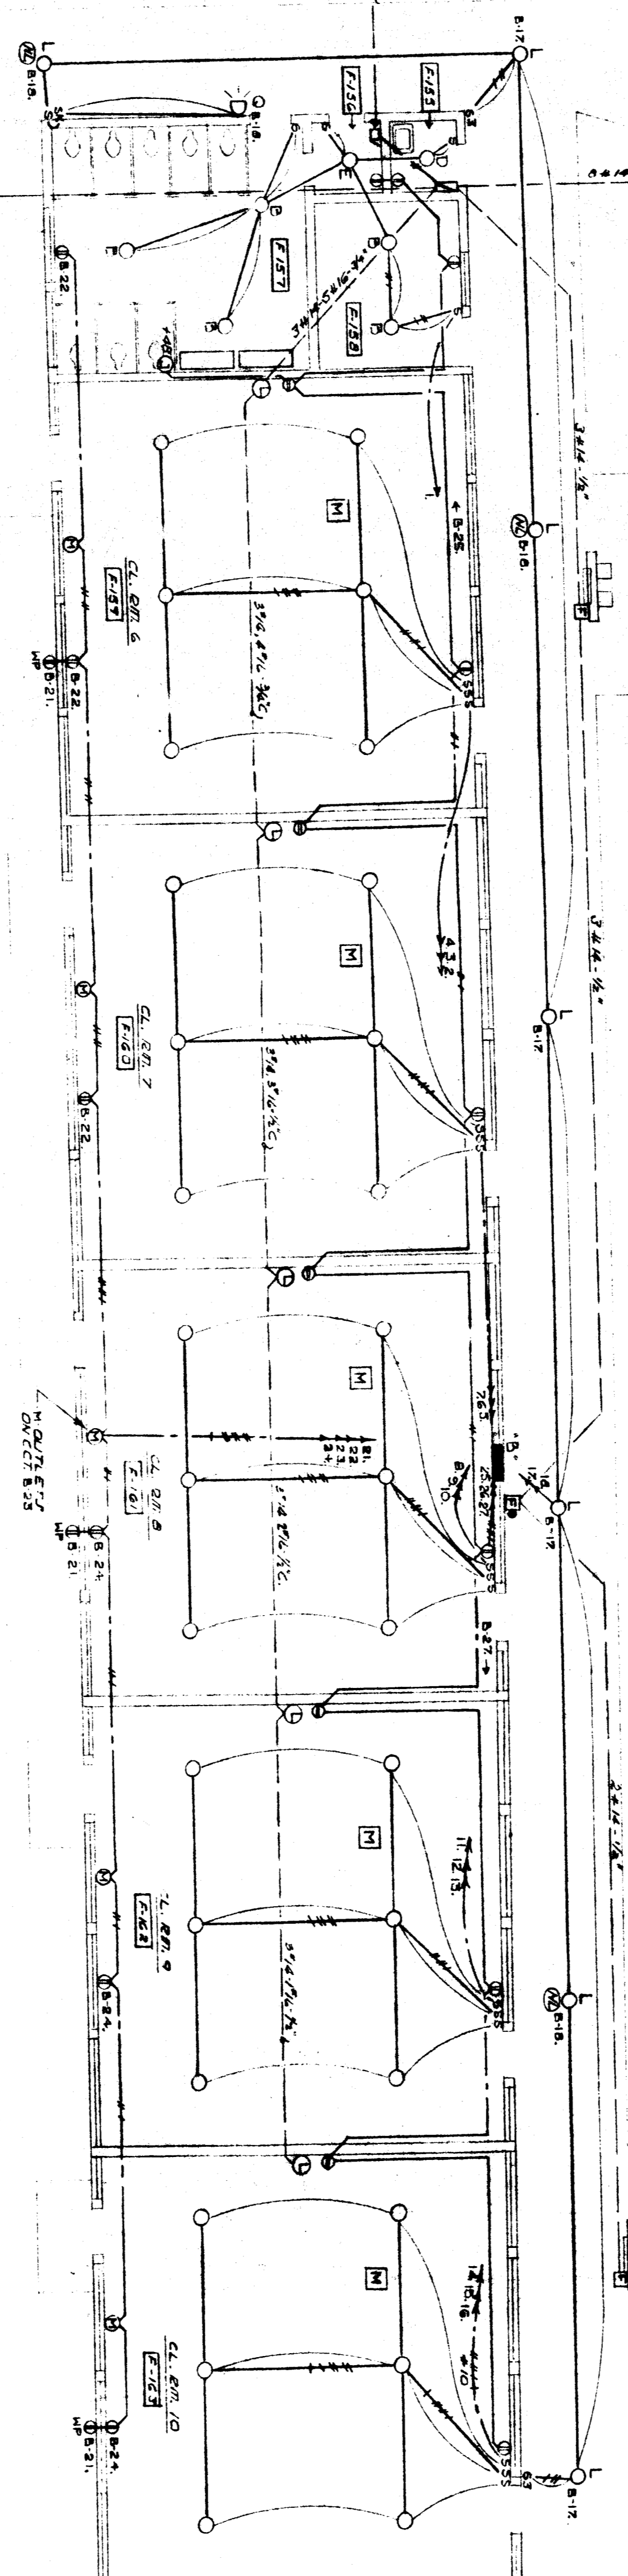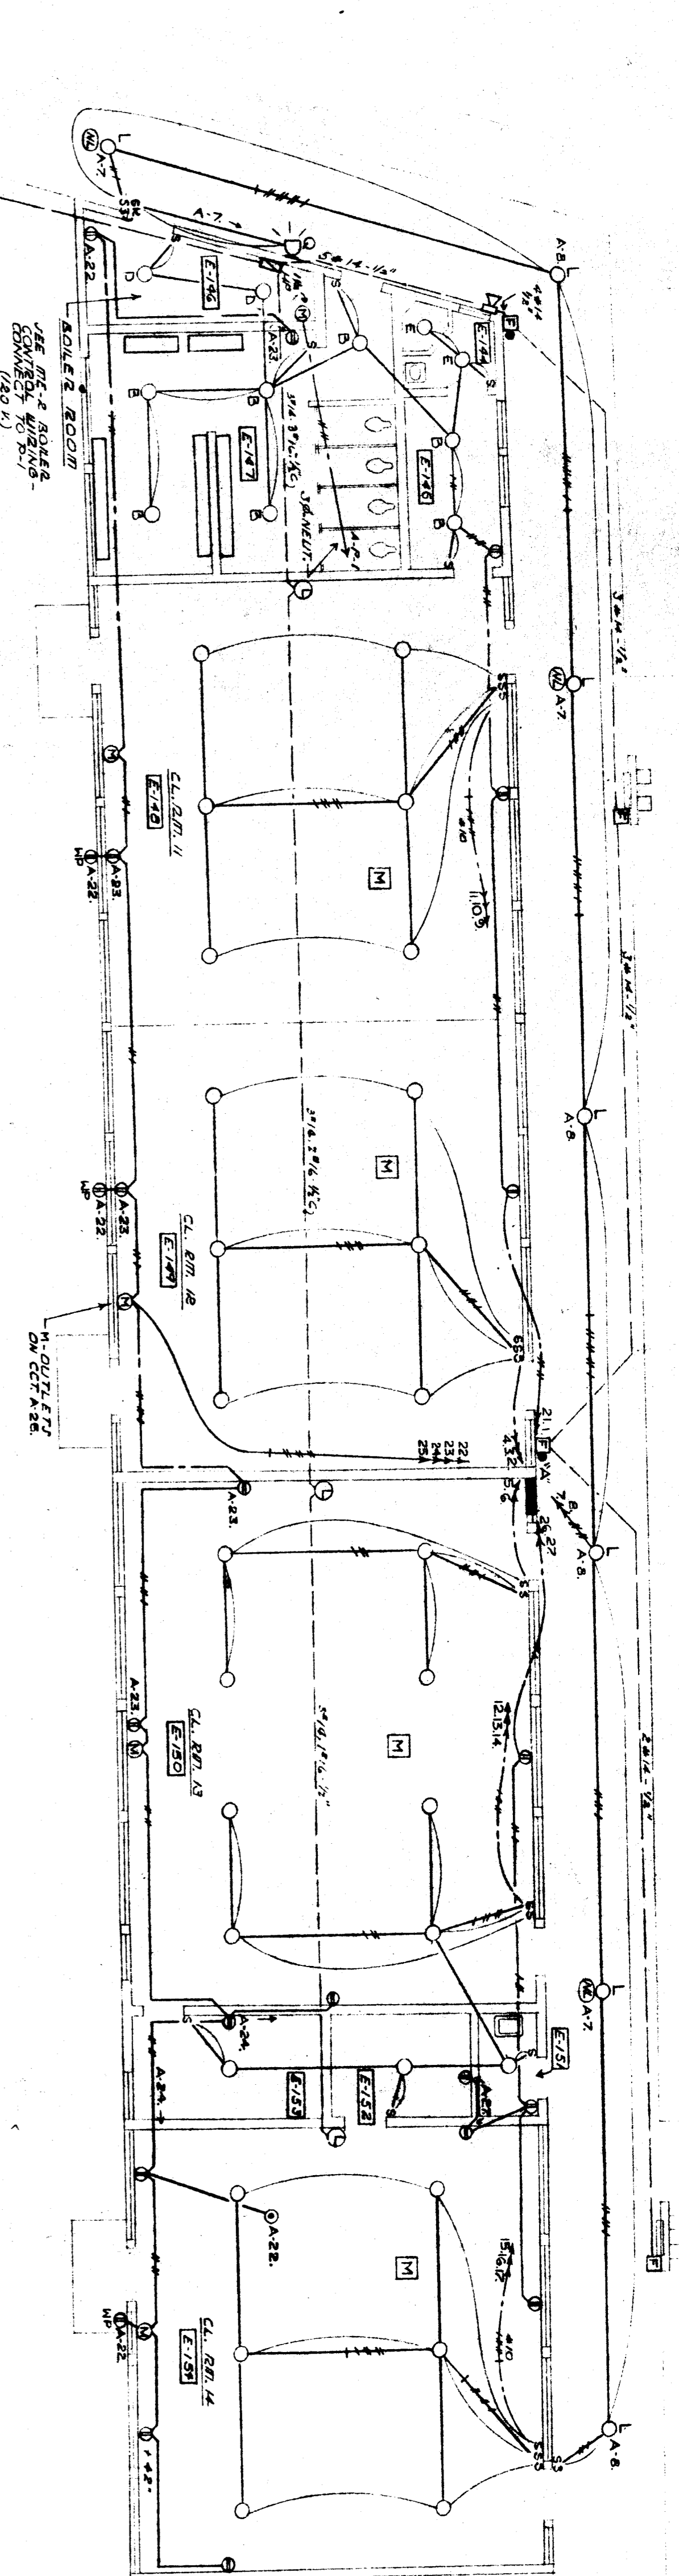

**W. A. STAINS**  
CONSULTING ENGINEER  
1603 CALIFORNIA AVENUE  
BAKERSFIELD, CALIFORNIA

**KEEN CO. SUPERINTENDENT OF SCHOOLS**  
BAKERSFIELD CITY SCHOOL DIST. DIVISION OF EDUCATION  
BAKERSFIELD, CALIFORNIA

**ROBERT N. EDDY**  
ARCHITECT R.I.A.  
2901 H ST BAKERSFIELD CALIFORNIA PH 59044

**LINCOLN JUNIOR HIGH SCHOOL**  
BAKERSFIELD DISTRICT CRIPPLEMIRE

DATE 3-30-55  
JOB NO 117053  
CHECKED  
RECORDED  
C-275

REVISIONS

APPROVED 02/28/53  
APPROVED 02/28/53  
APPROVED 02/28/53

PH 59044