



VISTA EAST CONTINUATION HIGH SCHOOL
 30 YEAR MODERNIZATION PROJECT
 KERN HIGH SCHOOL DISTRICT
 815 EUREKA ST., BAKERSFIELD, CALIFORNIA, 93305

SITE PLAN

SCALE: 1" = 50'-0"

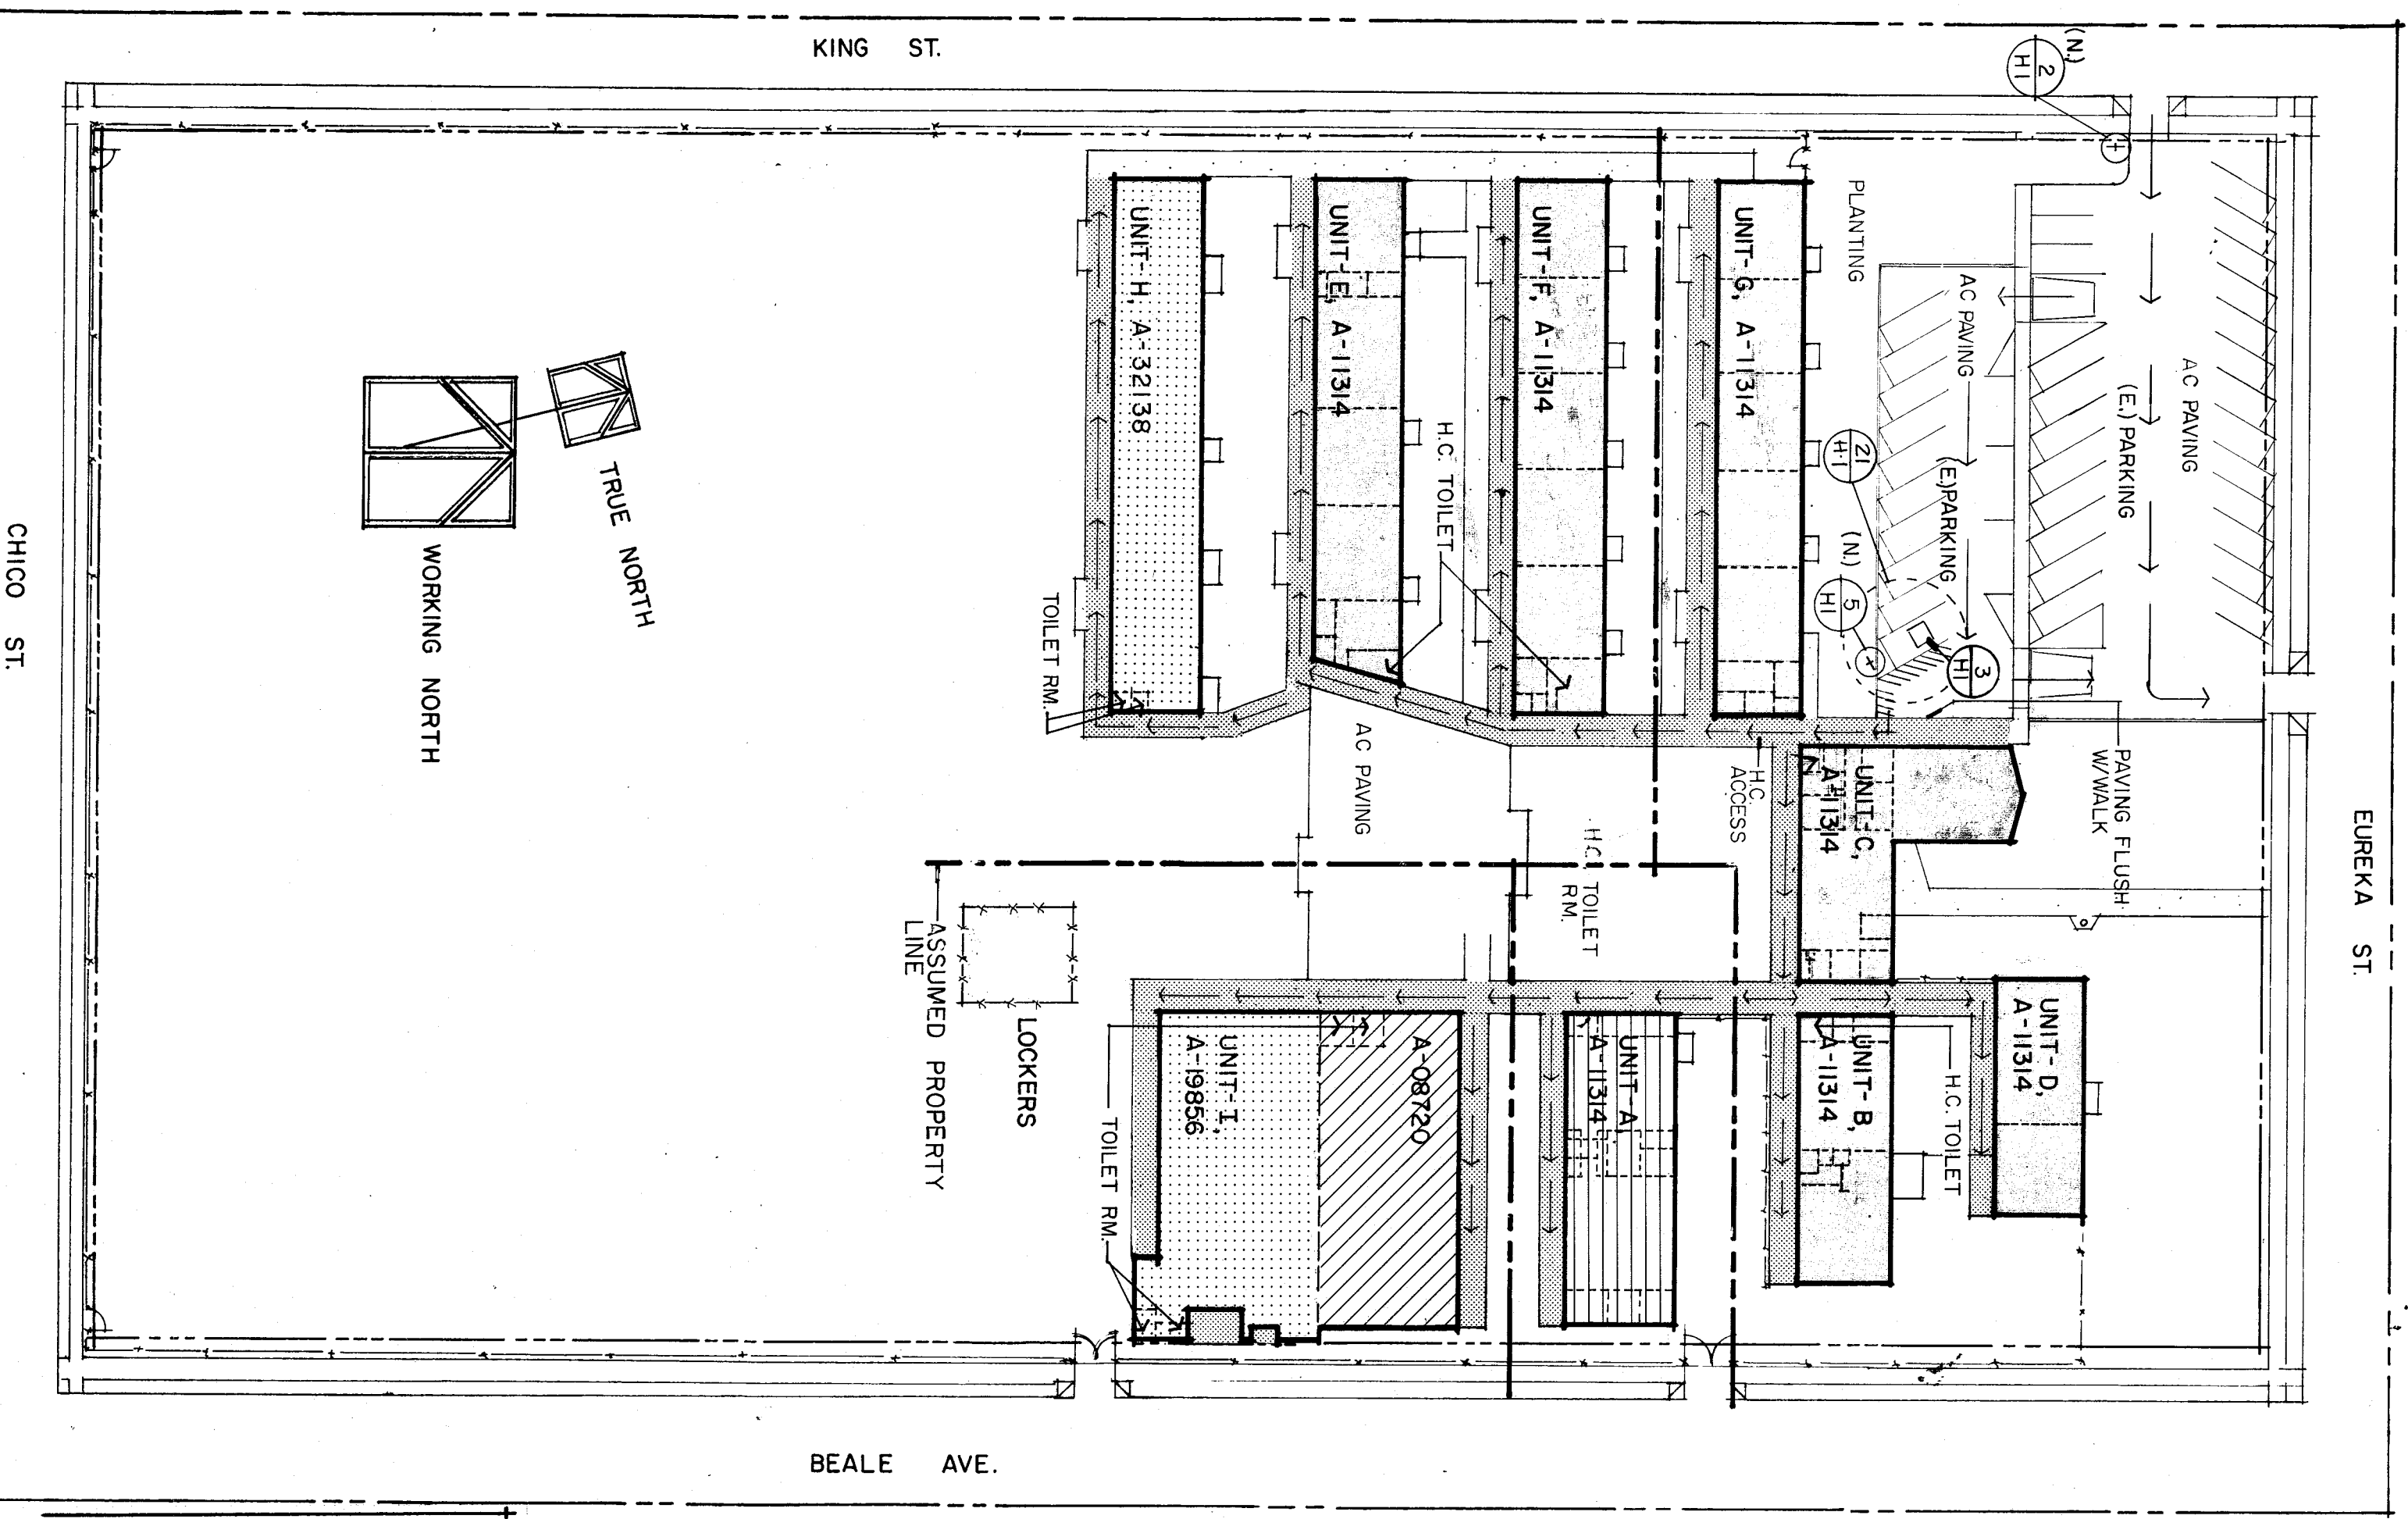

- UNITS OVER 30 YEARS
- UNITS UNDER 30 YEARS
- UNITS OVER 30 YEARS, N.I.C.
- UNITS OVER 30 YEARS, N.I.C. APPROVAL
- COVERED CORRIDORS
- N.I.C. PAINT ONLY
- UNITS OVER 30 YEARS- PAINT EXTERIOR ONLY

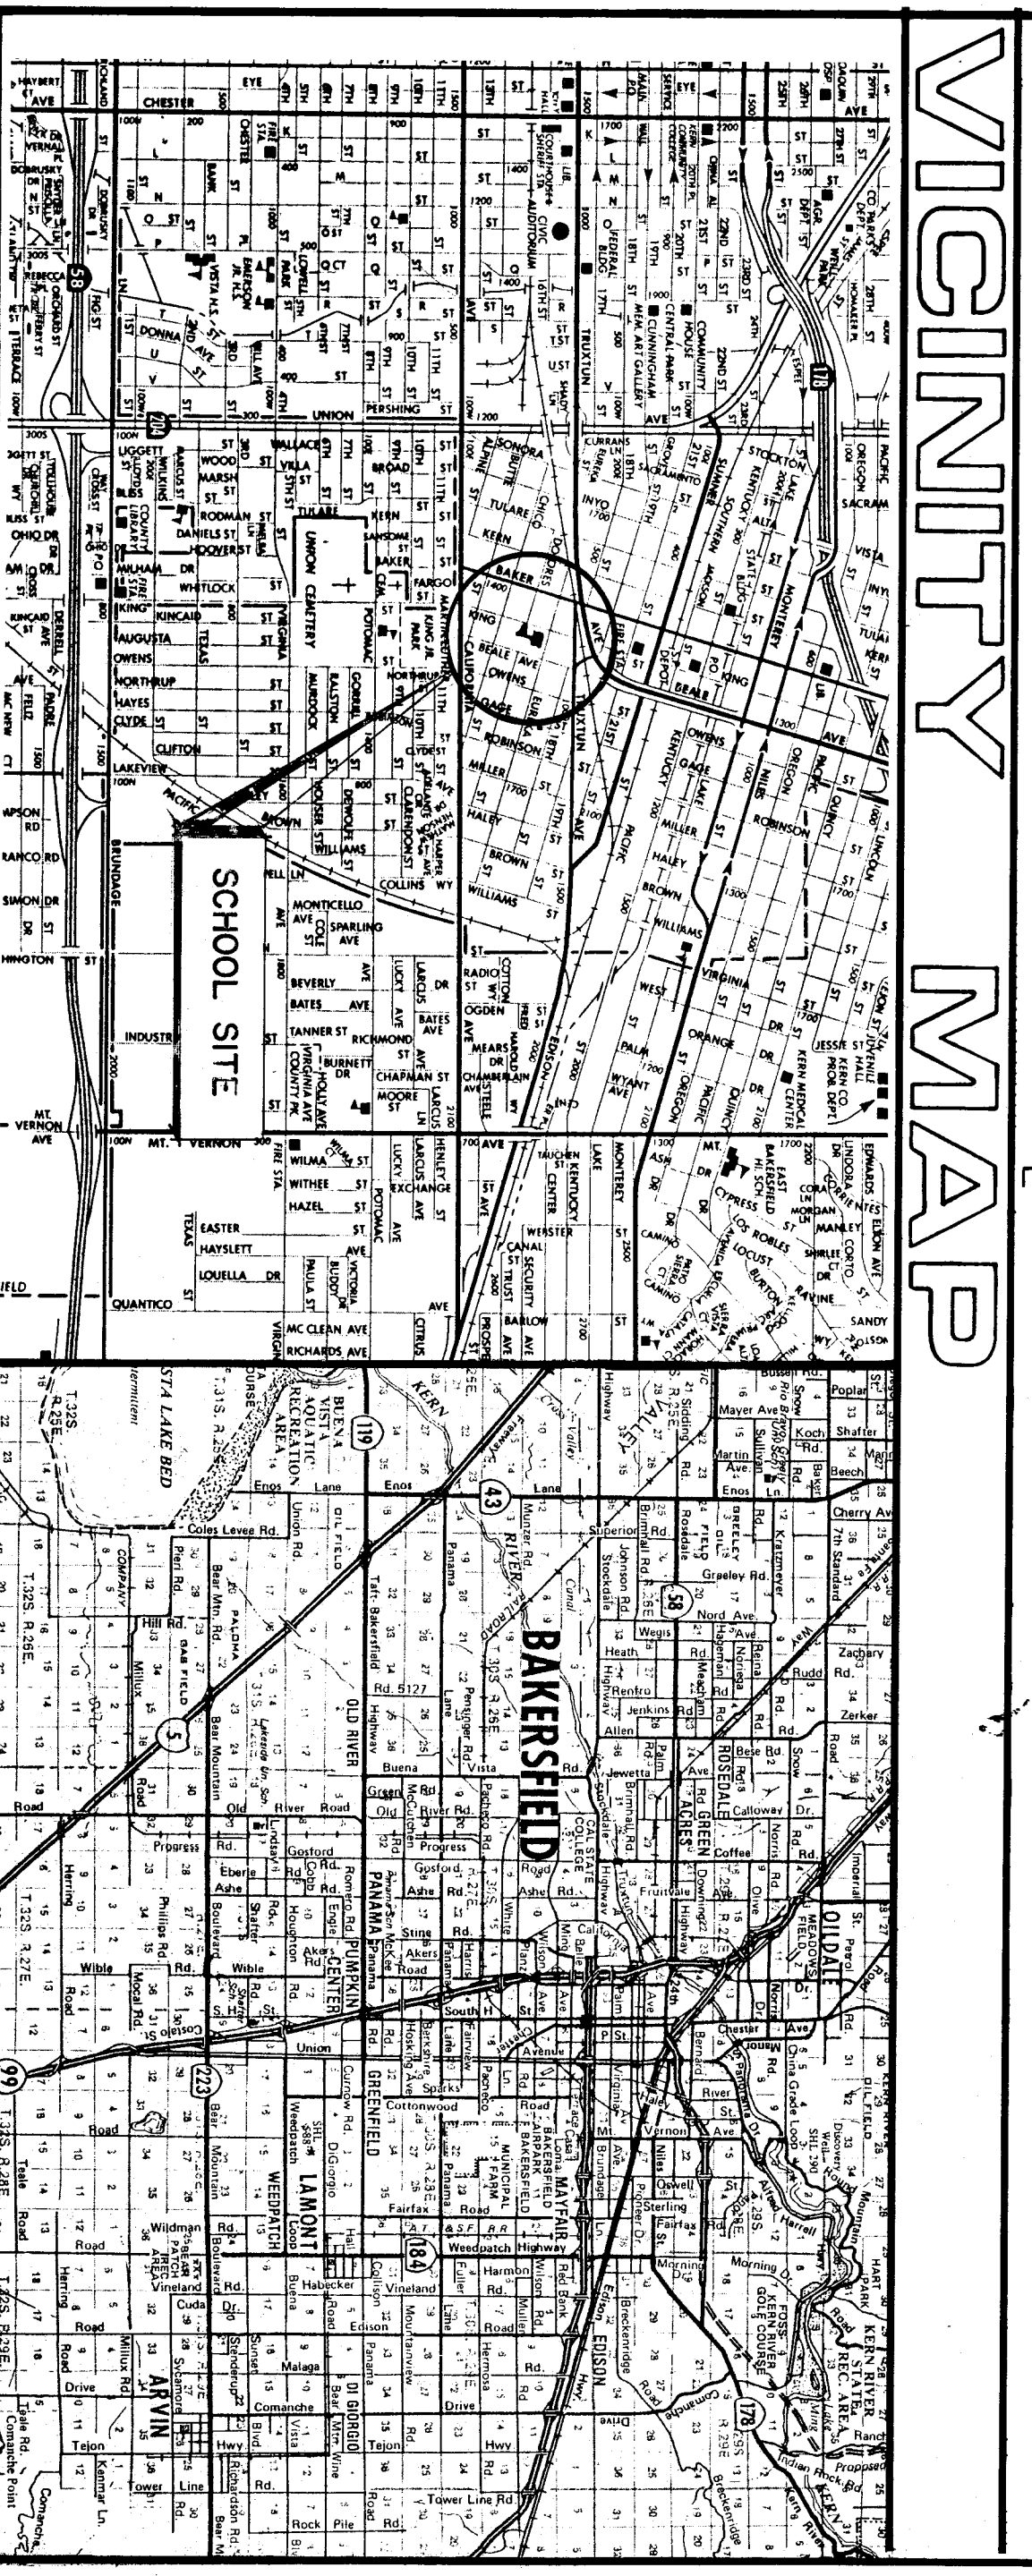

BUILDING DATA

BUILDING	TYPE	OCCUPANCY	ACTUAL SQ. FT.	ALLOWABLE SQ. FT.	SEPARATION
Unit - A	V-3	E-1	3,427.8	9,100	3 - Sides
Unit - B	V-3	E-1	2,423.7	9,100	3 - Sides
Unit - C	V-3	E-1	3,428.7	9,100	3 - Sides
Unit - D	V-3	E-1	14,768.9	18,200	3 - Sides
Unit - E	V-3	E-1	4,939.8	9,100	3 - Sides
Unit - F	V-3	E-1	5,340.0	18,200	3 - Sides
Unit - G	V-3	E-1	15,629.5	12,000	3 - Sides
Unit - H	V-3	E-1	5,400.0	6,000	3 - Sides
Unit - I	V-1-HR	R-2	5,459.2	16,000	3 - Sides
				16,000	3 - Sides
				152	3 - Sides
				302	3 - Sides

LEGEND SYMBOLS

- COORDINATE LINES
- DOOR SYMBOL
- WINDOW SYMBOL
- LOUVER SYMBOL
- EQUIPMENT TYPE
- REVISION NUMBER
- WATCH LINE
- WORK POINT, CONTROL POINT, DATUM POINT
- NORTH ARROW
- KEY NOTES SYMBOLS
- FLOOR PLAN
- ROOF PLAN
- EXTERIOR ELEVATIONS
- SECTION NUMBER/LETTER
- DETAIL NUMBER
- INTERIOR ELEVATION
- ROOM NUMBER
- INTERIOR ELEVATION SHIT
- NEW FINISH GRADE (DRAIN AT 4%)
- EXISTING GRADE
- NEW OR FINISH CONTOURS
- EXISTING CONTOURS
- N.I.C.
- BY OTHERS
- COLUMN SIZE AS NOTED
- METAL AS NOTED
- BATT TYPE INSUL.

ABBREVIATIONS

Symbol	Abbreviation	Meaning
1	1	And
2	2	At
3	3	Centerline
4	4	Foundation
5	5	Found or
6	6	Found or
7	7	Found or
100	100	Found or

INDEX ARCHITECTURAL

A.1	TITLE SHEET, SITE PLAN, VICINITY MAP, BUILDING DATA, LEGEND, INDEX
A.2	FLOOR PLANS - UNITS A & B, NOTES
A.3	FLOOR PLANS - UNITS C & D, NOTES
A.4	FLOOR PLANS - UNIT E, NOTES
A.5	FLOOR PLANS - UNITS F & G, NOTES
A.6	REFLECTED CEILING PLANS - UNITS A & B, NOTES
A.7	REFLECTED CEILING PLANS - UNITS C & D, NOTES
A.8	REFLECTED CEILING PLANS - UNITS E, F & G, NOTES
A.9	REFLECTED CEILING PLANS - UNITS F & G, NOTES
A.10	INTERIOR ELEVATIONS - UNITS B & C, NOTES
A.11	INTERIOR ELEVATIONS - UNIT C, NOTES
A.12	INTERIOR ELEVATIONS - UNITS C & D, NOTES
A.13	INTERIOR ELEVATIONS - UNITS D & E, NOTES
A.14	INTERIOR ELEVATIONS - UNITS E, F & G, NOTES
A.15	EXTERIOR ELEVATIONS - UNITS A, B, C & D, NOTES
A.16	EXTERIOR ELEVATIONS - UNITS E, F, G, NOTES
A.17	SECTIONS - UNIT C, TYPICAL CLASSROOM
A.18	FINISH SCHEDULE, DOOR SCHEDULE
A.19	DOOR TYPES, DETAILS, CABINET SCHEDULE
H.1	HANDICAP - DETAILS

MECHANICAL

M.1	UNIT A & B PLUMBING & MECHANICAL PLANS, NOTES
M.2	UNIT C & D PLUMBING & MECHANICAL PLANS, NOTES
M.3	UNIT E PLUMBING & MECHANICAL PLANS, NOTES
M.4	UNIT F & G PLUMBING & MECHANICAL PLANS, NOTES

ELECTRICAL

E.1	SITE ELECTRICAL PLAN, SYMBOLS, SCHEDULES
E.2	UNIT A & B UNIT B LIGHTING PLAN
E.3	UNIT A & B UNIT B POWER & SIGNAL PLAN
E.4	UNIT C & D UNIT D LIGHTING PLAN
E.5	UNIT C & D UNIT D POWER & SIGNAL PLAN
E.6	UNIT E LIGHTING PLAN
E.7	UNIT E POWER & SIGNAL PLAN
E.8	UNIT F & G UNIT G LIGHTING PLAN
E.9	UNIT F & G UNIT G POWER & SIGNAL PLAN

NOTE: FOOD HANDLING FACILITIES SHALL CONFORM WITH ALL LOCAL HEALTH REQUIREMENTS AND CALIFORNIA UNIFORM REMAIN FACILITIES LAW.

CHECK AND VERIFY ALL DIMENSIONS BEFORE PROCEEDING WITH THE WORK. REPORT ALL DISCREPANCIES TO ARCHITECT IMMEDIATELY UPON CONSTRUCTION. SHALL CONFORM TO UBC.

DATE: 07/19/90

JOB NO. 707

DRWN: M.B.

CHECKED: M.B.

DATE: 07/19/90

ROBERT F. STUHR ARCHITECT INC.

3121 CALIFORNIA AVE. BAKERSFIELD, CA 93304 (805) 327-1632

ROBERT F. STUHR AIA C-1810
 WILLIAM J. MELBY AIA C-18835
 DANNY E. ORDIZ AIA C-14728

TITLE: 24 & 1422 L.B.C.

UTL/LA

TITLE SHEET, SITE PLAN, VICINITY MAP, LEGEND, & INDEX

VISTA EAST CONTINUATION HIGH SCHOOL 30 YEAR MODERNIZATION

815 EUREKA STREET
 KERN HIGH SCHOOL DISTRICT
 KERN COUNTY, CALIFORNIA

3318 15 90