

ROOF PLAN
1/8" = 1'-0"

STATE OF CALIFORNIA
DEPARTMENT OF PUBLIC WORKS
DIVISION OF ARCHITECTURE

SAN FRANCISCO CITY SCHOOL DISTRICT
BOARD OF EDUCATION
APPROVED


Wright Metcalf & Parsons
Architects
111 MASON BUILDING
SAN FRANCISCO, CALIFORNIA

DATE 7-7-49
DRAWN BY W.M.P.
CHECKED BY W.M.P.
SECRETARY


7-7-49
10

NOTE: SEE SHEETS 5-3 & 5-4 FOR FRAMING

ACCESS OPENING
1/2" x 1'-0"
(UNDER PLATFORM)

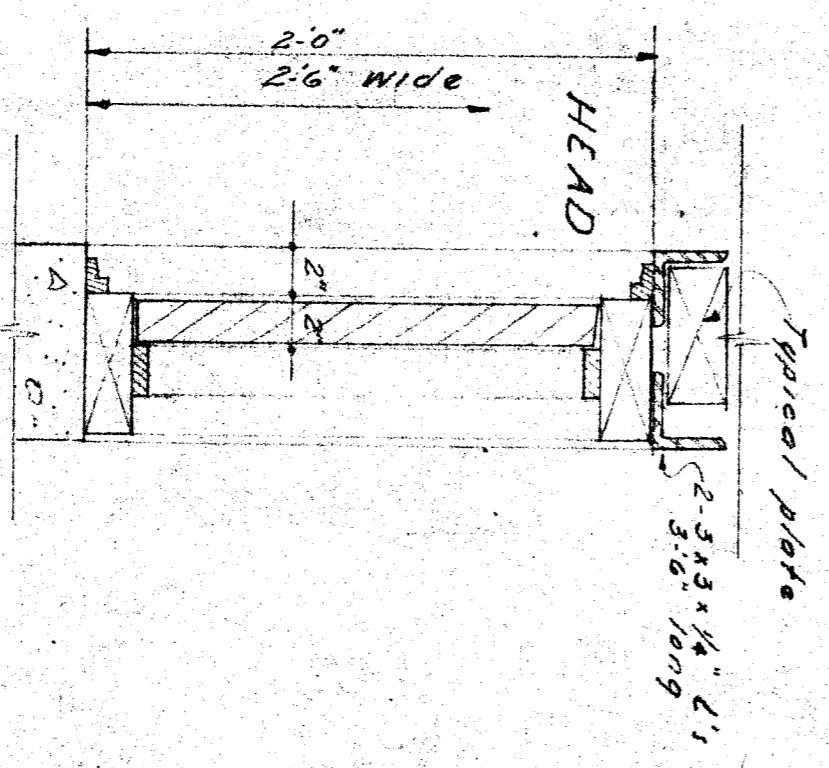

3" SECTION TYPICAL
UNDERFLOOR VENTS

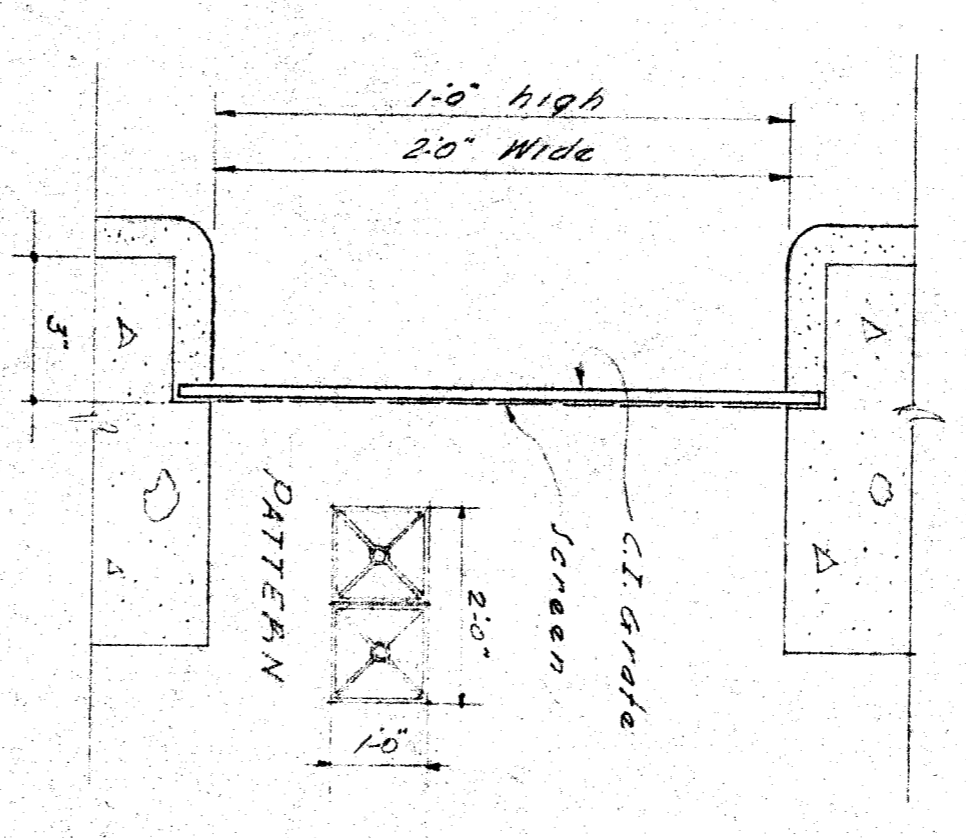

TYPICAL VERTICAL FLASHING
5'-11-0"

