

NORTH WALL  
INTERIOR ELEVATIONS GIRLS TOILET B-10









EAST WALL  
SOUTH WALL

WEST WALL  
NORTH WALL

INTERIOR ELEVATIONS BOYS TOILET B-9

EAST WALL  
SOUTH WALL

WEST WALL  
NORTH WALL

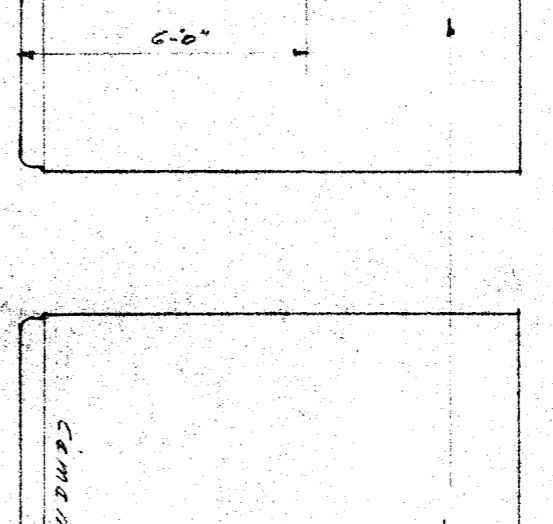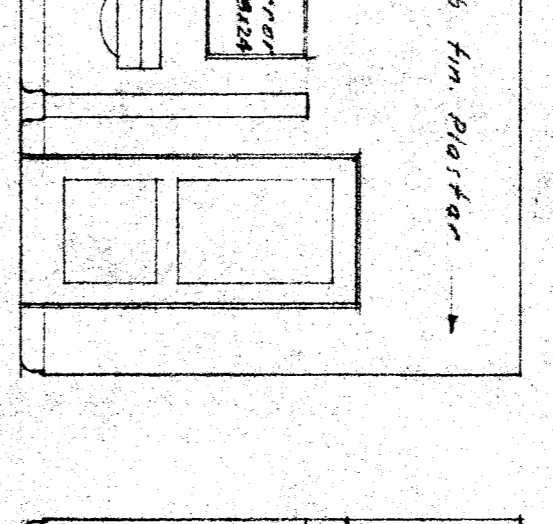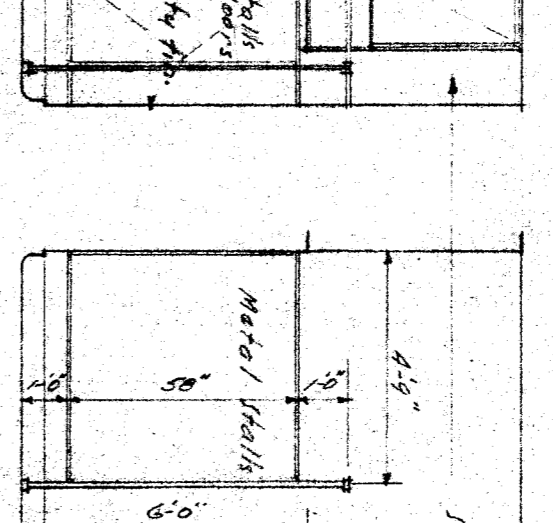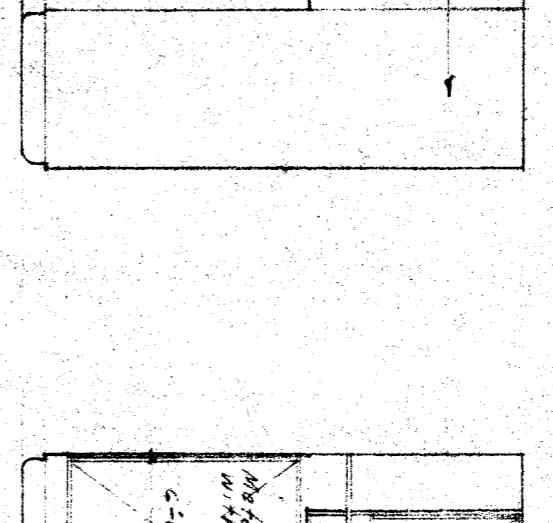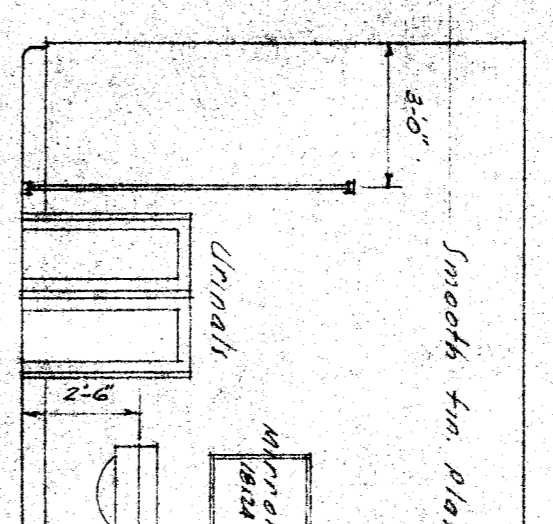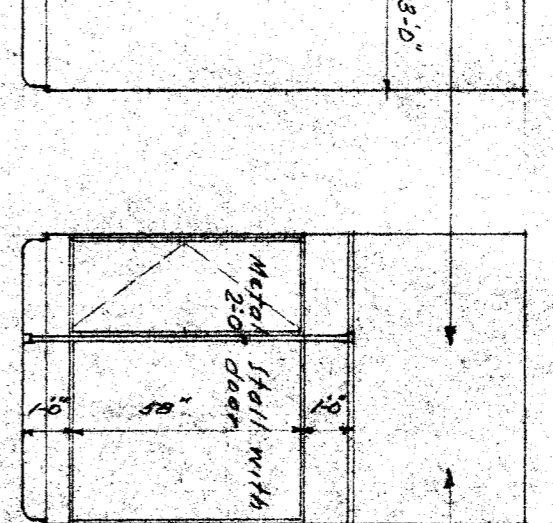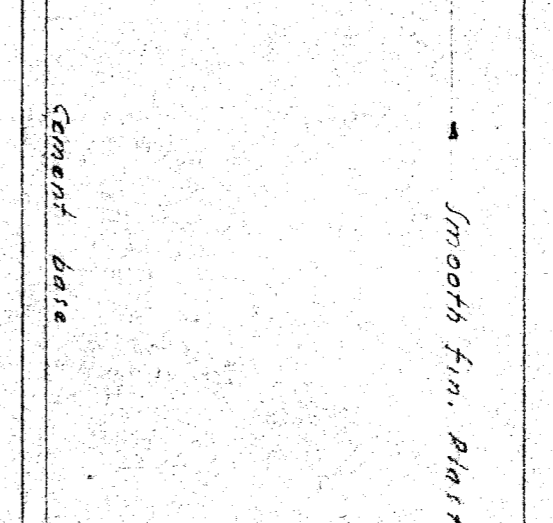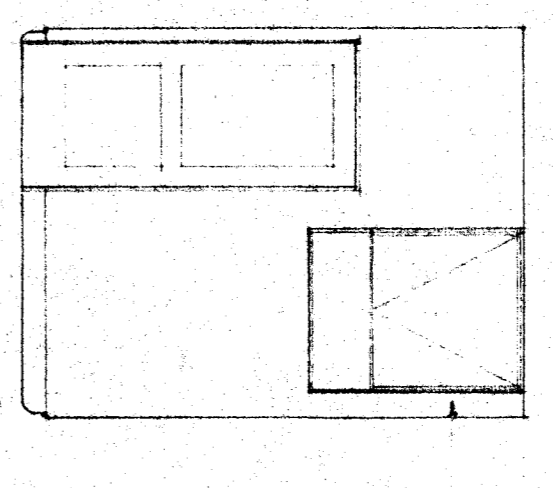

NORTH WALL  
INTERIOR ELEVATIONS MENS TOILET A-12









EAST WALL  
SOUTH WALL

WEST WALL  
NORTH WALL

INTERIOR ELEVATIONS WOMENS TOILET A-11

EAST WALL  
SOUTH WALL

WEST WALL  
NORTH WALL

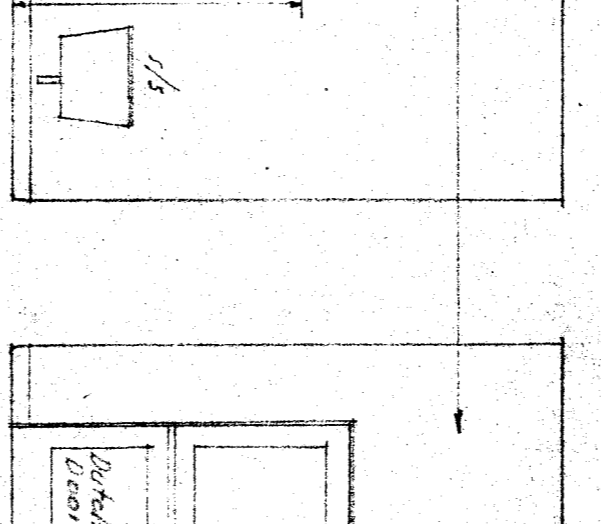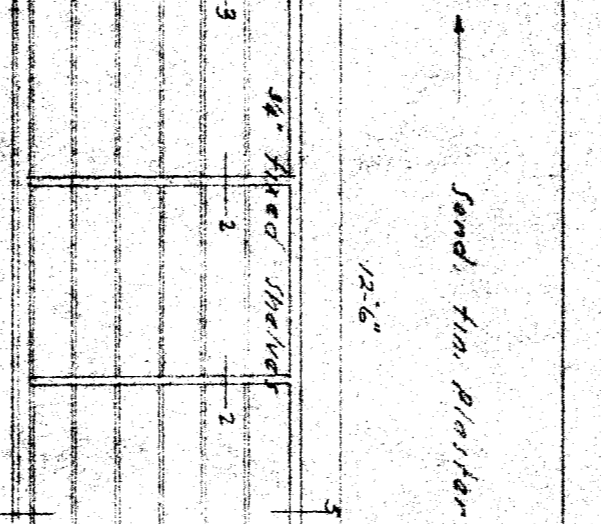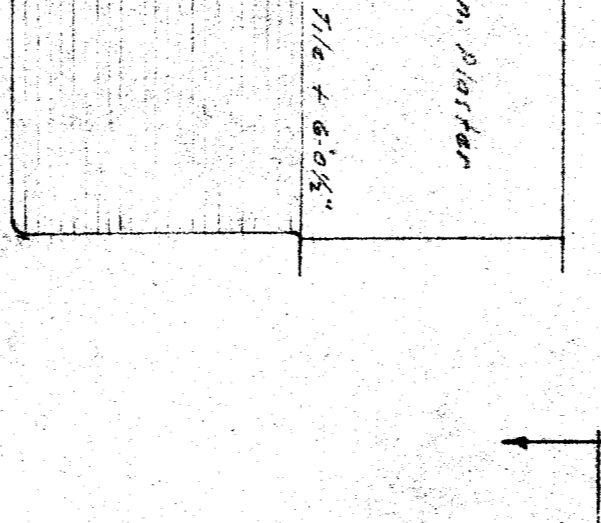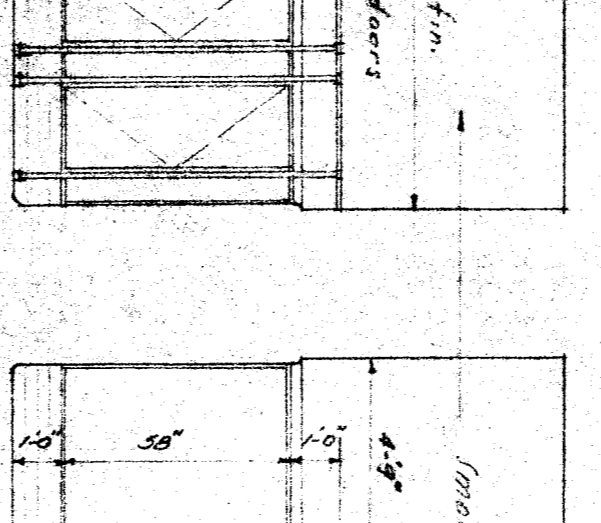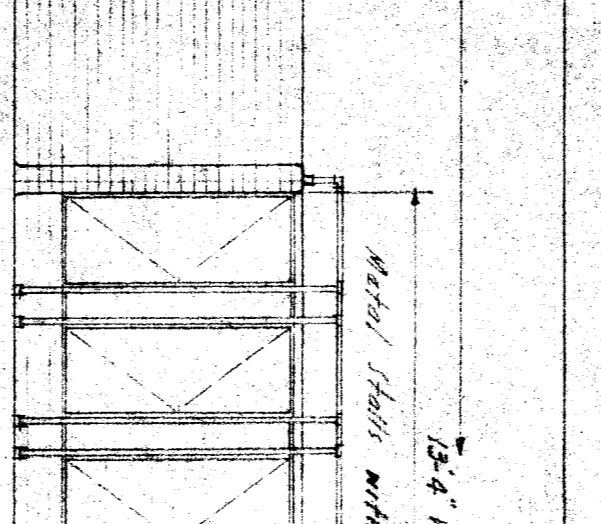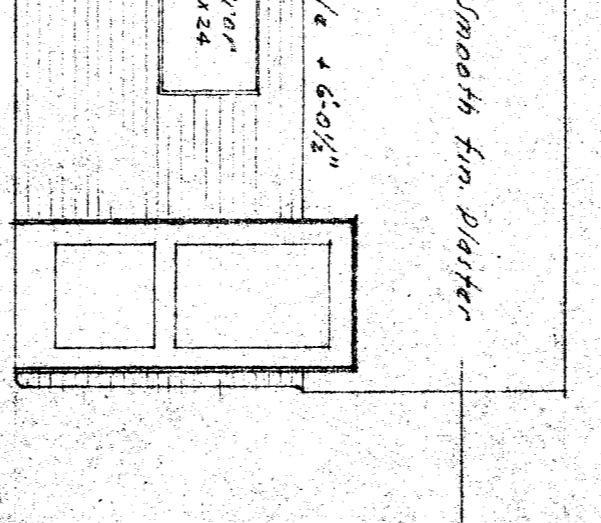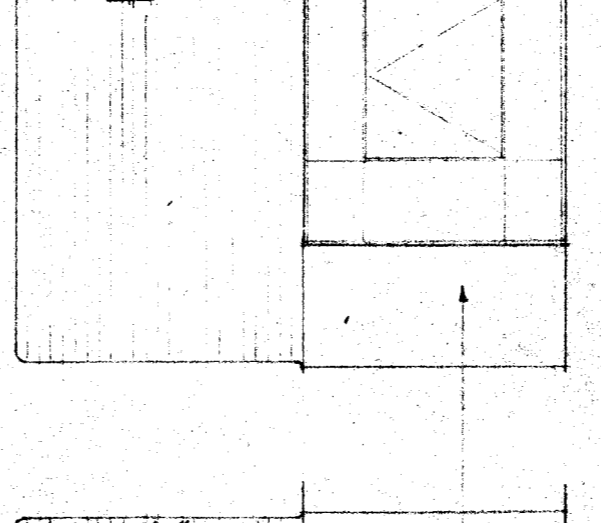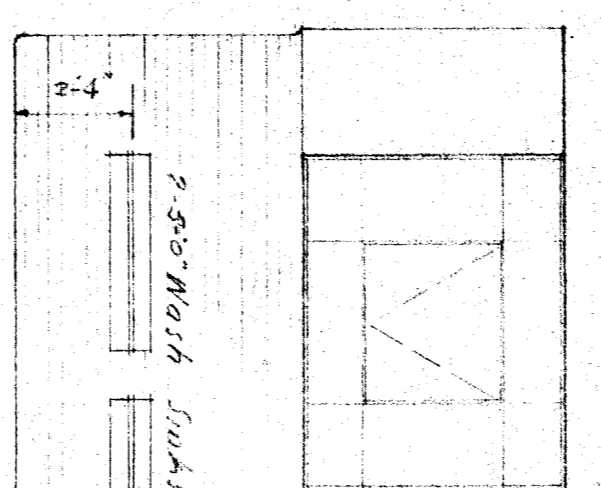

NORTH WALL  
INTERIOR ELEVATIONS GIRLS TOILETS F-5, G-5 & H-5









EAST WALL  
SOUTH WALL

WEST WALL  
NORTH WALL

INTERIOR ELEVATIONS JANITORS ATHLETIC SUPPLY ROOM H-7

EAST WALL  
SOUTH WALL

WEST WALL  
NORTH WALL

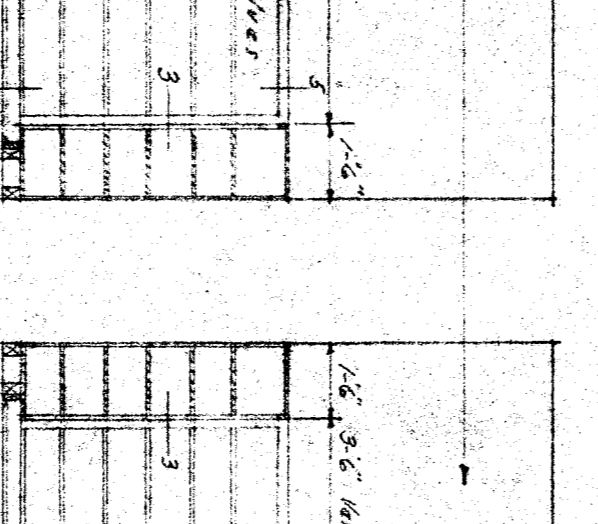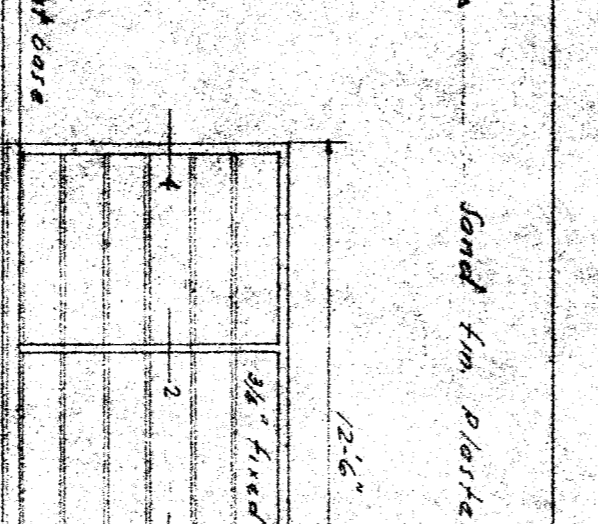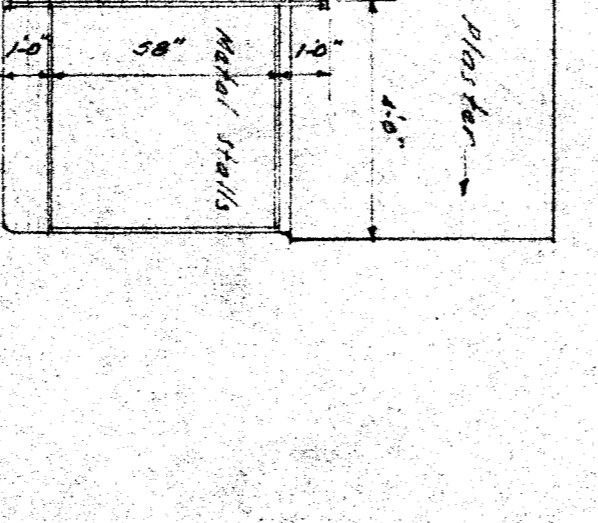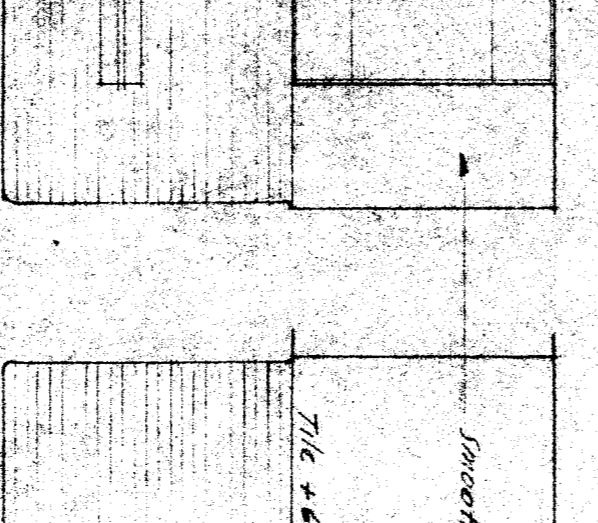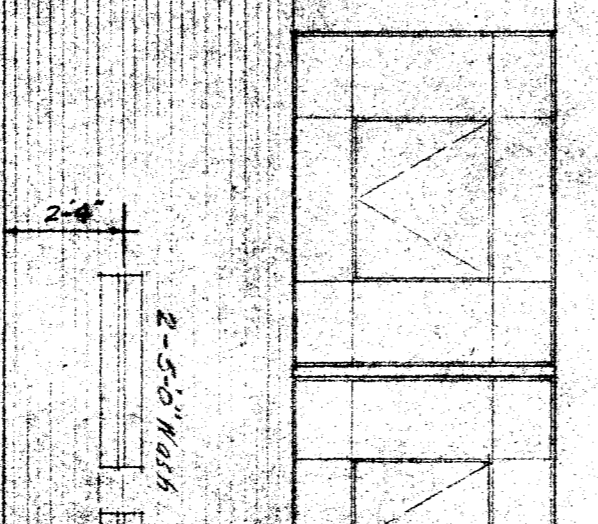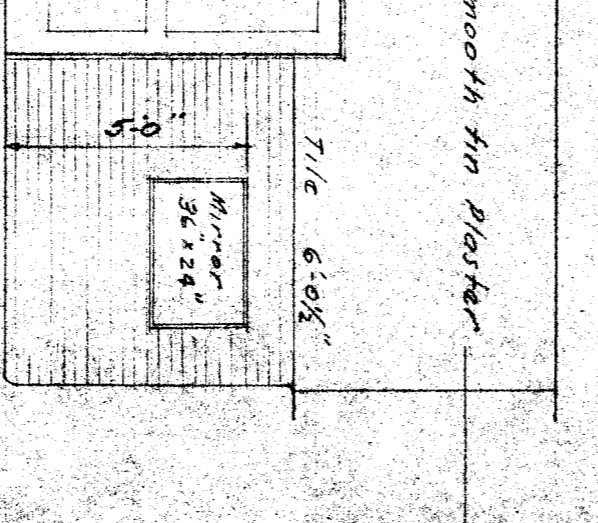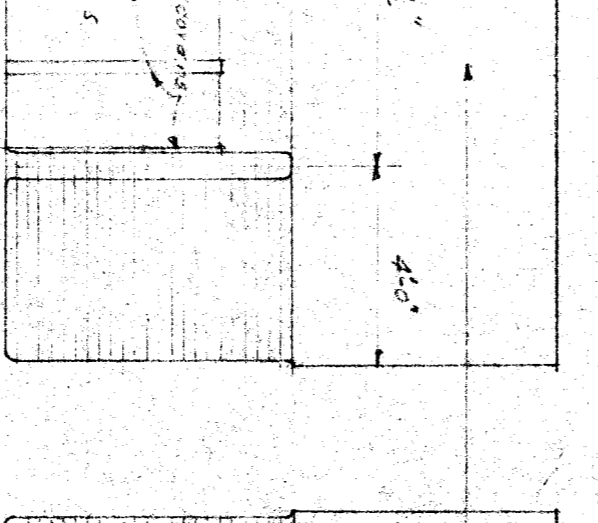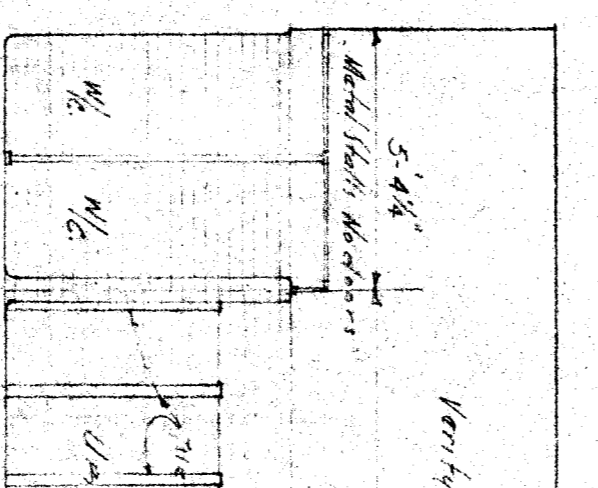

NORTH WALL  
INTERIOR ELEVATIONS BOYS TOILETS F-6, G-6 & H-6


EAST WALL  
SOUTH WALL

WEST WALL  
NORTH WALL

INTERIOR ELEVATIONS JANITORS ATHLETIC SUPPLY ROOM H-7

EAST WALL  
SOUTH WALL

WEST WALL  
NORTH WALL

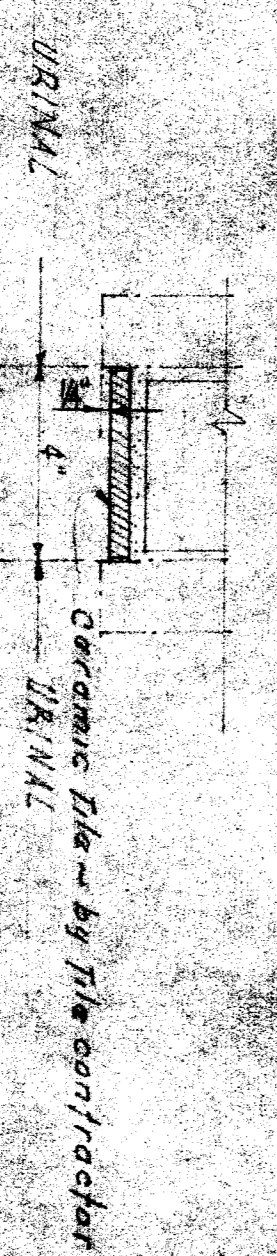

TILE SEAM COVER  
No Scale

STATE OF CALIFORNIA  
DEPARTMENT OF PUBLIC WORKS  
DIVISION OF ARCHITECTURE

BAKERSFIELD CITY SCHOOL DISTRICT  
BOARD OF EDUCATION  
4504 99th  
BAKERSFIELD

INTERIOR ELEVATIONS TOILET & M.I.L.  
POTOMAC AND QUIN KING STREET 10-202  
BAKERSFIELD CITY SCHOOL DISTRICT  
111 KIRKMAN BUILDING  
RENSSELAER CALIFORNIA

Secretary  
2-7-49

WRIGHT METCALF & PARSONS  
133  
SHEET  
23