


3" DETAIL SECTIONS DOOR HEADS

NOTE: Dotted lines indicate finish of Jamb only  
 All Jamb & Head set 2" finish to rough  
 All casing set back 1/2" from Jamb & head edges.  
 1/2" min. width of stop.  
 NOTE: Nail finish frames to rough framing with 10d casing nails spaced 16" o.c.

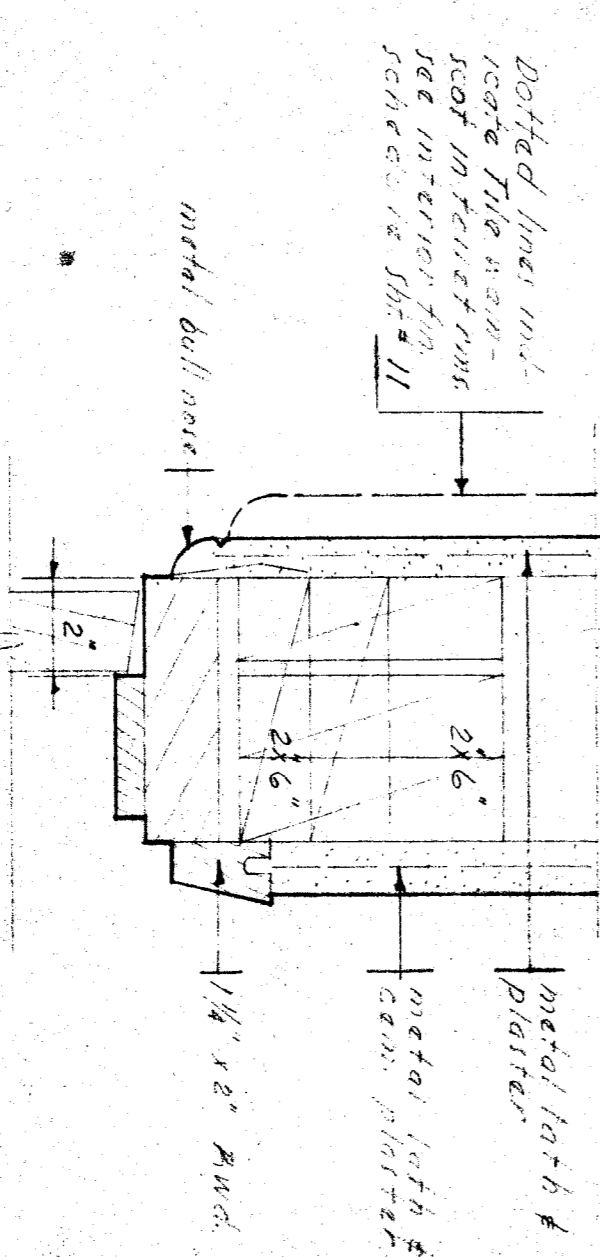

HEAD  
 JAMB AS NOTED  
 TYPE - X"

STATE OF CALIFORNIA DEPARTMENT OF PUBLIC WORKS DIVISION OF ARCHITECTURE		2440 RIVER STREET SACRAMENTO, CALIFORNIA	
PROJECT: DOOR JAMB & HEAD DETAILS LOCATION: POTOMAC AND SOUTH KING STREET, CHOC.		DATE: 7-1-48	BY: WRIGHT METCALF & PARSONS
DRAWN BY: [Signature]		DATE: 7-1-48	BY: WRIGHT METCALF & PARSONS
CHECKED BY: [Signature]		DATE: 7-1-48	BY: WRIGHT METCALF & PARSONS
APPROVED BY: [Signature]		DATE: 7-1-48	BY: WRIGHT METCALF & PARSONS
SECRETARY: [Signature]		DATE: 7-1-48	BY: WRIGHT METCALF & PARSONS
111 BOND STREET, SACRAMENTO, CALIF.		DATE: 7-1-48	BY: WRIGHT METCALF & PARSONS