
4 RELOCATABLE CLASSROOMS MOUNT VERNON ELEMENTARY SCHOOL BAKERSFIELD CITY SCHOOL DISTRICT 2161 POTOMAC AVE. BAKERSFIELD, CA 93307

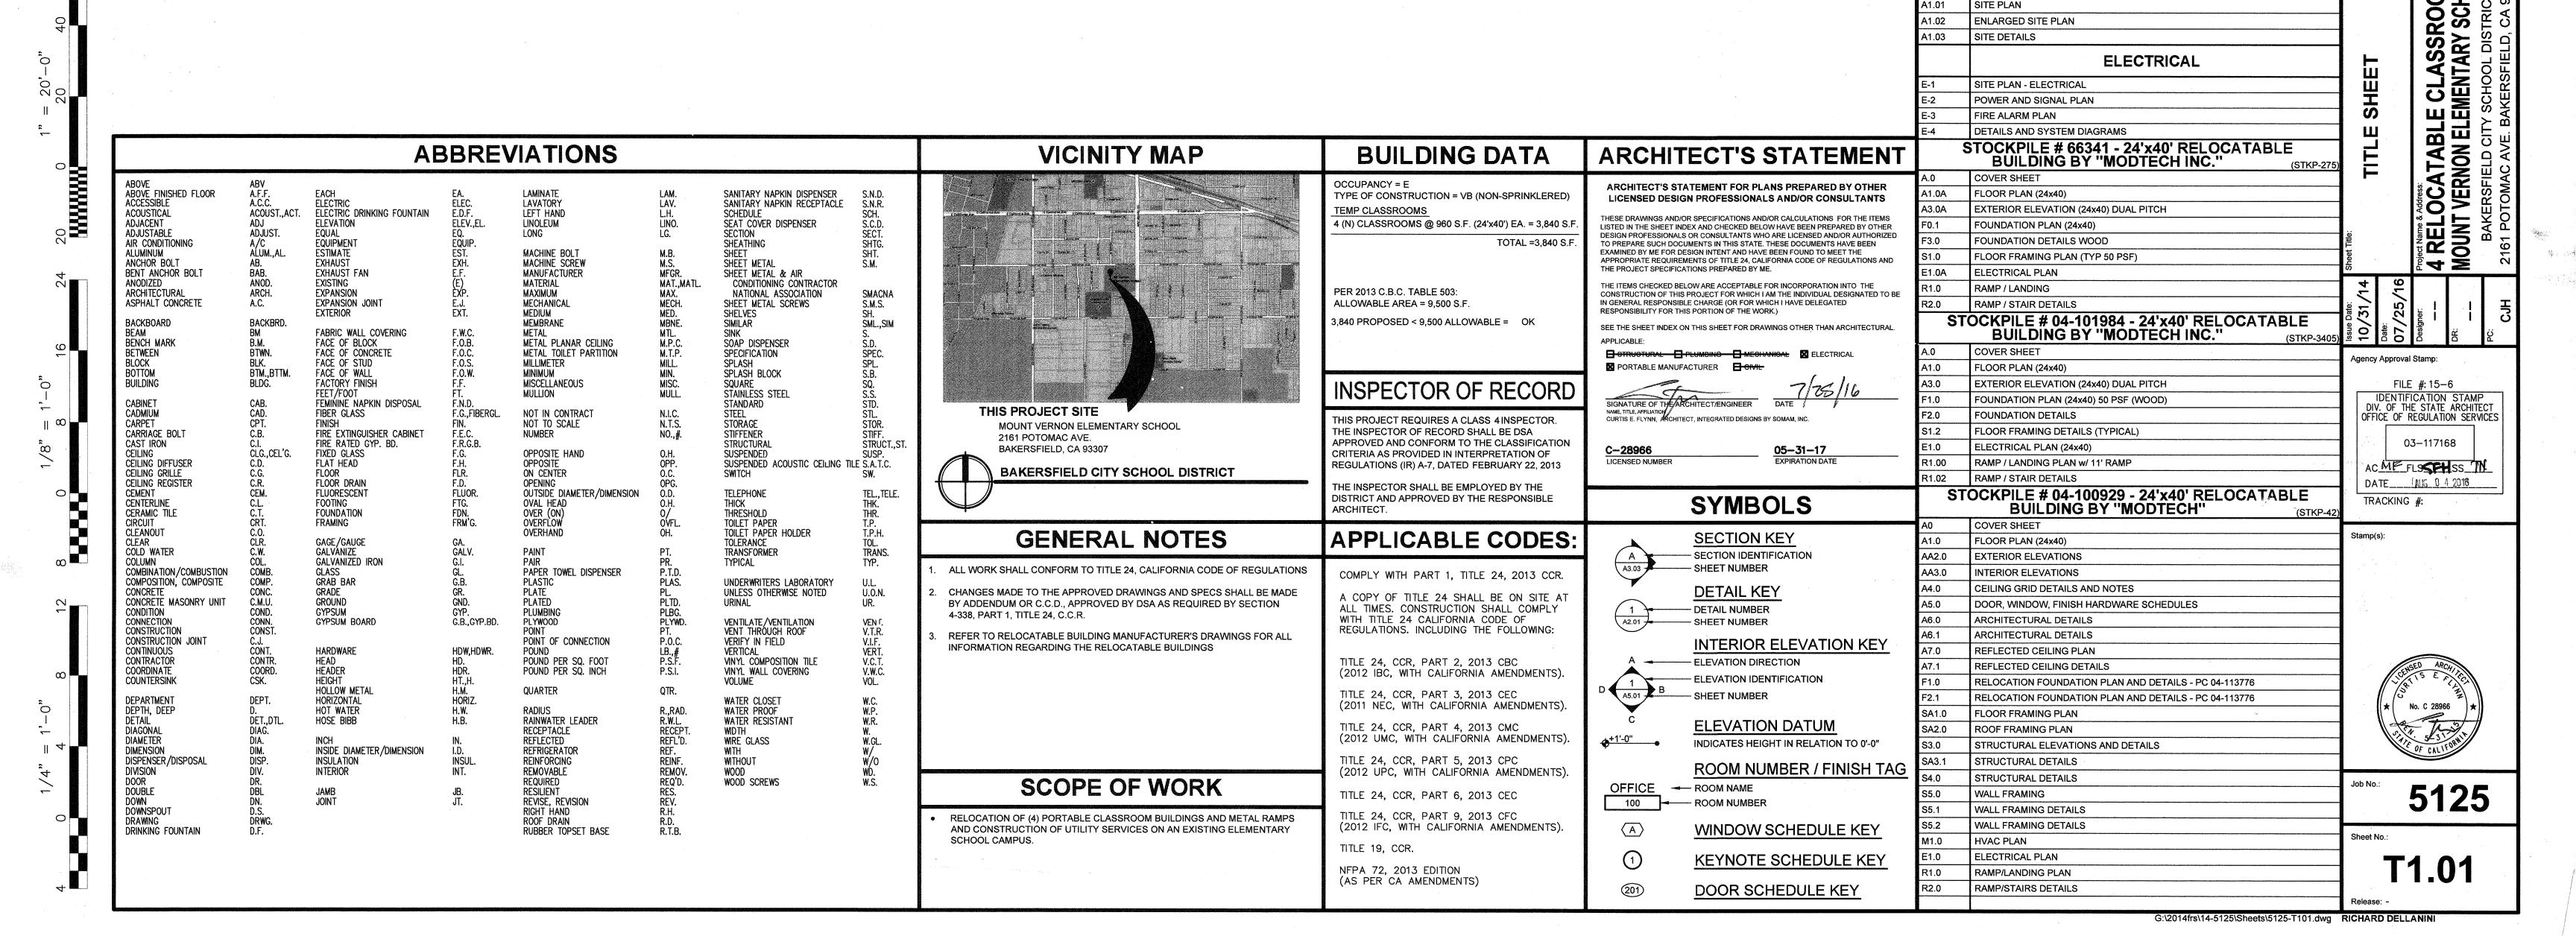

SHEET INDEX

TITLE SHEET

GENERAL

ARCHITECTURAL