

'A' SHOWN
'B' OPPOSITE
FLOOR PLAN

INTERIOR REFERENCE
SHEET A4.0

SCALE 1/4"=1'-0"

LEGEND


- 1 EXTERIOR DOOR SEE DOOR SCHEDULE
- A WINDOW (SEE SCHED. A5.0)

KEY NOTES

- 1 ROOF OVERHANG
- 2 HVAC UNIT - SEE M-1.0
- 3 2- 8'X4' MARKER BOARDS (SEE SPEC'S FOR TYPE)
- 4 FINISH FLOORING (SEE FINISH SCHED.)
- 5 TYPICAL INTERIOR FINISH (SEE FINISH SCHED.)
- 6 FIRE EXTINGUISHER - 5 LBS. DRY CHEMICAL WITH 2A-10BC UL RATING ON HALL MTD. RE. HANDLE AT 40"
- 7 MODLINE (2X TYPICAL)
- 8 ELECTRICAL PANEL (SEE E1.0)
- 9 RAMP (SEE R1.0 & R2.0)
- 10 RAMP LANDING (SEE DET. 11 on Sht. R2.0)
- 11 ACCESSIBLE SINK CABINET. SEE A4.0 SINK. CRA-1725-A-GR 5" DEEP FAUCET: CHICAGO 350. BUBBLER: USB 10
- 12 COLD WATER POC.
- 13 WASTE POC.
- A METAL TAG ON ALL MODULES. MECHANICALLY ATTACHED TO REAR EXTERIOR OF BUILDING SHOWING DSA APPLICATION NUMBER, MANUFACTURER'S NAME AND SERIAL NUMBER AND ROOF & FLOOR DESIGN LIVE LOAD.

NOTE:
SINK CABINET OPTIONAL


REVISED

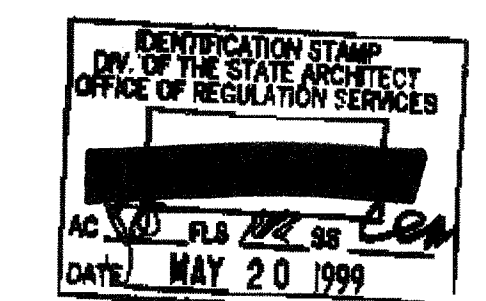

IDENTIFICATION STAMP
DIV. OF THE STATE ARCHITECT
OFFICE OF REGULATION SERVICES
APP#3 117168
Date AUG 04 2018

1/30/15 OBA HANDICAP ENVIRONMENT

ARCHITECT	ELECTRICAL	STRUCTURAL	MECHANICAL	FIRE MARSHAL	ACCESS COMPLIANCE	STRUCTURAL SAFETY

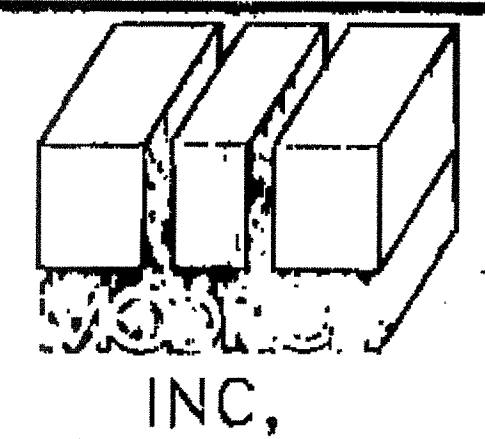

FLOOR PLAN

A1.0A