

CLASS LEASING, LLC.

1221 Harley Knox Blvd. Perris, CA 92571-7408
(951) 943-1908 Fax (951) 943-5768

SPECIFICATIONS RELOCATABLE CLASSROOMS

3.01 CARPENTRY:

- Scope of Work:** Contractor shall provide all labor, materials and services to install carpentry.
- Workmanship:**
 - FRAMING:** securely nailed, bridged and blocked to form rigid structure. Work cut, fitted and assembled level, plumb and true to line. Trim in as long lengths as possible with all standing trim in one piece. Trim sealed at all edges.
 - NAILING:** in accordance with the title 24 CCR-Table 2304.9.1. Nails shall be corrosion resistant box nails.
 - Machine applied nailing shall have prior demonstration and approval by DSA Field Inspector and the Architect. The approval is subject to continuous satisfactory performance. Plywood shall have a minimum thickness of 3/8". If nail heads penetrate the outer ply more than would be normal for a hand hammer or if minimum allowable edge distances are not maintained, the performance will be deemed unsatisfactory.
 - TRIM:** sealed at all edges. Sealant painted to match trim or siding.

4.01 MATERIAL SPECIFICATIONS:

- Structural framing shall be Hem Fir-Larch graded in accordance with the standard grading rules of the Western Wood Products Association or standard grading rules No. 16 of the West Coast Lumber Inspection Bureau, latest editions. Grades shall be as follows unless noted otherwise on the drawings. (Hem Fir South is not allowed.) Each piece shall be grade marked and no piece may fall below grade indicated. All framing except as noted Hem Fir No. 2.
- Plywood shall be as shown on these drawings with exterior glue in accordance with U.S. Product Standard PS 1-07. All panels shall be marked with an APA grade mark with an identification index as shown on drawings. Use 4" x 8" panels minimum, except at boundaries and at framing changes where minimum panel dimension shall be 24" at rooks and 12" at walls.
- Bolts for timber connections shall conform to ANSI/ASME Standard B18.2.1-2012 & 2012 edition of NDS (the National Design Specification for Wood Construction by the National Forest Products Association). Bolts shall be installed in accordance with the requirement of 2012 NDS. Bolt holes shall be 1/32 to 1/16 inch larger than bolt diameter. Bolts shall be full body steel bolts with minimum yield strength of 45,000 PSI. Re-light bolts before coating in work.
- Lag screws shall be steel and conform to ANSI/ASME Standard B18.2.1 and 2012 NDS. Holes for lag screw shanks shall be bored to the same depth and diameter as the shank. The remaining depth of penetration of the screw shall be bored to 70% of the shank diameter. One quarter inch (1/4") diameter lag screw needs not have pre-drilled holes if it can be shown that wood members are not damaged during installation. Provide full diameter body lag screws with bending yield strengths per Table 11.4 in NDS.
- Provide malleable iron washers or equivalent cut plate washers (not less than a standard cut washer) under nuts and bolt or lag screw heads which bear on wood.
- Wood screws shall conform to ANSI/ASME Standard B18.6.1 and the requirements of the 2012 NDS. Galvanized or other corrosion resistant coating where exposed to weather or used in foundations. Screws shall be steel with tensile and bending yield strengths per Table 11.1 in NDS.
- Wood members shall be cut or notched only as shown on structural drawings.
- When required nailing tends to split wood members, nail holes shall be pre-bored to 3/4 of the nail diameter.
- Structural nailing shall be with BOX NAILS per all requirements of 2012 NDS. Nailing not specifically indicated shall comply with CCR Title 24, Part 2, Table 2304.9.1. All nails shall be galvanized or other corrosion resistant coating where exposed to weather. In foundations and as noted on plans, per the requirements of CCR Title 24, Part 2, with minimum bending yields per table 11N in NDS. (See nail schedule below.)
- Nail equivalence:
provide minimum nail lengths as required for equivalent penetration, TYPICAL: U.N.O.)
6d equals .113" DIA. - provide 1.36" minimum point penetration
8d equals .131" DIA. - provide 1.57" minimum point penetration
- Pressure preservative treatment shall be per Section 2303.1.5, CCR Title 24, Part 2. Provide quality mark on all treated foundation members that comply with CBC 2303.1.6.1. All foundation members shall be marked as "For ground contact" or "For above ground use" as appropriate. Pressure treated material shall comply with ANPA Standard L1 as required by CBC 2303.1.8. Treat all cut ends of pressure treated members with an approved preservative. (Willard W/S Copper Green 2% or an approved equivalent). Where noted, members below the sub floor that are not a part of the foundation shall be pressure treated.
- Only material in contact with ground needs to be pressure treated, all other foundation lumber can be DF or HF/2 or equal.
- If machine nailing is utilized for this project, contractor shall comply with all requirements of CCR Title 24, Part 2. Machine nailing is subject to approval by the Structural Engineer or Architect and the Division of the State Architect.
- Fasteners for pressure-preservative treated and fire-retarded treated wood shall comply with Section 2304.9 of CBC.
- Nails and spikes used in wet or exterior locations shall comply with Section 2304.9.1.1 of CBC.
- Shim material shall be plywood CD EXP 1 or equal (not pressure treated).
- Used lumber in good condition is acceptable for use in foundation system.
- The plates shall conform to A-1011 Grade 33.

5.01 SITE INSTALLATION REQUIREMENTS FOR DSA CLASSROOM BUILDINGS:

- In the case of equipment located in the State of California, the LESSEE (School District) is responsible for the site being cleared (free of grass, trees, shrubs, etc) and graded to within 4 1/2" of level grade for each building. If the site exceeds the 4 1/2" level grade requirement additional costs may be charged to lessee.
- Under no circumstances should the site be greater than 9" from level grade or have less than a 1000 PSF MINIMUM SOIL BEARING PRESSURE.
- Prior to delivery, the lessee shall mark the four corners of the building on the site, including door location. Should special handling be required to either place, install or relocate the classroom on the lessee's site due to site obstruction such as fencing, landscaping, other classrooms, etc., additional costs will be charge to the lessee.

6.01 TEST AND INSTALLATION:

- Provide Electrical Grounding Test per DSA IR-1.
- Field Welding for welded plate option. (If used, requires Test and Inspection.)
The example form DSA 103's shown on this sheet are for illustration purposes only. A form DSA 103 is to be completed for each application that this PC is being incorporated into and all example form DSA-103's are to be crossed out on this drawing.
- No other tests and inspections are required.

1.01 GENERAL REQUIREMENTS:

- The requirements of the general conditions of the agreement and these General Requirements apply to the several trade sections with the same force as though fully repeated in each section.
- Name brands are indicated to establish a standard of quality. Items of equal or better quality may be substituted for the listed brand named products.

1.02 SCOPE OF WORK:

- The work consists of installing on-site, modular relocatable buildings as defined herein, shown and detailed on the drawings.
- All requirements of CCR (California Code of Regulation) Title 19 and 24 relating to inspections and verified reports shall be complied with and shall include:
 - General responsible charge of Field Administration by the Architect of Record.
 - Inspection during the course of construction by an Inspector approved by DSA (Division of the State Architect) and the District Architect. The Inspector shall be responsible for and approved to inspect the general construction, welding, mechanical and electrical work. Cost of these inspections shall be borne by the School District.
 - On site inspection of the building installation, electrical and utility of the building installation or connection by an Inspector approved by the DSA and related by the School District.
 - Other special tests or inspections as may be required by DSA. Cost of these inspections/tests shall be borne by the School District.

1.03 WORK NOT INCLUDED:

- All on-site or off-site utilities and the connection of them to the building unless indicated on the drawings.
- All leveling, grading or other site preparation (except concrete or wood leveling strips, where Required) unless otherwise indicated on the drawings.
- Fire alarm system, program bell, clock, public address system, intercom system, TV system, computer data or any other low voltage system, unless otherwise indicated on the drawings or the lease agreement.

1.04 ACCESSIBILITY OF SITE:

The School District shall provide access to the site for the installation of the building. Removal of trees, shrubs, fencing, sidewalks, etc. necessary for move-in and removal of the buildings shall be the responsibility of the School District.

2.01 SITE ASSEMBLY:

- Scope of Work:** Contractor shall provide all labor, materials and services to prepare the building elements, transport them from the plant to the site and to complete the assembly at the site.
The condition of the site, such as drainage and soil bearing capacity, shall be the responsibility of the School District and the District Architect.
- Assembly of Elements:**
 - In a location on the site as determined by the District Architect. The contractor shall place the foundation as detailed on the drawings.
 - The elements shall be brought to the site on wheel assembly and transferred to the prepared site. Great care shall be taken to avoid damage to the elements by racking or bumping.
 - Connection of the elements together shall be done according to instructions on the drawings. Flashing, trim and other loose items shall be installed per plans and details of the original building manufacturer's drawings.

DSA DSA 103 is used to certify that all structural tests and special inspections were performed in accordance with the DSA Structural Tests & Special Inspections - 2013 CBC. This form is used to certify that all structural tests and special inspections were performed in accordance with the DSA Structural Tests & Special Inspections - 2013 CBC.

TEST OR SPECIAL INSPECTION	CODE REQUIREMENT AND METHOD	TESTED	DATE	TESTER	INSPECTOR
SOILS	Table 1706.3				
CONCRETE	Table 1706.3				
MASONRY	Table 1706.3				
STEEL	Table 1706.3				
WELDING	Table 1706.3				

- ### APPLICABLE BUILDING CODES
- ALL NEW WORK SHALL COMPLY AND CONFORM TO THE REQUIREMENTS OF THE 2013 CBC
- 2013 CALIFORNIA CODE OF REGULATIONS (CCR) As of January 01, 2014:**
- 2013 CALIFORNIA BUILDING STANDARDS ADMINISTRATIVE CODE PART 1, TITLE 2 (2012 INTERNATIONAL BUILDING CODE VOLUMES 1-2 WITH 2013 CALIFORNIA AMENDMENTS)
 - 2013 CALIFORNIA ELECTRICAL CODE (CEC) PART 3, TITLE 2, CCR (2011 NATIONAL ELECTRICAL CODE WITH 2013 CALIFORNIA AMENDMENTS)
 - 2013 CALIFORNIA MECHANICAL CODE (CMC) PART 4, TITLE 24, CCR (2012 UNIFORM MECHANICAL CODE WITH 2013 CALIFORNIA AMENDMENTS)
 - 2013 CALIFORNIA PLUMBING CODE (CPC) PART 5, TITLE 24, CCR (2012 UNIFORM PLUMBING CODE WITH 2013 CALIFORNIA AMENDMENTS)
 - 2013 CALIFORNIA ENERGY CODE (CEC) PART 6, TITLE 24, CCR*
 - 2013 CALIFORNIA FIRE CODE PART 9, TITLE 24, CCR (2012 INTERNATIONAL FIRE CODE WITH 2013 CALIFORNIA AMENDMENTS)
 - 2013 CALIFORNIA REFERENCED STANDARDS CODE PART 12, TITLE 24, CCR
 - TITLE 19 CCR PUBLIC SAFETY, STATE FIRE MARSHALL REGULATIONS.

- ### DESIGN DATA:
- FLOOR LIVE LOAD = 50 PSF, 50 x 20 PSF PARTITIONS, 100 PSF
ROOF LIVE LOAD = 20 PSF REDUCIBLE FOR TRIBUTARY AREA
WIND SPEED = 120 MPH (1 SECOND GUST), K_t = 1.0
SNOW LOAD: PROJECT IS NOT LOCATED IN A SNOW REGION.
BUILDING CODES = 2012 IBC AND CBC 2013

SEISMIC DESIGN DATA:
Basic Seismic-Force-Resisting System = STEEL MOMENT FRAME
ANALYSIS PROCEDURE USED = EQUIVALENT LATERAL FORCE
Seismic Design Category = E (per CBC Section 1613A.5.6)
Design Base Shear: 2840 BUILDING = 3480 # (Roof, Floor, Walls & Partitions)
2840 BUILDING = 1493 # (Roof, Floor, Walls & Partitions)
4840 BUILDING = 1820 # (Roof, Floor, Walls & Partitions)

SEISMIC DESIGN DATA:
Basic Seismic-Force-Resisting System = WOOD PANEL SHEAR WALLS
ANALYSIS PROCEDURE USED = EQUIVALENT LATERAL FORCE
Seismic Design Category = E (per CBC Section 1613A.5.6)
Design Base Shear: 2840 BUILDING = 3480 # (Roof, Floor, Walls & Partitions)
2840 BUILDING = 1493 # (Roof, Floor, Walls & Partitions)
4840 BUILDING = 1820 # (Roof, Floor, Walls & Partitions)

SHEAR WALL PC'S:
Basic Seismic-Force-Resisting System = WOOD PANEL SHEAR WALLS
ANALYSIS PROCEDURE USED = EQUIVALENT LATERAL FORCE
Seismic Design Category = E (per CBC Section 1613A.5.6)
Design Base Shear: 2840 BUILDING = 3480 # (Roof, Floor, Walls & Partitions)
2840 BUILDING = 1493 # (Roof, Floor, Walls & Partitions)
4840 BUILDING = 1820 # (Roof, Floor, Walls & Partitions)


DESIGN DATA:
e = 1.0 C_u = 0.411 R = 3.5 SITE CLASS = D p = 1.3
S_u = 2.7 mapped value / 0.8 S_s = 2.16 (Per Design)
Site = 1.44 (Site Specific Conditions Shall be Submitted to DSA Prior
to Approval) S₁ = 1.3 per CBC Figure 1613A.6(2) S₁ = 1.3 To Approval

LIMITATIONS FOUNDATION PC ONLY:

FOUNDATION ONLY PC IS DESIGNED TO SUPPORT THE SUPERSTRUCTURE FOR THE RELOCATABLE BUILDINGS AS LISTED ON THIS DRAWING.

THE DESIGN CALCULATIONS ARE BASED ON THE FOLLOWING:

- DSA APPROVED STOCKPILE BUILDINGS
- ROOF OVERHANGS OF 5'-0" MAXIMUM
- SINGLE SLOPE OR DUAL SLOPE BUILDINGS
WALL HEIGHT: 9'-0" MAXIMUM ON DUAL SLOPE BUILDING.
(HEIGHT DETERMINED FROM FINISH FLOOR IN BUILDING TO BOTTOM OF STEEL ROOF STRUCTURE: BEAMS OR ROOF HEADERS)
WALL HEIGHT: 9'-10" MAXIMUM ON SHEAR WALL-DUAL SLOPE BUILDING
- WALL DEAD LOAD OF 10 PSF (NO STUCCO)
- FLOOR DEAD LOAD OF 8 PSF

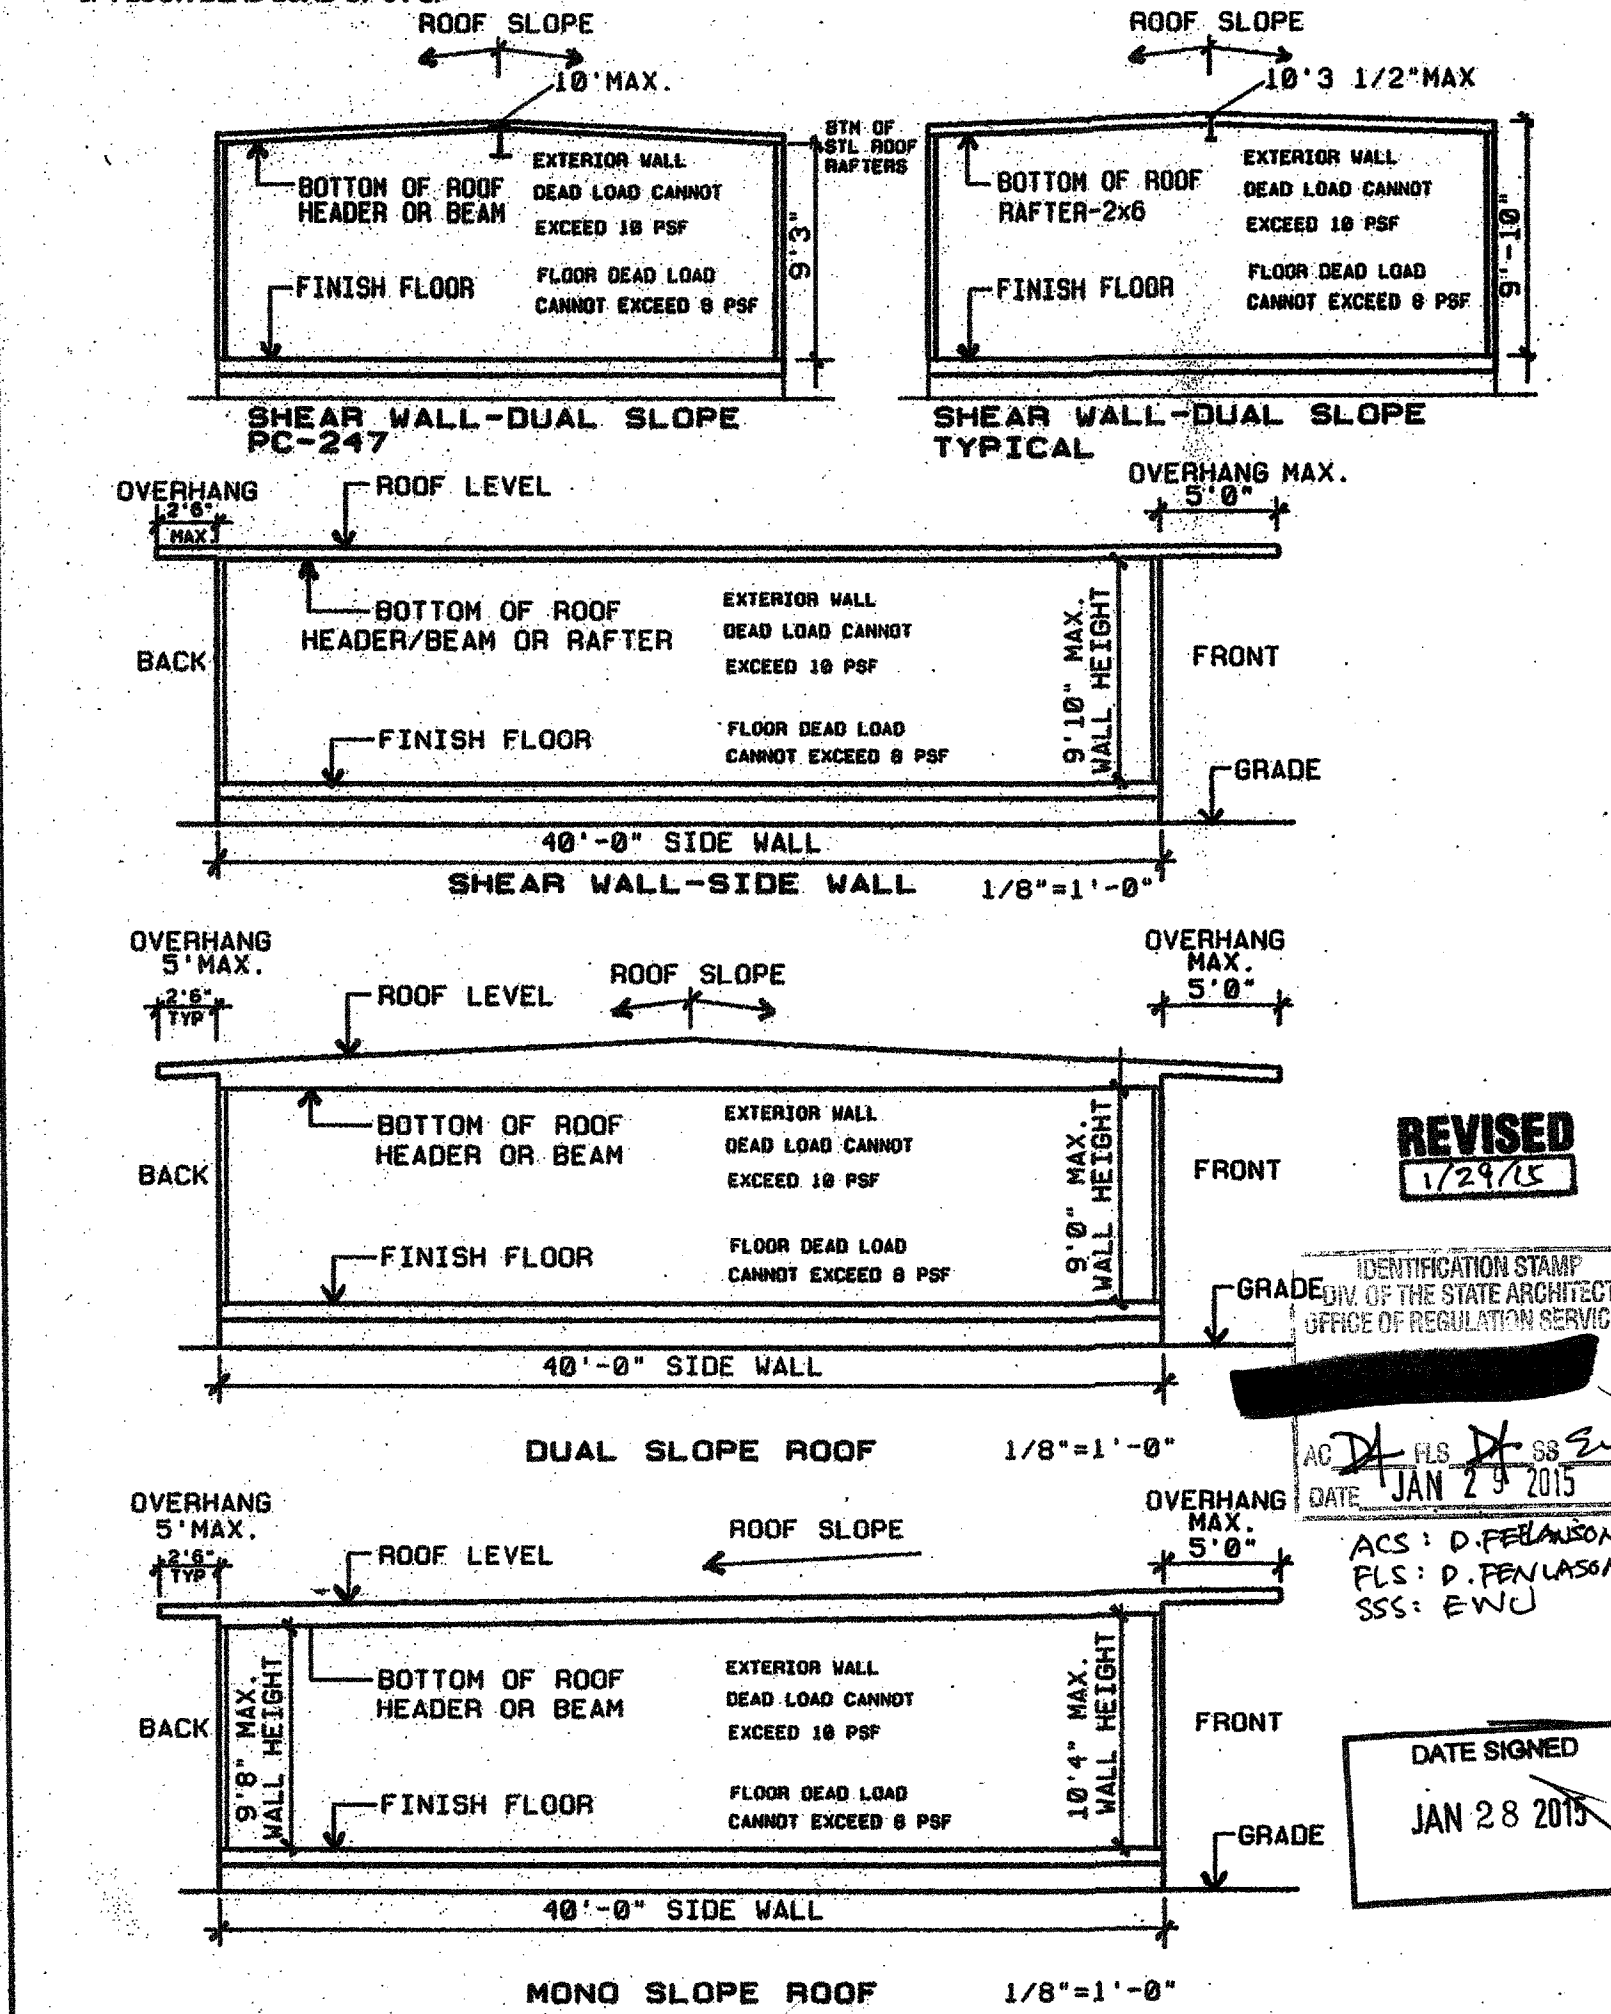

SCOPE OF WORK: DSA FOUNDATION PLANS FOR EXISTING STOCKPILE BUILDINGS FOR CLASS LEASING, LLC.

SHEET INDEX: STOCKPILE BUILDING FOUNDATION—2013 CODE UPDATE

F1.0 COVER SHEET, BUILDING DATA, STOCKPILE APPROVAL INDEX	FOUNDATION PLAN AND DETAILS, ADJACENT BUILDING PAD
F2.0 24x40 50 PSF	FOUNDATION PLAN AND DETAILS, ADJACENT BUILDING PAD
F2.1 28x40 50+20 PSF	FOUNDATION PLAN AND DETAILS, ADJACENT BUILDING PAD
F2.2 38x40 50 PSF	FOUNDATION PLAN AND DETAILS, ADJACENT BUILDING PAD
F3.1 38x40 50+20 PSF	FOUNDATION PLAN AND DETAILS, ADJACENT BUILDING PAD
F3.2 38x40 100 PSF	FOUNDATION PLAN AND DETAILS, ADJACENT BUILDING PAD
F4.0 48x40 50 PSF	FOUNDATION PLAN AND DETAILS, ADJACENT BUILDING PAD
F4.1 48x40 50+20 PSF	FOUNDATION PLAN AND DETAILS, ADJACENT BUILDING PAD
F4.2 48x40 100 PSF	FOUNDATION PLAN AND DETAILS, ADJACENT BUILDING PAD

SHEET INDEX: BELOW GRADE CONCRETE FOUNDATION - DESIGNED FOR MODTECH BUILDINGS ONLY

C1.0 COVER SHEET, BUILDING DATA, STOCKPILE APPROVAL INDEX	CONCRETE FOUNDATION PLAN & DETAILS, ADJACENT BUILDING PAD
C2.0 24 x 40 - 50 PSF	CONCRETE FOUNDATION PLAN & DETAILS, ADJACENT BUILDING PAD
C2.1 24 x 40 - 50+20 PSF	CONCRETE FOUNDATION PLAN & DETAILS, ADJACENT BUILDING PAD
C3.0 38 x 40 - 50 PSF	CONCRETE FOUNDATION PLAN & DETAILS, ADJACENT BUILDING PAD
C3.1 38 x 40 - 50+20 PSF	CONCRETE FOUNDATION PLAN & DETAILS, ADJACENT BUILDING PAD
C3.2 38 x 40 - 100 PSF	CONCRETE FOUNDATION PLAN & DETAILS, ADJACENT BUILDING PAD
C4.0 48 x 40 - 50 PSF	CONCRETE FOUNDATION PLAN & DETAILS, ADJACENT BUILDING PAD
C4.1 48 x 40 - 50+20 PSF	CONCRETE FOUNDATION PLAN & DETAILS, ADJACENT BUILDING PAD
C4.2 48 x 40 - 100 PSF	CONCRETE FOUNDATION PLAN & DETAILS, ADJACENT BUILDING PAD

ADJACENT BUILDINGS: ONLY THOSE BUILDINGS MANUFACTURED BY THE SAME COMPANY MAY BE PLACED ADJACENT TO EACH OTHER

CLASS LEASING-APPROVED STOCKPILE A NUMBERS FOR THIS FOUNDATION PC

BUILDING DATA - 24 X 40 SHEAR WALL	STKP #	DSA #	PC-BASE	DATE	SIZE	FLOOR LOAD	BLDG MFG
STKP 02	62543	SHR	10-21-1998	24 x 40	50+20P	MODTECH	
STKP 02	62512	4813B-SHR	11-09-1999	24 x 40	50P	MODTECH	
STKP 01	62813	4813B-SHR	11-09-1999	24 x 40	50P	MODTECH	
STKP 03	62914	SHR	11-09-1999	24 x 40	50P	MODTECH	
STKP 06	62816	4840-SHR	12-07-1999	24 x 40	50P	AURORA	
STKP 04	62916	SHR PC 28 HR	12-07-1999	24 x 40	50P	MODTECH	
STKP 22	69113	PC 28	03-18-2000	24 x 40	50P	MODTECH	
STKP 24	62819	PC 28	05-14-1994	24 x 40	50P	MODTECH	
STKP 13	61967	PC 247	08-28-1994	24 x 40	50P	MODTECH	
STKP 77	67970	PC 247	11-10-1997	24 x 40	50P	MODTECH	

BUILDING DATA - 24 X 40 RIGID FRAME	STKP #	DSA #	PC-BASE	DATE	SIZE	FLOOR LOAD	BLDG MFG
STKP 11	62462	SHR	08-13-1991	24 x 40	50+20P	MODTECH	
STKP 20	59331	PC 79	09-18-1990	24 x 40	50P	MODTECH	
STKP 21	59332	PC 79	09-18-1990	24 x 40	50P	MODTECH	
STKP 23	65347	PC 79	11-28-1990	24 x 40	50P	MODTECH	
STKP 5W	67184	PC 79	11-08-1991	24 x 40	50+20P	MODTECH	
STKP 14	67873	PC 98	03-18-1992	24 x 40	50P	MODTECH	
STKP 18	63298	PC 243	05-04-1998	24 x 40	50P	MODTECH	
STKP 19	63321	PC 242	05-11-1998	24 x 40	50P	MODTECH	
STKP 27	65483	PC 266	07-31-1998	24 x 40	50P	MODTECH	
STKP 31	66318	PC 268	11-12-1998	24 x 40	50+20P	MODTECH	
STKP 33	67333	PC 266	08-11-1997	24 x 40	50P	MODTECH	
STKP 35	64113	PC 266	01-15-1999	24 x 40	50+20P	MODTECH	
STKP 39	04-100596	PC 275	08-10-1998	24 x 40	50+20P	MODTECH	
STKP 37	04-100598	PC 266	08-10-1998	24 x 40	50+20P	MODTECH	
STKP 40	04-100590	PC 282	09-03-1998	24 x 40	50+20P	MODTECH	
STKP 42	04-100629	PC 266	01-07-1999	24 x 40	50+20P	MODTECH	
STKP 43	04-10055	PC 275	09-09-1999	24 x 40	50+20P	MODTECH	
STKP 44	04-101602	PC 266	09-30-1999	24 x 40	50+20P	MODTECH	
STKP 48	04-101788	PC 101288	12-16-1999	24 x 40	50P	MODTECH	
STKP 51	04-102018	PC 101288	03-18-2000	24 x 40	50P / 50+20P	MODTECH	
STKP 53	04-102385	PC 101288	07-06-2000	24 x 40	50+20P	MODTECH	
STKP 55	04-102824	PC 101288	12-21-2000	24 x 40	50P	MODTECH	
STKP 62	04-104168	PC 101288	04-18-2002	24 x 40	50+20P	MODTECH	
STKP 67	04-104812	PC 101288	12-08-2002	24 x 40	50+20P	MODTECH	
STKP 70	04-105299	PC 104801	05-22-2003	24 x 40	50+20P	MODTECH	
STKP 75	04-110431	PC 04-105387	08-05-2003	24 x 40	50P	MODTECH	
STKP 76	04-105455	PC 04-104796	07-17-2003	24 x 40	50P	MODTECH	
STKP 78	04-105644	PC 105884	12-03-2007	24 x 40	50P	CURRENTISM	
STKP 107	68985	PC 266	05-24-1998	24 x 40	50P	MODTECH	
STKP 109	69341	PC 275	05-20-1999	24 x 40	50P	MODTECH	
STKP 110	04-100118	PC 04-100073	01-15-1998	24 x 40	50P	MSI	
STKP 111	04-101894	PC 04-101419	03-09-2000	24 x 40	50P	MODTECH	
STKP 112	04-105623	PC 04-101419	02-13-2002	24 x 40	50P	MODTECH	
STKP 113	04-104310	PC 04-101419	08-02-2002	24 x 40	50P	MODTECH	
STKP 114	04-105458	PC 04-104798	07-17-2003	24 x 40	50P	MODTECH	
STKP 130	04-101827	PC 270	08-12-1999	24 x 40	50P / 50+20P	MODTECH	
STKP 131	04-104846	PC 04-101419	01-23-2003	24 x 40	50P / 50+20P	MODTECH	

BUILDING DATA - 38 X 40 RIGID FRAME	STKP #	DSA #	PC-BASE	DATE	SIZE	FLOOR LOAD	BLDG MFG
STKP 3W	67194	PC 79	11-08-1991	38 x 40	70P	MODTECH	
STKP 37	65319	PC 266	11-22-1998	38 x 40	50+20P	MODTECH	
STKP 36	67332	PC 266	03-11-1997	38 x			