
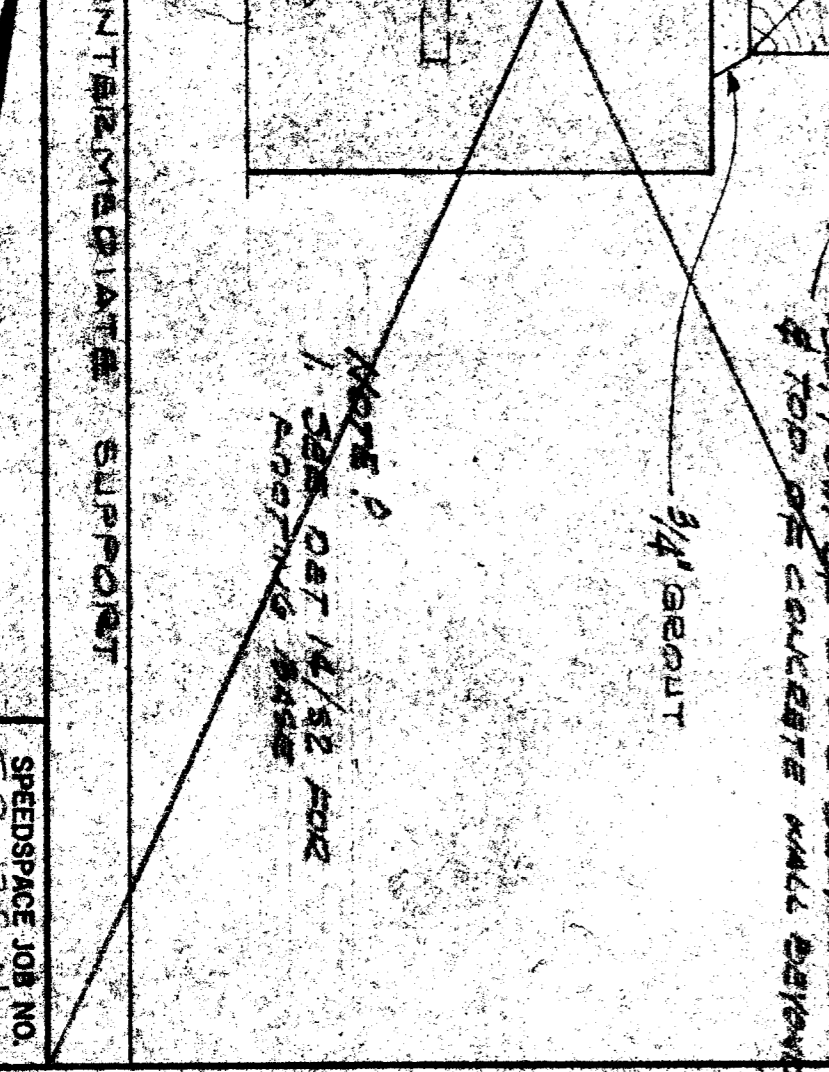
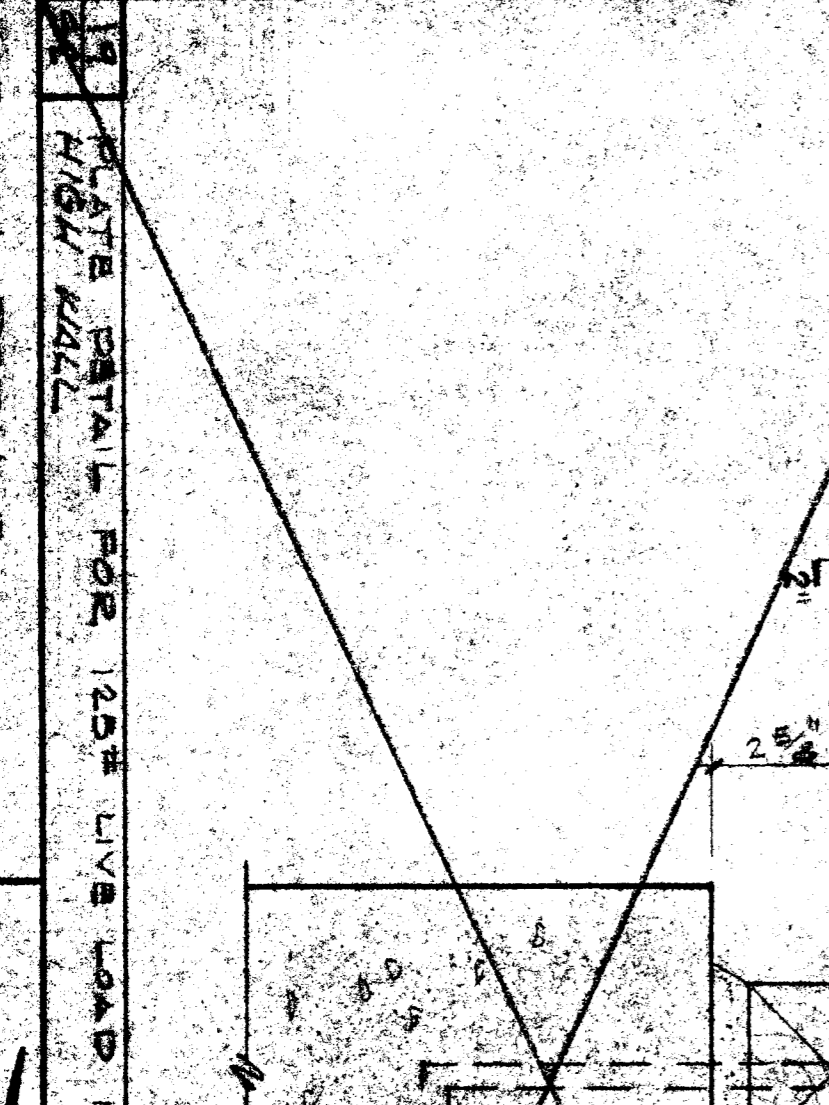
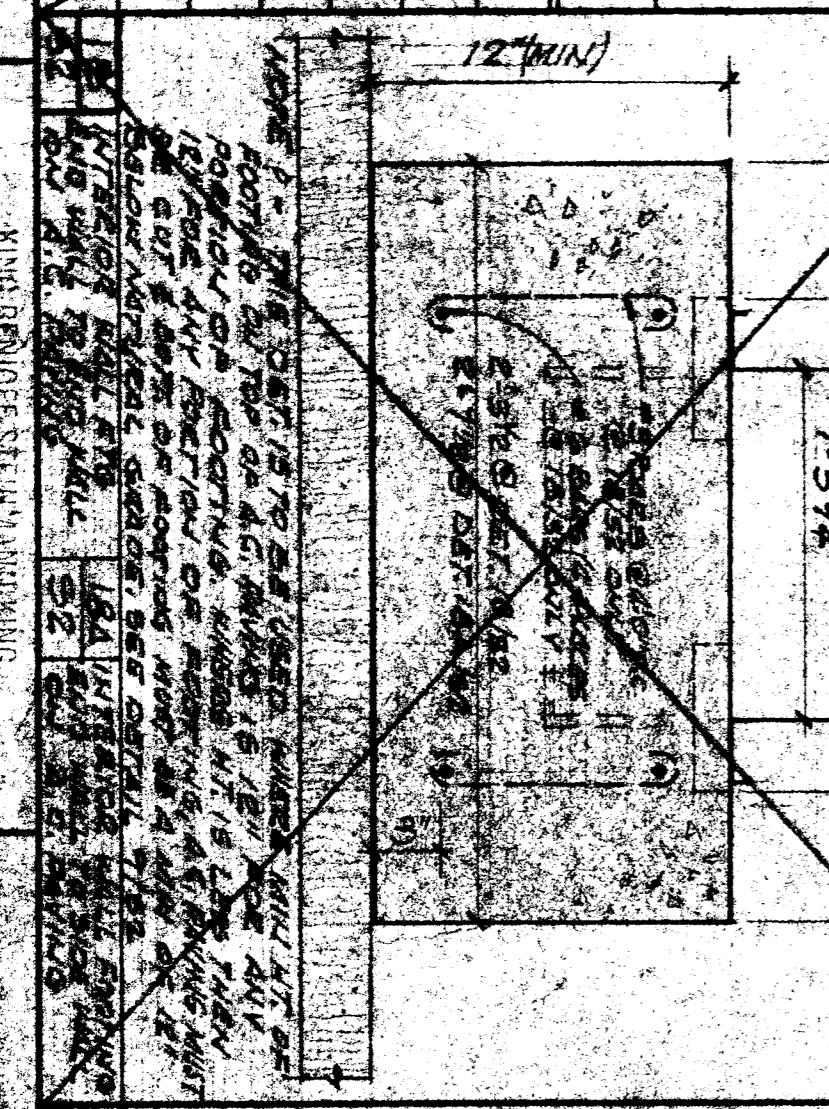
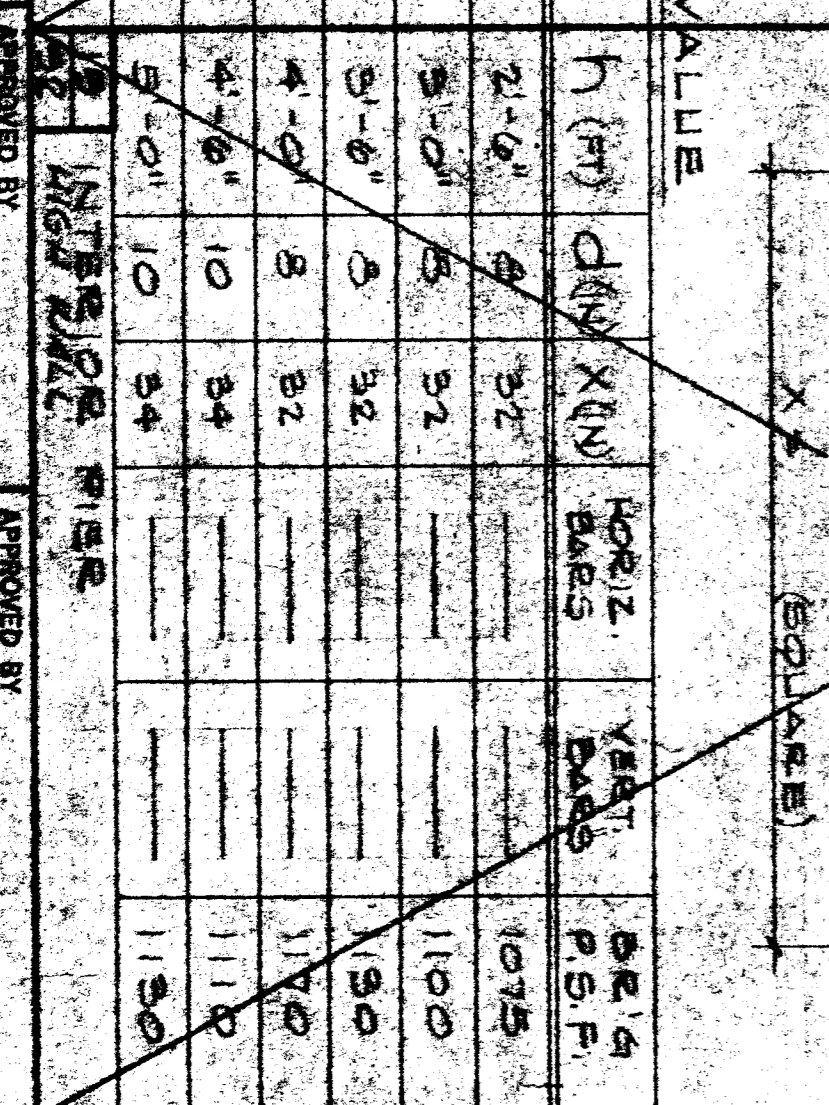


SCHEDULES BASED ON 1200# P.S.F. SOIL VALUE

h (ft)	d (in)	X (in)	h (ft)	d (in)	X (in)	h (ft)	d (in)	X (in)	h (ft)	d (in)	X (in)
2-0"	6	2-#5	3-0"	6	2-#5	4-0"	6	2-#5	5-0"	6	2-#5
3-0"	6	3-#5	4-0"	6	3-#5	5-0"	6	3-#5	6-0"	6	3-#5
4-0"	6	4-#5	5-0"	6	4-#5	6-0"	6	4-#5	7-0"	6	4-#5
5-0"	6	5-#5	6-0"	6	5-#5	7-0"	6	5-#5	8-0"	6	5-#5
6-0"	6	6-#5	7-0"	6	6-#5	8-0"	6	6-#5	9-0"	6	6-#5
7-0"	6	7-#5	8-0"	6	7-#5	9-0"	6	7-#5	10-0"	6	7-#5
8-0"	6	8-#5	9-0"	6	8-#5	10-0"	6	8-#5	11-0"	6	8-#5
9-0"	6	9-#5	10-0"	6	9-#5	11-0"	6	9-#5	12-0"	6	9-#5
10-0"	6	10-#5	11-0"	6	10-#5	12-0"	6	10-#5	13-0"	6	10-#5
11-0"	6	11-#5	12-0"	6	11-#5	13-0"	6	11-#5	14-0"	6	11-#5
12-0"	6	12-#5	13-0"	6	12-#5	14-0"	6	12-#5	15-0"	6	12-#5

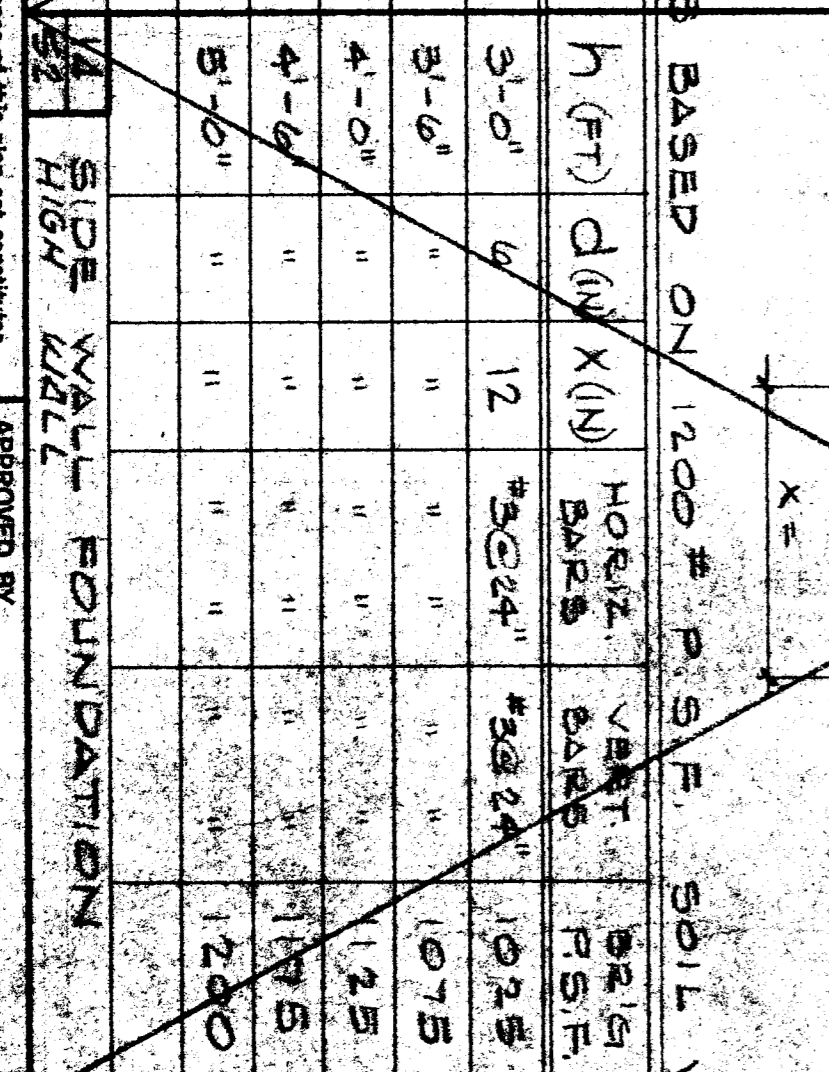

REVISIONS

NO.	DATE	DESCRIPTION
1		
2		
APPROVED BY: [Signature]

STATE OF CALIFORNIA - DEPARTMENT OF INDUSTRIAL RELATIONS

8 2 6 8 2 APPROVED 001 31 1918

OFFICE OF ARCHITECTURE & CONSTRUCTION

STATE PRINT SYSTEM

BAKERSFIELD CITY S.D.

BAKERSFIELD, CALIF.

SPEEDSPAC CORPORATION

RESIDENTIAL BUILDINGS

1000-5th Street, Suite 400

Bakersfield, CA 93311

TEL: (805) 338-1111

FAX: (805) 338-1112

WEBSITE: www.speedspac.com

SHEET NO. 5-21A

13 OF 31