
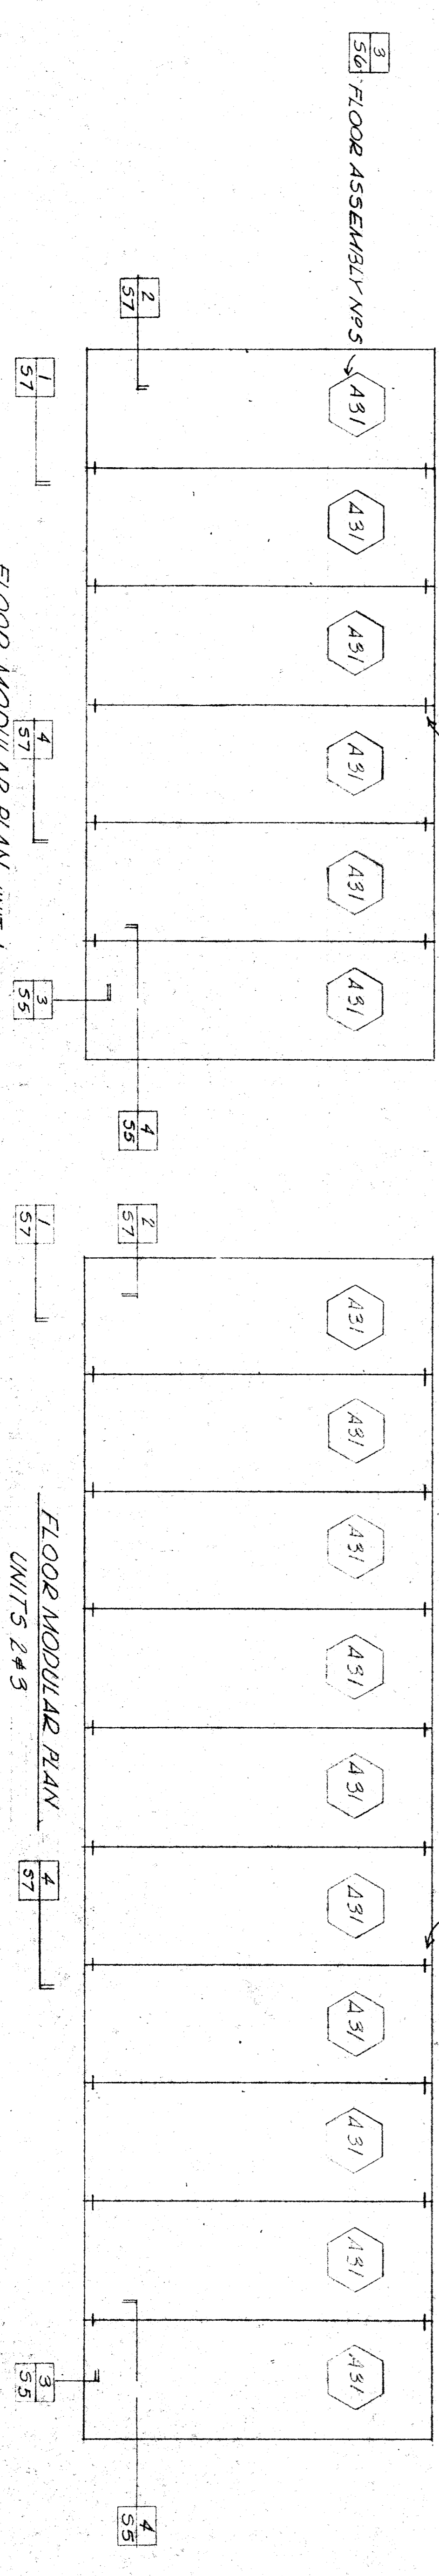
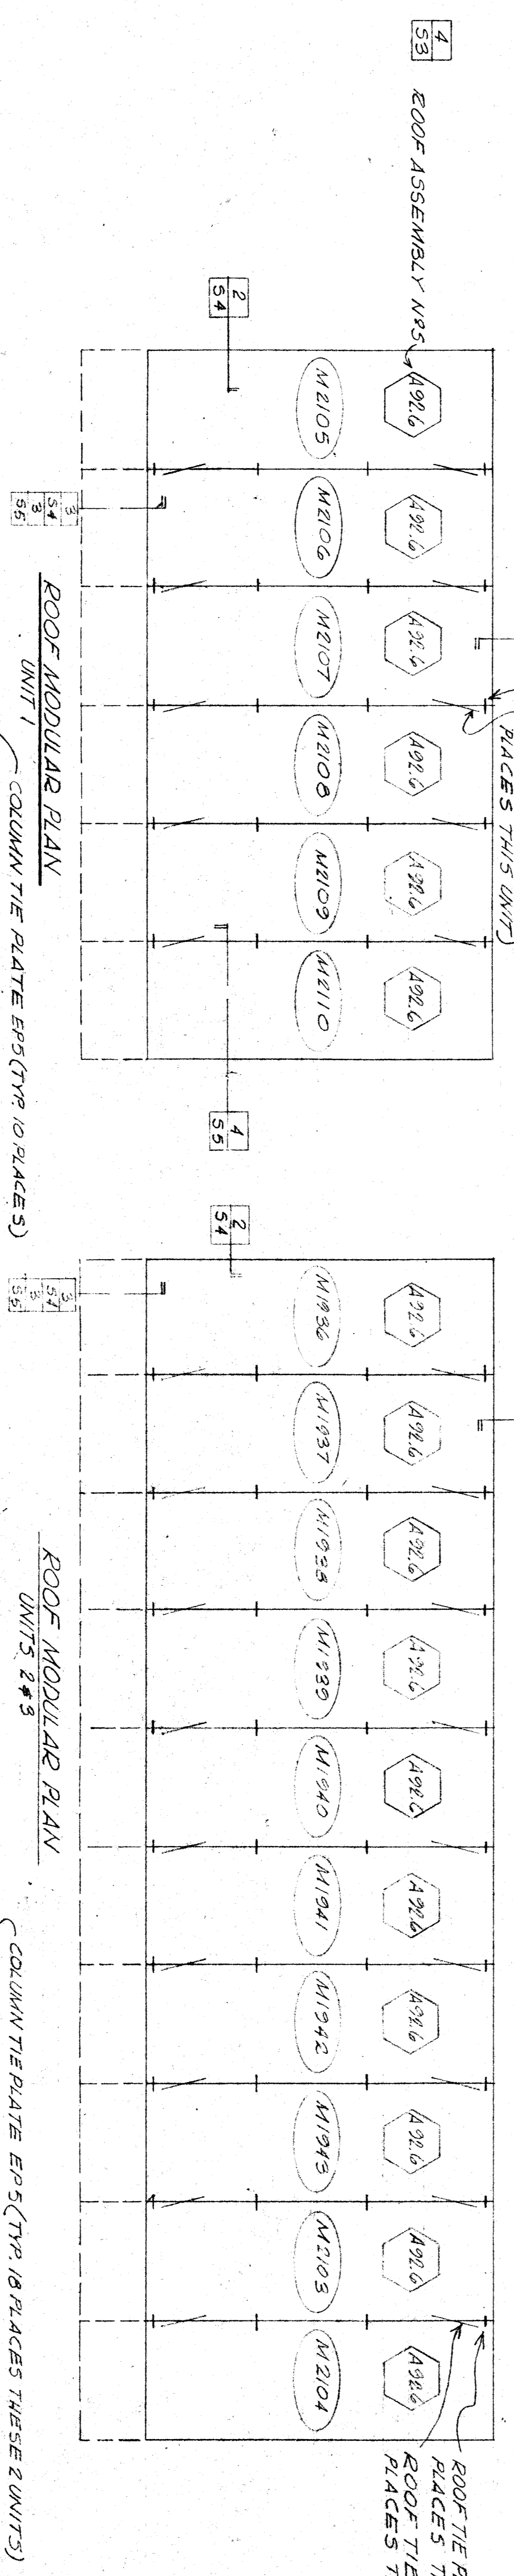


7 PYRODOD SHEAR PANELS 304
ON UNITS 4, 5 & 6

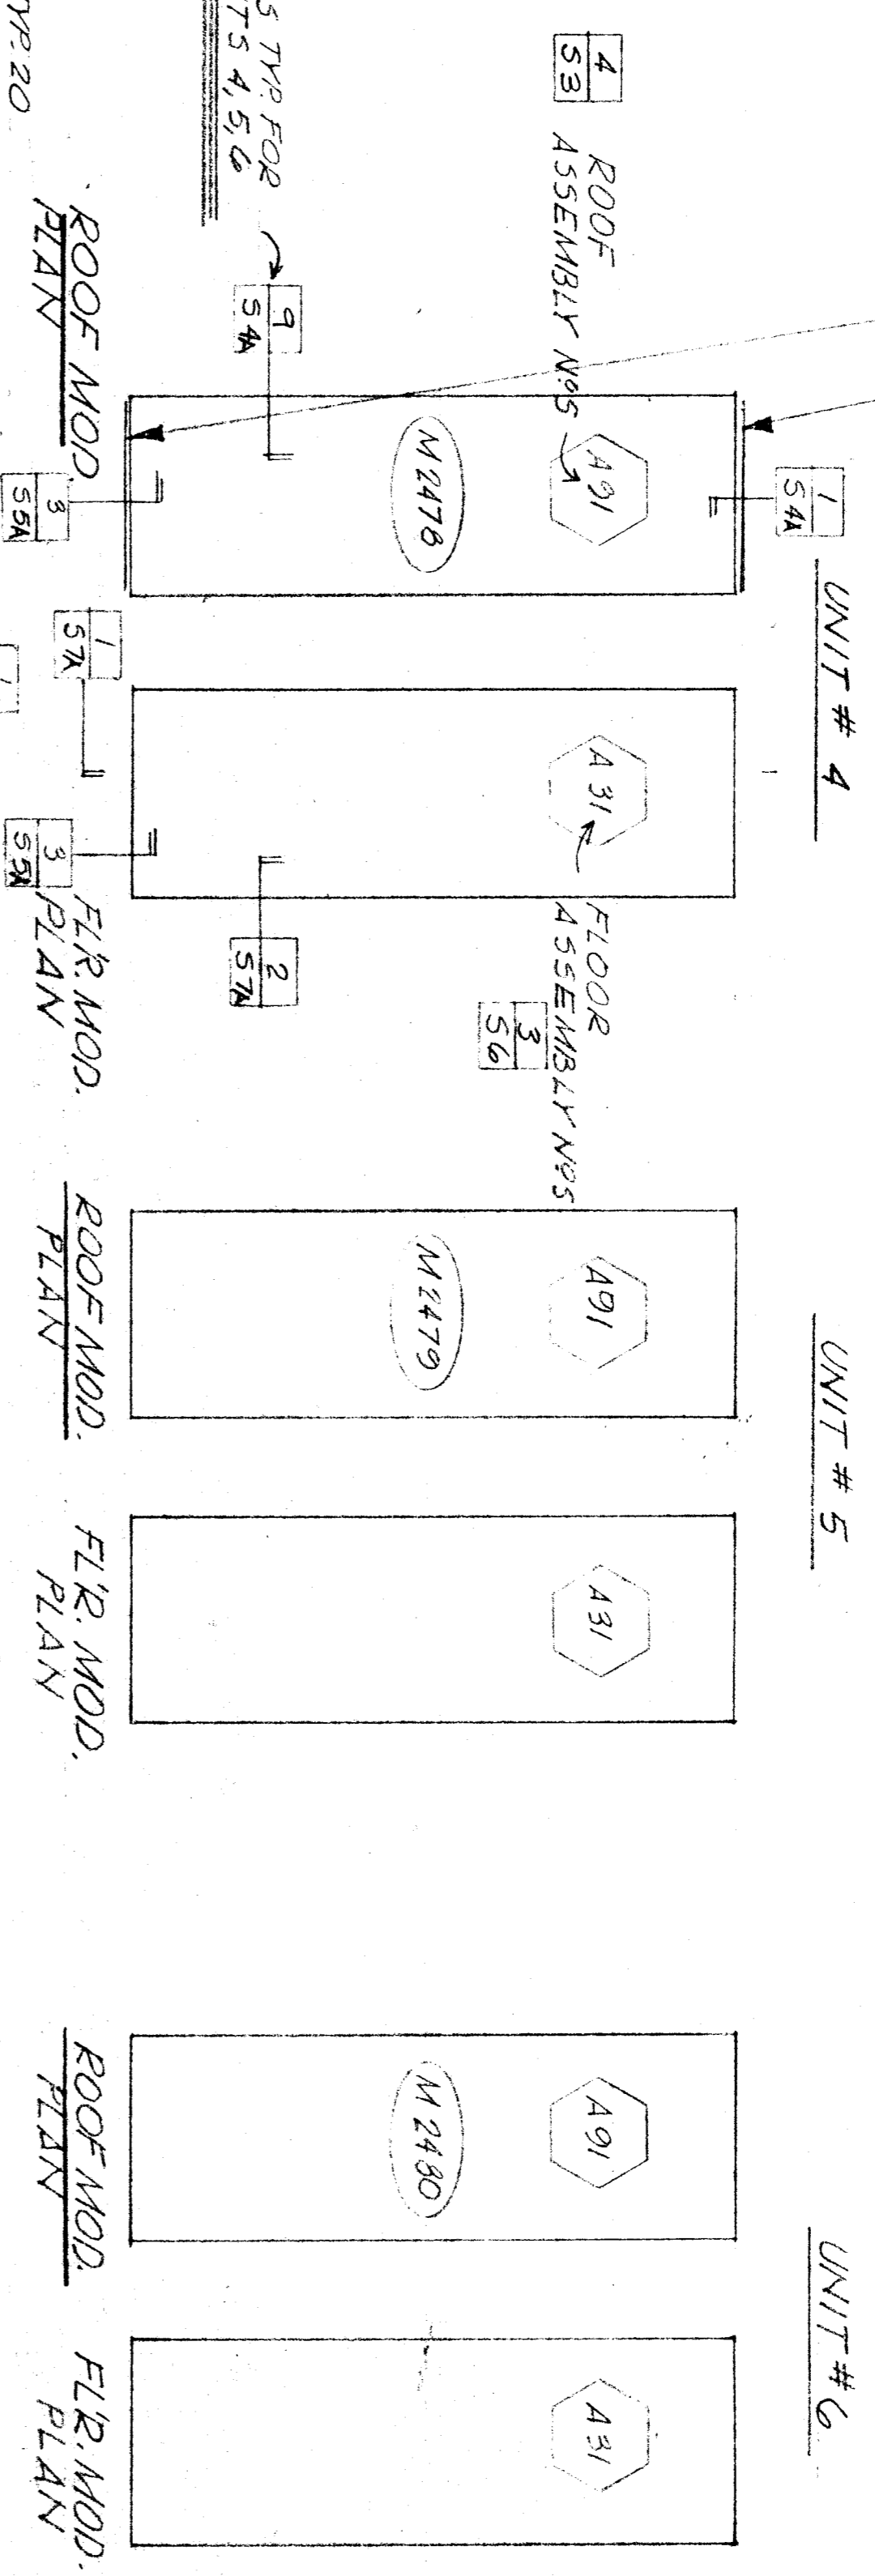

<p>BY: _____</p>		<p>DATE: _____</p>		<p>REVISIONS:</p>	
<p>REFERENCE PLAN SET NO. _____</p>		<p>The acceptance of this plan set constitutes agreement that the design, shop drawings and specifications are to be used only for the project and shall not be exhibited, delivered or transferred to anyone or used for additional projects in whole or in part without the written consent of Speedspace Corporation.</p>			
<p>APPROVED BY: _____</p>		<p>OFFICE OF ARCHITECTURE & CONSTRUCTION</p>		<p>STATE FIRE MARSHAL</p>	
<p>APPROVED BY: _____</p>		<p>SCHOOL DISTRICT</p>		<p>BAKER'S FIELD CITY SCH. DIST. BAKER'S FIELD, CALIFORNIA</p>	
<p>APPROVED BY: _____</p>		<p>ROOF & FLOOR MODULAR PLAN</p>		<p>BAKER'S FIELD CITY SCH. DIST. BAKER'S FIELD, CALIFORNIA</p>	
<p>APPROVED BY: _____</p>		<p>ROOF & FLOOR MODULAR PLAN</p>		<p>BAKER'S FIELD CITY SCH. DIST. BAKER'S FIELD, CALIFORNIA</p>	
<p>APPROVED BY: _____</p>		<p>ROOF & FLOOR MODULAR PLAN</p>		<p>BAKER'S FIELD CITY SCH. DIST. BAKER'S FIELD, CALIFORNIA</p>	

SPEEDSPACE CORPORATION
RELOCATABLE BUILDINGS
P.O. Box 990 - Santa Rosa, California 95401
Telephone (707) 544-1641

ATC
Licensed Plant
No. 160
FACILITY NO. 500

SPEEDSPACE JOB NO. 59-1925
SHEET NO. 2 OF 31