
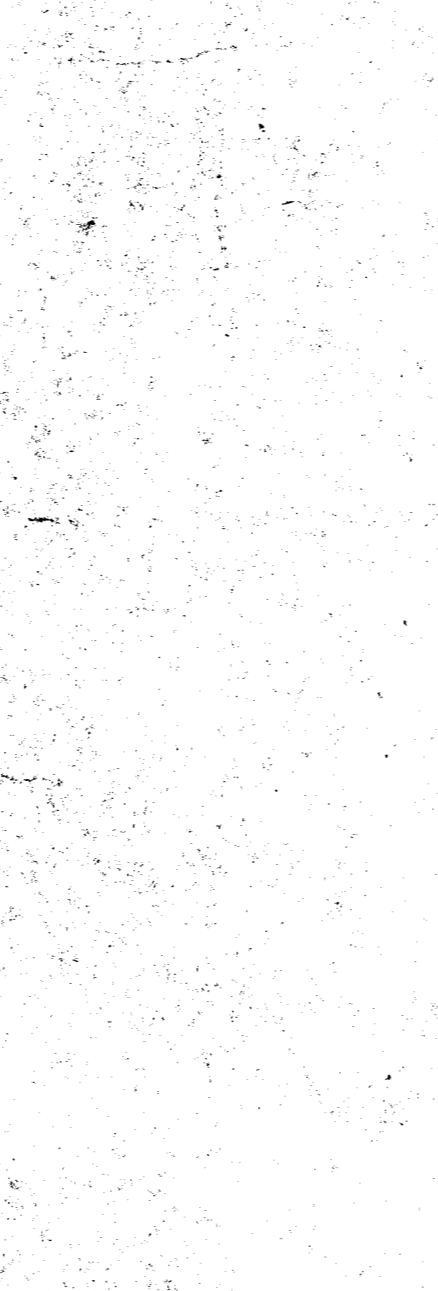


LENNOX RBE UNIT MECHANICAL DATA NO SCALE

MODEL NO.	FRON COMP. H.P.	FRON COMP. AMPS	FRON COMP. VOLTS	FRON COMP. PHASE	FRON COMP. SPEED	FRON COMP. TYPE	FRON COMP. CONDENSER	FRON COMP. EVAPORATOR	FRON COMP. MOTOR	FRON COMP. WEIGHT	FRON COMP. HEIGHT	FRON COMP. WIDTH	FRON COMP. DEPTH
1180-1030	1 1/2	1 1/2	45,000	1	3600	CONDENSER	EVAPORATOR	CONDENSER	EVAPORATOR	CONDENSER	EVAPORATOR	CONDENSER	EVAPORATOR

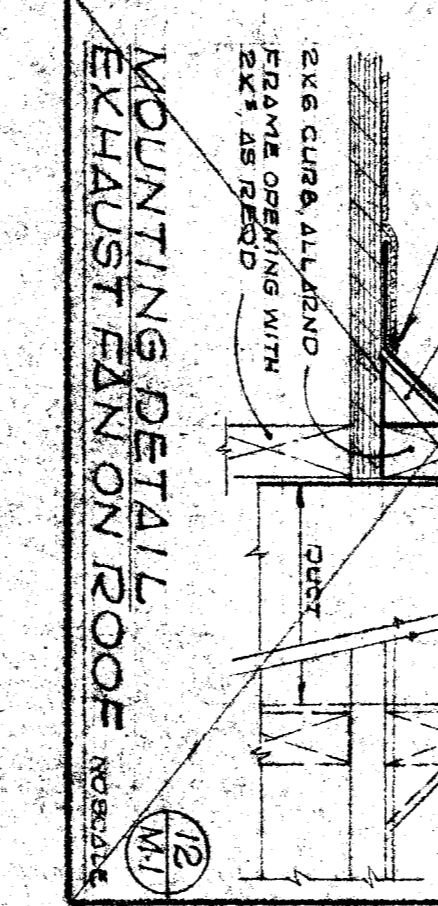

MECHANICAL LEGEND

SYMBOL	DESCRIPTION
[Symbol]	SUPPLY AIR
[Symbol]	RETURN OR EXHAUST AIR
[Symbol]	SUPPLY DUCT
[Symbol]	RETURN OR EXHAUST DUCT
[Symbol]	VOLUME DAMPER
[Symbol]	FIRE DAMPER
[Symbol]	CEILING SUPPLY DIFFUSER
[Symbol]	CEILING RETURN REGISTER
[Symbol]	CEILING EXHAUST REGISTER
[Symbol]	WALL TRANSFER GRILLE
[Symbol]	CEILING TRANSFER GRILLE
[Symbol]	VENT FAN IN CEILING
[Symbol]	EXHAUST FAN ON ROOF
[Symbol]	DIRECTION OF AIR FLOW

AIR OUTLET SCHEDULE

MODEL NO.	FRON COMP. H.P.	FRON COMP. AMPS	FRON COMP. VOLTS	FRON COMP. PHASE	FRON COMP. SPEED	FRON COMP. TYPE	FRON COMP. CONDENSER	FRON COMP. EVAPORATOR	FRON COMP. MOTOR	FRON COMP. WEIGHT	FRON COMP. HEIGHT	FRON COMP. WIDTH	FRON COMP. DEPTH
1180-1030	1 1/2	1 1/2	45,000	1	3600	CONDENSER	EVAPORATOR	CONDENSER	EVAPORATOR	CONDENSER	EVAPORATOR	CONDENSER	EVAPORATOR

GENERAL NOTES

1. ALL DUCTS SHALL BE INSTALLED TO AVOID ARCHITECTURAL OPENINGS, UNLESS OTHERWISE SPECIFIED.
2. ALL DUCT CONNECTIONS TO EXISTING SYSTEMS SHALL BE REVERSIBLE.
3. ALL DUCT CONNECTIONS TO EXISTING SYSTEMS SHALL BE REVERSIBLE.
4. ALL SQUARE ELBOWS IN DUCTWORK SHALL HAVE TURNING VANES.
5. INCREASED SIZE OF PUCTWORK WHERE ACoustICAL LINING IS CALLED FOR TO OBTAIN INSIDE DIMENSIONS AS NOTED.
6. PUCTWORK IS TO BE INSTALLED AS NOTED.
7. MAKE CONNECTIONS TO EQUIPMENT AS SPECIFIED IN DRAWINGS.
8. REFER TO MECH. CONTRACT DRAWINGS FOR EXHAUST FAN ON ROOF.
9. EXHAUST FAN ON ROOF SHALL BE INSTALLED AS SPECIFIED IN DRAWINGS.
10. DO NOT SCALE FLOOR PLAN DRAWINGS.
11. INSTALL TO FIT FIELD CONDITIONS.

APPROVED BY: [Signature]

STATE FIRE MARSHAL

MECHANICAL

BAKERFIELD CITY S.D.

BAKERFIELD, CALIF.

SPEEDSPACE CORPORATION

RELOCATABLE BUILDINGS

27 OF 37

BAKERFIELD, CALIF.