


SOUTH ELEVATION

EAST ELEVATION



FLOOR PLAN UNIT #1

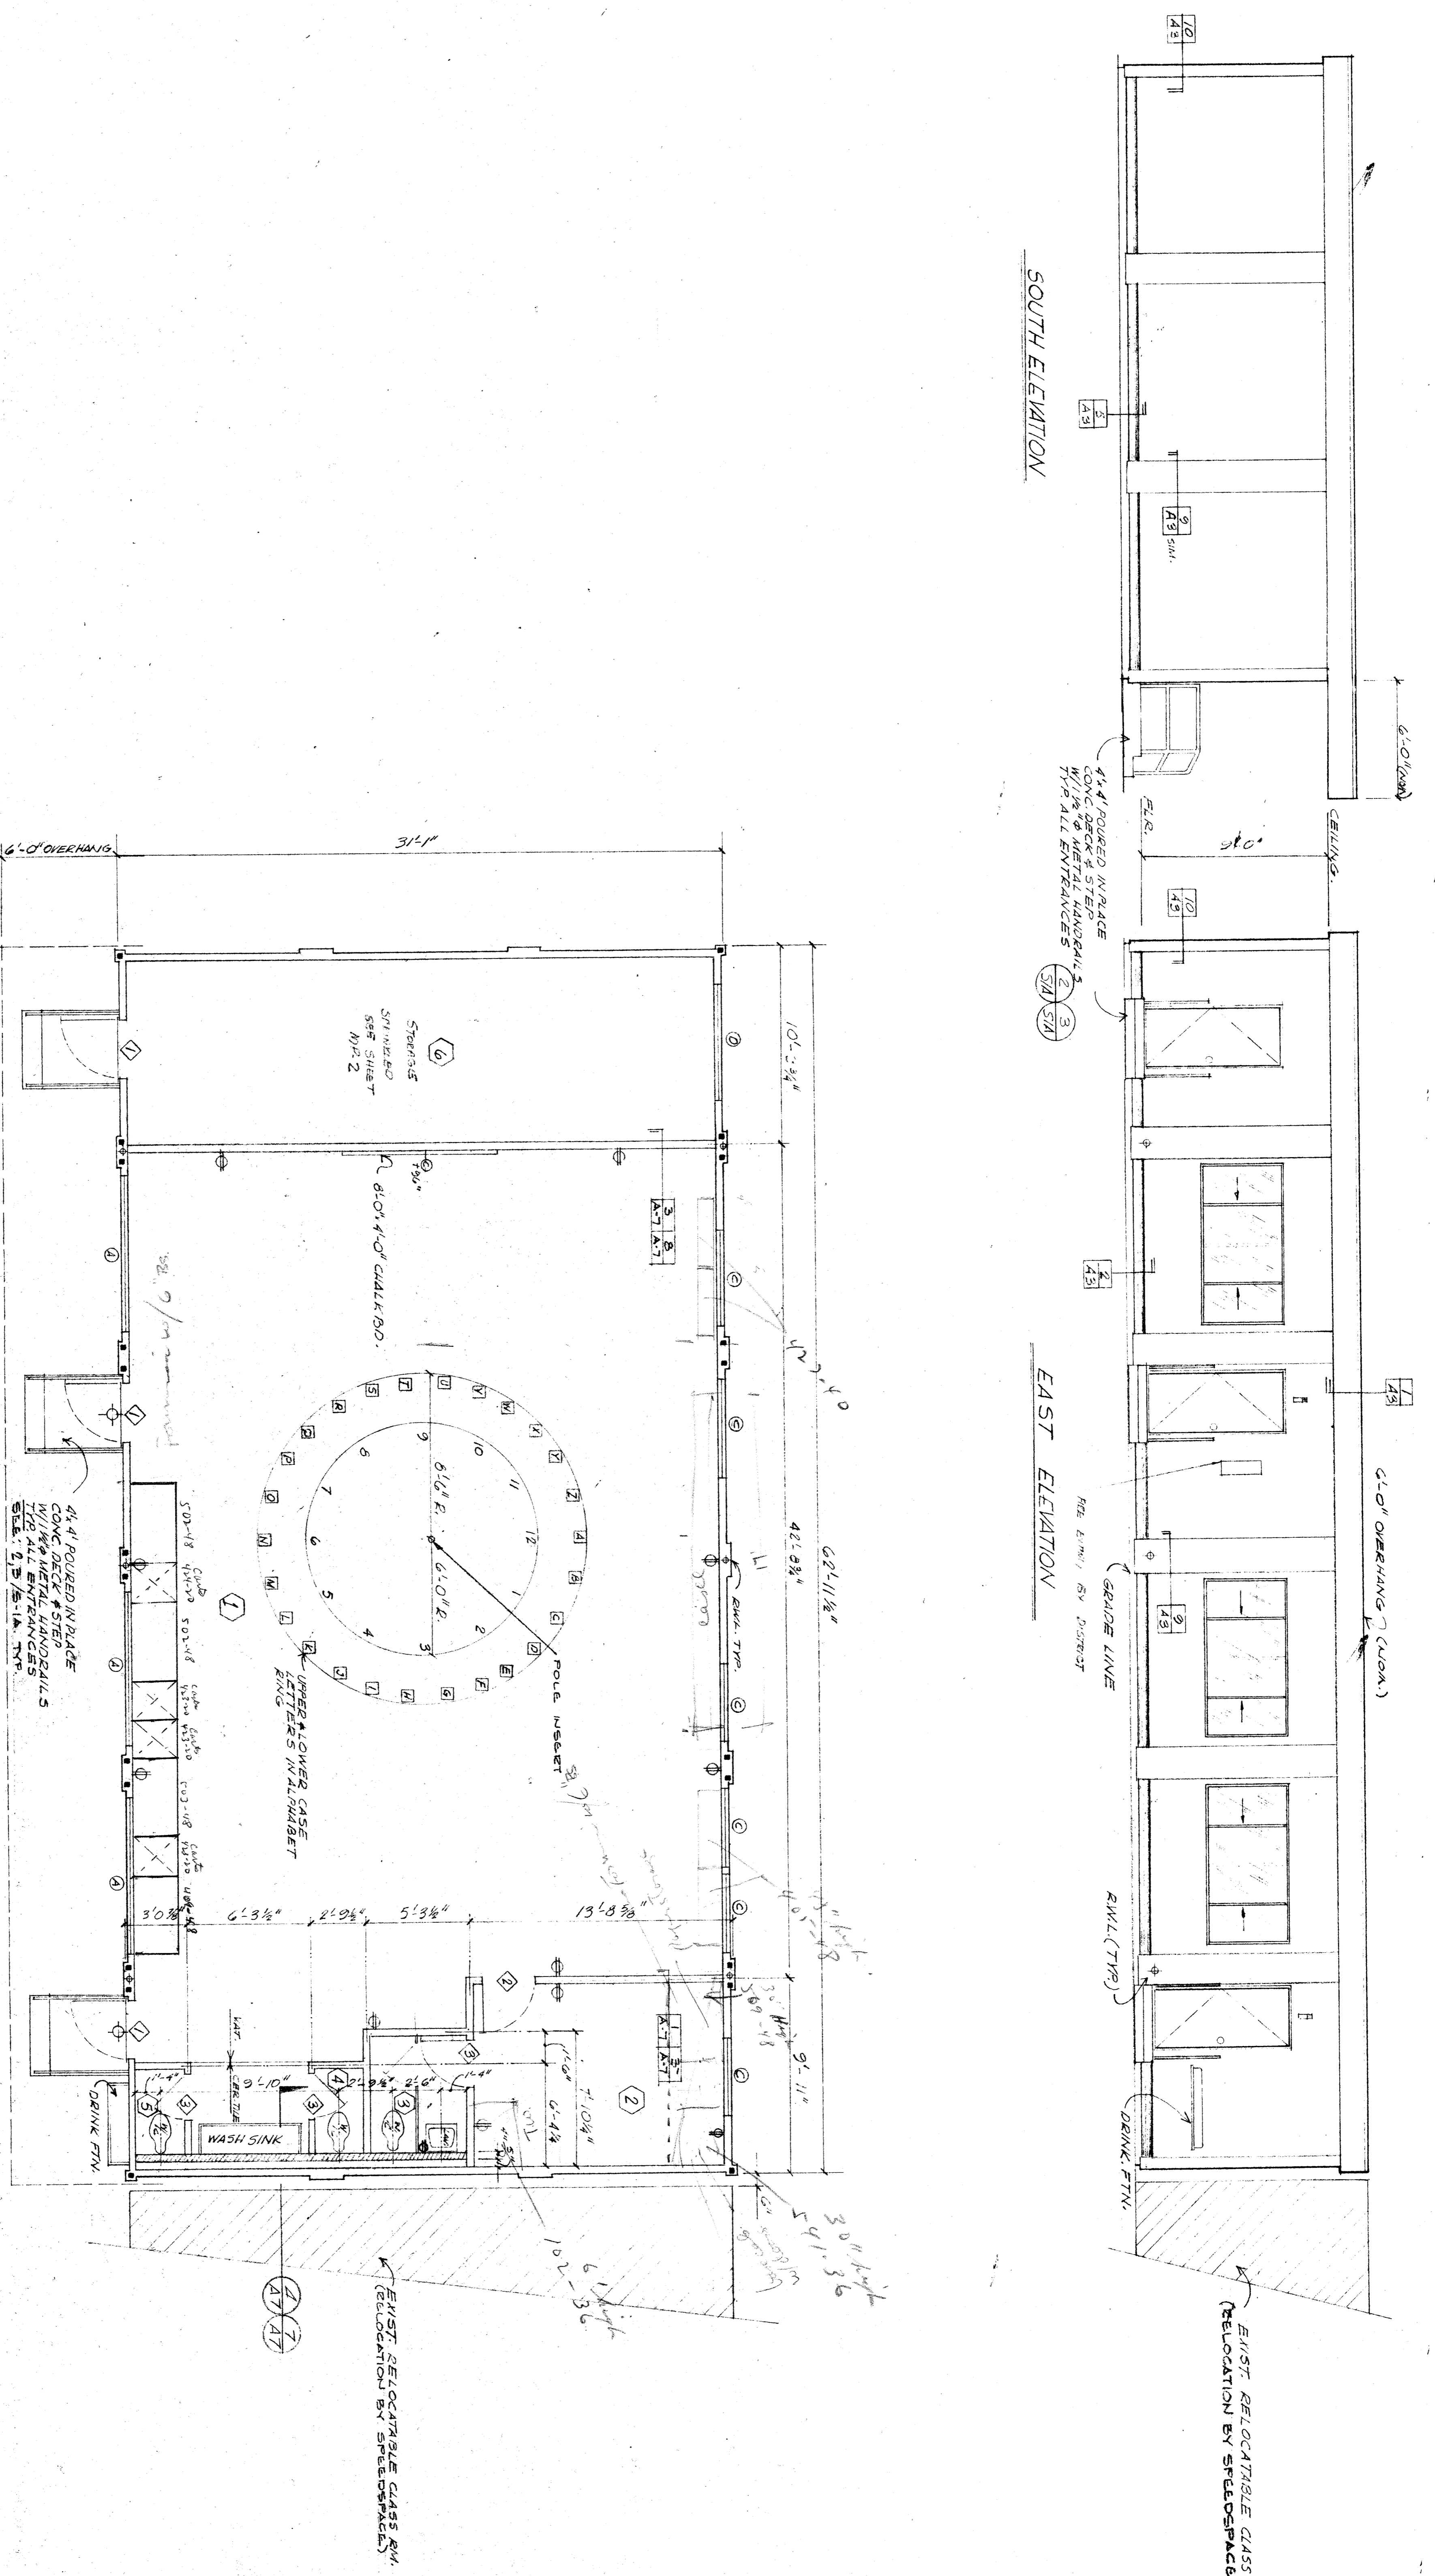

DATE	NO.	DESCRIPTION
12-22-62	1	REFERENCE PLAN

The acceptance of this plan set constitutes agreement that the design, shop drawing and specifications for the project noted shall be used solely for the project indicated. It is not to be used for any other project without the written consent of Speedspace Corporation.

APPROVED BY
 OFFICE OF ARCHITECTURE & CONSTRUCTION

APPROVED BY
 STATE FIRE MARSHAL

APPROVED BY
 SCHOOL DISTRICT

FLOOR PLAN & ELEVATIONS UNIT #1
 BAKERSFIELD CITY SCHOOL DIST.
 BAKERSFIELD, CALIFORNIA

SPEEDSPACE CORPORATION
 RELOCATABLE BUILDINGS
 P.O. Box 590 - Santa Rosa, California 95401
 Telephone (707) 544-1541

ATC
 Licensed Architect
 No. 100
 State of California

SPEEDSPACE JOB NO. 59-132-S
 SHEET NO. A-1
 3 OF 31