


FLOOR PLAN UNITS 2,3
SCALE 1/8" = 1'-0"

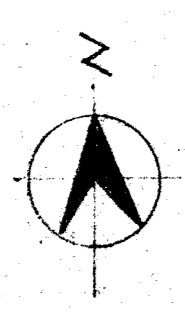

BY	REVISIONS	DATE	NO.	SET NO.
E.G.T. REVISED	FEEL ARCHITECTS CHECK SET	02-23-95	1	REFERENCE PLAN

The acceptance of this plan and conditions agreement that the design, shop drawing and specifications for the project shall be used solely for said project and shall not be exhibited, delivered or transferred to anyone or used for additional projects in whole or in part without the written consent of Speedspace Corporation.

APPROVED BY: [Signature]
OFFICE OF ARCHITECTURE & CONSTRUCTION

APPROVED BY: [Signature]
STATE FIRE MARSHAL

APPROVED BY: [Signature]
\$4000-123456789

FLOOR PLAN & ELEVATION UNITS # 2&3
BAKERSFIELD CITY SD.
BAKERSFIELD, CALIFORNIA

SPEEDSPACE CORPORATION
RELOCATABLE BUILDINGS
P.O. Box 590 - Shell Beach, California 94941
Telephone (707) 544-1541

ATC
Licensed Professional Architect
SHEET NO. **A-1-A**
4 OF 31
SPEEDSPACE JOB NO. 23