




1 FOUNDATION AND SHEARWALL PLAN
 SCALE: 1/8" = 1'-0"

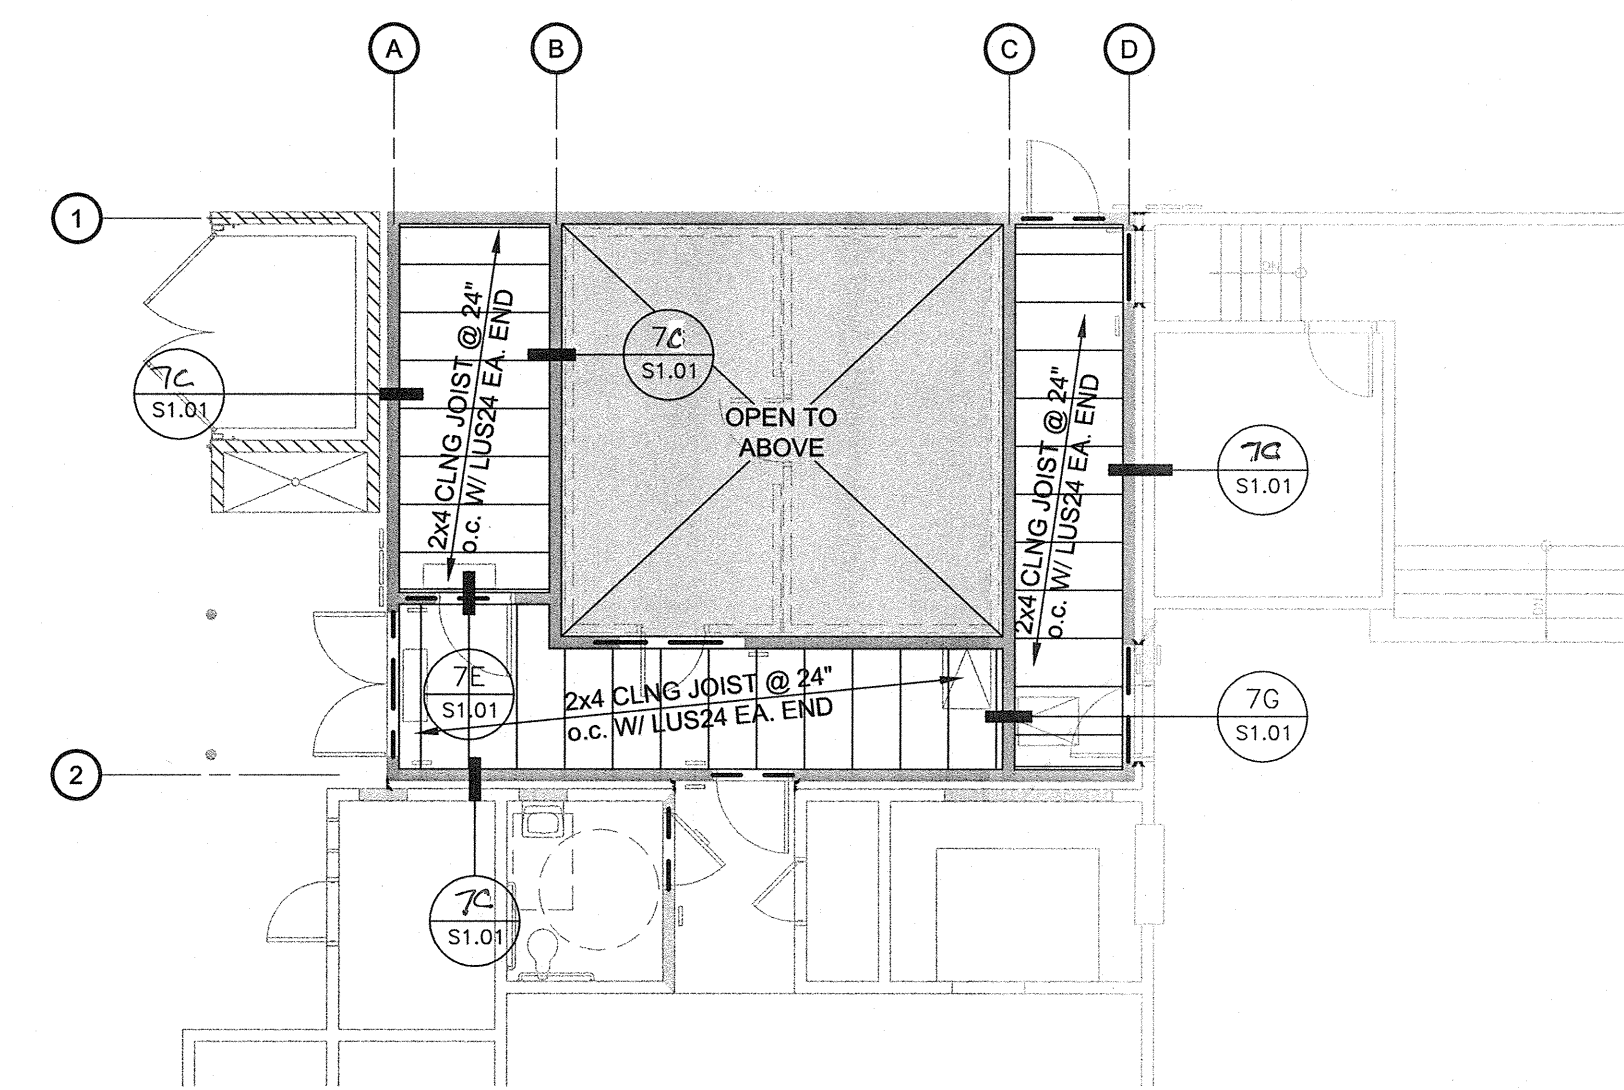

2 CEILING FRAMING PLAN
 SCALE: 1/8" = 1'-0"

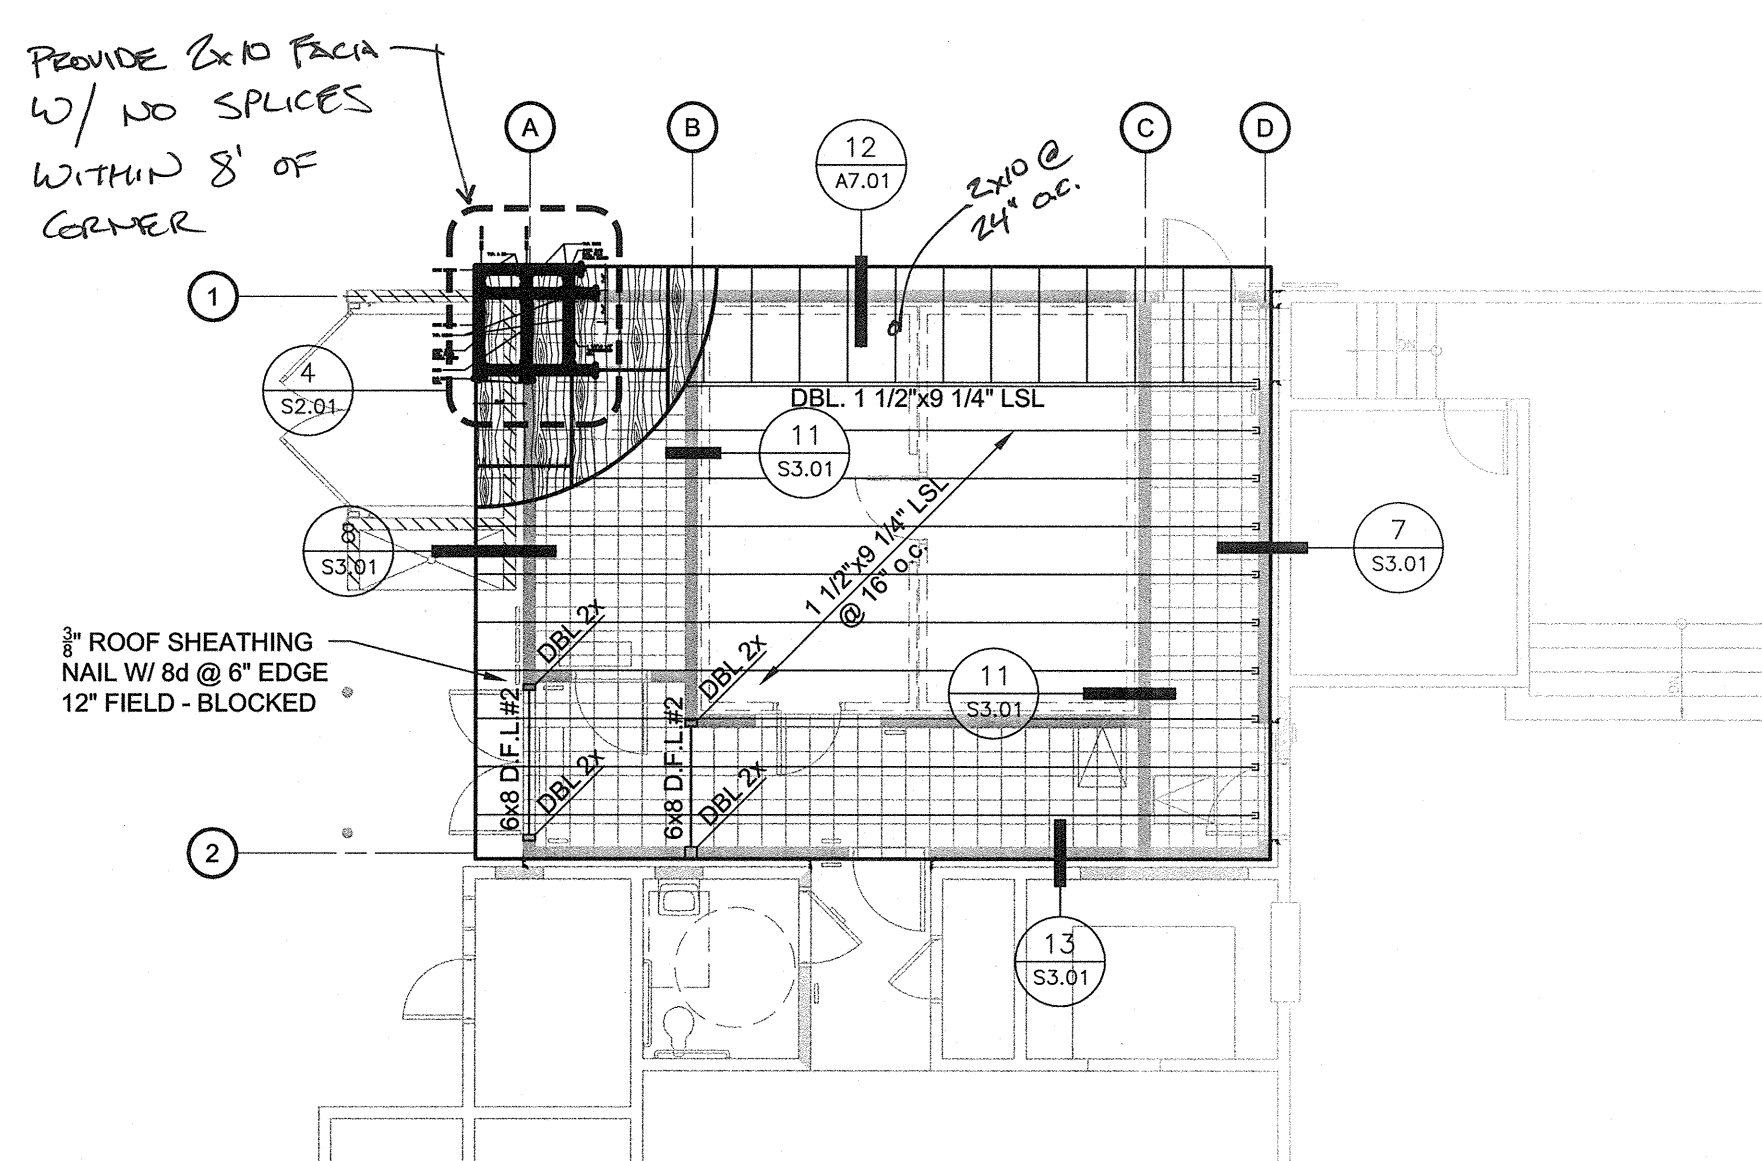

3 ROOF FRAMING PLAN
 SCALE: 1/8" = 1'-0"

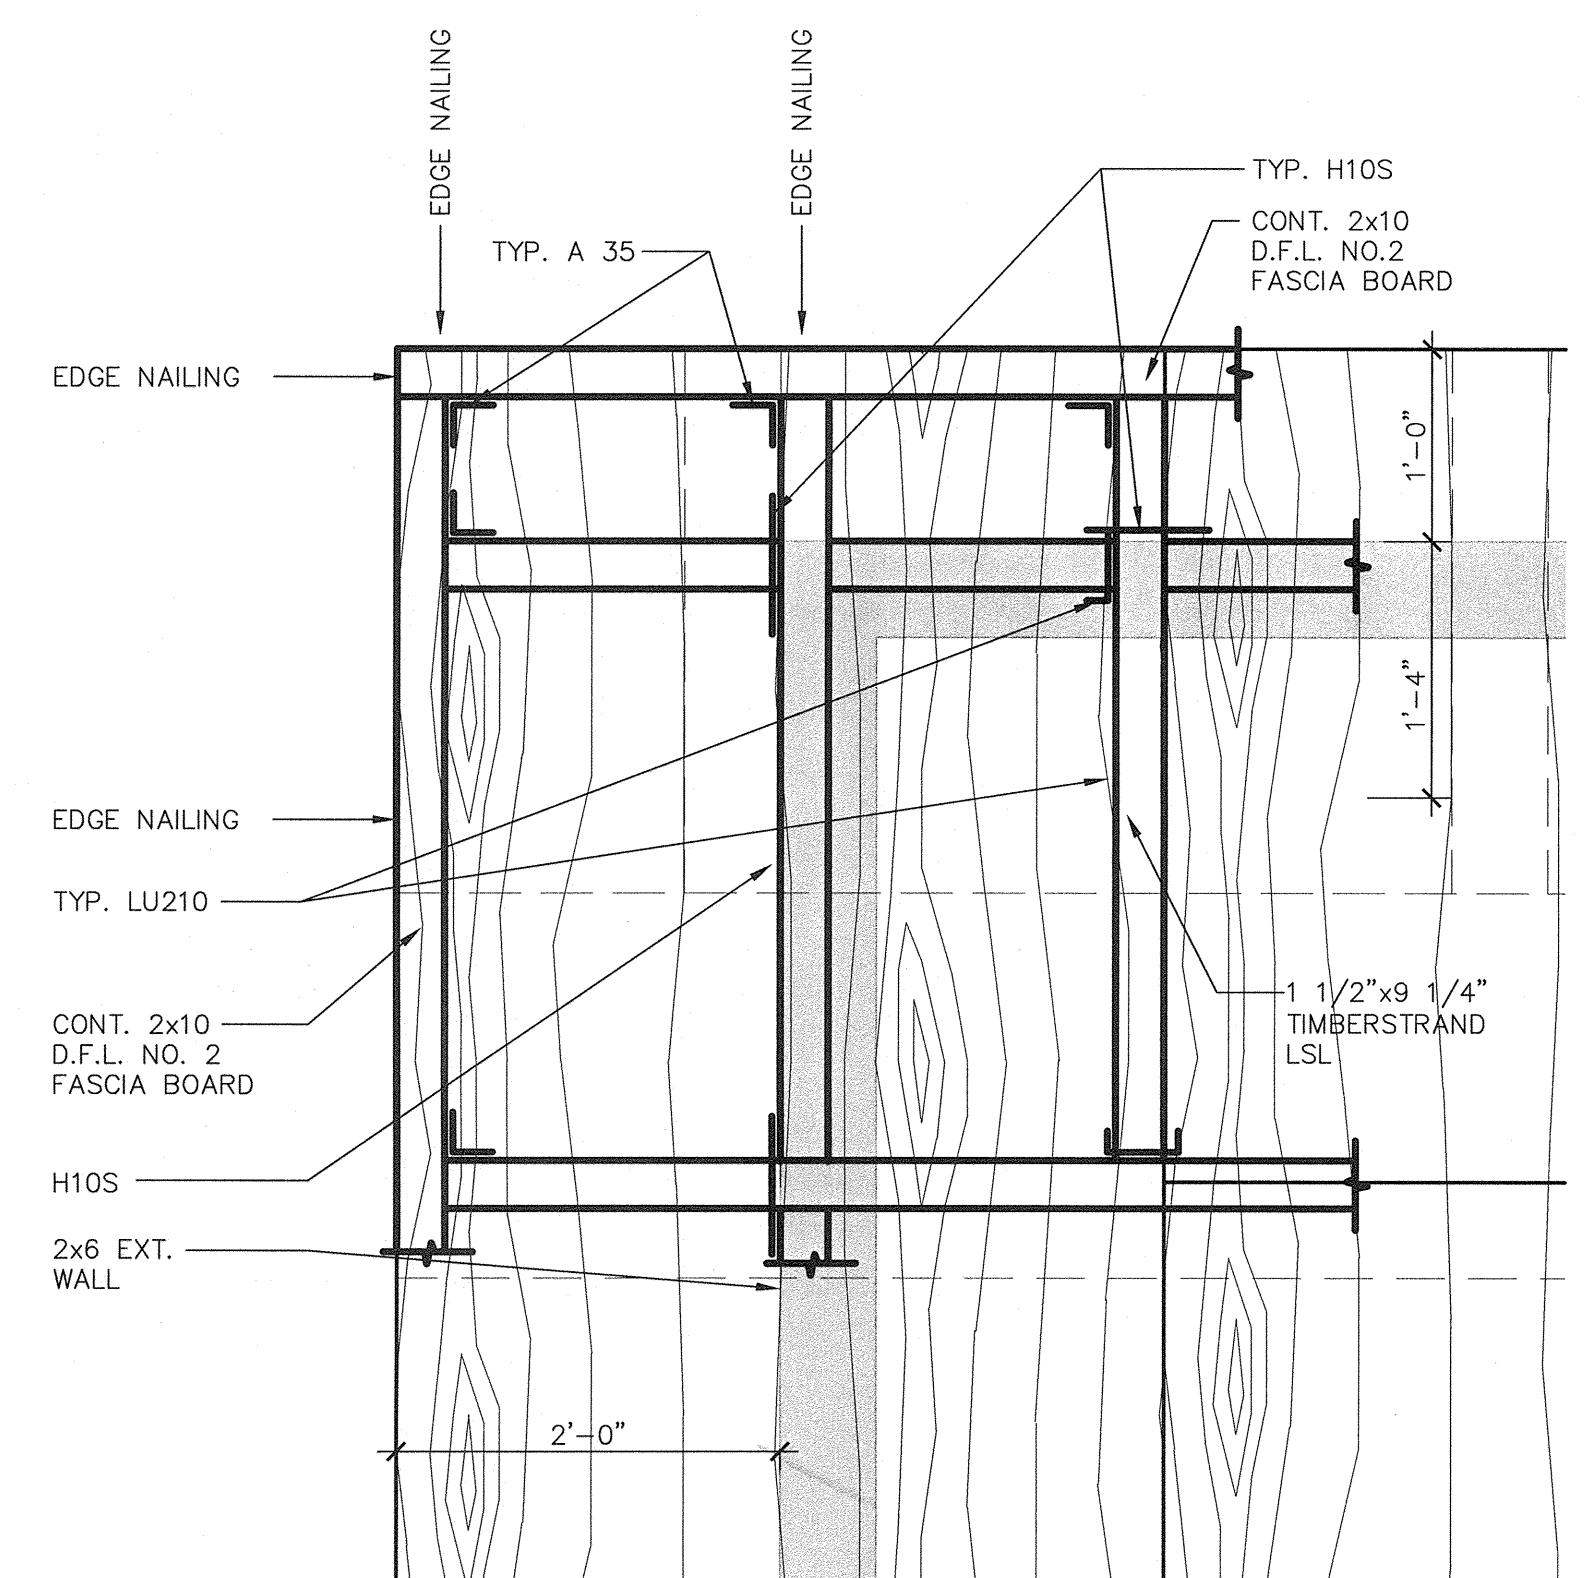

4 ROOF CORNER FRAMING
 SCALE: 1" = 1'-0"

HOLDOWN SCHEDULE

| SYMB | TYPE |
|------|---|
| ▲ | SIMPSON HTT4 WITH #10 HEAVY HEX HEAD ANCHOR BOLT (9" EMBED.) SEE 4/S1.02 SM. AND USING 18 - 16d x 2 1/2" FASTENERS TO SINGLE 4 x 6 STUD |

SHEARWALL SCHEDULE

| SYMB | TYPE |
|------|--|
| ⊗ | 3/8" THK. STRUCT I SHEATHING W/ 8d NAILS, 6" o.c. ALL EDGES AND 12" o.c. AT FIELDS BLOCKED PROVIDE #6 L ANCHOR BOLTS @ 48" o.c. MAX AND MIN. (4) ANCHORS PER SHEARWALL (7" MIN EMBEDMENT) |

FOOTING SCHEDULE

| LINE | SIZE | REINFORCEMENT |
|------|-------------------------------------|------------------|
| A | 16" WIDE 18" BELOW UNDISTURBED SOIL | (2) #5 CONT. T&B |
| B | 18" WIDE 18" BELOW UNDISTURBED SOIL | (2) #5 CONT. T&B |
| C | 18" WIDE 18" BELOW UNDISTURBED SOIL | (2) #5 CONT. T&B |
| D | 16" WIDE 18" BELOW UNDISTURBED SOIL | (2) #5 CONT. T&B |
| 1 | 16" WIDE 18" BELOW UNDISTURBED SOIL | (2) #5 CONT. T&B |
| 2 | 16" WIDE 18" BELOW UNDISTURBED SOIL | (2) #5 CONT. T&B |

FOUNDATION NOTES

- A. SEE NOTES & DETAILS ON SHEET S1.01 & S1.02
- B. DIMENSIONS ARE TO CENTERLINE OF COLUMN OR FACE OF STUD UNLESS OTHERWISE NOTED.
- C. TOP OF FOOTING ELEV. TO BE AT (-) 0'-6" UNLESS OTHERWISE NOTED.
- D. REFER TO SITE PLAN FOR LOCATION AND DIMENSIONS OF SIDEWALKS, MOWSTRIPS, AND PLANTERS.
- E. INDICATES AREA OF DEPRESSED SLAB SEE 3/S1.02 FOR TYP. PERIMETER SECTION. U.N.O.
- F. FOR METHOD OF POUR OF CONCRETE SLABS ON GRADE, AND LOCATION OF CONTROL AND CONSTRUCTION JOINTS SEE 6/S1.02.
- G. FOR REBAR SPLICE REQUIREMENTS SEE 1/S1.02.
- H. REBAR BENDING AND FABRICATION TO BE PER 12, 13, 14, 15/S1.02
- I. COORDINATE ALL FLOOR DRAINS WITH ARCHITECTURAL, MECHANICAL AND PLUMBING DRAWINGS.
- J. PENETRATION OF FOOTINGS WITH PLUMBING PER 10/S1.02.
- K. NOT USED
- L. FOUNDATIONS TO BE FORMED PER 2/S1.02
- M. VERIFY ALL DIMENSIONS W/ ARCH. PLANS.
- N. CONTRACTOR TO VERIFY WIDTH OF ALL DOOR OPENINGS.
- O. FOR CONSTRUCTION JOINT IN CONTINUOUS FOOTINGS SEE 8/S1.02.
- P. ALL COLUMNS AND WALLS ARE TO BE CENTERED ON PADS AND FOOTINGS RESPECTIVELY, U.N.O.
- Q. ALL EMBEDDED ITEMS SHALL BE IN PLACE AND SECURE PRIOR TO POURING OF CONCRETE.
- R. REFER TO DETAIL 4/S1.01 FOR NON-BEARING WALLS AT SLAB.

Ownership of Documents
 This document, the ideas and designs incorporated herein, as an instrument of Professional Service is the property of Integrated Designs by SOMAM, Inc. and is not to be used, in whole or in part for any other project without written authorization. © COPYRIGHT 2012

integrated designs by SOMAM, Inc.
 ARCHITECTURE - ENGINEERING - INTERIOR DESIGN - CONSTRUCTION MANAGEMENT
 6011 N. Fresno, Suite 130 - Fresno, California 93710
 Phone (559) 436-0881 Fax (559) 436-0887 E-Mail: design@somam.com
 www.integrateddesigns.com

| Rev. Date | Revision Description |
|-----------|----------------------|
| | |
| | |
| | |

STRUCTURAL PLANS
 MT. VERNON ELEMENTARY SCHOOL
 KITCHEN ADDITION
 BAKERSFIELD CITY SCHOOL DISTRICT
 2161 POTOMAC AVENUE BAKERSFIELD CA.

Sheet Title: **STRUCTURAL PLANS**
 Date: 07/20/12
 Designer: [Signature]
 Checker: [Signature]
 P.C.: CJM

FILE # 15-6
 IDENTIFICATION STAMP
 DIV. OF THE STATE ARCHITECT
 OFFICE OF REGULATION SERVICES
 03-114521
 AC: FLS SS
 DATE: 8/1/12
 TRACKING #: 63321-118

Stamp(s):

Job No.: **3990**
 Sheet No.: **S2.01**
 Release: -

C:\2011\11\11-3990\Sheets\3990-S2.01.dwg CURTIS MCNALLY