



### HEADER SCHEDULE

CLEAR SPAN OF OPENING	HEADER SIZE	NUMBER OF TRIMMERS	NUMBER OF KING STUDS		NUMBER OF SILL PLATES	
			EXTER.	INTER.	EXTER.	INTER.
UP TO 4'-0"	6x4	1	1	1	1	1
4'-1" TO 6'-0"	6x8	1	2	2	1	1


- NOTES:**
- NOT USED
  - DETAILS AND MEMBER SIZES ARE TYPICAL UNLESS OTHERWISE NOTED OR DETAILED.
  - NOTES AND MEMBER SIZES SHOWN ON FRAMING PLANS SHALL TAKE PRECEDENCE OVER SCHEDULE.

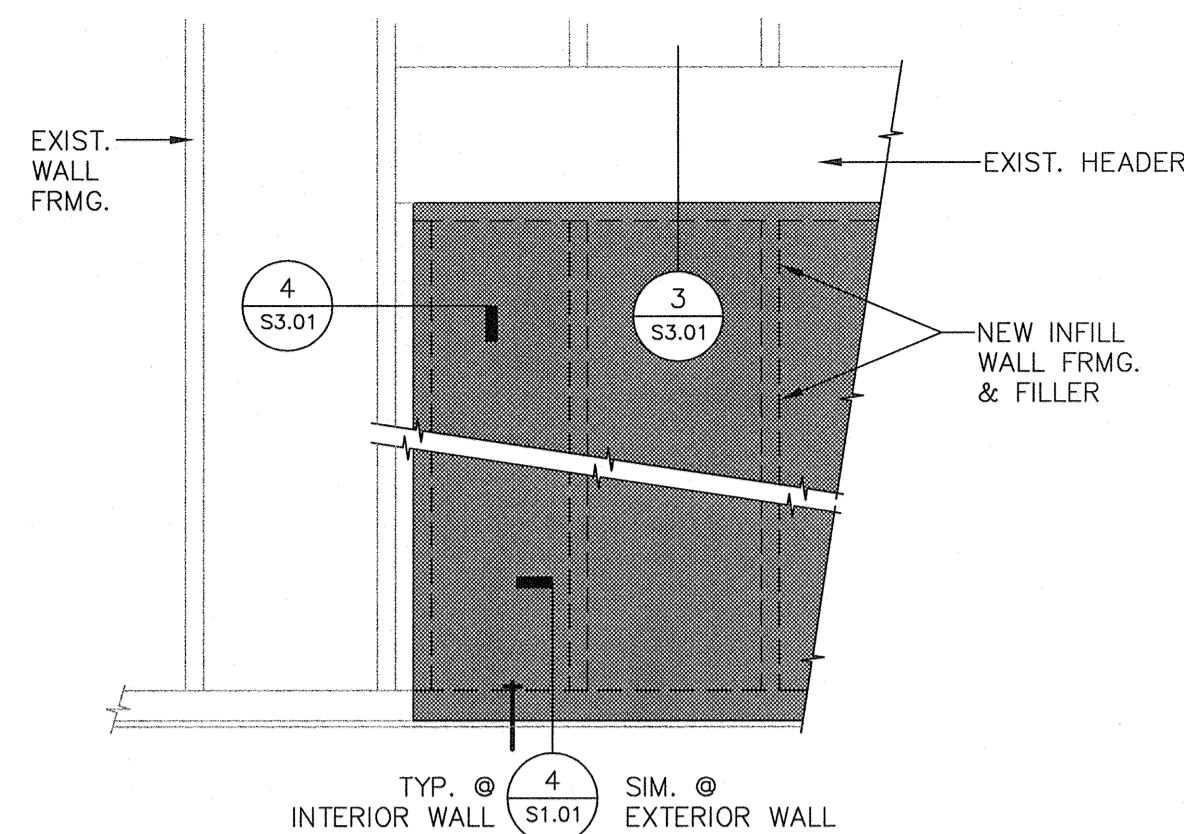


**5 TYP. OPENING INFILL FRAMING ELEVATION**  
 S3.01 SDW141-01 SCALE: 3/4" = 1'-0"

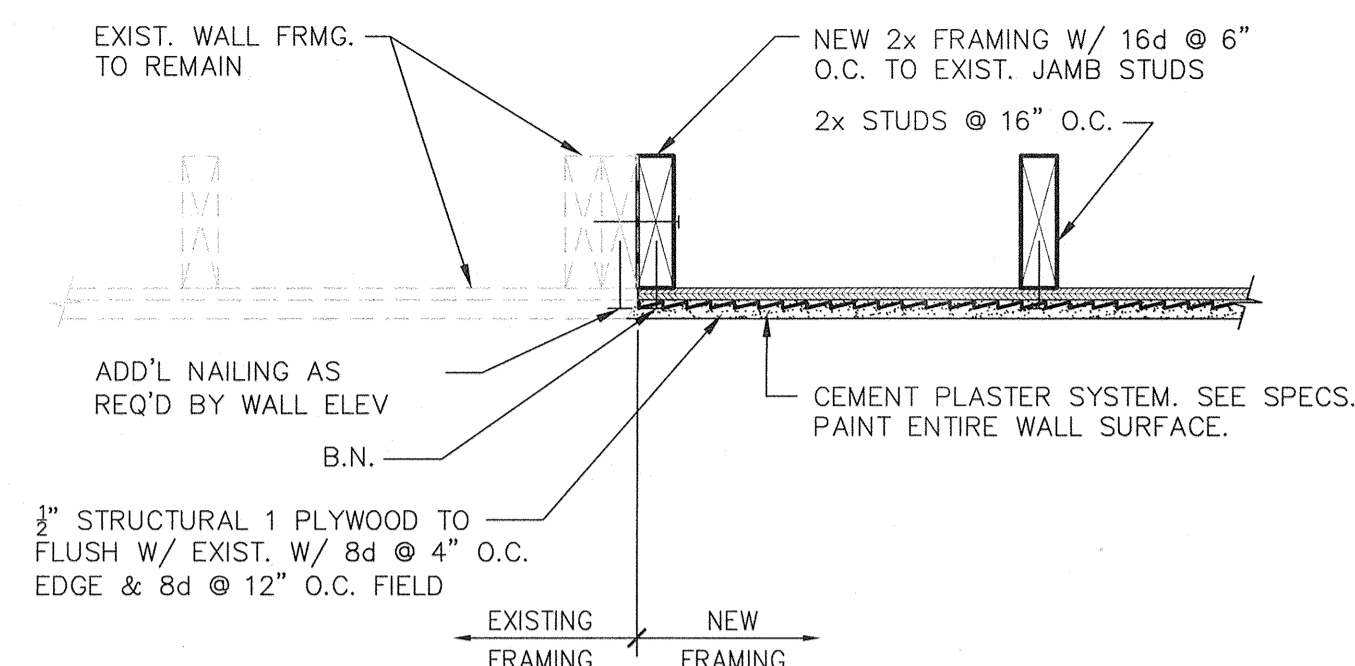


**1 TYPICAL INFILL FRAMING**  
 S3.01 ADW141-21 SCALE: 1 1/2" = 1'-0"

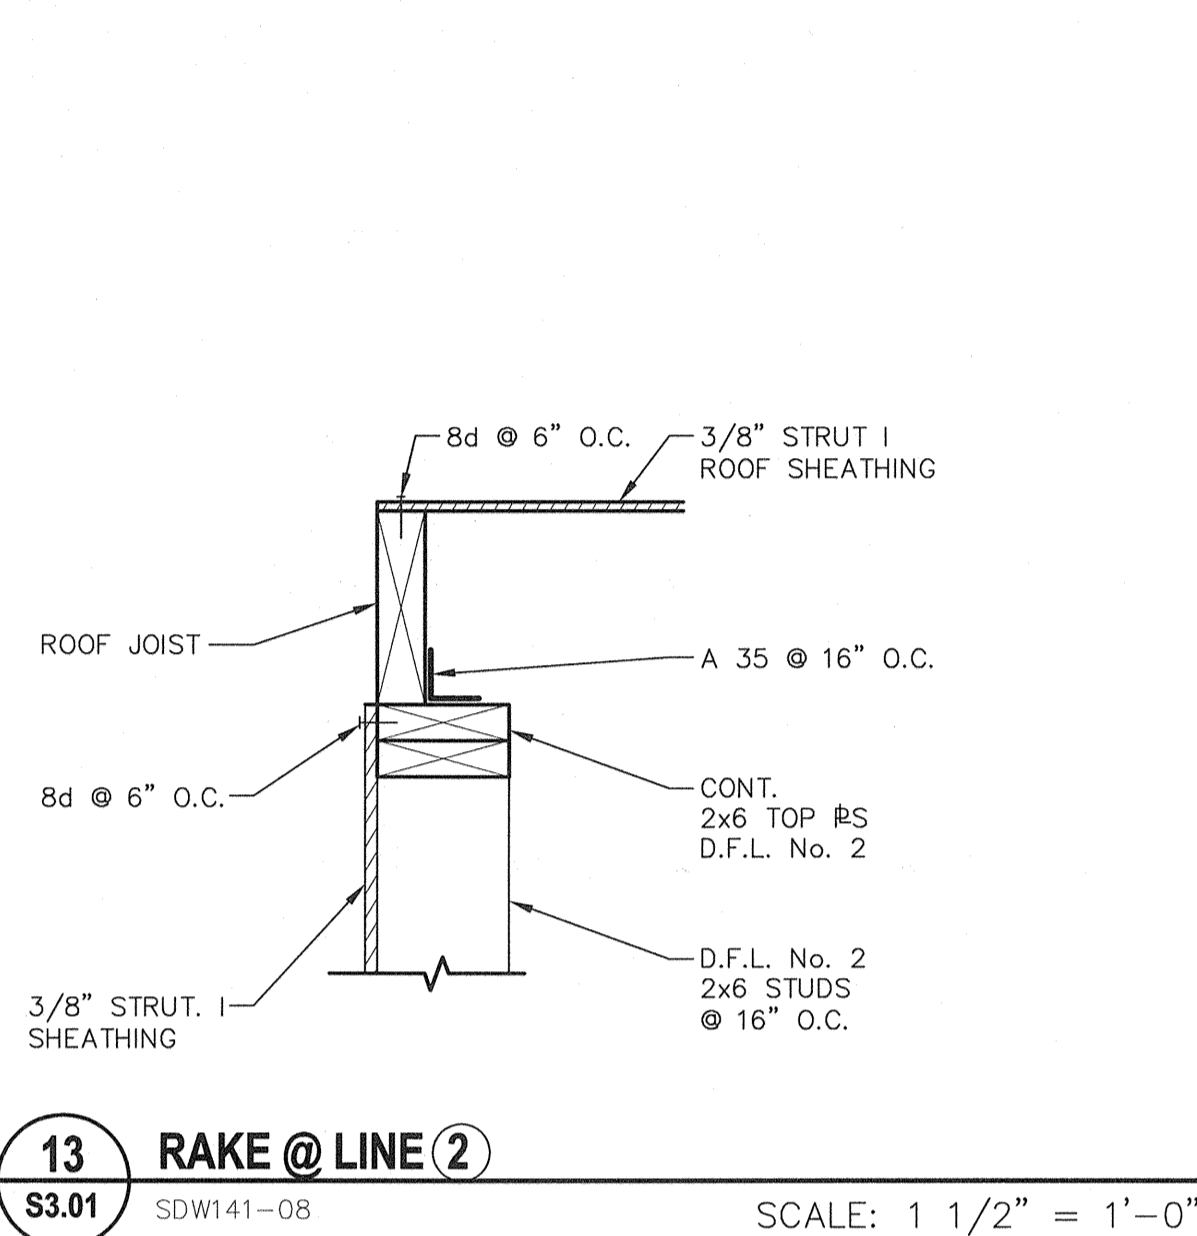


**13 RAKE @ LINE**  
 S3.01 SDW141-08 SCALE: 1 1/2" = 1'-0"

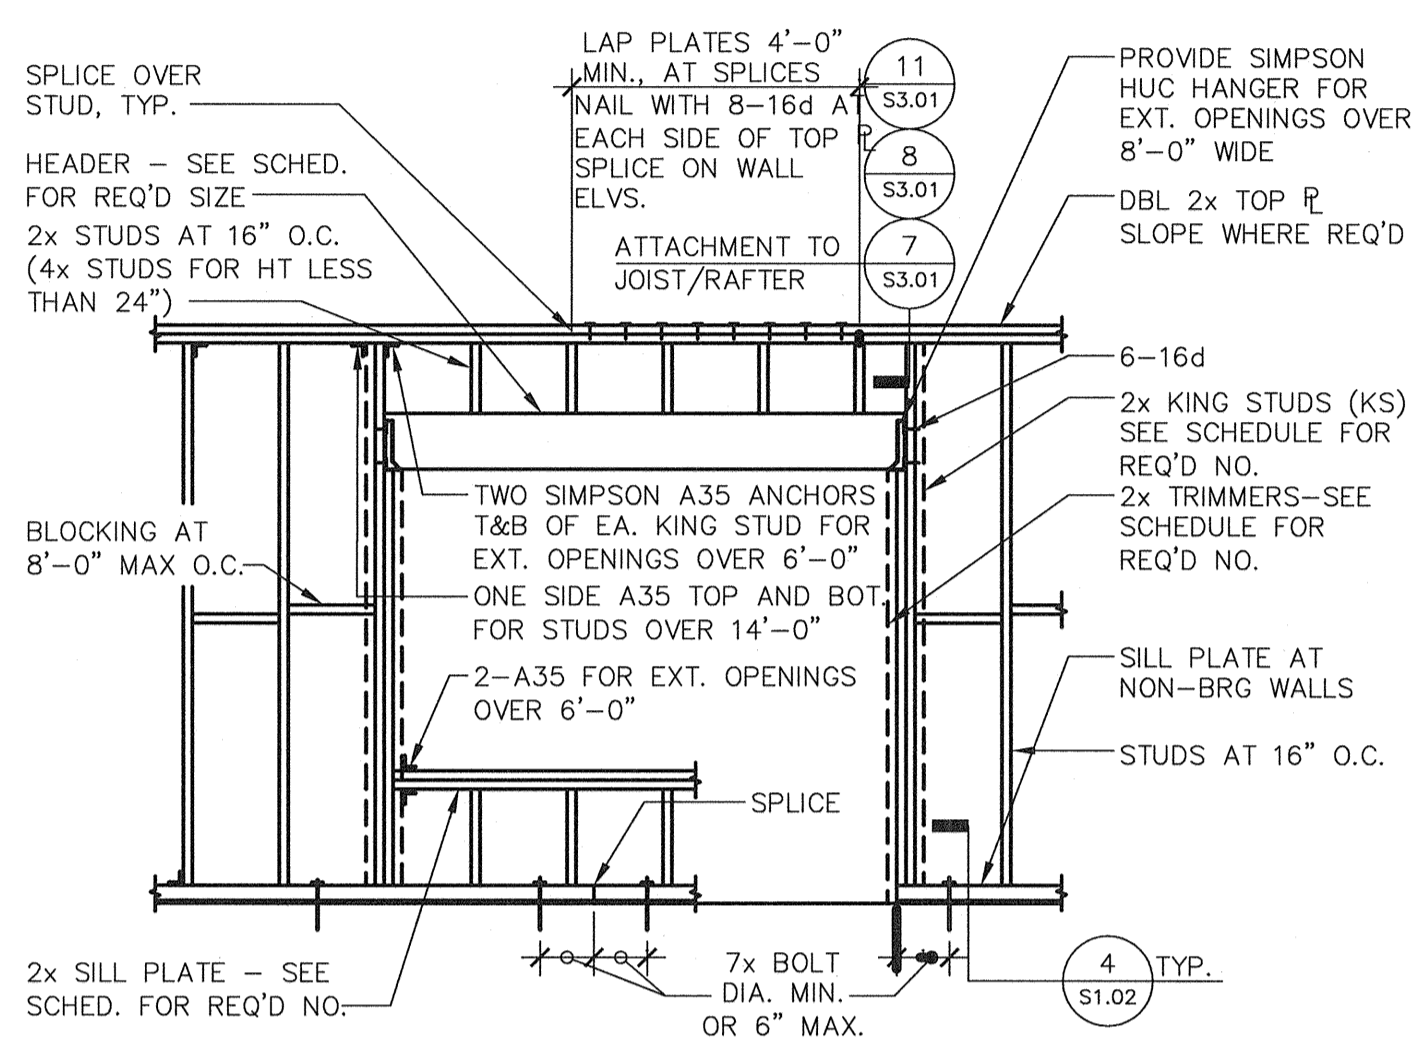


**10 TYPICAL WALL FRAMING**  
 S3.01 SDW240-05 SCALE: 1 1/2" = 1'-0"

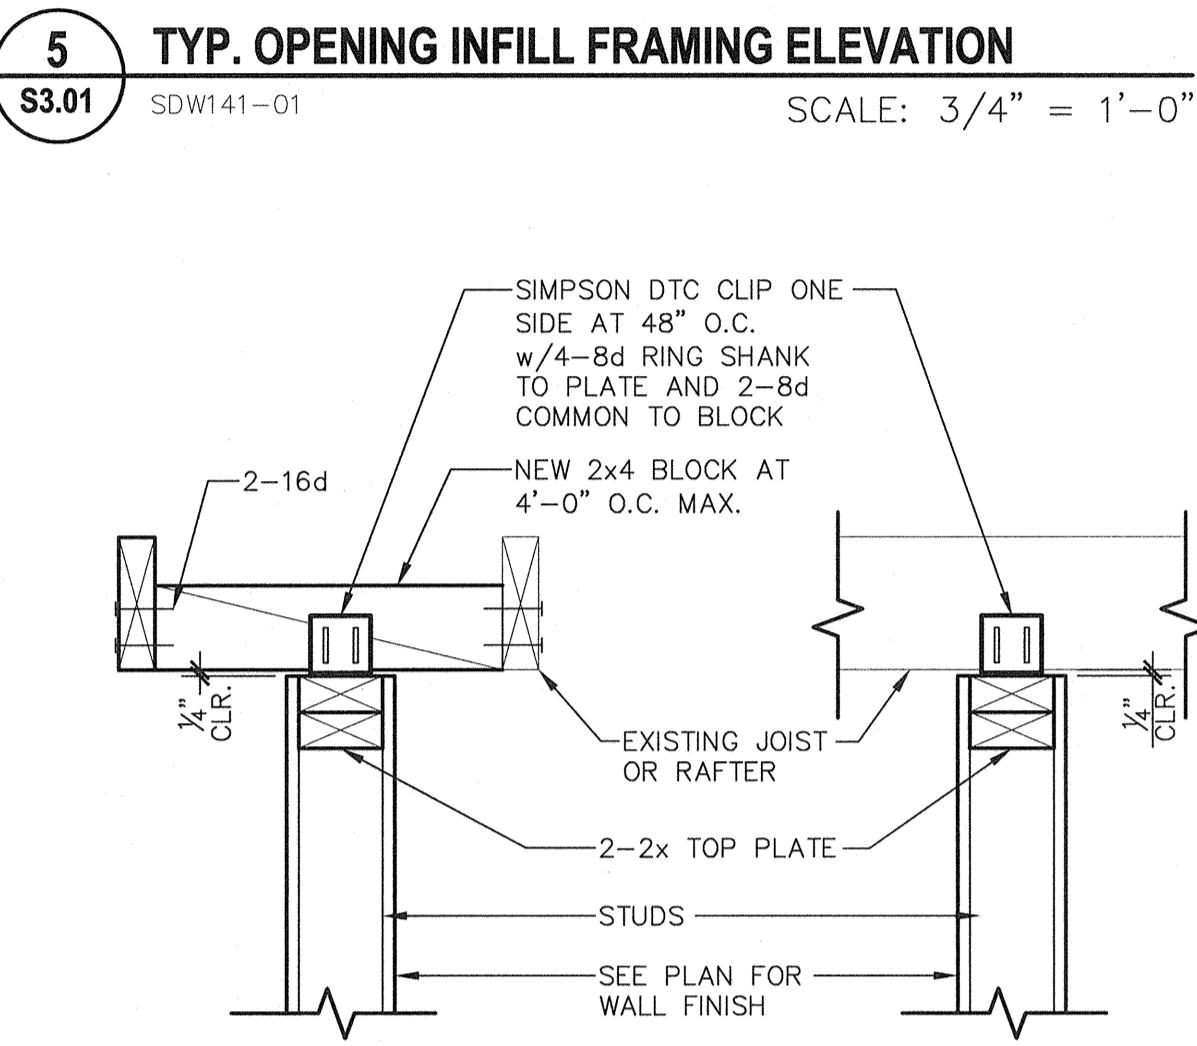


**6 TYPICAL NON-BEARING WALL/ TOP PLATE ATTACHMENT TO FRAMING**  
 S3.01 SDW240-01 SCALE: 1 1/2" = 1'-0"

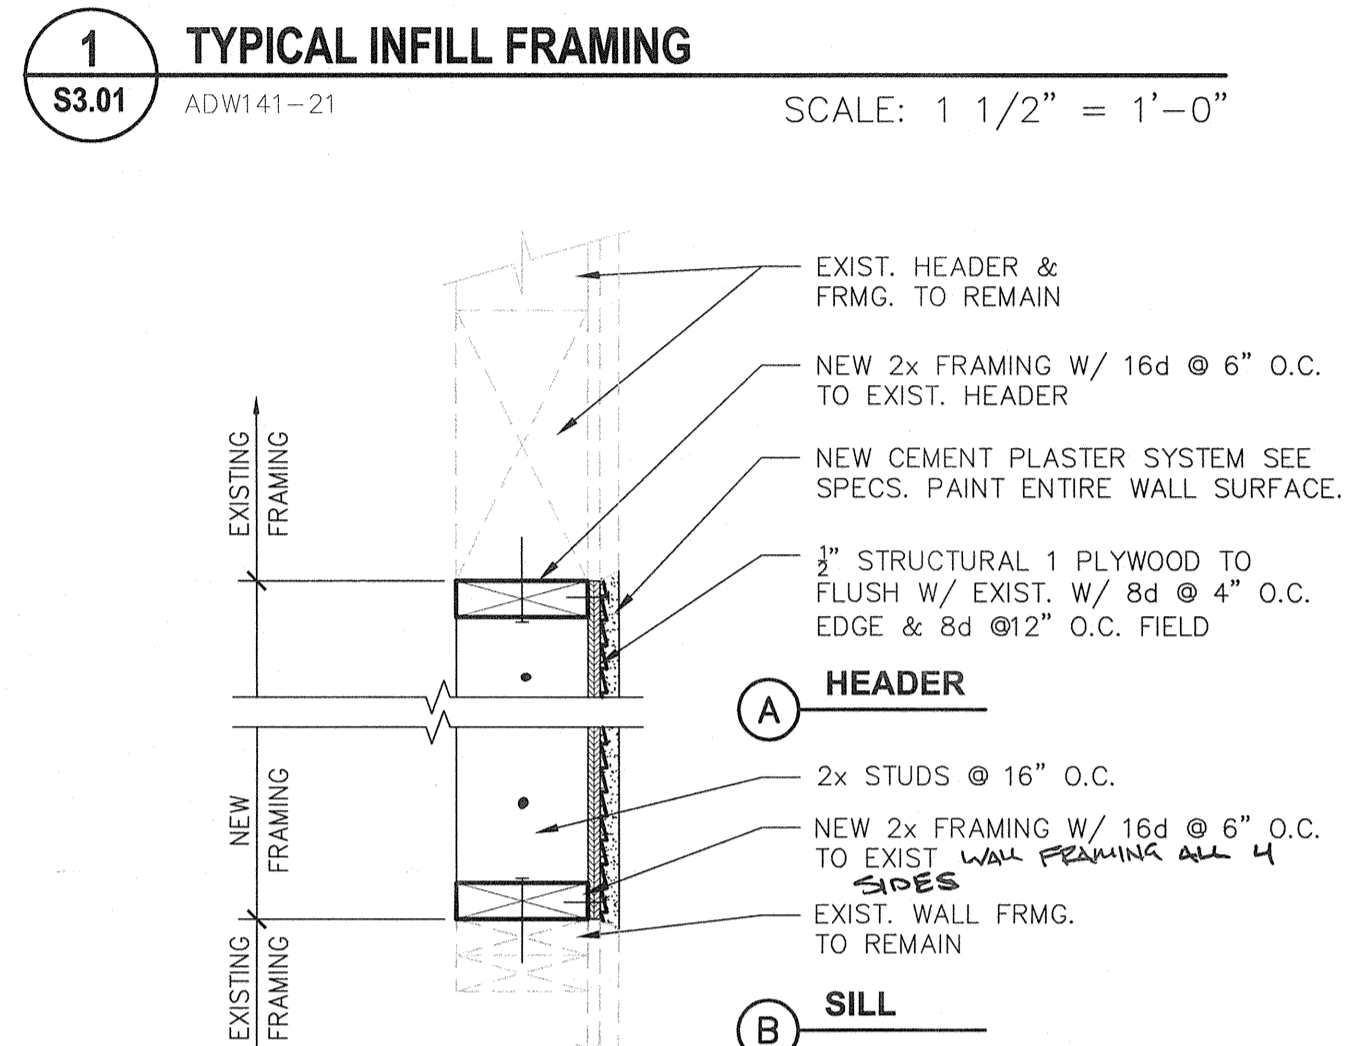


**2 TYPICAL INFILL FRAMING @ HEADER & SILL**  
 S3.01 ADW141-22 SCALE: 1 1/2" = 1'-0"

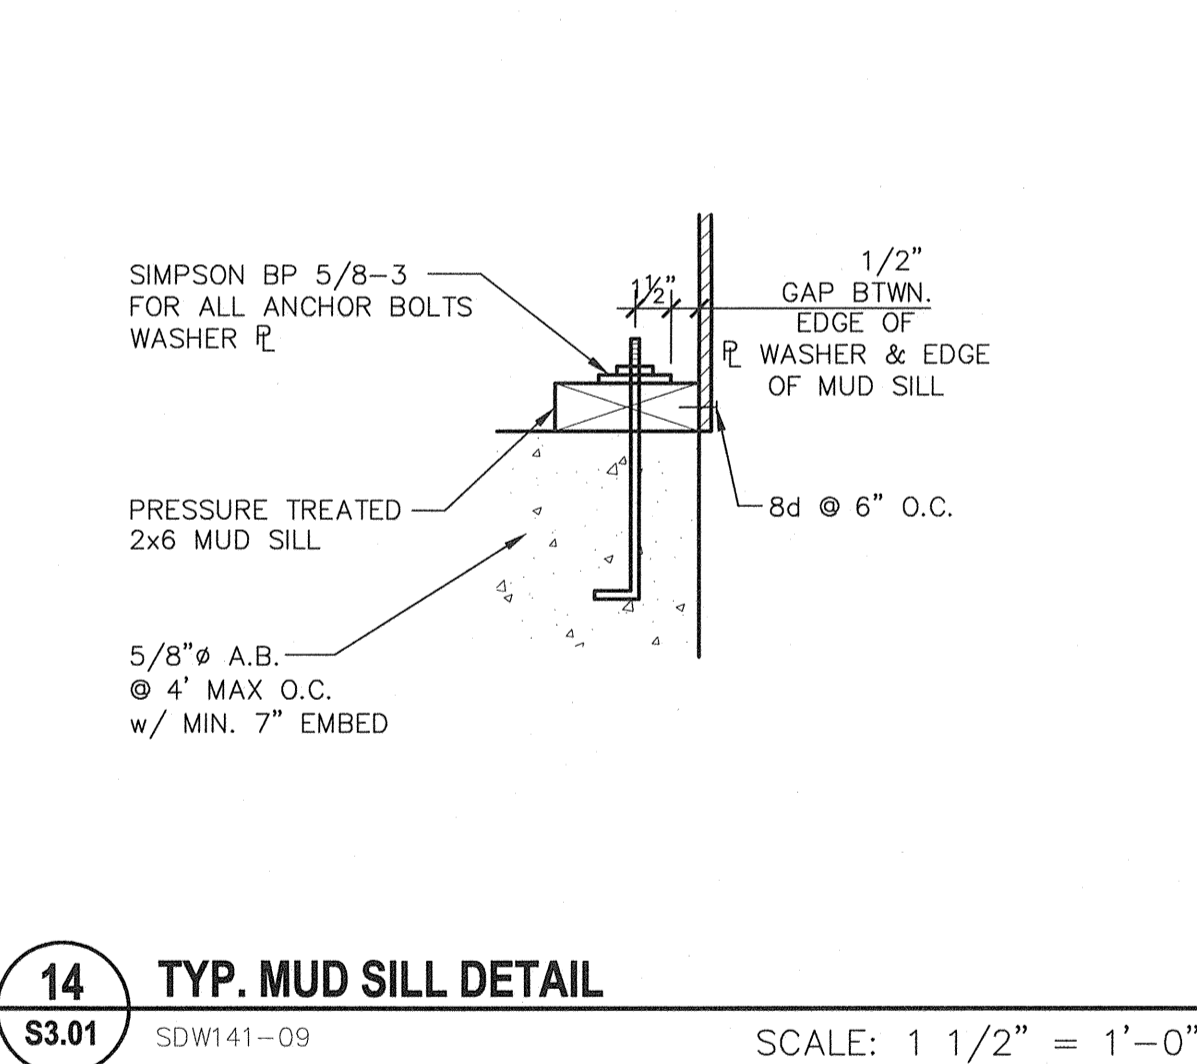


**14 TYP. MUD SILL DETAIL**  
 S3.01 SDW141-09 SCALE: 1 1/2" = 1'-0"

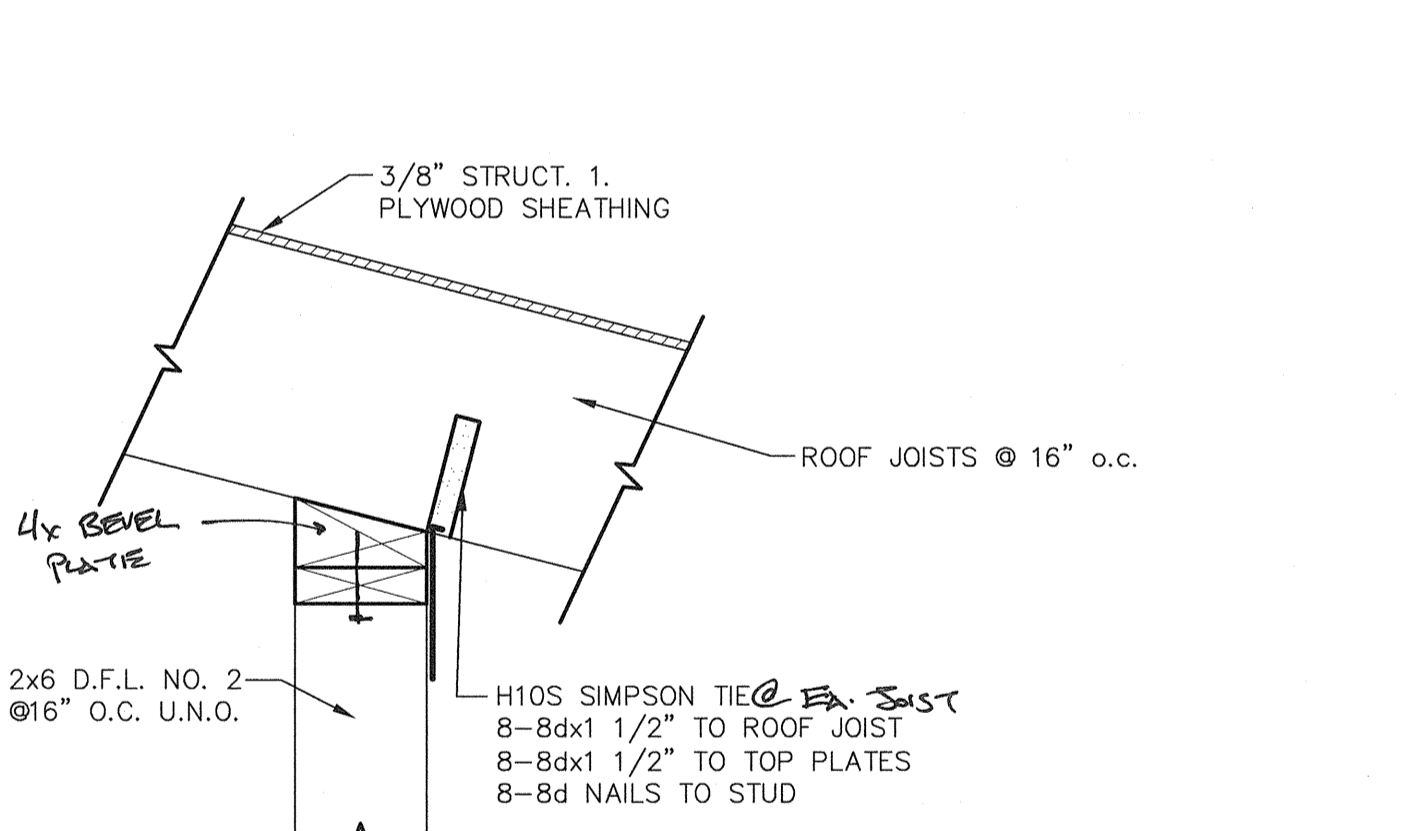


**11 ROOF JOIST @ LINE (B) (C) INT. SUPPORT**  
 S3.01 SDW141-06 SCALE: 1 1/2" = 1'-0"

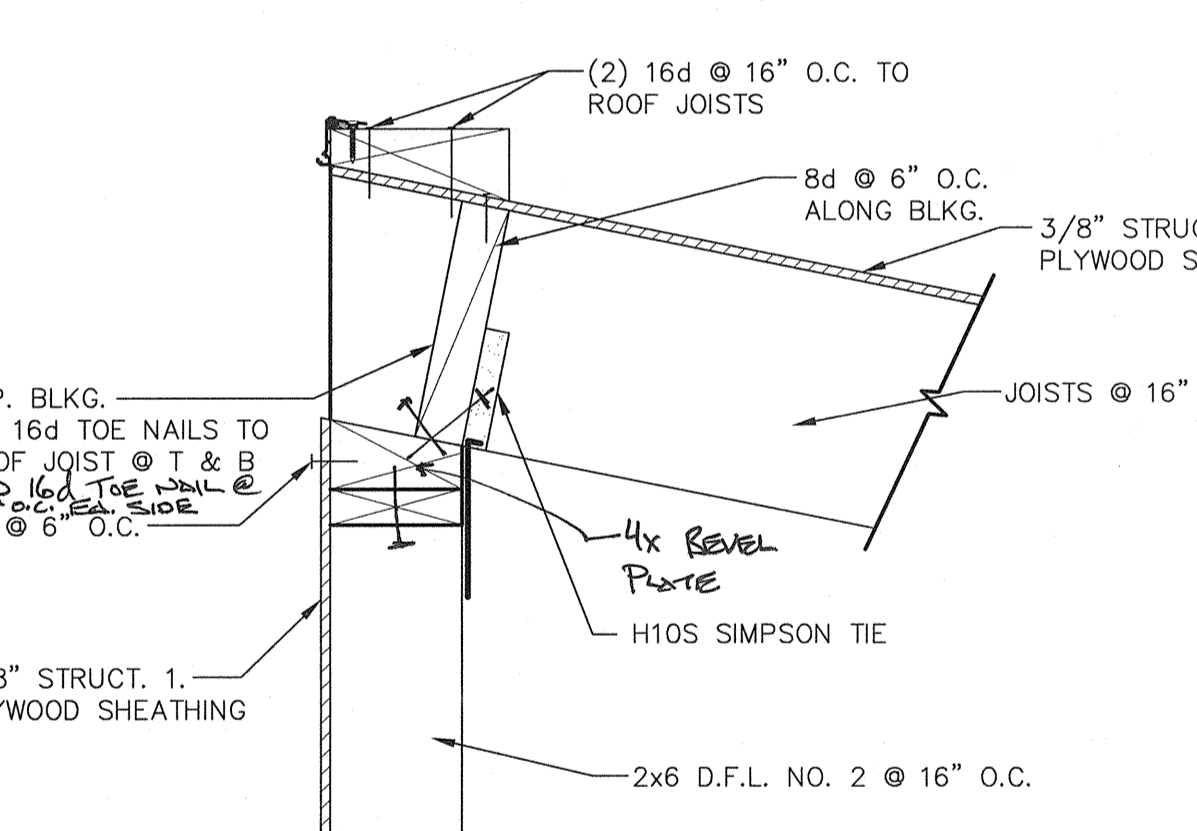


**7 ROOF JOIST @ HIGH EAVE**  
 S3.01 SDW141-10 SCALE: 1 1/2" = 1'-0"

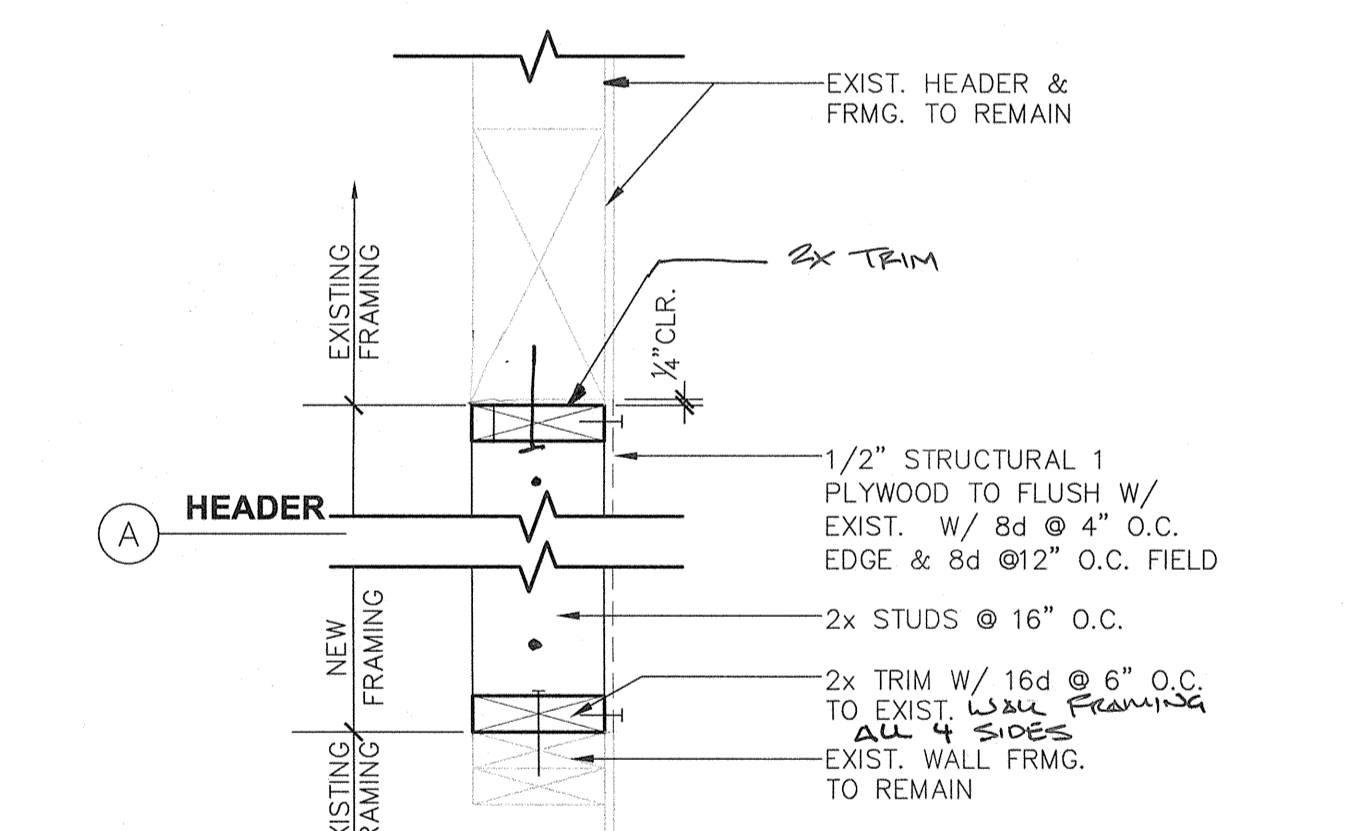


**3 TYPICAL INFILL FRAMING DETAIL @ HEADER & SILL**  
 S3.01 SDW141-02 SCALE: 1 1/2" = 1'-0"

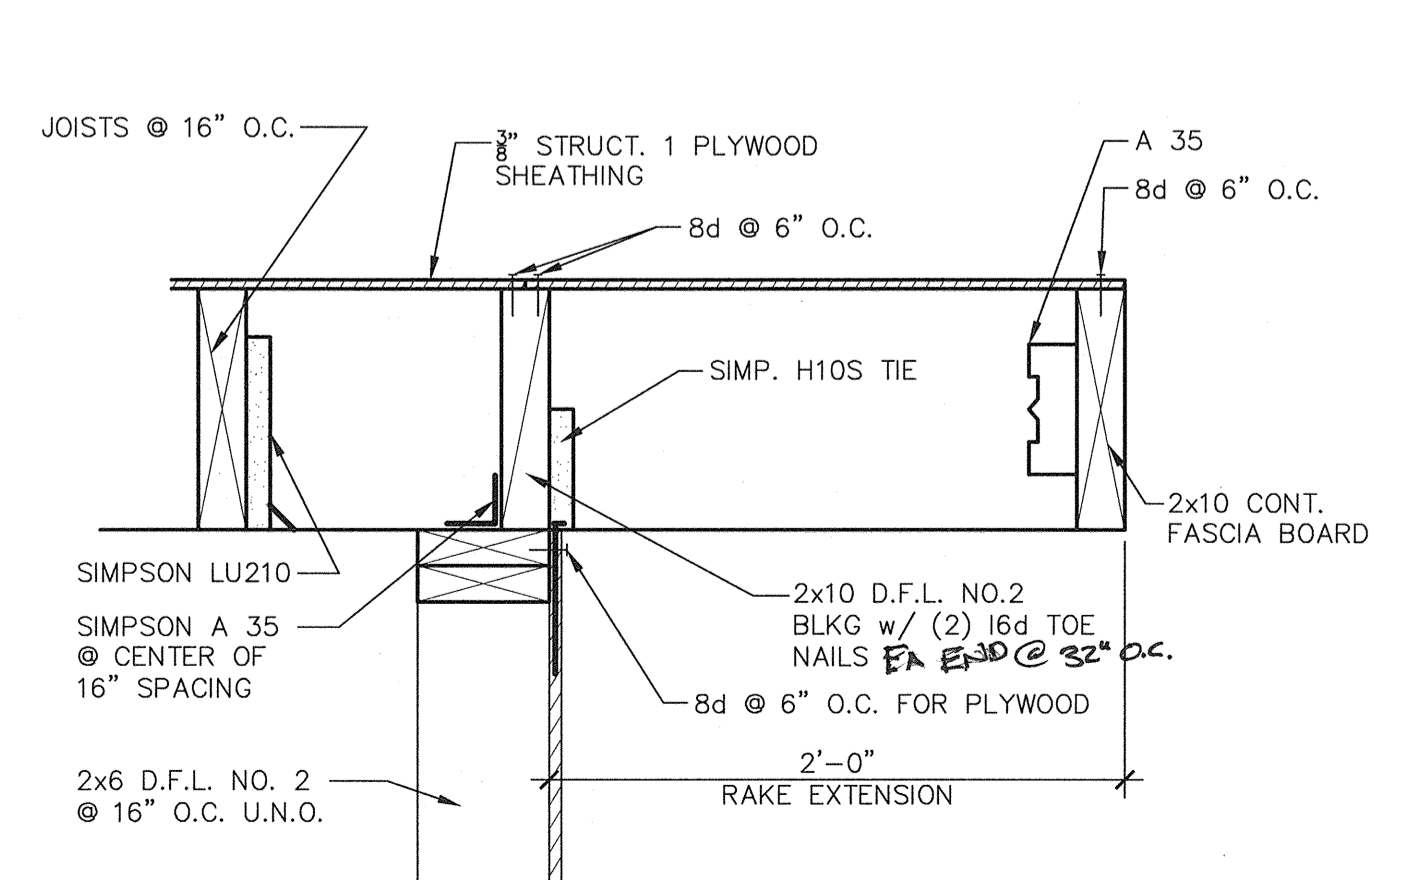

**12 ROOF JOIST @ RAKE @ LINE**  
 S3.01 SDW141-07 SCALE: 1 1/2" = 1'-0"

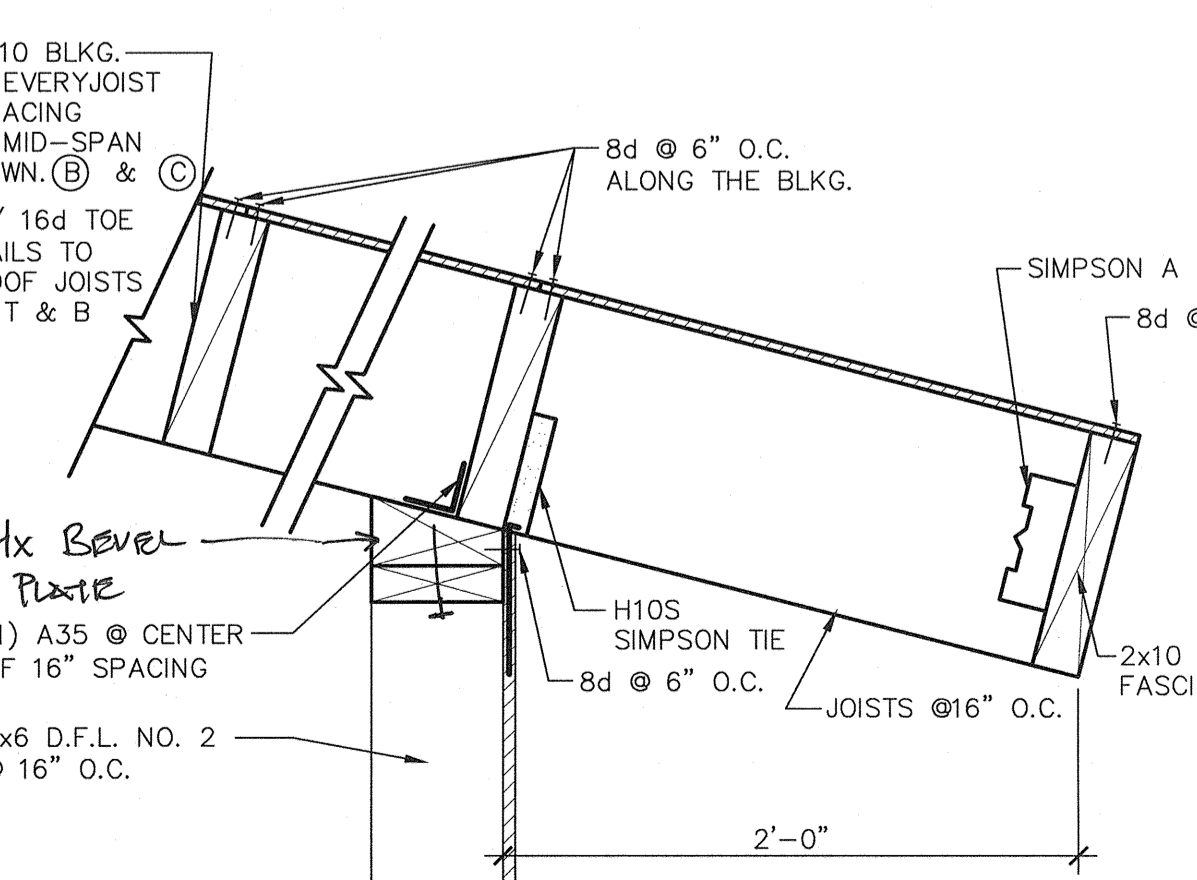

**8 ROOF JOIST @ LOW EAVE**  
 S3.01 SDW141-05 SCALE: 1 1/2" = 1'-0"

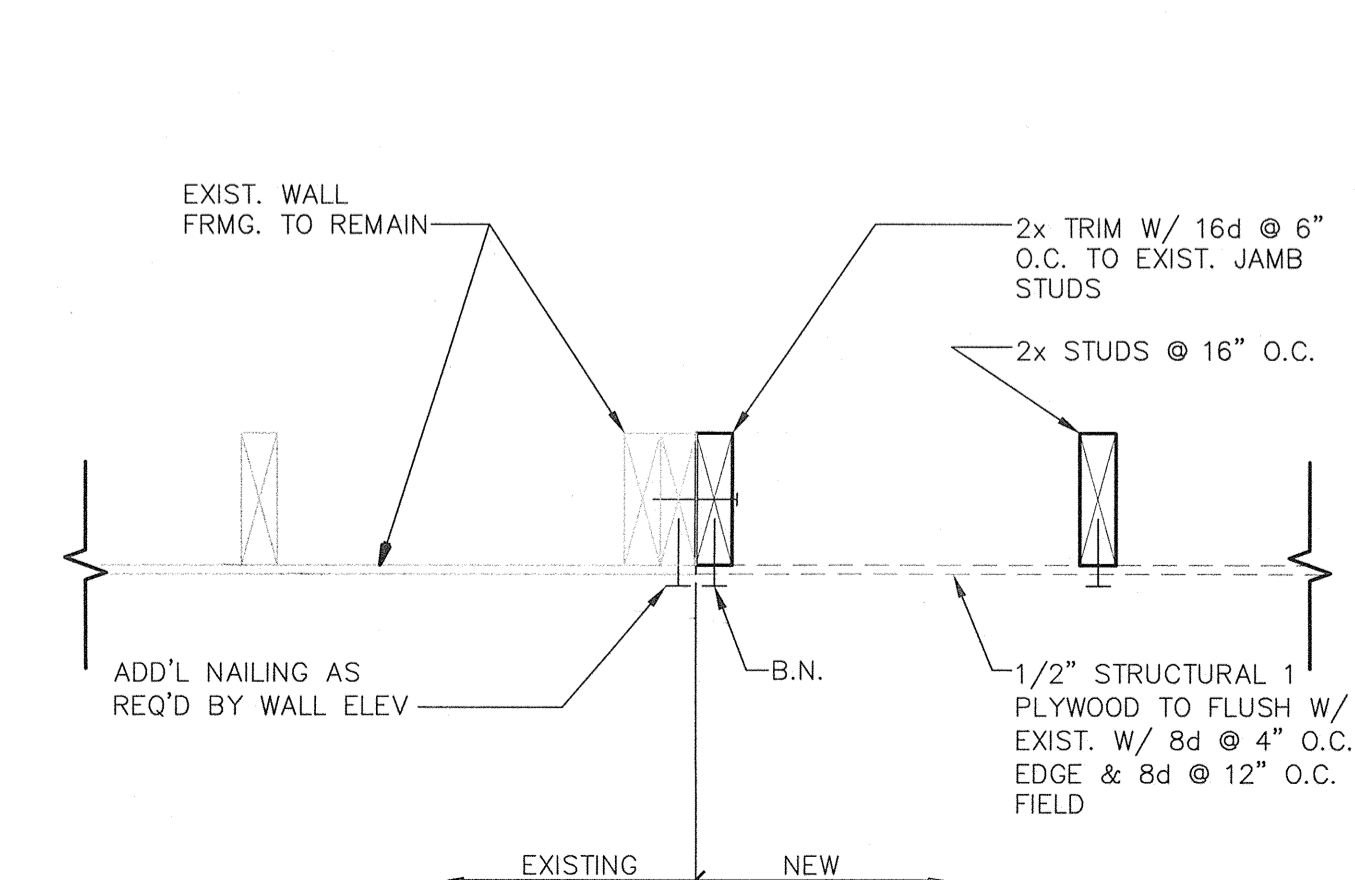

**4 WALL INFILL**  
 S3.01 SDW141-03 SCALE: 1 1/2" = 1'-0"

Ownership of Documents  
 This document, the ideas and designs incorporated herein, as an instrument of Professional Service is the property of Integrated Designs by SOMAM Inc. and is not to be used, in whole or in part for any other project without written authorization.  
 © COPYRIGHT 2012

**integrated designs** by SOMAM, Inc.  
 ARCHITECTURE - ENGINEERING - INTERIOR DESIGN - CONSTRUCTION MANAGEMENT  
 6011 N. Fresno, Suite 130 - Fresno, California 93710  
 Phone (559) 438-0881 Fax (559) 438-0887 E-Mail: design@somam.com  
 www.integrateddesigns.com

Rev. Date:	
Revision Description:	
Rev. Date:	
Revision Description:	
Rev. Date:	
Revision Description:	

**STRUCTURAL DETAILS**

**MT. VERNON ELEMENTARY SCHOOL KITCHEN ADDITION**  
 BAKERSFIELD CITY SCHOOL DISTRICT  
 2161 POTOMAC AVENUE BAKERSFIELD CA

Sheet Title: \_\_\_\_\_  
 Issue Date: 07/20/12  
 Date: 07/31/12  
 Designer: \_\_\_\_\_  
 Checker: \_\_\_\_\_  
 P.C.: CJM

Agency Approval Stamp:

FILE # 15-6  
 IDENTIFICATION STAMP  
 DIV. OF THE STATE ARCHITECT  
 OFFICE OF REGULATION SERVICES

03-114521  
 AC: \_\_\_\_\_ FLS: \_\_\_\_\_ SS: \_\_\_\_\_  
 DATE: 8/1/12  
 TRACKING #: 63321-118

Stamp(s):

REGISTERED PROFESSIONAL ENGINEER  
 S 3877  
 EXP. 6-30-15  
 STATE OF CALIFORNIA

1/30/12

Job No.: **3990**

Sheet No.: **S3.01**

Release: \_\_\_\_\_